




31+25

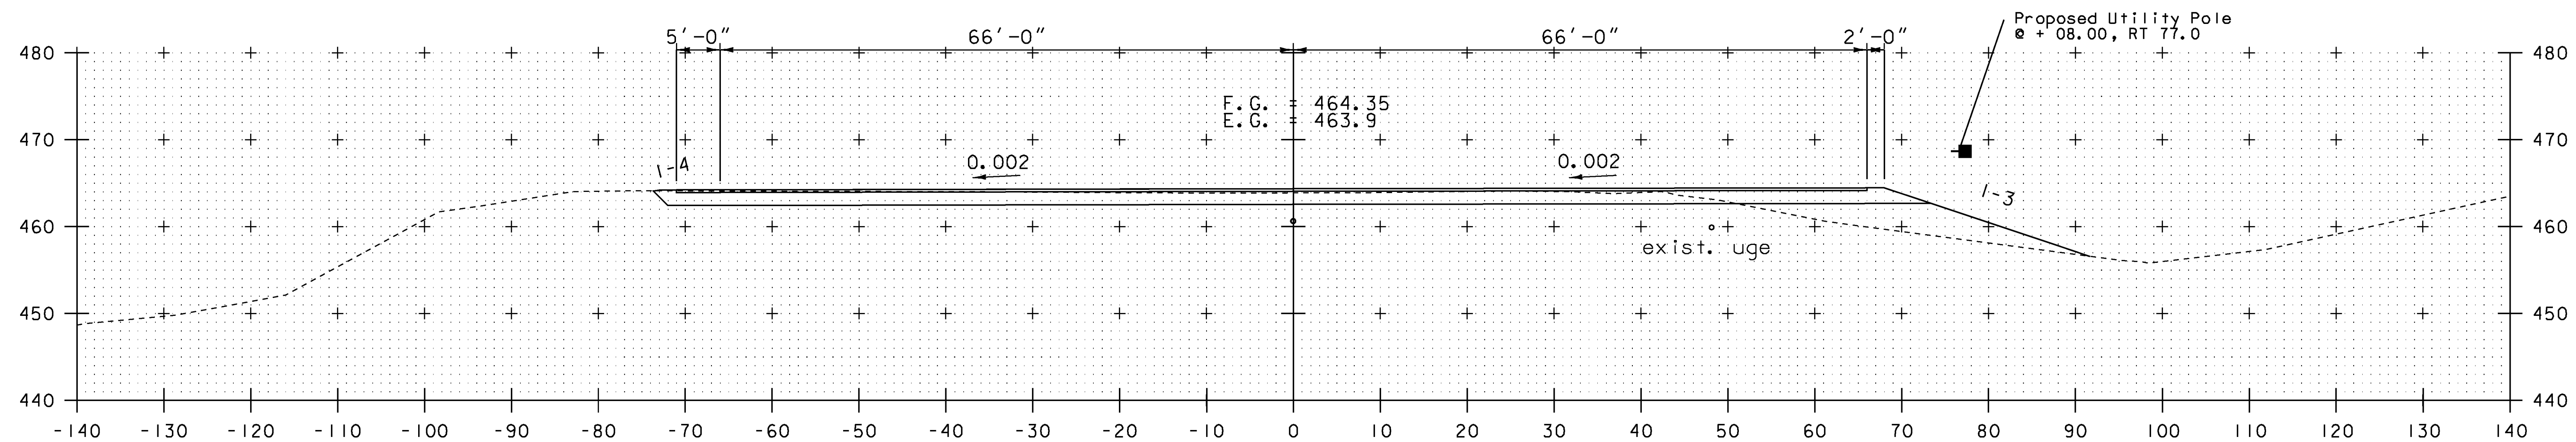

31+00

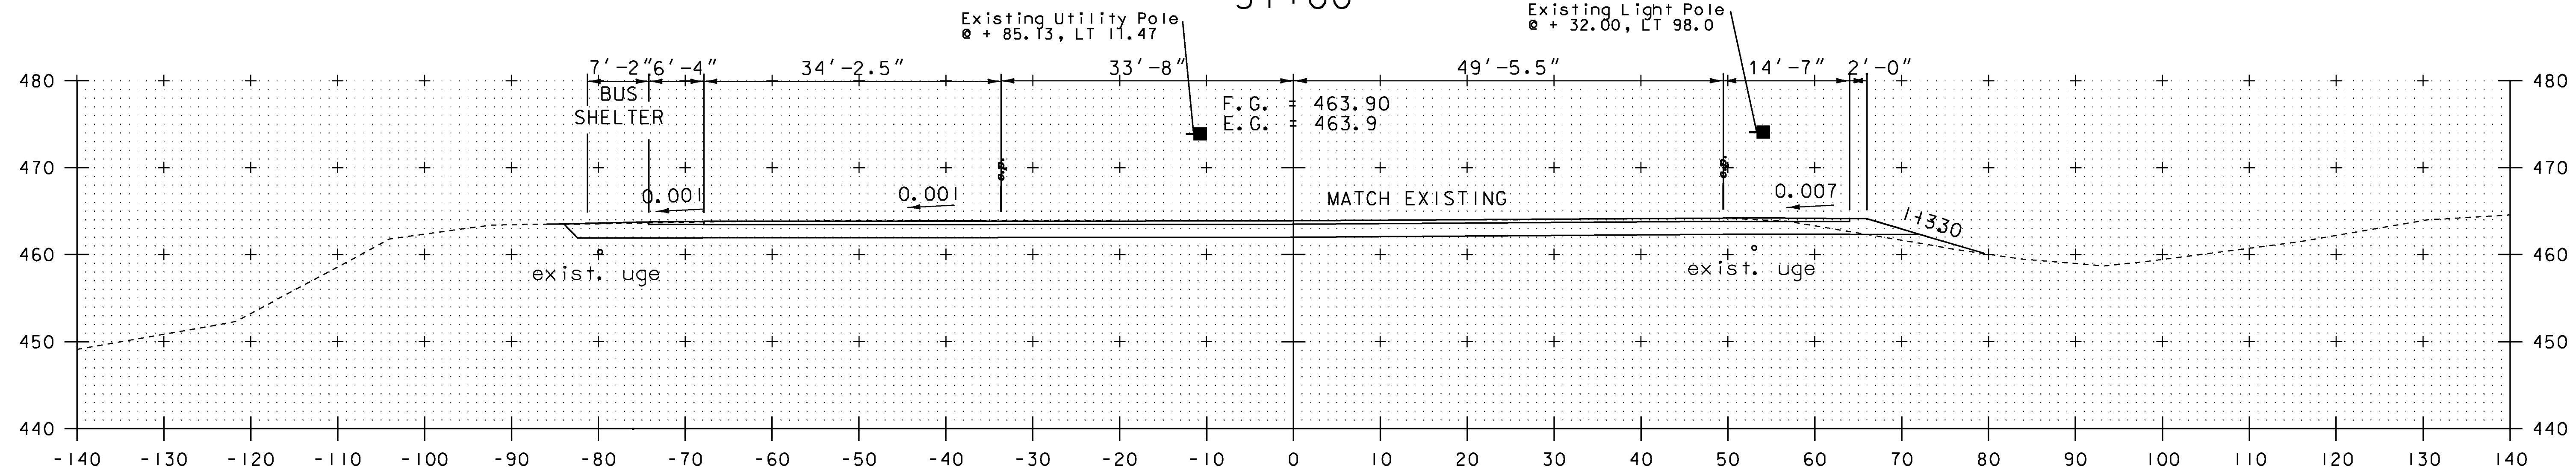

30+75

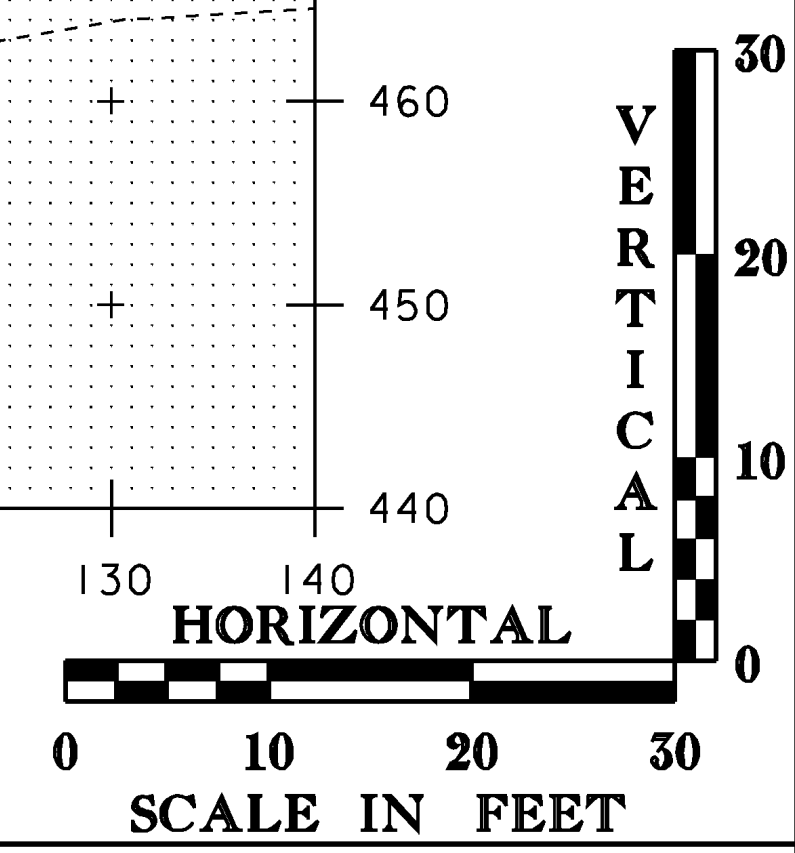

Hoyle, Tanner & Associates, Inc.

STA. 30+75 TO STA. 31+25

HTA PROJECT 904221	MODEL Z20K15401XS02
-----------------------	------------------------

PROJECT NAME: HARTLAND
 PROJECT NUMBER: CMG PARK(25)
 FILE NAME: Z20K154xsl.dgn
 PROJECT LEADER: WAYNE L. DAVIS
 DESIGNED BY: JCC
CROSS SECTIONS 2 OF 4

PLOT DATE: 9/16/2013
 DRAWN BY: JCC
 CHECKED BY: CRM
 SHEET 28 OF 30

9/16/2013 10:00 AM
 Z:\Projects\2013\CMG Park\25\28.dwg
 JCC