


BEGIN PAINTED ISLAND  
49+50 CL AND PAINTED ISLAND 55+00 CL

DURABLE 4" WHITE LINE  
STA. 48+50 RT. ~ STA. 49+00 RT  
STA. 48+50 LT. ~ STA. 49+00 LT

BEGIN SCARIFIED PAVEMENT  
STA. 48+50 CL ~ STA. 49+00 CL

DURABLE DOTTED LINE WHITE LINE  
STA. 53+00 RT. ~ STA. 55+00 RT

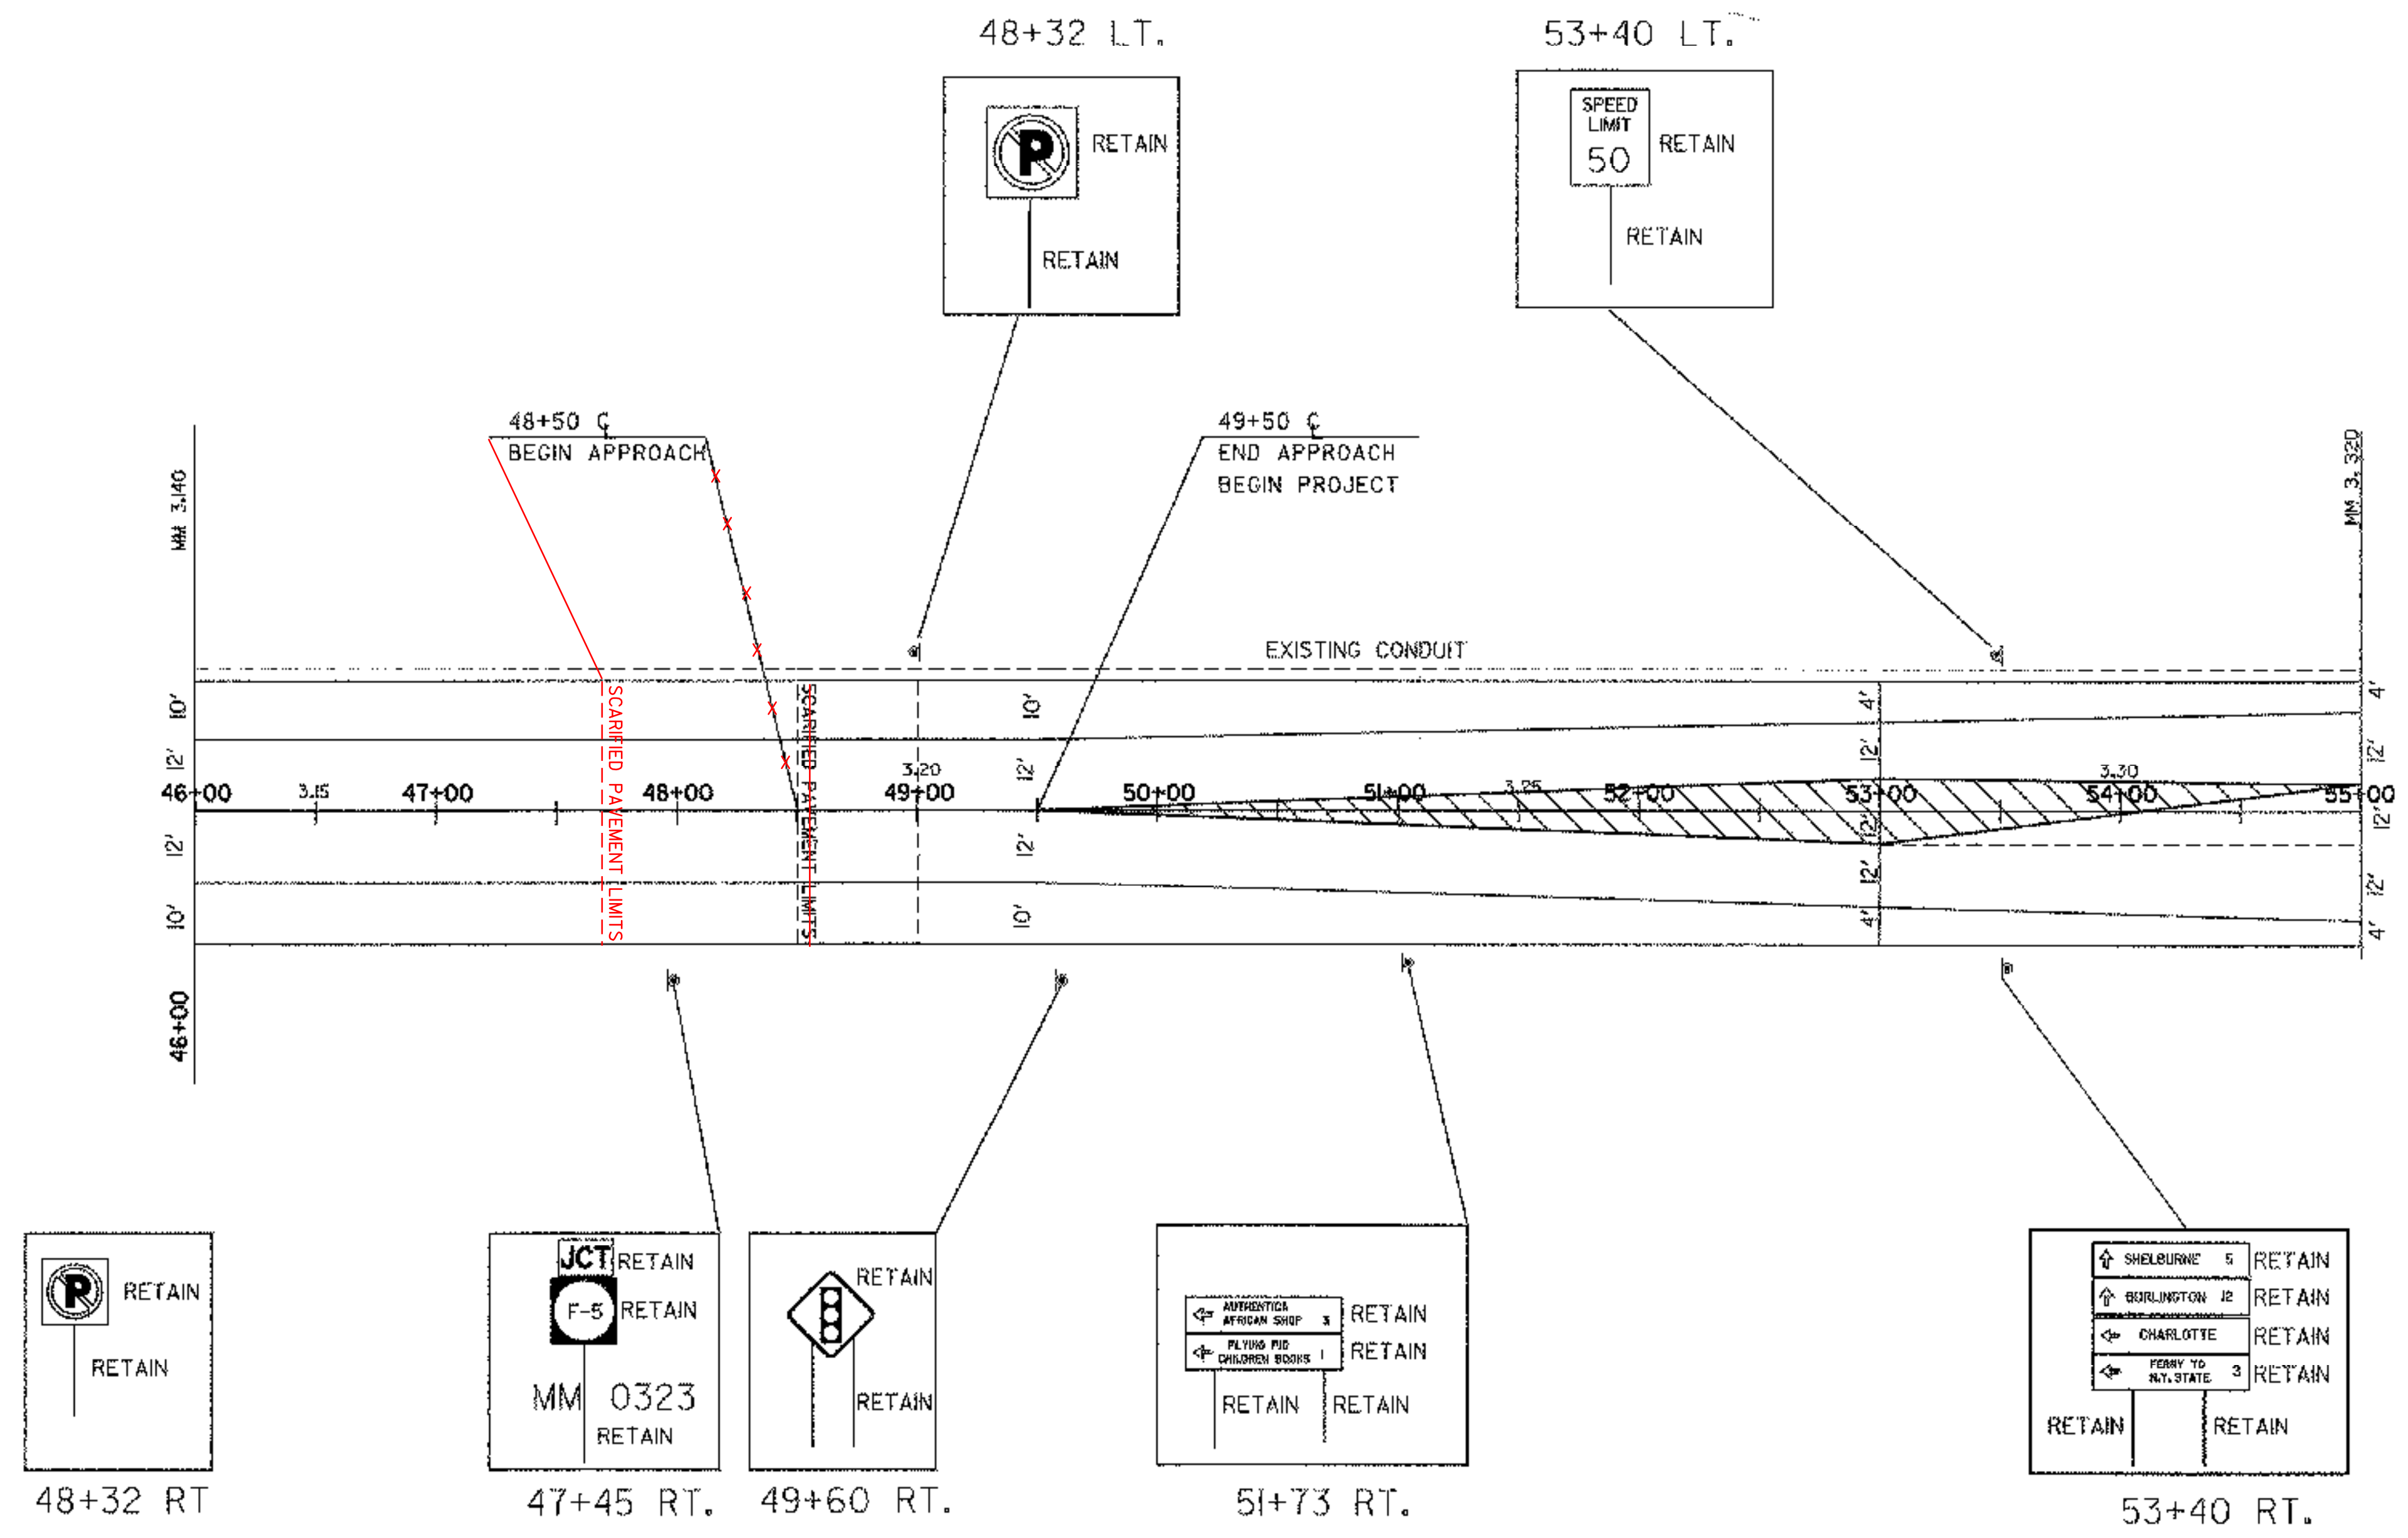

TRAFFIC SIGN & PAVEMENT MARKING LAYOUT  
STA. 46+00 - STA. 55+00

NOT TO SCALE

LEGEND

SCARIFIED PAVEMENT LIMITS -----

PREPARED BY \_\_\_\_\_ DATE \_\_\_\_\_  
CHECKED BY \_\_\_\_\_ DATE \_\_\_\_\_  
PROJECT MANAGER \_\_\_\_\_  
PROJ. CHARLOTTE  
HES 019-4 (30)  
SHEET 5 OF 6 SHEETS