

BEGIN PAINTED ISLAND
 STA. 61+46 C AND PAINTED ISLAND STA. 65+50 C

DURABLE 4" WHITE LINE
 55+00 LT. ~ SL 12+75 LT.
 SL 12+75 RT. ~ 65+50 LT.
 55+00 RT. ~ SL 15+15 RT.
 SL 15+15 LT. ~ 65+50 RT.


DURABLE DOTTED LINE WHITE LINE
 63+50 LT. ~ 65+50 LT.
 63+50 RT. ~ 65+50 RT.

DURABLE ARROW MARKINGS
 2 @ STA. 58+35 RT
 2 @ STA. 59+88 RT
 2 @ STA. 61+60 LT
 2 @ STA. 63+05 LT

DURABLE 24" STOPBAR
 STA. 60+17 RT
 STA. 61+46 LT
 TH. 2 STA. 60+84 77 RT
 RTE F5 STA. 61+64 80 LT

DURABLE LETTER WORD MARKING
 STA. 59+42 RT (ONLY)
 STA. 62+33 LT (ONLY)

BEGIN SCARIFIED PAVEMENT
 STA. 65+00 C ~ STA. 65+50 C

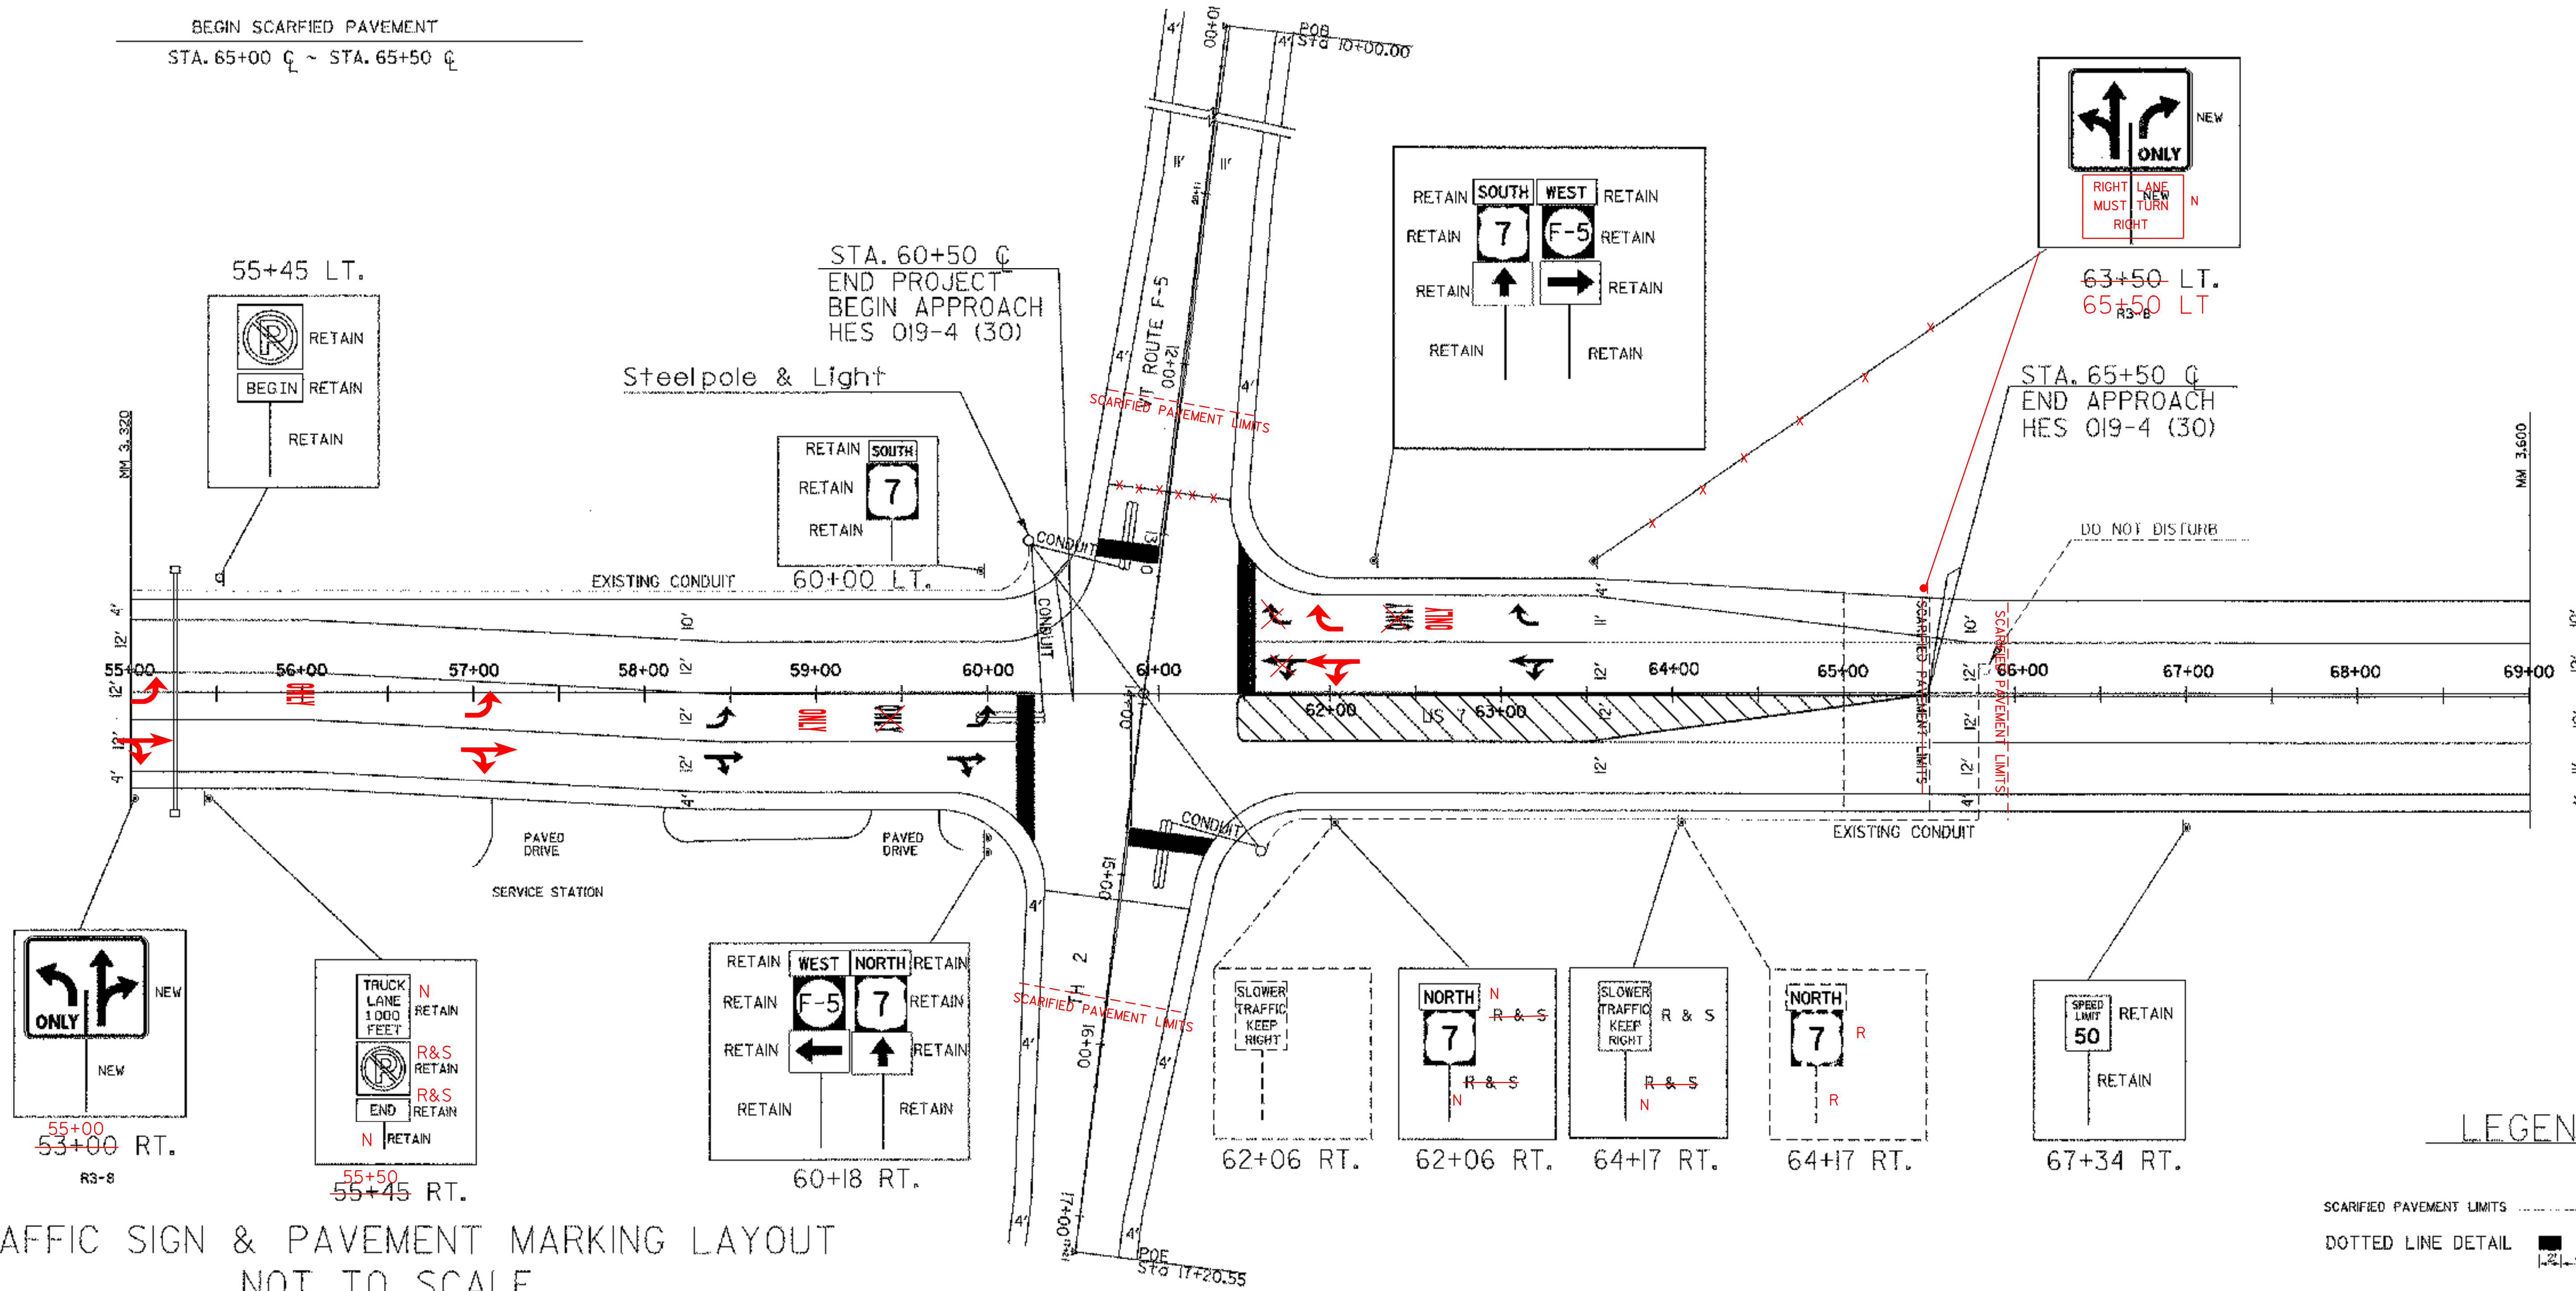

TRAFFIC SIGN & PAVEMENT MARKING LAYOUT
 NOT TO SCALE

LEGEND

SCARIFIED PAVEMENT LIMITS - - - - -
 DOTTED LINE DETAIL [thick black line]

DATUM
 VERTICAL _____
 HORIZONTAL _____

PREPARED BY AL JONES DATE 06/23/04
 CHECKED BY AL JONES DATE 06/23/04
 PROJECT MANAGER AMY GAMBLE DATE 06/23/04
 PROJ. CHARLOTTE
 HES 019-4 (30)
 SHEET 5 OF 6 SHEETS