


**CURVE E-1**  
 P.C.= STA. E2+000.000  
 P.T.= STA. E2+072.385  
 Δ=09°43'09.0" RT  
 R=426.720 m  
 T=36.279 m  
 L=72.385 m  
 E=1.538 m  
 e<sub>max</sub>=N/A

**CURVE E-2**  
 P.C.= STA. E2+284.158  
 P.T.= STA. E2+471.417  
 Δ=72°34'42.0" RT  
 R=147.828 m  
 T=108.547 m  
 L=187.258 m  
 E=35.572 m  
 e<sub>max</sub>=N/A



LEGEND	
	SILT FENCE
	SILT FENCE FOR DRAINAGE STRUCTURE PROTECTION
	EROSION MATTING, (SEE NOTE 2)

\*SEE NOTE 1

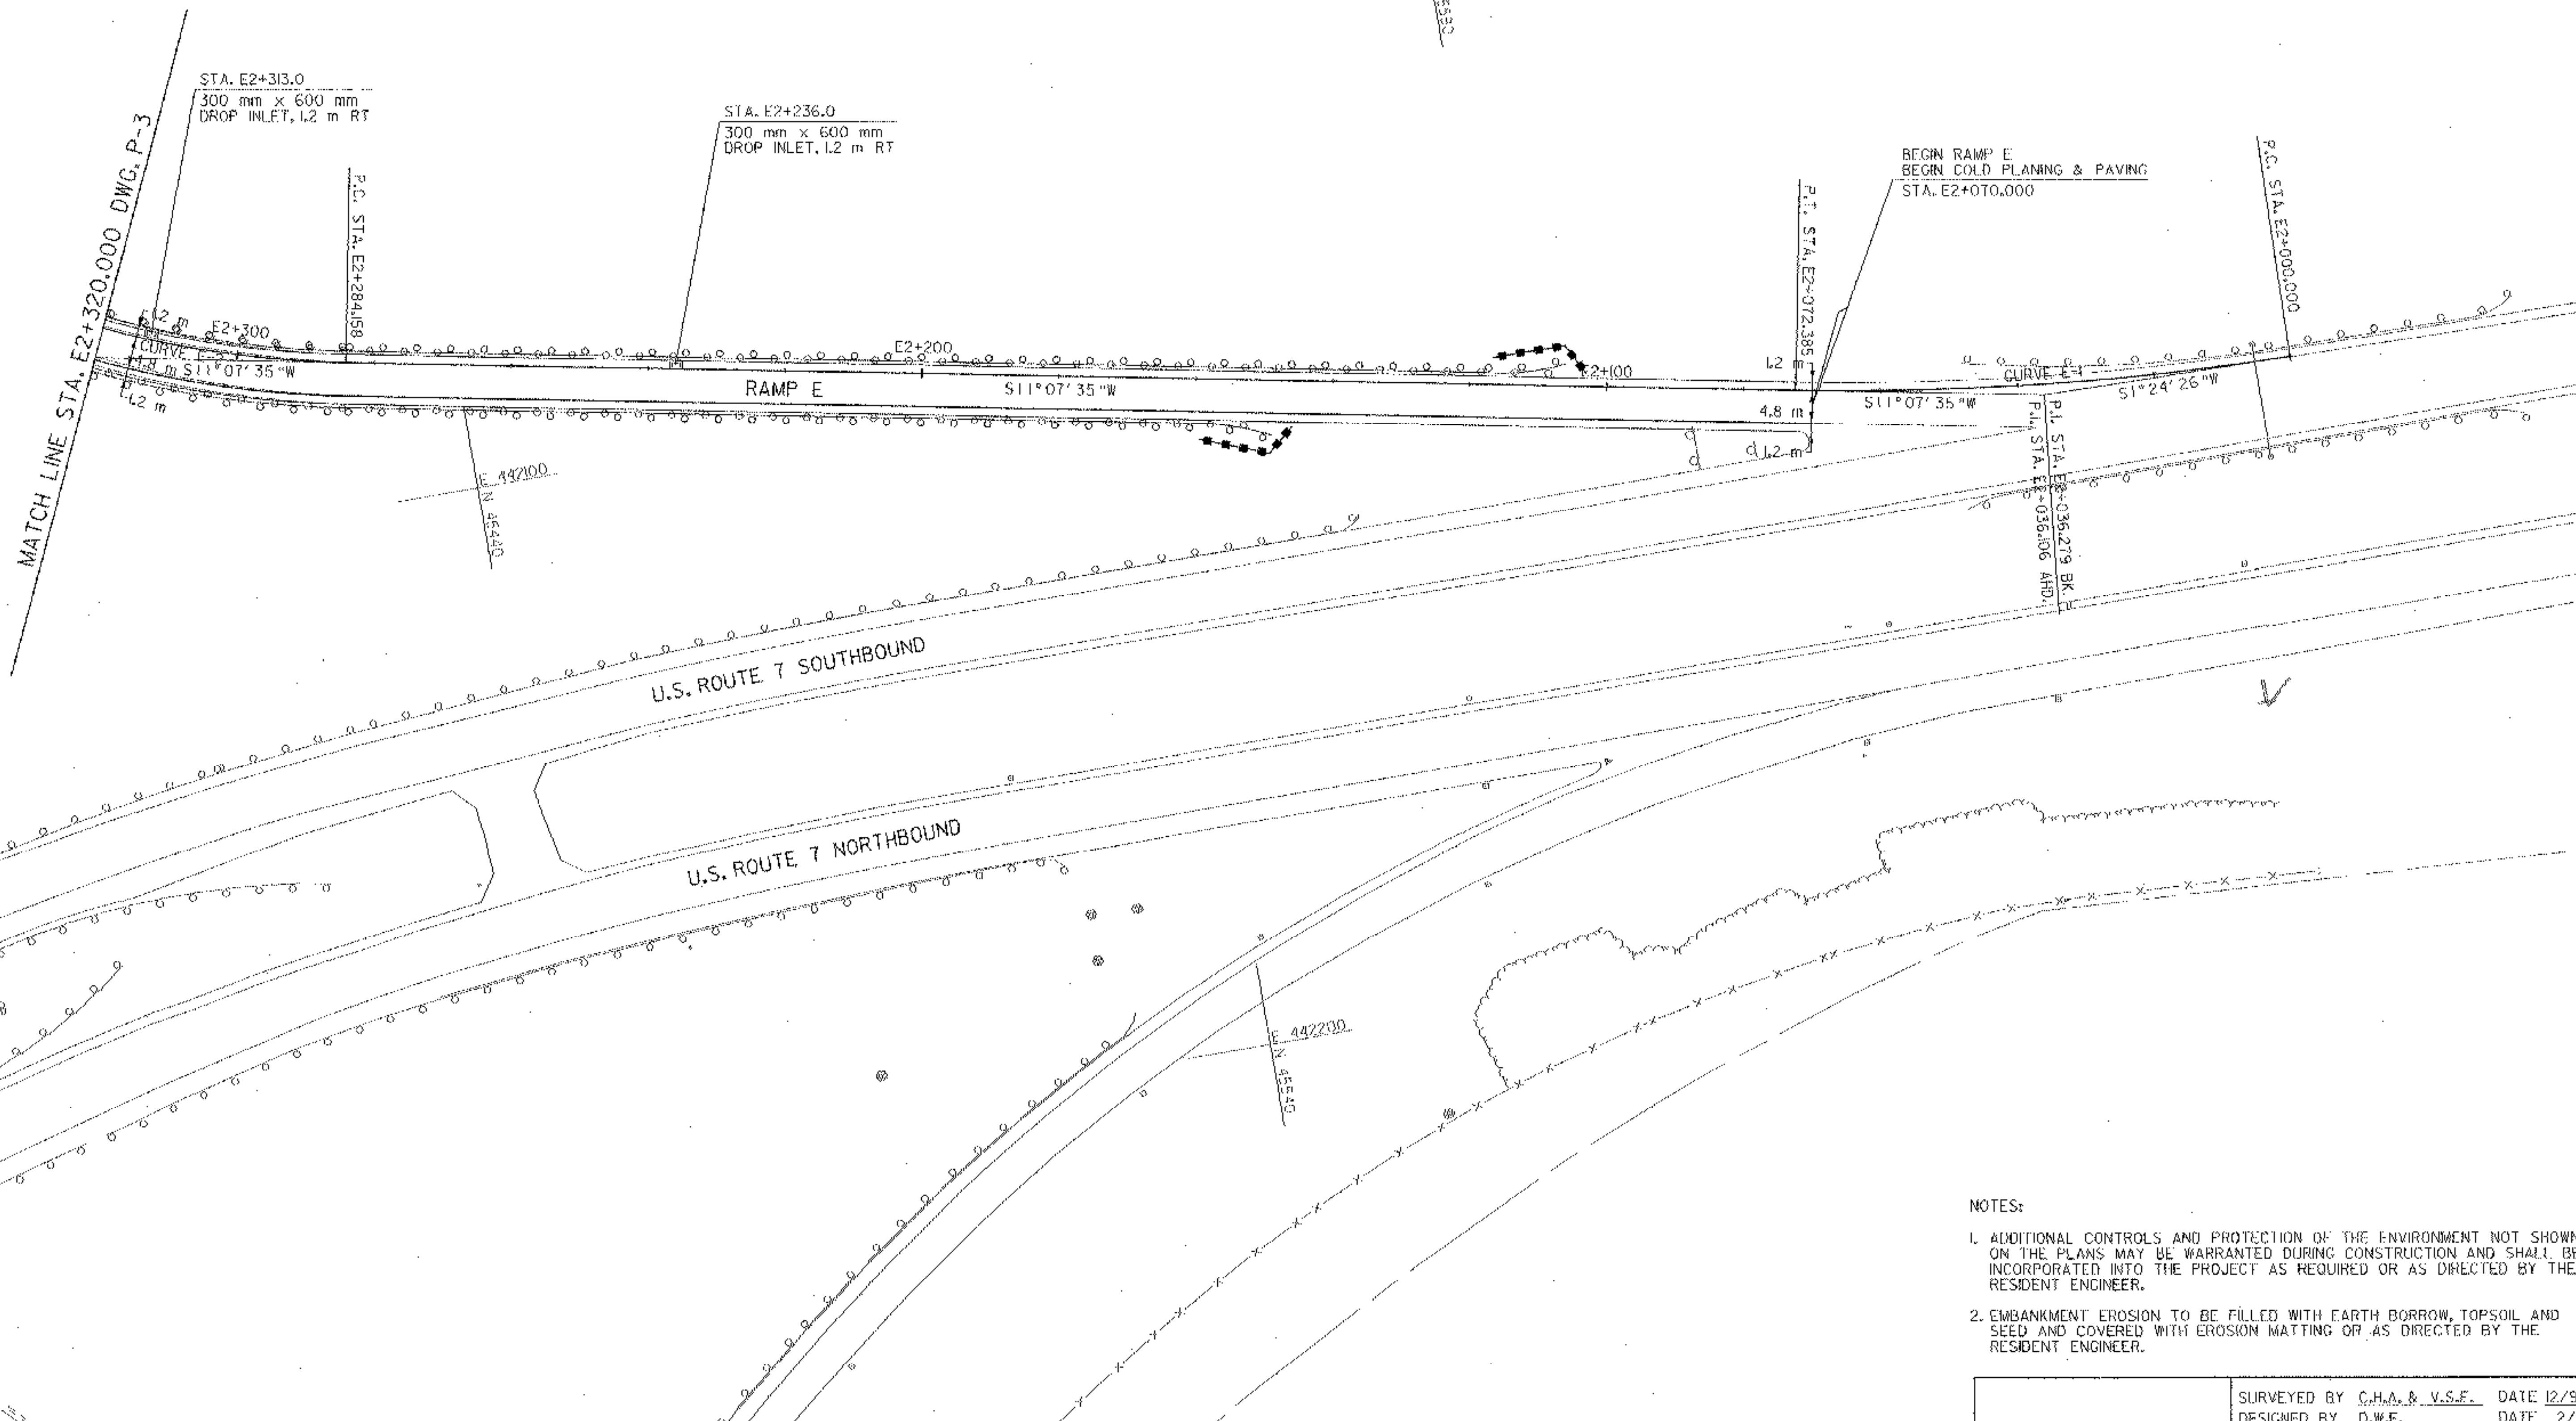

- NOTES:**
- ADDITIONAL CONTROLS AND PROTECTION OF THE ENVIRONMENT NOT SHOWN ON THE PLANS MAY BE WARRANTED DURING CONSTRUCTION AND SHALL BE INCORPORATED INTO THE PROJECT AS REQUIRED OR AS DIRECTED BY THE RESIDENT ENGINEER.
  - EMBANKMENT EROSION TO BE FILLED WITH EARTH BORROW, TOPSOIL AND SEED AND COVERED WITH EROSION MATTING OR AS DIRECTED BY THE RESIDENT ENGINEER.

- 604.40 CHANGE ELEVATION OF DL CB OR MI  
 STA. E2+236.0 RT  
 STA. E2+313.0 RT  
 35 TREATED TIMBER CURB  
 616.31 BITUMINOUS CONCRETE CURB TYPE B  
 STA. E2+156.2 - STA. E2+320.0 (6.7 ft)
- 621.80 STEEL BEAM GUARDRAIL  
 STA. E2+113.5 - STA. E2+320.0 RT (206.7 m)  
 STA. E2+160.0 - STA. E2+320.0 LT (160.0 m)
- 621.505 MANUFACTURED TERMINAL SECTION (FLARED)  
 STA. E2+113.3 RT (1EA)  
 STA. E2+160.0 LT (1EA)
- 621.80 REMOVAL AND DISPOSAL OF GUARDRAIL  
 STA. E2+109.0 - STA. E2+320.0 RT (211.0 m)  
 STA. E2+150.0 - STA. E2+320.0 LT (170.0 m)

DATUM	
VERTICAL	NAVD 88
HORIZONTAL	NAD 83 (1982)



<b>PLAN</b>	SURVEYED BY	C.H.A. & V.S.F.	DATE	12/93
	DESIGNED BY	D.W.E.	DATE	2/04
	DRAWN BY	C.A.K.	DATE	2/04
	CHECKED BY	D.E.G.	DATE	2/04
DESIGN FILE NO. PLAN04.DGN				
PROJ. NAME BENNINGTON - HOOSICK D.P.L. 0146(1) C/6				
PROJ. NO. P.I.N. 1305.60				
DWG NO. P-4 SHEET 23 OF 83				

FILE NAME: m:\1116\vaot\centr\act\6\plan04.dgn  
 DATE/TIME: 2/16/2004  
 USER: 2225