


INDEX OF SHEETS  
SEE DWG. NO. IND-1

# STATE OF VERMONT AGENCY OF TRANSPORTATION

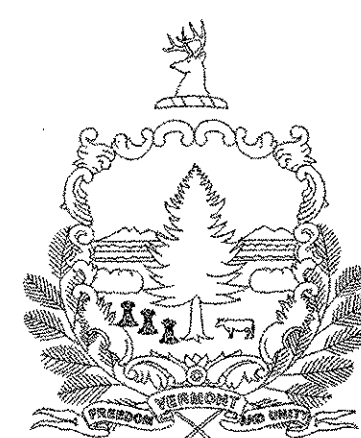


## PROPOSED IMPROVEMENT TOWN OF BENNINGTON COUNTY OF BENNINGTON VT. ROUTE 279

### BENNINGTON-HOOSICK D.P.I. 0146(1) C/6

BEGINNING APPROXIMATELY 5175 m (3.216 MILES) EAST OF THE VERMONT/NEW YORK STATE LINE AT W.B. STA. 17+305.027 AND E.B. STA. 17+298.377, BENNINGTON - HOOSICK D.P.I. 0146(1) C/6 PROCEEDS EASTERLY 514.973 m (0.320 MILE) CROSSING VT. ROUTE 67A, VT. RAILWAY AND HISTORIC VT. ROUTE 7A BEFORE TERMINATING AT THE U.S. ROUTE 7 INTERCHANGE AT W.B. STA. 18+000.000 AND E.B. STA. 18+000.000.

LENGTH OF ROADWAY 1075.412 m (0.668 MILE)  
LENGTH OF STRUCTURE 321.184 m (0.200 MILE)  
LENGTH OF PROJECT 1396.596 m (0.868 MILE)

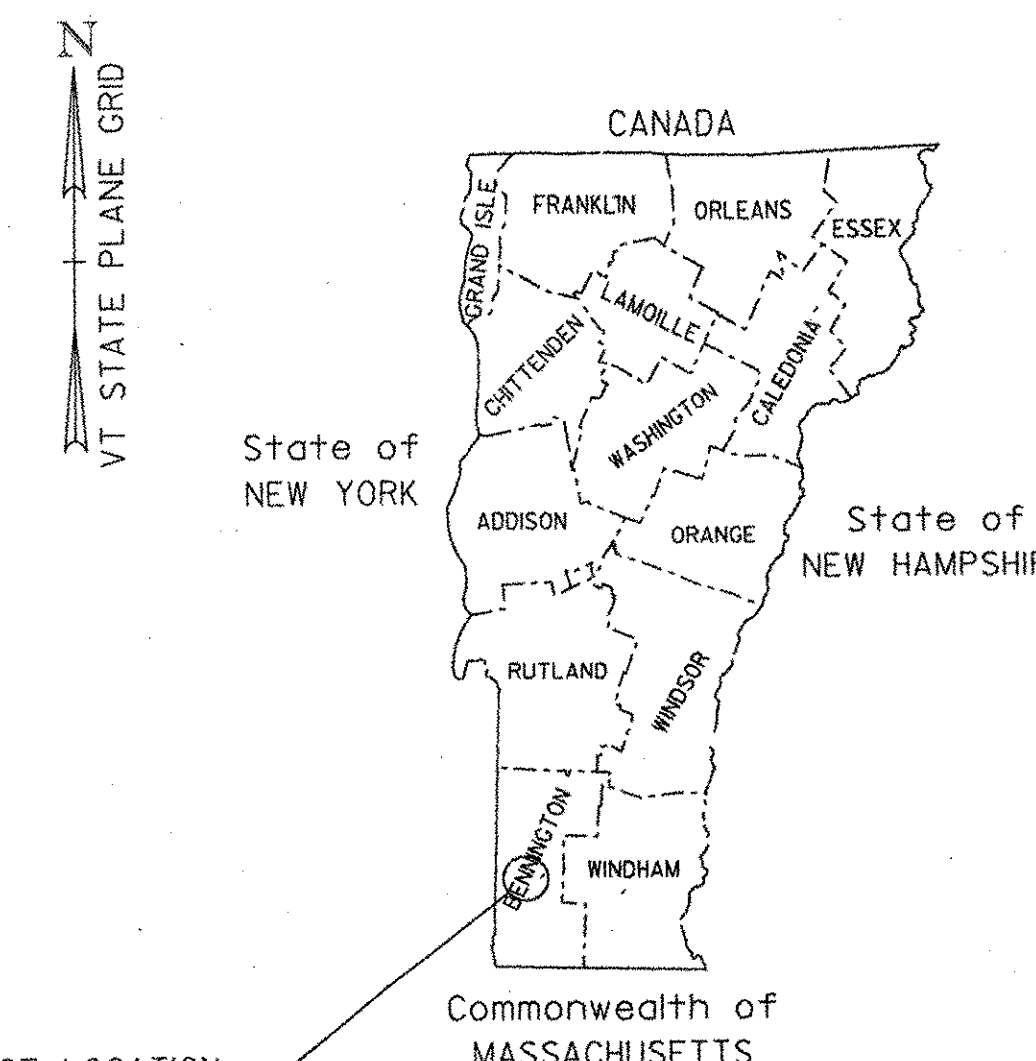

PROJECT LOCATION  
D.P.I. 0146(1) C/6


#### TRAFFIC DATA

2000 ADT = 5300  
2020 ADT = 6600  
2020 ADTT = 460  
2020 DHV = 840  
T = 7%  
D = 52%  
V = 100 km/h  
2000 ~ 2020 CUM. ESALS = 4,825,000  
2000 ~ 2040 CUM. ESALS = 17,229,000  
PRINCIPAL ARTERIAL

RECORD PLANS	
CONTRACTOR:	KUBRICKY CONSTRUCTION CORP - GLENS FALLS, NY
RESIDENT ENGINEER:	RON LEMAIRE
CONSTRUCTION BEGAN:	MAY 16, 2004
CONSTRUCTION COMPLETE:	SEPTEMBER 14, 2005
RECORD PLANS BY:	RON LEMAIRE & J. GILMORE
I HEREBY CERTIFY THAT ALL THE CONSTRUCTION REQUIRED BY THIS SET OF DRAWINGS HAS BEEN ACCOMPLISHED AS INDICATED HEREIN.	
BY <i>Ronald Lemaire</i>	RESIDENT ENGINEER
DATE <i>02/23/07</i>	
NOTE: Any further information concerning final quantities, amounts or other details relative to this project may be found at Central Files in the electronic archives.	


WORK TO BE PERFORMED UNDER THIS PROJECT INCLUDES COLD PLANING, RESURFACING WITH A SHIM/LEVELING COURSE AND WEARING COURSE; BRIDGE REHABILITATION WORK, MILLED RUMBLE STRIPS, GUARDRAIL IMPROVEMENTS, DRAINAGE IMPROVEMENTS, PAVEMENT MARKINGS, SIGNING AND INCIDENTAL ITEMS.

BITUMINOUS CONCRETE PAVEMENT SUPERPAVE MIXTURE DESIGN CRITERIA	
DESIGN LANE / DESIGN LIFE ESAL	2,509,000
DESIGN NUMBER OF GYRATIONS	100
PERFORMANCE GRADED ASPHALT BINDER	PG 58-28

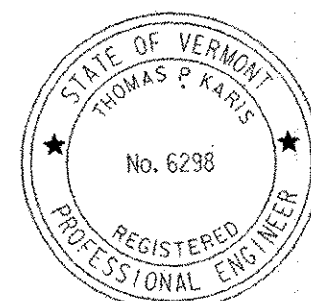

PLANS PREPARED BY  
**CHA CLOUGH, HARBOUR & ASSOCIATES LLP**  
ENGINEERS, SURVEYORS, PLANNERS & LANDSCAPE ARCHITECTS  
111 WENDELLS CIRCLE ALBANY, NEW YORK, 12205  
518-453-4500

BY *Anna J. Cain* 2/17/04

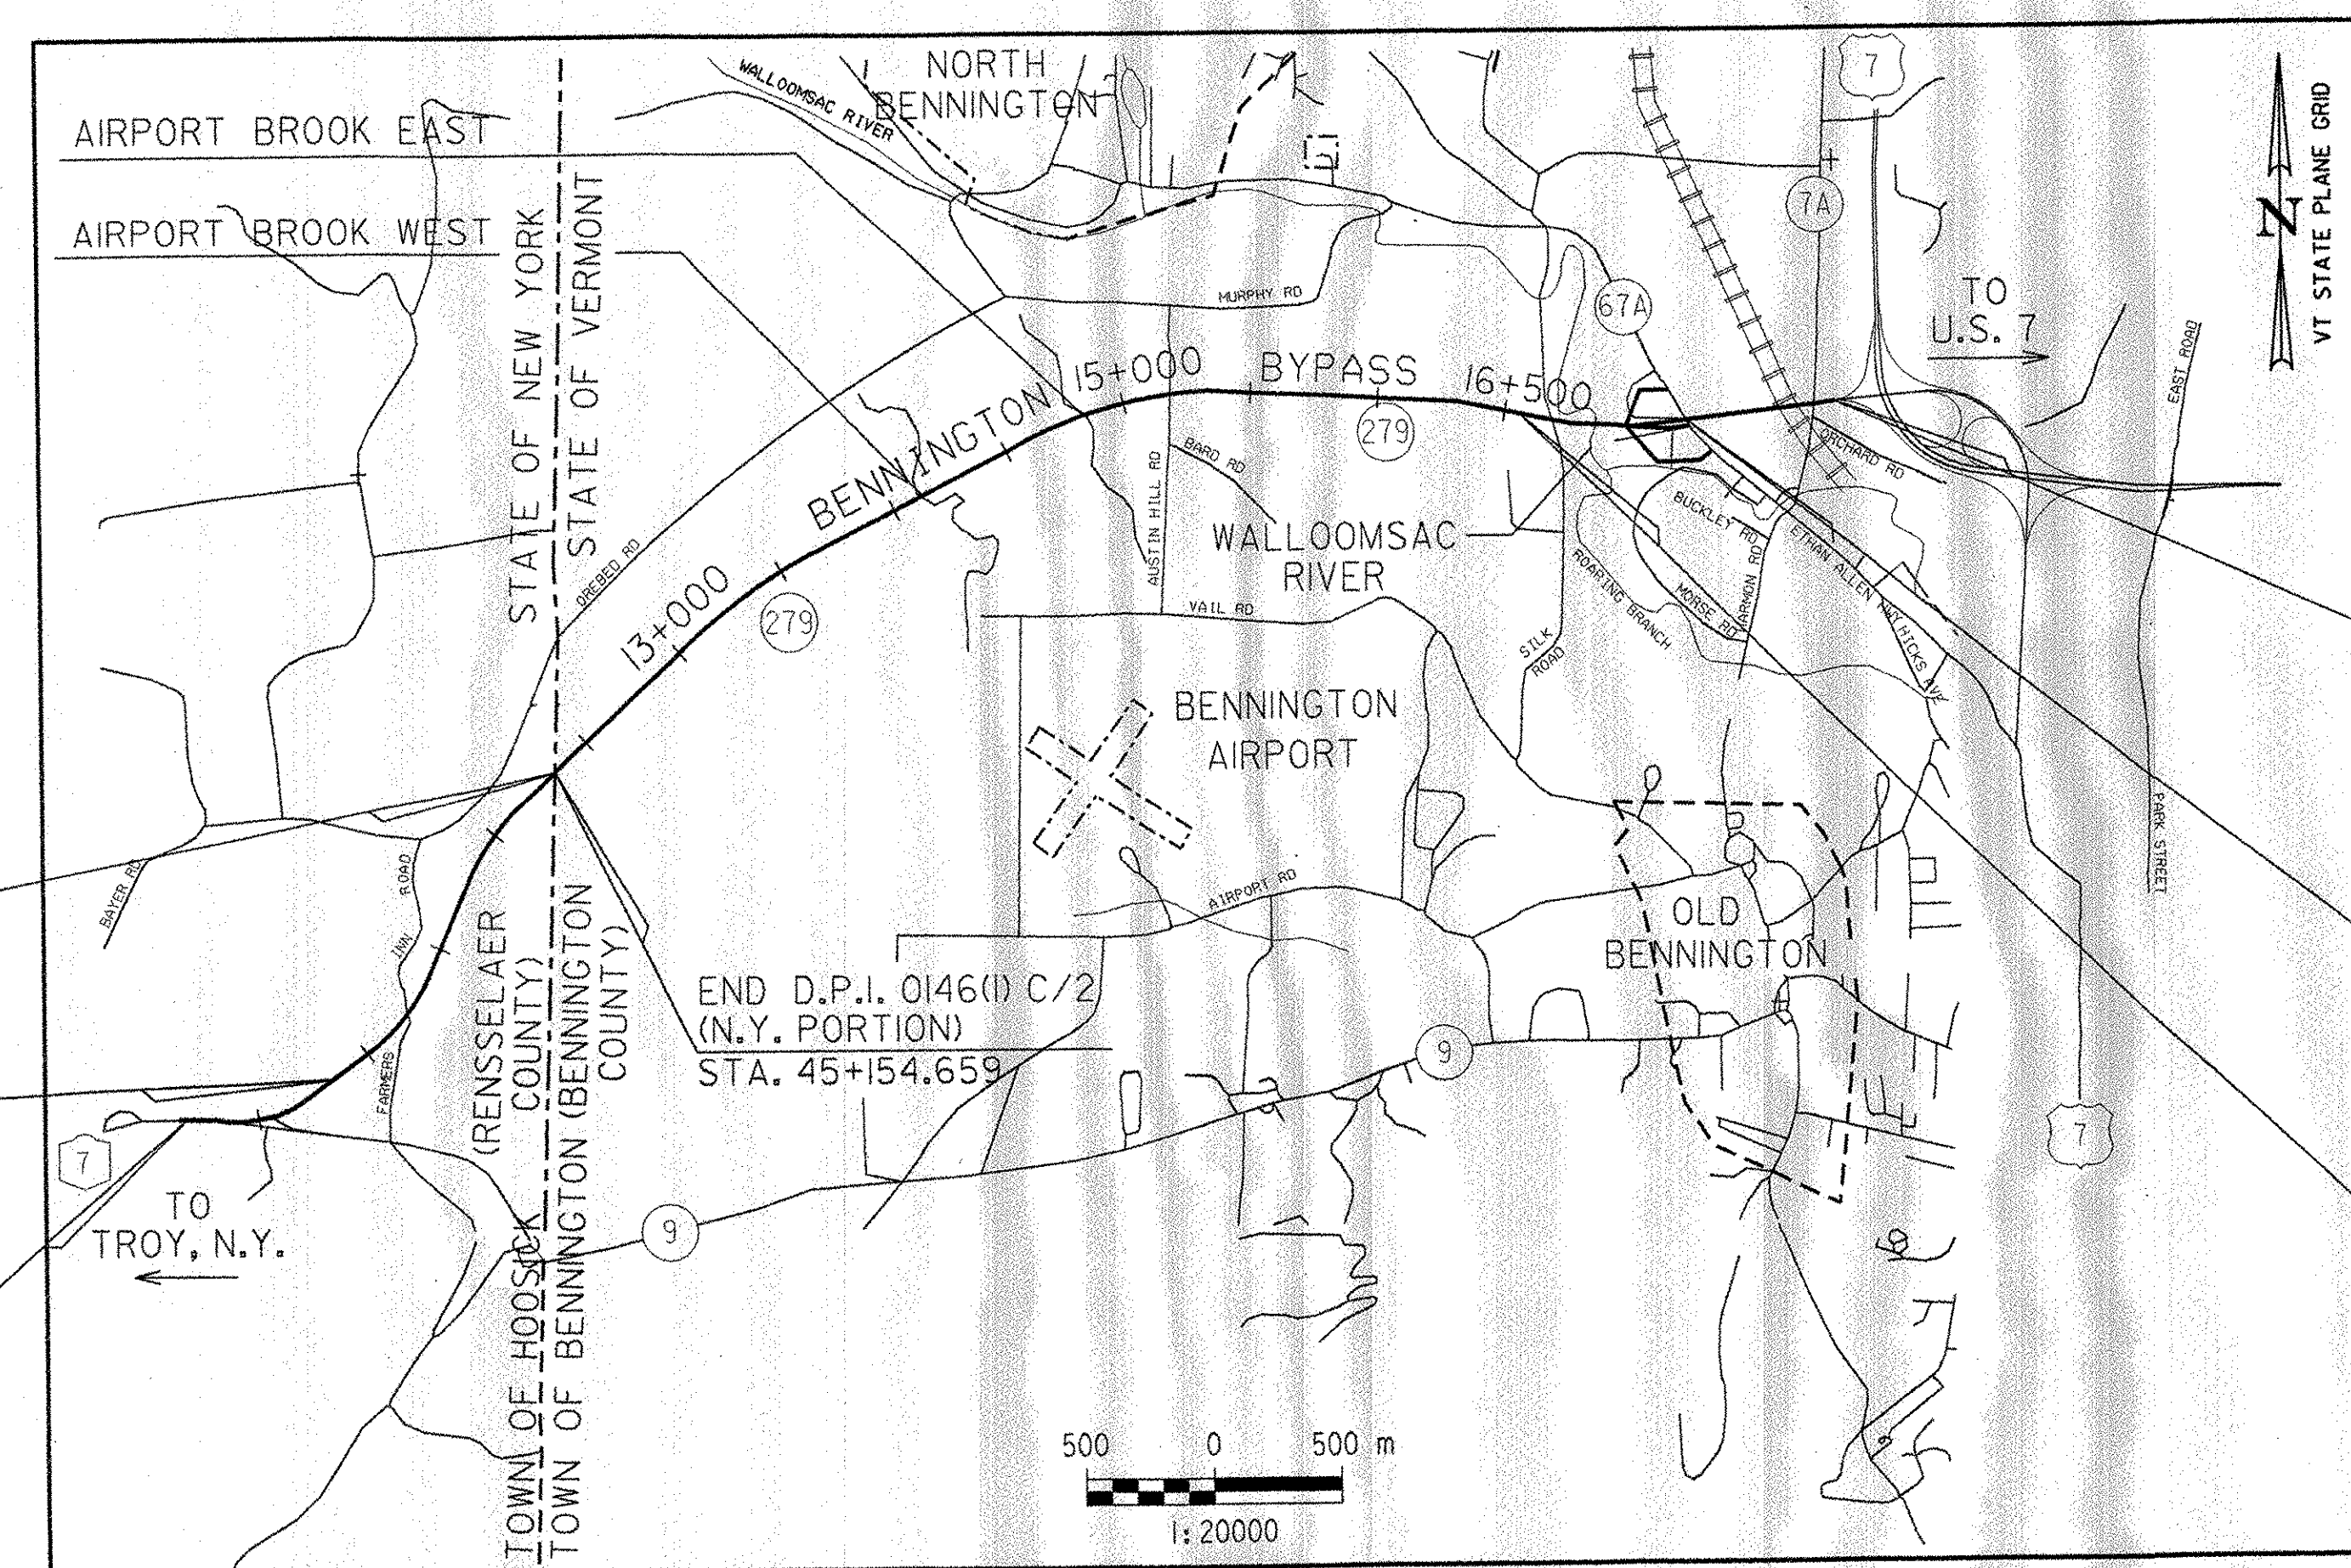

CONVENTIONAL SIGNS	
COUNTY LINE	---
TOWN LINE	---
LIMITS OF ACCESS	---X---
POINT OF ACCESS	---X---
FENCE LINE	---X---
STONE WALL	---X---
TRAVELED WAY	---X---
GUARD RAIL	---X---
RAILROAD	---X---
SURVEY LINE	---X---
CULVERT	---X---
POWER POLE	---X---
TELEPHONE POLE	---X---
TREES	---X---
CONTROL OF ACCESS	---X---
PROPERTY LINE	---X---
R.O.W. TAKING LINE	---X---
SLOPE RIGHTS	---X---
TOP OF CUT	---X---
TOE OF SLOPE	---X---

DATUM	
VERTICAL	NAVD 88
HORIZONTAL	NAD 83 (1992)

FILE NAME = \\S116\VA001\CONTRACTS\COVER.DGN  
DATE/TIME = 2/16/2004 10:22:25  
USER = 2225

END D.P.I. 0146(1) C/6 (VT. PORTION)  
W.B. STA. 18+000.000 & E.B. STA. 18+000.000

END D.P.I. 0146(1) C/4  
BEGIN D.P.I. 0146(1) C/6 (VT. PORTION)  
STA. 10+064.800 = W.B. STA. 17+305.027 & STA. 10+236.439 = E.B. STA. 17+298.377

END D.P.I. 0146(1) C/3  
BEGIN D.P.I. 0146(1) C/4 (VT. PORTION)  
STA. 16+695.000

THESE PLANS ARE SUBJECT TO SUCH ENGINEERING CHANGES AS MAY BE REQUIRED BY THE FEDERAL HIGHWAY ADMINISTRATION OR THE DIRECTOR OF PROGRAM DEVELOPMENT.

CONSTRUCTION IS TO BE CARRIED ON IN ACCORDANCE WITH THESE PLANS AND THE STANDARD SPECIFICATIONS FOR CONSTRUCTION DATED 2001, AS APPROVED BY THE FEDERAL HIGHWAY ADMINISTRATION ON JANUARY 4, 2001 FOR USE ON THIS PROJECT, INCLUDING ALL SUBSEQUENT REVISIONS AND SUCH REVISED SPECIFICATIONS AND SPECIAL PROVISIONS AS ARE INCORPORATED IN THESE PLANS.



SUBMITTED BY ORDER OF THE STATE TRANSPORTATION BOARD	
APPROVED <i>[Signature]</i>	DATE <i>2/17/04</i>
DIRECTOR OF PROGRAM DEVELOPMENT	
DEPARTMENT OF TRANSPORTATION FEDERAL HIGHWAY ADMINISTRATION	
APPROVED _____	DATE _____
DIVISION ADMINISTRATOR	
PROJECT	BENNINGTON-HOOSICK D.P.I. 0146(1) C/6 P.I.N. 1306.60
DWG. NO. T-1	SHEET 1 OF 83 SHEET

SHEET NO.	DWG. NO.	TITLE
1	T-1	TITLE SHEET
2	IND-1	INDEX OF SHEETS
3	TS-1	TYPICAL SECTION
4-5	PDT-1 TO PDT-2	PAVING DETAIL SHEETS
6-9	Q-1 TO Q-4	QUANTITY SHEETS
10-15	DS-1 TO DS-6	ITEM DETAIL SUMMARY SHEETS
16	HC-1	HORIZONTAL CONTROL TABLE
17	EC-1	EROSION CONTROL DETAIL SHEET
18-19	G-1 TO G-2	GENERAL PLANS
20-23	P-1 TO P-4	PLANS
24-35	CSP-1 TO CSP-12	CONSTRUCTION SEQUENCING PLANS
36-39	TSP-1 TO TSP-4	TEMPORARY SIGNING & STRIPING PLANS
40	CAS-1	CONSTRUCTION APPROACH SIGNING DETAIL SHEET
41-44	SSP-1 TO SSP-4	SIGNING AND STRIPING PLANS
45-49	TSS-1 TO TSS-4	TRAFFIC SIGN SUMMARY SHEETS
50	TS-1	TRAFFIC SIGN DETAIL SHEET
51	SPD-1	OVERHEAD SIGN PLACEMENT DETAIL SHEET
52-53	MD-1 TO MD-2	APPROACH RAIL - N.E.T.C. 2 RAIL DETAIL SHEETS
54-56	-	BLANK
57	BR1	GENERAL NOTES AND DETAILS
58	BR2	SECTIONS AND DETAILS
59	BR3	PAVEMENT AND CURB DETAILS
60	BR4	BRIDGE RAILING - N.E.T.C. 2 RAIL
61	BR5	SNOW FENCE FOR BRIDGE RAILING - N.E.T.C. 2 RAIL
62	BR800	VT. ROUTE 67A - PLAN AND ELEVATION
63	BR801	VT. ROUTE 67A - EXISTING TRANSVERSE BRIDGE SECTIONS
64	BR802	VT. ROUTE 67A - BRIDGE QUANTITY SHEET
65	BR803	VT. ROUTE 67A - BRIDGE RAILING AND CURB DETAILS
66	BR804	VT. ROUTE 67A - FRAMING PLAN AND STEEL DETAILS
67	BRI00	VT. RAILWAY - PLAN AND ELEVATION
68	BRI01	VT. RAILWAY - EXISTING TRANSVERSE BRIDGE SECTIONS
69	BRI02	VT. RAILWAY - BRIDGE QUANTITY SHEET
70	BRI03	VT. RAILWAY - BRIDGE RAILING AND CURB DETAILS
71	BRI04	VT. RAILWAY - EXPANSION JOINTS AT WEST ABUTMENTS
72	BRI05	VT. RAILWAY - JOINT DETAILS
73	BRI06	VT. RAILWAY - BEARING LAYOUT PLAN AND DETAILS
74	BRI07	VT. RAILWAY - PEDESTAL DETAILS
75	BR200	HISTORIC VT. ROUTE 7A - PLAN AND ELEVATION
76	BR201	HISTORIC VT. ROUTE 7A - EXISTING TRANSVERSE BRIDGE SECTIONS
77	BR202	HISTORIC VT. ROUTE 7A - BRIDGE QUANTITY SHEET
78	BR203	HISTORIC VT. ROUTE 7A - BRIDGE RAILING AND CURB DETAILS
79	BR204	HISTORIC VT. ROUTE 7A - EXPANSION JOINTS AT EAST ABUTMENTS
80	BR205	HISTORIC VT. ROUTE 7A - JOINT DETAILS
81	BR206	HISTORIC VT. ROUTE 7A - BEARING LAYOUT PLAN AND DETAILS
82	BR207	HISTORIC VT. ROUTE 7A - BEARING DETAILS
83	BR208	HISTORIC VT. ROUTE 7A - PEDESTAL DETAILS

**VAOT STANDARDS**

C-1M	CAST IN PLACE CONCRETE CURB	01-03-00
D-3M	TREATED GUTTERS	06-13-97
D-6M	REINFORCED CONCRETE DROP INLET WITH GRATE FOR USE IN DITCHES	06-13-97
D-9M	REINFORCED CONCRETE DROP INLET WITH VERTICAL CURB, REINFORCED CONCRETE DROP INLET WITH THROAT ADAPTOR	06-13-97
D-11M	STEEL GRATE, CAST IRON GRATE TYPE A, CAST IRON COVER	06-13-97
D-13M	CONCRETE CATCH BASIN WITH A CAST IRON GRATE, CONCRETE MANHOLE WITH A CAST IRON GRATE	01-03-00
D-15M	CAST IRON GRATE WITH FRAME, TYPE D AND TYPE E	06-13-97
E-100M	CONSTRUCTION APPROACH SIGNS	06-13-97
E-101M	CONSTRUCTION SIGN DETAILS	05-30-03
E-102M	CONSTRUCTION SIGN DETAILS	06-30-03
E-102AM	CONSTRUCTION SIGN DETAILS	06-13-97
E-103M	MAINLINE TRAFFIC CONTROL DIVIDED HIGHWAY, ONE LANE CLOSED	09-24-98
E-105M	TRAFFIC CONTROL FOR CONSTRUCTION VEHICLE, U-TURNS ON DIVIDED HIGHWAY	04-01-99
E-106M	TRAFFIC CONTROL - MISCELLANEOUS DETAILS	06-13-97
E-107M	DELINEATION, BARRICADES AND DETOURS FOR CONSTRUCTION AREAS	06-30-03
E-107AM	BREAKAWAY BARRICADE DETAILS	06-13-97
E-108M	CONSTRUCTION ZONE LONGITUDINAL DROP OFFS	06-13-97
E-110M	MAJOR MAINTENANCE OPERATION LANE CLOSURE	06-13-97
E-111M	MAINTENANCE OPERATION APPROACH SIGNS	02-17-98
E-112M	TYPICAL MOVING MAINTENANCE OPERATIONS	02-23-98
E-120M	STANDARD SIGN PLACEMENT EXPRESSWAY AND FREEWAY	06-13-97
E-123M	GUIDE SIGN PLACEMENT - MISCELLANEOUS DETAILS	06-13-97
E-126M	TYPICAL FREEWAY INTERCHANGE SIGNING	02-01-00
E-130M	TYPE "B" GUIDE SIGN ATTACHMENT DETAILS	06-13-97
E-131M	GUIDE SIGN DETAILS	06-13-97
E-132M	GENERAL MOTORIST SERVICE SIGN DETAILS	06-13-97
E-134M	BRIDGE NUMBER PLAQUE	06-13-97
E-136AM	U.S. ROUTE MARKER SIGN DETAILS	06-13-97
E-136BM	STATE ROUTE MARKER - SIGN DETAILS	06-13-97
E-138M	REFERENCE PLAQUE DETAILS STATE AND TOWN HIGHWAYS	05-30-03
E-142M	REGULATORY SIGN DETAILS	06-13-97
E-143M	REGULATORY SIGN DETAILS	06-13-97
E-150M	WARNING SIGN DETAILS	06-13-97
E-151M	WARNING SIGN DETAILS	06-13-97
E-155M	WARNING SIGN DETAILS	06-13-97
E-161M	W-SHAPED STEEL SIGN POST	06-13-97
E-162M	TUBULAR ALUMINUM SIGN POST	06-13-97
E-164M	SQUARE STEEL SIGN POST	06-13-97
E-191M	PAVEMENT MARKING DETAILS	02-01-99
E-192M	PAVEMENT MARKING DETAILS	12-28-98
E-193M	PAVEMENT MARKING DETAILS	06-13-97
E-197M	DELINEATOR PLACEMENT TYPICAL	06-13-97
E-198M	DELINEATOR AND MILE POSTS	06-13-97
E-199M	DELINEATORS AND MILE POST MOUNTING ON BRIDGE RAIL	06-13-97
G-1M	STEEL BEAM GUARDRAIL	01-03-00
G-1DM	STEEL BEAM GUARDRAIL	01-03-00
G-4M	MARKER - GUIDE POSTS - PLANK GUARDRAIL, PLANK RAIL, WOOD MARKER POSTS, STEEL MARKER POSTS	06-13-97
G-18M	PRECAST CONCRETE TEMPORARY TRAFFIC BARRIER	06-13-97
G-19M	GENERIC GRADING PLAN FOR GUARDRAIL TERMINALS	11-15-02
T-1M	TEMPORARY EROSION CONTROL DETAILS	06-13-97
T-2M	TEMPORARY EROSION CONTROL DETAILS	06-13-97

ALIGNMENT	
AHD.	= AHEAD
BK.	= BACK
C	= HORIZONTAL CONTROL LINE
Δ	= ANGLE OF INTERSECTION
E	= EXTERNAL DISTANCE
e	= SUPERELEVATION RATE
H.C.L.	= HORIZONTAL CONTROL LINE
L	= LENGTH
P.C.	= POINT OF CURVATURE
P.C.C.	= POINT OF COMPOUND CURVATURE
P.I.	= POINT OF INTERSECTION
P.T.	= POINT OF TANGENT
R	= RADIUS
STA.	= STATION
T	= TANGENT

FILE NAME = u:\5116\vaot\contract6\index.dgn  
 DATE/TIME = 2/16/2004  
 USER = 2225

DATUM	
VERTICAL	NAVD 88
HORIZONTAL	NAD 83 (1992)


**INDEX OF SHEETS**

SURVEYED BY	C.H.A. & V.S.E.	DATE	12/93
DESIGNED BY	D.W.E.	DATE	2/04
DRAWN BY	C.A.K.	DATE	2/04
CHECKED BY	D.E.G.	DATE	2/04
DESIGN FILE NO.	INDEX.DGN		
PROJ. NAME	BENNINGTON - HOOSICK D.P.I. 0146(1) C/6		
PROJ. NO.	P.I.N. 1306.60		
DWG. NO.	IND-1	SHEET	2 OF 83

TYPICAL SECTION - VT. ROUTE 279 & INTERCHANGE RAMPS



- NOTES:
1. THE WEARING COURSE SHALL BE TYPE **WS III** SUPERPAVE BITUMINOUS CONCRETE PAVEMENT (PG 58-28). THE LEVELING COURSE SHALL BE TYPE IVS SUPERPAVE BITUMINOUS CONCRETE PAVEMENT (PG 58-28) OR AS DIRECTED BY THE RESIDENT ENGINEER.
  2. SUPERPAVE BITUMINOUS CONCRETE PAVEMENT TOLERANCE = ±5 mm (TOTAL PAVEMENT THICKNESS EXCLUDING LEVELING).
  3. THE ENTIRE WIDTH OF THE EXISTING ROADWAY SURFACE SHALL BE COLD PLANED TO A DEPTH OF 50 mm OR AS DIRECTED BY THE RESIDENT ENGINEER. ALL PAVEMENT ON BRIDGES SHALL BE REMOVED UNDER ITEM 529.00 REMOVAL OF BRIDGE PAVEMENT OR AS DIRECTED BY THE RESIDENT ENGINEER.
  4. EMULSIFIED ASPHALT SHALL BE APPLIED ON ALL EXISTING PAVEMENT SURFACES, ON ALL COLD PLANED SURFACES AND BETWEEN ALL COURSES OF PAVEMENT AT THE RATE OF 0.12 L/m<sup>2</sup> OR AS DIRECTED BY THE RESIDENT ENGINEER.
  5. BITUMINOUS CONCRETE CURB, TYPE B SHALL BE BACKED UP TO FULL HEIGHT WITH ITEM 402.12 AGGREGATE SHOULDERS (MOD.) OR AS DIRECTED BY THE RESIDENT ENGINEER. AN ESTIMATED QUANTITY HAS BEEN INCLUDED IN THE PLANS.
  6. A FULL-DEPTH BUTT JOINT SHALL BE CONSTRUCTED AT THE BEGIN AND END PROJECT LOCATIONS AND AT ALL INTERCHANGE RAMP APPROACHES AS INDICATED ON THE PROJECT PLANS OR AS DIRECTED BY THE RESIDENT ENGINEER.

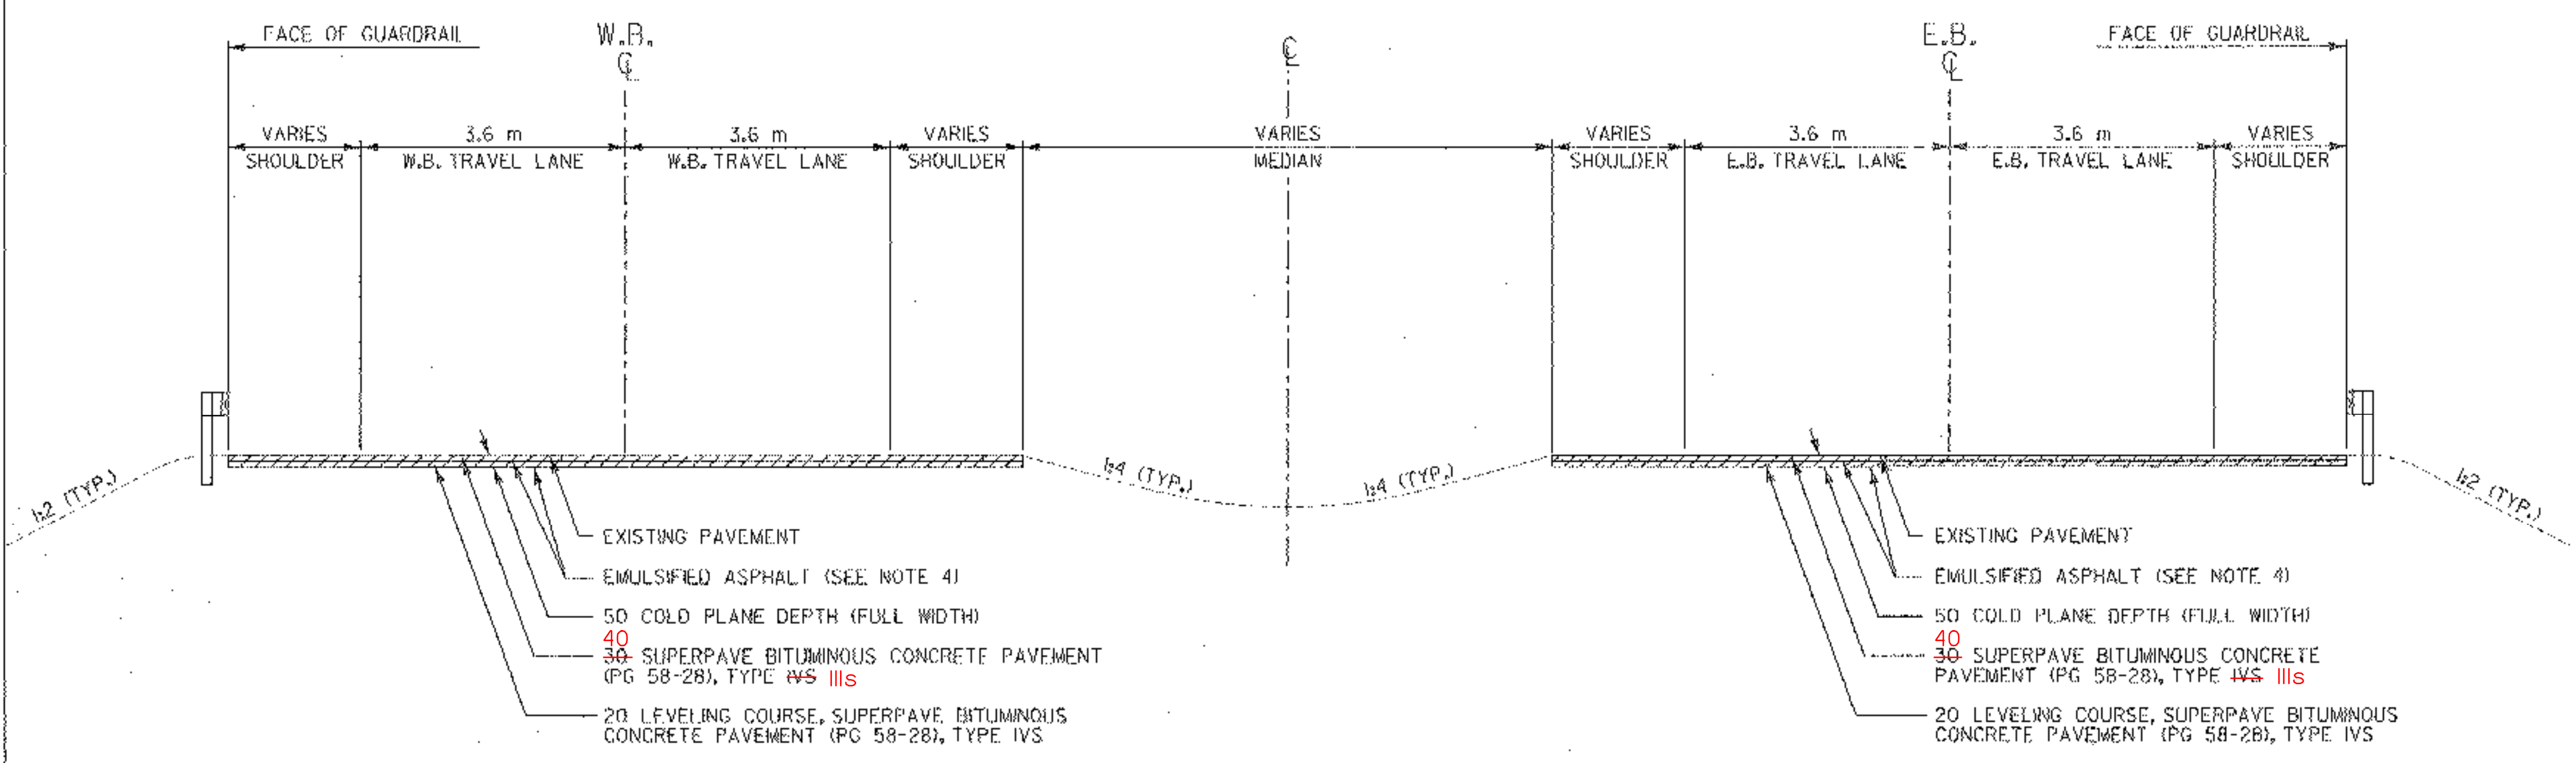

**RESURFACING DETAIL**

W.B. STA. 17+372.691 - W.B. STA. 18+000.000  
 E.B. STA. 17+366.002 - E.B. STA. 18+000.000

**CONSERVATION SEED MIX**

% MASS	kg/ha	NAME	PUR. %	GERM. %
37.14	26.0	CREeping RED FESCUE	98	85
37.14	26.0	TALL FESCUE	95	90
5.71	4.0	RED TOP	95	90
14.30	10.0	BIRDSFOOT TREFOLI	98	85
5.71	4.0	ANNUAL RYEGRASS	95	85
100.0	70.0			

SEED MIXTURE:  
 SHALL NOT HAVE A WEED CONTENT EXCEEDING 0.40% BY MASS AND SHALL BE FREE OF ALL NOXIOUS SEED.


SEED:  
 TO BE APPLIED PER SEEDING FORMULA OR AS DIRECTED BY THE RESIDENT ENGINEER.

FERTILIZER:  
 FORMULA 10-20-10 TO BE USED WITH SEED, APPLIED AT THE RATE OF 560 kg/ha (HYDRO SEEDERS MAY USE 19-19-19 FORMULA).

AGRICULTURAL LIMESTONE:  
 TO BE APPLIED AT THE RATE OF 4.5 tons/ha OR AS DIRECTED BY THE RESIDENT ENGINEER.

HAY MULCH:  
 TO BE APPLIED ON EARTH SLOPES AT THE RATE OF 4.5 tons/ha OR AS DIRECTED BY THE RESIDENT ENGINEER.

TOPSOIL:  
 TO BE USED WITH SEED AS INDICATED ON THE PLANS OR AS DIRECTED BY THE RESIDENT ENGINEER.

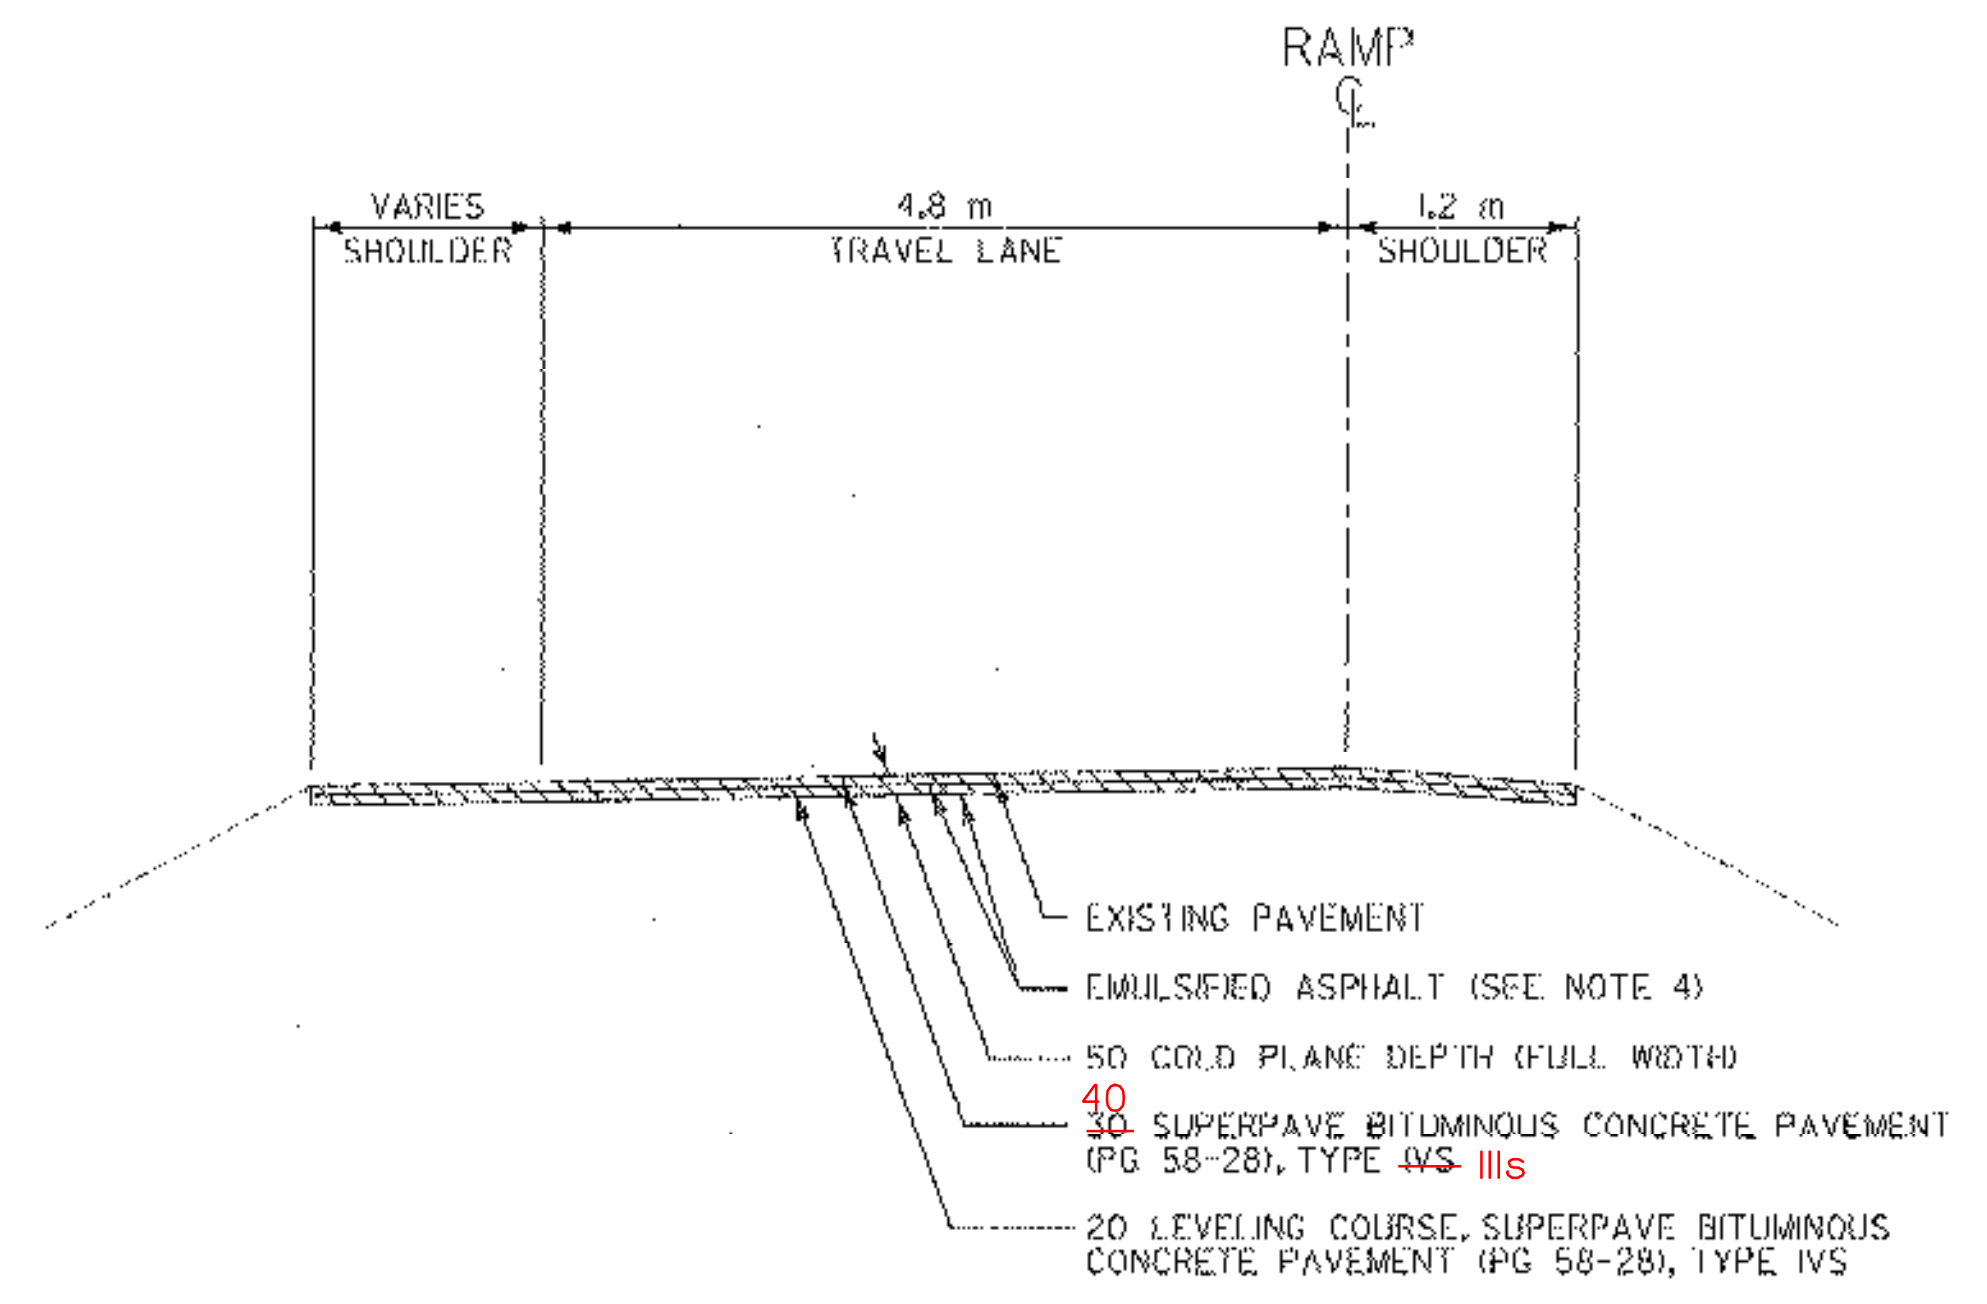

**TYPICAL SECTIONS RAMPS E & F**

(SHOWN IN DIRECTION OF TRAVEL)  
 STA. E2+070.000 - STA. E2+471.417  
 STA. F2+000.000 - STA. F2+100.000


ALL DIMENSIONS IN MILLIMETERS EXCEPT WHERE OTHERWISE INDICATED.

DESIGNED BY		DATE	
SURVEYED BY C.H.A. & V.S.E.		DATE 12/93	
DESIGNED BY D.W.E.		DATE 2/04	
DRAWN BY C.A.K.		DATE 2/04	
CHECKED BY D.E.G.		DATE 2/04	
DESIGN FILE NO. TYPOLDGN			
PROJ. NAME BENNINGTON - HOOSICK D.P.L. 0146(U) C/6			
PROJ. NO. P.L.N. 1306.60			
DWG NO. TS-1		SHEET 3 OF 83	

**TYPICAL SECTIONS**

FILE NAME: \\s1616\vaot\contract\styp01.dgn  
 DATE/TIME: 2/16/2004  
 USER: 2225

DATUM	
VERTICAL	NAVD 88
HORIZONTAL	NAD 83 (1982)

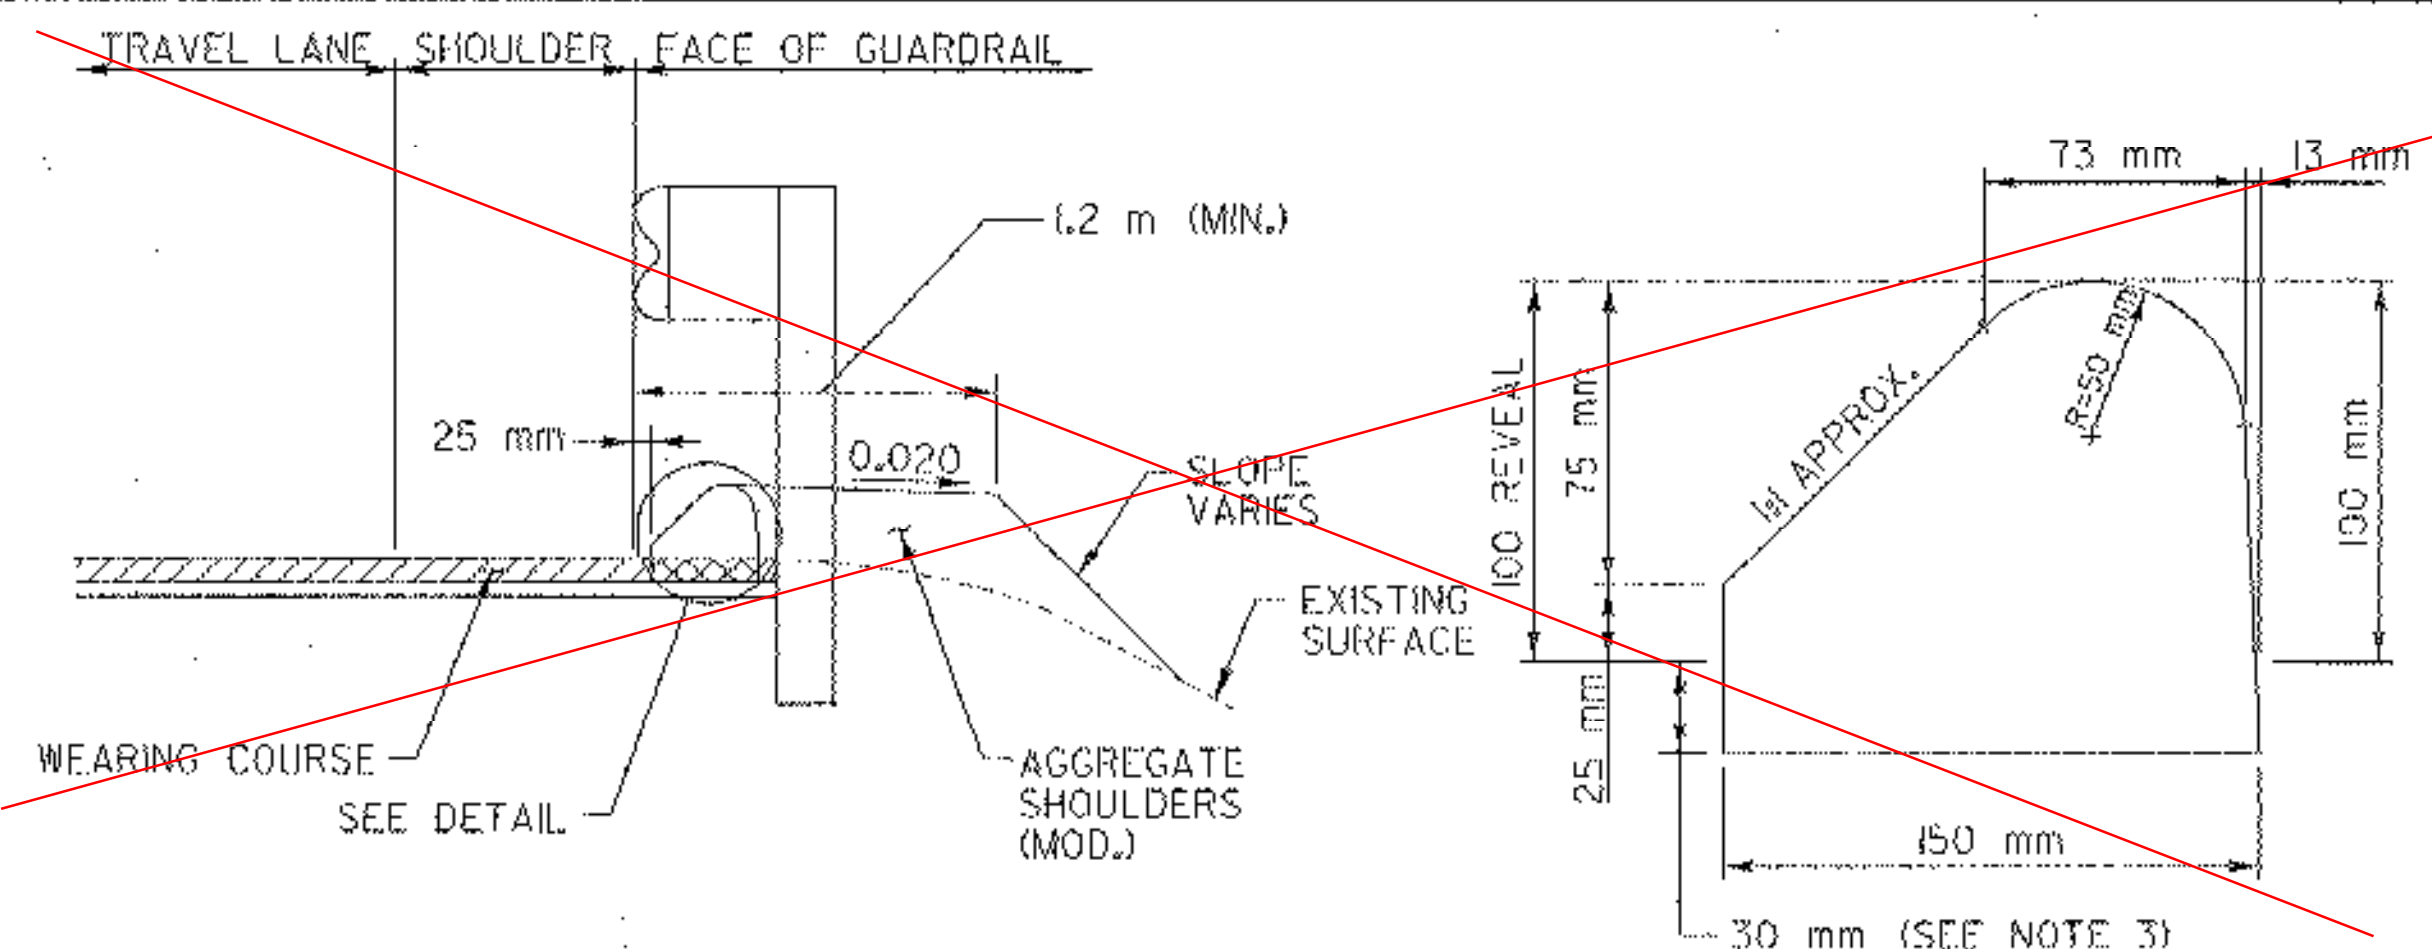


- NOTES:
1. BITUMINOUS CONCRETE CURB IS TO BE PLACED PRIOR TO THE INSTALLATION OF GUARDRAIL AND THE PLACEMENT OF THE WEARING COURSE OR AS DIRECTED BY THE RESIDENT ENGINEER.
  2. THE CROSS HATCHED AREA SHALL BE CONSIDERED SUBSIDIARY TO ITEM 616.28 BITUMINOUS CONCRETE CURB, TYPE B.
  3. MATCH 30 mm FACE TO WEARING COURSE.

**BITUMINOUS CONCRETE CURB, TYPE B DETAIL**


N.T.S.

**SUBSTITUTED TREATED TIMBER CURB**

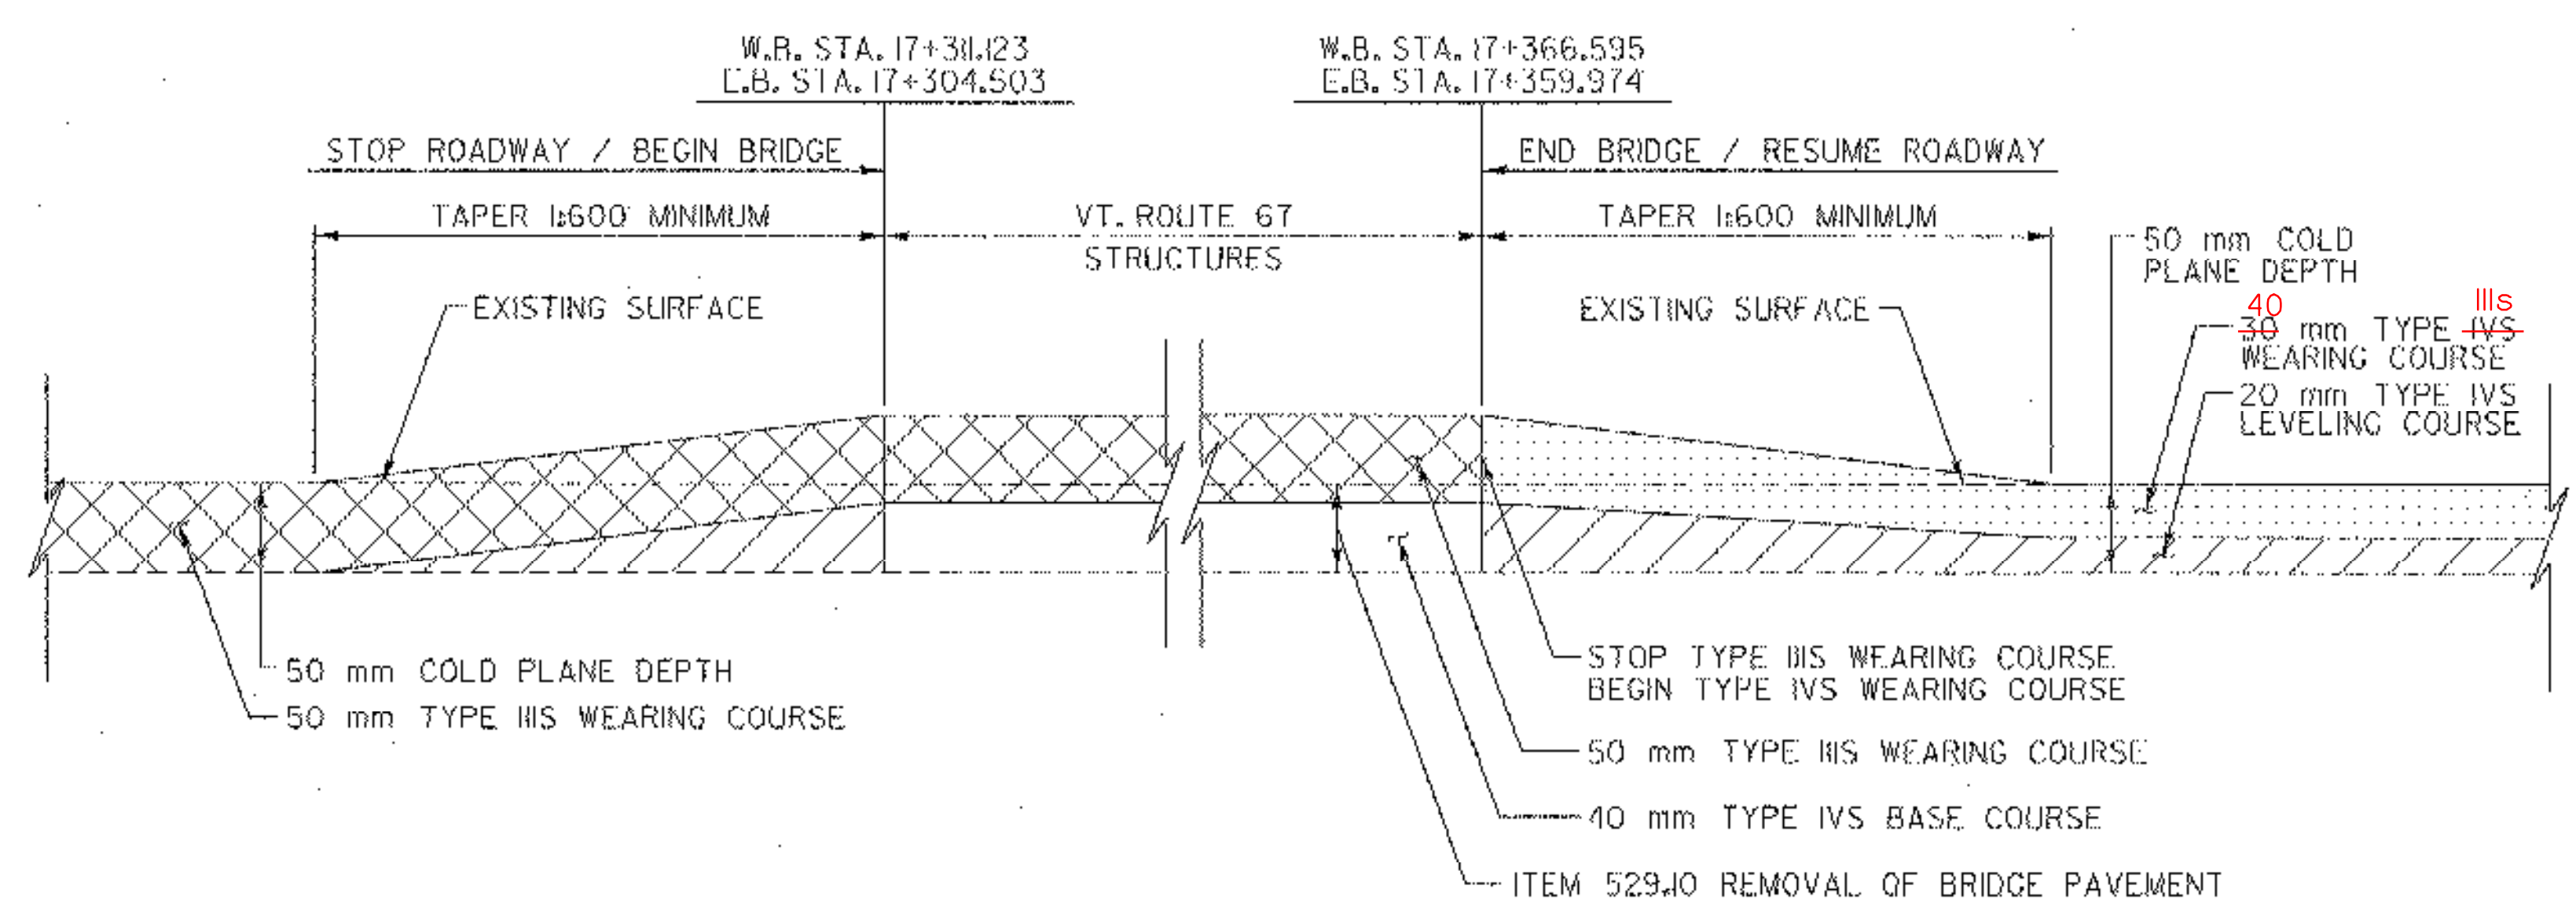


**BRIDGE APPROACH TRANSITION DETAIL VT. ROUTE 67A**

N.T.S.

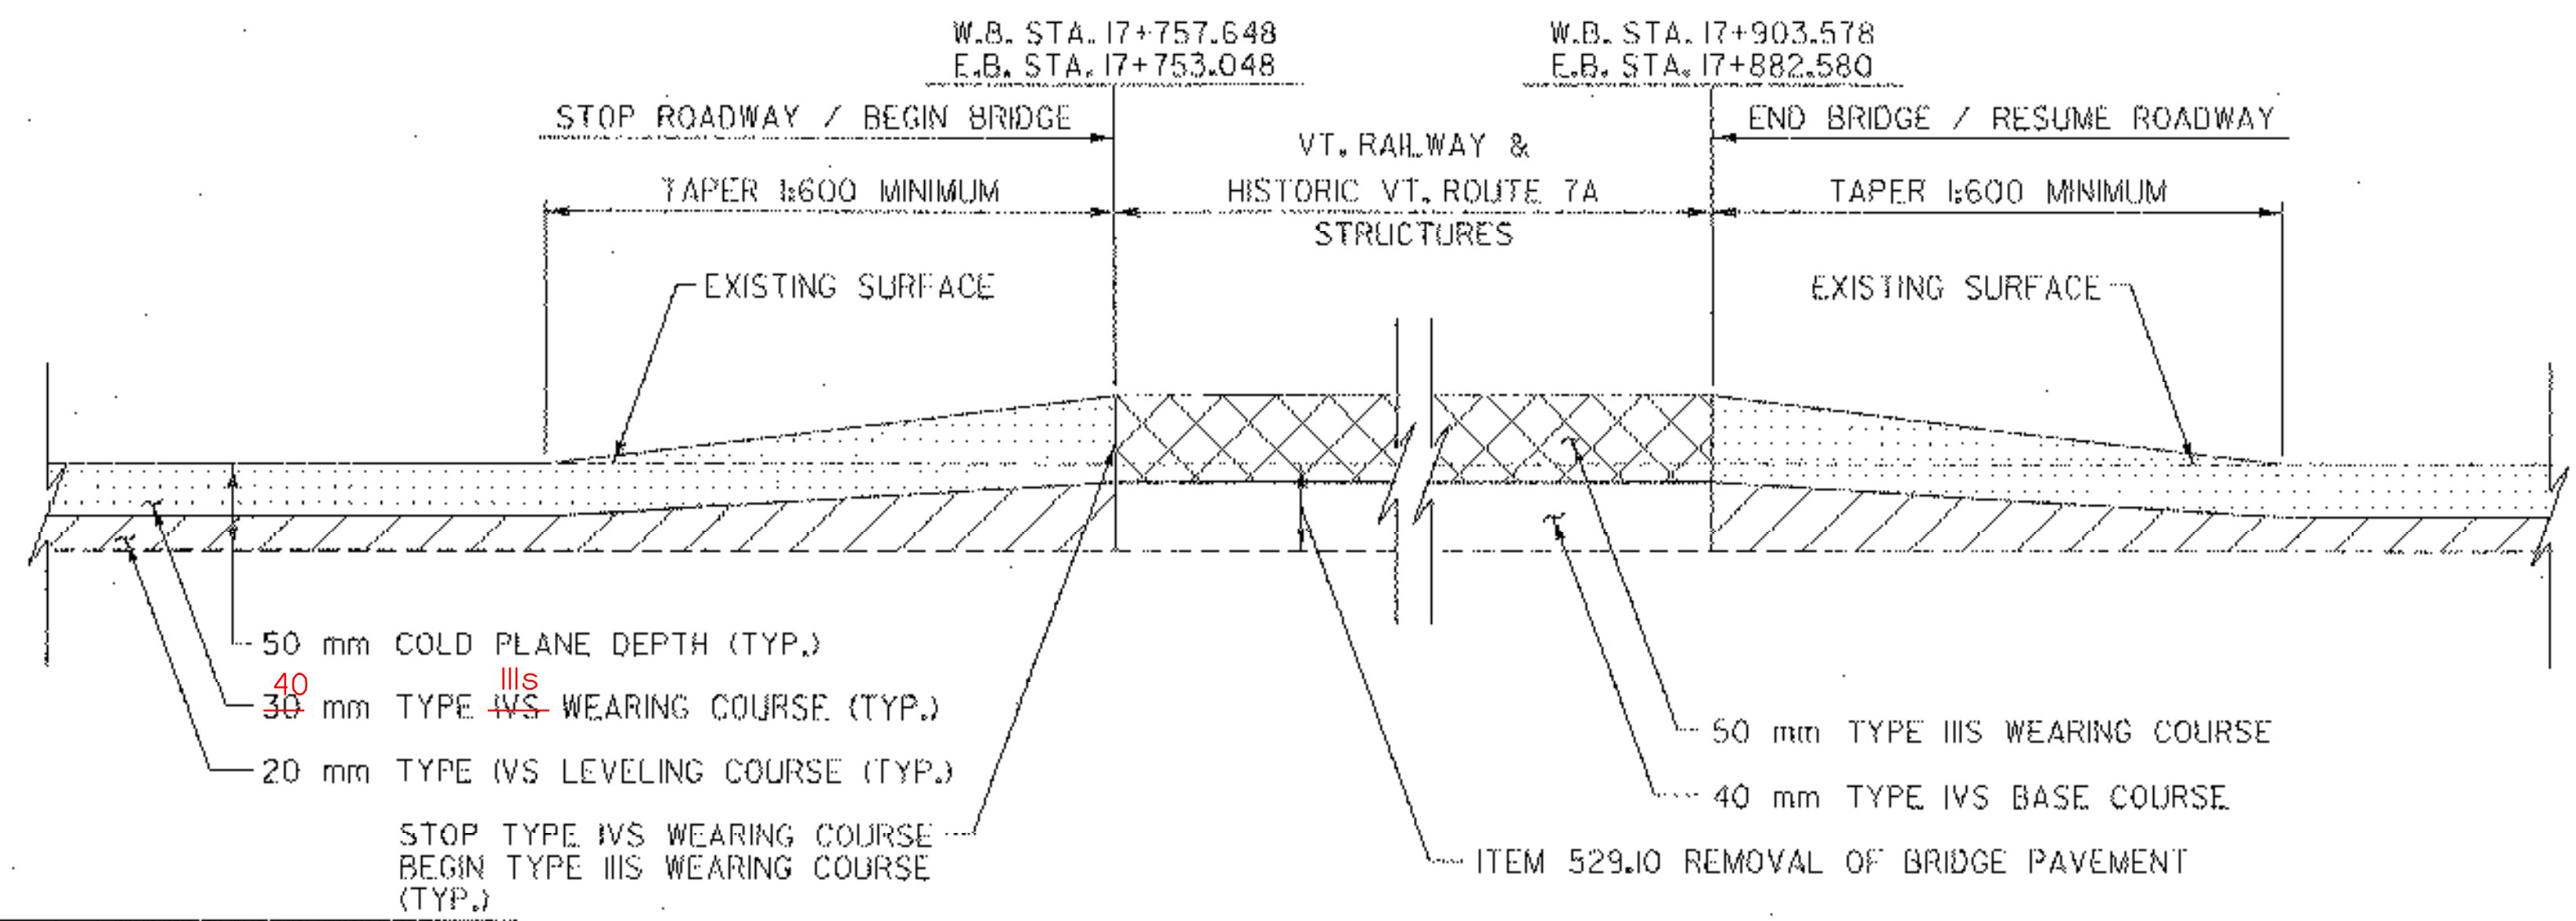


**BRIDGE APPROACH TRANSITION DETAIL VT. RAILWAY AND HISTORIC VT. ROUTE 7A**


N.T.S.

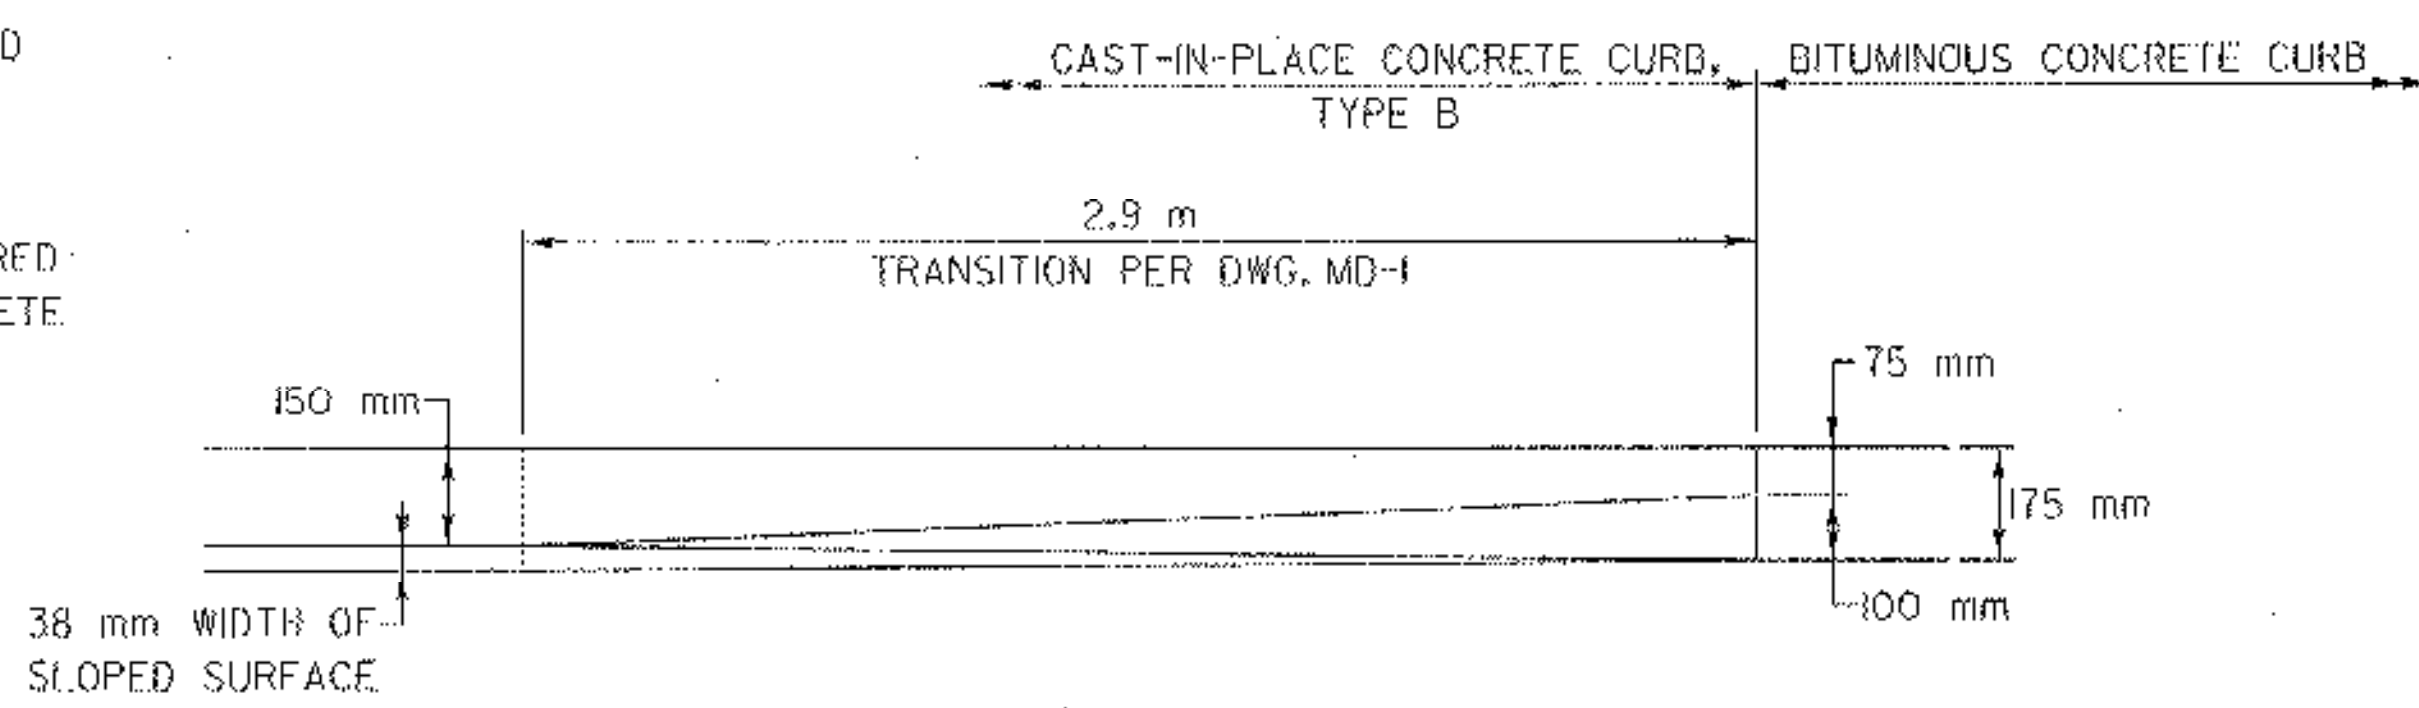

**PLAN**

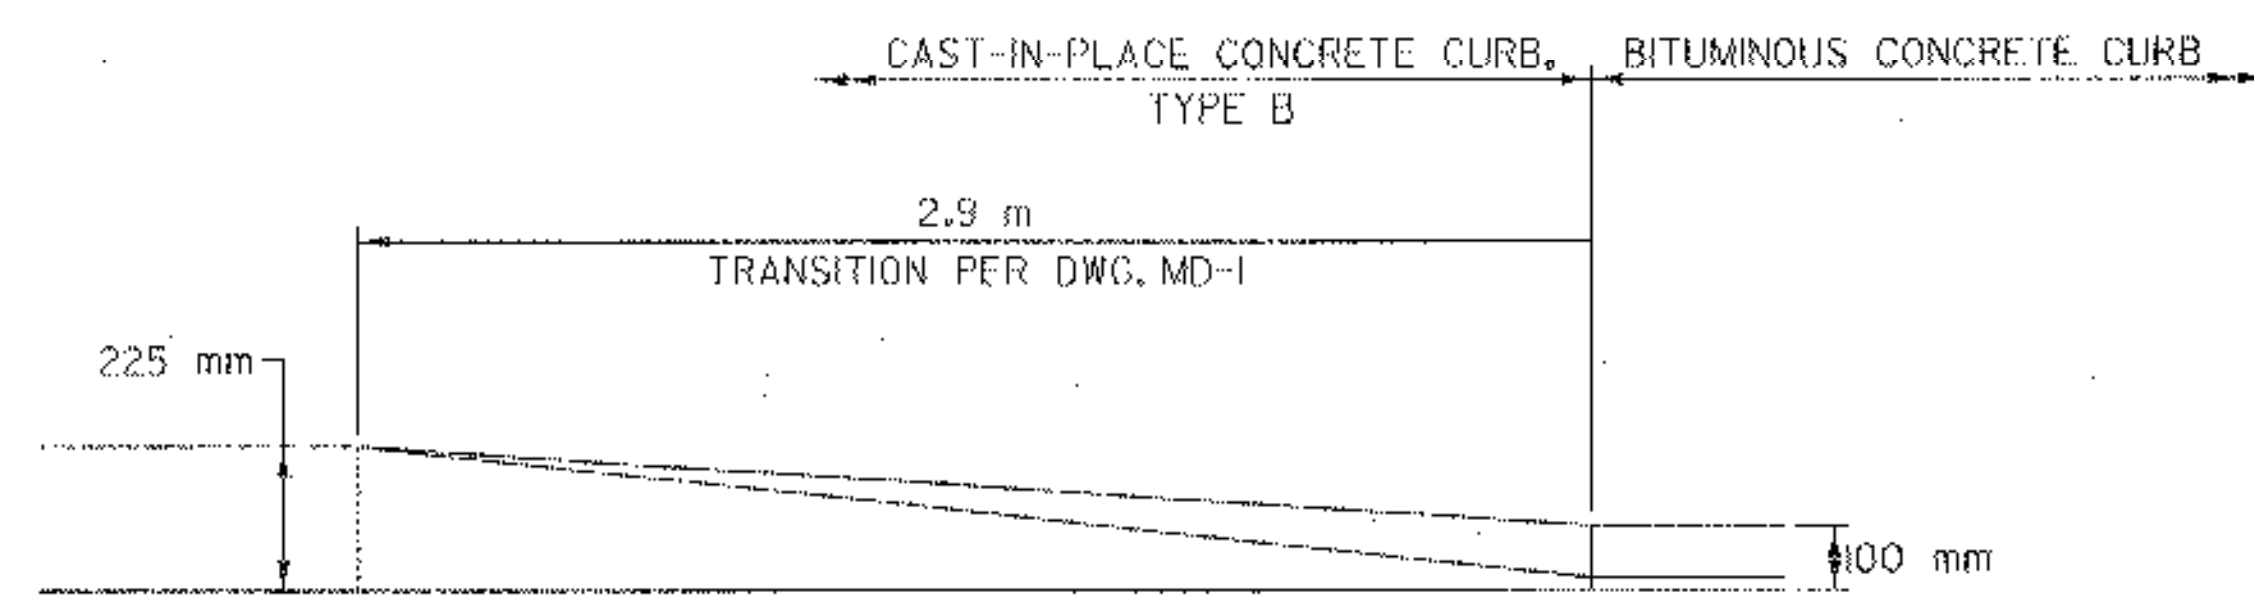

**ELEVATION**

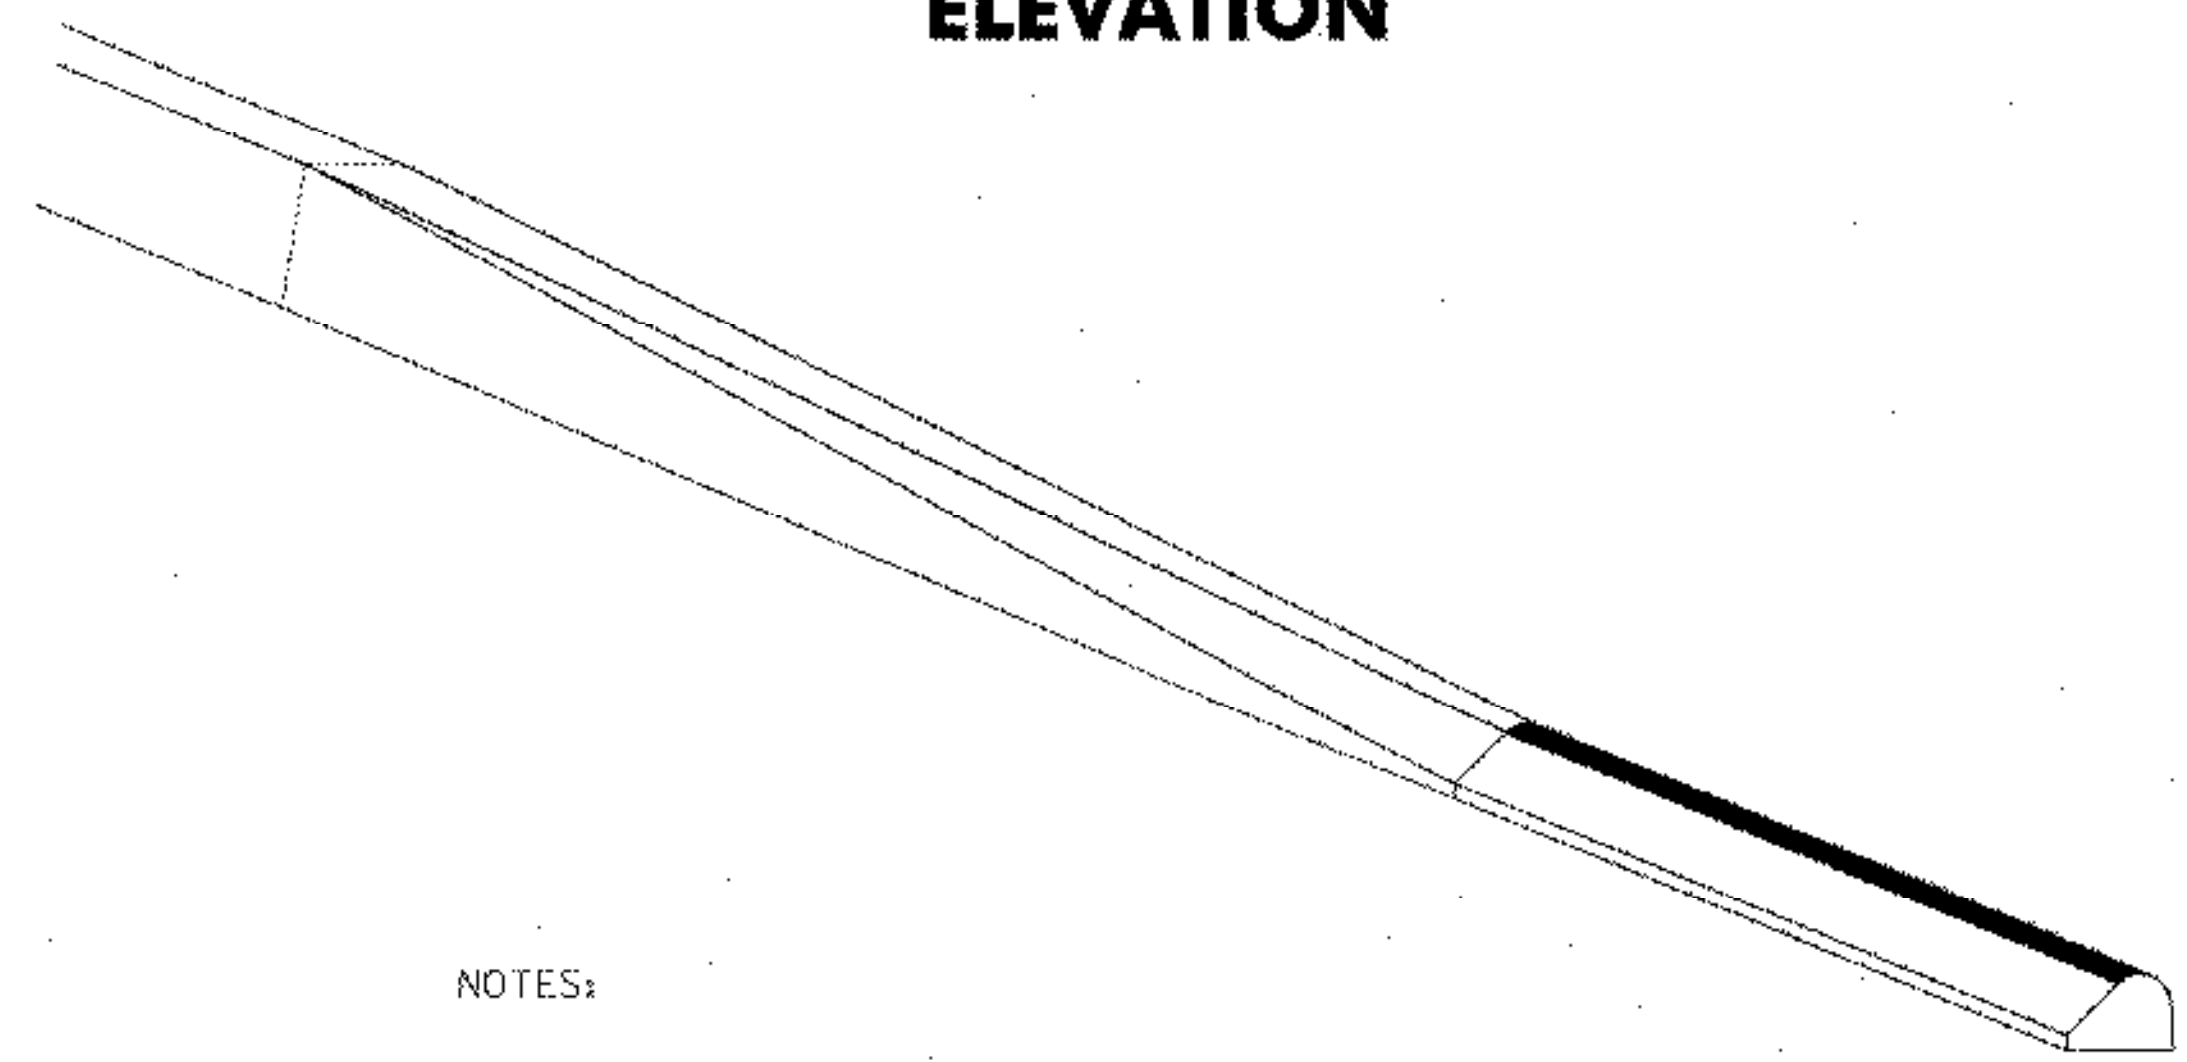

- NOTES:
1. SEE VAOT STANDARD SHEET C-111 AND THE BITUMINOUS CONCRETE CURB, TYPE B DETAIL ON THIS SHEET FOR DETAILS ON THE TWO TYPES OF CURBS.
  2. SEE DWG.'S MD-1 & MD-2 FOR BRIDGE APPROACH CURB DETAILS.



**TREATED TIMBER CONCRETE CURB TO BITUMINOUS CURB TRANSITION DETAIL**

N.T.S.

FILE NAME = u:\1115\vaot\contrans6\std\_01.dgn  
DATE/TIME = 2/16/2004  
USER = 2225


DATUM	
VERTICAL	NAVD 88
HORIZONTAL	NAD 83 (1992)

<b>PAVING DETAILS SHEET</b>	SURVEYED BY	C.H.A. & V.S.E.	DATE	12/93
	DESIGNED BY	D.W.E.	DATE	2/04
	DRAWN BY	C.A.K.	DATE	2/04
	CHECKED BY	D.F.G.	DATE	2/04
DESIGN FILE NO. PTD_01DGN				
PROJ. NAME BENNINGTON - HOOSICK D.P.L. 0146(1) C/6				
PROJ. NO. P.L.N. 1306.60				
DWG NO. PDT-1 SHEET 4 OF 83				

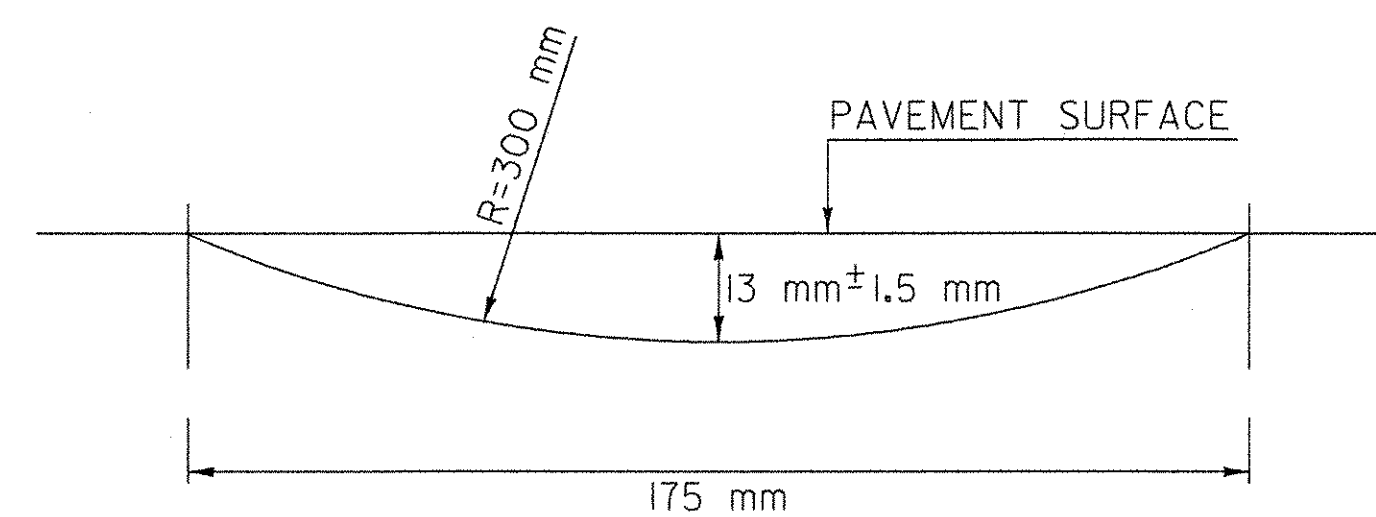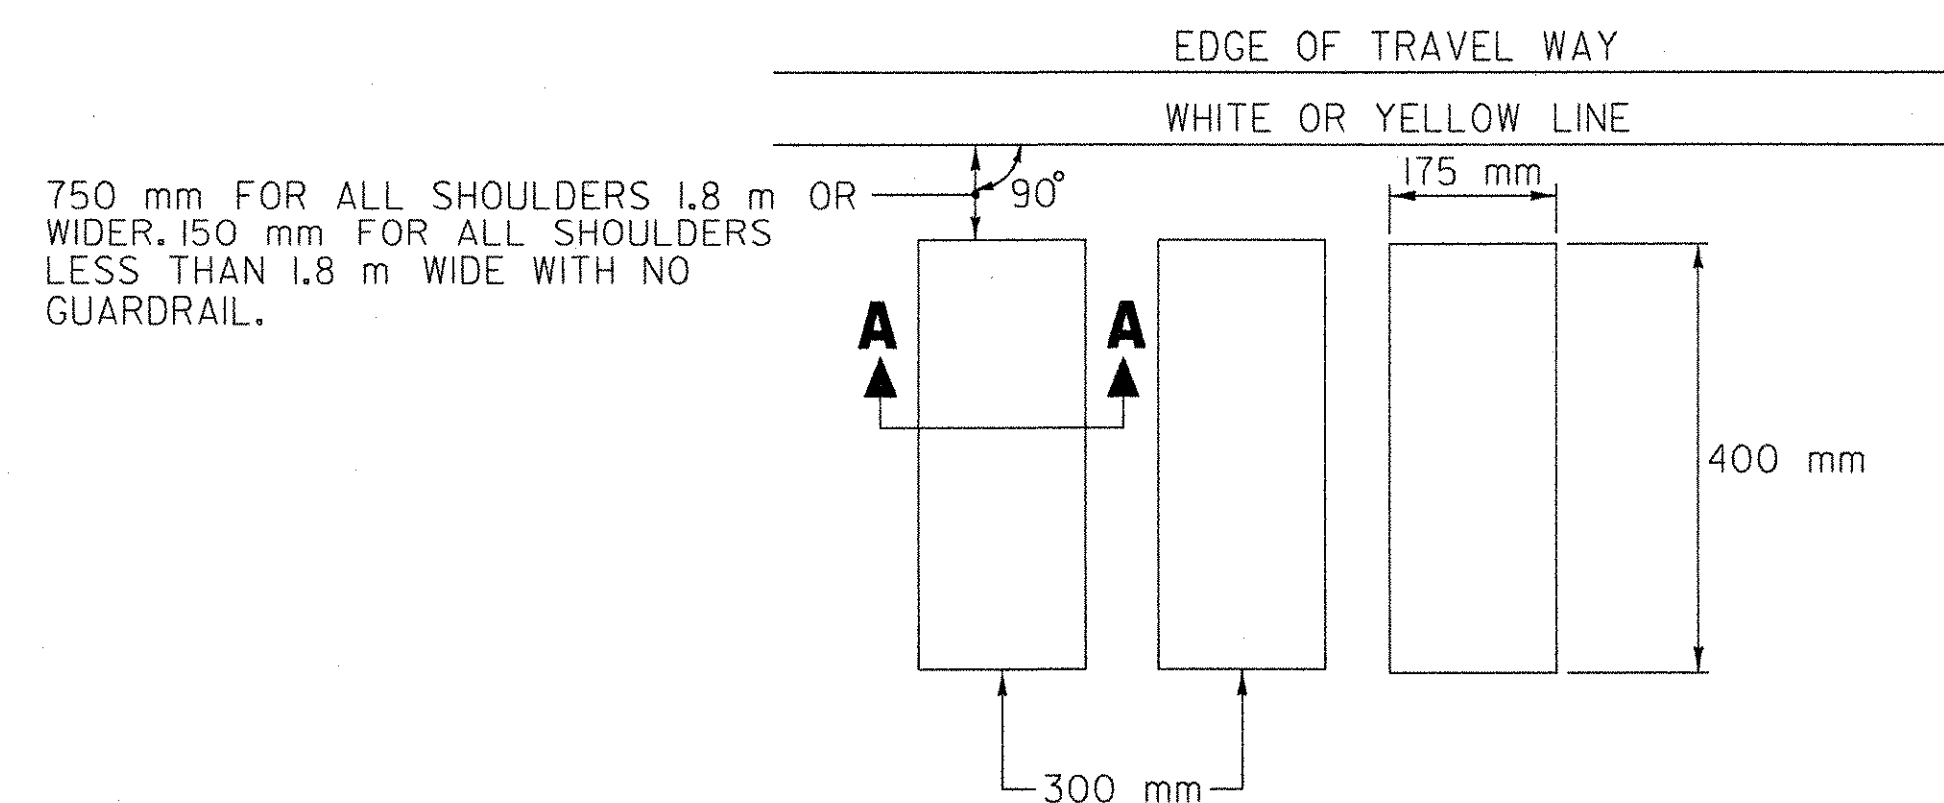

**SECTION A-A**

**TYPICAL MILLING DETAIL**

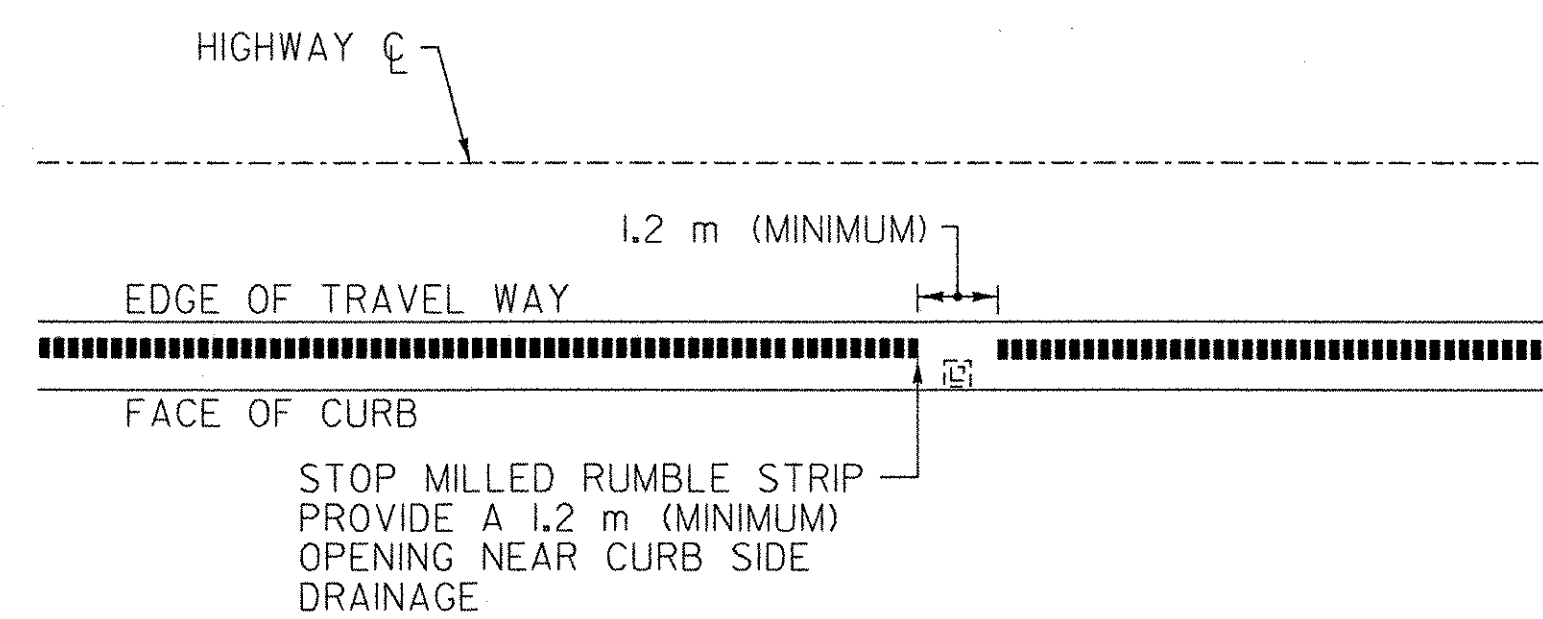

**DRAINAGE DETAIL**

**MILLED RUMBLE STRIP DETAIL**  
N.T.S.

**LEGEND**

■■■■■■ MILLED RUMBLE STRIPS

DATUM	
VERTICAL	NAVD 88
HORIZONTAL	NAD 83 (1992)

**NOTE:**

1. MILLED RUMBLE STRIPS WILL NOT BE REQUIRED IN GUARDRAIL AREAS ADJACENT TO THE 1.2 m SHOULDER.

**PAVING DETAILS SHEET**

SURVEYED BY	C.H.A. & V.S.E.	DATE	12/93
DESIGNED BY	D.W.E.	DATE	2/04
DRAWN BY	C.A.K.	DATE	2/04
CHECKED BY	D.E.G.	DATE	2/04
DESIGN FILE NO.	PTD_02.dgn		
PROJ. NAME	BENNINGTON - HOOSICK D.P.I. 0146(1) C/6		
PROJ. NO.	P.I.N. 1306.60		
DWG NO.	PDT-2	SHEET	5 OF 83









# ITEM DETAIL SUMMARY SHEET



LOCATION			MISCELLANEOUS				GUARDRAIL					REMARKS	
STATION	STATION	POS.	613.10 STONE FILL, TYPE I m <sup>3</sup>	616.28 CAST-IN-PLACE CONC. CURB, TYPE B m	616.31 BITUMINOUS CONC. CURB, TYPE B t	649.31 GEOTEXTILE UNDER STONE FILL m <sup>2</sup>	621.20 STEEL BEAM G.R. m	621.505 MANUFACT. TERM. SECT. (FLARED) EA	621.52 TRAILING END TERMINAL EA	621.72 G.R. APPR. NETC 2 RAIL (MOD.) EA	621.75 REMOVE & RESET G.R. m		621.80 REMOVE & DISP. G.R. m
VT. ROUTE 279 WESTBOUND:													
17+366.9	17+751.6	LT		19.8	15.0		365.8			2		384.7	INSTALL NEW APPROACH SECTIONS, NETC 2 RAIL (MOD.) FROM STA. 17+366.9 TO STA. 17+375.9 AND FROM STA. 17+742.6 TO STA. 17+751.6. INSTALL BITUMINOUS CONCRETE CURB, TYPE B FROM STA. 17+376.8 TO STA. 17+741.7.
17+372.7	17+491.9	RT	0.9	12.2		4.5	110.2	1		1		59.9	INSTALL NEW APPROACH SECTION NETC 2 RAIL (MOD.) FROM STA. 17+372.7 TO STA. 17+381.7. INSTALL NEW MANUFACTURED TERMINAL SECTION (FLARED) AT STA. 17+491.1. CONSTRUCT STONE PAD AT STA. 17+386.1.
17+744.7	17+757.8	RT	0.9	12.2		4.5			1	1		34.0	INSTALL NEW TRAILING END TERMINAL AT STA. 17+748.8. INSTALL NEW APPROACH SECTION, NETC 2 RAIL (MOD.) FROM STA. 17+748.8 TO STA. 17+757.8. CONSTRUCT STONE PAD AT STA. 17+745.0.
17+905.4	18+032.2	RT	0.9	12.2		4.5	117.8	1		1		58.0	INSTALL NEW APPROACH SECTION, NETC 2 RAIL (MOD.) FROM STA. 17+905.4 TO STA. 17+914.4. INSTALL NEW MANUFACTURED TERMINAL SECTION (FLARED) AT STA. 18+032.2. CONSTRUCT STONE PAD AT STA. 17+918.2.
17+906.9	17+941.6	LT		9.9	1.0		25.7			1		34.7	INSTALL NEW APPROACH SECTION, NETC 2 RAIL (MOD.) FROM STA. 17+906.9 TO STA. 17+915.9. INSTALL BITUMINOUS CONCRETE CURB, TYPE B FROM STA. 17+916.8 TO STA. 17+941.6.
VT. ROUTE 279 EASTBOUND:													
17+360.8	17+373.9	LT	0.9	12.2		4.5			1	1		31.5	INSTALL NEW APPROACH SECTION, NETC 2 RAIL (MOD.) FROM STA. 17+360.8 TO STA. 17+369.8. INSTALL NEW TRAILING END TERMINAL AT STA. 17+369.8. CONSTRUCT STONE PAD AT STA. 17+374.2.
17+367.1	17+753.5	RT		19.8	15.0		368.4			2		386.4	INSTALL NEW APPROACH SECTIONS, NETC 2 RAIL (MOD.) FROM STA. 17+367.1 TO STA. 17+376.1 AND FROM STA. 17+744.5 TO STA. 17+753.5. INSTALL BITUMINOUS CONCRETE CURB, TYPE B FROM STA. 17+377.0 TO STA. 17+743.6.
17+631.8	17+747.2	LT	0.9	12.2		4.5	106.4	1		1		63.5	INSTALL NEW MANUFACTURED TERMINAL SECTION (FLARED) AT STA. 17+631.8. INSTALL NEW APPROACH SECTION, NETC 2 RAIL (MOD.) FROM STA. 17+738.2 TO STA. 17+747.2. CONSTRUCT STONE PAD AT STA. 17+734.4.
17+886.6	17+899.7	LT	0.9	12.2		4.5			1	1		24.6	INSTALL NEW APPROACH SECTION, NETC 2 RAIL (MOD.) FROM STA. 17+886.6 TO STA. 17+895.6. INSTALL NEW TRAILING END TERMINAL AT STA. 17+895.6. CONSTRUCT STONE PAD AT STA. 17+899.4.
17+885.1	17+911.2	RT		9.9	0.7		17.1			1		26.1	INSTALL NEW APPROACH SECTION, NETC 2 RAIL (MOD.) FROM STA. 17+885.1 TO STA. 17+894.1. INSTALL BITUMINOUS CONCRETE CURB, TYPE B FROM STA. 17+895.0 TO STA. 17+911.2.
RAMPS:													
BIO+059.5	BIO+155.9	LT	0.9	12.2		4.5	87.4	1		1		31.1	INSTALL NEW APPROACH SECTION, NETC 2 RAIL (MOD.) FROM STA. BIO+059.5 TO STA. BIO+068.5. INSTALL NEW MANUFACTURED TERMINAL SECTION (FLARED) AT STA. BIO+155.9. CONSTRUCT STONE PAD AT STA. BIO+072.3.
BIO+065.1	BIO+161.8	RT		9.9	3.1		83.6		1	1		54.3	INSTALL NEW APPROACH SECTION, NETC 2 RAIL (MOD.) FROM STA. BIO+065.1 TO STA. BIO+074.1. INSTALL NEW TRAILING END TERMINAL AT STA. BIO+157.7. INSTALL BITUMINOUS CONCRETE CURB, TYPE B FROM STA. BIO+075.0 TO STA. BIO+150.0.
DIO+177.3	DIO+243.3	RT		9.9	1.2		57.0	1		1		48.8	INSTALL NEW MANUFACTURED TERMINAL SECTION (FLARED) AT STA. DIO+177.3. INSTALL NEW APPROACH SECTION, NETC 2 RAIL (MOD.) FROM STA. DIO+234.3 TO DIO+243.3. INSTALL BITUMINOUS CONCRETE CURB, TYPE B FROM STA. DIO+203.4 TO STA. DIO+233.4.
DIO+228.3	DIO+237.3	LT	0.9	12.2		4.5				1		9.0	INSTALL NEW APPROACH SECTION, NETC 2 RAIL (MOD.) FROM STA. DIO+228.3 TO STA. DIO+237.3. CONSTRUCT STONE PAD AT STA. DIO+224.5.
XIO+229.0	XIO+331.6	LT					102.6	1				50.5	INSTALL NEW MANUFACTURED TERMINAL SECTION (FLARED) AT STA. XIO+229.0.
E2+113.3	E2+471.4	RT			12.9		358.1	1				362.4	INSTALL NEW MANUFACTURED TERMINAL SECTION (FLARED) AT STA. E2+113.3. INSTALL BITUMINOUS CONCRETE CURB, TYPE B FROM STA. E2+156.2 TO STA. E2+471.4.
E2+160.0	E2+384.5	LT					220.4	1	1			233.0	INSTALL NEW MANUFACTURED TERMINAL SECTION (FLARED) AT STA. E2+160.0. INSTALL NEW TRAILING END TERMINAL AT STA. E2+380.4.
F2+000.0	F2+040.2	RT			1.4		36.1		1			35.1	INSTALL NEW TRAILING END TERMINAL AT STA. F2+036.1. INSTALL BITUMINOUS CONCRETE CURB, TYPE B FROM STA. F2+000.0 TO STA. F2+033.8.
SHEET SUBTOTAL			7.2	176.8	50.3	36.0	2056.6	8	6	16		1927.6	
ROUNDING			0.8	3.2	0.7	4.0	-	-	-	-		-	
TOTAL			8.0	180	51	40.0	2056.6	8	6	16		1927.6	

DATUM  
 VERTICAL NAVD 88  
 HORIZONTAL NAD 83 (1992)

### ITEM DETAIL SHEET 1

SURVEYED BY C.H.A. & V.S.E. DATE 12/93  
 DESIGNED BY D.W.E. DATE 2/04  
 DRAWN BY C.A.K. DATE 2/04  
 CHECKED BY D.E.G. DATE 2/04  
 DESIGN FILE NO. DSS.DGN  
 PROJ. NAME BENNINGTON - HOOSICK D.P.I. 0146(1) C/6  
 PROJ. NO. P.I.N. 1306.60  
 DWG NO. DS-1 SHEET 10 OF 83

FILE NAME = ur:\5116\svoot\contract6\ds.dgn  
 DATE/TIME = 5/16/2004  
 USER = 2225

# ITEM DETAIL SUMMARY SHEET



LOCATION			MISCELLANEOUS			REMARKS
STATION	STATION	POSITION	213.10	619.17	676.10	
			MILLED RUMBLE STRIPS m	YIELDING MARKER POSTS EA	DELINEATORS W/STEEL POSTS EA	
VT. ROUTE 279						
D.P.I. 0146(1) C/3 SECTION:						
12+130.5	12+210.0	RT	79.5			SEE DWG. PDT-2 FOR MILLED RUMBLE STRIP DETAILS.
12+130.5	12+230.0	LT	99.5			SEE DWG. PDT-2 FOR MILLED RUMBLE STRIP DETAILS.
12+210.8		LT & RT			2	INSTALL NEW WHITE TYPE IDELINEATORS.
12+291.3		LT & RT			2	INSTALL NEW WHITE TYPE IDELINEATORS.
12+371.8		LT & RT			2	INSTALL NEW WHITE TYPE IDELINEATORS.
12+430.0	12+470.0	RT	40.0			SEE DWG. PDT-2 FOR MILLED RUMBLE STRIP DETAILS.
12+450.0	14+113.2	LT	1663.2			SEE DWG. PDT-2 FOR MILLED RUMBLE STRIP DETAILS.
12+452.3		LT			1	INSTALL NEW WHITE TYPE IDELINEATOR.
12+532.7		LT			1	INSTALL NEW WHITE TYPE IDELINEATOR.
12+613.2		LT			1	INSTALL NEW WHITE TYPE IDELINEATOR.
12+693.7		LT			1	INSTALL NEW WHITE TYPE IDELINEATOR.
12+740.0	13+540.0	RT	800.0			SEE DWG. PDT-2 FOR MILLED RUMBLE STRIP DETAILS.
12+774.2		LT & RT			2	INSTALL NEW WHITE TYPE IDELINEATORS.
12+854.6		LT & RT			2	INSTALL NEW WHITE TYPE IDELINEATORS.
12+935.1		LT & RT			2	INSTALL NEW WHITE TYPE IDELINEATORS.
13+015.6		LT & RT			2	INSTALL NEW WHITE TYPE IDELINEATORS.
13+096.1		LT & RT			2	INSTALL NEW WHITE TYPE IDELINEATORS.
13+176.4		LT & RT			2	INSTALL NEW WHITE TYPE IDELINEATORS.
13+256.9		LT & RT			2	INSTALL NEW WHITE TYPE IDELINEATORS.
13+337.4		LT & RT			2	INSTALL NEW WHITE TYPE IDELINEATORS.
13+417.9		LT & RT			2	INSTALL NEW WHITE TYPE IDELINEATORS.
13+498.3		LT & RT			2	INSTALL NEW WHITE TYPE IDELINEATORS.
13+578.8		LT			1	INSTALL NEW WHITE TYPE IDELINEATOR.
13+659.3		LT			1	INSTALL NEW WHITE TYPE IDELINEATOR.
13+739.8		LT			1	INSTALL NEW WHITE TYPE IDELINEATOR.
13+820.0	14+113.2	RT	293.2			SEE DWG. PDT-2 FOR MILLED RUMBLE STRIP DETAILS.
13+820.2		LT			1	INSTALL NEW WHITE TYPE IDELINEATOR.
13+900.7		LT & RT			2	INSTALL NEW WHITE TYPE IDELINEATORS.
13+981.2		LT & RT			2	INSTALL NEW WHITE TYPE IDELINEATORS.
14+061.7		LT & RT			2	INSTALL NEW WHITE TYPE IDELINEATORS.
14+142.0		LT & RT			2	INSTALL NEW WHITE TYPE IDELINEATORS.
SHEET SUBTOTAL			2975.4	-	42	

FILE NAME = u:\5116\vaot\contract6\dss.dgn  
 DATE/TIME = 2/16/2004  
 USER = 2225

DATUM	
VERTICAL	NAVD 88
HORIZONTAL	NAD 83 (1992)

ITEM  
DETAIL  
SHEET 2

SURVEYED BY	C.H.A. & V.S.E.	DATE	12/93
DESIGNED BY	D.W.E.	DATE	2/04
DRAWN BY	C.A.K.	DATE	2/04
CHECKED BY	D.E.G.	DATE	2/04
DESIGN FILE NO. DSS.DGN			
PROJ. NAME BENNINGTON - HOOSICK D.P.I. 0146(1) C/6			
PROJ. NO. P.I.N. 1306.60			
DWG NO. DS-2		SHEET 11 OF 83	



# ITEM DETAIL SUMMARY SHEET



LOCATION			MISCELLANEOUS			REMARKS
STATION	STATION	POSITION	213.10	619.17	676.10	
			MILLED RUMBLE STRIPS m	YIELDING MARKER POSTS EA	DELINEATORS W/STEEL POSTS EA	
VT. ROUTE 279						
D.P.I. 0146(II) C/3 SECTION CONT.:						
16+234.3		LT & RT			2	INSTALL NEW WHITE TYPE IDELINEATORS.
16+314.8		LT & RT			2	INSTALL NEW WHITE TYPE IDELINEATORS.
16+395.3		RT			1	INSTALL NEW WHITE TYPE IDELINEATOR.
16+475.8		RT			1	INSTALL NEW WHITE TYPE IDELINEATOR.
16+556.3		RT			1	INSTALL NEW WHITE TYPE IDELINEATOR.
16+636.6		RT			1	INSTALL NEW WHITE TYPE IDELINEATOR.
D.P.I. 0146(II) C/6 SECTION						
VT. ROUTE 279						
WESTBOUND						
17+377.8	17+740.7	LT	362.9			SEE DWG. PDT-2 FOR MILLED RUMBLE STRIP DETAILS.
17+383.6	17+580.9	RT	197.3			SEE DWG. PDT-2 FOR MILLED RUMBLE STRIP DETAILS.
17+392.6		RT		1		INSTALL NEW MARKER POST NEAR EXISTING DI.
17+441.3		LT & RT			2	INSTALL NEW WHITE TYPE IDELINEATOR ON LT AND INSTALL NEW AMBER TYPE IDELINEATOR ON RT.
17+493.9		RT				INSTALL NEW MARKER POST NEAR EXISTING DI.
17+521.8		LT & RT			2	INSTALL NEW WHITE TYPE IDELINEATOR ON LT AND INSTALL NEW AMBER TYPE IDELINEATOR ON RT.
17+602.3		LT & RT		1	2	INSTALL NEW WHITE TYPE IDELINEATOR ON LT AND INSTALL NEW AMBER TYPE IDELINEATOR ON RT.
17+617.9		RT		1		INSTALL NEW MARKER POST NEAR EXISTING DI.
17+633.8	17+746.9	RT	113.1			SEE DWG. PDT-2 FOR MILLED RUMBLE STRIP DETAILS.
17+682.3		LT & RT			2	INSTALL NEW WHITE TYPE IDELINEATOR ON LT AND INSTALL NEW AMBER TYPE IDELINEATOR ON RT.
17+746.2		RT		1		INSTALL NEW MARKER POST NEAR EXISTING DI.
17+763.3		LT & RT			2	INSTALL NEW WHITE TYPE IDELINEATOR ON LT AND INSTALL NEW AMBER TYPE IDELINEATOR ON RT.
17+900.0		LT			1	INSTALL NEW WHITE TYPE IDELINEATOR ON LT.
17+912.3		RT		1		INSTALL NEW MARKER POST NEAR EXISTING DI.
17+916.3	18+000.0	RT	83.7			SEE DWG. PDT-2 FOR MILLED RUMBLE STRIP DETAILS.
17+930.0		LT & RT			2	INSTALL NEW WHITE TYPE IDELINEATOR ON LT AND INSTALL NEW AMBER TYPE IDELINEATOR ON RT..
17+980.0	18+000.0	LT	20			SEE DWG. PDT-2 FOR MILLED RUMBLE STRIP DETAILS.
SHEET SUBTOTAL			777.0	5	21	

FILE NAME = ur:\5116\vgot\contract\ds.dgn  
 DATE/TIME = 2/16/2004  
 USER = 2225

DATUM  
 VERTICAL      NAVD 88  
 HORIZONTAL    NAD 83 (1992)

ITEM  
DETAIL  
SHEET 4

SURVEYED BY	C.H.A. & V.S.E.	DATE	12/93
DESIGNED BY	D.W.E.	DATE	2/04
DRAWN BY	C.A.K.	DATE	2/04
CHECKED BY	D.E.G.	DATE	2/04
DESIGN FILE NO.	DSS.DGN		
PROJ. NAME	BENNINGTON - HOOSICK D.P.I. 0146(II) C/6		
PROJ. NO.	P.I.N. 1306.60		
DWG NO.	DS-4	SHEET	13 OF 83

# ITEM DETAIL SUMMARY SHEET



LOCATION			MISCELLANEOUS			REMARKS
STATION	STATION	POSITION	213.10	619.17	676.10	
			MILLED RUMBLE STRIPS m	YIELDING MARKER POSTS EA	DELINEATORS W/STEEL POSTS EA	
D.P.I. 0146(I) C/3 SECTION CONT.						
VT. ROUTE 279						
EASTBOUND:						
17+371.7	17+563.1	LT	191.4			SEE DWG. PDT-2 FOR MILLED RUMBLE STRIP DETAILS.
17+378.0	17+742.6	RT	364.6			SEE DWG. PDT-2 FOR MILLED RUMBLE STRIP DETAILS.
17+441.3		LT & RT			2	INSTALL NEW WHITE TYPE IDELINEATOR ON RT AND INSTALL NEW AMBER TYPE IDELINEATOR ON LT.
17+521.8		LT & RT			2	INSTALL NEW WHITE TYPE IDELINEATOR ON RT AND INSTALL NEW AMBER TYPE IDELINEATOR ON LT.
17+602.3		LT & RT			2	INSTALL NEW WHITE TYPE IDELINEATOR ON RT AND INSTALL NEW AMBER TYPE IDELINEATOR ON LT.
17+616.1	17+736.3	LT	120.2			SEE DWG. PDT-2 FOR MILLED RUMBLE STRIP DETAILS.
17+682.3		LT & RT			2	INSTALL NEW WHITE TYPE IDELINEATOR ON RT AND INSTALL NEW AMBER TYPE IDELINEATOR ON LT.
17+763.8		LT & RT			2	INSTALL NEW WHITE TYPE IDELINEATOR ON RT AND INSTALL NEW AMBER TYPE IDELINEATOR ON LT.
17+843.8		LT & RT			2	INSTALL NEW WHITE TYPE IDELINEATOR ON RT AND INSTALL NEW AMBER TYPE IDELINEATOR ON LT.
17+860.0		RT				INSTALL NEW WHITE TYPE IDELINEATOR ON RT.
17+890.0		RT				INSTALL NEW WHITE TYPE IDELINEATOR ON RT.
17+897.5	18+000.0	LT	102.5			SEE DWG. PDT-2 FOR MILLED RUMBLE STRIP DETAILS.
17+924.3		LT			1	INSTALL NEW AMBER TYPE IDELINEATOR ON LT.
17+990.0	18+000.0	RT	10.0			SEE DWG. PDT-2 FOR MILLED RUMBLE STRIP DETAILS.
RAMPS:						
Y10+054.0	Y10+189.0	LT	135.0			SEE DWG. PDT-2 FOR MILLED RUMBLE STRIP DETAILS.
Y10+140.0	B10+070.4	RT	181.6			SEE DWG. PDT-2 FOR MILLED RUMBLE STRIP DETAILS.
X10+067.0	X10+250.0	RT	183.0			SEE DWG. PDT-2 FOR MILLED RUMBLE STRIP DETAILS.
X10+160.0	X10+329.7	LT	169.7			SEE DWG. PDT-2 FOR MILLED RUMBLE STRIP DETAILS.
B10+076.0	B10+145.0	RT	69.0			SEE DWG. PDT-2 FOR MILLED RUMBLE STRIP DETAILS.
B10+074.1		LT		1		INSTALL NEW MARKER POST NEAR EXISTING DI.
B10+139.2		LT		1		INSTALL NEW MARKER POST NEAR EXISTING DI.
D10+190.0	D10+232.4	RT	42.4			SEE DWG. PDT-2 FOR MILLED RUMBLE STRIP DETAILS.
E2+077.0		RT			1	INSTALL NEW WHITE TYPE IDELINEATOR ON RT.
E2+107.0		LT & RT			2	INSTALL NEW WHITE TYPE IDELINEATOR ON RT AND INSTALL NEW AMBER TYPE IDELINEATOR ON LT.
E2+137.0		LT & RT			2	INSTALL NEW WHITE TYPE IDELINEATOR ON RT AND INSTALL NEW AMBER TYPE IDELINEATOR ON LT.
E2+167.0		LT & RT			2	INSTALL NEW WHITE TYPE IDELINEATOR ON RT AND INSTALL NEW AMBER TYPE IDELINEATOR ON LT.
E2+197.0		LT & RT			2	INSTALL NEW WHITE TYPE IDELINEATOR ON RT AND INSTALL NEW AMBER TYPE IDELINEATOR ON LT.
E2+227.0		LT & RT			2	INSTALL NEW WHITE TYPE IDELINEATOR ON RT AND INSTALL NEW AMBER TYPE IDELINEATOR ON LT.
SHEET SUBTOTAL			1569.4	2	24	

DATUM  
 VERTICAL NAVD 88  
 HORIZONTAL NAD 83 (1992)

**ITEM  
DETAIL  
SHEET 5**

SURVEYED BY C.H.A. & V.S.E. DATE 12/93  
 DESIGNED BY D.W.E. DATE 2/04  
 DRAWN BY C.A.K. DATE 2/04  
 CHECKED BY D.E.G. DATE 2/04

DESIGN FILE NO. DSS.DGN

PROJ. NAME BENNINGTON - HOOSICK  
 D.P.I. 0146(I) C/6  
 PROJ. NO. P.I.N. 1306.60  
 DWG NO. DS-5 SHEET 14 OF 83

FILE NAME = u:\5116\voat\contract6\dss.dgn  
 DATE/TIME = 5/16/2004  
 USER = 2225

# ITEM DETAIL SUMMARY SHEET



LOCATION			MISCELLANEOUS			REMARKS
STATION	STATION	POSITION	213.10	619.17	676.10	
			MILLED RUMBLE STRIPS m	YIELDING MARKER POSTS EA	DELINEATORS W/STEEL POSTS EA	
D.P.I. 0146(I) C/3 SECTION CONT. VT. ROUTE 279						
RAMPS:						
E2+257.0		LT & RT			2	INSTALL NEW WHITE TYPE IDELINEATOR ON RT AND INSTALL NEW AMBER TYPE IDELINEATOR ON LT.
E2+277.0		LT & RT			2	INSTALL NEW WHITE TYPE IDELINEATOR ON RT AND INSTALL NEW AMBER TYPE IDELINEATOR ON LT.
E2+297.0		LT & RT			2	INSTALL NEW WHITE TYPE IDELINEATOR ON RT AND INSTALL NEW AMBER TYPE IDELINEATOR ON LT.
E2+317.0		LT & RT			2	INSTALL NEW WHITE TYPE IDELINEATOR ON RT AND INSTALL NEW AMBER TYPE IDELINEATOR ON LT.
E2+337.0		LT & RT			2	INSTALL NEW WHITE TYPE IDELINEATOR ON RT AND INSTALL NEW AMBER TYPE IDELINEATOR ON LT.
E2+357.0		LT & RT			2	INSTALL NEW WHITE TYPE IDELINEATOR ON RT AND INSTALL NEW AMBER TYPE IDELINEATOR ON LT.
E2+377.0		LT & RT			2	INSTALL NEW WHITE TYPE IDELINEATOR ON RT AND INSTALL NEW AMBER TYPE IDELINEATOR ON LT.
E2+397.0		LT & RT			2	INSTALL NEW WHITE TYPE IDELINEATOR ON RT AND INSTALL NEW AMBER TYPE IDELINEATOR ON LT.
E2+417.0		LT & RT			2	INSTALL NEW WHITE TYPE IDELINEATOR ON RT AND INSTALL NEW AMBER TYPE IDELINEATOR ON LT.
E2+453.0		RT			1	INSTALL NEW WHITE TYPE IDELINEATOR ON RT.
F2+008.8		RT			1	INSTALL NEW WHITE TYPE IDELINEATOR ON RT.
F2+038.8		RT			1	INSTALL NEW WHITE TYPE IDELINEATOR ON RT.
F2+068.8		RT			1	INSTALL NEW WHITE TYPE IDELINEATOR ON RT.
F2+091.8		RT			1	INSTALL NEW WHITE TYPE IDELINEATOR ON RT.
SHEET SUBTOTAL			-	-	23	
DWG. NO. DS-2 SUBTOTAL			2975.4	-	42	
DWG. NO. DS-3 SUBTOTAL			4817.3	-	50	
DWG. NO. DS-4 SUBTOTAL			777.0	5	21	
DWG. NO. DS-5 SUBTOTAL			1569.4	2	24	
ROUNDING			60.9	-	-	
TOTAL			10200	7	160	

FILE NAME = u:\5116\vsoc\contract\ds.dgn  
 DATE TIME = 2/2/04  
 USER = 2225

DATUM  
 VERTICAL      NAVD 88  
 HORIZONTAL    NAD 83 (1992)

ITEM  
DETAIL  
SHEET 6

SURVEYED BY	C.H.A. & V.S.E.	DATE	12/93
DESIGNED BY	D.W.E.	DATE	2/04
DRAWN BY	C.A.K.	DATE	2/04
CHECKED BY	D.E.G.	DATE	2/04
DESIGN FILE NO.	DSS.DGN		
PROJ. NAME	BENNINGTON - HOOSICK D.P.I. 0146(I) C/6		
PROJ. NO.	P.I.N. 1306.60		
DWG NO.	DS-6	SHEET	15 OF 83

HORIZONTAL CONTROL TABLE				
HCL POINT	COORDINATES		HCL STATION	DESCRIPTION
	NORTH	EAST		
<b>VT. ROUTE 279</b>				
BEGIN VT. ROUTE 279	43892.063	436593.036	I2+130.455	BEGIN VT. ROUTE 279 STA. 45+154.659 BK. (NEW YORK) = STA. I2+130.455 AHD. (VERMONT) D.P.I. 0146(1) C/3
P.C. CURVE W.B. 5	44369.434	437119.776	I2+841.329	
P.I. CURVE W.B. 5	44605.105	437379.821	P.I. STA. I3+192.276 BK. = P.I. STA. I3+187.719 AHD.	
P.T. CURVE W.B. 5	44760.069	437694.702	I3+538.666	
P.C. CURVE W.B. 6	45151.109	438489.280	I4+424.255	
P.I. CURVE W.B. 6	45348.540	438890.454	P.I. STA. I4+871.379 BK. = P.I. STA. I4+861.447 AHD.	
P.C.C. CURVE W.B. 6/ W.B. 7	45389.916	439335.659	I5+308.571	
P.I. CURVE W.B. 7	45438.564	439859.121	P.I. STA. I5+834.288 BK. = P.I. STA. I5+826.701 AHD.	
P.T. CURVE W.B. 7	45333.413	440374.214	I6+352.419	
END D.P.I. 0146(1) C/3 BEGIN D.P.I. 0146(1) C/4	45264.892	440709.875	I6+695.000	END D.P.I. 0146(1) C/3 BEGIN D.P.I. 0146(1) C/4
P.C. CURVE W.B. 8	45255.051	440758.080	I6+744.201	
P.I. CURVE W.B. 8	45214.430	440957.064	P.I. STA. I6+947.288 BK. = P.I. STA. I6+944.475 AHD.	
P.T. CURVE W.B. 8 STOP VT. ROUTE 279	45232.025	441159.388	I6+978.091	
<b>VT. ROUTE 279 WESTBOUND</b>				
END D.P.I. 0146(1) C/4 BEGIN VT. ROUTE 279 WESTBOUND D.P.I. 0146(1) C/6	45245.667	441316.261	I7+305.027	END D.P.I. 0146(1) C/4 BEGIN VT. ROUTE 279 WESTBOUND D.P.I. 0146(1) C/6
P.I.	45281.617	441729.674	I7+720.000	
END VT. ROUTE 279 WESTBOUND D.P.I. 0146(1) C/6	45312.772	442068.245	I8+060.000	END VT. ROUTE 279 WESTBOUND D.P.I. 0146(1) C/6
<b>VT. ROUTE 279 EASTBOUND</b>				
END D.P.I. 0146(1) C/4 BEGIN VT. ROUTE 279 EASTBOUND D.P.I. 0146(1) C/6	45219.754	441329.843	I7+298.377	END D.P.I. 0146(1) C/4 BEGIN VT. ROUTE 279 EASTBOUND D.P.I. 0146(1) C/6
P.I.	45256.284	441749.880	I7+720.000	
END VT. ROUTE 279 EASTBOUND D.P.I. 0146(1) C/6	45283.756	442070.915	I8+042.207	END VT. ROUTE 279 EASTBOUND D.P.I. 0146(1) C/6
<b>RAMPS</b>				
<b>RAMP X</b>				
BEGIN RAMP X	45227.585	440990.079	X10+000.000	
P.C. CURVE X-1	45219.486	441226.076	X10+236.136	
P.I. CURVE X-1	45218.031	441268.470	P.I. STA. X10+278.556 BK. = P.I. STA. X10+278.451 AHD.	
P.T. CURVE X-1	45221.706	441310.730	X10+320.871	
END RAMP X	45222.592	441320.916	X10+331.096	
<b>RAMP Y</b>				
BEGIN RAMP Y	45227.585	440990.079	Y10+000.000	
P.C. CURVE Y-1	45225.316	441056.213	Y10+066.173	
P.I. CURVE Y-1	45223.653	441104.657	P.I. STA. Y10+114.646 BK. = P.I. STA. Y10+114.528 AHD.	
P.T. CURVE Y-1	45227.852	441152.949	Y10+163.001	
END RAMP Y	45232.525	441206.691	Y10+216.946	
<b>RAMP B</b>				
BEGIN RAMP B	45251.281	441380.817	B10+000.000	
P.C. CURVE B-1	45236.112	441206.379	B10+175.097	
P.I. CURVE B-1	45233.640	441177.961	P.I. STA. B10+203.623 BK. = P.I. STA. B10+201.819 AHD.	
P.C.C. CURVE B-1/ B-2	45247.990	441153.307	B10+230.345	
P.I. CURVE B-2	45276.597	441104.161	P.I. STA. B10+287.211 BK. = P.I. STA. B10+266.916 AHD.	
P.T. CURVE B-2 / END RAMP B	45329.109	441125.982	B10+323.782	

HORIZONTAL CONTROL TABLE CONT.				
HCL POINT	COORDINATES		HCL STATION	DESCRIPTION
	NORTH	EAST		
<b>RAMP D</b>				
BEGIN RAMP D / P.C. CURVE D-1	45100.344	441194.212	D10+000.000	
P.I. CURVE D-1	45151.799	441149.691	P.I. STA. D10+068.042 BK. = P.I. STA. D10+037.032 AHD.	
P.C.C. CURVE D-1/ D-2	45193.921	441203.128	D10+105.074	
P.I. CURVE D-2	45210.572	441224.251	P.I. STA. D10+131.970 BK. = P.I. STA. D10+130.450 AHD.	
P.T. CURVE D-2	45212.902	441251.046	D10+157.346	
END RAMP D	45225.091	441391.208	D10+298.036	
<b>RAMP E</b>				
BEGIN RAMP E P.C. CURVE E-1	45704.196	442127.652	E2+000.000	
P.I. CURVE E-1	45667.928	442126.761	P.I. STA. E2+036.279 BK. = P.I. STA. E2+036.106 AHD.	
P.T. CURVE E-1	45632.330	442119.760	E2+072.385	
P.C. CURVE E-2	45424.537	442078.894	E2+284.158	
P.I. CURVE E-2	45318.030	442057.947	P.I. STA. E2+392.705 BK. = P.I. STA. E2+362.870 AHD.	
P.T. CURVE E-2 END RAMP E	45306.127	441950.055	E2+471.417	
<b>RAMP F</b>				
BEGIN RAMP F	45267.720	441940.800	F2+000.000	
P.C. CURVE F-1	45269.809	441970.414	F2+029.688	
P.I.	45272.329	442006.130	P.I. STA. F2+065.493 BK. = P.I. STA. F2+064.810 AHD.	
P.T. CURVE F-1 END RAMP F	45262.871	442040.663	F2+100.615	

FILE NAME = ur\5116\vaot\contract6\vhvc-1.dgn  
DATE/TIME = 2/16/2004  
USER = 2225

DATUM  
VERTICAL NAVD 88  
HORIZONTAL NAD 83 (1992)

**HORIZONTAL CONTROL TABLE**

SURVEYED BY C.H.A. & V.S.E. DATE 12/93  
DESIGNED BY D.W.E. DATE 2/04  
DRAWN BY C.A.K. DATE 2/04  
CHECKED BY D.E.G. DATE 2/04

DESIGN FILE NO. VTHVC-1DGN  
PROJ. NAME BENNINGTON - HOOSICK  
D.P.I. 0146(1) C/6  
PROJ. NO. P.I.N. 1306.60  
DWG NO. HC-1 SHEET 16 OF 83


**GENERAL NOTES FOR TEMPORARY SOIL EROSION AND SEDIMENT CONTROL**

THE CONTRACTOR'S ATTENTION IS DIRECTED TO THE FACT THAT THROUGHOUT THE DURATION OF THE CONTRACT IT WILL BE THE CONTRACTOR'S RESPONSIBILITY TO PROTECT ALL WATER COURSES FROM WATERBORNE SEDIMENT OR POLLUTANTS ORIGINATING FROM ANY WORK DONE ON OR IN SUPPORT OF THIS PROJECT.


THE POLLUTION CONTROL NOTES AND DETAILS SHOWN IN THESE DRAWINGS ARE NOT INTENDED TO BE ALL INCLUSIVE BUT TO SERVE AS A GUIDELINE FOR THE DEVELOPMENT OF THE CONTRACTOR'S EROSION CONTROL SCHEME REQUIRED UNDER SECTION 105.22 THROUGH 105.30, OF THE STANDARD SPECIFICATIONS AND ALSO INCLUDING STANDARD SHEETS T-1M AND T-2M.

THE PURPOSE OF TEMPORARY SOIL EROSION AND SEDIMENT CONTROL IS TO PROTECT ABUTTING PROPERTY, WATER COURSES, PONDS, DITCHES, ETC., FROM THE DETRIMENTAL EFFECTS OF SOIL EROSION AND/OR SEDIMENT ORIGINATING FROM WITHIN THE WORK LIMITS AND/OR FROM AREAS SPECIFICALLY DESIGNATED FOR CONTRACTUAL OPERATIONS BY THE STATE. TEMPORARY EROSION CONTROL WORK DONE BY THE CONTRACTOR IN ACCORDANCE WITH THE PRE-APPROVED SCHEME, OR AS DIRECTED BY THE RESIDENT ENGINEER, SHALL BE PAID FOR UNDER THE APPROPRIATE ITEMS). TO PROTECT PRIVATE PROPERTY, WATER COURSES, PONDS, DITCHES, ETC., IT REMAINS THE CONTRACTOR'S RESPONSIBILITY TO PROTECT HIS/HER OWN WORK AT NO ADDITIONAL COST TO THE STATE, IN ACCORDANCE WITH THE PROVISIONS OF SECTION 105.29 OF THE STANDARD SPECIFICATIONS.

- INSPECTION OF SOIL EROSION AND POLLUTION CONTROL MEASURES, SHALL BE DONE ON A DAILY BASIS AND AFTER EVERY STORM OF 12 mm OR GREATER OR AS DIRECTED BY THE RESIDENT ENGINEER. REPAIRS SHALL BE MADE AS NEEDED AND SEDIMENT SHALL BE REMOVED WHEN THE STORAGE VOLUME OF AN EROSION CONTROL MEASURE IS APPROACHING ONE HALF OF ITS INTENDED CAPACITY OR AS DIRECTED BY THE RESIDENT ENGINEER.
- A TEMPORARY LINING MATERIAL MAY BE REQUIRED WHERE THE CONTRACTOR PROVIDES TEMPORARY CHANNELS TO KEEP CONTRACTOR'S WORK SITES FREE FROM WATER DURING CONSTRUCTION AS DIRECTED BY THE RESIDENT ENGINEER. NO DIRECT PAYMENT WILL BE MADE FOR THIS WORK; THE COST IS TO BE INCLUDED IN THE PRICE BID FOR THE OTHER ITEMS OF THE CONTRACT.
- THE CONTRACTOR SHALL GRADE AND TRIM ALL SLOPES AS THE EXCAVATION PROGRESSES AND SEED ALL SLOPES AS DIRECTED BY THE RESIDENT ENGINEER, AND AS REQUIRED BY STANDARD T-1M.
- THE CONTRACTOR SHALL HAVE A HYDROSEEDER AND/OR A MULCHING MACHINE AVAILABLE ON THE PROJECT SITE OR AVAILABLE AT ONE WEEK'S NOTICE (MAXIMUM) UNTIL THE PERMANENT SEEDING IS COMPLETED.
- CONSTRUCTION OPERATIONS SHALL BE CONDUCTED IN SUCH A MANNER AS TO PREVENT ANY DAMAGE TO THE WATERS OF THE UNITED STATES FROM POLLUTION BY DEBRIS, SEDIMENT, OR OTHER FOREIGN MATERIAL, OR FROM MANIPULATION OF EQUIPMENT AND/OR MATERIALS IN OR NEAR THE WATERS OF THE UNITED STATES. THE CONTRACTOR SHALL NOT RETURN DIRECTLY TO THE WATERS OF THE UNITED STATES ANY WATER WHICH HAS BEEN USED FOR WASH PURPOSES OR OTHER SIMILAR OPERATIONS WHICH WOULD CAUSE THIS WATER TO BECOME POLLUTED WITH SAND, SILT, CEMENT, OIL OR OTHER IMPURITIES. IF THE CONTRACTOR USES WATER FROM THE WATERS OF THE UNITED STATES, THE CONTRACTOR SHALL CONSTRUCT AN INTAKE OR TEMPORARY DAM TO PROTECT AND MAINTAIN STREAM WATER QUALITY.
- DURING CONSTRUCTION, NO WET OR FRESH CONCRETE OR LEACHATE SHALL BE ALLOWED TO ESCAPE INTO THE WATERS OF THE UNITED STATES, NOR SHALL WASHING FROM CONCRETE TRUCKS, MIXERS OR OTHER DEVICES BE ALLOWED TO ENTER ANY WETLANDS OR WATERS OF THE UNITED STATES.
- THE SCHEME PROPOSED BY THE CONTRACTOR TO ACCOMPLISH EROSION AND POLLUTION CONTROL SHALL BE SUBJECT TO APPROVAL BY THE RESIDENT ENGINEER.
- GRAVEL BAGS SHALL BE AS DESCRIBED IN SECTION 203 EXCEPT THAT ONLY GRAVEL FILL IS ACCEPTABLE. GRAVEL FILL SHALL BE FREE OF SILT AND GRAVEL BAGS WILL BE REMOVED IN THEIR ENTIRETY AT THE COMPLETION OF THE PROJECT.
- SNOW FENCE (MOD.) SHALL BE ERECTED PRIOR TO ANY ACTIVITY THAT WILL ALTER THE SITE SUCH AS PLACING TRAILERS, STOCK PILES, STORAGE AREAS, DEMOLITION, OR CONSTRUCTION.
- SILT FENCE MAY BE SUBSTITUTED WITH COMMERCIALY AVAILABLE EROSION / SEDIMENT CONTROL DEVICES AS APPROVED IN WRITING BY THE RESIDENT ENGINEER. THE DEVICES SHALL OFFER EROSION / SEDIMENT CONTROL EQUAL TO OR BETTER THAN THE ITEMS THEY ARE SUBSTITUTING.

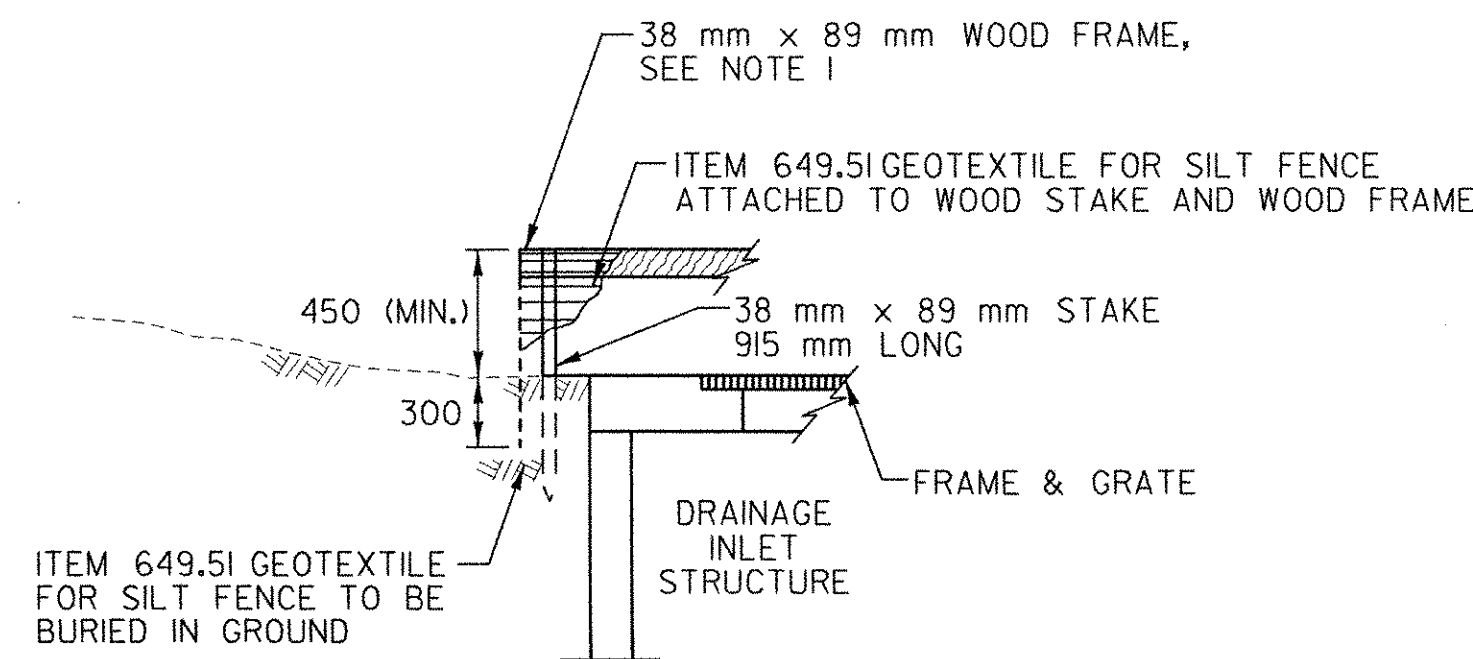

**ELEVATION**

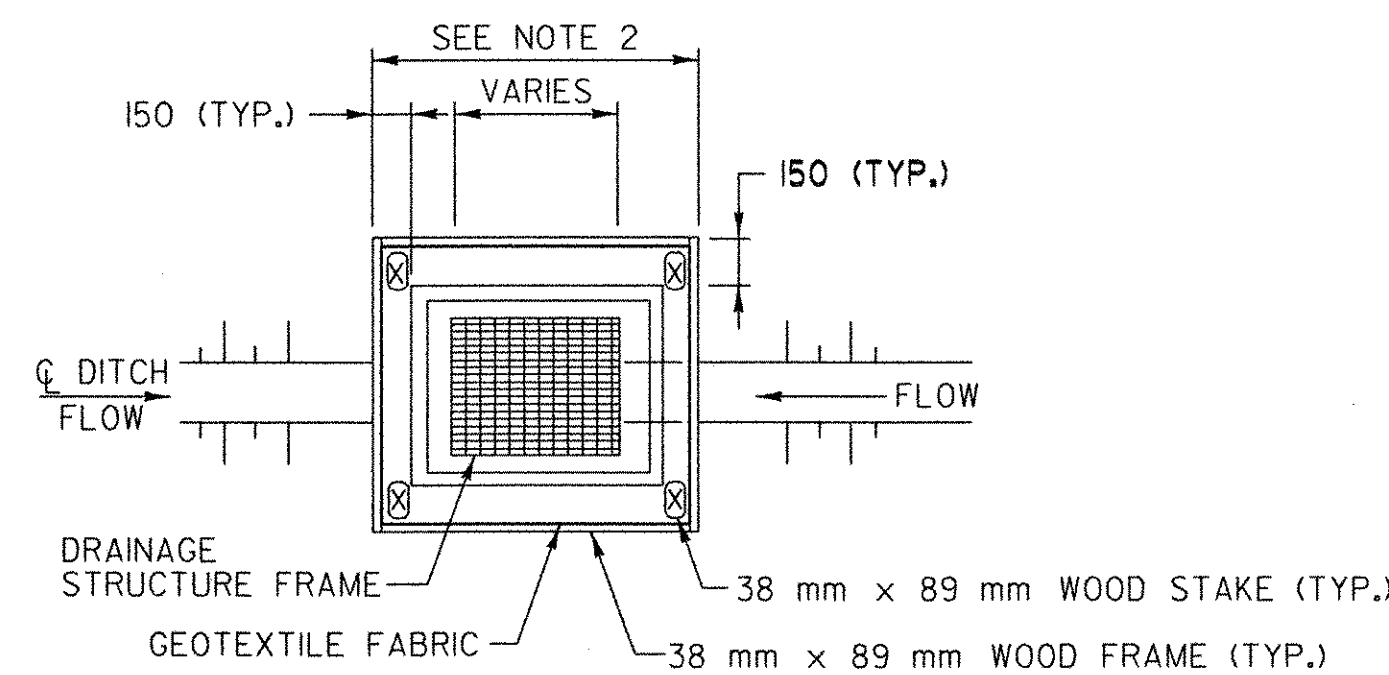



**PLAN**

NOTES:


- A 38 mm x 89 mm WOOD FRAME SHALL BE COMPLETED AROUND THE TOP OF THE STAKES OVER THE ATTACHED FABRIC FOR OVERFLOW STABILITY.
- SPACE STAKES EVENLY AROUND INLET MAXIMUM OF 900 mm SPACING AND DRIVE A MINIMUM 450 mm DEEP. SPANS GREATER THAN 900 mm MAY BE BRIDGED WITH THE USE OF WIRE MESH BEHIND THE FILTER FABRIC FOR SUPPORT.
- CUT GEOTEXTILE FROM A CONTINUOUS ROLL TO ELIMINATE JOINTS. IF JOINTS ARE NEEDED THEY SHALL BE OVERLAPPED TO THE NEXT SPLICE.

**SILT FENCE FOR TEMPORARY SEDIMENT CONTROL AT DRAINAGE INLET STRUCTURES**


STANDARD SYMBOL

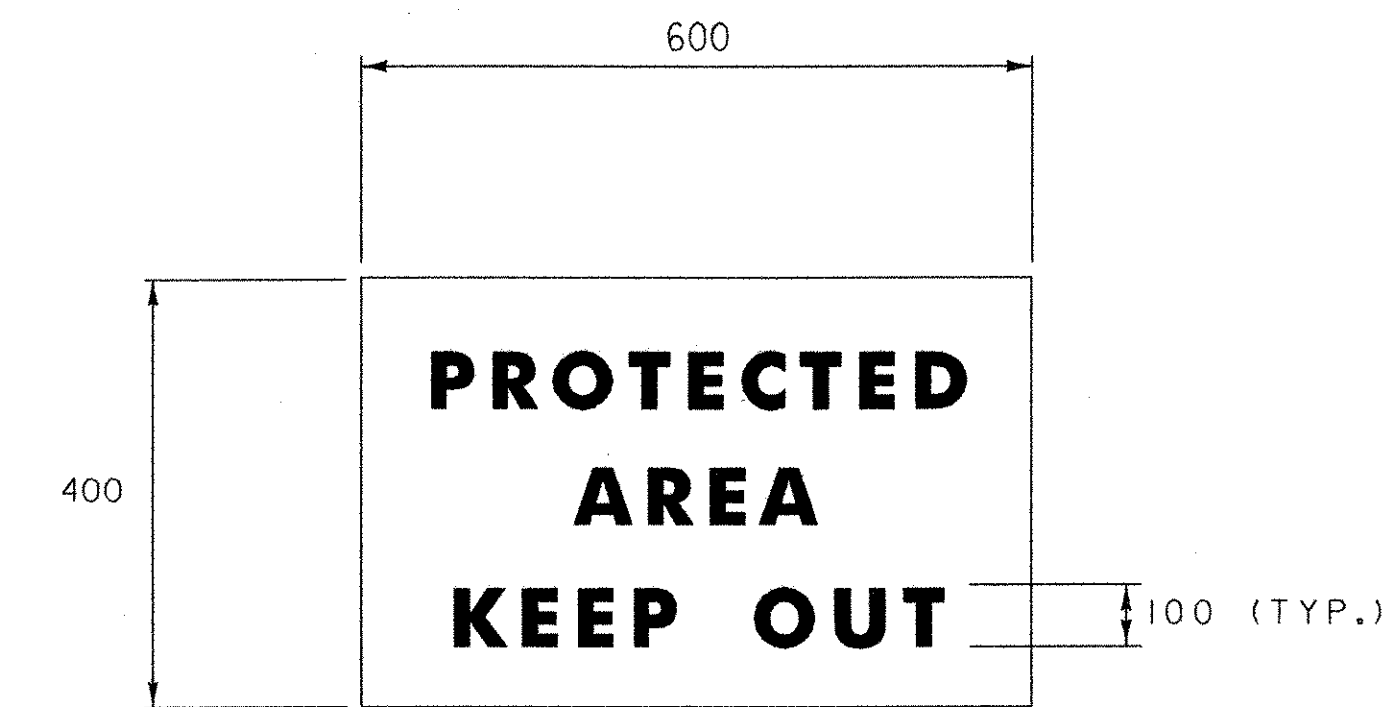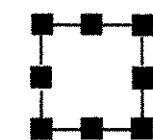

**WARNING SIGN DETAIL**

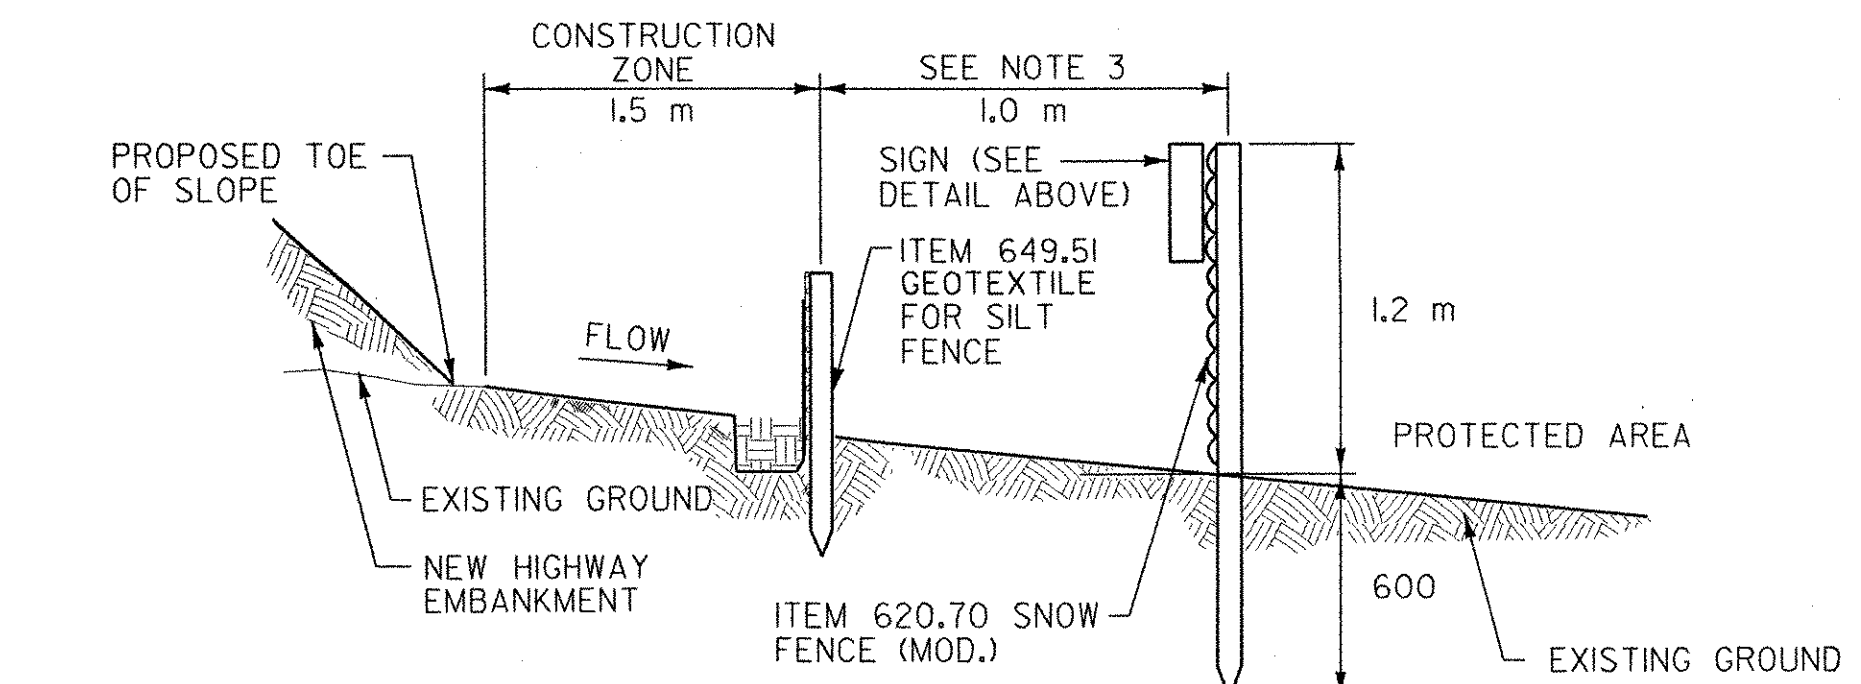

**SECTION**

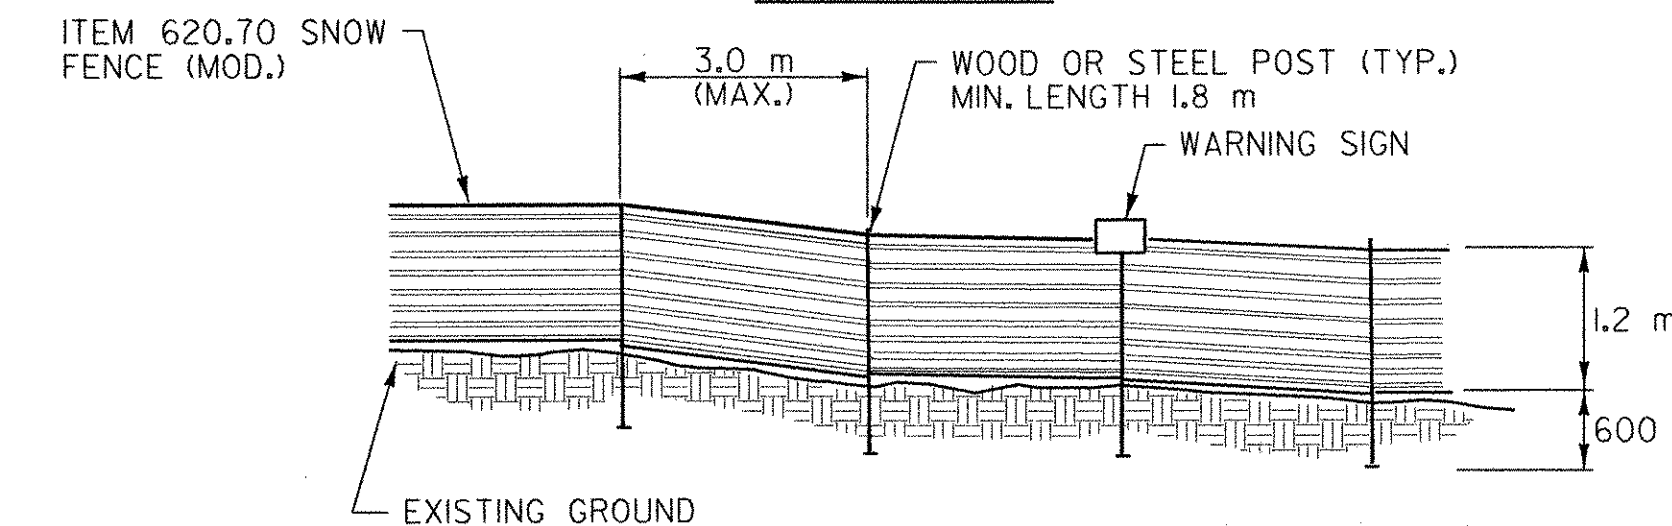


**ELEVATION**

NOTES:

- WARNING SIGNS SHALL BE PLACED AT 30 m INTERVALS.
- ITEM 620.70 SNOW FENCE (MOD.) SHALL BE INSTALLED PRIOR TO BEGINNING ANY WORK AS DIRECTED BY THE RESIDENT ENGINEER.
- IN AREAS ADJACENT TO OR WITHIN A WETLAND THE RESIDENT ENGINEER MAY REQUIRE ITEM 620.70 SNOW FENCE (MOD.) TO BE PLACED IN COMBINATION WITH THE SILT FENCE.
- THE RESIDENT ENGINEER MAY EXTEND THE DISTANCE BETWEEN THE PROPOSED TOE OF SLOPE AND SILT FENCE PROVIDING IT DOES NOT TAKE PLACE IN A WETLAND/WATERBODY AND DOES NOT REQUIRE THE REMOVAL OF EXISTING VEGETATION.
- THE CONTRACTOR SHALL INSTALL AT THE BEGINNING OF THE CONTRACT, AND MAINTAIN THROUGHOUT ITS DURATION ITEM 620.70 SNOW FENCE (MOD.) AROUND THE EXISTING WETLAND AREAS/STREAM COURSE AREAS AS SHOWN. THE CONTRACTOR SHALL NOT DISTURB THE FENCED AREAS. THE COST SHALL BE INCLUDED IN THE PRICE BID FOR ITEM 620.70 SNOW FENCE (MOD.)

**SNOW FENCE (MOD.)**

STANDARD SYMBOL

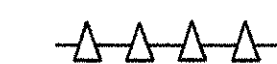

ALL DIMENSIONS IN MILLIMETERS EXCEPT WHERE OTHERWISE NOTED.

**EROSION CONTROL DETAIL SHEET**


SURVEYED BY C.H.A. & V.S.E. DATE 12/93  
 DESIGNED BY D.W.E. DATE 2/04  
 DRAWN BY C.A.K. DATE 2/04  
 CHECKED BY D.E.G. DATE 2/04

DESIGN FILE NO. DETPLOS.DGN  
 PROJ. NAME BENNINGTON - HOOSICK D.P.I. 0146(I) C/6  
 PROJ. NO. P.I.N. 1306.60  
 DWG NO. EC-1 SHEET 17 OF 83

DATUM	
VERTICAL	NAVD 88
HORIZONTAL	NAD 83 (1992)

FILE NAME = u:\5116\svoot\contr-act6\detp105.dgn  
 DATE/TIME = 16/2/2004  
 USER = 2225

CURVE W.B. 5	CURVE W.B. 6
P.C.= STA.12+841.329	P.C.= STA.14+424.255
P.T.= STA.13+538.666	P.C.C.= STA.15+308.571
$\Delta=15^{\circ}58'54.5''$ RT	$\Delta=20^{\circ}53'37.8''$ RT
R=2500.000 m	R=2425.000 m
T=350.947 m	T=447.124 m
L=697.337 m	L=884.316 m
E=24.513 m	E=40.876 m
$e_{max}=0.021$ DN, RT	$e_{max}=0.022$ DN, RT

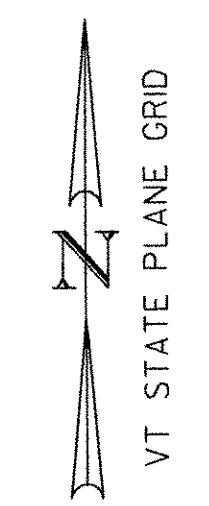

TOWN OF HOOSICK (RENSSELAER COUNTY)  
TOWN OF BENNINGTON (BENNINGTON COUNTY)

STATE OF NEW YORK  
STATE OF VERMONT

EQUALITY  
STA. 25+154.659 BK (NEW YORK)  
STA. 12+130.455 AID. (VERMONT)

SPARKS,  
WILLIAM

END BENNINGTON - HOOSICK D.P.I. 0146(I) C/2  
BEGIN BENNINGTON - HOOSICK D.P.I. 0146(I) C/3  
STA. 12+130.455

S.H. 98-2 - CONSTRUCTED BY OTHERS UNDER  
BENNINGTON - HOOSICK D.P.I. 0146(I) C/2 CONTRACT

VT. ROUTE 279 CONSTRUCTED BY OTHERS UNDER  
BENNINGTON - HOOSICK D.P.I. 0146(I) C/3

PROPOSED R.O.W.  
(W/O ACCESS) (TYP.)

STATE OF VERMONT  
(FORMERLY WOODLAND HEIGHTS  
REALTY CO)


TEMPORARY  
WEIGH STATION

WHIPSTOCK  
HILL ROAD

VAIL ROAD

AIRPORT ROAD

**SIGN LEGEND**  
R= REMOVE  
S= SALVAGE  
N= NEW  
RET= RETAIN  
B-B= BACK TO BACK  
EXISTING= \_\_\_\_\_  
NEW= \_\_\_\_\_

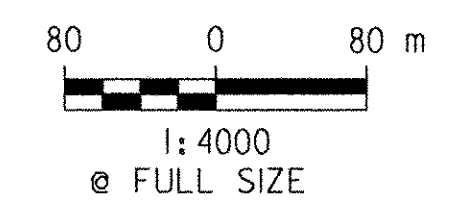

**NOTES:**

- SEE DWG'S, DS-2 THRU DS-6 AND PDT-2 FOR MILLED RUMBLE STRIP LOCATIONS AND DETAILS.
- INSTALL ALL BRIDGE PLAQUES AS SHOWN OR AS DIRECTED BY THE RESIDENT ENGINEER.
- INSTALL DELINEATORS AS SHOWN ON DWG'S, DS-2 THRU DS-6 OR AS DIRECTED BY THE RESIDENT ENGINEER.

**GENERAL PLAN**

SURVEYED BY	C.H.A. & V.S.E.	DATE	12/93
DESIGNED BY	D.W.E.	DATE	2/04
DRAWN BY	C.A.K.	DATE	2/04
CHECKED BY	D.E.G.	DATE	2/04
DESIGN FILE NO.	GI-DGN		
PROJ. NAME	BENNINGTON - HOOSICK D.P.I. 0146(I) C/6		
PROJ. NO.	P.I.N. 1306.60		
DWG NO.	G-1	SHEET 18 OF 83	

FILE NAME = u:\5116\svoot\contr-ect6\gl.dgn  
DATE/TIME = 2/16/2004  
USER = ZZZZ

DATUM

VERTICAL	NAVD 88
HORIZONTAL	NAD 83 (1992)

**CURVE W.B. 7**  
 P.C.C.= STA. 15+308.571  
 P.T.= STA. 16+352.419  
 $\Delta=16^{\circ}50'50.4''$  RT  
 R=3550.000 m  
 T=525.717 m  
 L=1043.848 m  
 E=38.715 m  
 $e_{max}=0.020$  DN. RT


**CURVE W.B. 8**  
 P.C.= STA. 16+744.201  
 P.T.= STA. 16+978.091  
 $\Delta=09^{\circ}34'19.5''$  LT  
 R=1400.000 m  
 T=117.218 m  
 L=233.890 m  
 E=4.899 m  
 $e_{max}=0.036$  DN. LT



VT. ROUTE 279 CONSTRUCTED BY OTHERS UNDER BENNINGTON - HOOSICK D.P.I. 0146(I) C/3

BEGIN ROADWAY  
 END BENNINGTON-HOOSICK D.P.I. 0146(I) C/4  
 BEGIN BENNINGTON-HOOSICK D.P.I. 0146(I) C/6  
 BEGIN APPROACH SLAB  
 STA. 16+064.800 =  
 W.B. STA. 17+305.027

END BENNINGTON-HOOSICK D.P.I. 0146(I) C/6  
 W.B. STA. 18+000.000

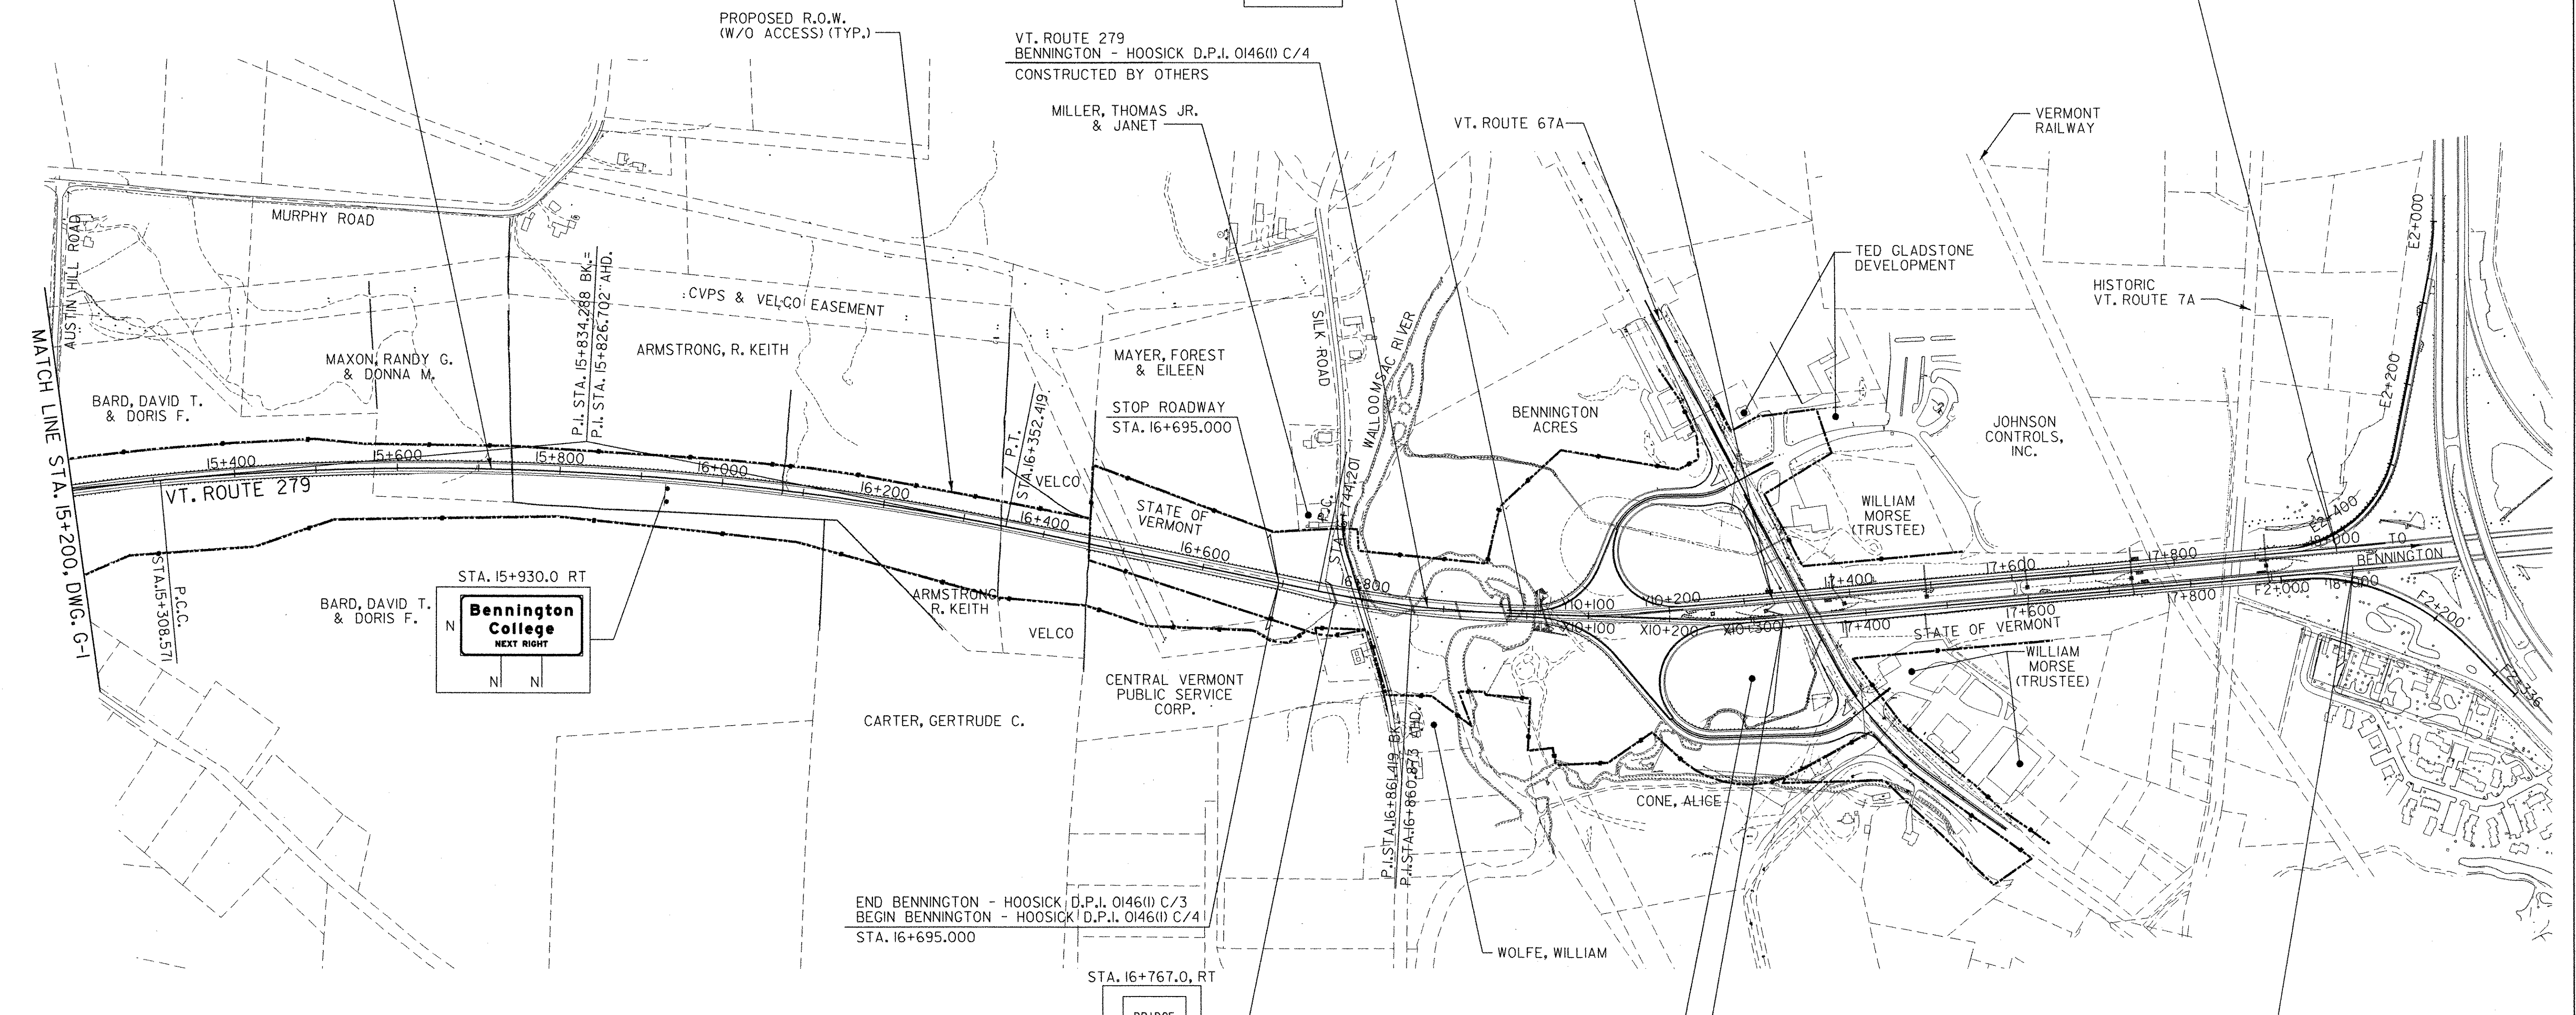

END BENNINGTON - HOOSICK D.P.I. 0146(I) C/3  
 BEGIN BENNINGTON - HOOSICK D.P.I. 0146(I) C/4  
 STA. 16+695.000

BEGIN ROADWAY  
 END BENNINGTON-HOOSICK D.P.I. 0146(I) C/4  
 BEGIN BENNINGTON-HOOSICK D.P.I. 0146(I) C/6  
 BEGIN APPROACH SLAB  
 STA. 16+236.439 =  
 E.B. STA. 17+298.377

END BENNINGTON-HOOSICK D.P.I. 0146(I) C/6  
 E.B. STA. 18+000.000

- NOTES:
- SEE DWG'S. DS-2 THRU DS-6 AND PDT-2 FOR MILLED RUMBLE STRIP LOCATIONS AND DETAILS.
  - INSTALL ALL BRIDGE PLAQUES AS SHOWN OR AS DIRECTED BY THE RESIDENT ENGINEER.
  - INSTALL DELINEATORS AS SHOWN ON DWG'S. DS-2 THRU DS-6 OR AS DIRECTED BY THE RESIDENT ENGINEER.

**CURVE B-1**  
 P.C.= STA. 16+175.097  
 P.C.C.= STA. 16+230.345  
 $\Delta=35^{\circ}10'19.8''$  RT  
 R=90.000 m  
 T=28.526 m  
 L=55.248 m  
 E=4.412 m  
 $e_{max}=0.069$  DN. RT

**CURVE D-1**  
 P.C.= STA. 16+000.000  
 P.C.C.= STA. 16+010.074  
 $\Delta=92^{\circ}37'11.1''$  RT  
 R=65.000 m  
 T=68.042 m  
 L=105.074 m  
 E=29.100 m  
 $e_{max}=0.077$  DN. RT

**CURVE E-1**  
 P.C.= STA. 16+000.000  
 P.T.= STA. 16+072.385  
 $\Delta=09^{\circ}43'09.0''$  RT  
 R=426.720 m  
 T=36.279 m  
 L=72.385 m  
 E=1.539 m  
 $e_{max}=N/A$

**CURVE D-2**  
 P.C.C.= STA. 16+010.074  
 P.T.= STA. 16+157.346  
 $\Delta=33^{\circ}16'39.0''$  RT  
 R=90.000 m  
 T=26.896 m  
 L=52.272 m  
 E=3.933 m  
 $e_{max}=0.069$  DN. RT


**CURVE X-1**  
 P.C.= STA. 16+236.439  
 P.T.= STA. 16+320.871  
 $\Delta=06^{\circ}56'08.5''$  LT  
 R=700.000 m  
 T=42.420 m  
 L=84.735 m  
 E=1.284 m  
 $e_{max}=0.063$  DN. LT

**CURVE F-1**  
 P.C.= STA. 16+029.688  
 P.T.= STA. 16+100.615  
 $\Delta=19^{\circ}21'06.0''$  RT  
 R=210.000 m  
 T=35.805 m  
 L=70.927 m  
 E=3.030 m  
 $e_{max}=N/A$

**CURVE F-2**  
 P.C.C.= STA. 16+100.615  
 P.T.= STA. 16+247.745  
 $\Delta=29^{\circ}47'15''$  RT  
 R=283.000 m  
 T=75.268 m  
 L=147.129 m  
 E=9.838 m  
 $e_{max}=N/A$

**CURVE E-2**  
 P.C.= STA. 16+284.158  
 P.T.= STA. 16+471.417  
 $\Delta=72^{\circ}34'42.0''$  RT  
 R=147.828 m  
 T=108.547 m  
 L=187.258 m  
 E=35.572 m  
 $e_{max}=N/A$

**SIGN LEGEND**  
 R= REMOVE  
 S= SALVAGE  
 N= NEW  
 RET= RETAIN  
 B-B= BACK TO BACK  
 EXISTING=   
 NEW=

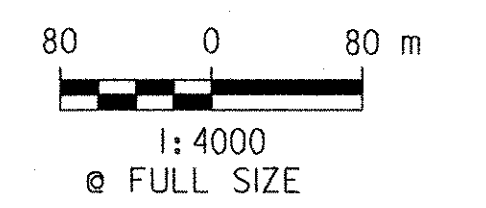


### GENERAL PLAN

SURVEYED BY C.H.A. & V.S.E. DATE 12/93  
 DESIGNED BY D.W.E. DATE 2/04  
 DRAWN BY C.A.K. DATE 2/04  
 CHECKED BY D.E.G. DATE 2/04

DESIGN FILE NO. G2-DGN  
 PROJ. NAME BENNINGTON - HOOSICK D.P.I. 0146(I) C/6  
 PROJ. NO. P.I.N. 1306.60  
 DWG NO. G-2 SHEET 19 OF 83

FILE NAME = n:\1515\vac\contract\act6\vg2.dgn  
 DATE/TIME = 2/17/2004 10:22:25  
 USER = 2225

DATUM  
 VERTICAL NAVD 88  
 HORIZONTAL NAD 83 (1992)

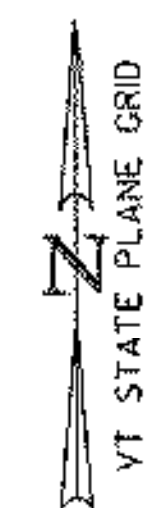

**LEGEND**

- SILT FENCE
- SILT FENCE FOR DRAINAGE STRUCTURE PROTECTION
- EROSION MATTING, (SEE NOTE 5)


\*SEE NOTE 4

**CURVE B-1**  
P.C.=STA. B10+175.097  
P.C.C.=STA. B10+230.345  
Δ=35°10'19.8" RT  
R=90.000 m  
T=28.526 m  
L=55.248 m  
E=4.412 m  
e<sub>max</sub>=0.069 DN, RT

**CURVE D-1**  
P.C.=STA. D10+000.000  
P.C.C.=STA. D10+105.074  
Δ=92°37'11.1" RT  
R=65.000 m  
T=68.042 m  
L=105.074 m  
E=29.100 m  
e<sub>max</sub>=0.077 DN, RT

**CURVE D-2**  
P.C.C.=STA. D10+105.074  
P.T.=STA. D10+157.346  
Δ=33°16'39.0" RT  
R=90.000 m  
T=26.896 m  
L=52.272 m  
E=3.933 m  
e<sub>max</sub>=0.069 DN, RT

**CURVE X-1**  
P.C.=STA. X10+236.136  
P.T.=STA. X10+320.871  
Δ=06°56'08.5" LT  
R=700.000 m  
T=42.420 m  
L=84.735 m  
E=1.284 m  
e<sub>max</sub>=0.063 DN, LT

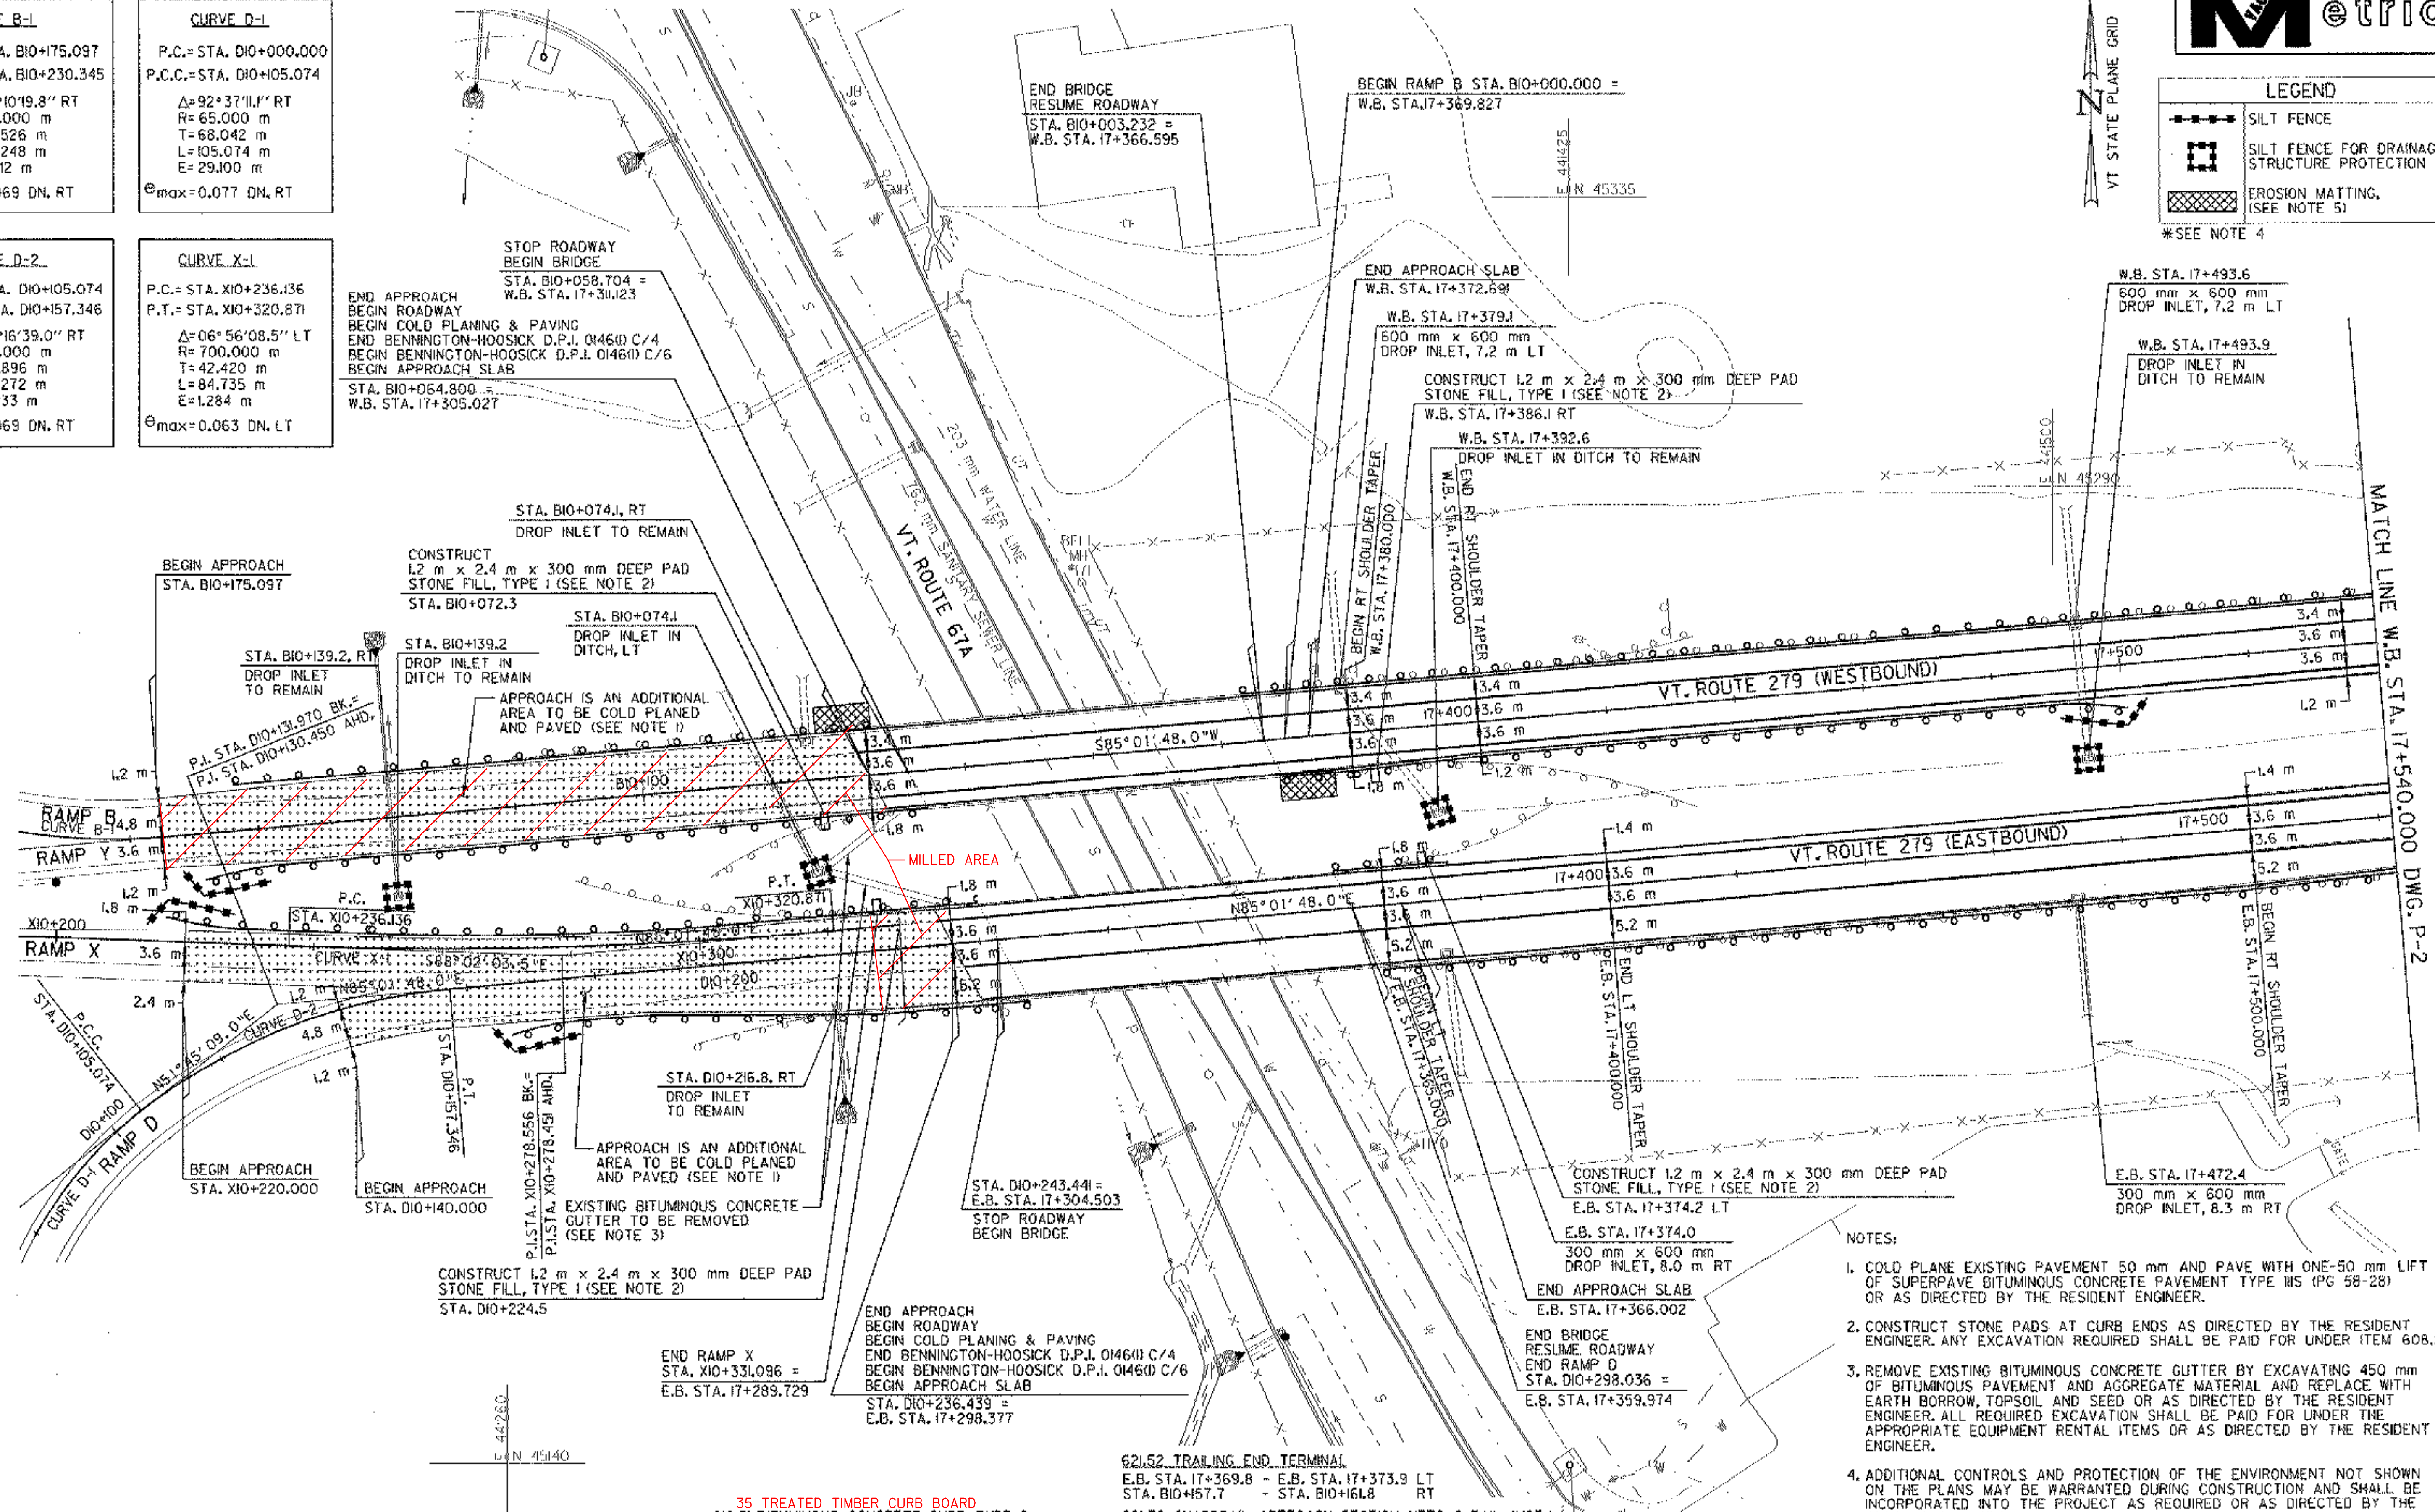

- NOTES:**
1. COLD PLANE EXISTING PAVEMENT 50 mm AND PAVE WITH ONE-50 mm LIFT OF SUPERPAVE BITUMINOUS CONCRETE PAVEMENT TYPE IHS (PG 58-28) OR AS DIRECTED BY THE RESIDENT ENGINEER.
  2. CONSTRUCT STONE PADS AT CURB ENDS AS DIRECTED BY THE RESIDENT ENGINEER. ANY EXCAVATION REQUIRED SHALL BE PAID FOR UNDER ITEM 608.25.
  3. REMOVE EXISTING BITUMINOUS CONCRETE GUTTER BY EXCAVATING 450 mm OF BITUMINOUS PAVEMENT AND AGGREGATE MATERIAL AND REPLACE WITH EARTH BORROW, TOPSOIL AND SEED OR AS DIRECTED BY THE RESIDENT ENGINEER. ALL REQUIRED EXCAVATION SHALL BE PAID FOR UNDER THE APPROPRIATE EQUIPMENT RENTAL ITEMS OR AS DIRECTED BY THE RESIDENT ENGINEER.
  4. ADDITIONAL CONTROLS AND PROTECTION OF THE ENVIRONMENT NOT SHOWN ON THE PLANS MAY BE WARRANTED DURING CONSTRUCTION AND SHALL BE INCORPORATED INTO THE PROJECT AS REQUIRED OR AS DIRECTED BY THE RESIDENT ENGINEER.
  5. EMBANKMENT EROSION TO BE FILLED WITH EARTH BORROW, TOPSOIL AND SEED AND COVERED WITH EROSION MATTING OR AS DIRECTED BY THE RESIDENT ENGINEER.

**213.00 MILLED RUMBLE STRIPS**

W.B. STA. 17+377.8	-	W.B. STA. 17+540.0	LT (162.2 m)
W.B. STA. 17+383.6	-	W.B. STA. 17+540.0	RT (156.4 m)
E.B. STA. 17+371.7	-	E.B. STA. 17+522.1	LT (150.4 m)
E.B. STA. 17+378.0	-	E.B. STA. 17+522.1	RT (144.1 m)
STA. X10+140.0	-	STA. B10+070.4	RT (81.6 m)
STA. X10+067.0	-	STA. X10+250.0	RT (83.0 m)
STA. X10+160.0	-	STA. X10+329.0	LT (169.7 m)
STA. B10+067.0	-	STA. B10+145.0	RT (69.0 m)
STA. D10+190.0	-	STA. D10+232.4	RT (42.4 m)

**604.40 CHANGE ELEVATION OF DI, CB, OR MH**

W.B. STA. 17+379.1	LT		
W.B. STA. 17+493.6	LT		
E.B. STA. 17+374.0	RT		
E.B. STA. 17+472.4	RT		
STA. B10+074.1	LT		
W.B. STA. 17+366.9	-	W.B. STA. 17+376.8	LT (9.9 m)
W.B. STA. 17+372.7	-	W.B. STA. 17+384.9	RT (12.2 m)
E.B. STA. 17+360.8	-	E.B. STA. 17+373.0	LT (12.2 m)
E.B. STA. 17+367.1	-	E.B. STA. 17+377.0	RT (9.9 m)
STA. B10+059.5	-	STA. B10+071.7	LT (12.2 m)
STA. B10+065.1	-	STA. B10+075.0	RT (9.9 m)
STA. D10+225.1	-	STA. D10+237.3	LT (12.2 m)
STA. D10+233.4	-	STA. D10+243.3	RT (9.9 m)

**35 TREATED TIMBER CURB BOARD**

**616.31 BITUMINOUS CONCRETE CURB, TYPE B**

W.B. STA. 17+376.8	-	W.B. STA. 17+540.0	LT (6.7 ft)
E.B. STA. 17+377.0	-	E.B. STA. 17+522.1	RT (5.9 ft)
STA. B10+075.0	-	STA. B10+150.0	RT (3.1 ft)
STA. D10+203.4	-	STA. D10+233.4	RT (11.2 ft)

**621.20 STEEL BEAM GUARDRAIL**

W.B. STA. 17+375.9	-	W.B. STA. 17+540.0	LT (164.1 m)
W.B. STA. 17+381.7	-	W.B. STA. 17+491.9	RT (110.2 m)
E.B. STA. 17+376.1	-	E.B. STA. 17+522.1	RT (145.0 m)
STA. B10+068.5	-	STA. B10+155.9	LT (87.4 m)
STA. B10+074.1	-	STA. B10+157.7	RT (83.6 m)
STA. D10+177.3	-	STA. D10+234.3	RT (57.0 m)
STA. X10+229.0	-	STA. X10+331.6	LT (102.6 m)

**621.505 MANUFACTURED TERMINAL SECTION (FLARED)**

W.B. STA. 17+491.9	RT (1EA)
STA. B10+155.9	LT (1EA)
STA. D10+177.3	RT (1EA)
STA. X10+229.0	LT (1EA)

**621.52 TRAILING END TERMINAL**

E.B. STA. 17+369.8	-	E.B. STA. 17+373.9	LT
STA. B10+157.7	-	STA. B10+161.8	RT

**621.72 GUARDRAIL APPROACH SECTION, NETIC 2 RAIL (MOD.)**


W.B. STA. 17+366.9	-	W.B. STA. 17+375.9	LT
W.B. STA. 17+372.7	-	W.B. STA. 17+381.7	RT
E.B. STA. 17+360.8	-	E.B. STA. 17+369.8	LT
E.B. STA. 17+367.1	-	E.B. STA. 17+376.1	RT
STA. B10+059.5	-	STA. B10+068.5	LT
STA. B10+065.1	-	STA. B10+074.1	RT
STA. D10+228.3	-	STA. D10+237.3	LT
STA. D10+234.3	-	STA. D10+243.3	RT

**621.80 REMOVAL AND DISPOSAL OF GUARDRAIL**

W.B. STA. 17+366.9	-	W.B. STA. 17+540.0	LT (173.1 m)
W.B. STA. 17+372.7	-	W.B. STA. 17+432.6	RT (59.9 m)
E.B. STA. 17+360.8	-	E.B. STA. 17+392.3	LT (31.5 m)
E.B. STA. 17+367.1	-	E.B. STA. 17+522.1	RT (155.0 m)
STA. B10+059.5	-	STA. B10+090.6	LT (31.1 m)
STA. B10+065.1	-	STA. B10+119.4	RT (54.3 m)
STA. X10+281.1	-	STA. X10+331.6	LT (50.5 m)
STA. D10+194.5	-	STA. D10+243.3	RT (48.8 m)
STA. D10+228.3	-	STA. D10+237.3	LT (9.0 m)

**DATUM**


VERTICAL	NAVD 88
HORIZONTAL	NAD 83 (1992)

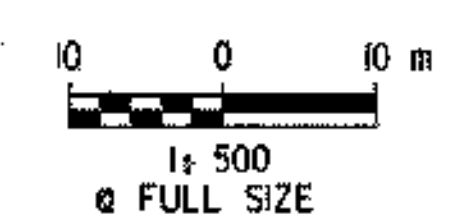

**PLAN**


SURVEYED BY	C.H.A. & V.S.E.	DATE	12/93
DESIGNED BY	D.W.E.	DATE	2/04
DRAWN BY	C.A.K.	DATE	2/04
CHECKED BY	D.E.G.	DATE	2/04
DESIGN FILE NO.	PLAN01.DGN		
PROJ. NAME	BENNINGTON - HOOSICK D.P.I. 014611 C/6		
PROJ. NO.	P.I.N. 1306.60		
DWG. NO.	P-1	SHEET	20 OF 83

FILE NAME = \\V16116\project\contract\ac\6\plan21.dgn  
 DATE/TIME = 2/18/2004 10:22:23  
 USER = 2228

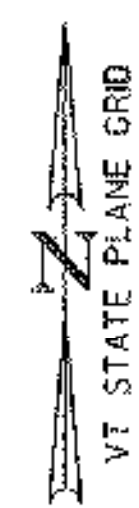

LEGEND	
	SILT FENCE
	SILT FENCE FOR DRAINAGE STRUCTURE PROTECTION
	EROSION MATTING, (SEE NOTE 3)

\*SEE NOTE 2

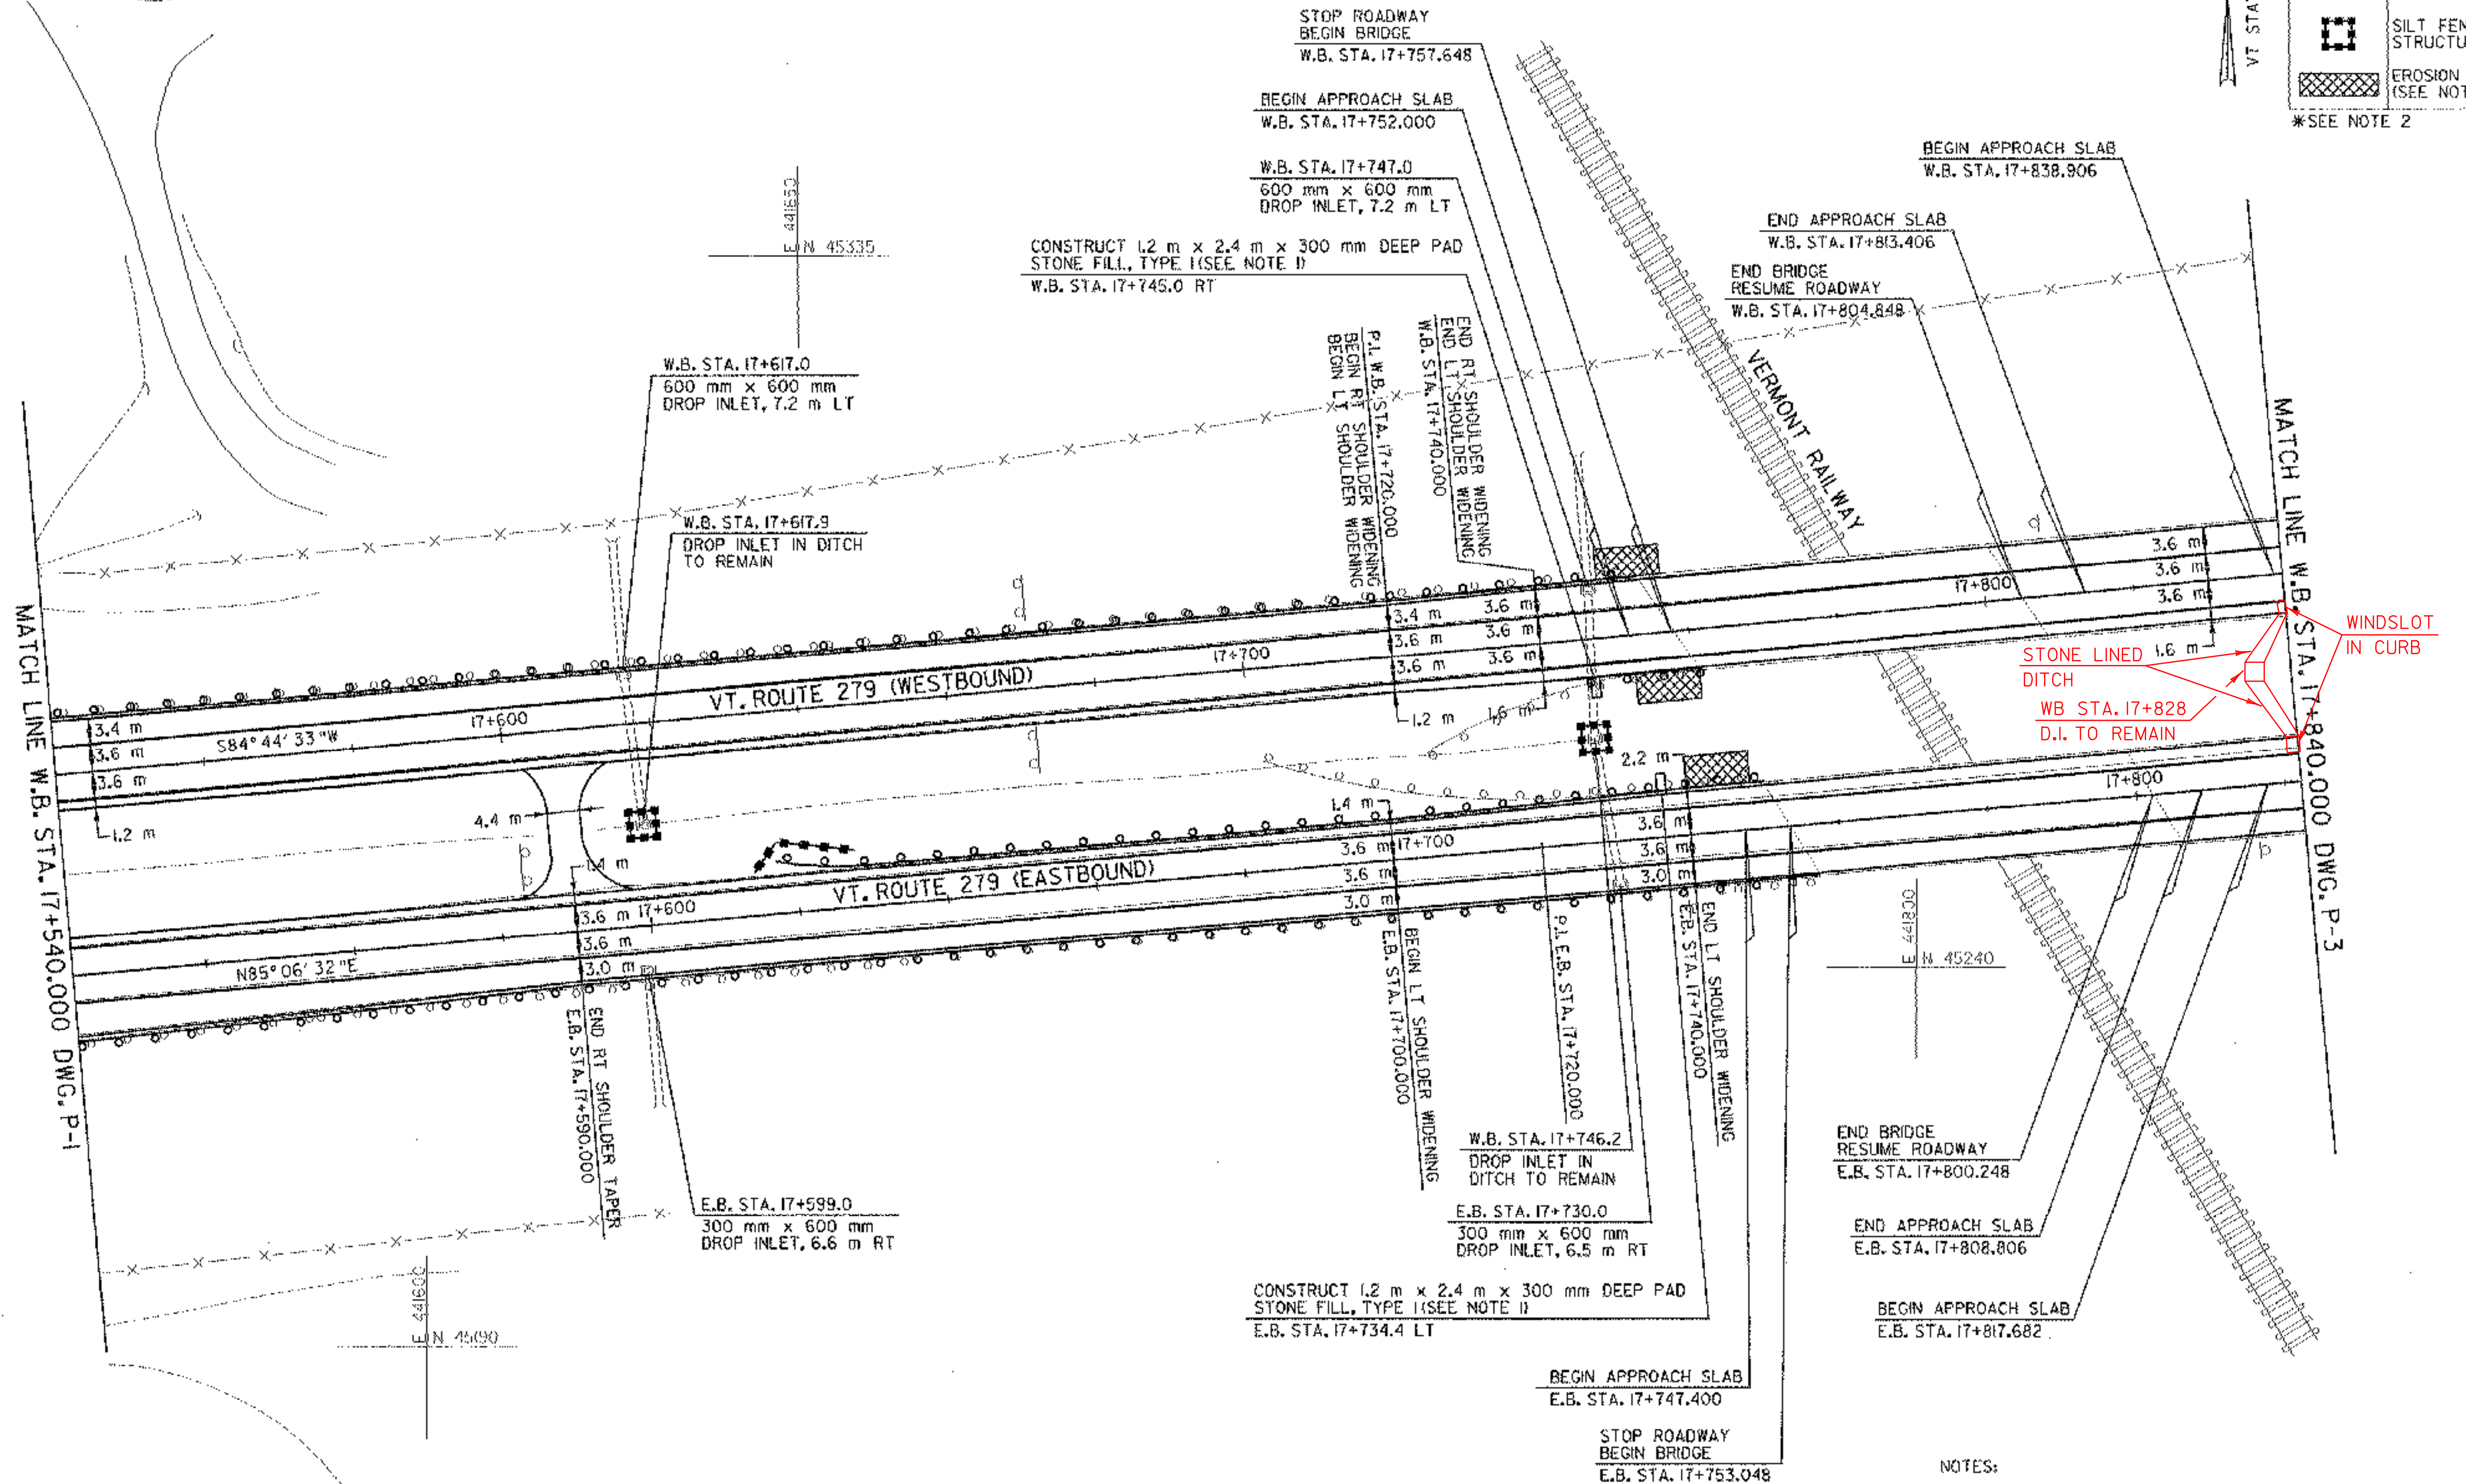

MATCH LINE W.B. STA. 17+540.000 DWG. P-1

MATCH LINE W.B. STA. 17+840.000 DWG. P-3

WINDSLOT IN CURB  
STONE LINED 1.6 m DITCH  
WB STA. 17+828 D.I. TO REMAIN

- NOTES:
- CONSTRUCT STONE PADS AT CURB ENDS OR AS DIRECTED BY THE RESIDENT ENGINEER. ANY EXCAVATION REQUIRED SHALL BE PAID FOR UNDER ITEM 608.25.
  - ADDITIONAL CONTROLS AND PROTECTION OF THE ENVIRONMENT NOT SHOWN ON THE PLANS MAY BE WARRANTED DURING CONSTRUCTION AND SHALL BE INCORPORATED INTO THE PROJECT AS REQUIRED OR AS DIRECTED BY THE RESIDENT ENGINEER.
  - EMBANKMENT EROSION TO BE FILLED WITH EARTH BORROW, TOPSOIL AND SEED AND COVERED WITH EROSION MATTING OR AS DIRECTED BY THE RESIDENT ENGINEER.

- 213.0 MILLED BUMBLE STRIPS**  
W.B. STA. 17+540.0 - W.B. STA. 17+740.7 LT (200.7 m)  
W.B. STA. 17+540.0 - W.B. STA. 17+580.9 RT (40.9 m)  
W.B. STA. 17+633.8 - W.B. STA. 17+746.9 RT (113.1 m)  
E.B. STA. 17+522.1 - E.B. STA. 17+563.1 LT (41.0 m)  
E.B. STA. 17+522.1 - E.B. STA. 17+742.6 RT (220.5 m)  
E.B. STA. 17+618.1 - E.B. STA. 17+736.3 LT (118.2 m)
- 604.40 CHANGE ELEVATION OF DL CB OR MH**  
W.B. STA. 17+617.0 LT  
W.B. STA. 17+747.0 LT  
E.B. STA. 17+599.0 RT  
E.B. STA. 17+730.0 RT
- 616.28 CAST-IN-PLACE CONCRETE CURB, TYPE B**  
W.B. STA. 17+741.7 - W.B. STA. 17+751.6 LT (9.9 m)  
W.B. STA. 17+745.6 - W.B. STA. 17+757.8 RT (12.2 m)  
E.B. STA. 17+735.0 - E.B. STA. 17+747.2 LT (12.2 m)  
E.B. STA. 17+743.6 - E.B. STA. 17+753.5 RT (9.9 m)
- 35 TREATED TIMBER CURB BOARD**  
**616.31 BITUMINOUS CONCRETE CURB, TYPE B**  
W.B. STA. 17+540.0 - W.B. STA. 17+741.7 LT (8.3 ft)  
E.B. STA. 17+522.1 - E.B. STA. 17+743.6 RT (9.1 ft)

- 621.20 STEEL BEAM GUARDRAIL**  
W.B. STA. 17+540.0 - W.B. STA. 17+742.6 LT (202.6 m)  
E.B. STA. 17+522.1 - E.B. STA. 17+744.5 RT (222.4 m)  
E.B. STA. 17+631.8 - E.B. STA. 17+738.2 LT (106.4 m)
- 621.505 MANUFACTURED TERMINAL SECTION (FLARED)**  
E.B. STA. 17+631.8 LT (1EA)
- 621.52 TRAILING END TERMINAL**  
W.B. STA. 17+744.7 - W.B. STA. 17+748.8 RT
- 621.72 GUARDRAIL APPROACH SECTION, NETIC 2 RAIL (MOD.)**  
W.B. STA. 17+742.6 - W.B. STA. 17+751.6 LT  
W.B. STA. 17+748.8 - W.B. STA. 17+757.8 RT  
E.B. STA. 17+738.2 - E.B. STA. 17+747.2 LT  
E.B. STA. 17+744.5 - E.B. STA. 17+753.5 RT
- 621.80 REMOVAL AND DISPOSAL OF GUARDRAIL**  
W.B. STA. 17+540.0 - W.B. STA. 17+751.6 LT (211.6 m)  
W.B. STA. 17+723.8 - W.B. STA. 17+757.8 RT (34.0 m)  
E.B. STA. 17+522.1 - E.B. STA. 17+753.5 RT (231.4 m)  
E.B. STA. 17+683.7 - E.B. STA. 17+747.2 LT (63.5 m)

DATUM	
VERTICAL	NAVD 88
HORIZONTAL	NAD 83 (1992)



PLAN	
SURVEYED BY	C.H.A. & V.S.E. DATE 12/93
DESIGNED BY	D.W.E. DATE 2/04
DRAWN BY	C.A.K. DATE 2/04
CHECKED BY	D.E.G. DATE 2/04
DESIGN FILE NO.	PLAN02.DGN
PROJ. NAME	BENNINGTON - HOOSICK D.P.I. 0146(D) C/6
PROJ. NO.	P.I.N. 1306.60
DWG. NO.	P-2
SHEET 21 OF 83	

FILE NAME: h:\5116\vaet\contract6\plan02.dgn  
DATE/TIME: 2/19/2004 10:22:25  
USER: JLS




**LEGEND**

- SILT FENCE
- SILT FENCE FOR DRAINAGE STRUCTURE PROTECTION
- EROSION MATTING, (SEE NOTE 3)

\*SEE NOTE 2

CURVE E-2		CURVE E-1	
P.C.= STA. E2+284.58	P.T.= STA. E2+471.417	P.C.= STA. F2+029.688	P.T.= STA. F2+100.615
Δ= 72°34'42.0" RT	R= 147.828 m	Δ= 19°21'06.0" RT	R= 210.000 m
T= 108.547 m	L= 187.258 m	T= 35.805 m	L= 70.927 m
E= 35.572 m	max=N/A	E= 3.030 m	max=N/A

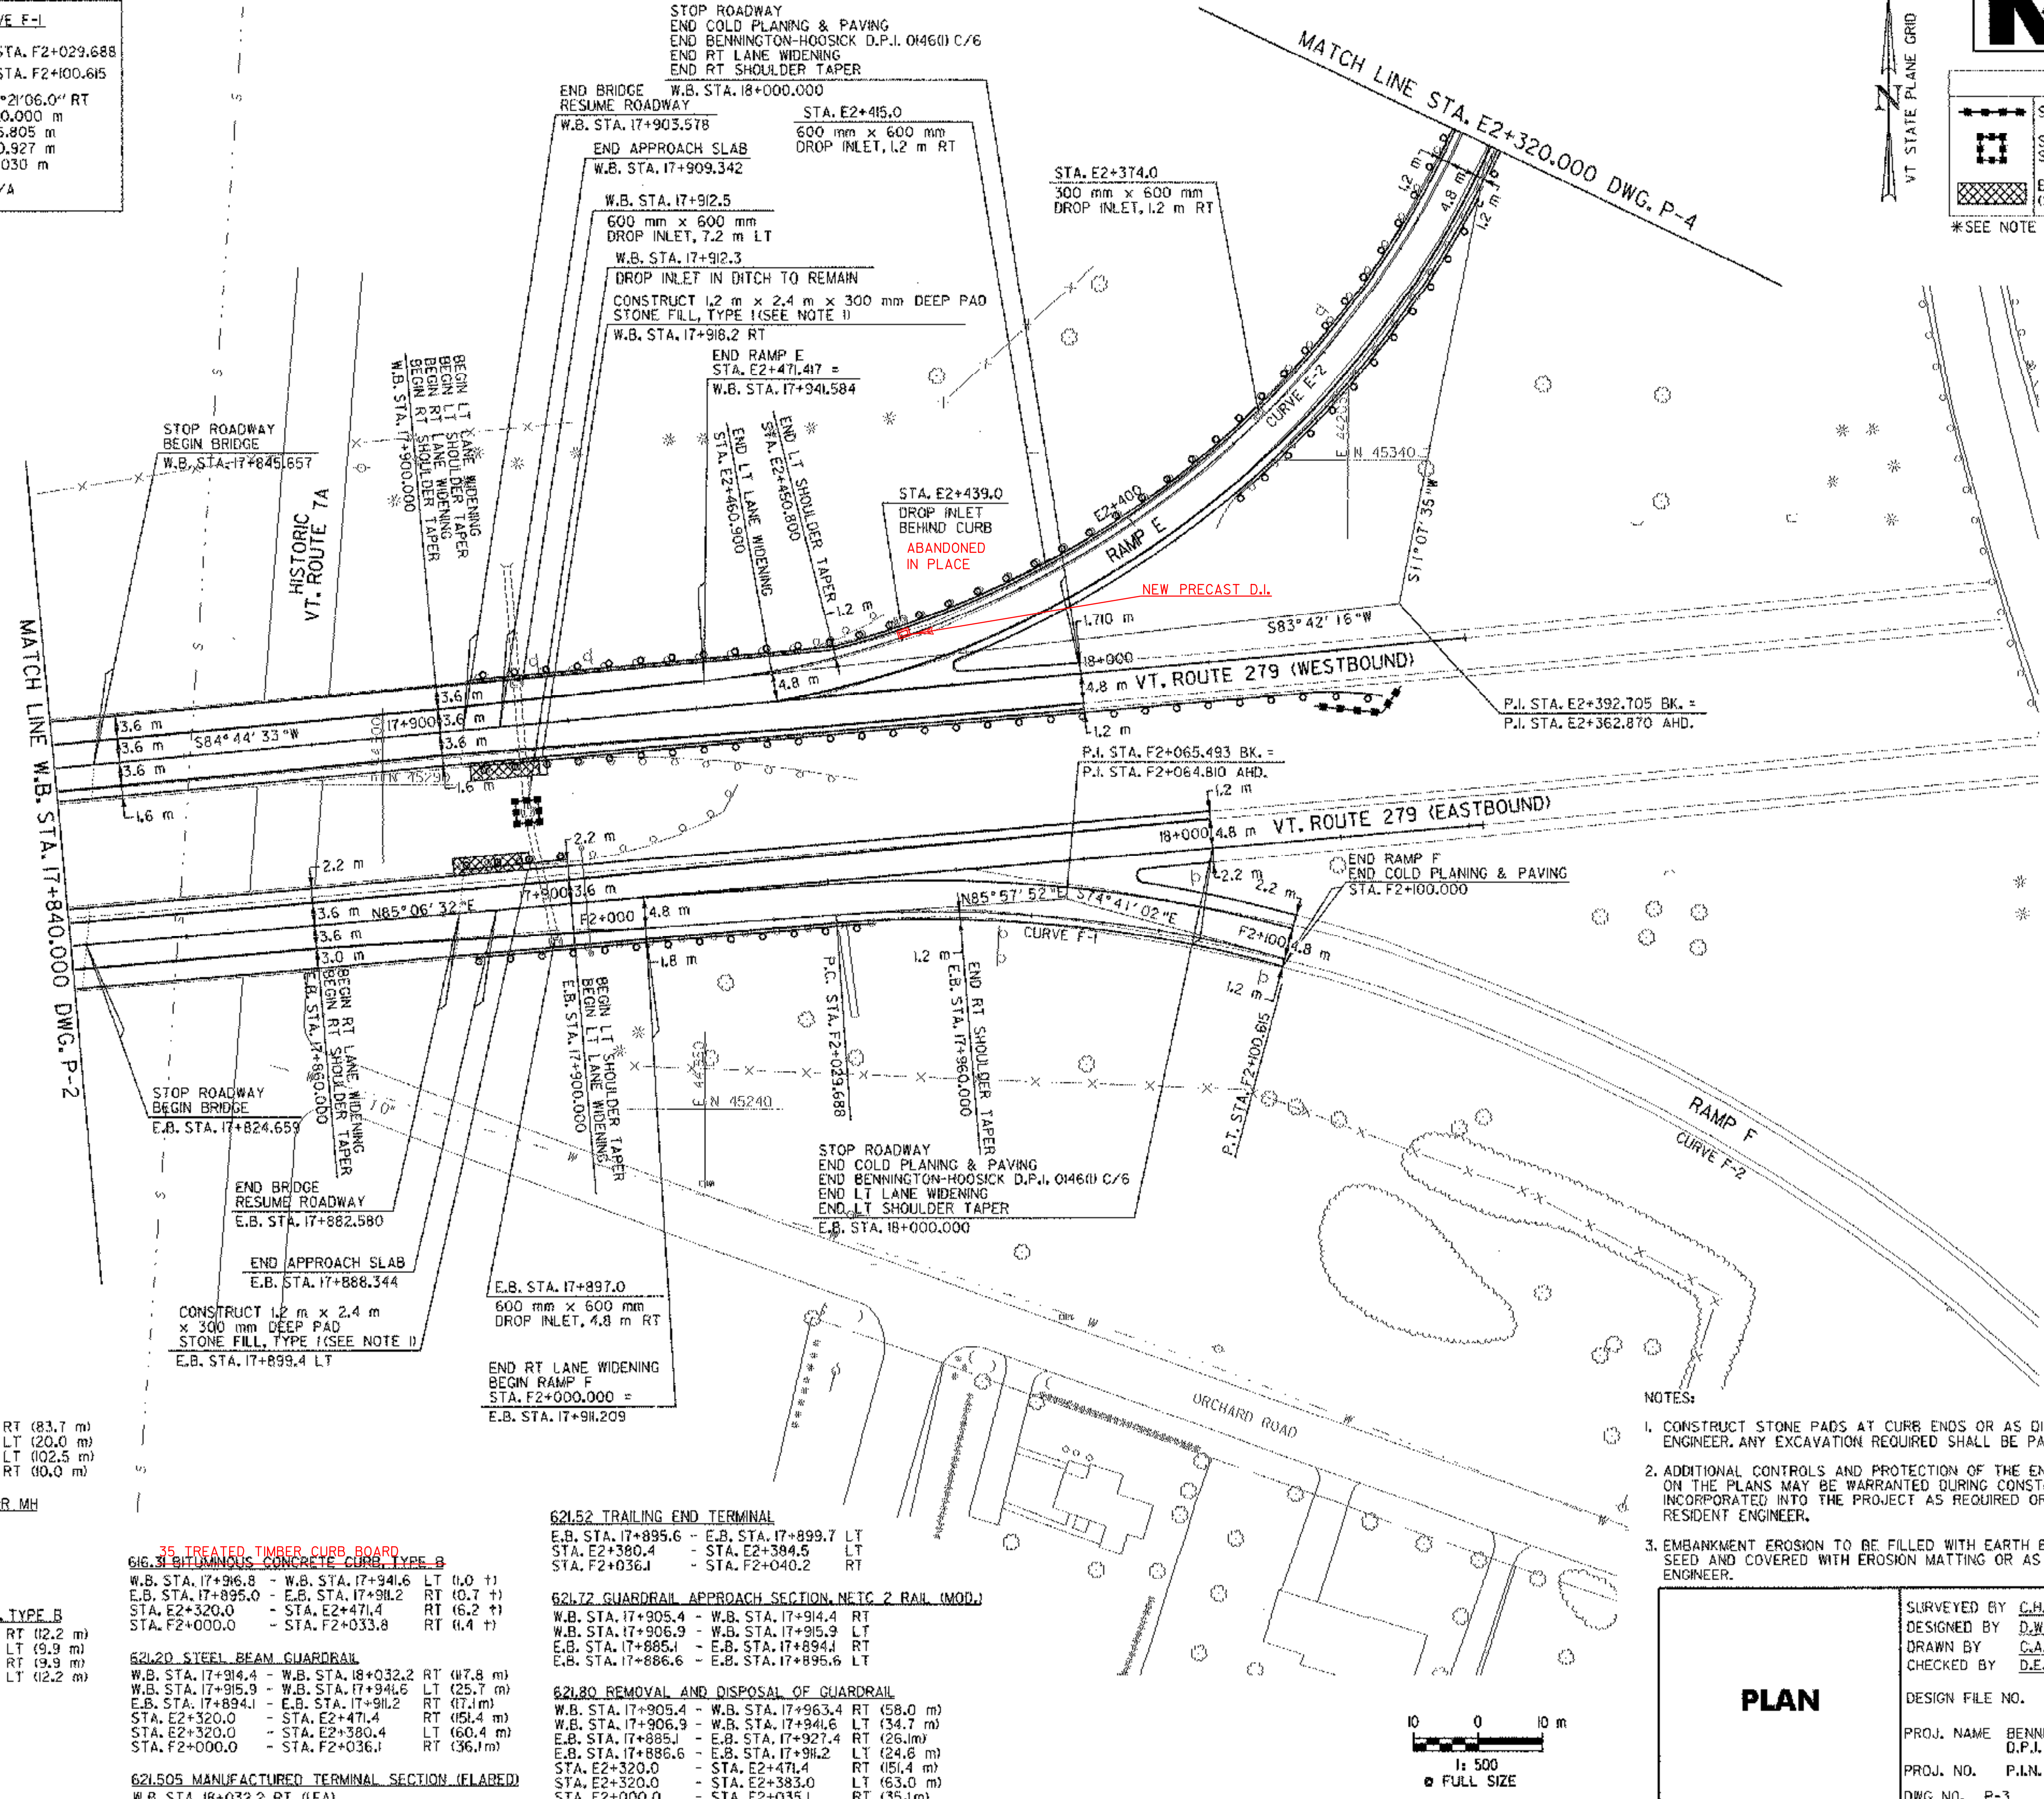

- 213.10 MILLED RUMBLE STRIPS**  
W.B. STA. 17+916.3 - W.B. STA. 18+000.0 RT (83.7 m)  
W.B. STA. 17+980.0 - W.B. STA. 18+000.0 LT (20.0 m)  
E.B. STA. 17+897.5 - E.B. STA. 18+000.0 RT (102.5 m)  
E.B. STA. 17+990.0 - E.B. STA. 18+000.0 LT (100.0 m)
- 604.40 CHANGE ELEVATION OF DI, CB OR MH**  
W.B. STA. 17+912.5 LT  
E.B. STA. 17+897.0 RT  
STA. E2+374.0 RT  
STA. E2+415.0 RT  
STA. E2+439.0 RT
- 616.28 CAST-IN-PLACE CONCRETE CURB, TYPE B**  
W.B. STA. 17+905.4 - W.B. STA. 17+917.6 RT (12.2 m)  
W.B. STA. 17+906.9 - W.B. STA. 17+916.8 LT (9.9 m)  
E.B. STA. 17+885.1 - E.B. STA. 17+895.0 RT (9.9 m)  
E.B. STA. 17+886.6 - E.B. STA. 17+898.8 LT (12.2 m)


- 35 TREATED TIMBER CURB BOARD**  
**616.31 BITUMINOUS CONCRETE CURB, TYPE B**  
W.B. STA. 17+916.8 - W.B. STA. 17+941.6 LT (10.7 m)  
E.B. STA. 17+895.0 - E.B. STA. 17+911.2 RT (10.7 m)  
STA. E2+320.0 - STA. E2+471.4 RT (16.2 m)  
STA. F2+000.0 - STA. F2+033.8 RT (11.4 m)
- 621.20 STEEL BEAM GUARDRAIL**  
W.B. STA. 17+914.4 - W.B. STA. 18+032.2 RT (117.8 m)  
W.B. STA. 17+915.9 - W.B. STA. 17+941.6 LT (25.7 m)  
E.B. STA. 17+894.1 - E.B. STA. 17+911.2 RT (17.1 m)  
STA. E2+320.0 - STA. E2+471.4 RT (151.4 m)  
STA. E2+320.0 - STA. E2+380.4 LT (60.4 m)  
STA. F2+000.0 - STA. F2+036.1 RT (36.1 m)
- 621.505 MANUFACTURED TERMINAL SECTION (FLARED)**  
W.B. STA. 18+032.2 RT (EA)

- 621.52 TRAILING END TERMINAL**  
E.B. STA. 17+895.6 - E.B. STA. 17+899.7 LT  
STA. E2+380.4 - STA. E2+384.5 LT  
STA. F2+036.1 - STA. F2+040.2 RT
- 621.72 GUARDRAIL APPROACH SECTION, NETC 2 RAIL (MOD.)**  
W.B. STA. 17+905.4 - W.B. STA. 17+914.4 RT  
W.B. STA. 17+906.9 - W.B. STA. 17+915.9 LT  
E.B. STA. 17+885.1 - E.B. STA. 17+894.1 RT  
E.B. STA. 17+886.6 - E.B. STA. 17+895.6 LT
- 621.80 REMOVAL AND DISPOSAL OF GUARDRAIL**  
W.B. STA. 17+905.4 - W.B. STA. 17+963.4 RT (58.0 m)  
W.B. STA. 17+906.9 - W.B. STA. 17+941.6 LT (34.7 m)  
E.B. STA. 17+885.1 - E.B. STA. 17+927.4 RT (26.1 m)  
E.B. STA. 17+886.6 - E.B. STA. 17+911.2 LT (24.6 m)  
STA. E2+320.0 - STA. E2+471.4 RT (151.4 m)  
STA. E2+320.0 - STA. E2+383.0 LT (63.0 m)  
STA. F2+000.0 - STA. F2+035.1 RT (35.1 m)

- NOTES:**
- CONSTRUCT STONE PADS AT CURB ENDS OR AS DIRECTED BY THE RESIDENT ENGINEER. ANY EXCAVATION REQUIRED SHALL BE PAID FOR UNDER ITEM 608.25.
  - ADDITIONAL CONTROLS AND PROTECTION OF THE ENVIRONMENT NOT SHOWN ON THE PLANS MAY BE WARRANTED DURING CONSTRUCTION AND SHALL BE INCORPORATED INTO THE PROJECT AS REQUIRED OR AS DIRECTED BY THE RESIDENT ENGINEER.
  - EMBANKMENT EROSION TO BE FILLED WITH EARTH BORROW, TOPSOIL AND SEED AND COVERED WITH EROSION MATTING OR AS DIRECTED BY THE RESIDENT ENGINEER.

**DATUM**

VERTICAL	NAVD 88
HORIZONTAL	NAID 83 (1992)

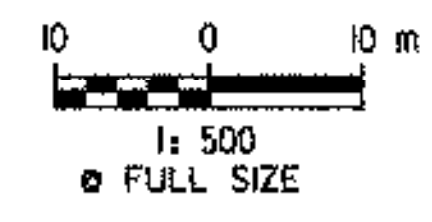

**PLAN**

SURVEYED BY C.H.A. & V.S.E. DATE 12/93  
DESIGNED BY D.W.E. DATE 2/04  
DRAWN BY C.A.K. DATE 2/04  
CHECKED BY D.E.G. DATE 2/04

DESIGN FILE NO. PLAN03.DGN

PROJ. NAME BENNINGTON - HOOSICK  
D.P.I. 0460) C/6

PROJ. NO. P.I.N. 1306.60

DWG. NO. P-3 SHEET 22 OF 83


FILE NAME = usn5116\vaot\contract6\p1er23.dgn  
DATE/TIME = 2/18/2004  
USER = 2225

CURVE E-1	CURVE E-2
P.C.= STA. E2+000.000	P.C.= STA. E2+284.158
P.T.= STA. E2+072.385	P.T.= STA. E2+171.417
$\Delta=09^{\circ}43'09.0''$ RT	$\Delta=72^{\circ}34'42.0''$ RT
R=426.720 m	R=147.828 m
T=36.279 m	T=108.547 m
L=72.385 m	L=187.258 m
E=1.538 m	E=35.572 m
$e_{max}=N/A$	$e_{max}=N/A$



LEGEND	
	SILT FENCE
	SILT FENCE FOR DRAINAGE STRUCTURE PROTECTION
	EROSION MATTING, (SEE NOTE 2)

\*SEE NOTE 1

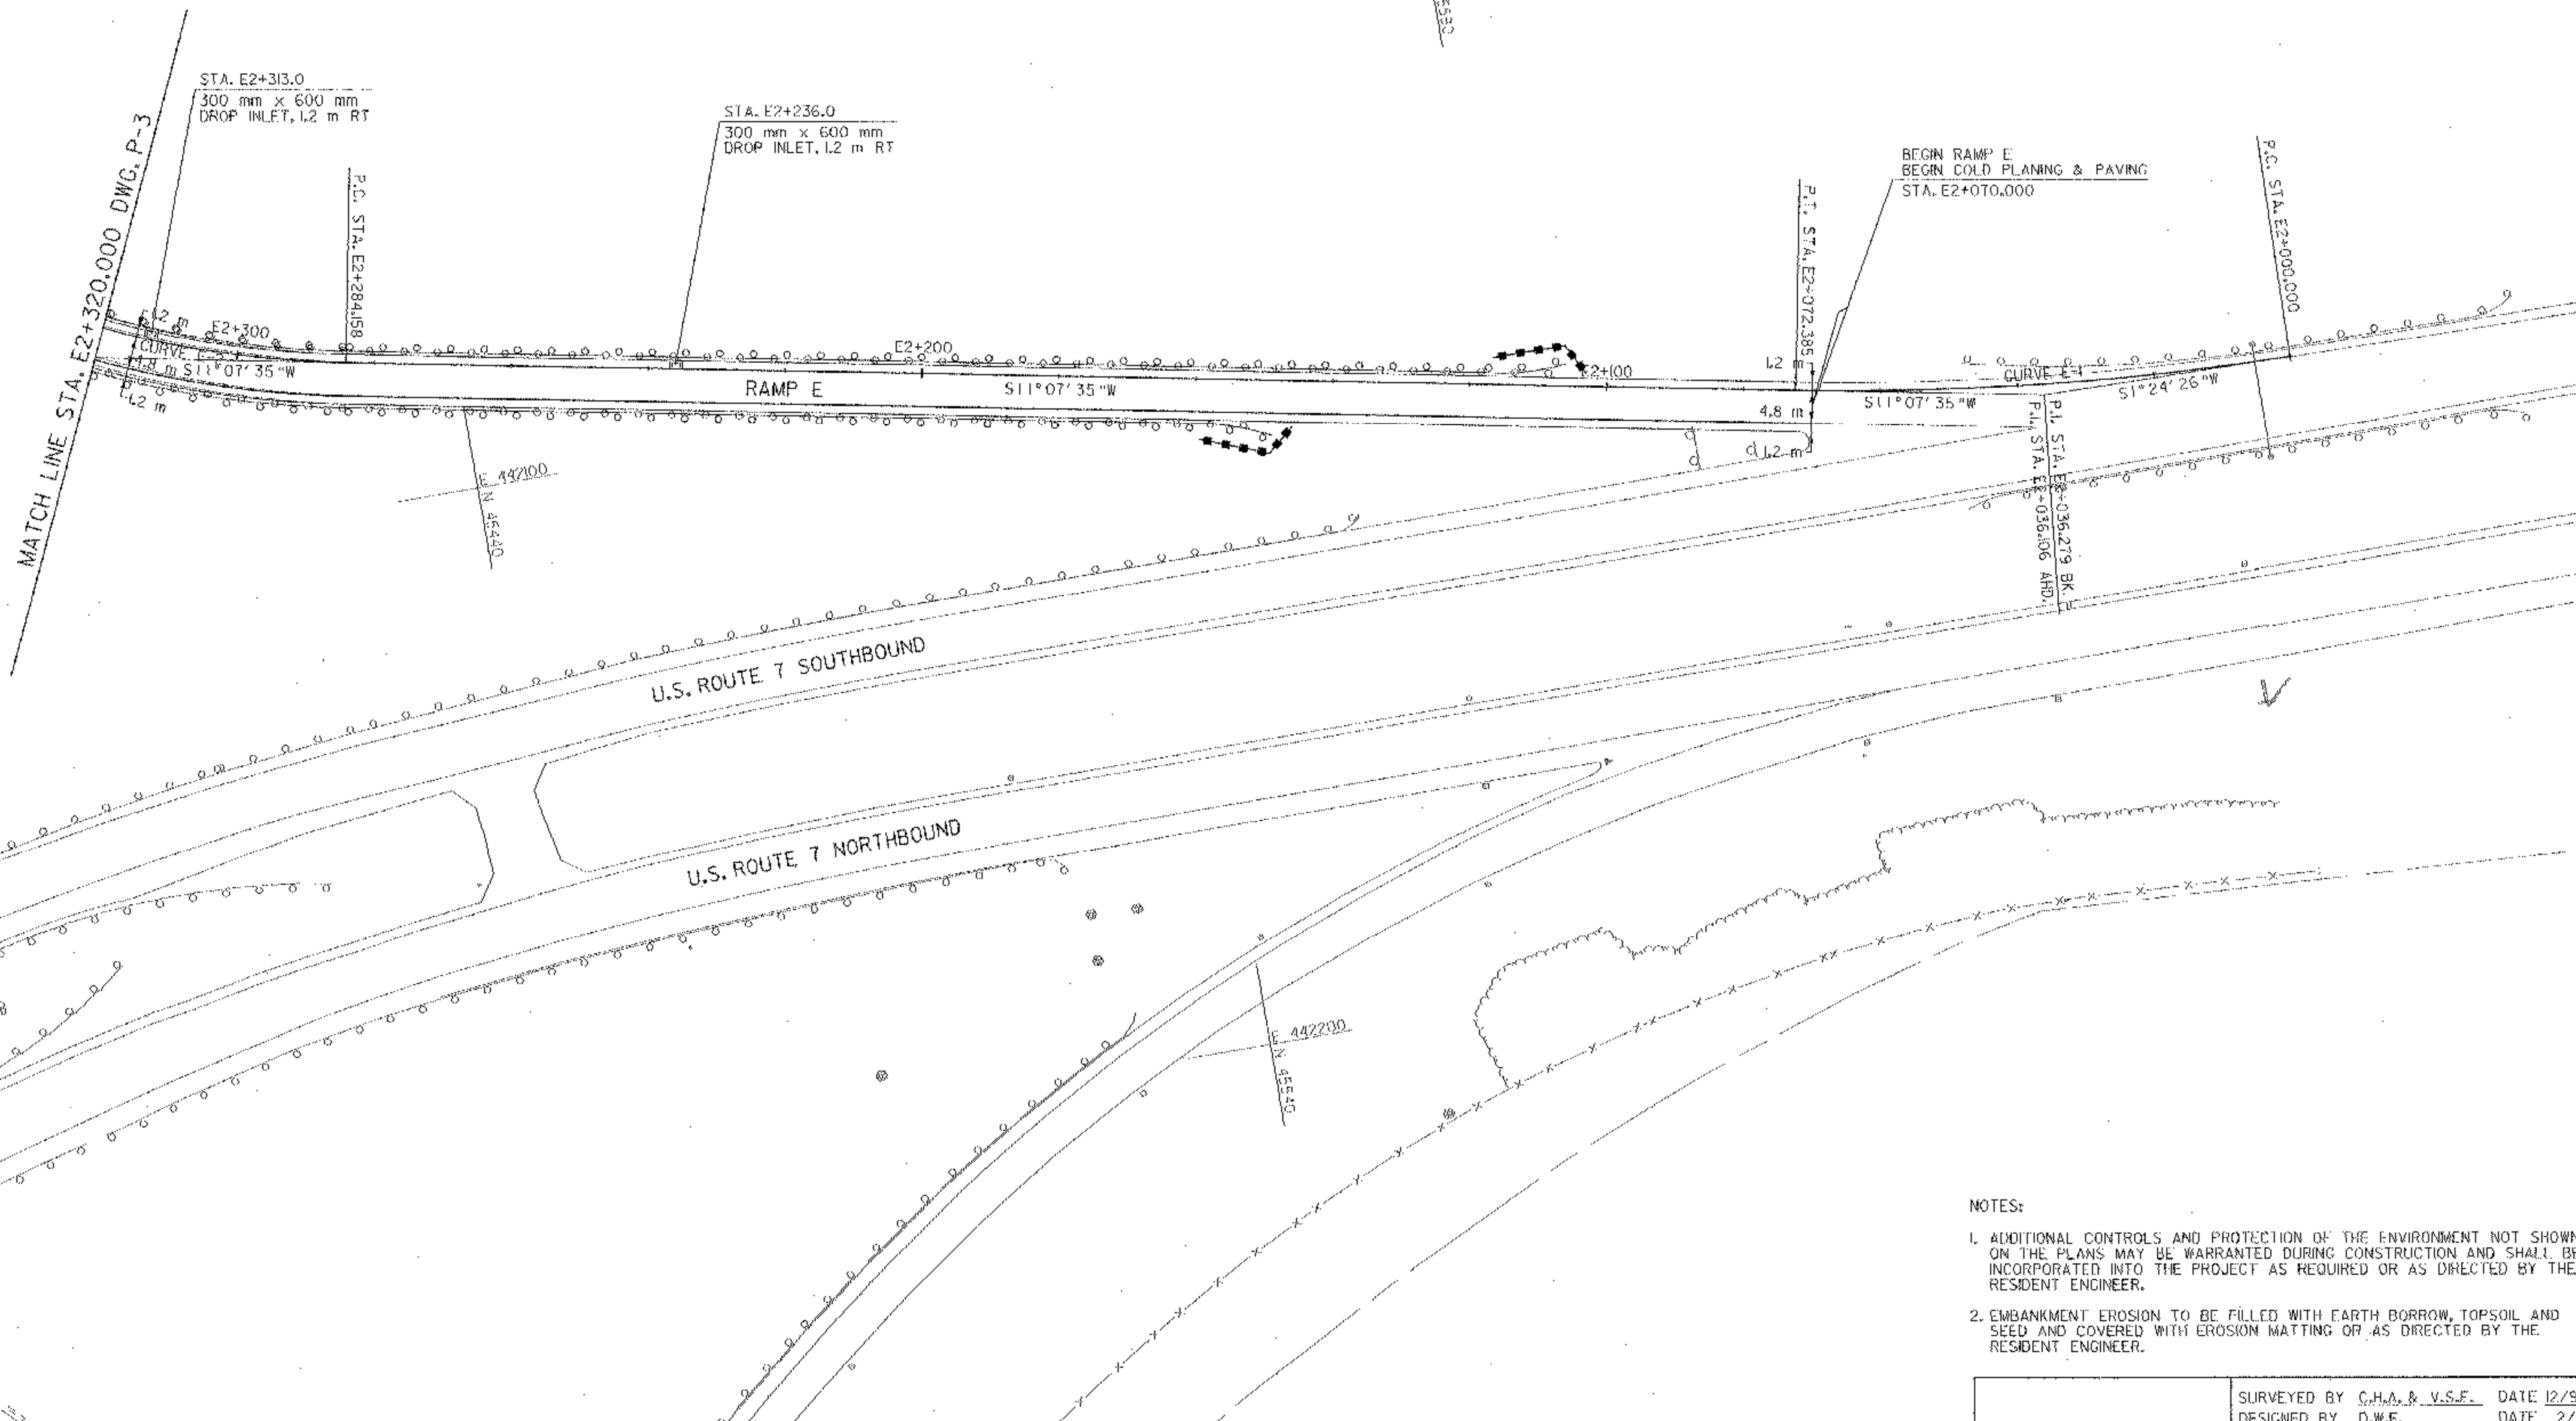


FILE NAME = \\s116\vaot\centr\act\6\plan04.dgn  
 DATE/TIME = 2/16/2004  
 USER = 2225


DATUM	
VERTICAL	NAVD 88
HORIZONTAL	NAD 83 (1982)

- 604.40 CHANGE ELEVATION OF DL CB OR MI  
 STA. E2+236.0 RT  
 STA. E2+313.0 RT  
 35 TREATED TIMBER CURB  
 616.31 BITUMINOUS CONCRETE CURB TYPE B  
 STA. E2+156.2 - STA. E2+320.0 (6.7 ft)
- 621.80 STEEL BEAM GUARDRAIL  
 STA. E2+113.5 - STA. E2+320.0 RT (206.7 m)  
 STA. E2+160.0 - STA. E2+320.0 LT (160.0 m)
- 621.505 MANUFACTURED TERMINAL SECTION (FLARED)  
 STA. E2+113.3 RT (1EA)  
 STA. E2+160.0 LT (1EA)
- 621.80 REMOVAL AND DISPOSAL OF GUARDRAIL  
 STA. E2+109.0 - STA. E2+320.0 RT (211.0 m)  
 STA. E2+150.0 - STA. E2+320.0 LT (170.0 m)

- NOTES:
- ADDITIONAL CONTROLS AND PROTECTION OF THE ENVIRONMENT NOT SHOWN ON THE PLANS MAY BE WARRANTED DURING CONSTRUCTION AND SHALL BE INCORPORATED INTO THE PROJECT AS REQUIRED OR AS DIRECTED BY THE RESIDENT ENGINEER.
  - EMBANKMENT EROSION TO BE FILLED WITH EARTH BORROW, TOPSOIL AND SEED AND COVERED WITH EROSION MATTING OR AS DIRECTED BY THE RESIDENT ENGINEER.

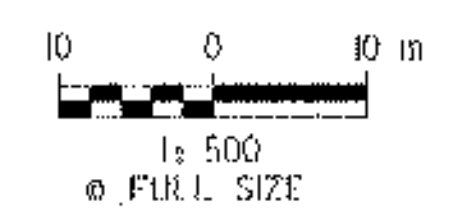

PLAN	
SURVEYED BY	C.H.A. & V.S.F. DATE 12/93
DESIGNED BY	D.W.E. DATE 2/04
DRAWN BY	C.A.K. DATE 2/04
CHECKED BY	D.E.G. DATE 2/04
DESIGN FILE NO.	PLAN04.DGN
PROJ. NAME	BENNINGTON - HOOSICK D.P.L. 014611) C/6
PROJ. NO.	P.I.N. 1305.60
DWG NO.	P-4
SHEET 23 OF 83	

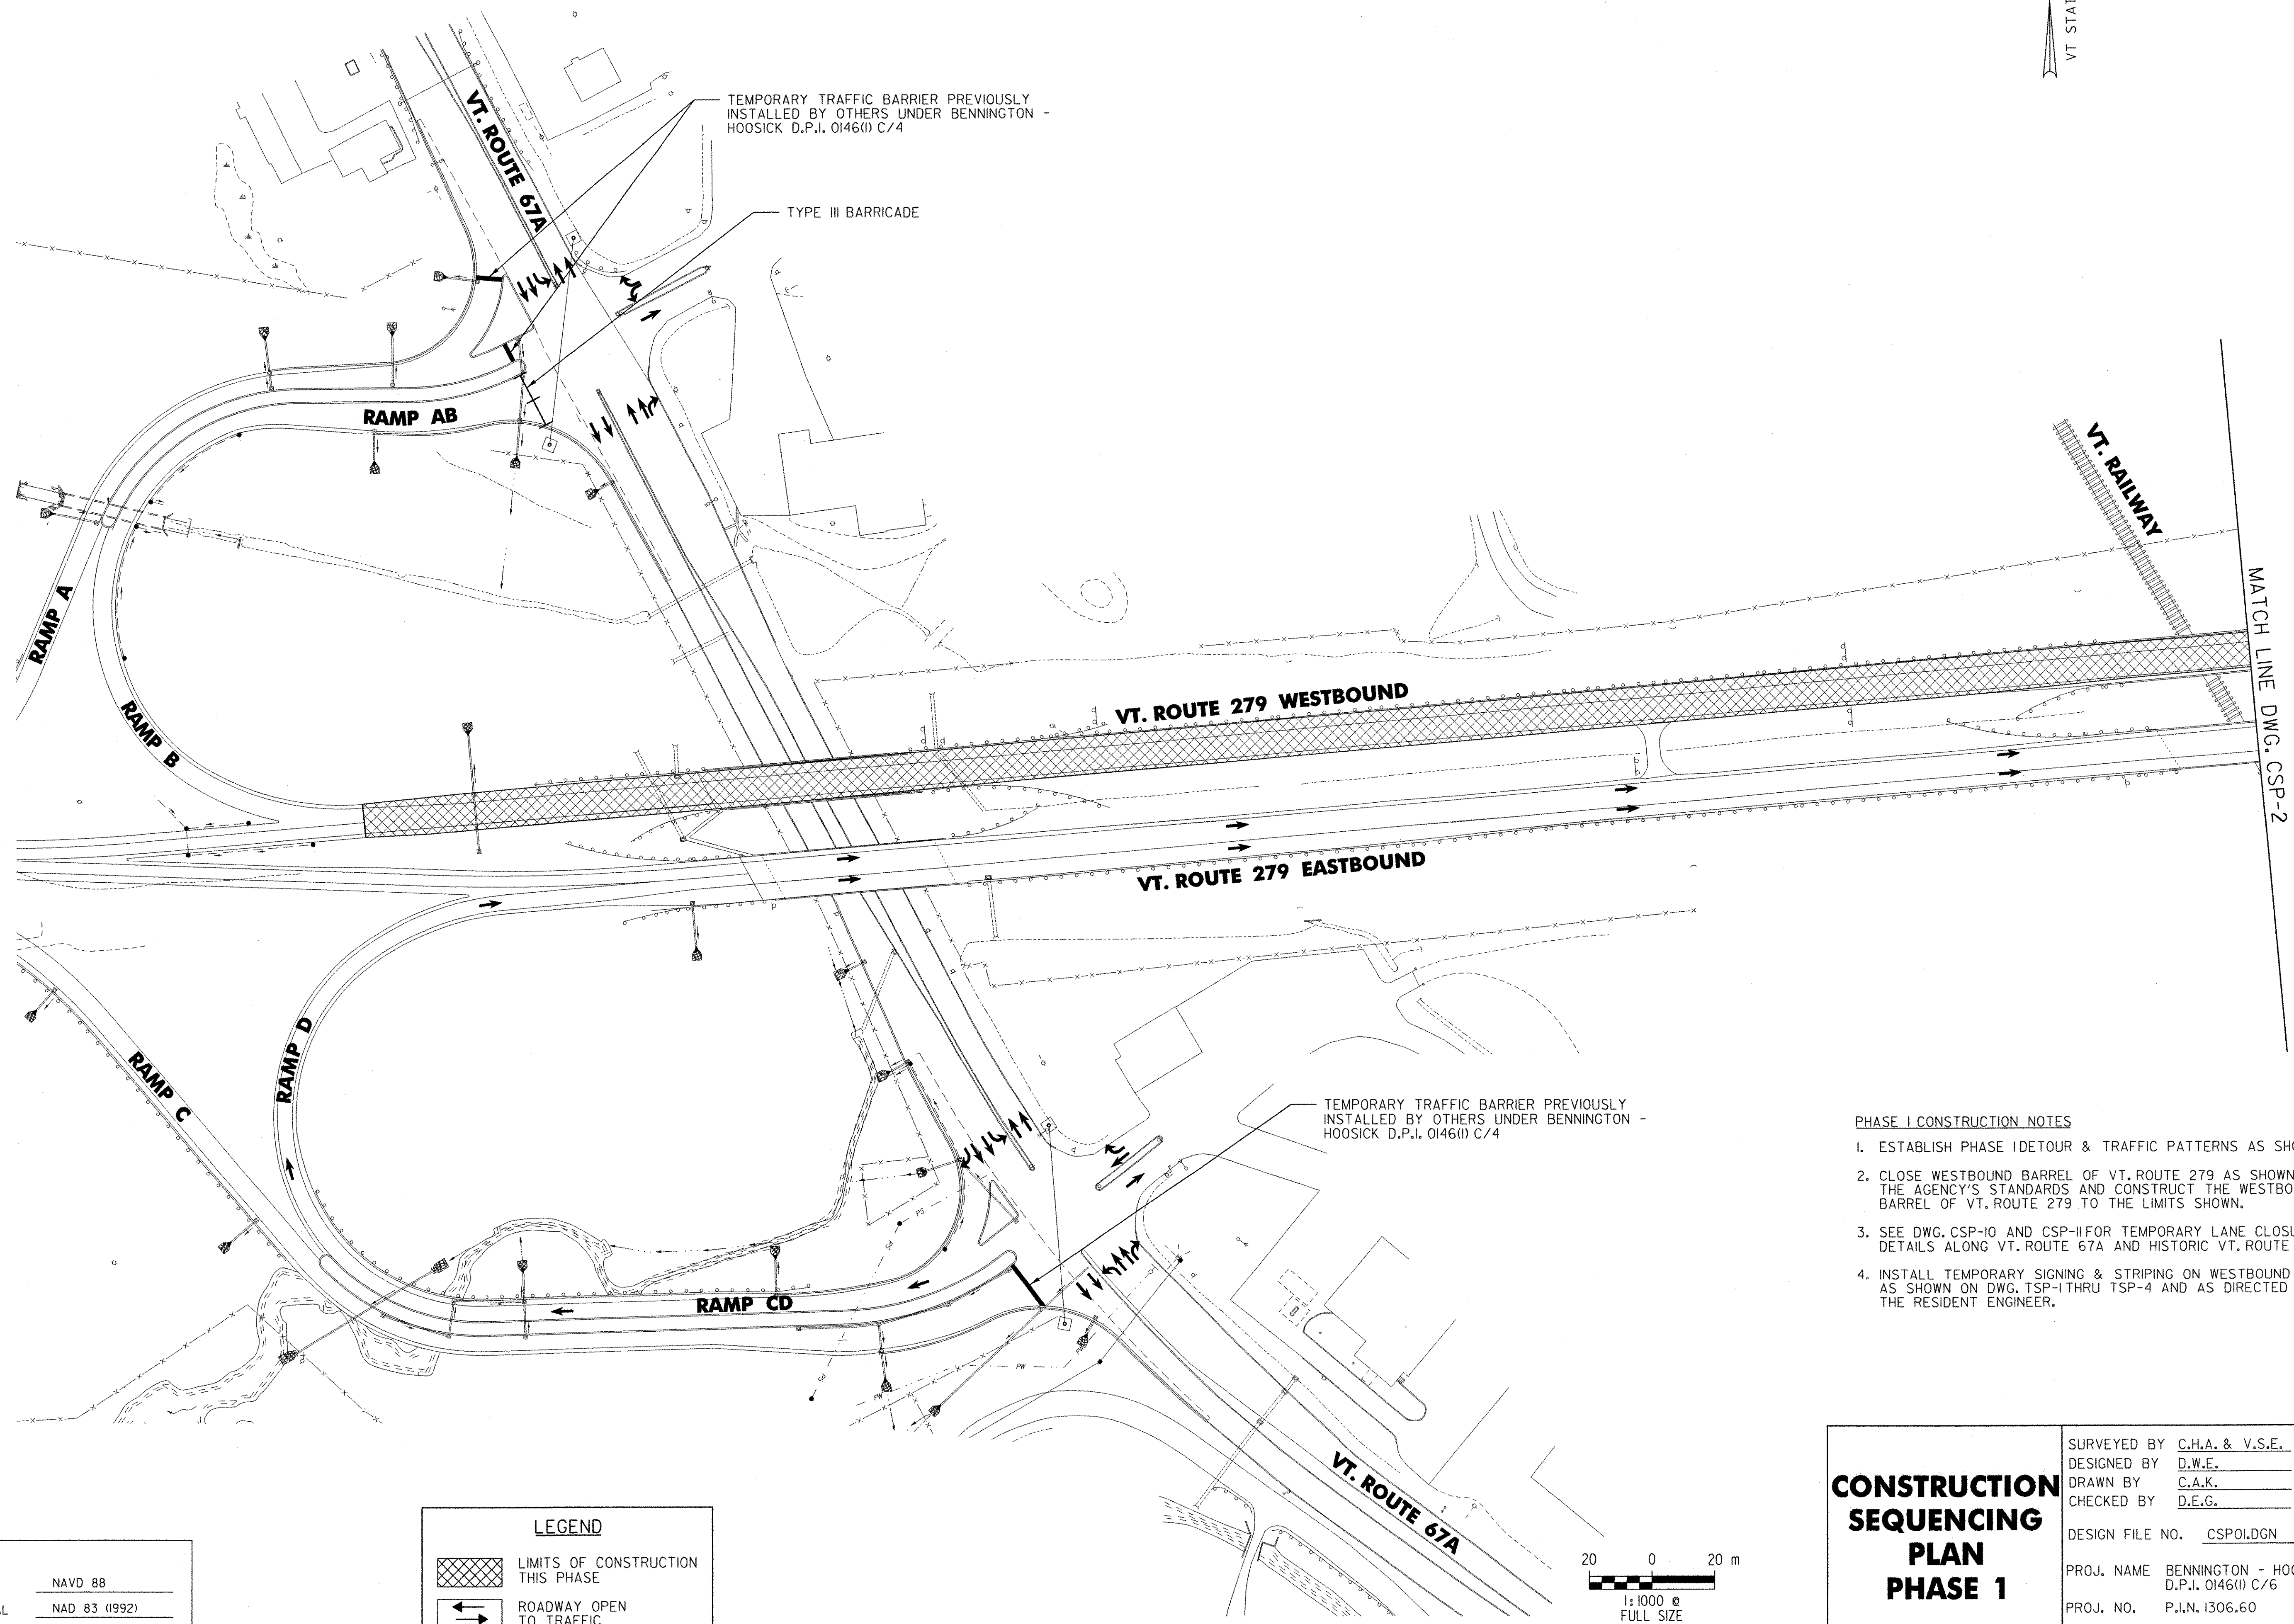

TEMPORARY TRAFFIC BARRIER PREVIOUSLY  
INSTALLED BY OTHERS UNDER BENNINGTON -  
HOOSICK D.P.I. 0146(I) C/4

TYPE III BARRICADE


MATCH LINE DWG. CSP-2

TEMPORARY TRAFFIC BARRIER PREVIOUSLY  
INSTALLED BY OTHERS UNDER BENNINGTON -  
HOOSICK D.P.I. 0146(I) C/4

**PHASE I CONSTRUCTION NOTES**

1. ESTABLISH PHASE I DETOUR & TRAFFIC PATTERNS AS SHOWN.
2. CLOSE WESTBOUND BARREL OF VT. ROUTE 279 AS SHOWN AND PER THE AGENCY'S STANDARDS AND CONSTRUCT THE WESTBOUND BARREL OF VT. ROUTE 279 TO THE LIMITS SHOWN.
3. SEE DWG. CSP-10 AND CSP-11 FOR TEMPORARY LANE CLOSURE DETAILS ALONG VT. ROUTE 67A AND HISTORIC VT. ROUTE 7A.
4. INSTALL TEMPORARY SIGNING & STRIPING ON WESTBOUND BARREL AS SHOWN ON DWG. TSP-1 THRU TSP-4 AND AS DIRECTED BY THE RESIDENT ENGINEER.

LEGEND	
	LIMITS OF CONSTRUCTION THIS PHASE
	ROADWAY OPEN TO TRAFFIC


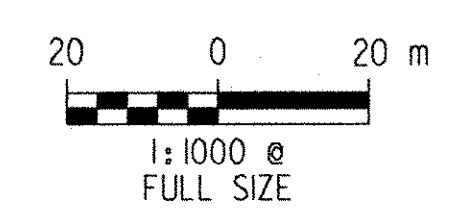


**CONSTRUCTION SEQUENCING PLAN PHASE 1**

SURVEYED BY	C.H.A. & V.S.E.	DATE	12/93
DESIGNED BY	D.W.E.	DATE	2/04
DRAWN BY	C.A.K.	DATE	2/04
CHECKED BY	D.E.G.	DATE	2/04
DESIGN FILE NO.	CSP01.DGN		
PROJ. NAME	BENNINGTON - HOOSICK D.P.I. 0146(I) C/6		
PROJ. NO.	P.I.N. 1306.60		
DWG NO.	CSP-1	SHEET	24 OF 83

FILE NAME = ur\5116\vaot\contract6\csp01.dgn  
DATE/TIME = 2/16/2004  
USER = 2225


DATUM	
VERTICAL	NAVD 88
HORIZONTAL	NAD 83 (1992)

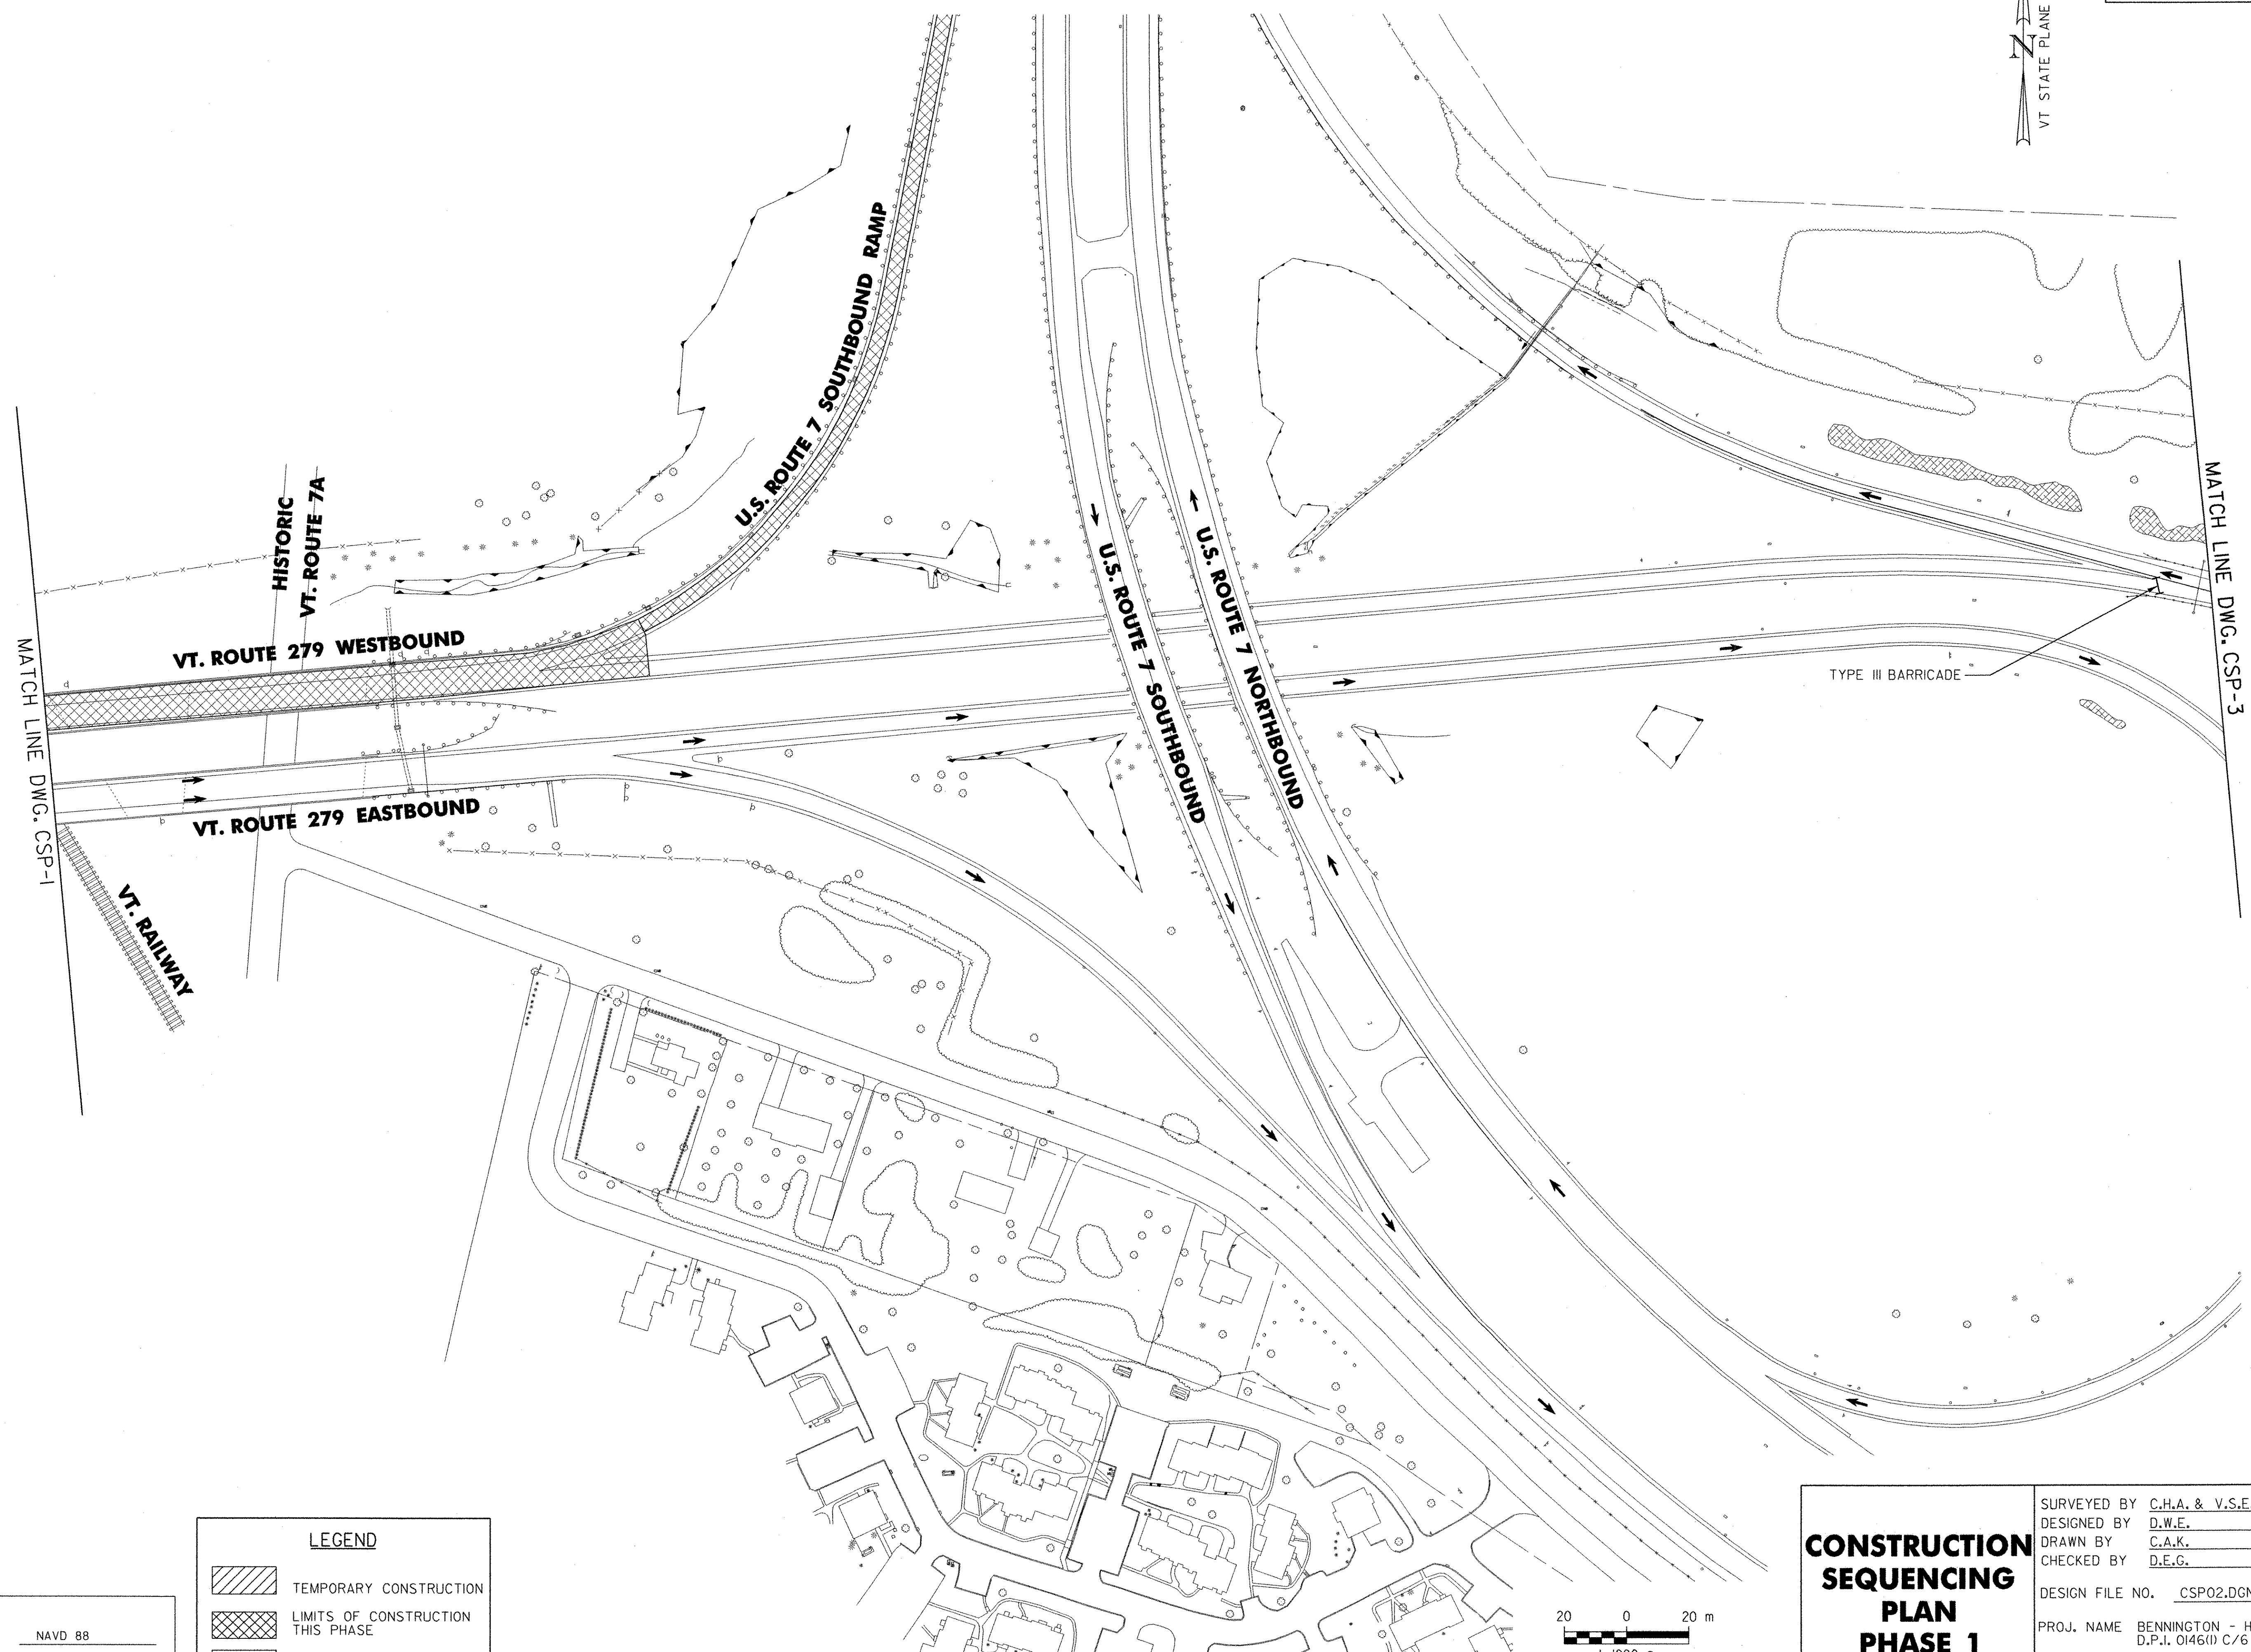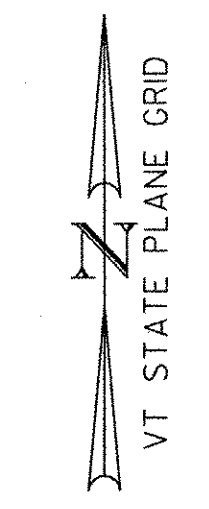

FILE NAME = u:\5116\vgot\cont-act6\esp02.dgn  
 DATE / TIME = 02/2004  
 USER = 2225


DATUM	
VERTICAL	NAVD 88
HORIZONTAL	NAD 83 (1992)

LEGEND	
	TEMPORARY CONSTRUCTION
	LIMITS OF CONSTRUCTION THIS PHASE
	ROADWAY OPEN TO TRAFFIC

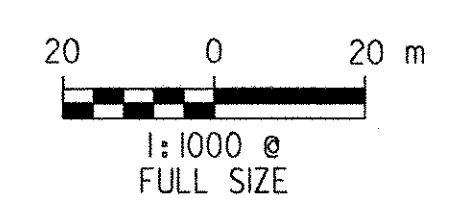

**CONSTRUCTION SEQUENCING PLAN PHASE 1**

SURVEYED BY	C.H.A. & V.S.E.	DATE	12/93
DESIGNED BY	D.W.E.	DATE	2/04
DRAWN BY	C.A.K.	DATE	2/04
CHECKED BY	D.E.G.	DATE	2/04
DESIGN FILE NO.	CSP02.DGN		
PROJ. NAME	BENNINGTON - HOOSICK D.P.I. 0146(I) C/6		
PROJ. NO.	P.I.N. 1306.60		
DWG NO.	CSP-2	SHEET	25 OF 83

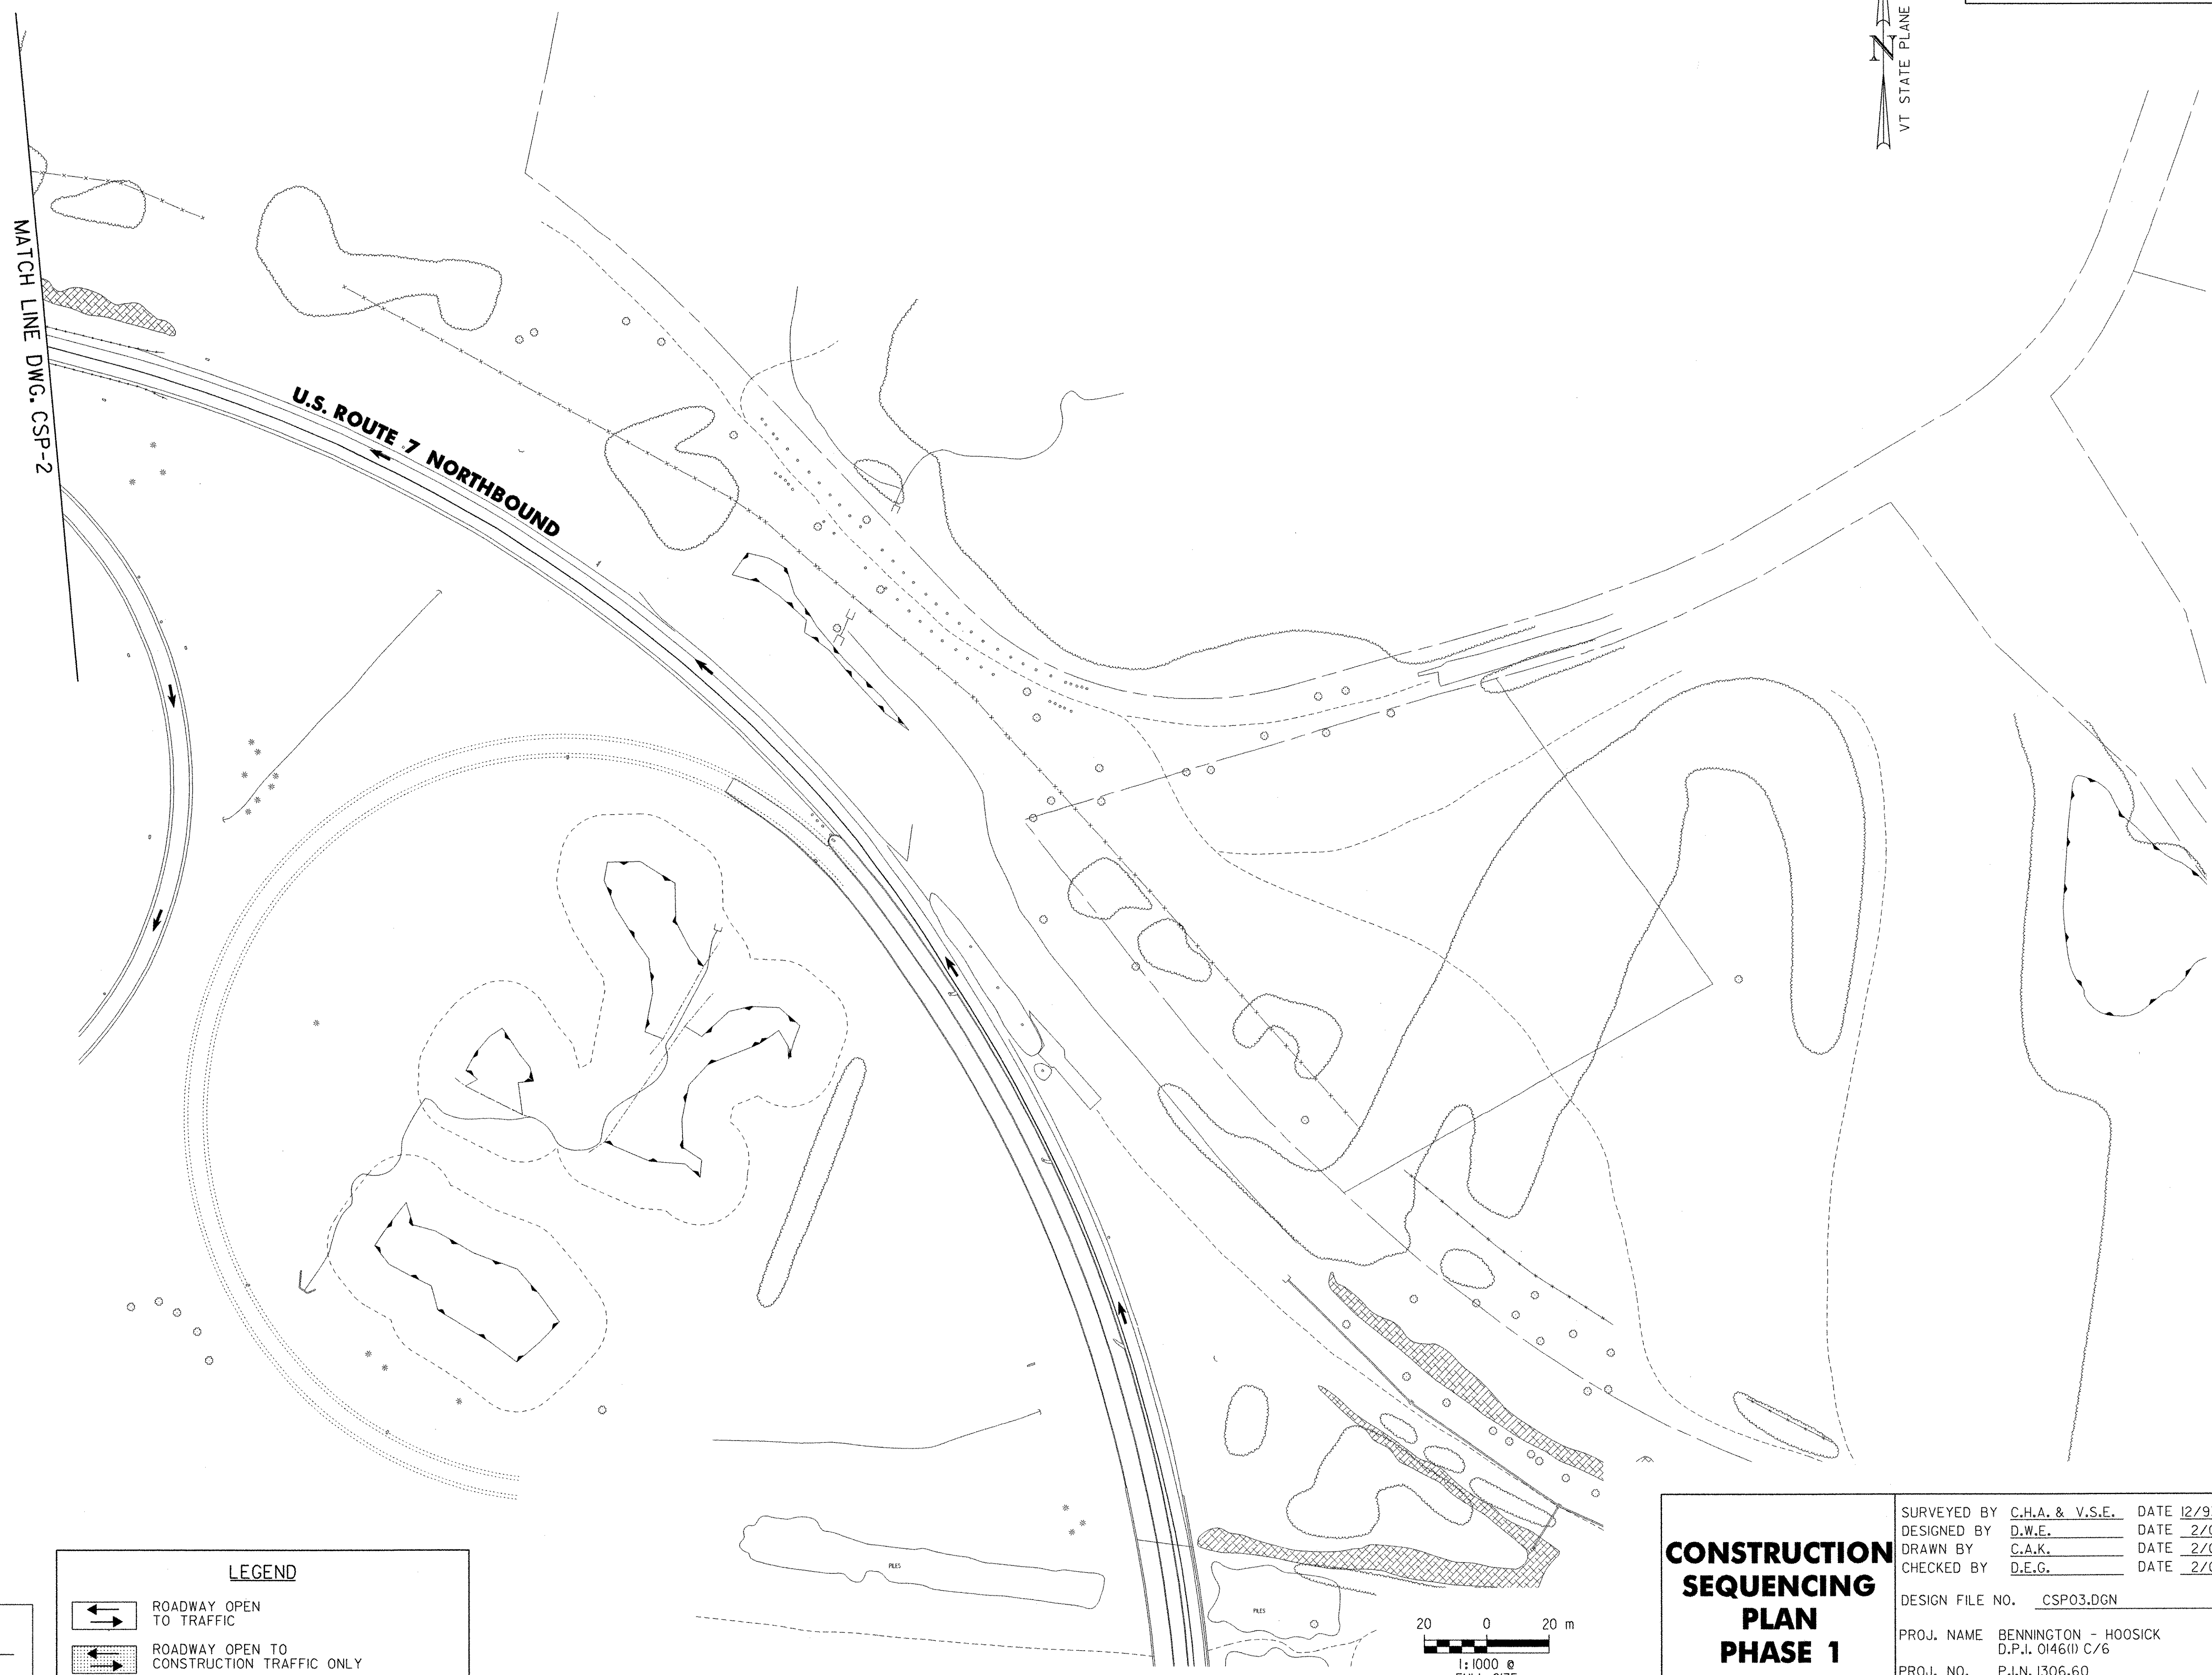


FILE NAME = ut:\5116\svect\contract6\csp03.dgn  
 DATE / TIME = 2/17/2004  
 USER = ZZZ3

DATUM	
VERTICAL	NAVD 88
HORIZONTAL	NAD 83 (1992)

**LEGEND**

	ROADWAY OPEN TO TRAFFIC
	ROADWAY OPEN TO CONSTRUCTION TRAFFIC ONLY








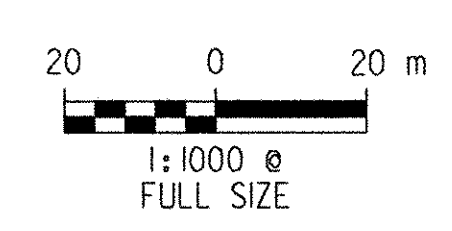


**CONSTRUCTION SEQUENCING PLAN PHASE 1**













SURVEYED BY	C.H.A. & V.S.E.	DATE	12/93
DESIGNED BY	D.W.E.	DATE	2/04
DRAWN BY	C.A.K.	DATE	2/04
CHECKED BY	D.E.G.	DATE	2/04
DESIGN FILE NO.	CSP03.DGN		
PROJ. NAME	BENNINGTON - HOOSICK D.P.I. 0146(II) C/6		
PROJ. NO.	P.I.N. 1306.60		
DWG NO.	CSP-3	SHEET	26 OF 83



### DETOUR 1

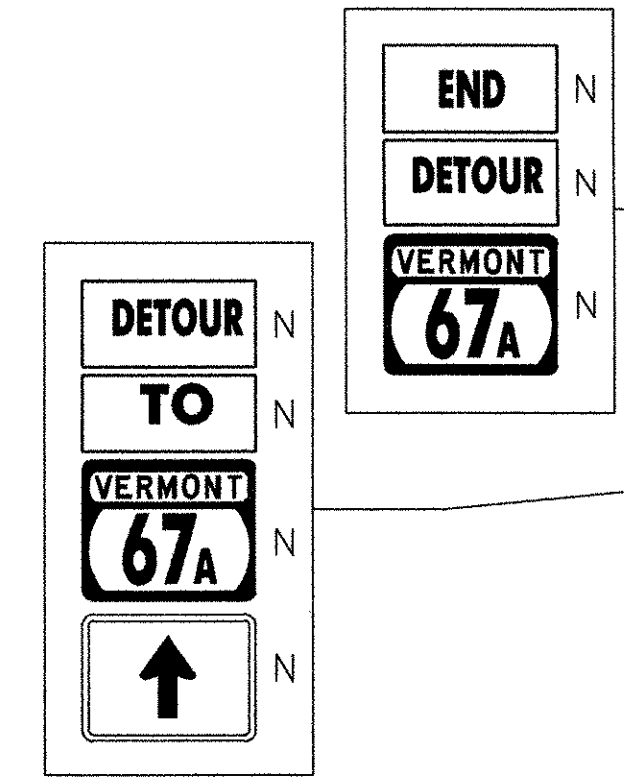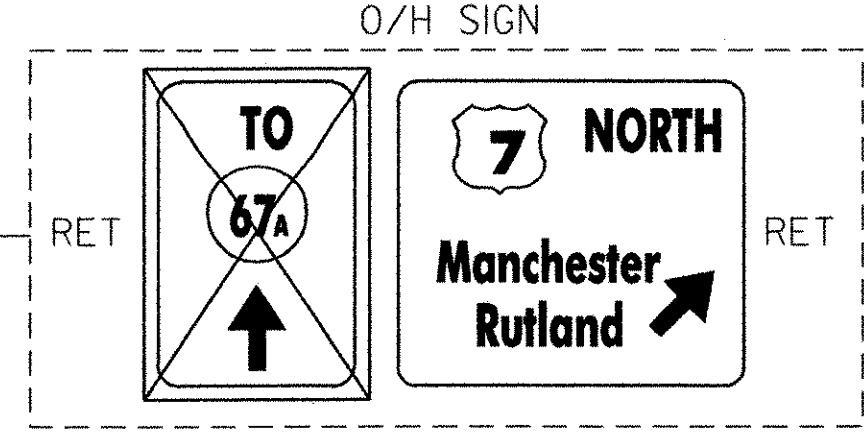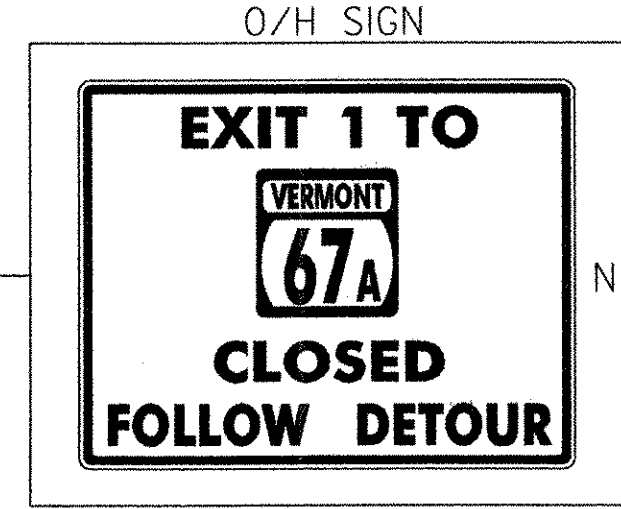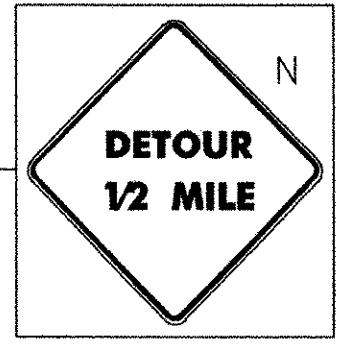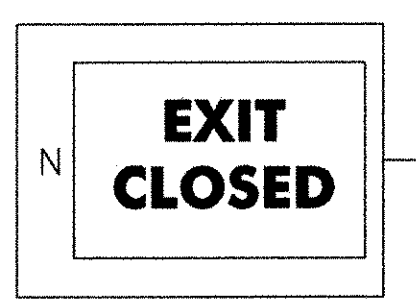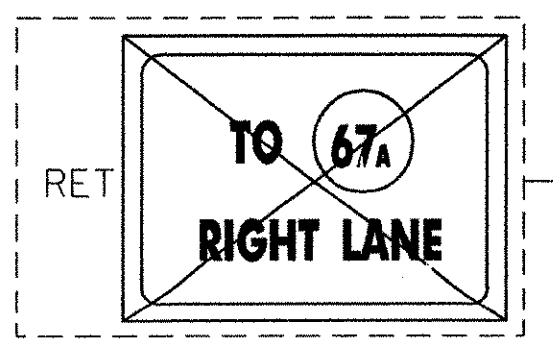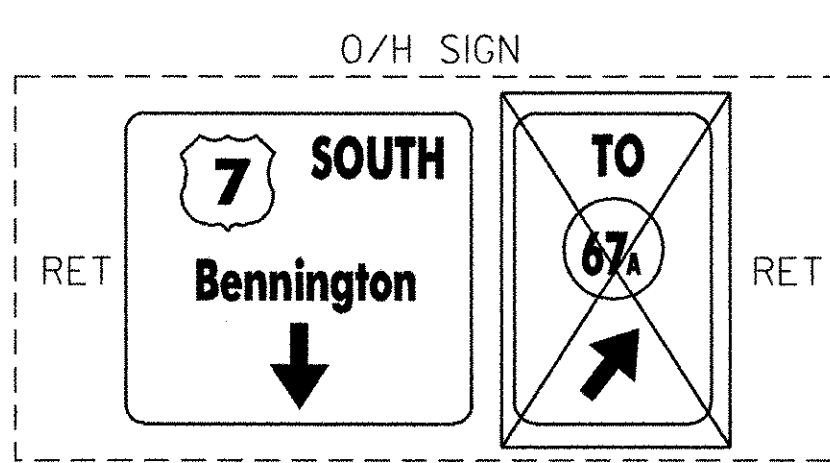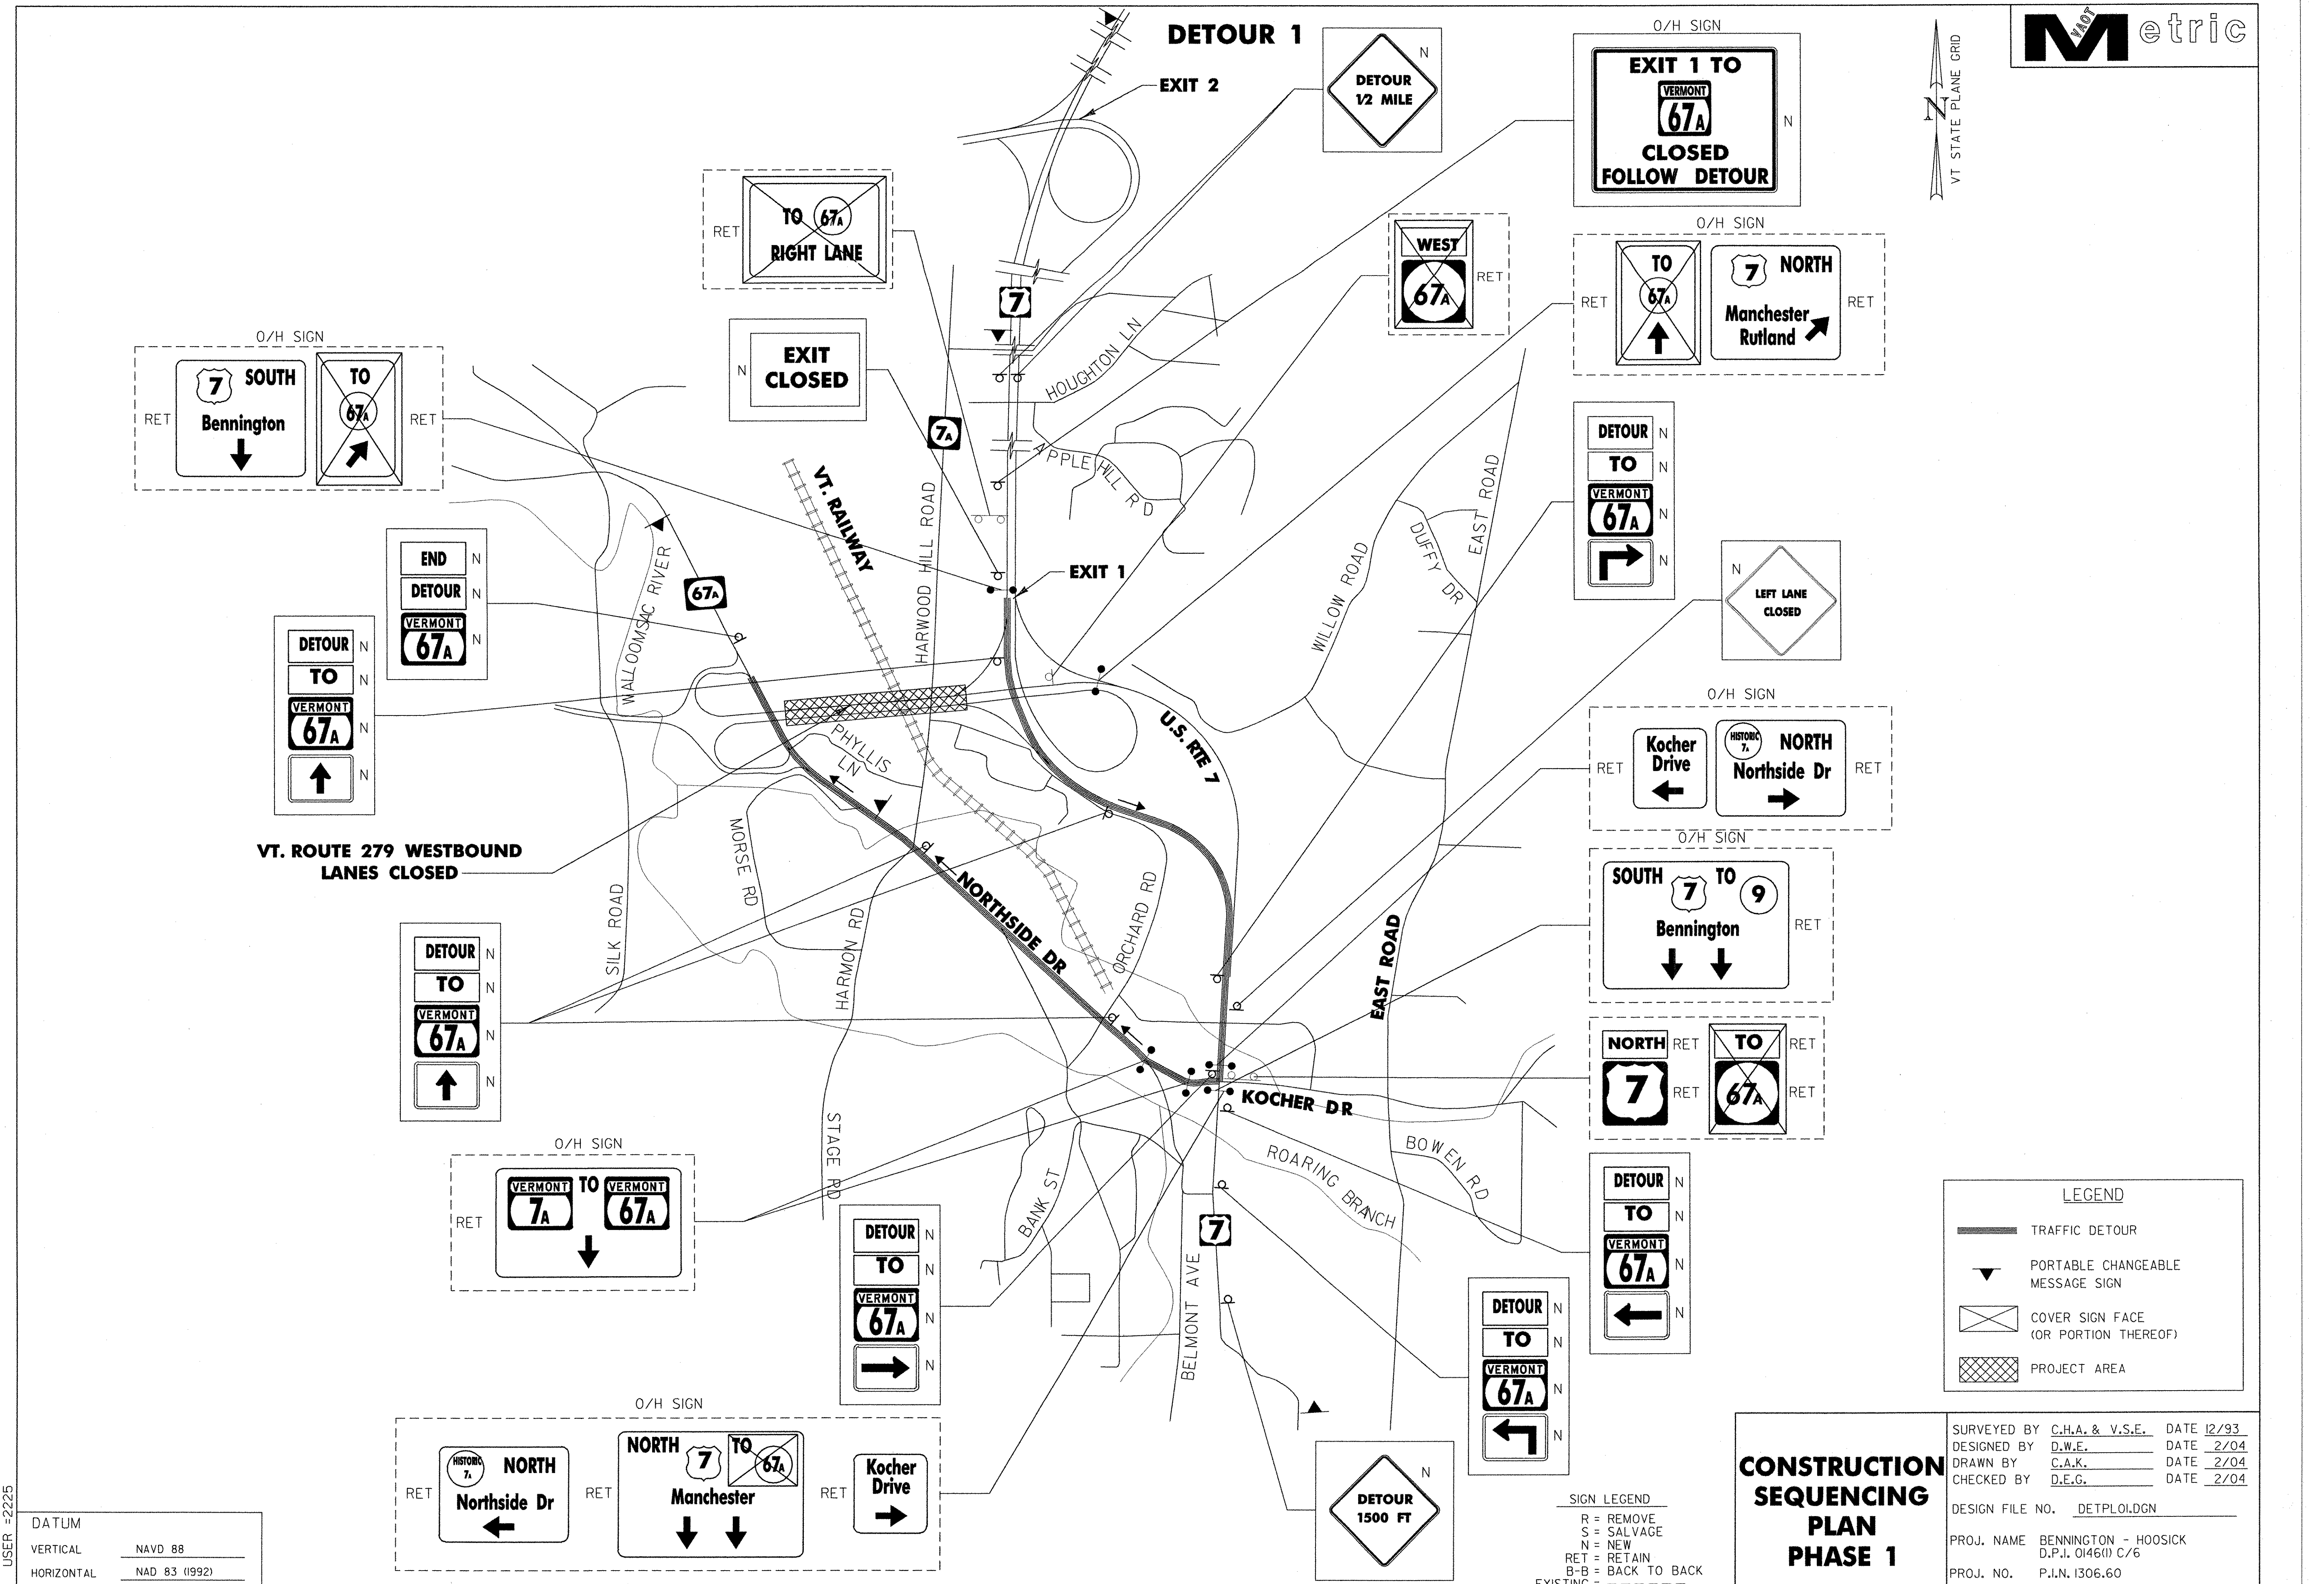

**VT. ROUTE 279 WESTBOUND LANES CLOSED**

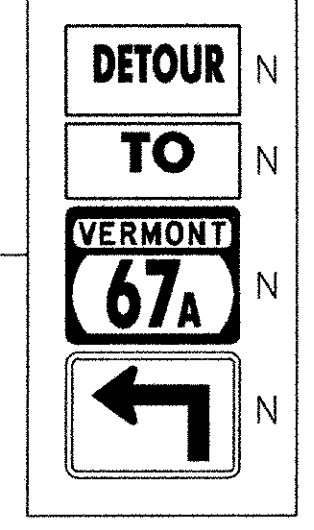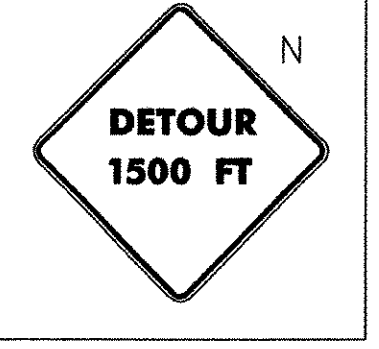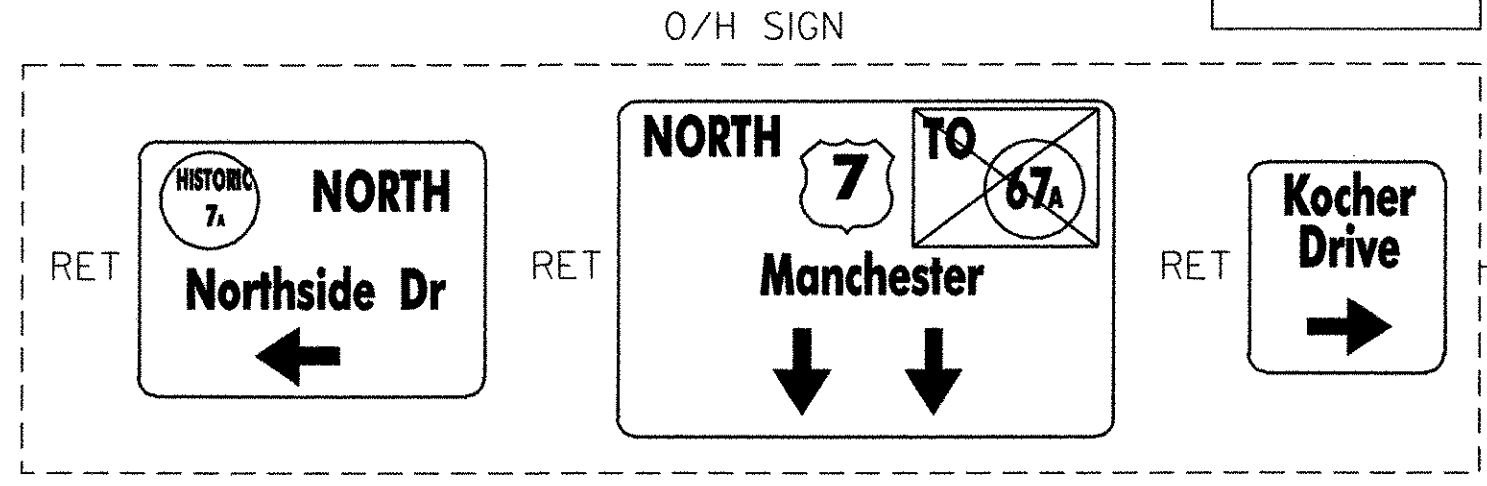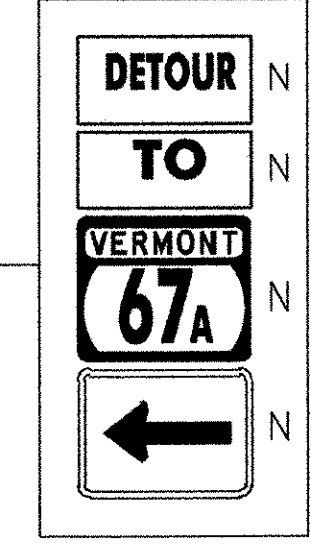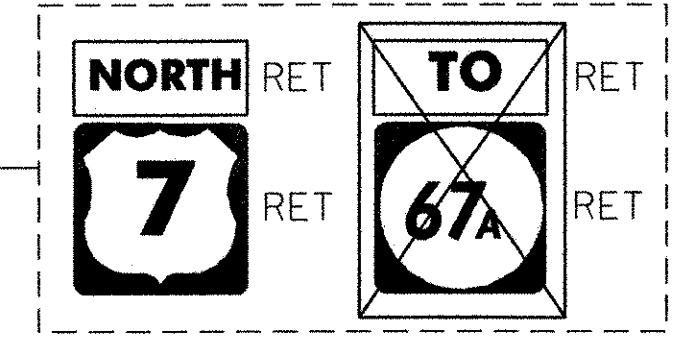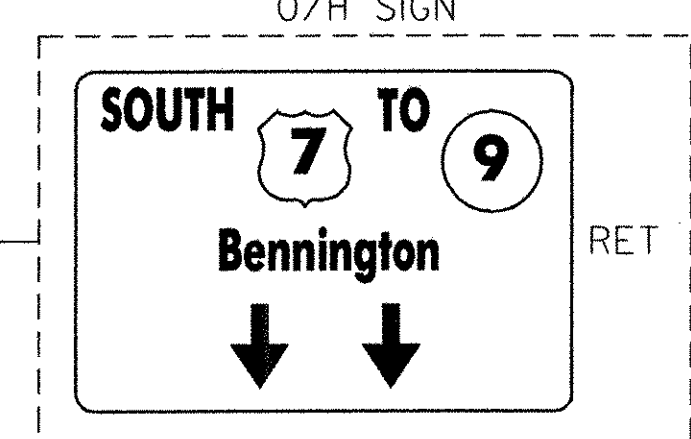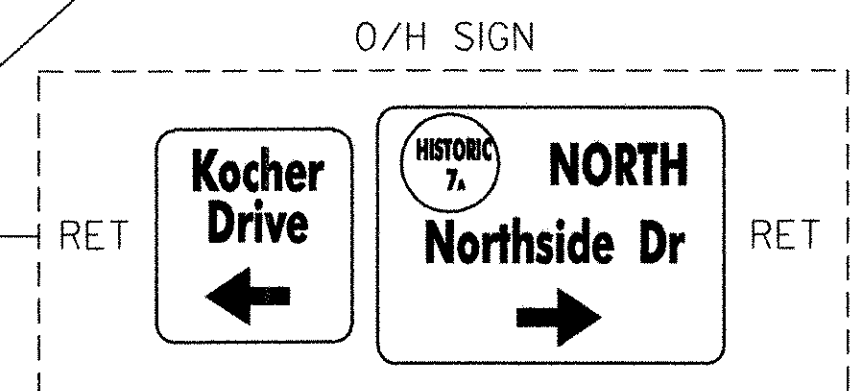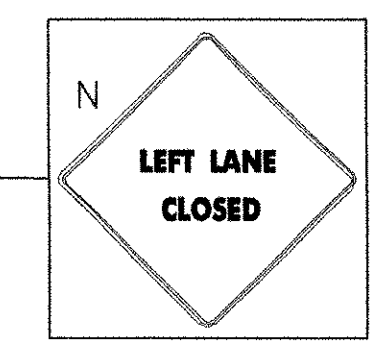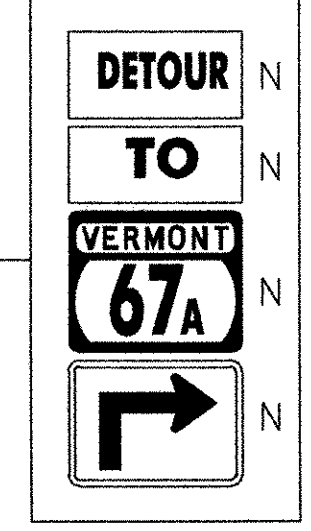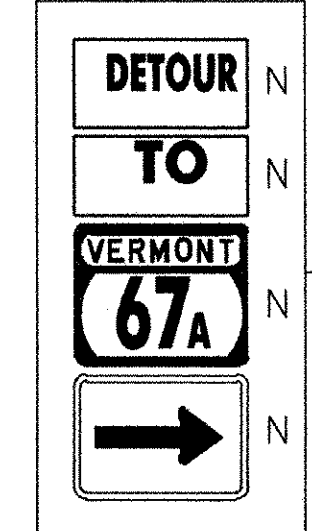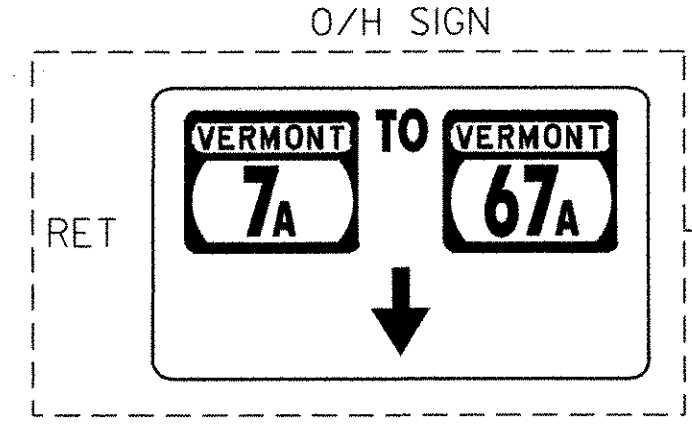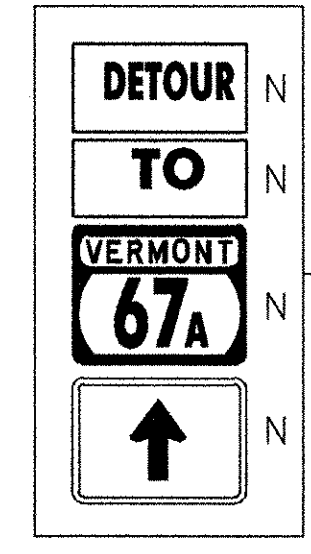

**SIGN LEGEND**  
R = REMOVE  
S = SALVAGE  
N = NEW  
RET = RETAIN  
B-B = BACK TO BACK  
EXISTING = ---  
NEW = - - -


LEGEND	
	TRAFFIC DETOUR
	PORTABLE CHANGEABLE MESSAGE SIGN
	COVER SIGN FACE (OR PORTION THEREOF)
	PROJECT AREA

## CONSTRUCTION SEQUENCING PLAN PHASE 1


SURVEYED BY	C.H.A. & V.S.E.	DATE	12/93
DESIGNED BY	D.W.E.	DATE	2/04
DRAWN BY	C.A.K.	DATE	2/04
CHECKED BY	D.E.G.	DATE	2/04
DESIGN FILE NO.	DETPLOI.DGN		
PROJ. NAME	BENNINGTON - HOOSICK D.P.I. 0146(I) C/6		
PROJ. NO.	P.I.N. 1306.60		
DWG NO.	CSP-4	SHEET	27 OF 83

FILE NAME = u:\5116\vsot\cont-act6\detp101.dgn  
DATE/TIME = 2/2/04 2:22:5

DATUM	
VERTICAL	NAVD 88
HORIZONTAL	NAD 83 (1992)

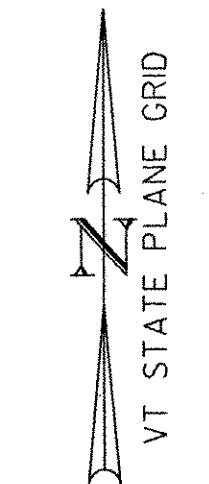


- PHASE 2 CONSTRUCTION NOTES**
1. ESTABLISH PHASE 2 DETOUR & TRAFFIC PATTERNS.
  2. CLOSE EASTBOUND BARREL OF VT. ROUTE 279 & CONSTRUCT TO THE LIMITS SHOWN.
  3. SEE DWG. CSP-10 AND CSP-11 FOR TEMPORARY LANE CLOSURE DETAILS, ALONG VT. ROUTE 67A AND HISTORIC VT. ROUTE 7A.
  4. REMOVE TEMPORARY TRAFFIC BARRIER INSTALLED BY OTHERS ON RAMP AB AND RAMP CD AS DIRECTED BY THE RESIDENT ENGINEER.

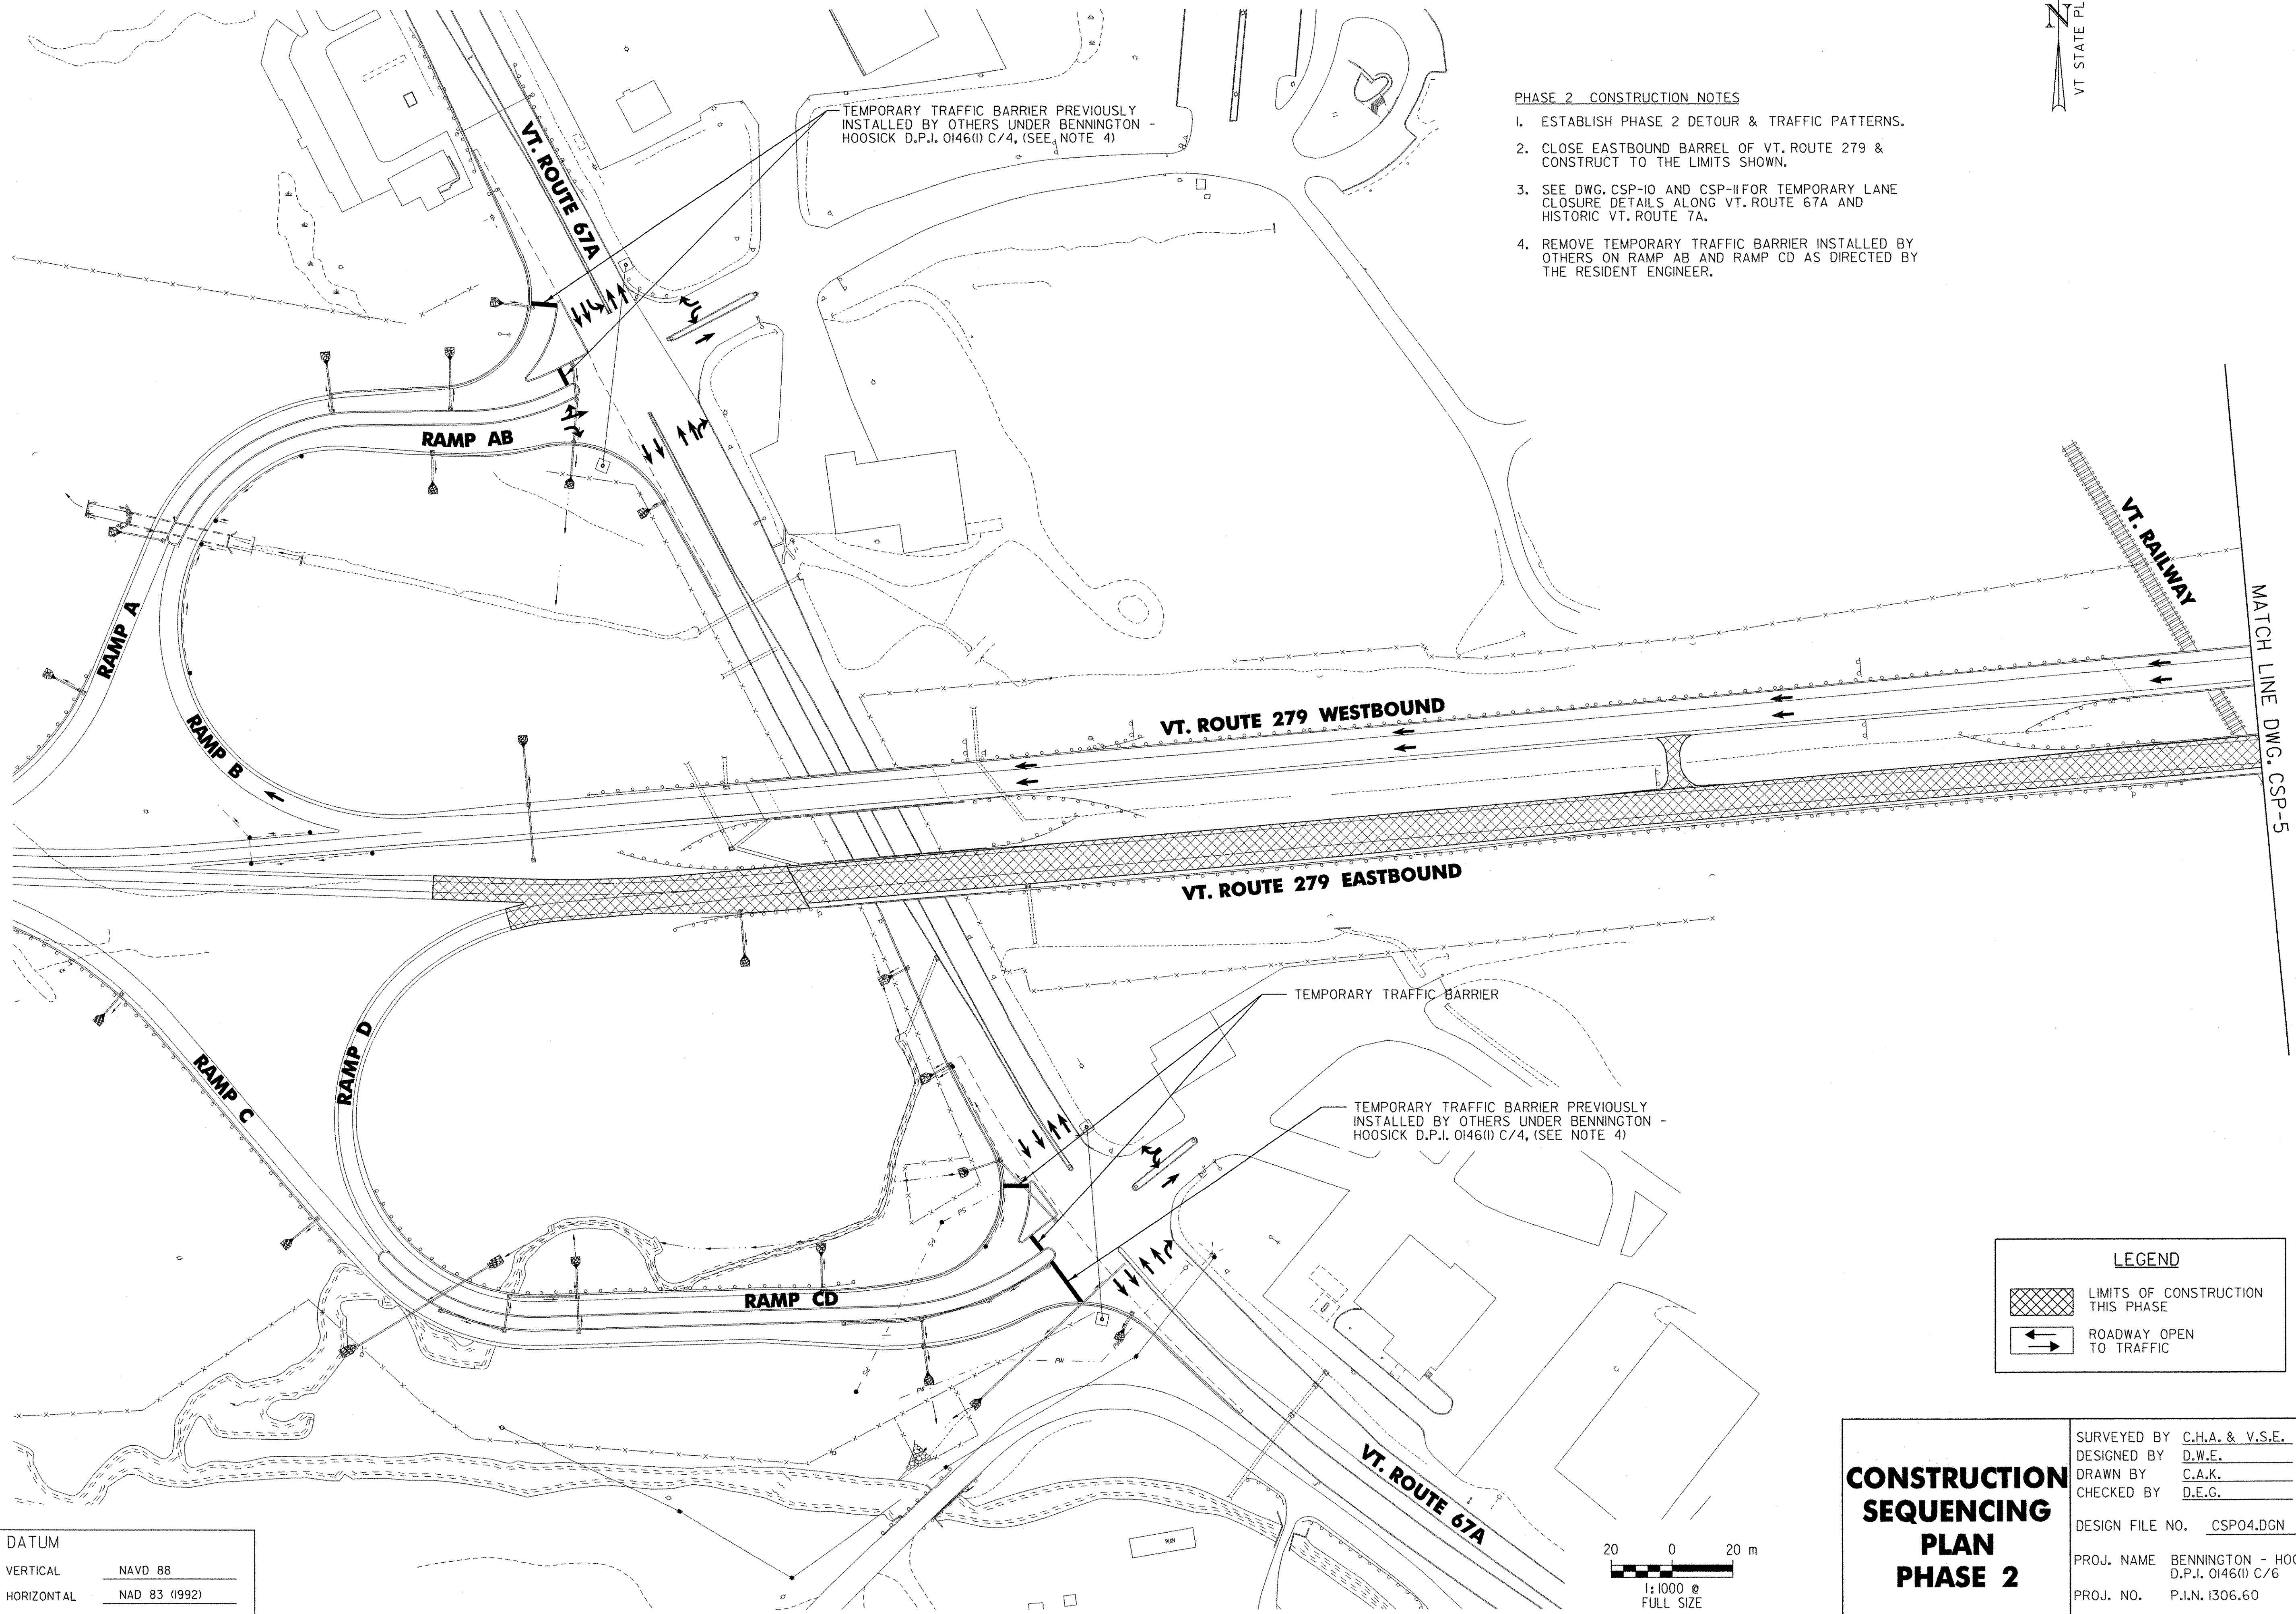


FILE NAME = ur:\5116\svoot\contract5\csp04.dgn  
 DATE/TIME = 5/16/2004  
 USER = z225

DATUM	
VERTICAL	NAVD 88
HORIZONTAL	NAD 83 (1992)

LEGEND	
	LIMITS OF CONSTRUCTION THIS PHASE
	ROADWAY OPEN TO TRAFFIC

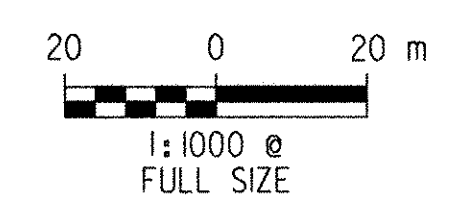


<b>CONSTRUCTION SEQUENCING PLAN PHASE 2</b>	SURVEYED BY	C.H.A. & V.S.E.	DATE	12/93
	DESIGNED BY	D.W.E.	DATE	2/04
	DRAWN BY	C.A.K.	DATE	2/04
	CHECKED BY	D.E.G.	DATE	2/04
DESIGN FILE NO.		CSP04.DGN		
PROJ. NAME	BENNINGTON - HOOSICK D.P.I. 0146(1) C/6			
PROJ. NO.	P.I.N. 1306.60			
DWG NO.	CSP-5	SHEET		28 OF 83

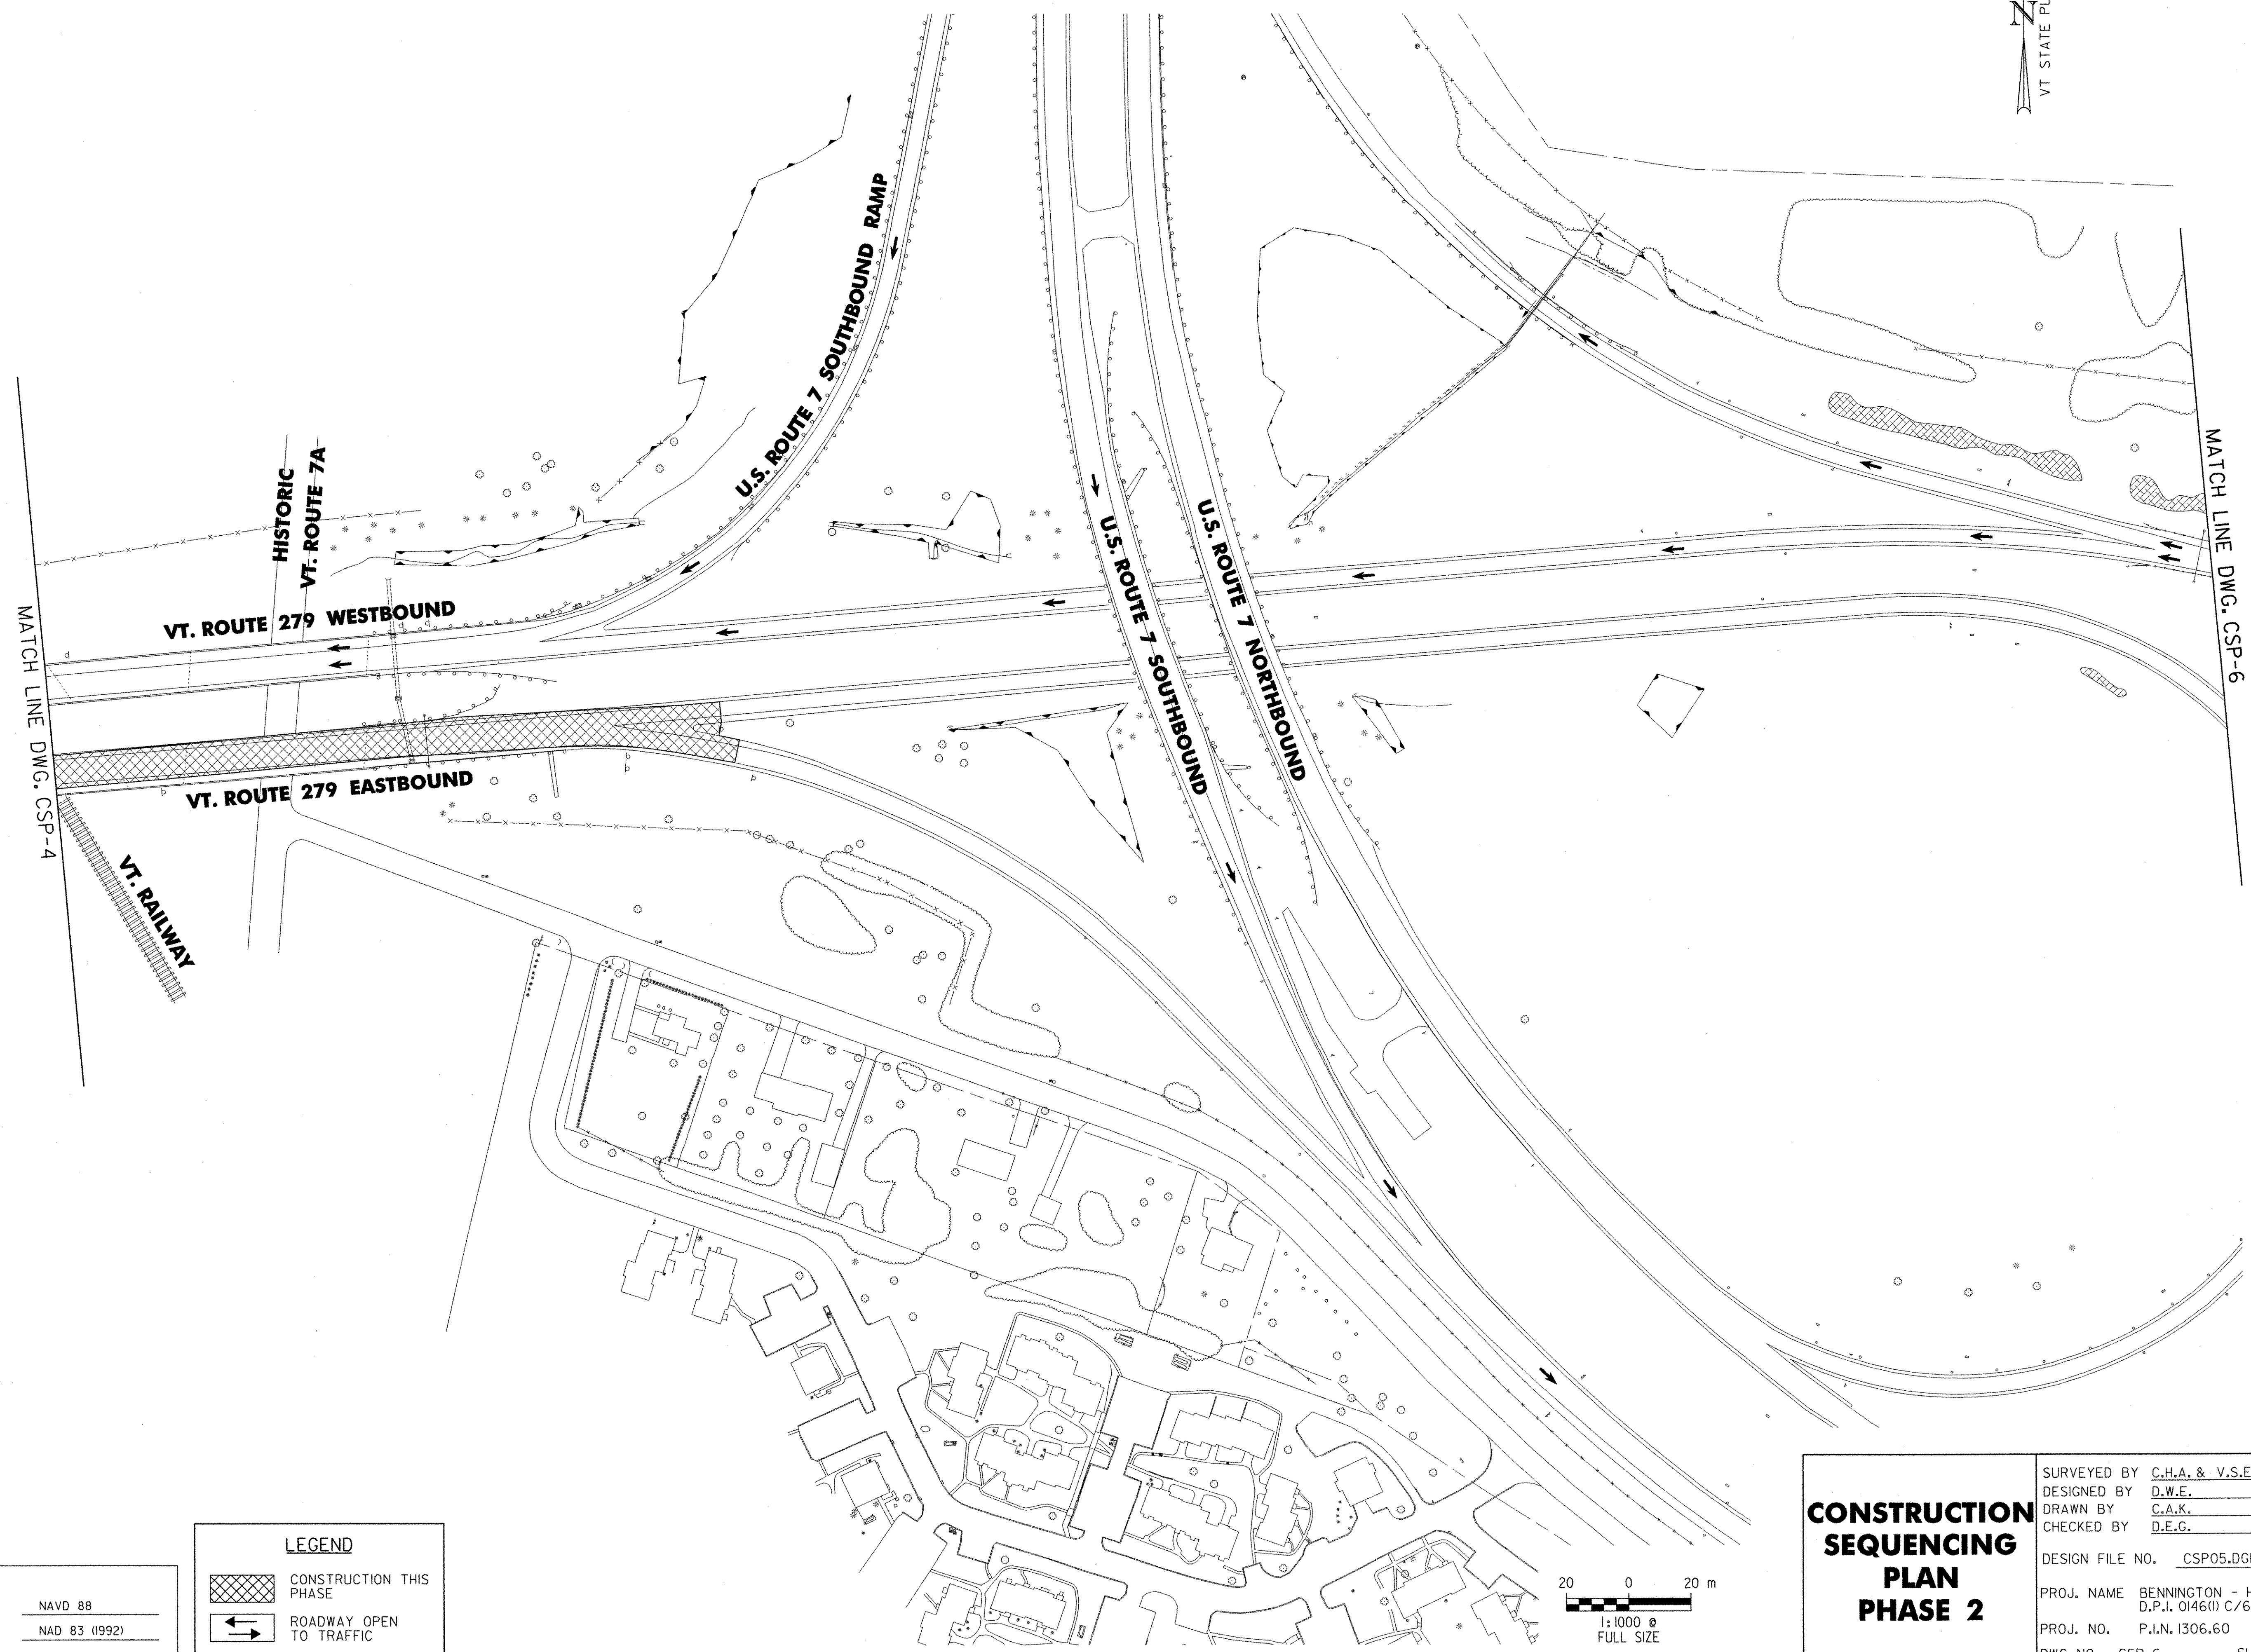

FILE NAME = ur:\5116\vaot\contract6\esp05.dgn  
 DATE/TIME = 2/16/2004  
 USER = 2225


DATUM	
VERTICAL	NAVD 88
HORIZONTAL	NAD 83 (1992)

LEGEND	
	CONSTRUCTION THIS PHASE
	ROADWAY OPEN TO TRAFFIC

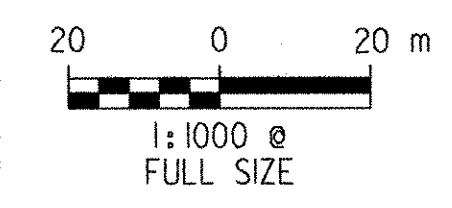

**CONSTRUCTION SEQUENCING PLAN PHASE 2**

SURVEYED BY	C.H.A. & V.S.E.	DATE	12/93
DESIGNED BY	D.W.E.	DATE	2/04
DRAWN BY	C.A.K.	DATE	2/04
CHECKED BY	D.E.G.	DATE	2/04
DESIGN FILE NO.	CSP05.DGN		
PROJ. NAME	BENNINGTON - HOOSICK D.P.I. 0146(I) C/6		
PROJ. NO.	P.I.N. 1306.60		
DWG NO.	CSP-6	SHEET	29 OF 83

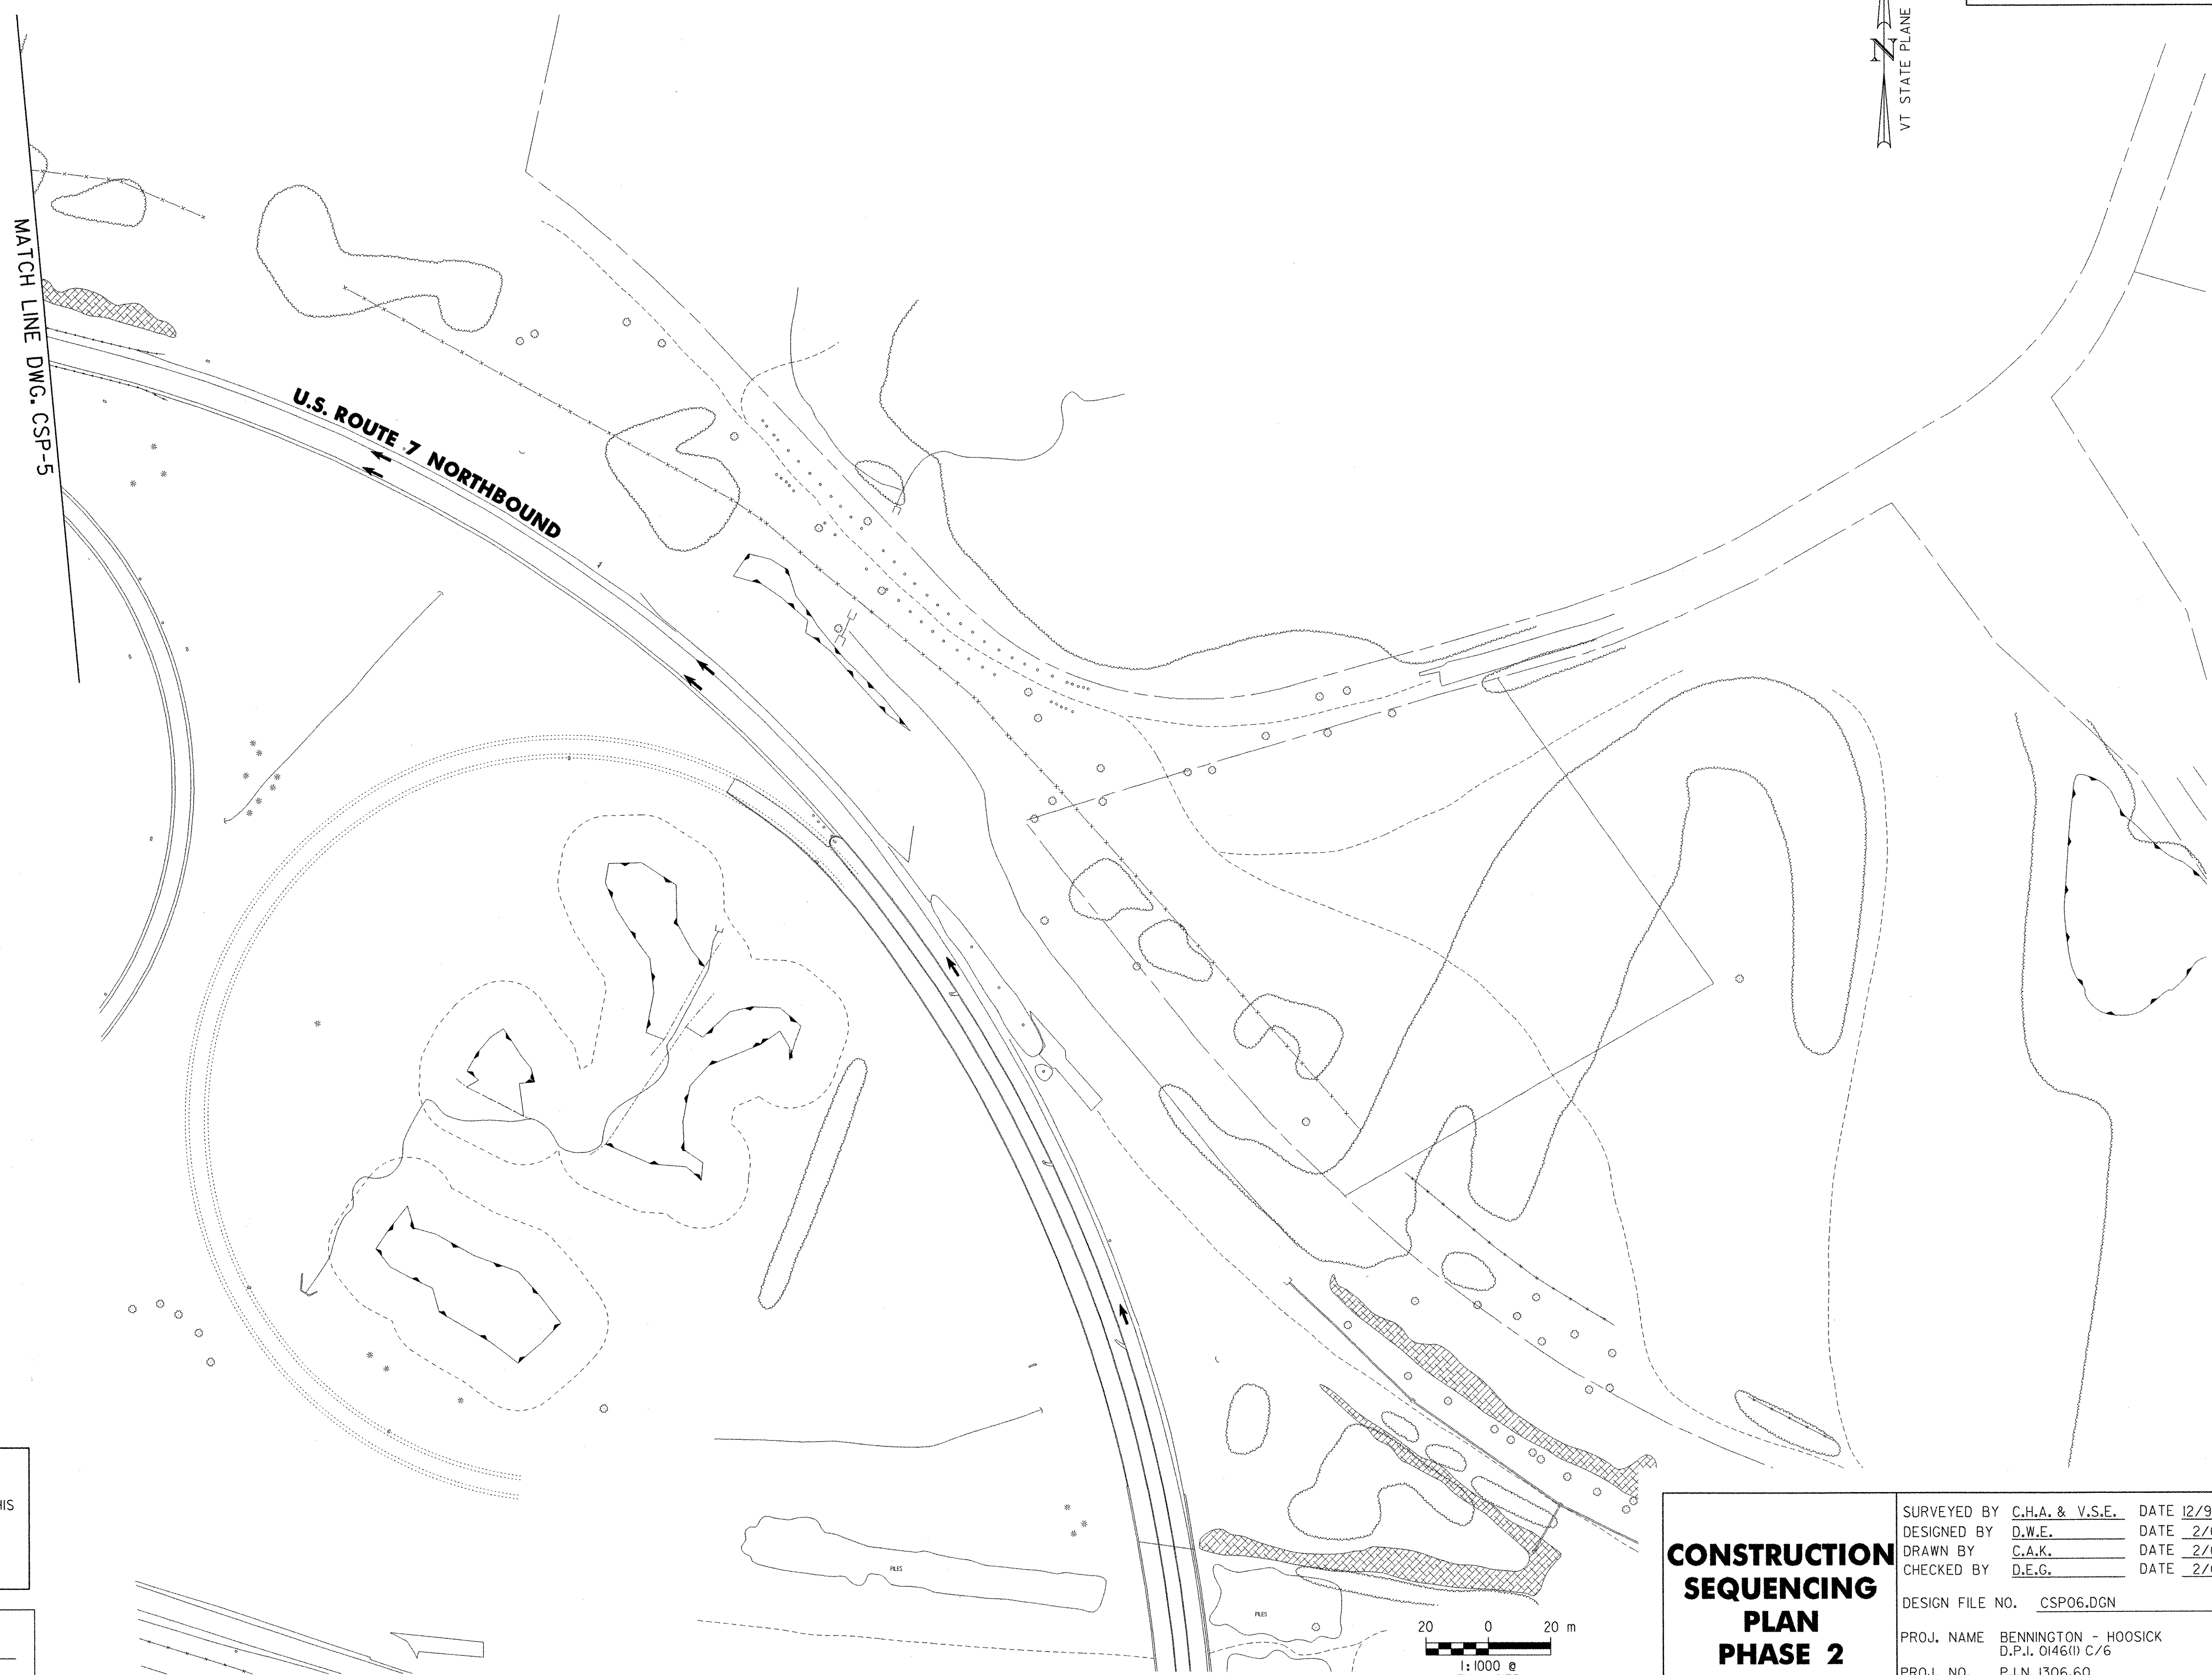


**LEGEND**

	CONSTRUCTION THIS PHASE
	ROADWAY OPEN TO TRAFFIC


**DATUM**

VERTICAL	NAVD 88
HORIZONTAL	NAD 83 (1992)

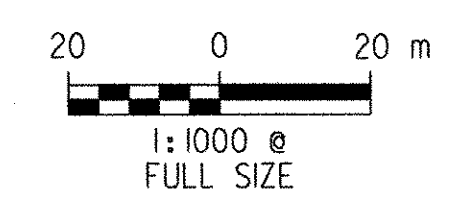

<b>CONSTRUCTION SEQUENCING PLAN PHASE 2</b>	SURVEYED BY	C.H.A. & V.S.E.	DATE	12/93
	DESIGNED BY	D.W.E.	DATE	2/04
	DRAWN BY	C.A.K.	DATE	2/04
	CHECKED BY	D.E.G.	DATE	2/04
DESIGN FILE NO. CSP06.DGN				
PROJ. NAME BENNINGTON - HOOSICK D.P.I. 0146(1) C/6				
PROJ. NO. P.I.N. 1306.60				
DWG NO. CSP-7 SHEET 30 OF 83				










FILE NAME =ur\5116\vaot\contract6\csp06.dgn  
 DATE/TIME = 2/17/2004  
 USER = 2225

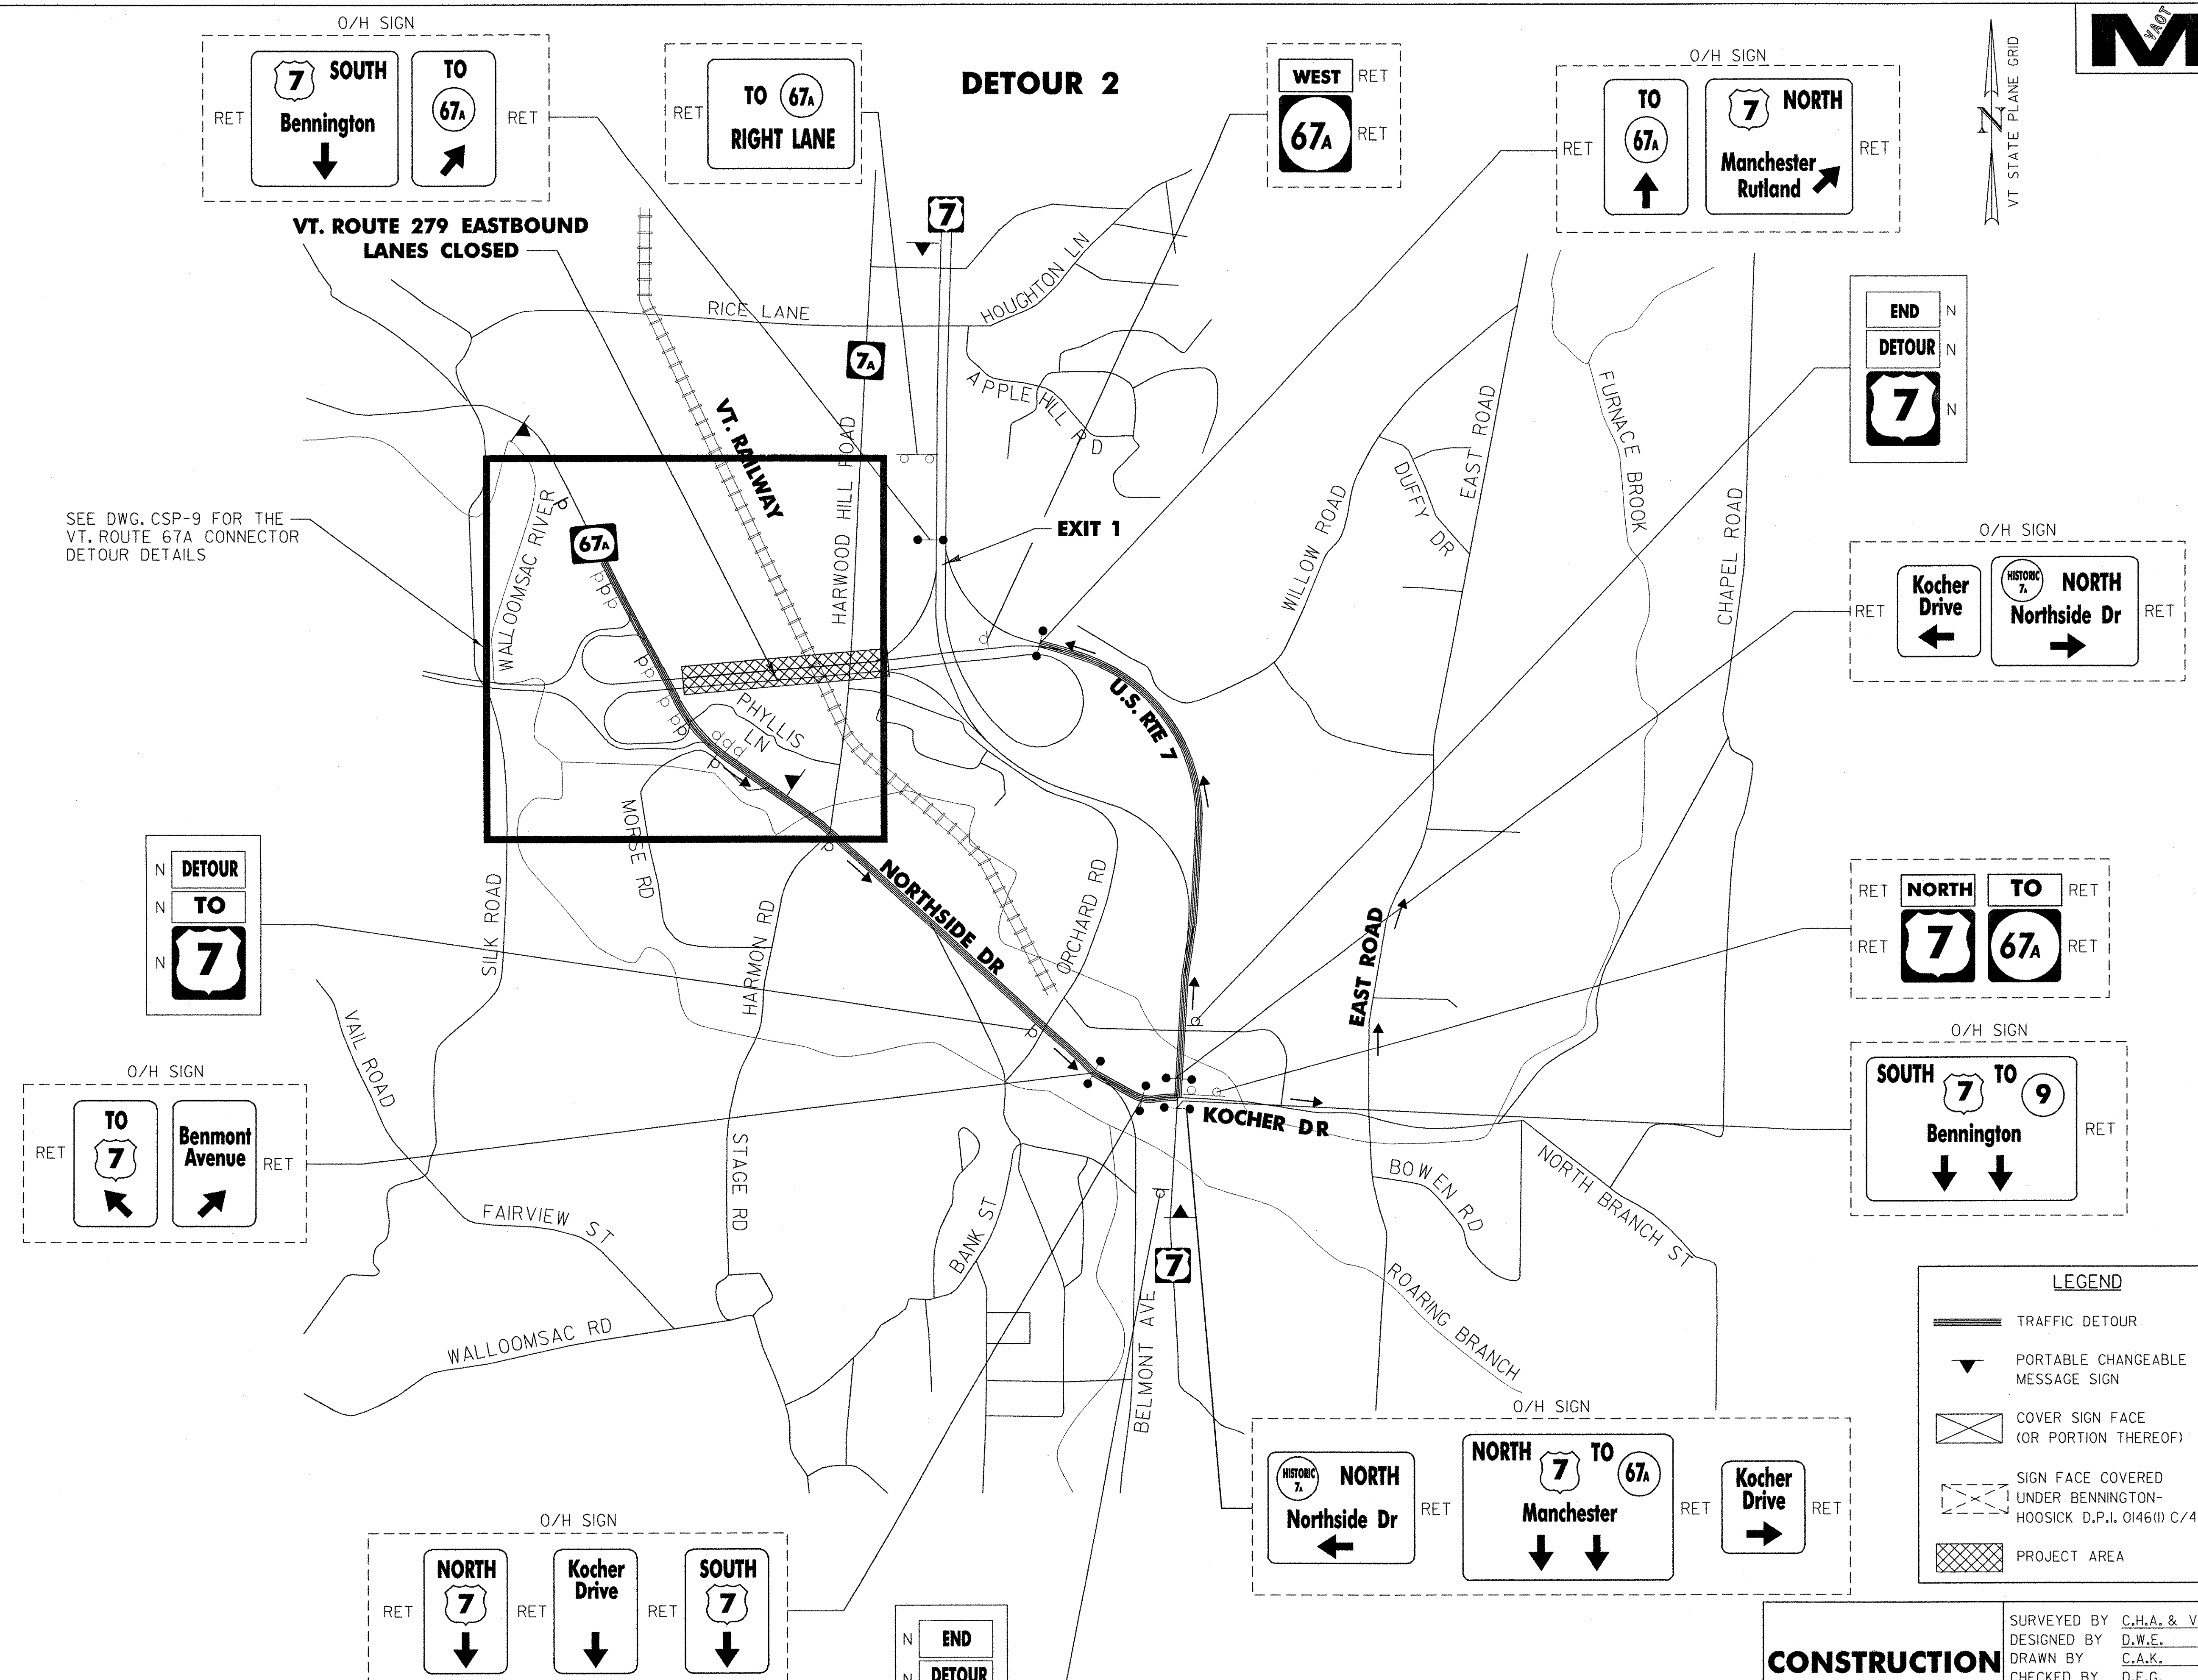

SEE DWG. CSP-9 FOR THE VT. ROUTE 67A CONNECTOR DETOUR DETAILS

**DETOUR 2**

VT. ROUTE 279 EASTBOUND LANES CLOSED

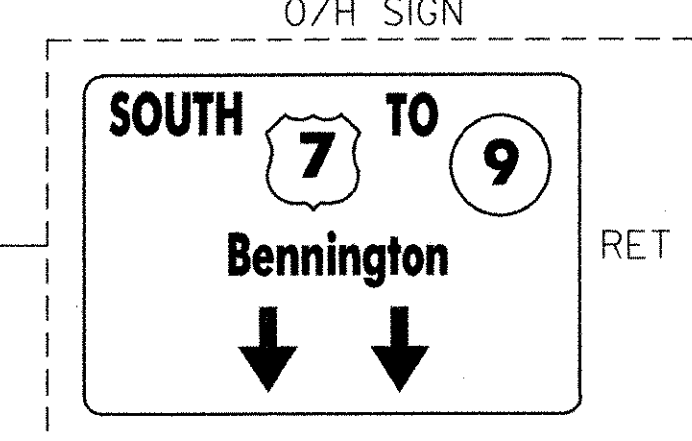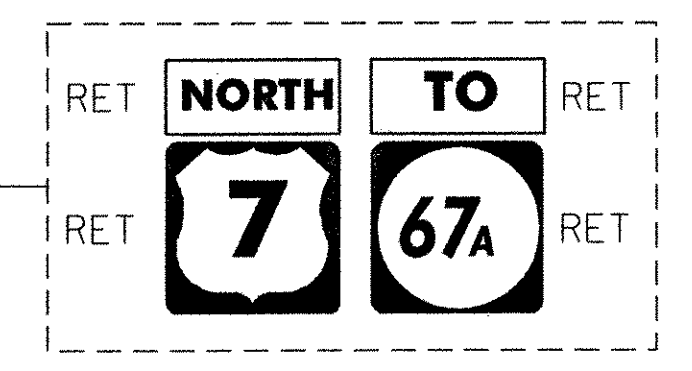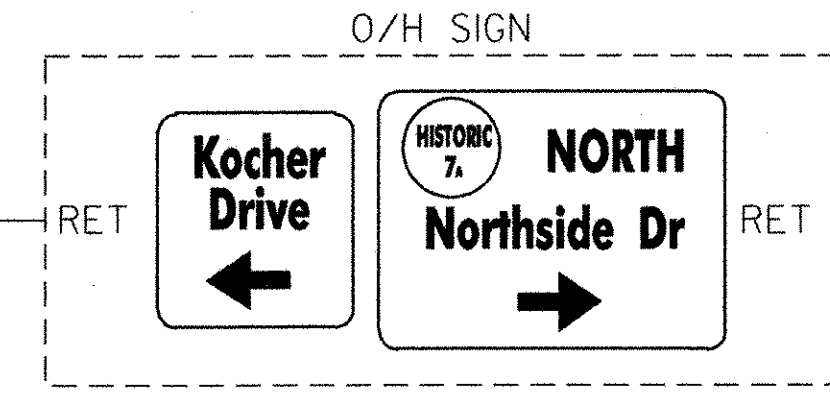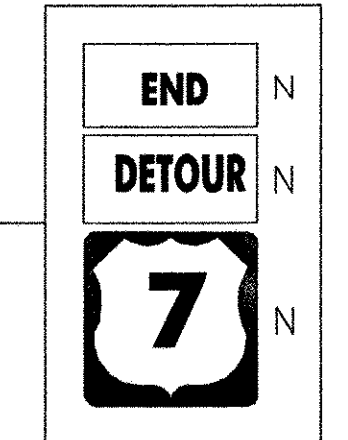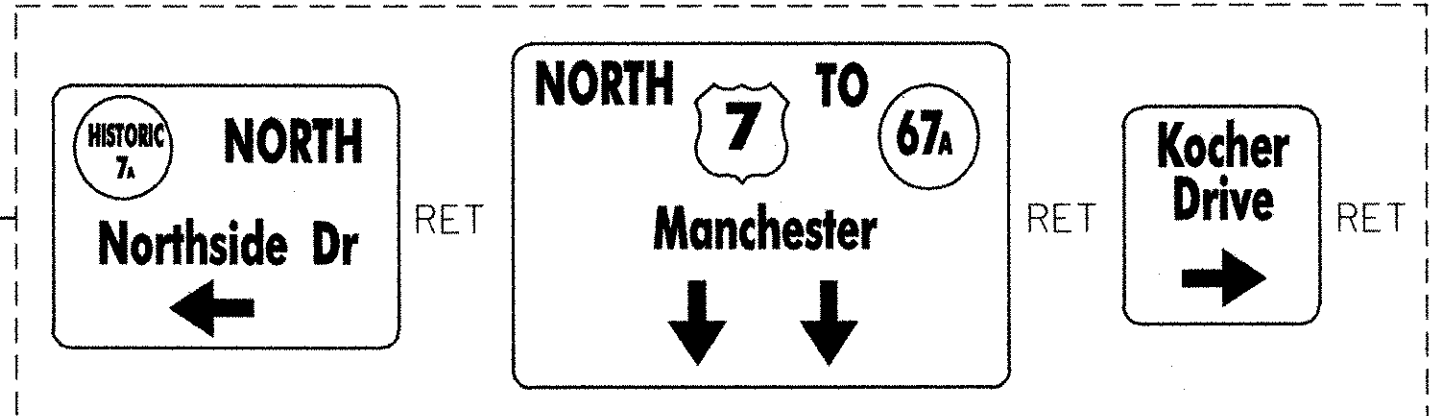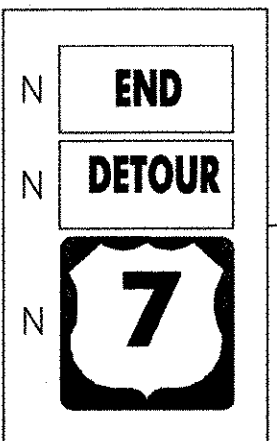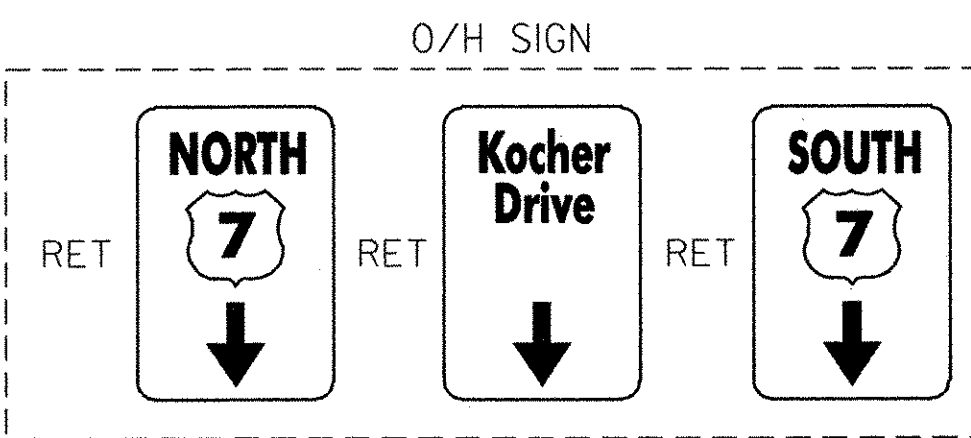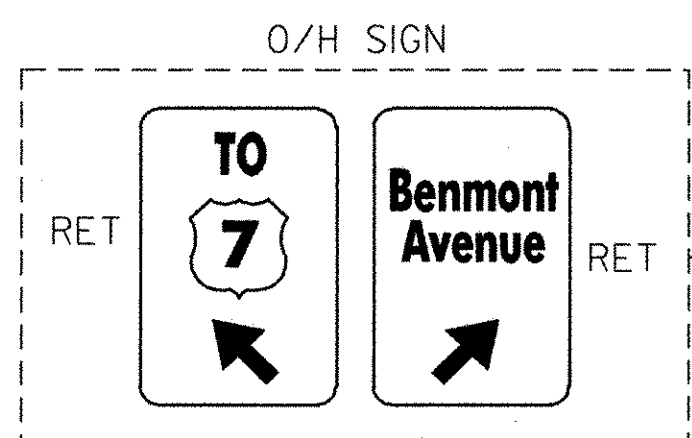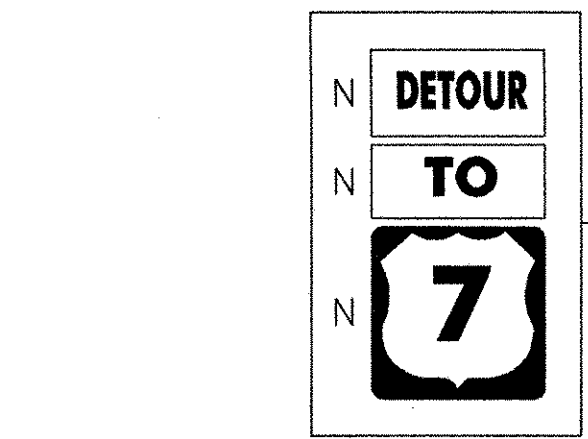

**SIGN LEGEND**  
 R = REMOVE  
 S = SALVAGE  
 N = NEW  
 RET = RETAIN  
 B-B = BACK TO BACK  
 EXISTING =   
 NEW =

**LEGEND**

- TRAFFIC DETOUR
- PORTABLE CHANGEABLE MESSAGE SIGN
- COVER SIGN FACE (OR PORTION THEREOF)
- SIGN FACE COVERED UNDER BENNINGTON-HOOSICK D.P.I. 0146(I) C/4
- PROJECT AREA

**CONSTRUCTION SEQUENCING PLAN PHASE 2**


SURVEYED BY	C.H.A. & V.S.E.	DATE	12/93
DESIGNED BY	D.W.E.	DATE	2/04
DRAWN BY	C.A.K.	DATE	2/04
CHECKED BY	D.E.G.	DATE	2/04
DESIGN FILE NO.	DETPLO2.DGN		
PROJ. NAME	BENNINGTON - HOOSICK D.P.I. 0146(I) C/6		
PROJ. NO.	P.I.N. 1306.60		
DWG NO.	CSP-8	SHEET	31 OF 83

FILE NAME: s:\15116\act\contract6\de-tp102.dgn  
 DATE/TIME: 2/16/2004 10:58:23  
 USER: 2223

**DATUM**

VERTICAL	NAVD 88
HORIZONTAL	NAD 83 (1992)

**DETOUR 2**

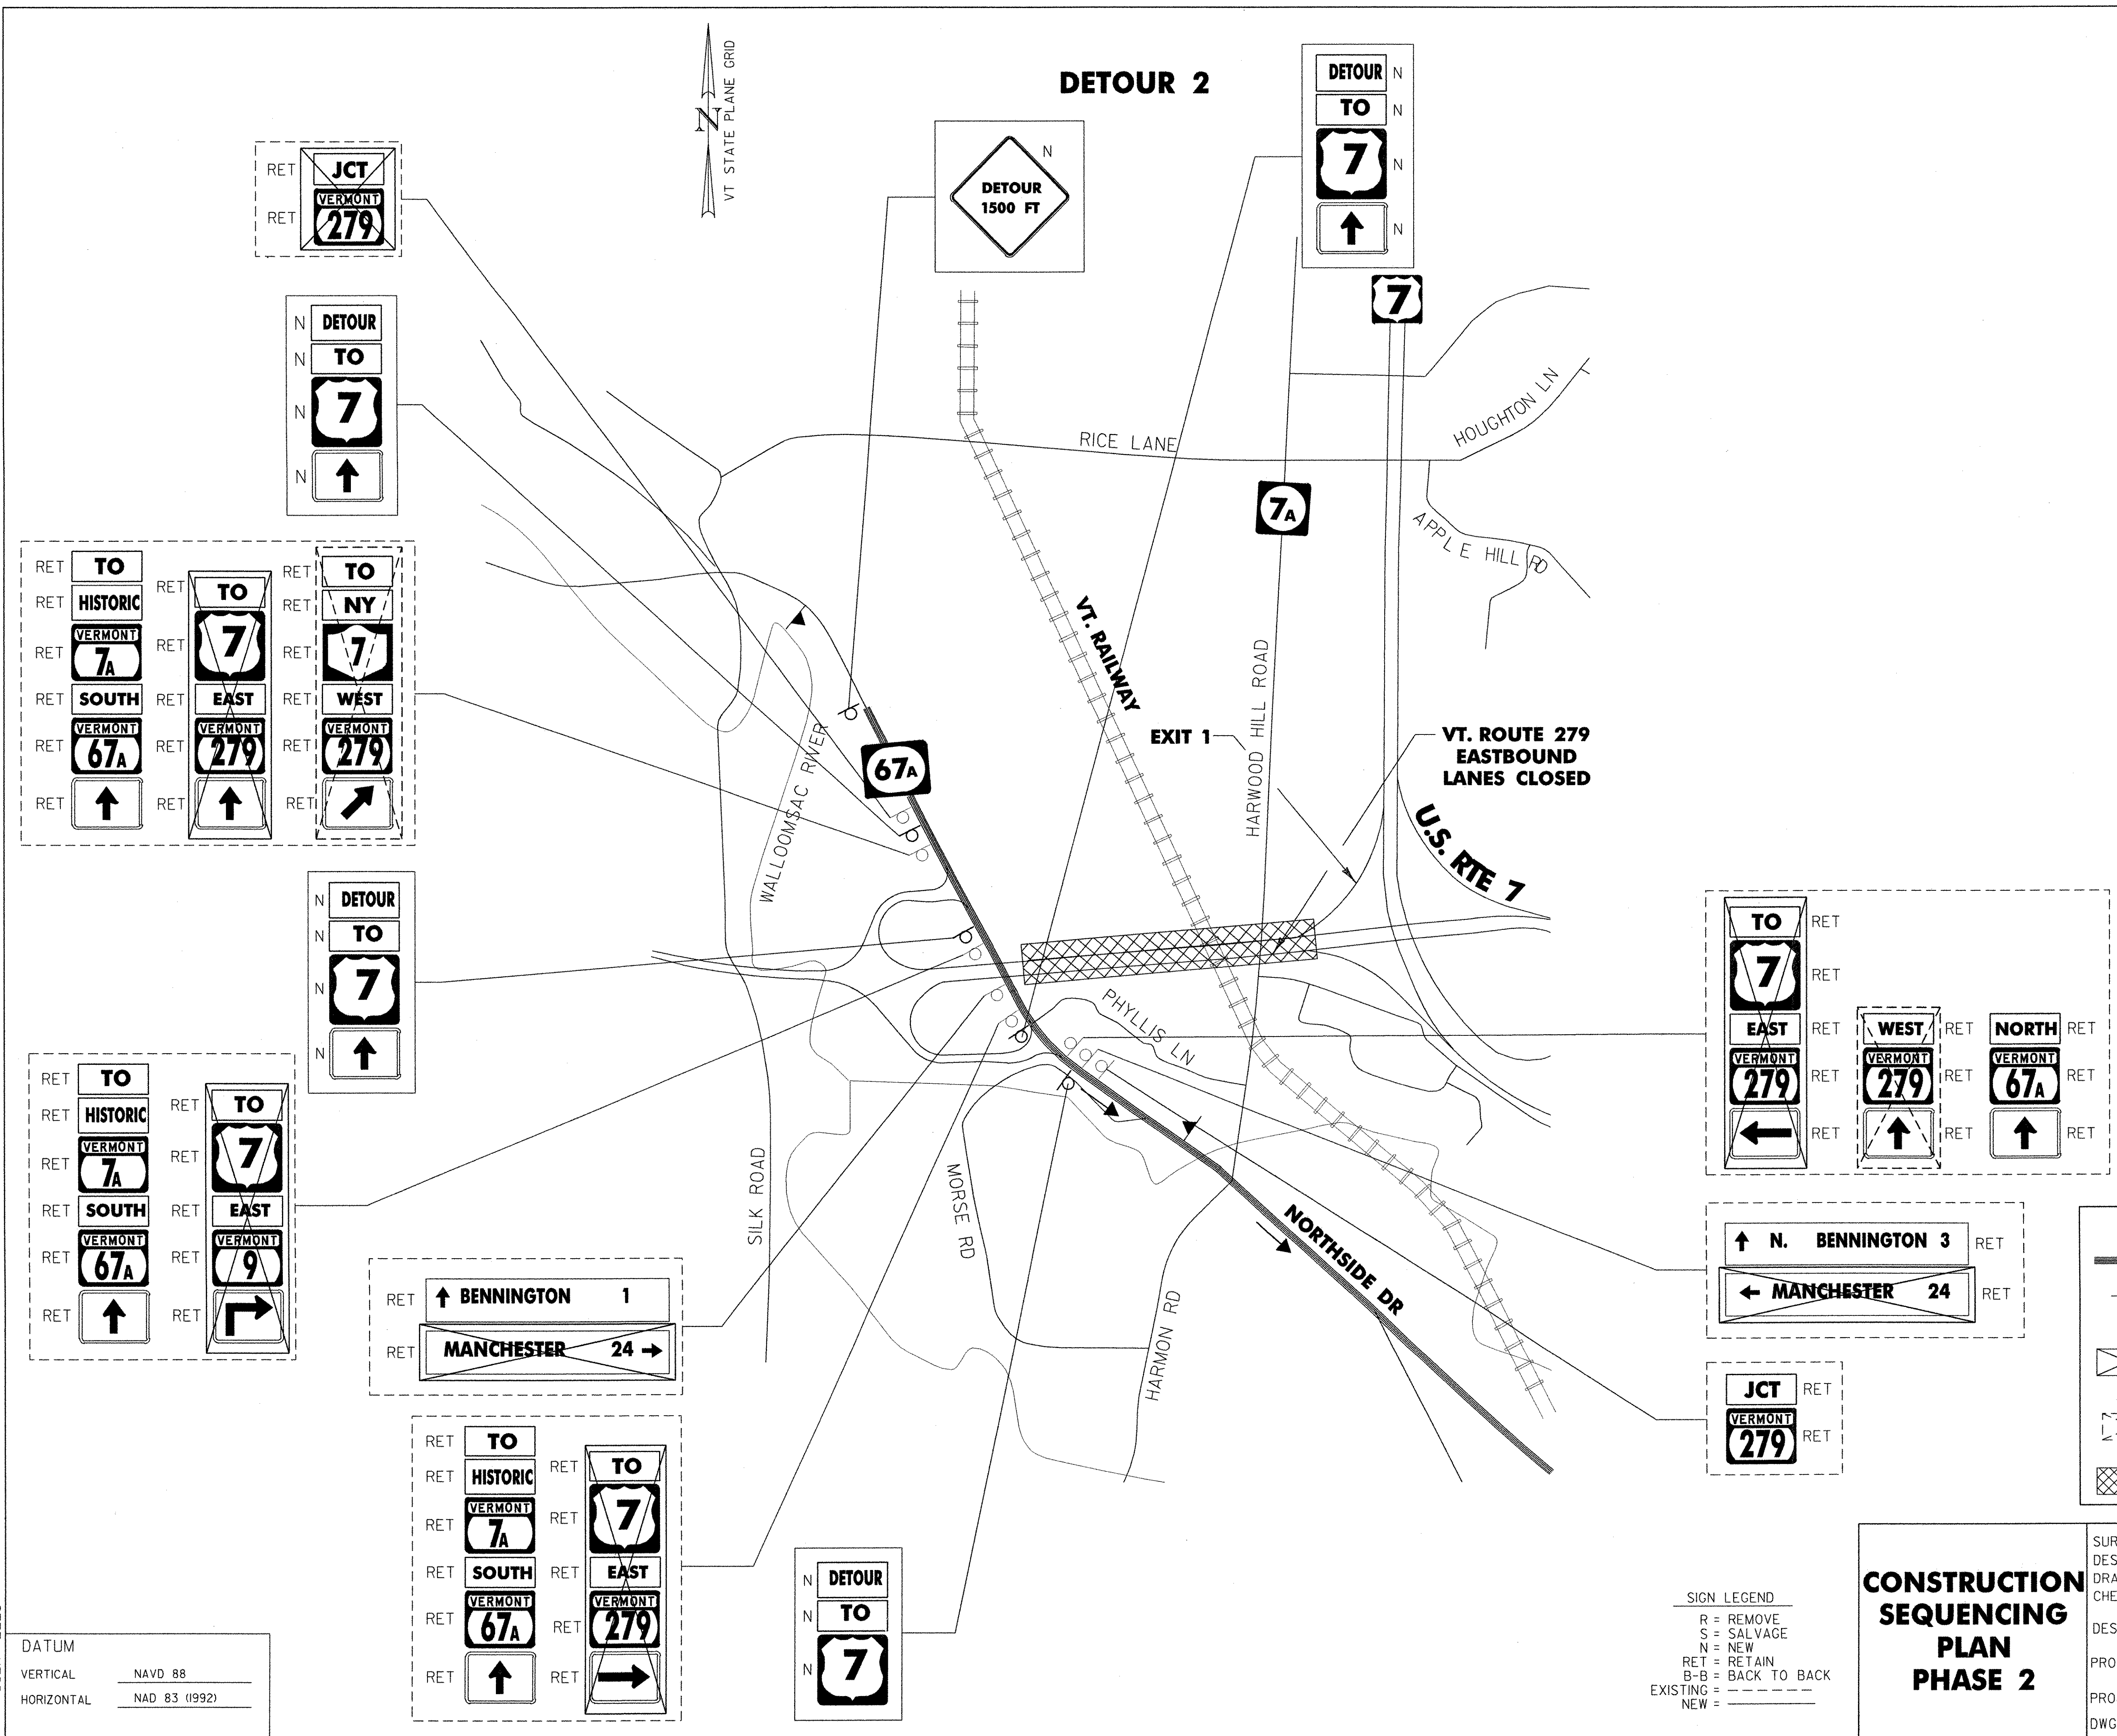

RET TO HISTORIC VERMONT 7A SOUTH VERMONT 67A ↑

RET TO VERMONT 7 EAST VERMONT 279 ↑

RET TO NY VERMONT 7 WEST VERMONT 279 ↘

RET TO HISTORIC VERMONT 7A SOUTH VERMONT 67A ↑

RET TO VERMONT 7 EAST VERMONT 9 ↘

RET ↑ BENNINGTON 1

RET MANCHESTER 24 →

RET TO HISTORIC VERMONT 7A SOUTH VERMONT 67A ↑

RET TO VERMONT 7 EAST VERMONT 279 →

RET DETOUR TO 7 ↑

RET TO VERMONT 7 EAST VERMONT 279 ←

RET WEST VERMONT 279 ↑

RET NORTH VERMONT 67A ↑

RET ↑ N. BENNINGTON 3

RET ← MANCHESTER 24

RET JCT VERMONT 279

**SIGN LEGEND**

R = REMOVE  
 S = SALVAGE  
 N = NEW  
 RET = RETAIN  
 B-B = BACK TO BACK  
 EXISTING = \_\_\_\_\_  
 NEW = \_\_\_\_\_

**LEGEND**

- TRAFFIC DETOUR
- PORTABLE CHANGEABLE MESSAGE SIGN
- COVER SIGN FACE (OR PORTION THEREOF)
- SIGN FACE COVERED UNDER BENNINGTON-HOOSICK D.P.I. 0146(II) C/4
- PROJECT AREA

**CONSTRUCTION SEQUENCING PLAN PHASE 2**

SURVEYED BY C.H.A. & V.S.E. DATE 12/93  
 DESIGNED BY D.W.E. DATE 2/04  
 DRAWN BY C.A.K. DATE 2/04  
 CHECKED BY D.E.G. DATE 2/04

DESIGN FILE NO. DETP03.DGN


PROJ. NAME BENNINGTON - HOOSICK D.P.I. 0146(II) C/6  
 PROJ. NO. P.I.N. 1306.60  
 DWG NO. CSP-9 SHEET 32 OF 83

FILE NAME = ur:\5116\vaot\contr-act6\detp103.dgn  
 DATE/TIME = 2/16/2004  
 USER = 2225


DATUM

VERTICAL NAVD 88


HORIZONTAL NAD 83 (1992)

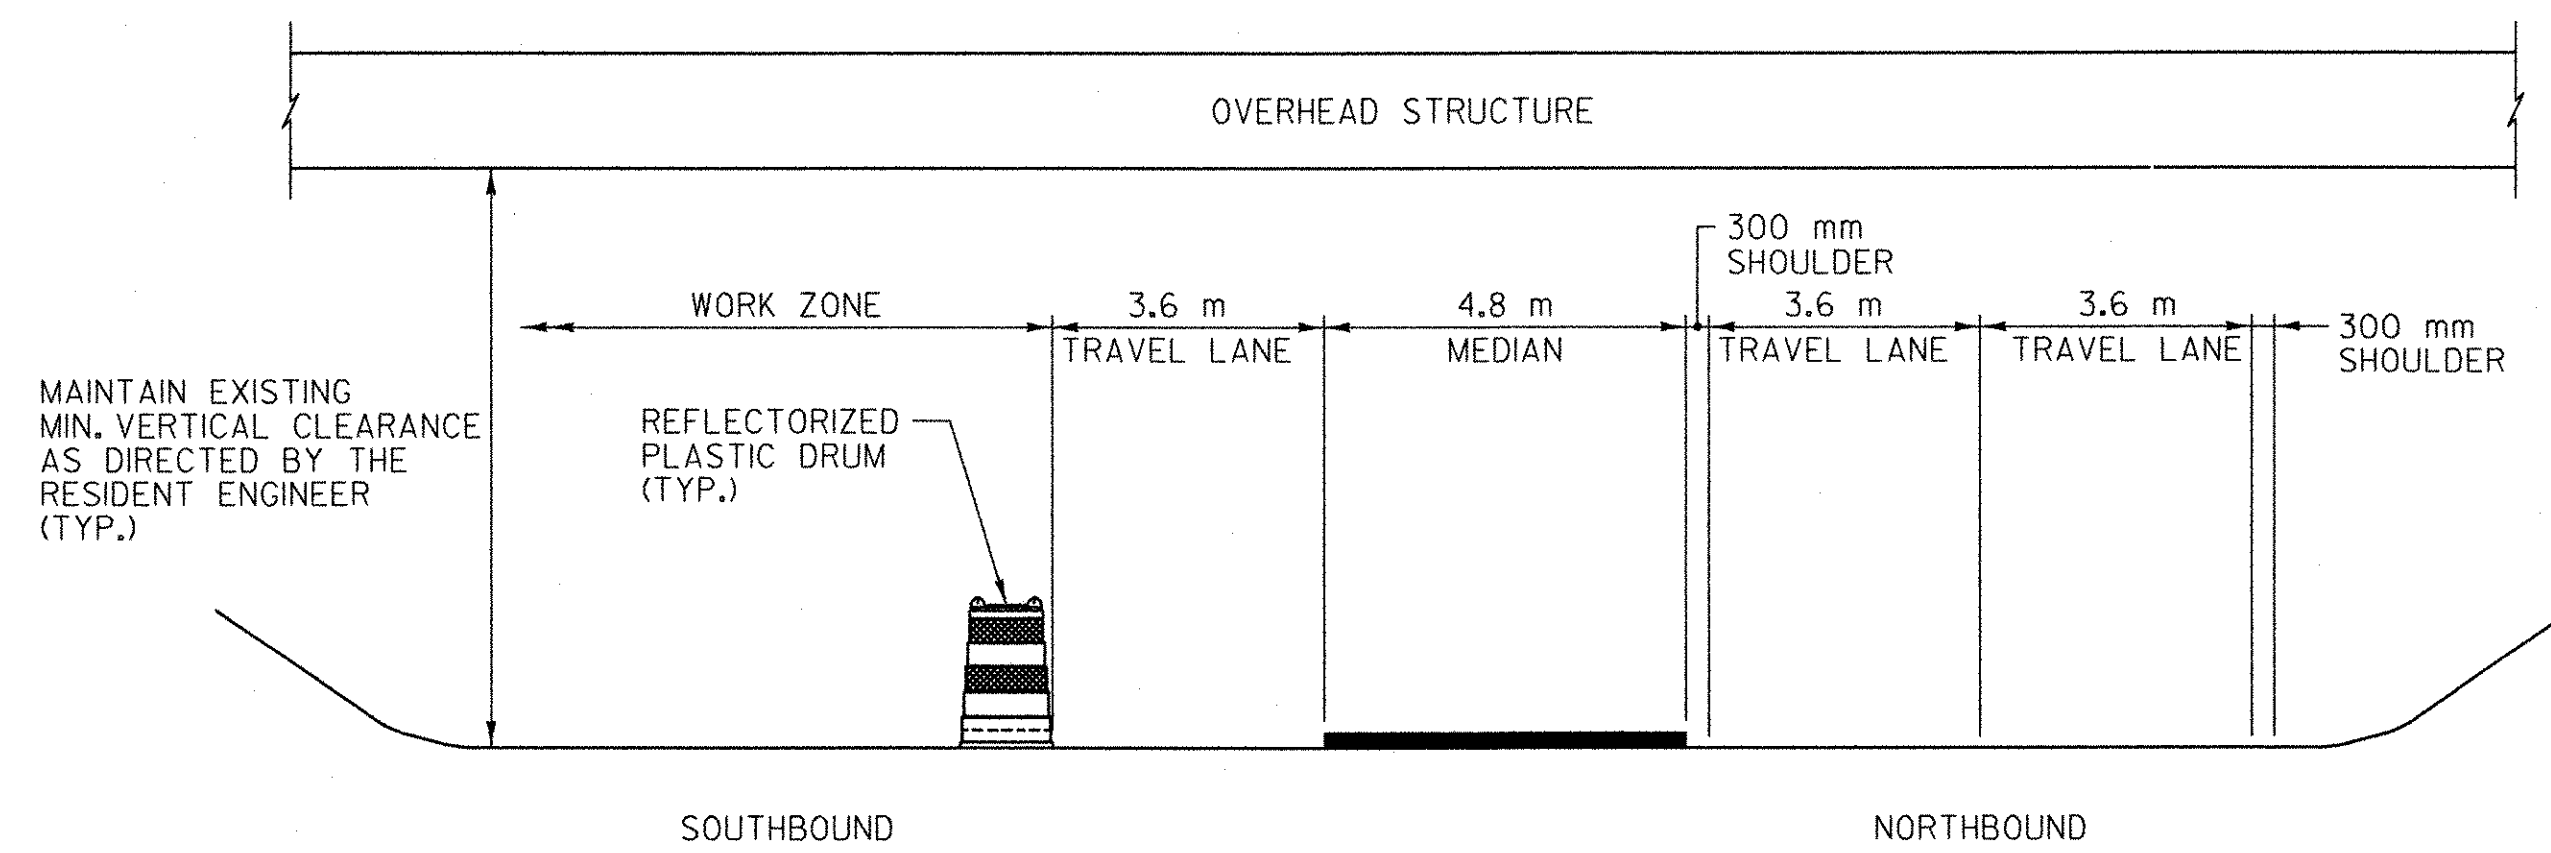


**VT. ROUTE 67A**  
**TYPICAL TEMPORARY LANE CLOSURE**  
**PHASE 1**  
 N.T.S

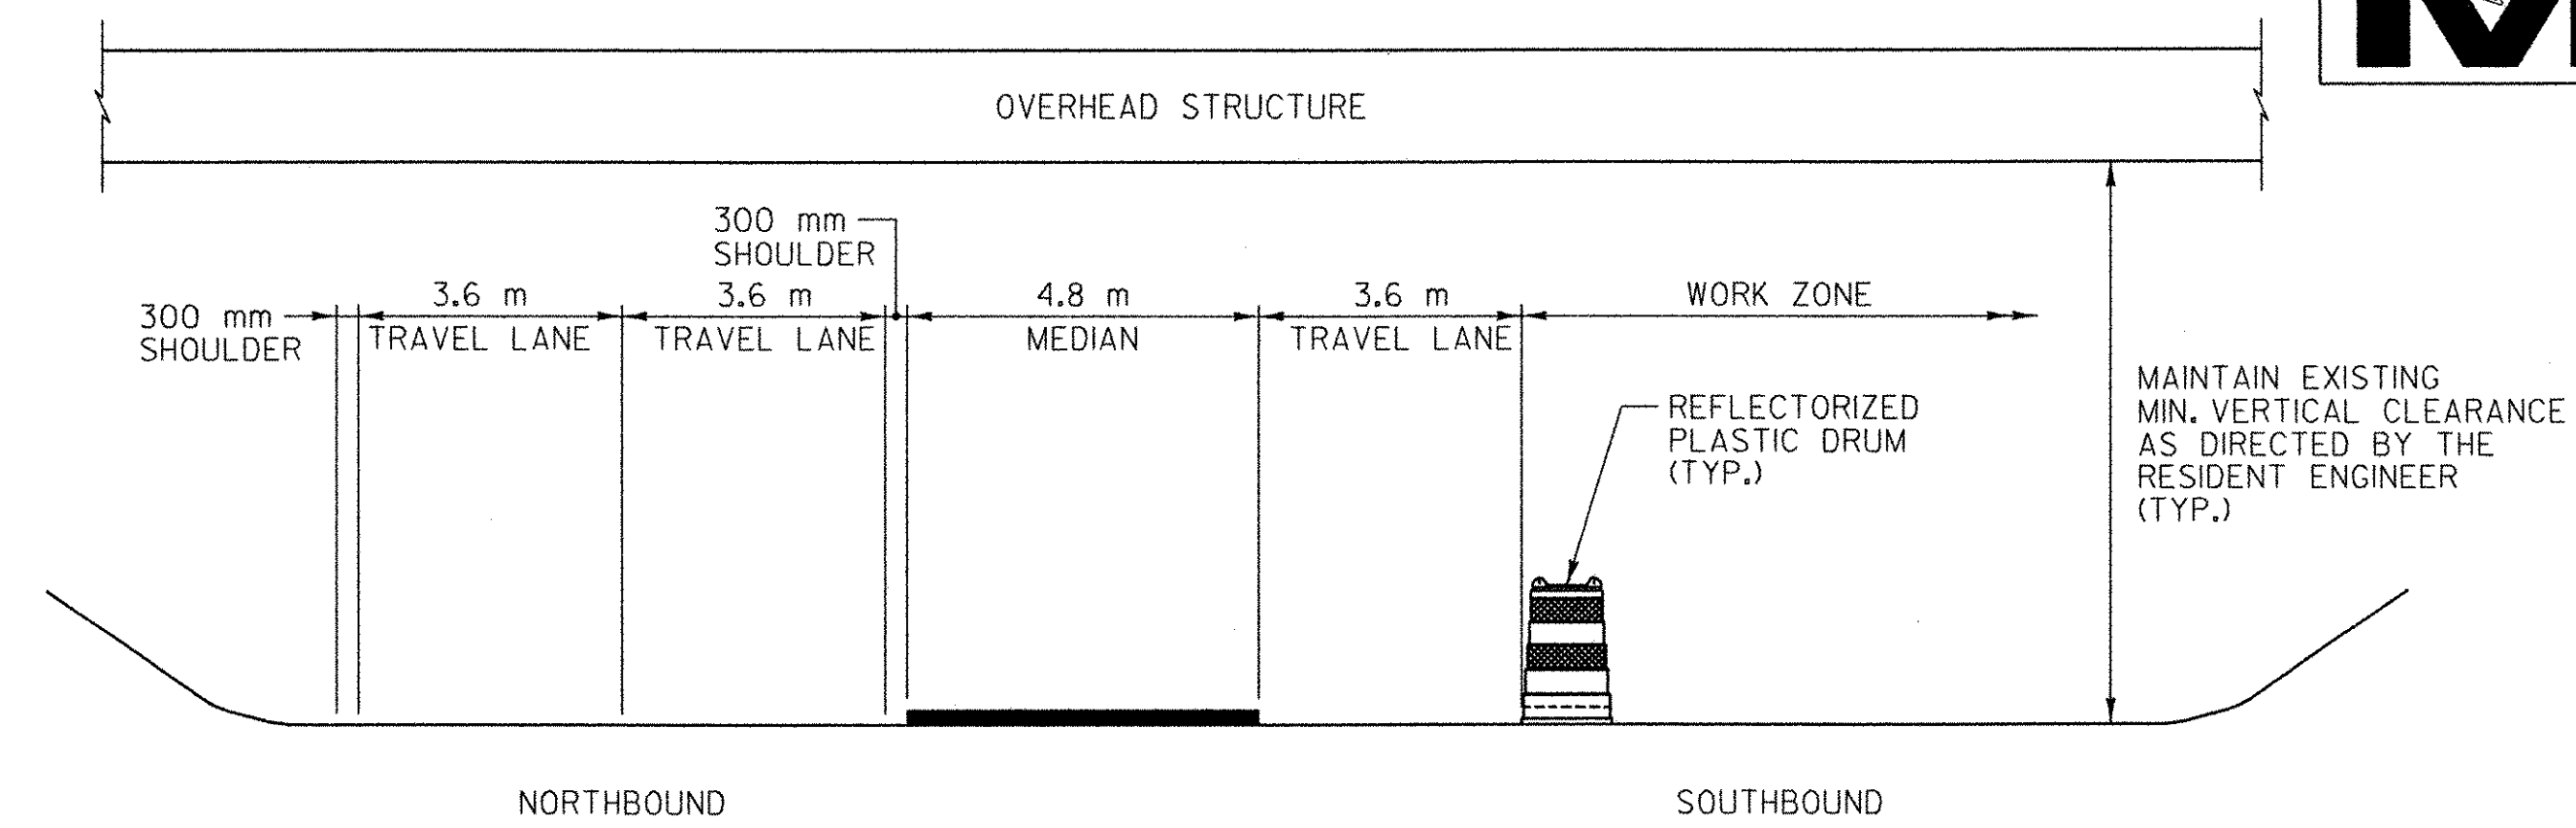

**VT. ROUTE 67A**  
**TYPICAL TEMPORARY LANE CLOSURE**  
**PHASE 3**  
 N.T.S

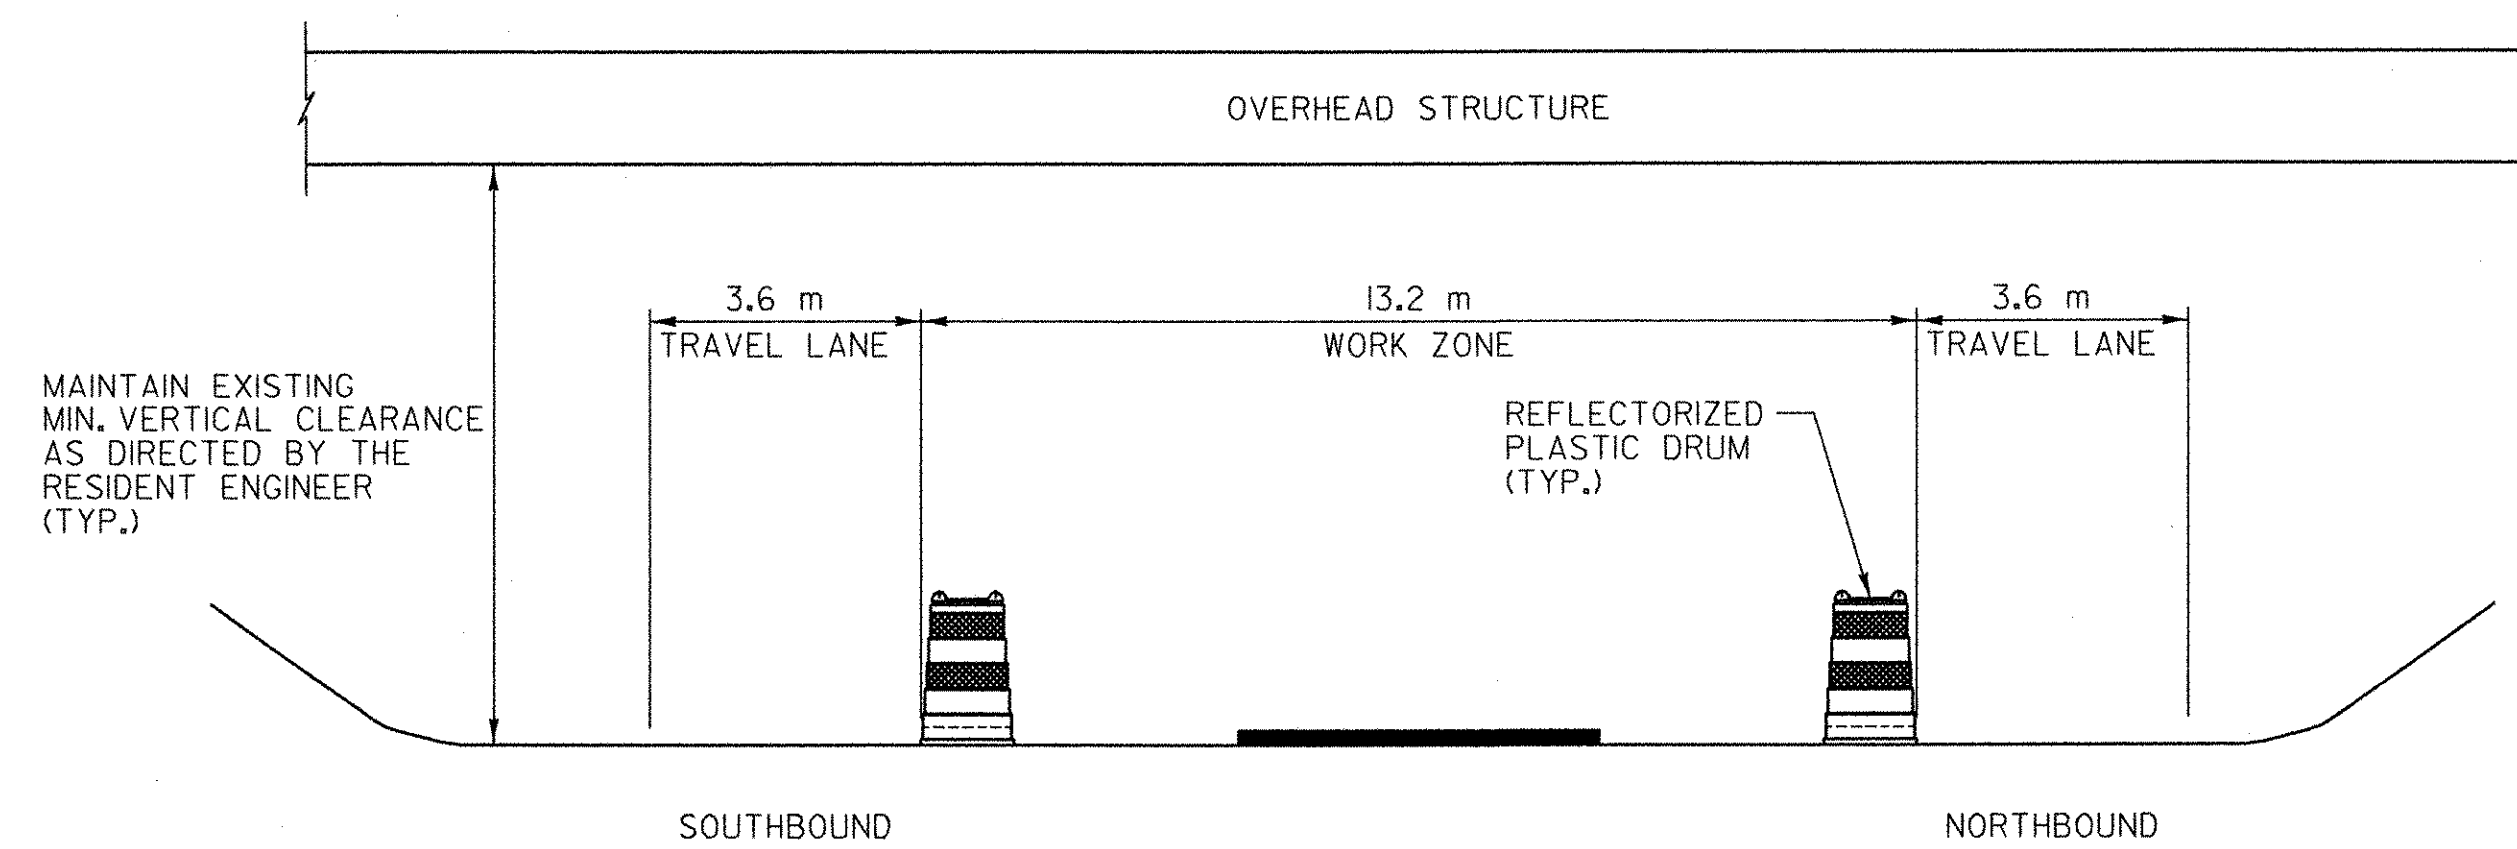

**VT. ROUTE 67A**  
**TYPICAL TEMPORARY LANE CLOSURE**  
**PHASE 2**  
 N.T.S

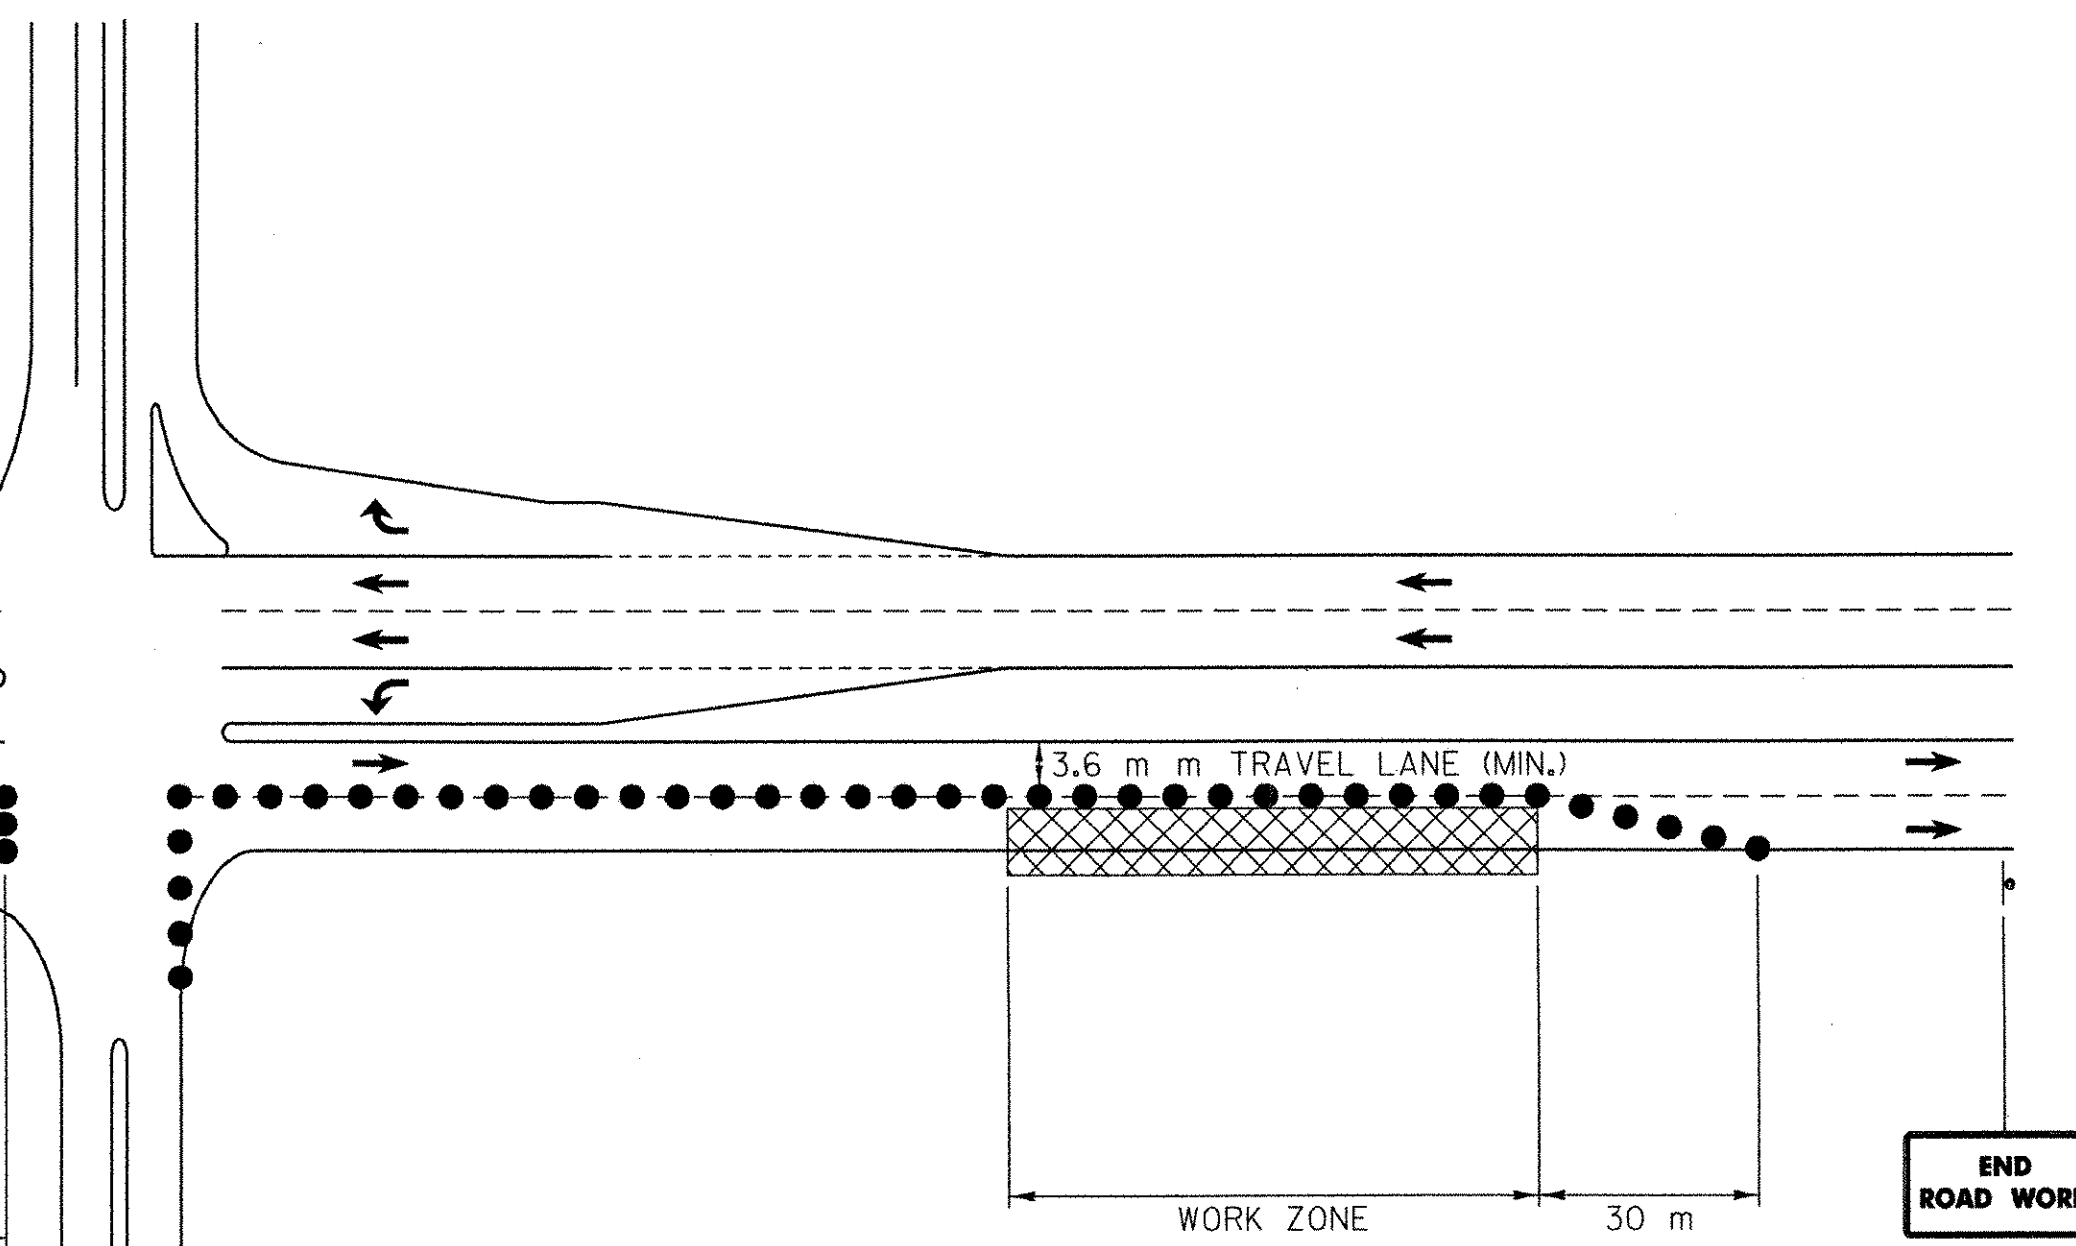

**VT. ROUTE 67A**  
**TYPICAL TEMPORARY LANE CLOSURE**  
**WITH TURN LANE**  
 N.T.S

**LEGEND**

- CHANNELIZING DEVICE (REFLECTORIZED PLASTIC DRUM)
- ↓ SIGN & POST
- ▨ WORK ZONE
- ⋯ FLASHING ARROW PANEL
- FLAGGERS

**TEMPORARY LANE CLOSURE DETAILS VT. ROUTE 67A**

SURVEYED BY	C.H.A. & V.S.E.	DATE	12/93
DESIGNED BY	D.W.E.	DATE	2/04
DRAWN BY	C.A.K.	DATE	2/04
CHECKED BY	D.E.G.	DATE	2/04
DESIGN FILE NO.	TLC01.DGN		
PROJ. NAME	BENNINGTON - HOOSICK D.P.I. 0146(II) C/6		
PROJ. NO.	P.I.N. 1306.60		
DWG. NO.	CSP-10	SHEET	33 OF 83


**NOTES**

- TEMPORARY LANE CLOSURES SHALL ONLY BE USED FOR DAILY CONSTRUCTION ACTIVITIES WITHIN THE WORK ZONE. NO TEMPORARY LANE CLOSURES SHALL BE LEFT IN PLACE OVERNIGHT OR AS DIRECTED BY THE RESIDENT ENGINEER.
- SEE VAOT STANDARD SHEET E-106M FOR CHANNELIZING DEVICE SPACING.


**DATUM**

VERTICAL	NAVD 88
HORIZONTAL	NAD 83 (1992)


FILE NAME = u:\5116\vaot\contract6\tlcb01.dgn  
 DATE/TIME = 2/16/2004  
 USER = 2225

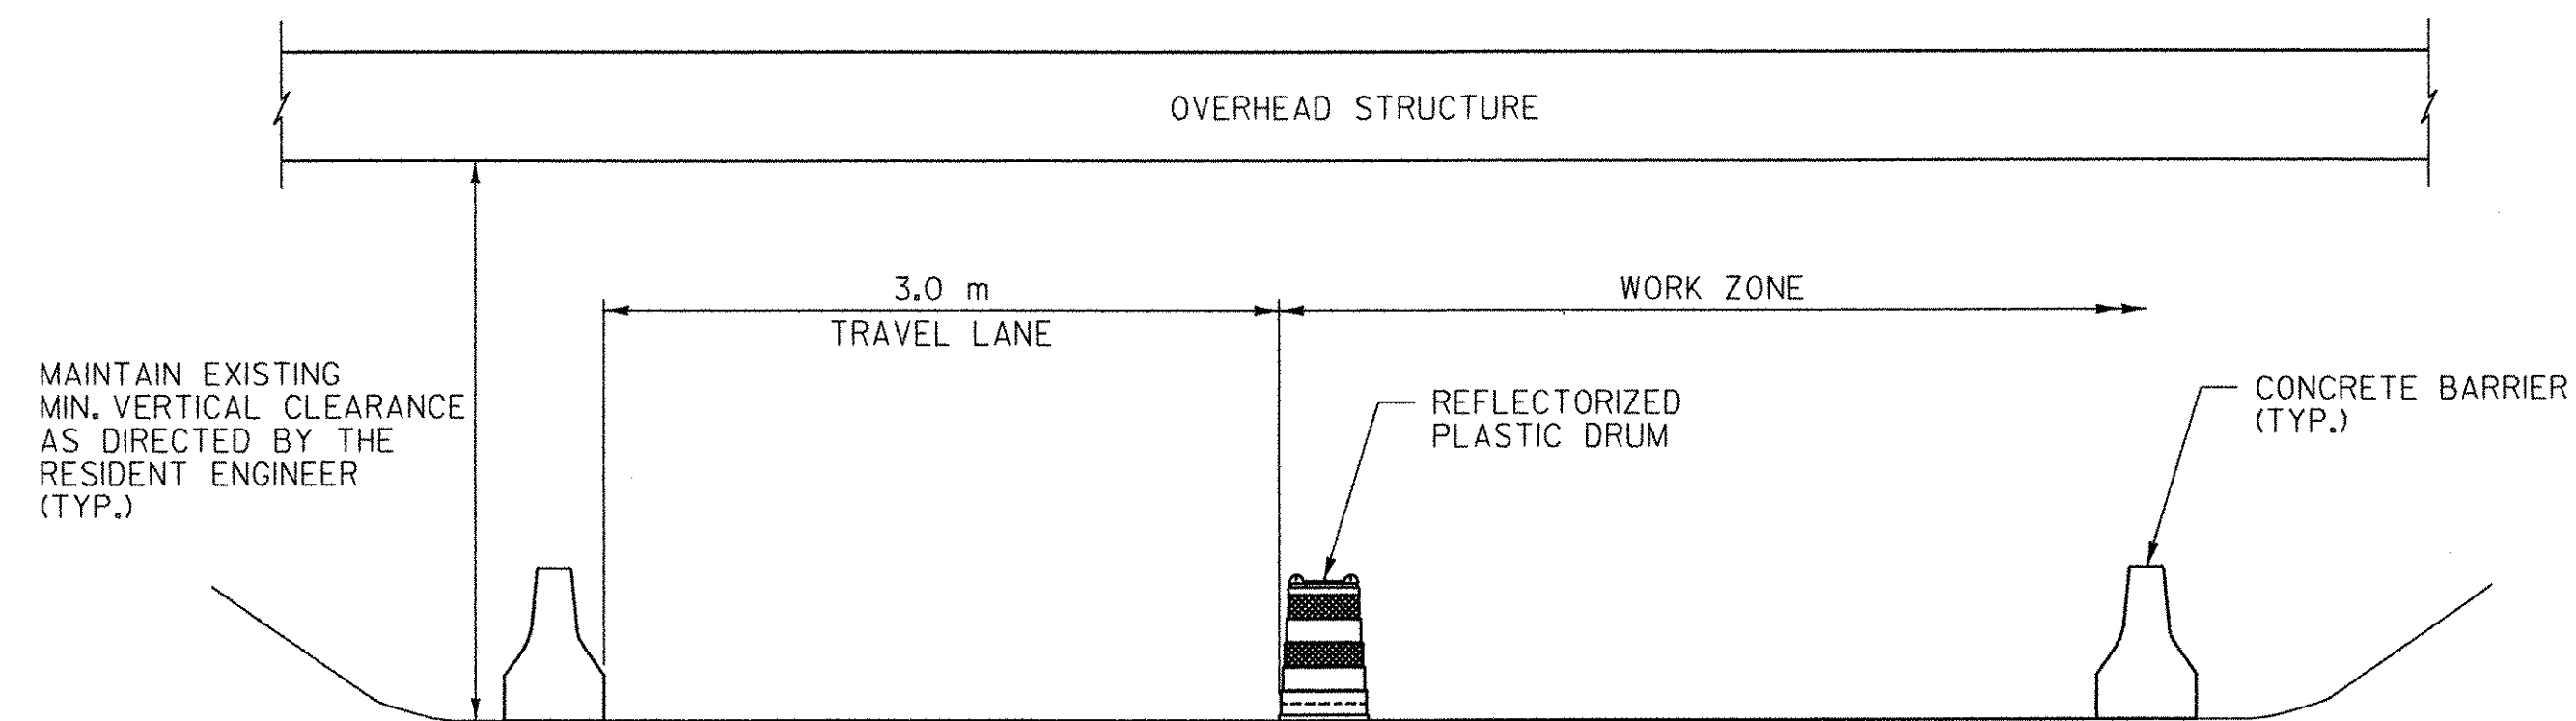

**HISTORIC VT. ROUTE 7A**  
**TYPICAL TEMPORARY LANE CLOSURE**  
**PHASE 1**  
 N.T.S

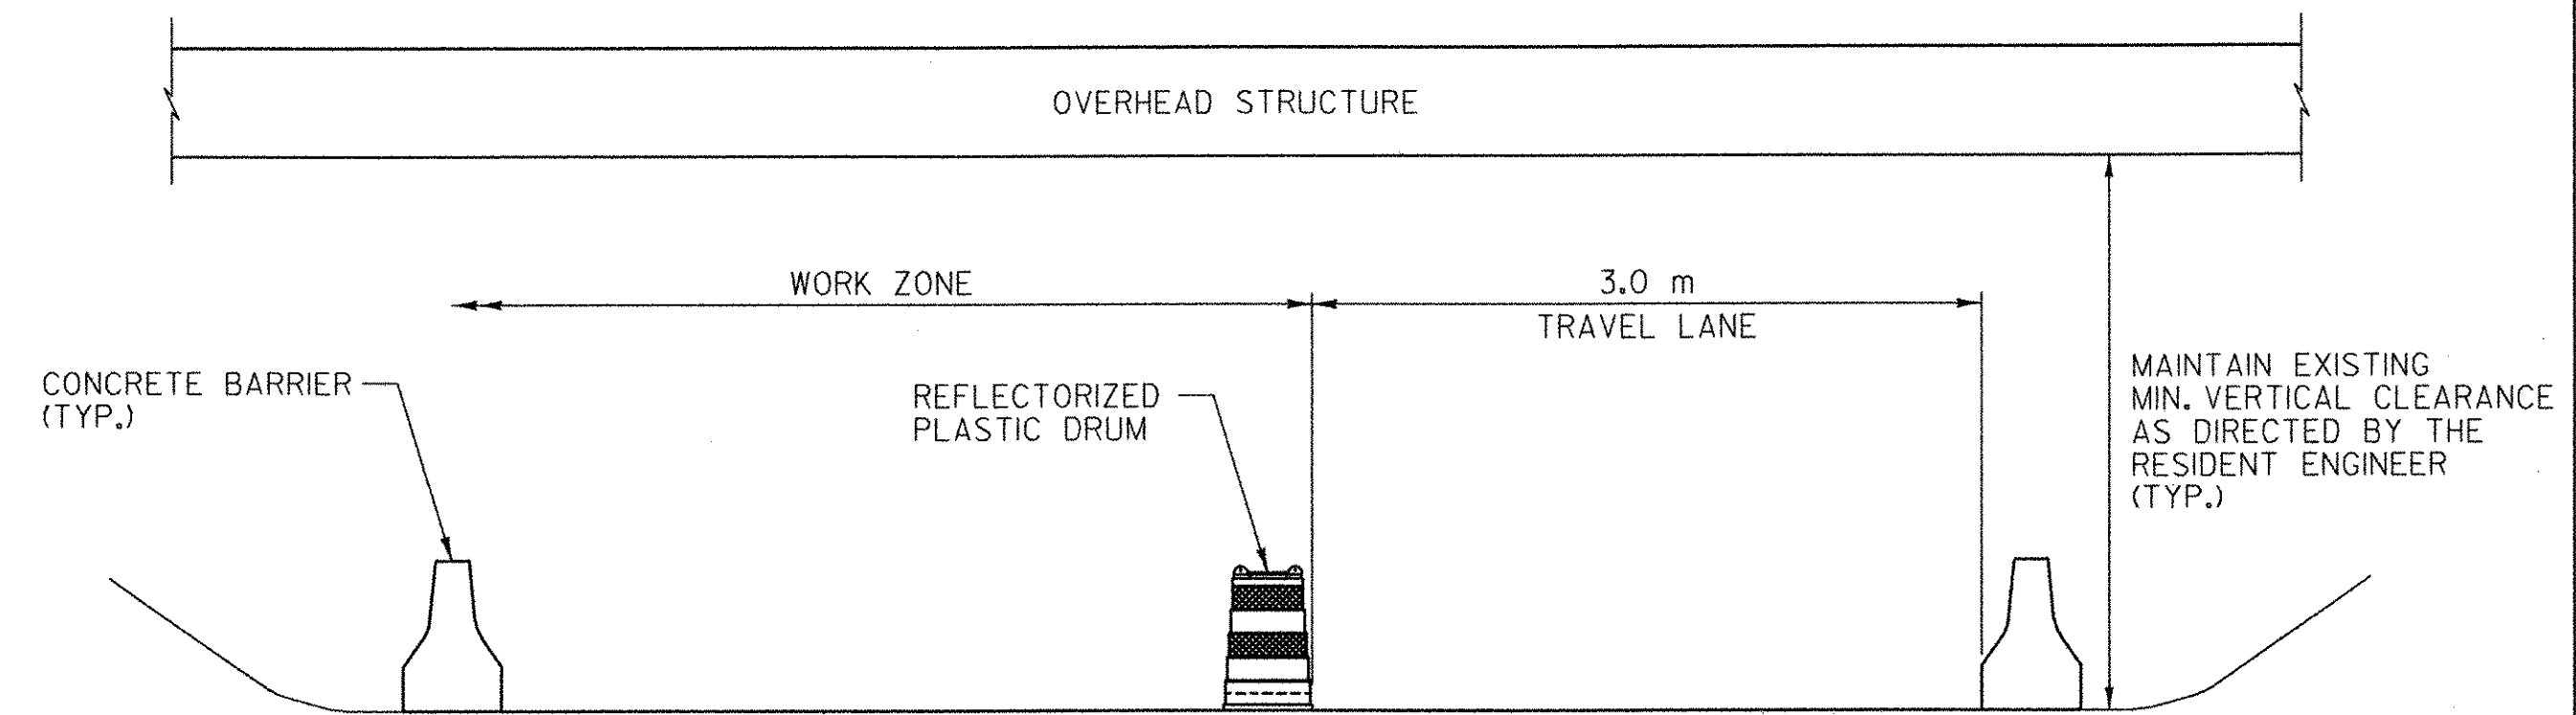

**HISTORIC VT. ROUTE 7A**  
**TYPICAL TEMPORARY LANE CLOSURE**  
**PHASE 2**  
 N.T.S

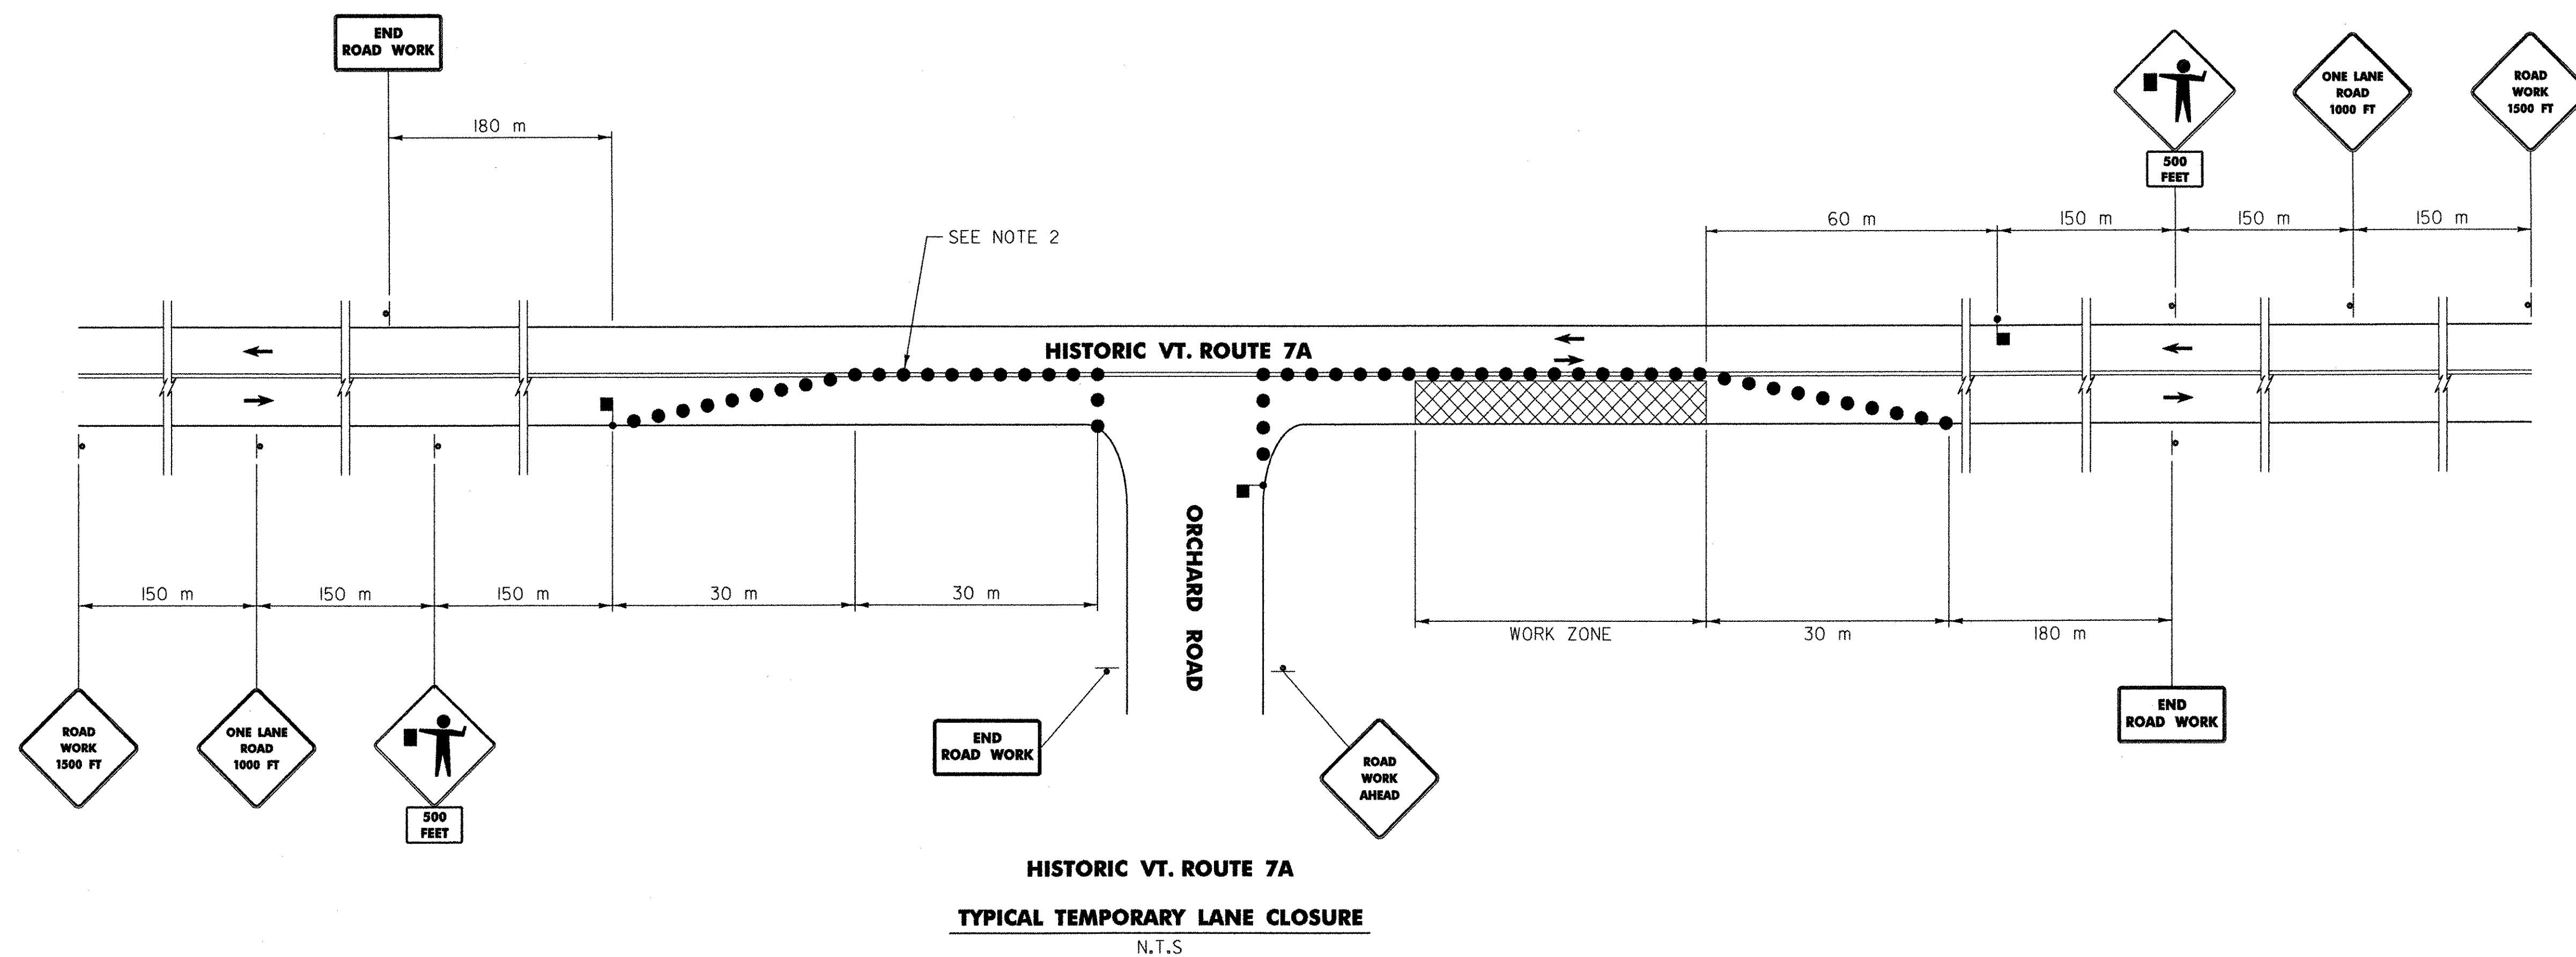

**HISTORIC VT. ROUTE 7A**  
**TYPICAL TEMPORARY LANE CLOSURE**  
 N.T.S

**NOTES**


- TEMPORARY LANE CLOSURES SHALL ONLY BE USED FOR DAILY CONSTRUCTION ACTIVITIES WITHIN THE WORK ZONE. NO TEMPORARY LANE CLOSURES SHALL BE LEFT IN PLACE OVERNIGHT OR AS DIRECTED BY THE RESIDENT ENGINEER.
- SEE VAOT STANDARD SHEET E-106M FOR CHANNELIZING DEVICE SPACING.

DATUM	
VERTICAL	NAVD 88
HORIZONTAL	NAD 83 (1992)

LEGEND	
●	CHANNELIZING DEVICE (REFLECTORIZED PLASTIC DRUM)
↓	SIGN & POST
▨	WORK ZONE
⬇	FLASHING ARROW PANEL
■	FLAGGERS


<b>TEMPORARY LANE CLOSURE DETAILS</b> <b>HISTORIC VT. ROUTE 7A</b>	SURVEYED BY	C.H.A. & V.S.E.	DATE	12/93
	DESIGNED BY	D.W.E.	DATE	2/04
	DRAWN BY	C.A.K.	DATE	2/04
	CHECKED BY	D.E.G.	DATE	2/04
DESIGN FILE NO. TLC0LDGN				
PROJ. NAME BENNINGTON - HOOSICK D.P.J. 0146(1) C/6				
PROJ. NO. P.I.N. 1306.60				
DWG NO. CSP-II SHEET 34 OF 83				

FILE NAME = ur\5116\vaot\contract6\tle01.dgn  
 DATE/TIME = 2/16/2004  
 USER = zzz25

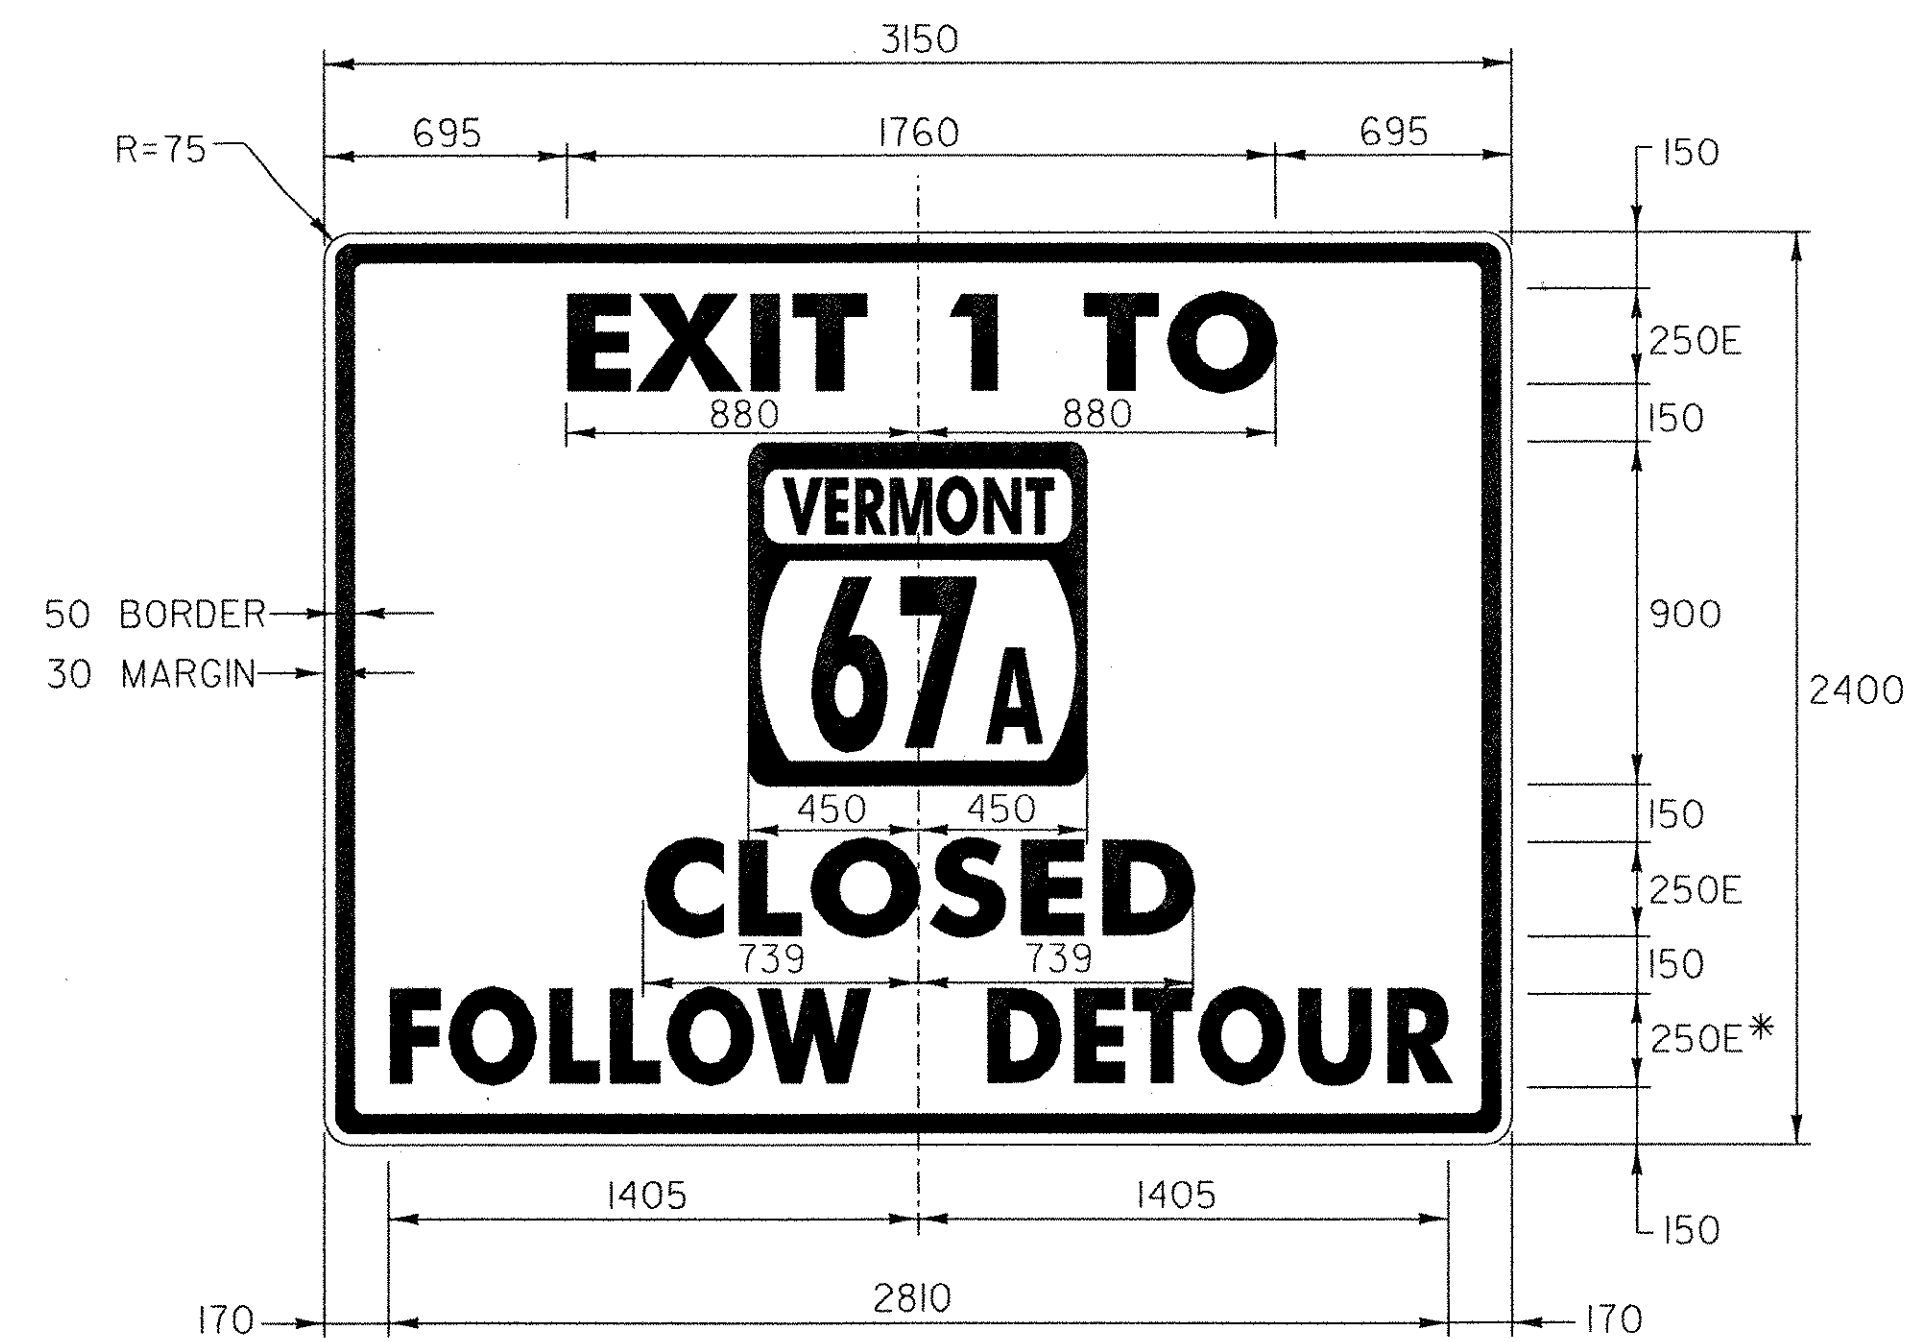

COLOR: BLACK BORDER & TEXT (REFLECTORIZED)  
ORANGE BACKGROUND (REFLECTORIZED)

MATERIAL: PER VAOT STANDARD E-131M  
\* 50% REDUCTION IN SPACING

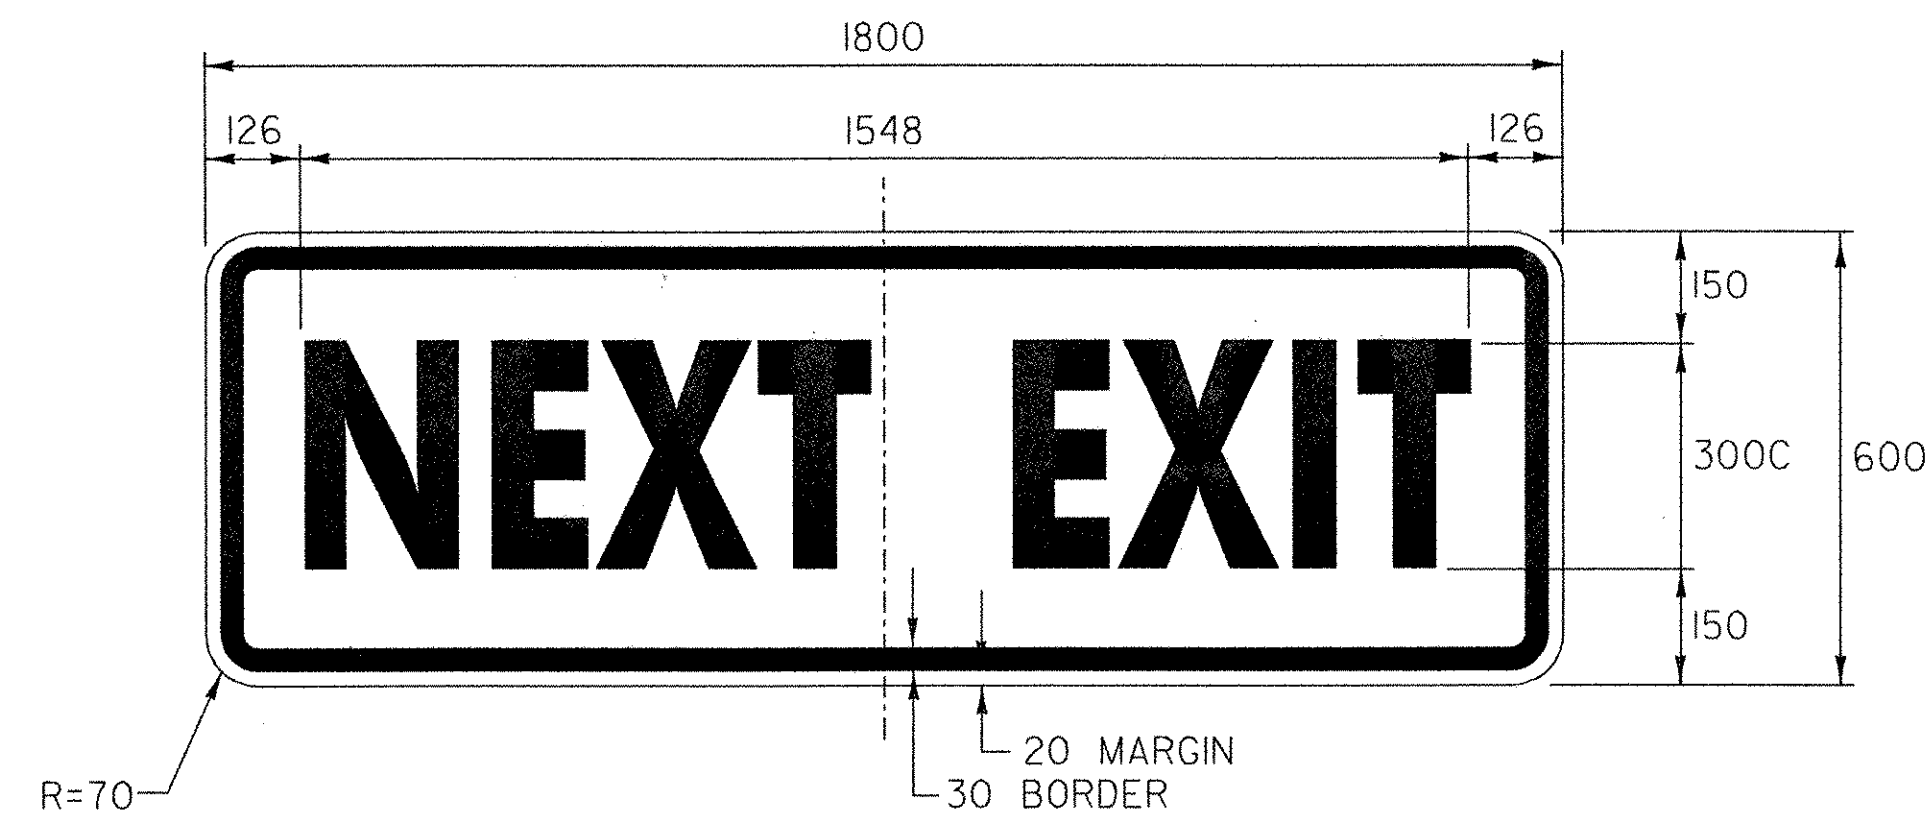

COLOR: BLACK BORDER & TEXT (REFLECTORIZED)  
ORANGE BACKGROUND (REFLECTORIZED)

MATERIAL: PER VAOT STANDARD E-155M

ALL DIMENSIONS IN MILLIMETERS UNLESS OTHERWISE NOTED.

**CONSTRUCTION SIGN DETAILS**


SURVEYED BY C.H.A. & V.S.E. DATE 12/93  
DESIGNED BY D.W.E. DATE 2/04  
DRAWN BY C.A.K. DATE 2/04  
CHECKED BY D.E.G. DATE 2/04

DESIGN FILE NO. DETPLO6.DGN  
PROJ. NAME BENNINGTON - HOOSICK  
D.P.I. 0146(II) C/6  
PROJ. NO. P.I.N.1306.60  
DWG NO. CSP-12 SHEET 35 OF 83

TEXT LAYOUT DIMENSIONS ARE BASED ON THE 'LETTER & NUMERAL WIDTHS AND SPACE' TABLES FOUND IN THE 'STANDARD HIGHWAY SIGNS' BOOKLET. MINOR VARIATIONS IN TEXT DIMENSIONS ARE ACCEPTABLE BASED ON INDIVIDUAL MANUFACTURER'S LETTER FABRICATION. SIGNIFICANT CHANGES WHICH AFFECT SIGN APPEARANCE SHALL BE BROUGHT TO THE ATTENTION OF THE VAOT'S TRAFFIC OPERATIONS SECTION AND RESIDENT ENGINEER FOR APPROVAL BEFORE FABRICATION.


FILE NAME =u:\5116\vaot\contr-act6\detp106.dgn  
DATE/TIME =2/16/2004  
USER =2225

DATUM	
VERTICAL	NAVD 88
HORIZONTAL	NAD 83 (1992)

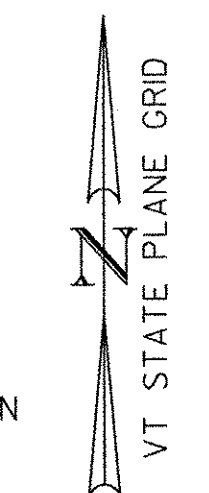

646.614 TEMPORARY 150 mm WHITE LINE (TYPE II TAPE)  
 W.B. STA. 17+305.027 - W.B. STA. 17+540.000 SOLID LT (EDGE LINE)  
 STA. BIO+064.800 - STA. BIO+175.097 RT (EDGE LINE)



646.615 TEMPORARY 150 mm YELLOW LINE (TYPE II TAPE)  
 W.B. STA. 17+305.027 - W.B. STA. 17+540.000 SOLID RT (EDGE LINE)  
 STA. BIO+064.800 - STA. BIO+175.097 LT (EDGE LINE)

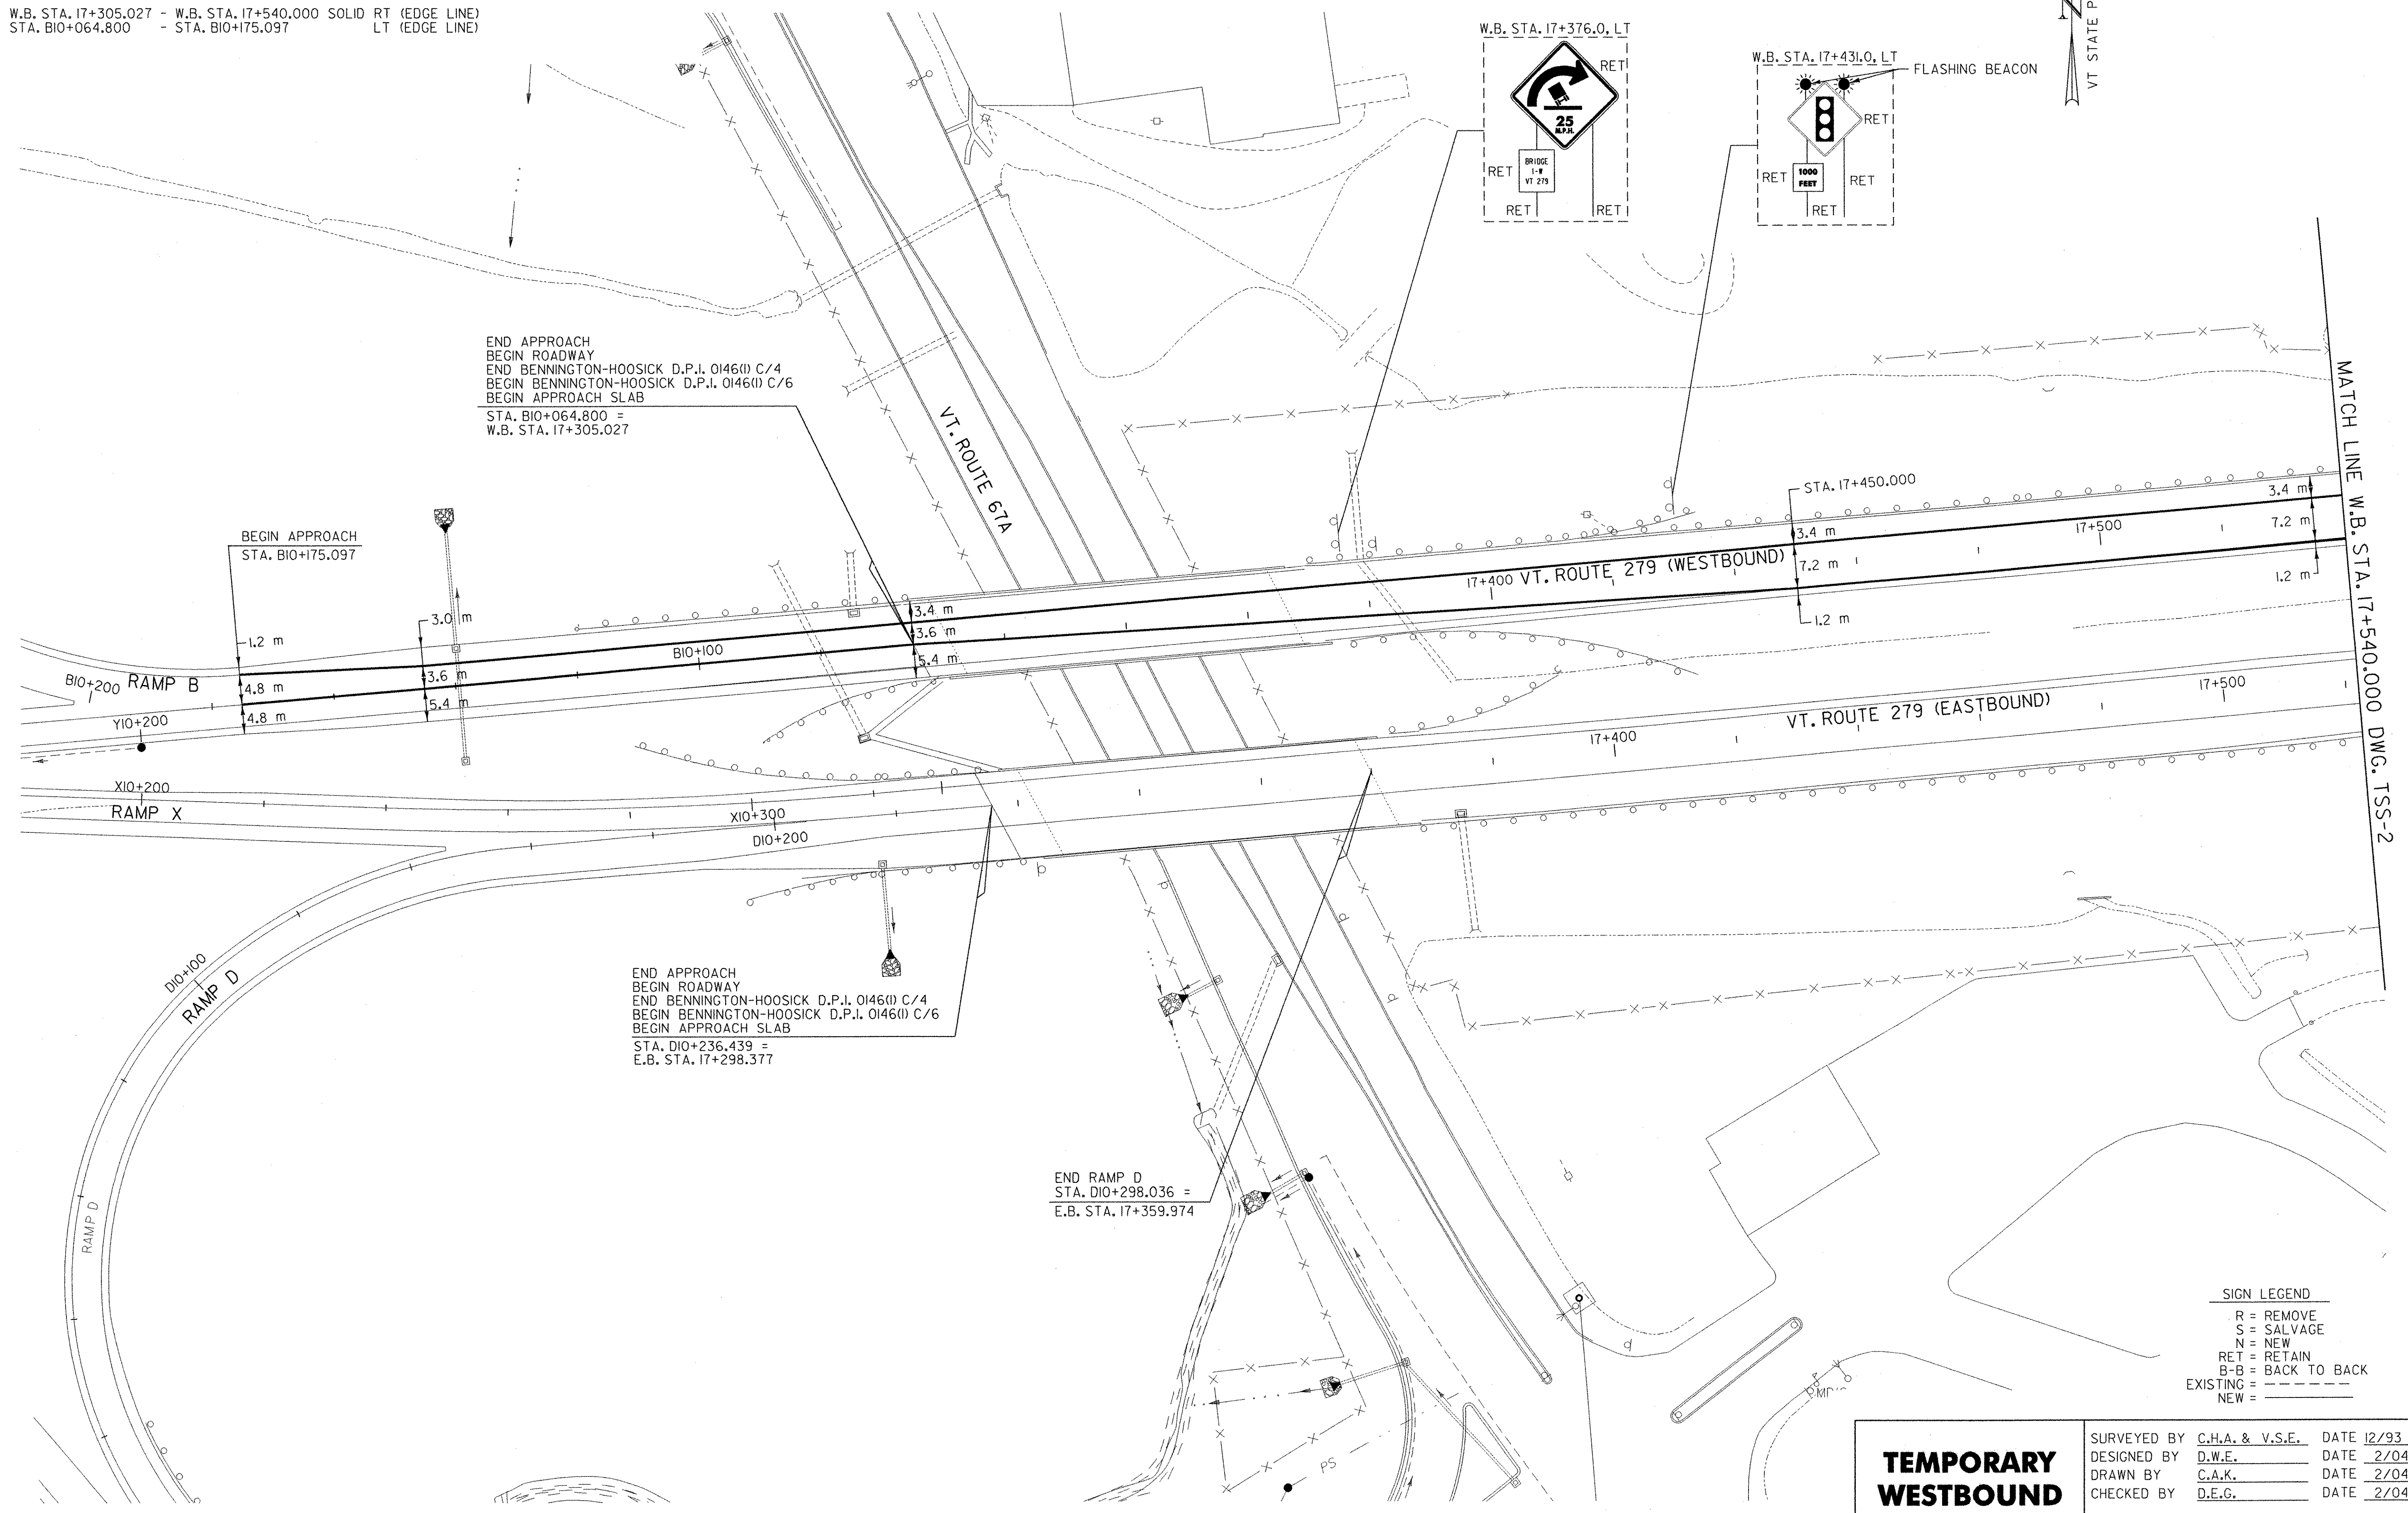

END APPROACH  
 BEGIN ROADWAY  
 END BENNINGTON-HOOSICK D.P.I. 0146(1) C/4  
 BEGIN BENNINGTON-HOOSICK D.P.I. 0146(1) C/6  
 BEGIN APPROACH SLAB  
 STA. BIO+064.800 =  
 W.B. STA. 17+305.027

END APPROACH  
 BEGIN ROADWAY  
 END BENNINGTON-HOOSICK D.P.I. 0146(1) C/4  
 BEGIN BENNINGTON-HOOSICK D.P.I. 0146(1) C/6  
 BEGIN APPROACH SLAB  
 STA. DIO+236.439 =  
 E.B. STA. 17+298.377


END RAMP D  
 STA. DIO+298.036 =  
 E.B. STA. 17+359.974

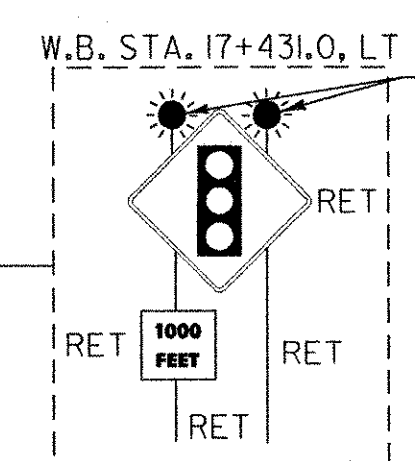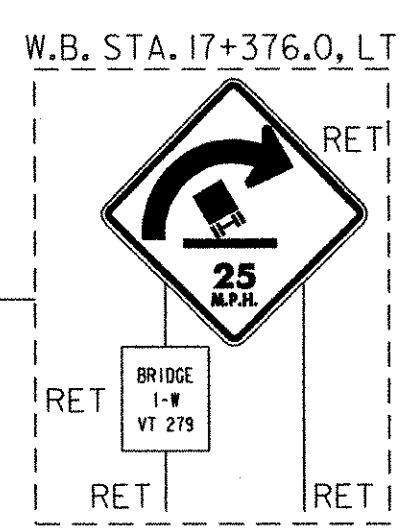


**SIGN LEGEND**  
 R = REMOVE  
 S = SALVAGE  
 N = NEW  
 RET = RETAIN  
 B-B = BACK TO BACK  
 EXISTING = - - - - -  
 NEW = \_\_\_\_\_

FILE NAME = ur\5116\vaot\contract6\tss01.dgn  
 DATE/TIME = 2/16/2004  
 USER = 2225


**DATUM**  
 VERTICAL      NAVD 88  
 HORIZONTAL    NAD 83 (1992)

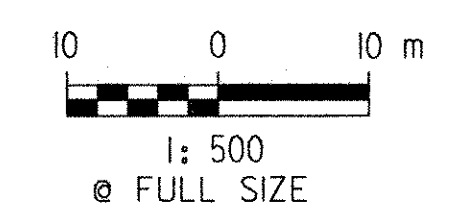

<b>TEMPORARY WESTBOUND SIGNING AND STRIPING PLAN</b>	SURVEYED BY	C.H.A. & V.S.E.	DATE	12/93
	DESIGNED BY	D.W.E.	DATE	2/04
	DRAWN BY	C.A.K.	DATE	2/04
	CHECKED BY	D.E.G.	DATE	2/04
DESIGN FILE NO.	TSS01.DGN			
PROJ. NAME	BENNINGTON - HOOSICK D.P.I. 0146(1) C/6			
PROJ. NO.	P.I.N. 1306.60			
DWG. NO.	TSP-1	SHEET 36 OF 83		

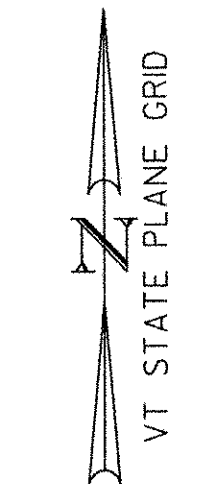

646.614 TEMPORARY 150 mm WHITE LINE (TYPE II TAPE)  
 W.B. STA. 17+540.000 - W.B. STA. 17+840.000 SOLID LT (EDGE LINE)  
 W.B. STA. 17+615.000 - W.B. STA. 17+840.000 DASHED C (LANE LINE)  
 646.615 TEMPORARY 150 mm YELLOW LINE (TYPE II TAPE)  
 W.B. STA. 17+540.000 - W.B. STA. 17+840.000 SOLID RT (EDGE LINE)

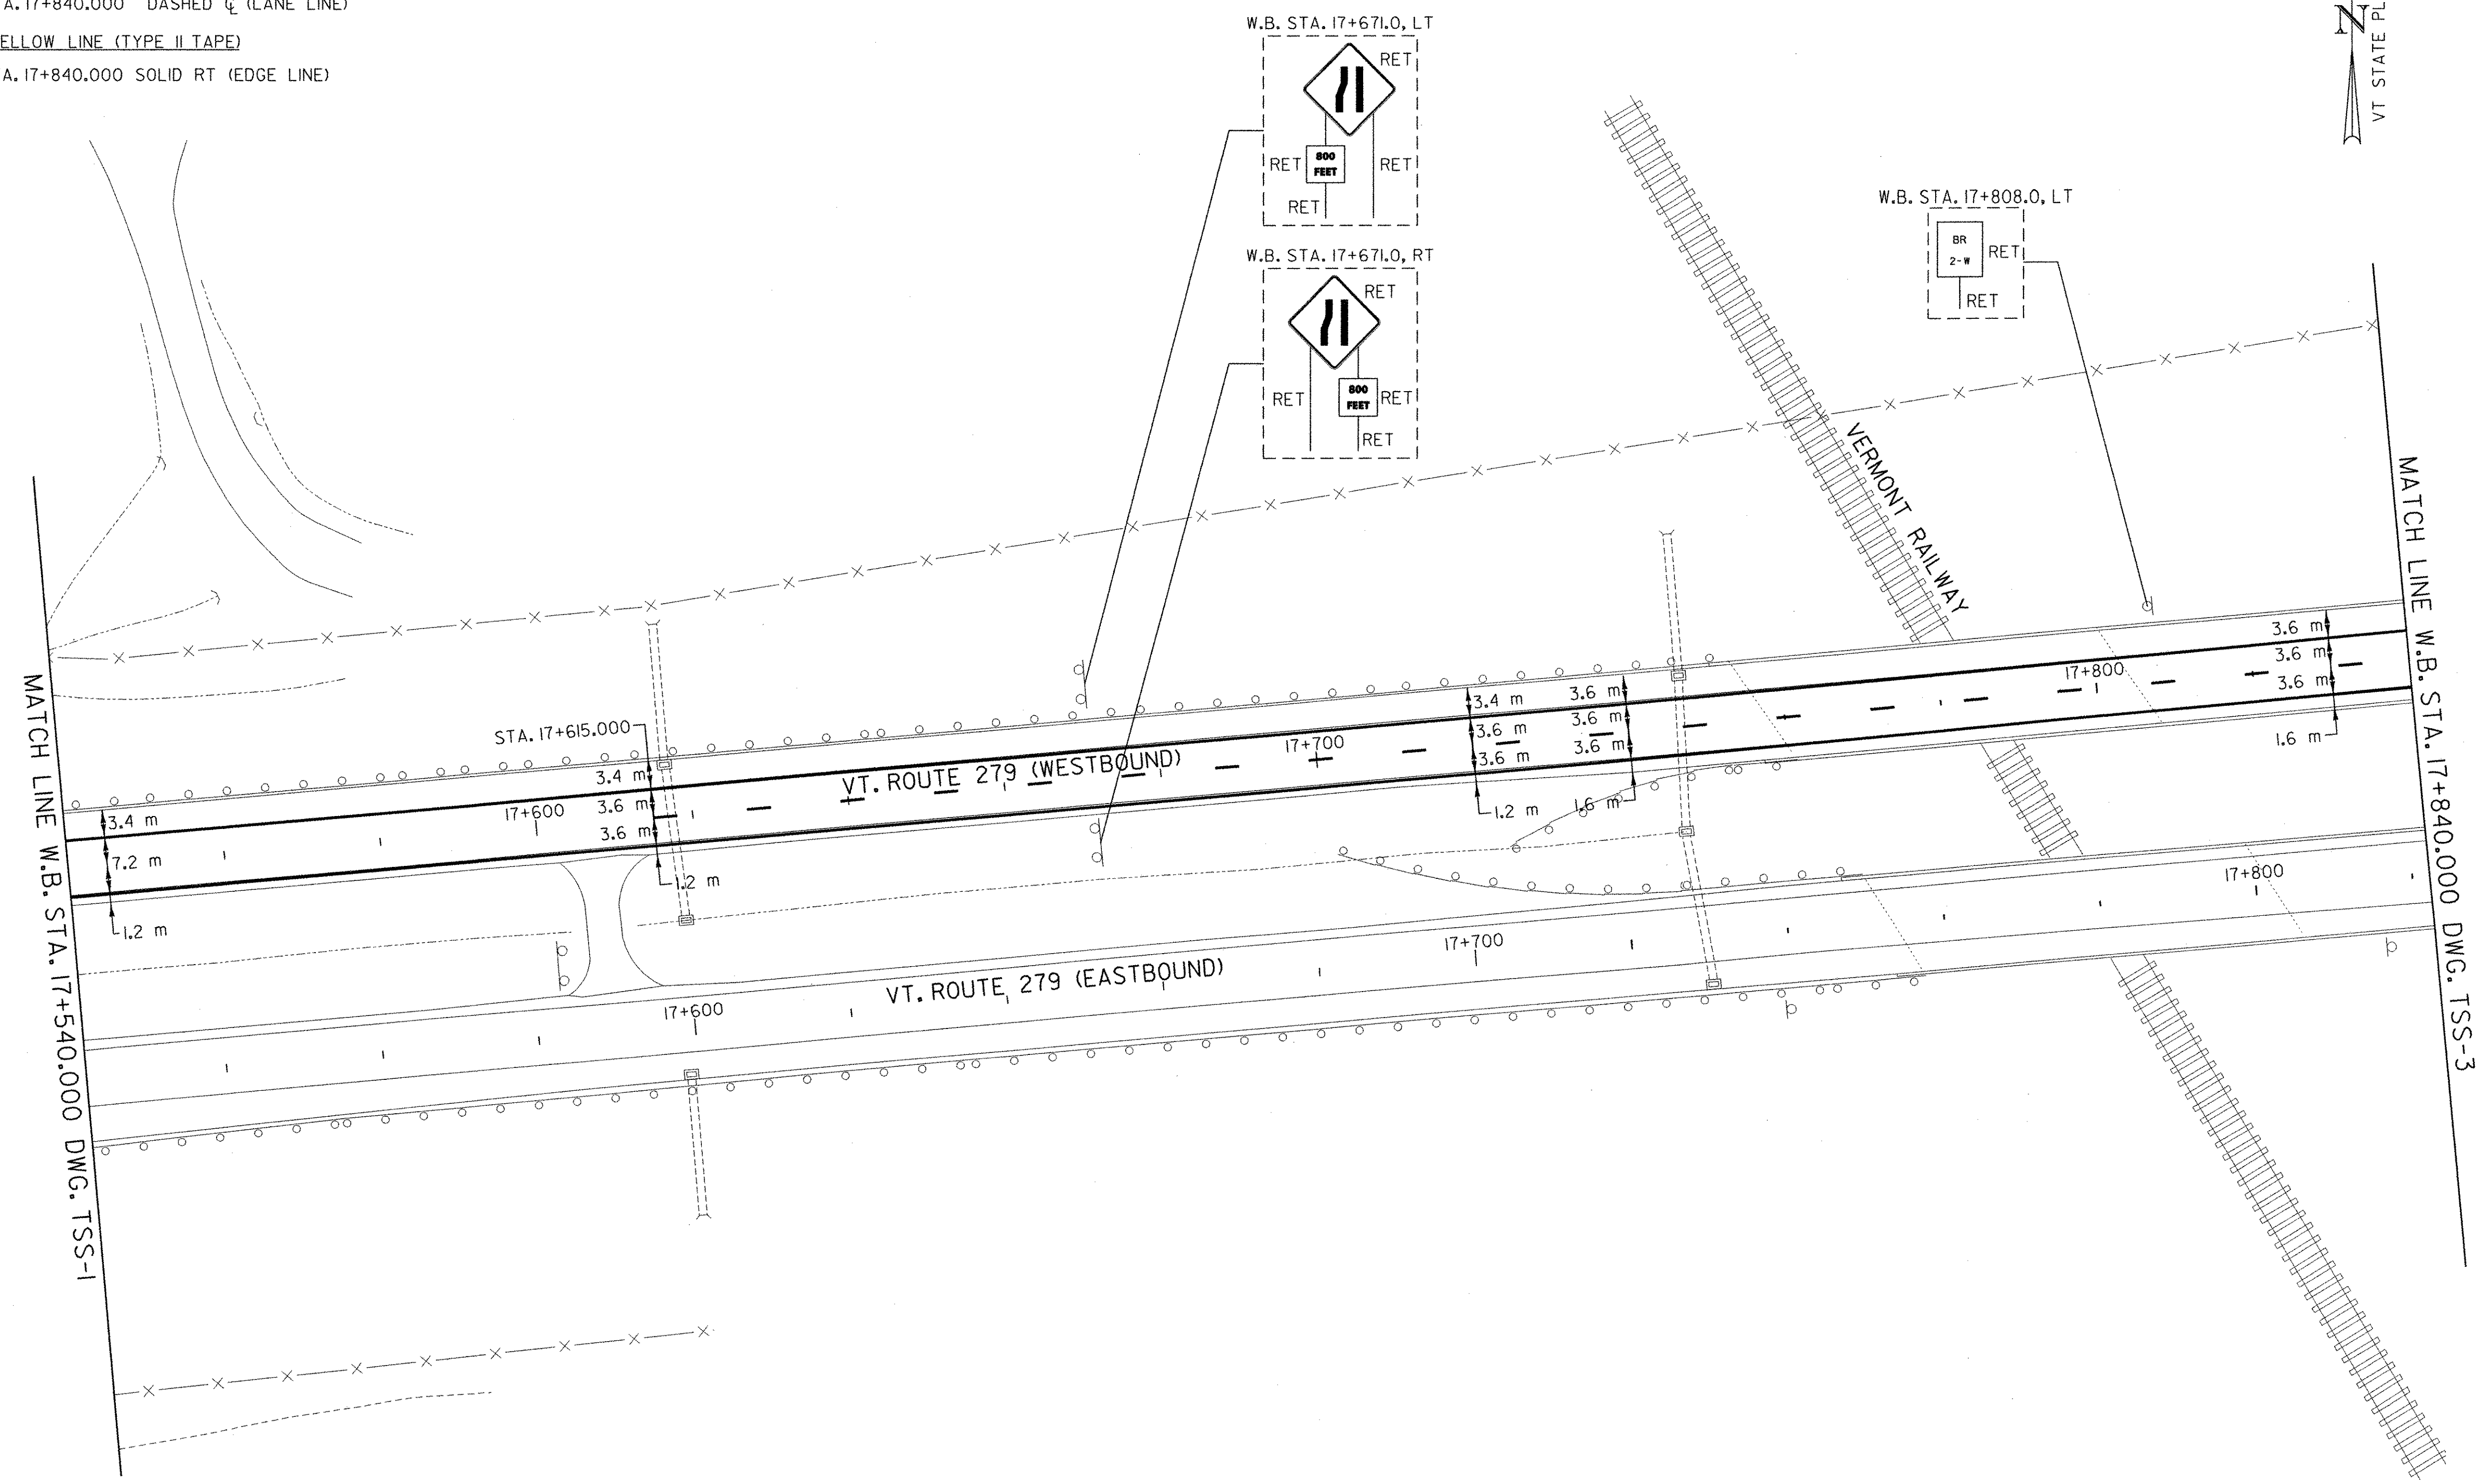


MATCH LINE W.B. STA. 17+540.000 DWG. TSS-1

MATCH LINE W.B. STA. 17+840.000 DWG. TSS-3

**SIGN LEGEND**  
 R = REMOVE  
 S = SALVAGE  
 N = NEW  
 RET = RETAIN  
 B-B = BACK TO BACK  
 EXISTING = - - - - -  
 NEW = \_\_\_\_\_

FILE NAME = ur\5116\voort\contract6\tss02.dgn  
 DATE = 5/16/2004  
 USER = 2225

DATUM	
VERTICAL	NAVD 88
HORIZONTAL	NAD 83 (1992)

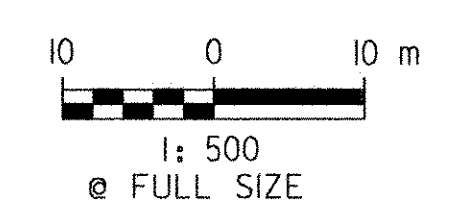


<b>TEMPORARY WESTBOUND SIGNING AND STRIPING PLAN</b>	SURVEYED BY	C.H.A. & V.S.E.	DATE	12/93
	DESIGNED BY	D.W.E.	DATE	2/04
	DRAWN BY	C.A.K.	DATE	2/04
	CHECKED BY	D.E.G.	DATE	2/04
DESIGN FILE NO.	TSS02.DGN			
PROJ. NAME	BENNINGTON - HOOSICK D.P.I. 0146(I) C/6			
PROJ. NO.	P.I.N. 1306.60			
DWG NO.	TSP-2	SHEET 37 OF 83		



646.614 TEMPORARY 150 mm WHITE LINE (TYPE II TAPE)  
 W.B. STA. 17+840.000 - W.B. STA. 17+938.000 DASHED @ (LANE LINE)  
 W.B. STA. 17+840.000 - W.B. STA. 17+941.584 SOLID LT (EDGE LINE)  
 W.B. STA. 17+982.000 - W.B. STA. 18+000.000 SOLID LT (EDGE LINE)  
 STA. E2+320.000 - STA. E2+471.417 SOLID RT (EDGE LINE)


646.615 TEMPORARY 150 mm YELLOW LINE (TYPE II TAPE)  
 W.B. STA. 17+840.000 - W.B. STA. 18+000.000 SOLID RT (EDGE LINE)  
 STA. E2+320.000 - STA. E2+434.500 SOLID LT (EDGE LINE)

646.64 TEMPORARY 300 mm WHITE LINE (TYPE II TAPE)  
 W.B. STA. 17+938.000 - W.B. STA. 17+982.000 SOLID @ (GORE LINE)  
 STA. E2+434.500 - STA. E2+461.000 SOLID LT (GORE LINE)

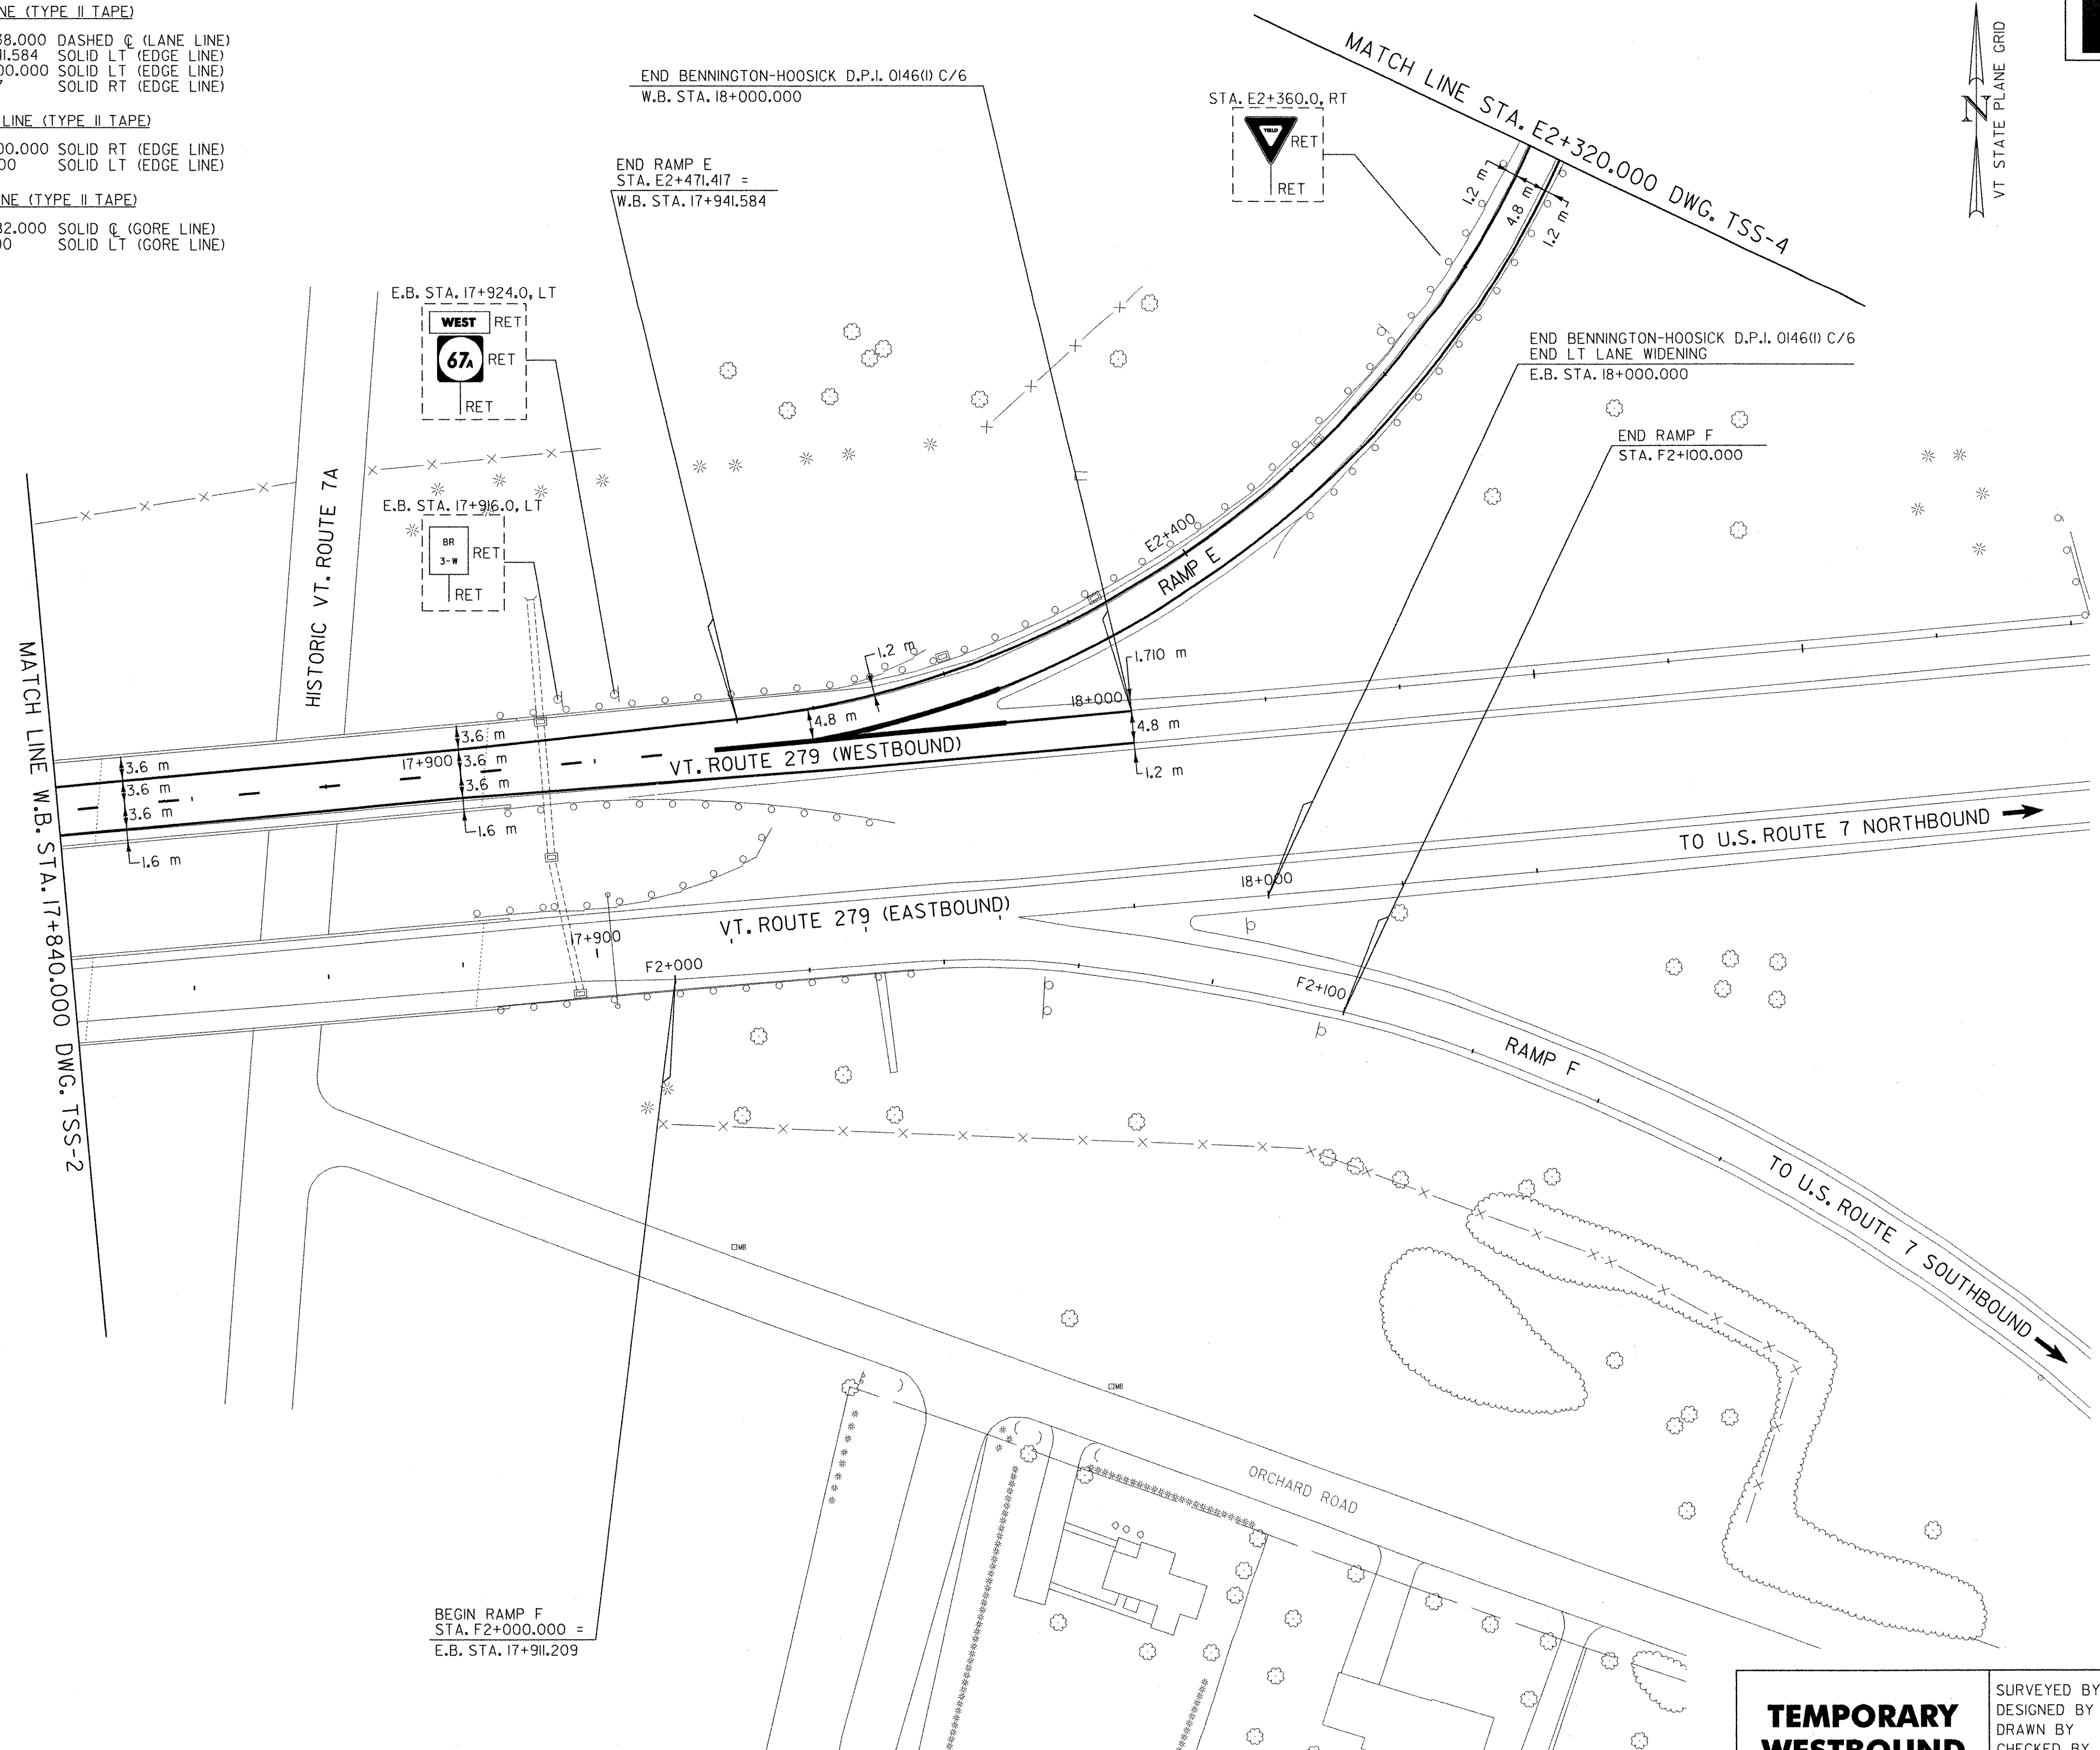

FILE NAME = ut:\5116\svoot\contract6\tss03.dgn  
 DATE/TIME = 2/16/2004  
 USER = 2225

DATUM	
VERTICAL	NAVD 88
HORIZONTAL	NAD 83 (1992)

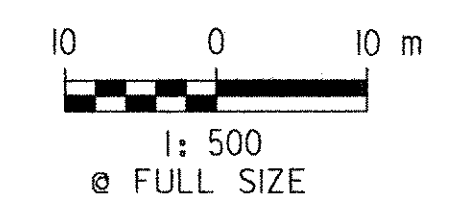

**SIGN LEGEND**

R = REMOVE
S = SALVAGE
N = NEW
RET = RETAIN
B-B = BACK TO BACK
EXISTING = - - - - -
NEW = _____

**TEMPORARY WESTBOUND SIGNING AND STRIPING PLAN**

SURVEYED BY	C.H.A. & V.S.E.	DATE	12/93
DESIGNED BY	D.W.E.	DATE	2/04
DRAWN BY	C.A.K.	DATE	2/04
CHECKED BY	D.E.G.	DATE	2/04

DESIGN FILE NO. TSS03.DGN


PROJ. NAME BENNINGTON - HOOSICK  
D.P.I. 0146(II) C/6

PROJ. NO. P.I.N. 1306.60

DWG NO. TSP-3 SHEET 38 OF 83




646.614 TEMPORARY 150 mm WHITE LINE (TYPE II TAPE)  
 STA. E2+070.000 - STA. E2+320.000 SOLID RT (EDGE LINE)  
 646.615 TEMPORARY 150 mm YELLOW LINE (TYPE II TAPE)  
 STA. E2+070.000 - STA. E2+320.000 SOLID LT (EDGE LINE)

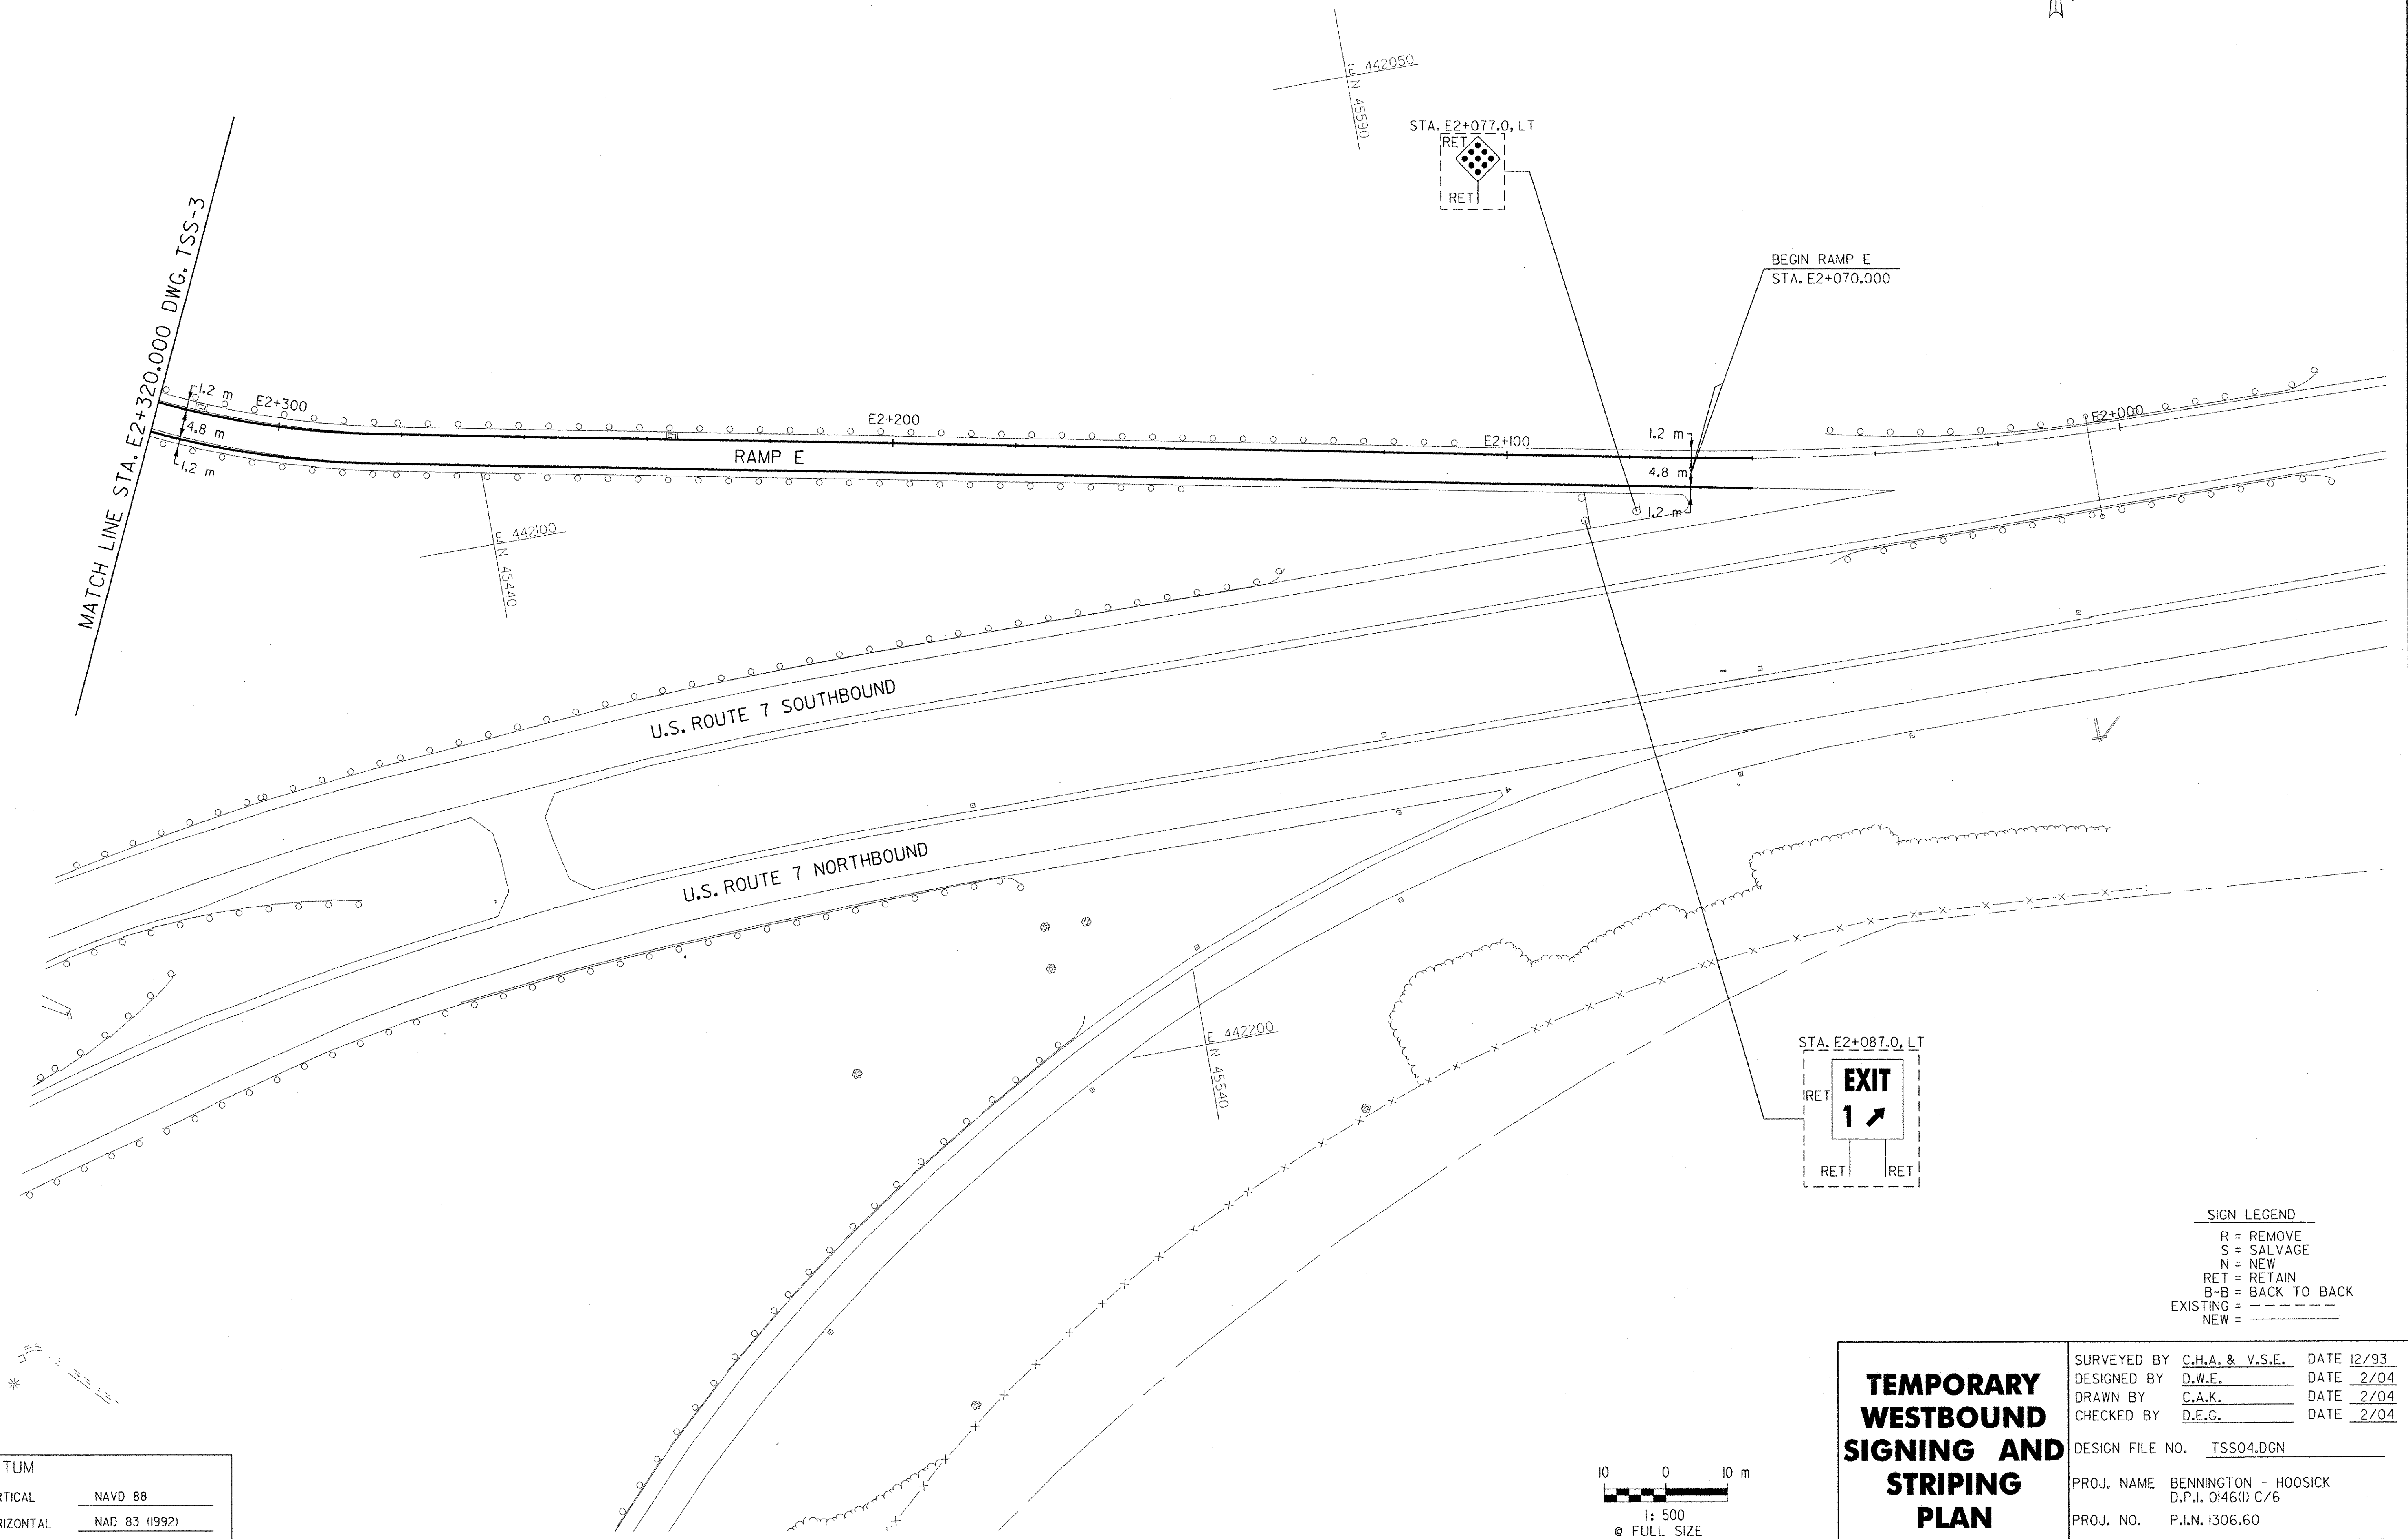


**SIGN LEGEND**  
 R = REMOVE  
 S = SALVAGE  
 N = NEW  
 RET = RETAIN  
 B-B = BACK TO BACK  
 EXISTING = - - - - -  
 NEW = \_\_\_\_\_

<b>TEMPORARY WESTBOUND SIGNING AND STRIPING PLAN</b>	SURVEYED BY	C.H.A. & V.S.E.	DATE	12/93
	DESIGNED BY	D.W.E.	DATE	2/04
	DRAWN BY	C.A.K.	DATE	2/04
	CHECKED BY	D.E.G.	DATE	2/04
DESIGN FILE NO.	TSS04.DGN			
PROJ. NAME	BENNINGTON - HOOSICK D.P.I. 0146(II) C/6			
PROJ. NO.	P.I.N. 1306.60			
DWG NO.	TSP-4	SHEET		39 OF 83

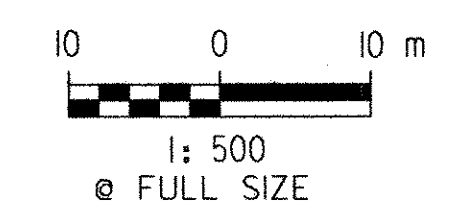

<b>DATUM</b>	
VERTICAL	NAVD 88
HORIZONTAL	NAD 83 (1992)


FILE NAME = u:\5116\vaot\contract6\tss04.dgn  
 DATE/TIME = 2/16/2004  
 USER = 2225

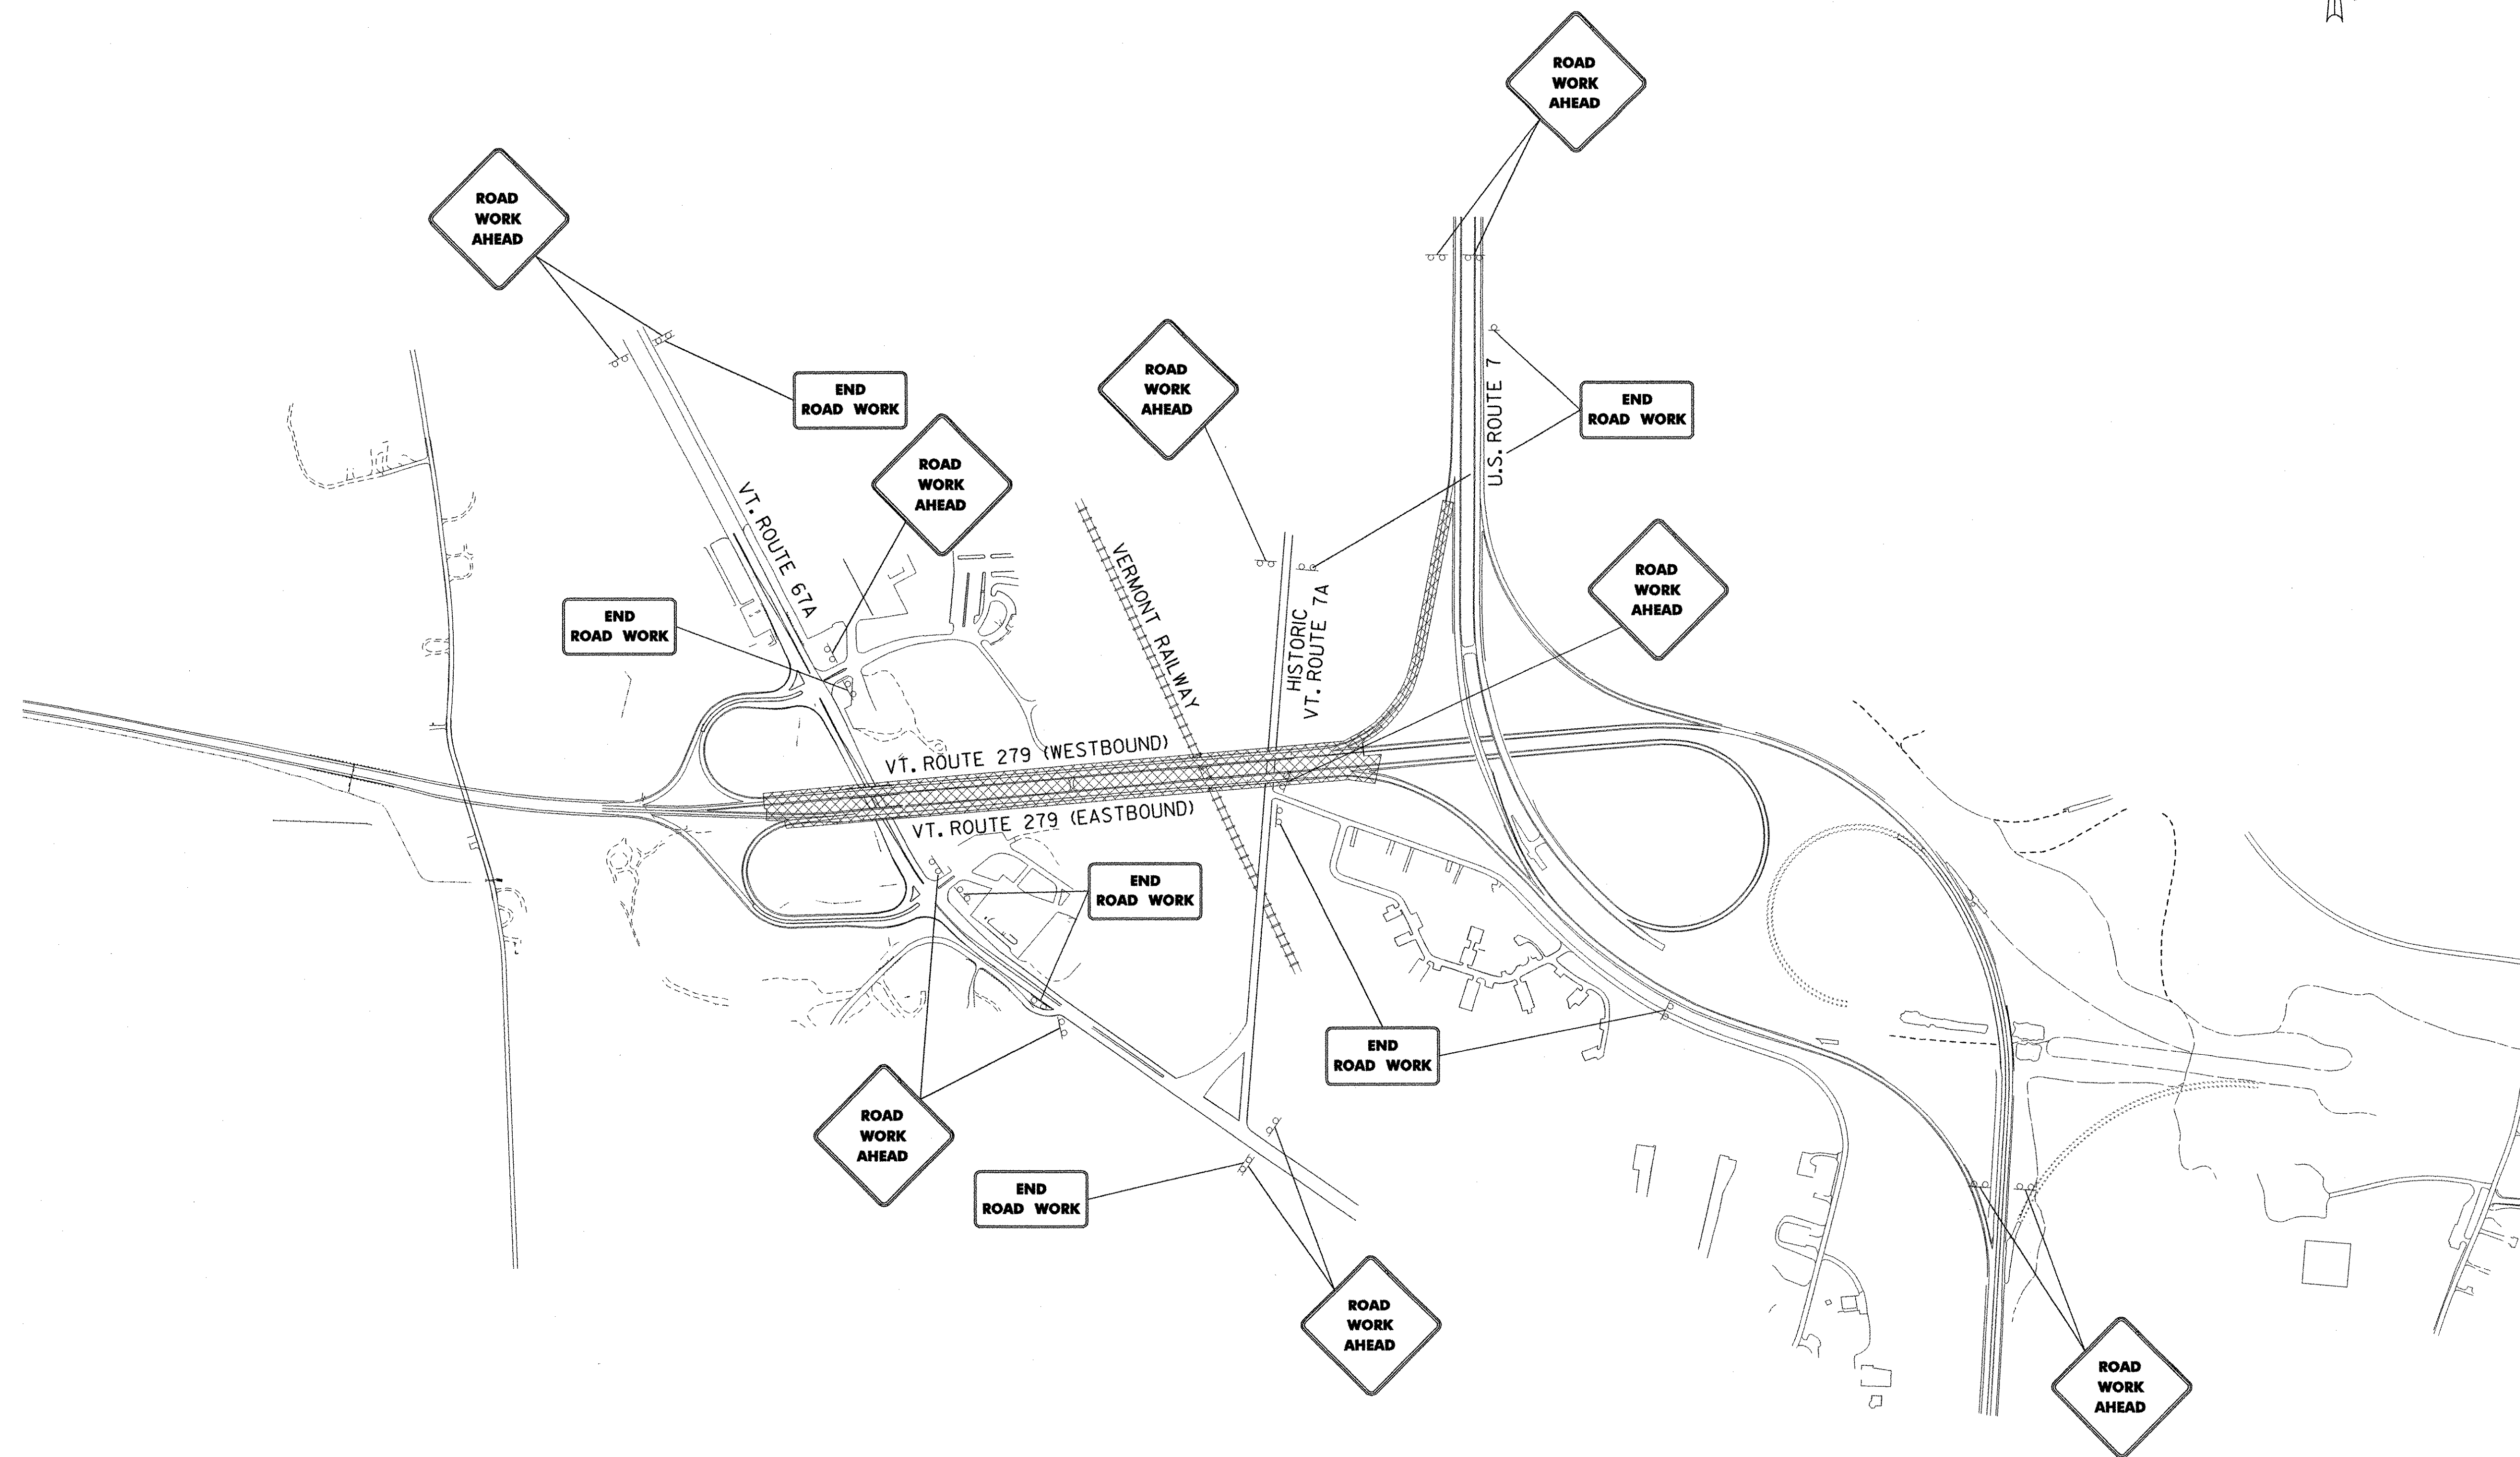

FILE NAME = u:\5116\svoot\contract6\ces.dgn  
 DATE/TIME = 2/16/2004  
 USER = 2225

DATUM	
VERTICAL	NAVD 88
HORIZONTAL	NAD 83 (1992)

PROJECT AREA

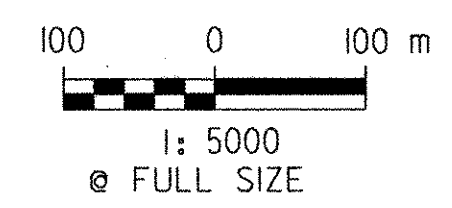

**CONSTRUCTION  
 APPROACH  
 SIGNING  
 DETAIL  
 SHEET**

SURVEYED BY	C.H.A. & V.S.E.	DATE	12/93
DESIGNED BY	D.W.E.	DATE	2/04
DRAWN BY	C.A.K.	DATE	2/04
CHECKED BY	D.E.G.	DATE	2/04
DESIGN FILE NO.	CAS.DGN		
PROJ. NAME	BENNINGTON - HOOSICK D.P.I. 0146(II) C/6		
PROJ. NO.	P.I.N. 1306.60		
DWG NO.	CAS-1	SHEET	40 OF 83

646.414 DURABLE 150 mm WHITE LINE  
 W.B. STA. 17+305.027 - W.B. STA. 17+540.000 DASHED C (LANE LINE)  
 W.B. STA. 17+305.027 - W.B. STA. 17+540.000 SOLID LT (EDGE LINE)  
 E.B. STA. 17+298.377 - E.B. STA. 17+522.100 DASHED C (LANE LINE)  
 E.B. STA. 17+298.377 - E.B. STA. 17+522.100 SOLID RT (EDGE LINE)  
 STA. BIO+064.800 - STA. BIO+100.000 DASHED C (LANE LINE)  
 STA. BIO+064.800 - STA. BIO+100.000 SOLID RT (EDGE LINE)  
 STA. BIO+064.800 - STA. BIO+175.097 SOLID RT (EDGE LINE)  
 STA. DIO+140.000 - STA. DIO+237.962 SOLID RT (EDGE LINE)  
 STA. XIO+220.000 - STA. XIO+246.000 SOLID RT (EDGE LINE)

646.415 DURABLE 150 mm YELLOW LINE  
 W.B. STA. 17+306.552 - W.B. STA. 17+540.000 SOLID RT (EDGE LINE)  
 E.B. STA. 17+289.729 - E.B. STA. 17+522.100 SOLID LT (EDGE LINE)  
 STA. BIO+063.272 - STA. BIO+175.097 SOLID LT (EDGE LINE)  
 STA. XIO+220.000 - XIO+331.096 SOLID LT (EDGE LINE)

646.44 DURABLE 300 mm WHITE LINE  
 STA. BIO+100.000 - STA. BIO+175.097 SOLID C (GORE LINE)  
 STA. DIO+140.000 - STA. DIO+236.439 SOLID C (GORE LINE)  
 STA. DIO+187.000 - STA. DIO+260.000 DIAGONALS RT (SHOULDER AREA)  
 STA. XIO+246.000 - STA. XIO+320.000 SOLID 3.6 m RT (GORE LINE)

675.50 REMOVING SIGNS  
 AS SHOWN - 5

END APPROACH  
 BEGIN ROADWAY  
 END BENNINGTON-HOOSICK D.P.I. 0146(I) C/4  
 BEGIN BENNINGTON-HOOSICK D.P.I. 0146(I) C/6  
 BEGIN APPROACH SLAB  
 STA. BIO+064.800 =  
 W.B. STA. 17+305.027

BEGIN APPROACH  
 STA. BIO+175.097

END RAMP X  
 STA. XIO+331.096 =  
 E.B. STA. 17+289.729

END APPROACH  
 BEGIN ROADWAY  
 END BENNINGTON-HOOSICK D.P.I. 0146(I) C/4  
 BEGIN BENNINGTON-HOOSICK D.P.I. 0146(I) C/6  
 BEGIN APPROACH SLAB  
 STA. DIO+236.439 =  
 E.B. STA. 17+298.377

END RAMP D  
 STA. DIO+298.036 =  
 E.B. STA. 17+359.974

676.10 DELINEATORS W/STEEL POSTS


TYPE I, WHITE  
 W.B. STA. 17+441.3 LT  
 W.B. STA. 17+521.8 LT  
 E.B. STA. 17+441.3 RT  
 E.B. STA. 17+521.8 RT

TYPE I, AMBER  
 W.B. STA. 17+441.3 RT  
 W.B. STA. 17+521.8 RT  
 E.B. STA. 17+441.3 LT  
 E.B. STA. 17+521.8 LT

LEGEND	
●	TYPE I, WHITE
○	TYPE I, AMBER
○	TYPE II, WHITE


DATUM	
VERTICAL	NAVD 88
HORIZONTAL	NAD 83 (1992)

FILE NAME = u:\5116\vsroot\contract\act6\ssp01.dgn  
 DATE / TIME = 5/16/2004  
 USER = 2225

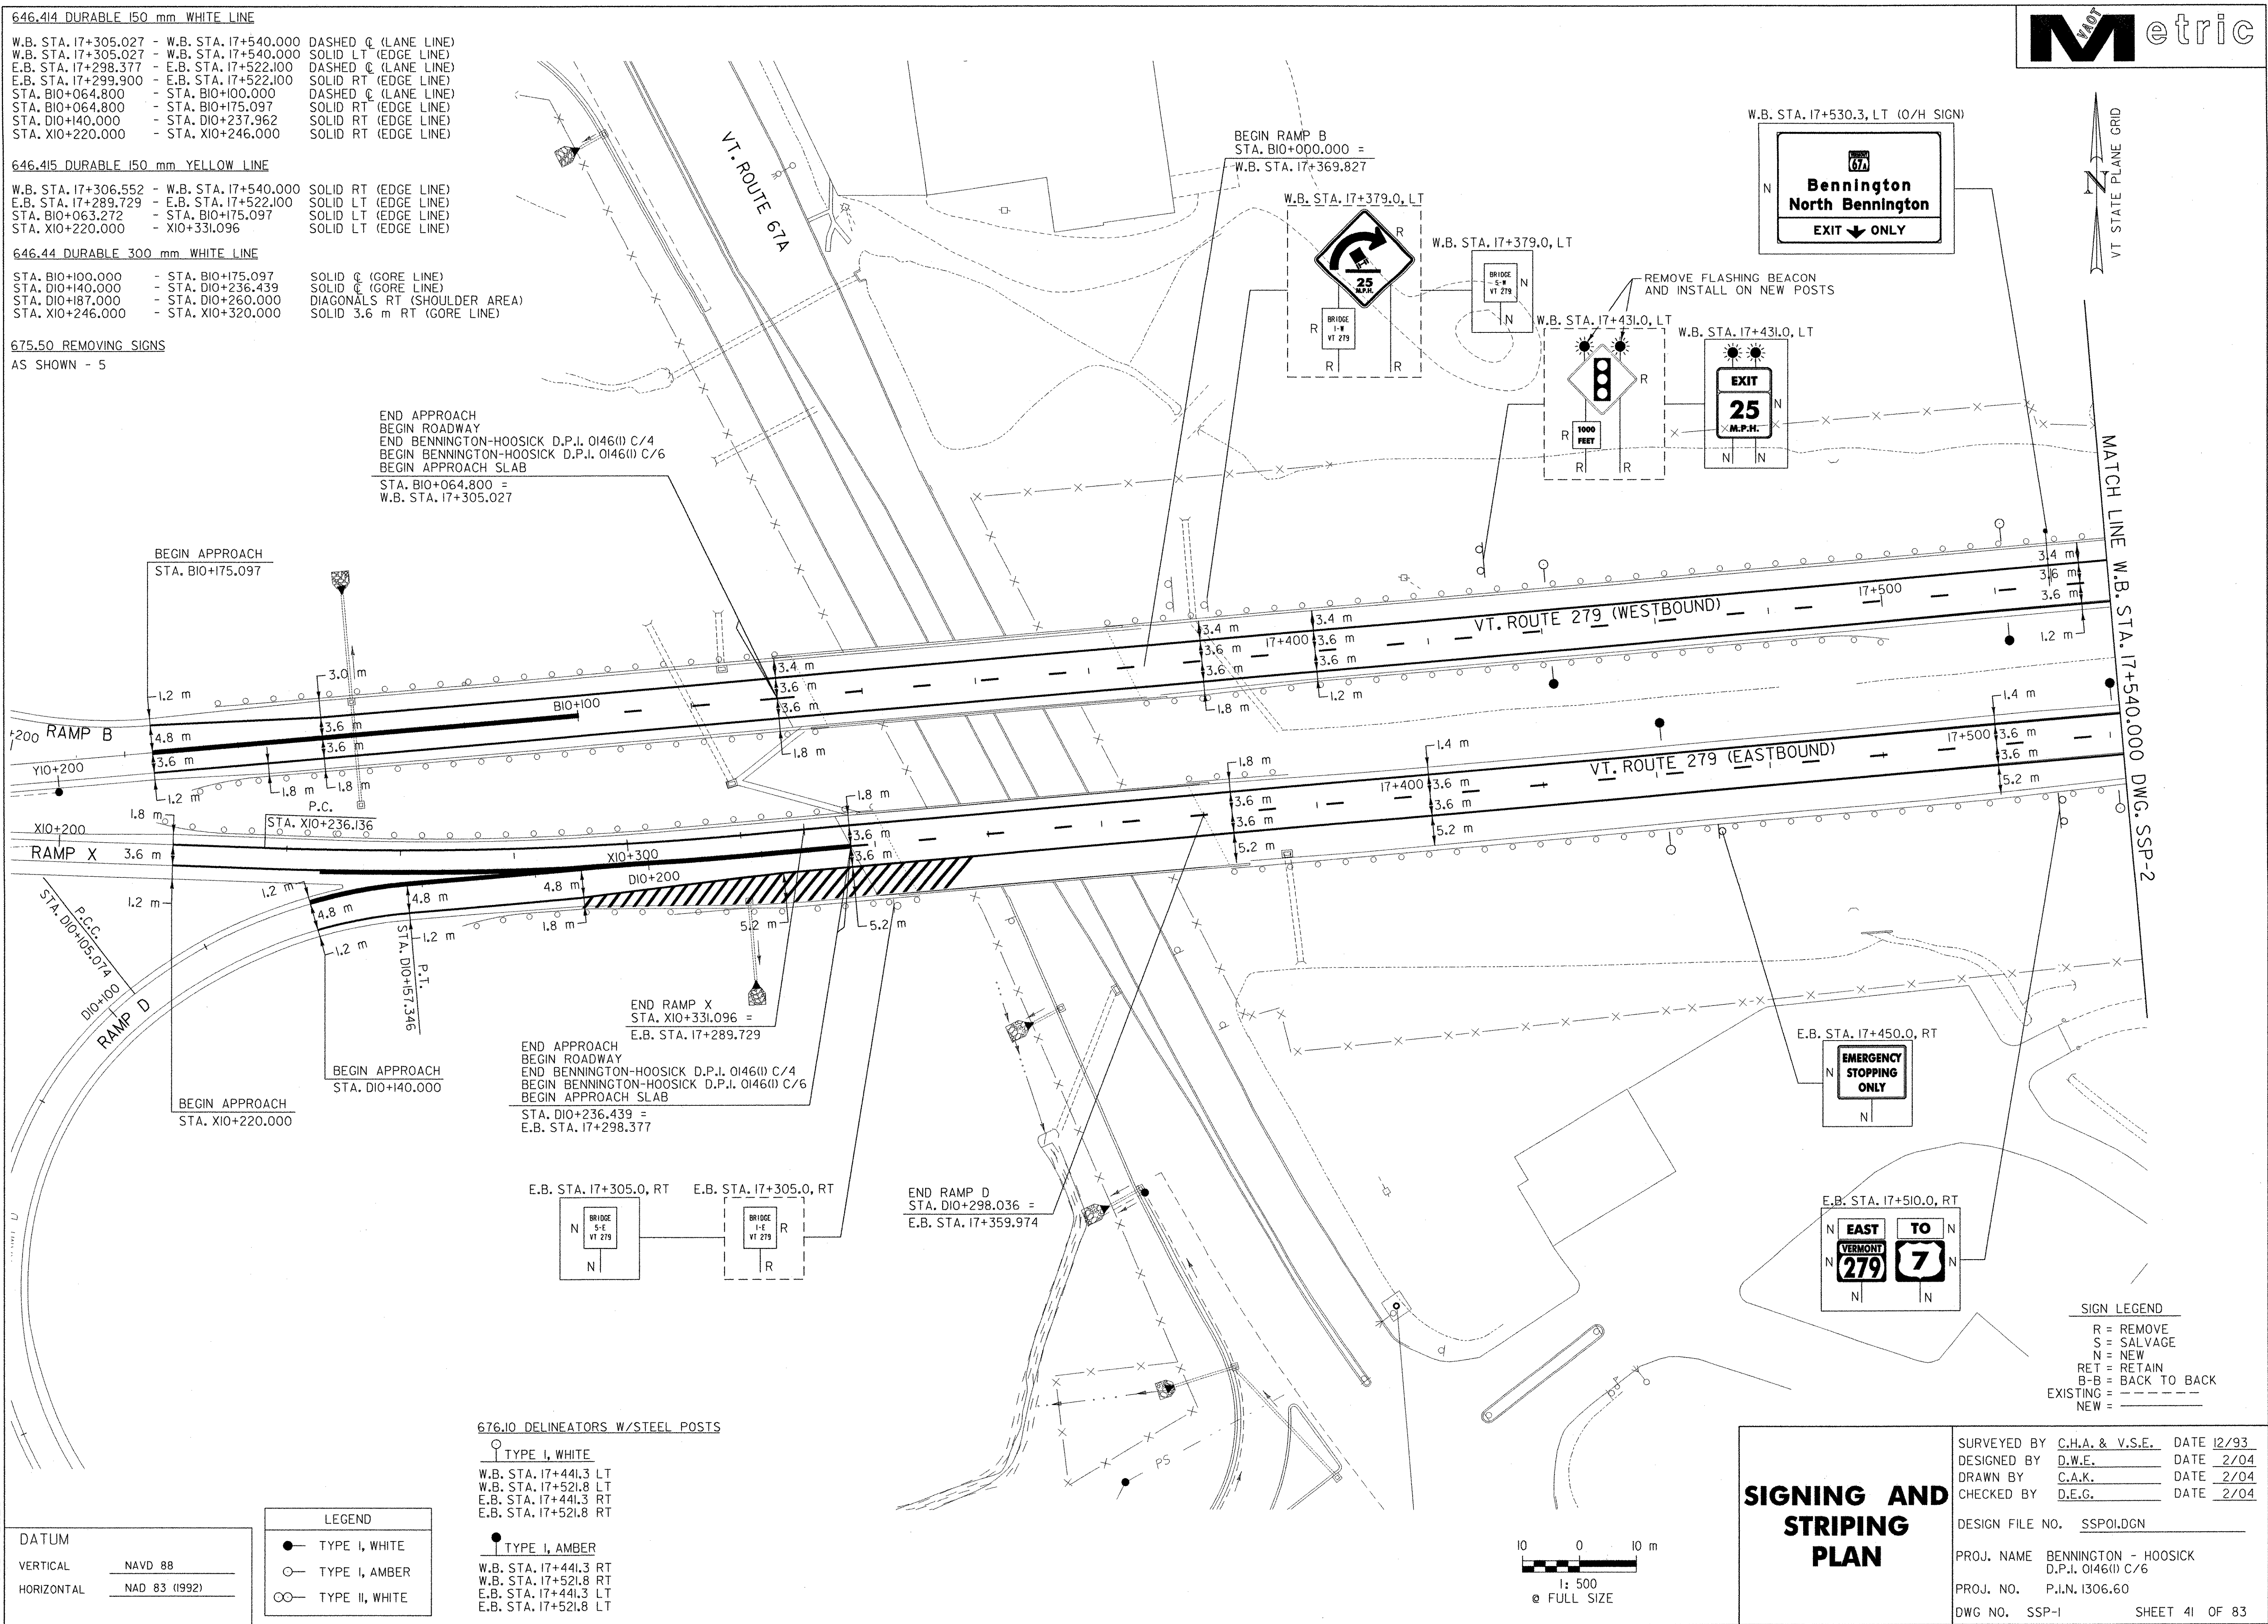

SIGN LEGEND		
R	= REMOVE	
S	= SALVAGE	
N	= NEW	
RET	= RETAIN	
B-B	= BACK TO BACK	
EXISTING	=	
NEW	=	

SIGNING AND STRIPING PLAN		
SURVEYED BY	C.H.A. & V.S.E.	DATE 12/93
DESIGNED BY	D.W.E.	DATE 2/04
DRAWN BY	C.A.K.	DATE 2/04
CHECKED BY	D.E.G.	DATE 2/04
DESIGN FILE NO.	SSPOLDGN	
PROJ. NAME	BENNINGTON - HOOSICK D.P.I. 0146(I) C/6	
PROJ. NO.	P.I.N. 1306.60	
DWG NO.	SSP-1	SHEET 41 OF 83

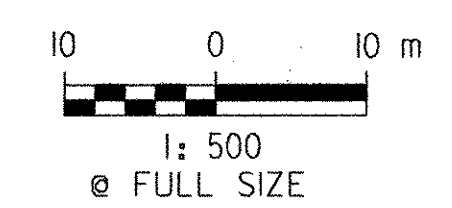



**646.414 DURABLE 150 mm WHITE LINE**

W.B. STA. 17+540.000 - W.B. STA. 17+840.000 DASHED C (LANE LINE)  
 W.B. STA. 17+540.000 - W.B. STA. 17+840.000 SOLID LT (EDGE LINE)  
 E.B. STA. 17+522.100 - E.B. STA. 17+822.000 DASHED C (LANE LINE)  
 E.B. STA. 17+522.100 - E.B. STA. 17+822.000 SOLID RT (EDGE LINE)

**646.415 DURABLE 150 mm YELLOW LINE**

W.B. STA. 17+540.000 - W.B. STA. 17+840.000 SOLID RT (EDGE LINE)  
 E.B. STA. 17+522.100 - E.B. STA. 17+822.000 SOLID LT (EDGE LINE)

**675.50 REMOVING SIGNS AS SHOWN - R**

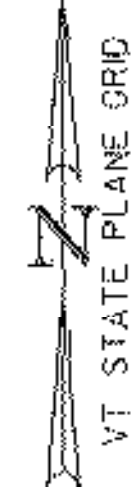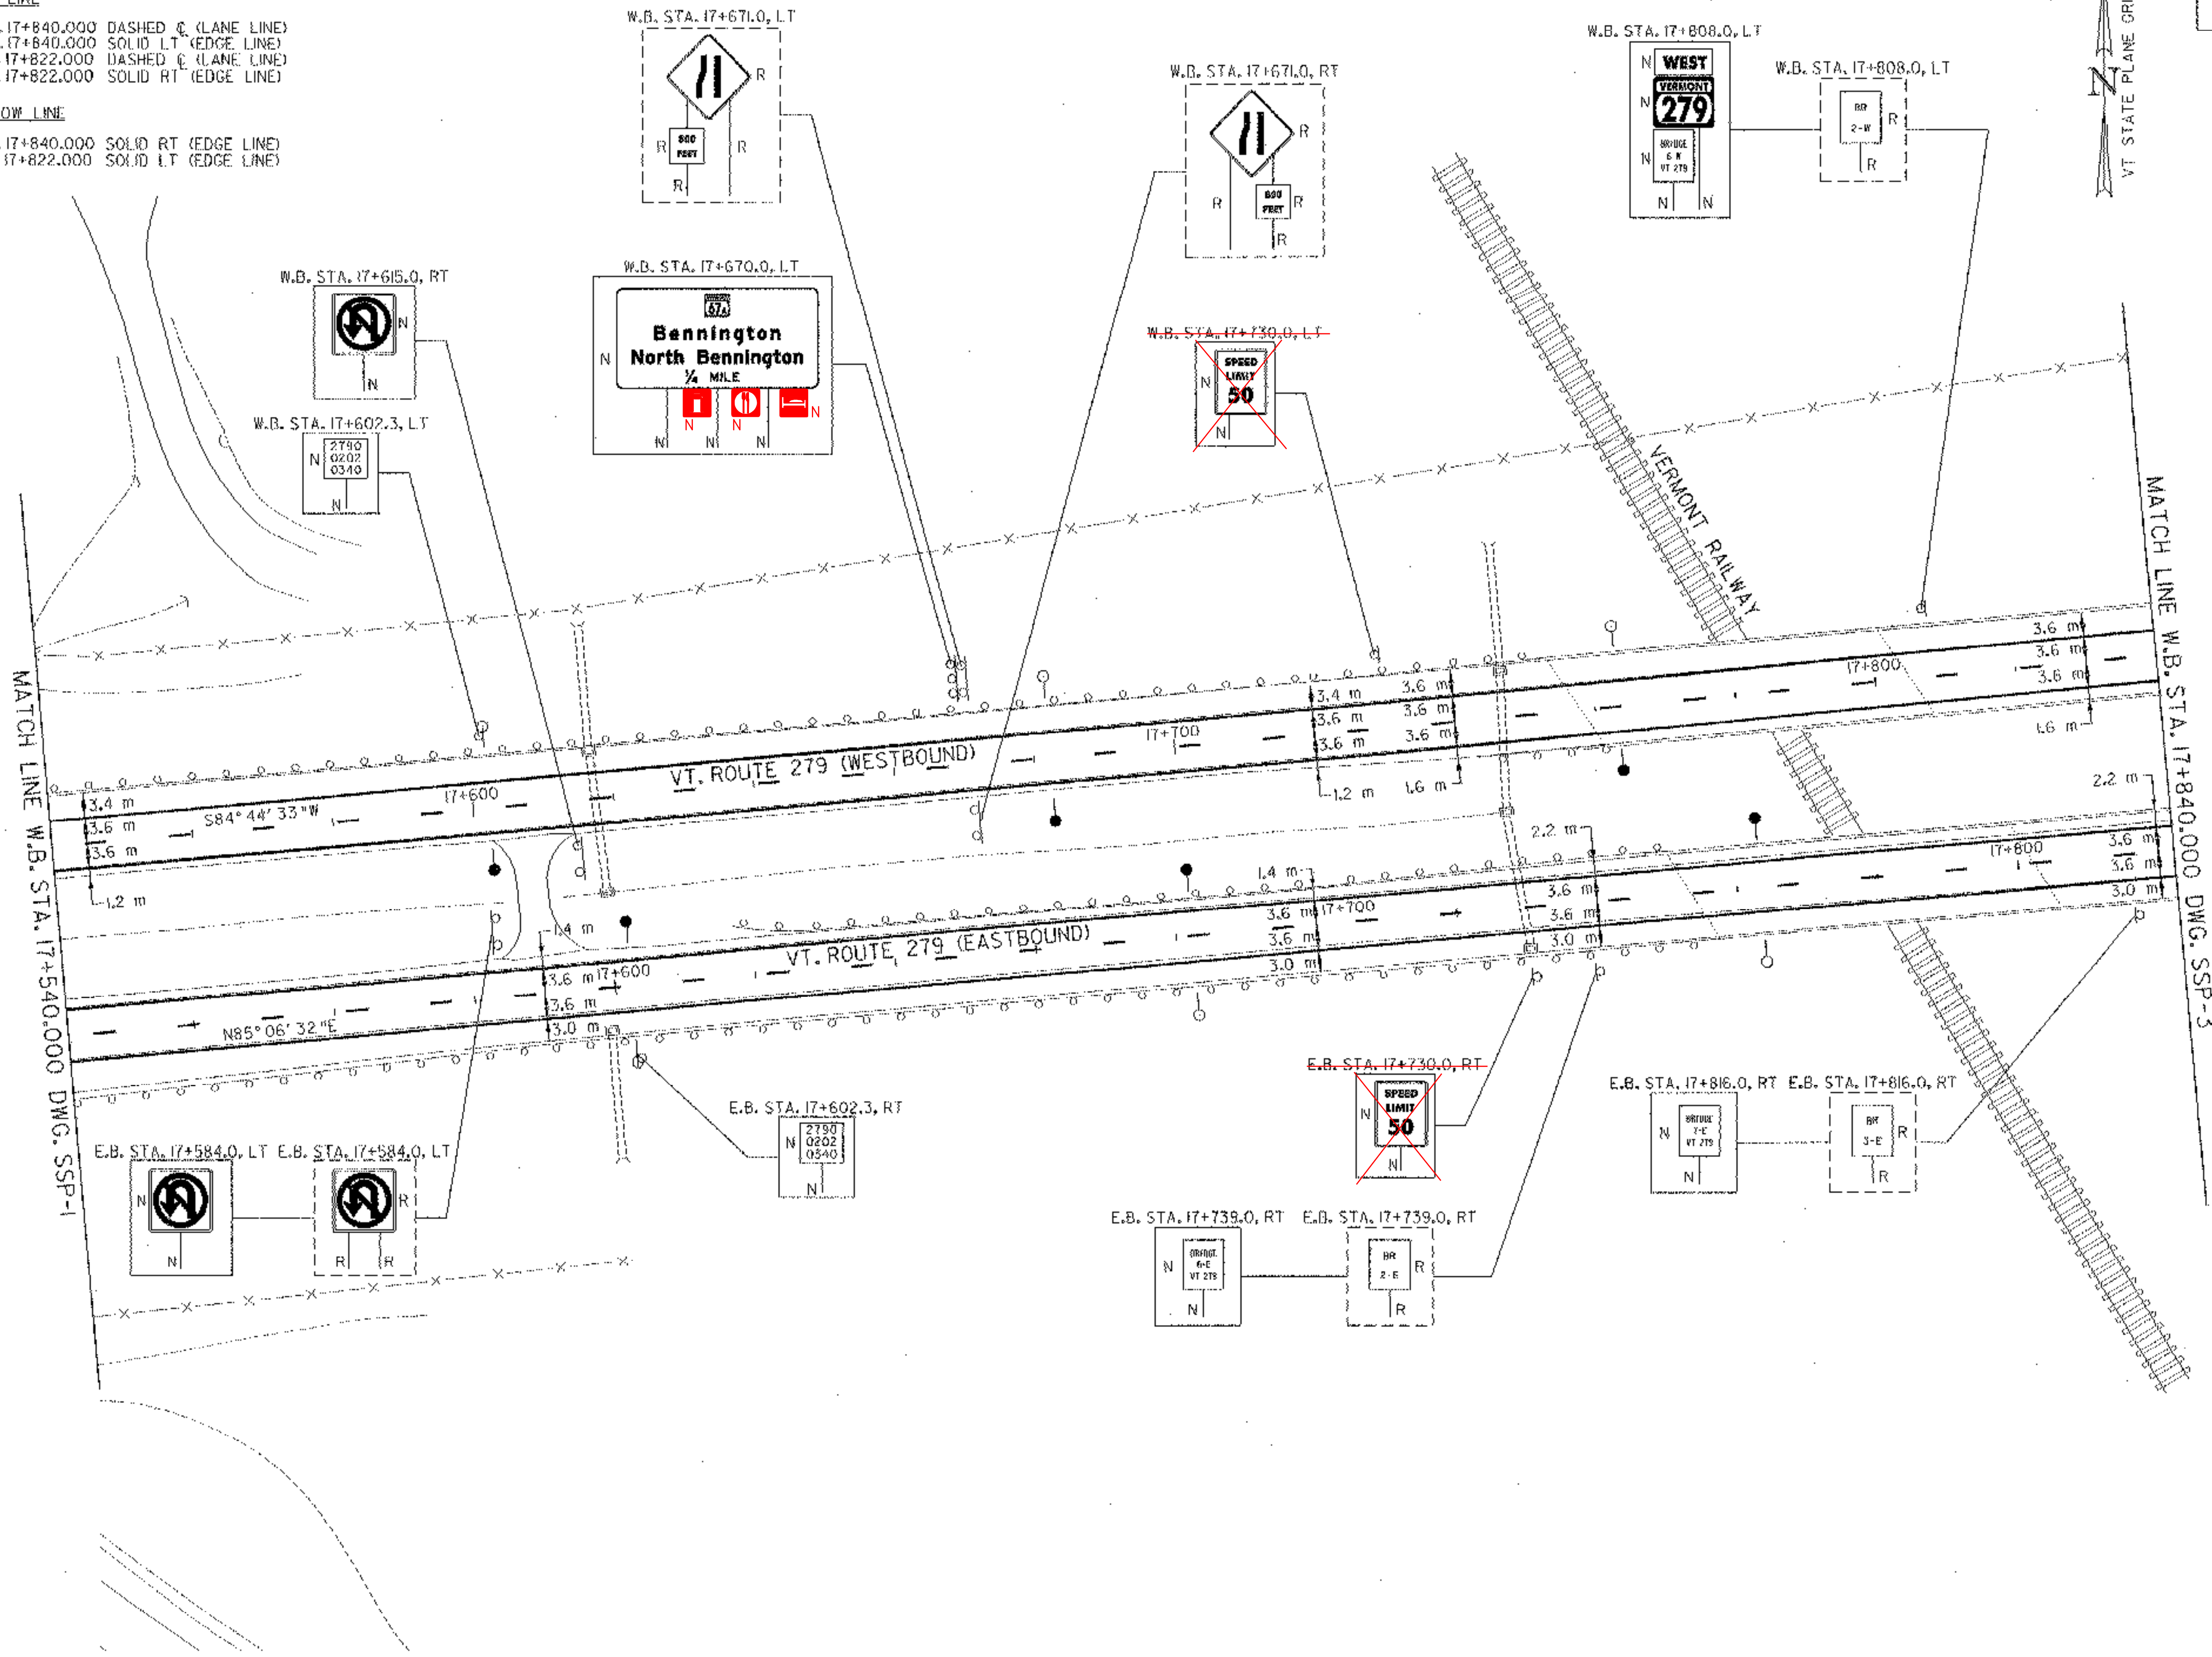

**SIGN LEGEND**

- R = REMOVE
- S = SALVAGE
- N = NEW
- RET = RETAIN
- B-B = BACK TO BACK
- EXISTING =
- NEW =

**676.10 DELINEATORS W/STEEL POSTS**

TYPE I, WHITE	TYPE I, AMBER
W.B. STA. 17+602.3 LT	W.B. STA. 17+602.3 RT
W.B. STA. 17+682.3 LT	W.B. STA. 17+682.3 RT
W.B. STA. 17+763.3 LT	W.B. STA. 17+763.3 RT
E.B. STA. 17+602.3 RT	E.B. STA. 17+602.3 LT
E.B. STA. 17+682.3 RT	E.B. STA. 17+682.3 LT
E.B. STA. 17+763.3 RT	E.B. STA. 17+763.3 LT

**LEGEND**

- TYPE I, WHITE
- TYPE I, AMBER
- TYPE II, WHITE

**DATUM**

VERTICAL	NAVD 88
HORIZONTAL	NAD 83 (9992)





**SIGNING AND STRIPING PLAN**

SURVEYED BY	C.H.A. & V.S.E.	DATE	12/93
DESIGNED BY	D.W.E.	DATE	2/04
DRAWN BY	C.A.K.	DATE	2/04
CHECKED BY	D.E.G.	DATE	2/04
DESIGN FILE NO.	SSP02.DGN		
PROJ. NAME	BENNINGTON - HOOSICK I.P.J. 014611 C/G		
PROJ. NO.	P.I.N. 1306.60		
DWG. NO.	SSP-2	SHEET	12 OF 83

FILE NAME = \\A1115\vac\con\contract6\ssp02.dgn  
 DATE/TIME = 2/16/2004  
 USER = 2225

- 646.414 DURABLE 150 mm WHITE LINE
- W.B. STA. 17+840.000 - W.B. STA. 17+938.000 DASHED C (LANE LINE)
  - W.B. STA. 17+840.000 - W.B. STA. 17+941.584 SOLID LT (EDGE LINE)
  - W.B. STA. 17+982.000 - W.B. STA. 18+000.000 SOLID LT (EDGE LINE)
  - E.B. STA. 17+822.000 - E.B. STA. 17+860.000 DASHED C (LANE LINE)
  - E.B. STA. 17+822.000 - E.B. STA. 17+860.000 SOLID RT (EDGE LINE)
  - E.B. STA. 17+987.900 - E.B. STA. 18+000.000 SOLID RT (EDGE LINE)
  - STA. E2+320.000 - STA. E2+471.417 SOLID RT (EDGE LINE)
  - STA. F2+000.000 - STA. F2+100.000 SOLID RT (EDGE LINE)
- 646.415 DURABLE 150 mm YELLOW LINE
- W.B. STA. 17+840.000 - W.B. STA. 18+000.000 SOLID RT (EDGE LINE)
  - E.B. STA. 17+822.000 - E.B. STA. 18+000.000 SOLID LT (EDGE LINE)
  - STA. E2+320.000 - STA. E2+434.500 SOLID LT (EDGE LINE)
  - STA. F2+076.100 - STA. F2+100.000 SOLID LT (EDGE LINE)
- 646.44 DURABLE 300 mm WHITE LINE
- W.B. STA. 17+938.000 - W.B. STA. 17+982.000 SOLID C (CORE LINE)
  - E.B. STA. 17+860.000 - E.B. STA. 17+987.900 SOLID C (CORE LINE)
  - E.B. STA. 17+950.000 - E.B. STA. 17+987.900 DIAGONALS RT (GORE AREA)
  - STA. E2+434.500 - STA. E2+461.000 SOLID LT (GORE LINE)
  - STA. F2+000.000 - STA. F2+075.600 SOLID LT (GORE LINE)


675.50 REMOVING SIGNS  
AS SHOWN - 9

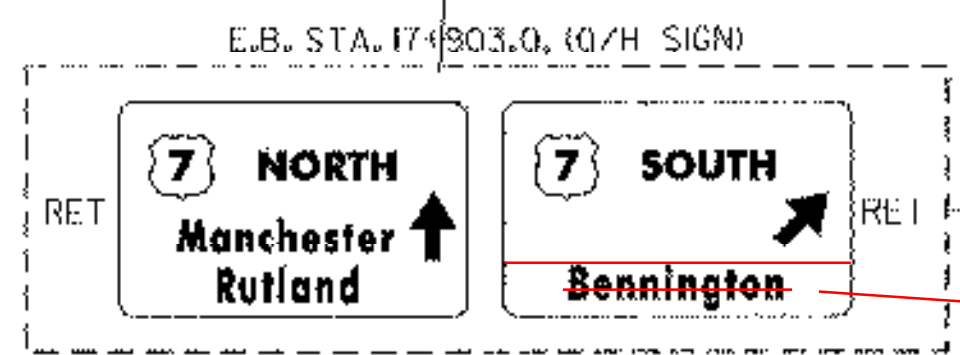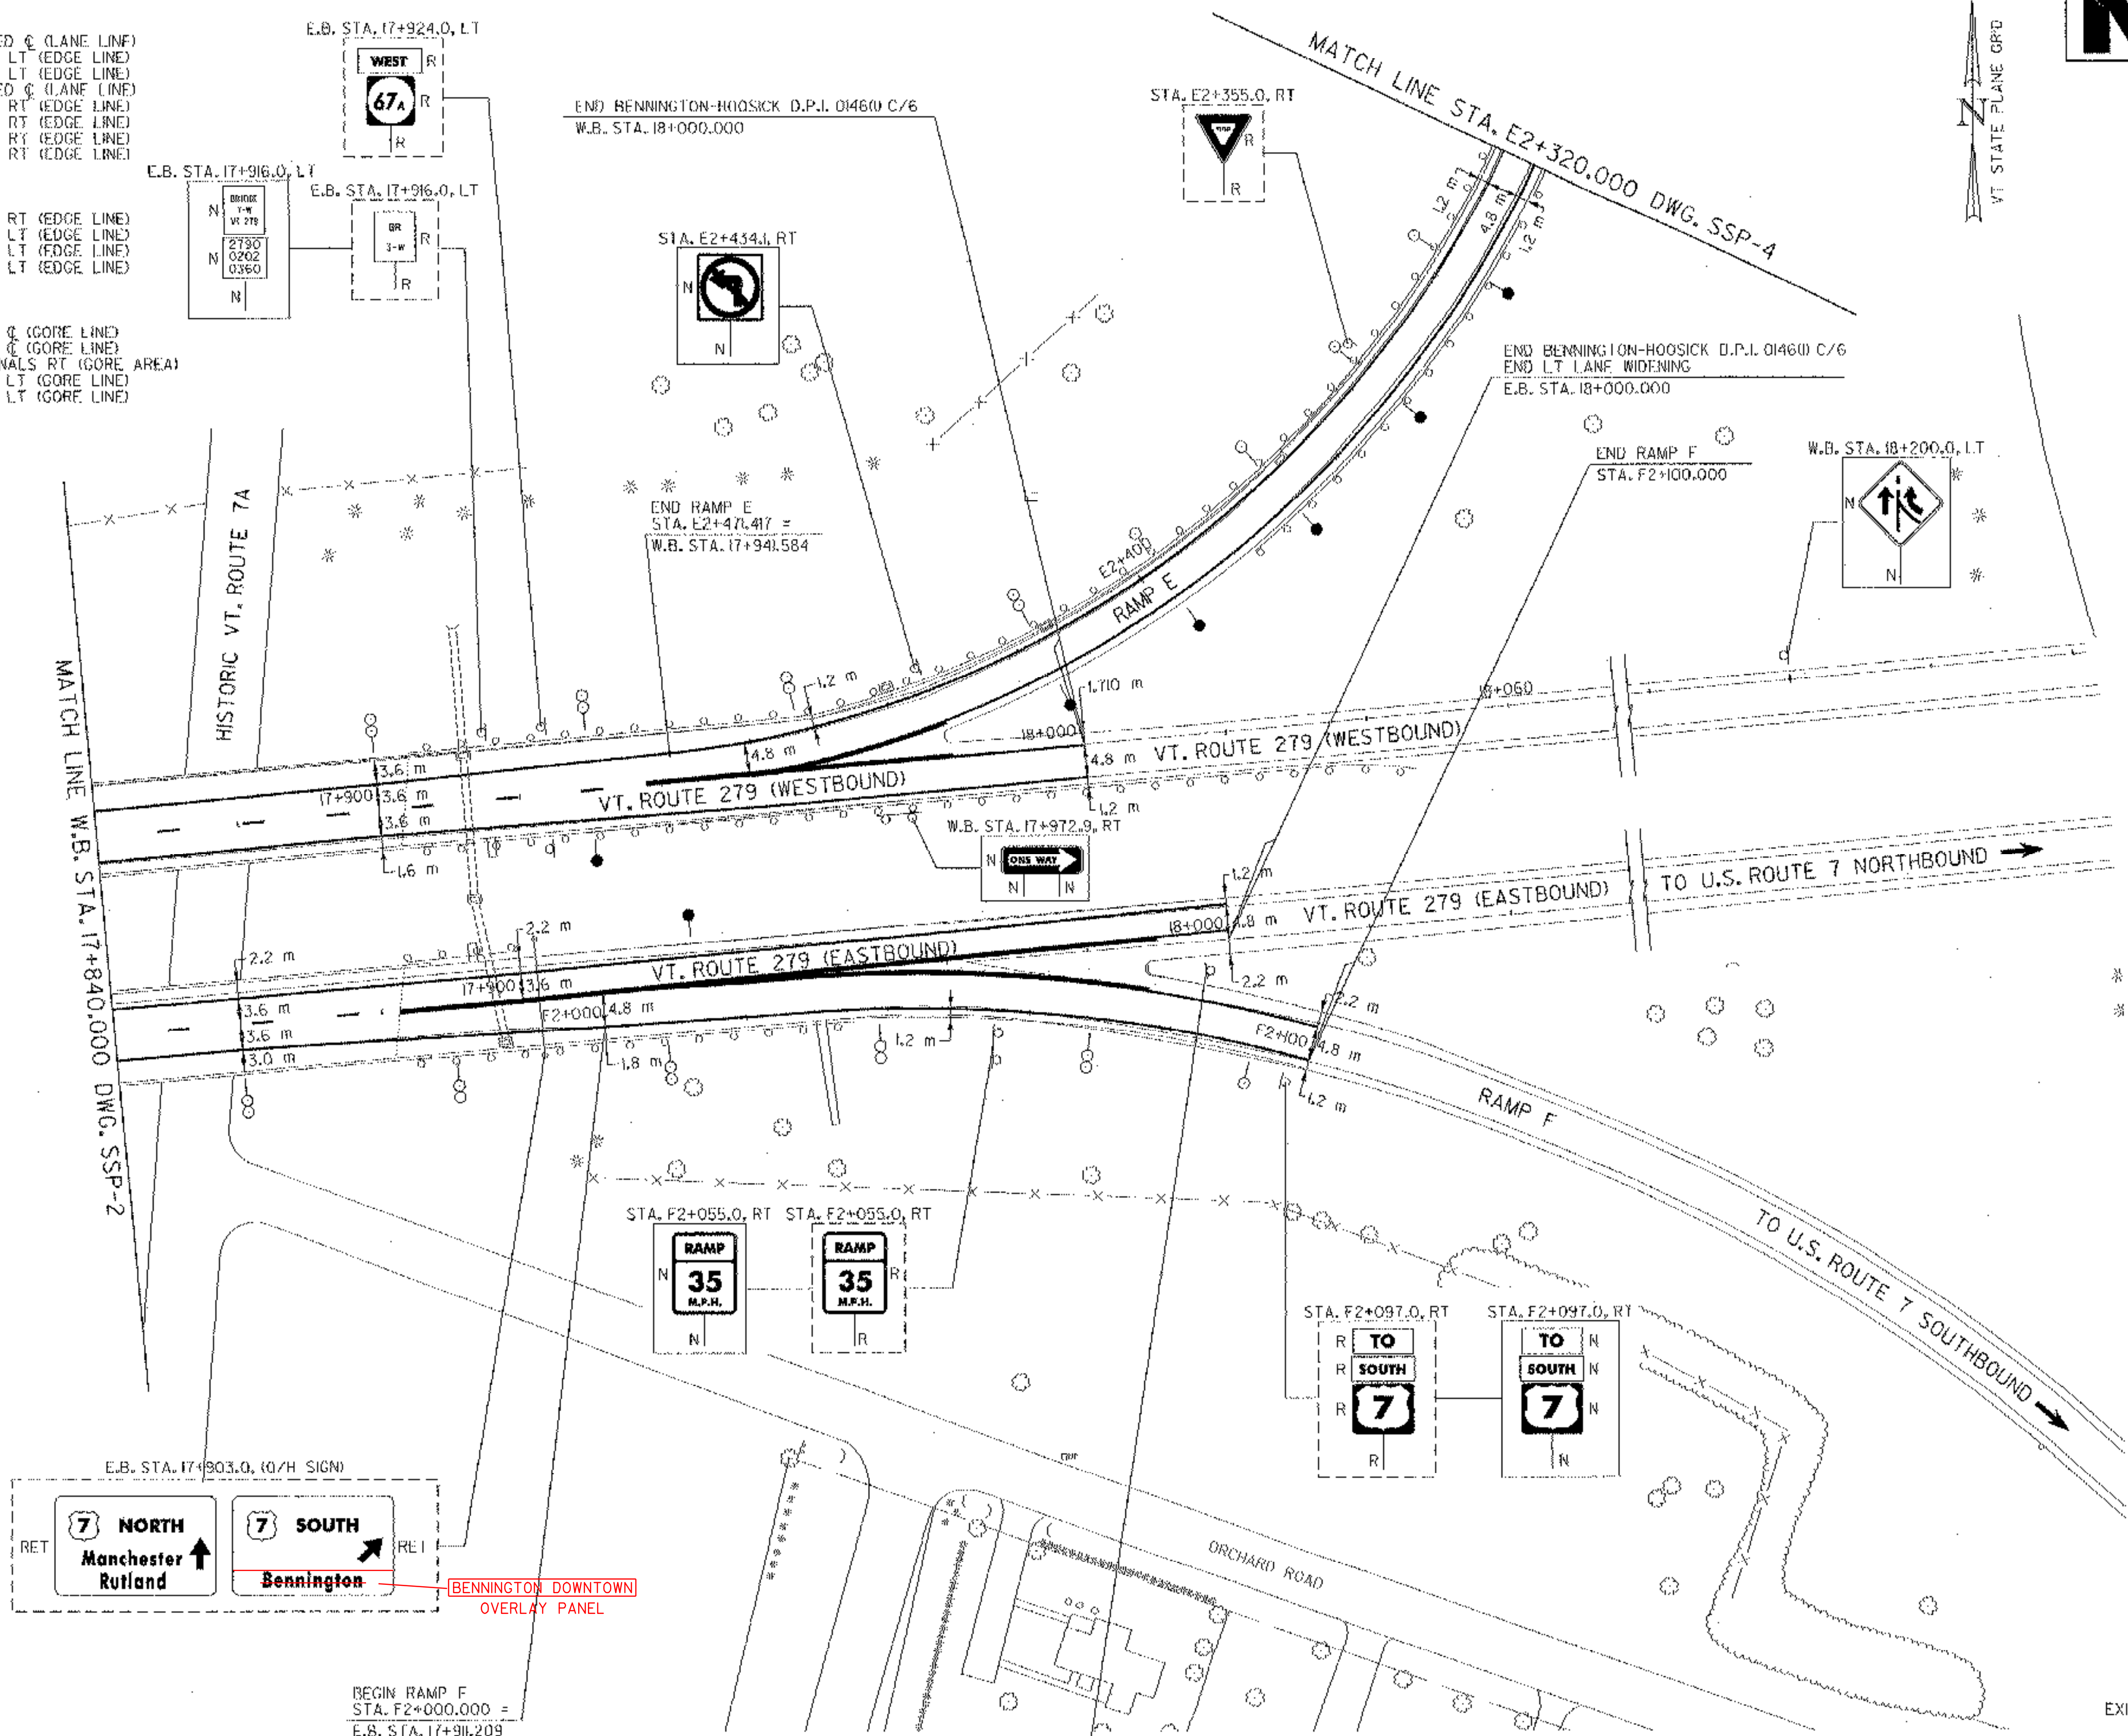

BEGIN RAMP F  
STA. F2+000.000 =  
E.B. STA. 17+911.209

676.10 DELINEATORS W/STEEL POSTS

- |                  |                       |                       |
|------------------|-----------------------|-----------------------|
| TYPE I, WHITE    | TYPE I, AMBER         | TYPE II, WHITE        |
| STA. E2+337.0 RT | W.B. STA. 17+930.0 RT | W.B. STA. 17+900.0 LT |
| STA. E2+357.0 RT | E.B. STA. 17+924.3 LT | W.B. STA. 17+930.0 LT |
| STA. E2+377.0 RT | STA. E2+337.0 LT      | E.B. STA. 17+860.0 RT |
| STA. E2+397.0 RT | STA. E2+357.0 LT      | E.B. STA. 17+890.0 RT |
| STA. F2+091.8 RT | STA. E2+377.0 LT      | STA. E2+417.0 RT      |
|                  | STA. E2+397.0 LT      | STA. E2+453.0 RT      |
|                  | STA. E2+417.0 LT      | STA. F2+008.8 RT      |
|                  |                       | STA. F2+038.8 RT      |
|                  |                       | STA. F2+068.8 RT      |

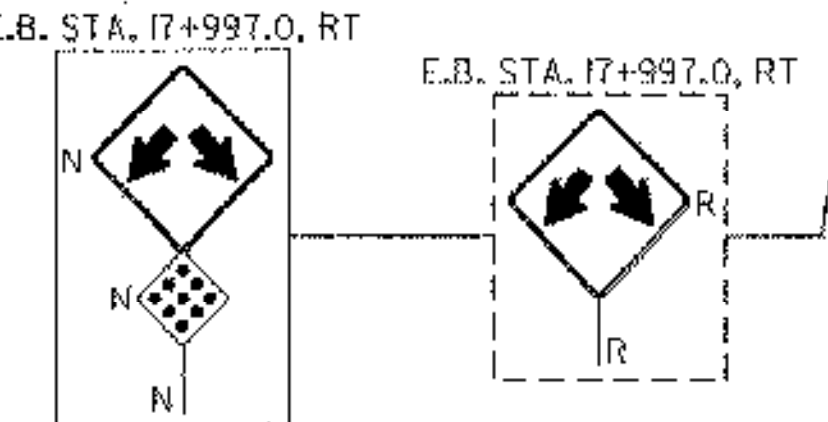

- SIGN LEGEND**
- R = REMOVE
  - S = SALVAGE
  - N = NEW
  - RET = RETAIN
  - B-B = BACK TO BACK
  - EXISTING = - - - - -
  - NEW = ————

**SIGNING AND STRIPING PLAN**


SURVEYED BY C.H.A. & V.S.E. DATE 12/93  
 DESIGNED BY D.W.E. DATE 2/04  
 DRAWN BY C.A.K. DATE 2/04  
 CHECKED BY D.E.G. DATE 2/04

DESIGN FILE NO. SSP03.DGN

PROJ. NAME BENNINGTON - HOOSICK  
D.P.I. 01461) C/6

PROJ. NO. P.I.N. 1306.60

DWG NO. SSP-3 SHEET 43 OF 83

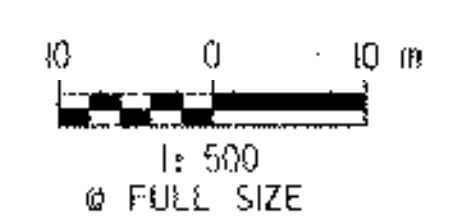


FILE NAME = ur\5116\sect\contract\6\ssp03.dgn  
DATE/TIME = 2/16/2004  
USER = 2225

DATUM	
VERTICAL	NAVD 88
HORIZONTAL	NAD 83 (0992)

LEGEND	
●	TYPE I, WHITE
○	TYPE I, AMBER
○	TYPE II, WHITE

646.414 DURABLE 150 mm WHITE LINE  
 STA. E2+070.000 - STA. E2+320.000 SOLID RT (EDGE LINE)  
 646.415 DURABLE 150 mm YELLOW LINE  
 STA. E2+070.000 - STA. E2+320.000 SOLID LT (EDGE LINE)

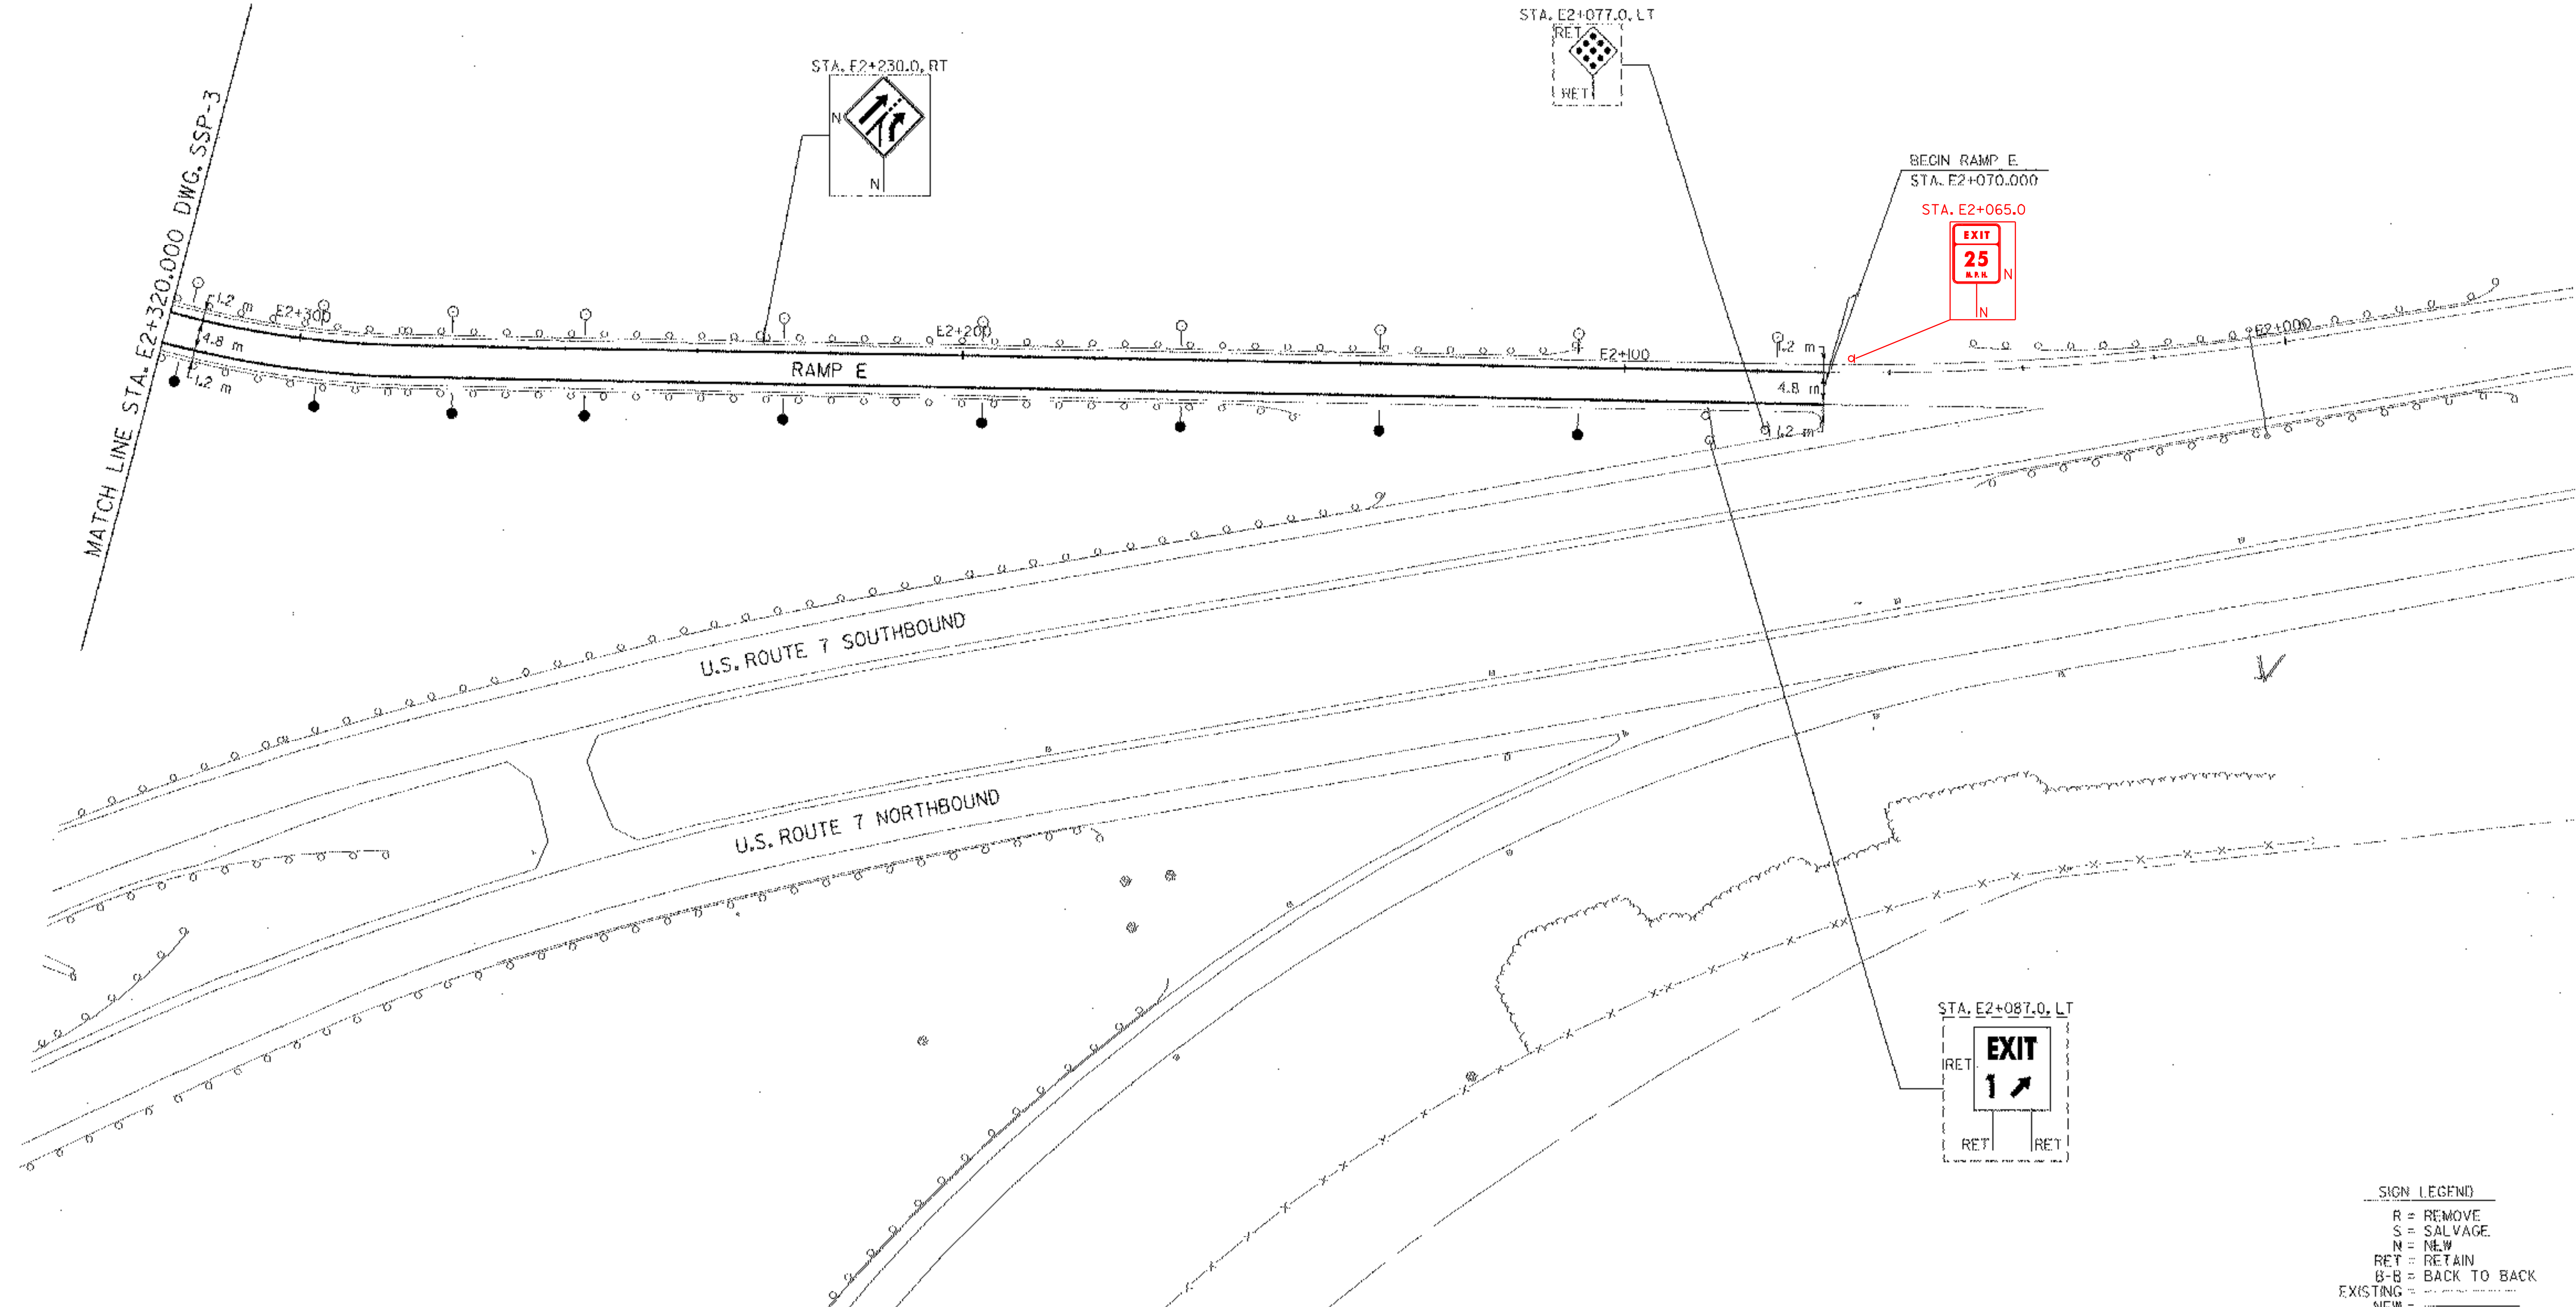

FILE NAME = u:\5116\vaot\contract6\ssp04.dgn  
 DATE/TIME = 2/16/2004  
 USER = 2225

DATUM

VERTICAL	NAVD 88
HORIZONTAL	NAD 83 (1992)

LEGEND


●	TYPE I, WHITE
○	TYPE I, AMBER
○	TYPE II, WHITE

67610 DELINEATORS W/STEEL POSTS

TYPE I, WHITE	TYPE I, AMBER
STA. E2+077.0 RT	STA. E2+107.0 LT
STA. E2+107.0 RT	STA. E2+137.0 LT
STA. E2+137.0 RT	STA. E2+167.0 LT
STA. E2+167.0 RT	STA. E2+197.0 LT
STA. E2+197.0 RT	STA. E2+227.0 LT
STA. E2+227.0 RT	STA. E2+257.0 LT
STA. E2+257.0 RT	STA. E2+277.0 LT
STA. E2+277.0 RT	STA. E2+297.0 LT
STA. E2+297.0 RT	STA. E2+317.0 LT
STA. E2+317.0 RT	

SIGN LEGEND

- R = REMOVE
- S = SALVAGE
- N = NEW
- RET = RETAIN
- B-B = BACK TO BACK
- EXISTING = - - - - -
- NEW = \_\_\_\_\_

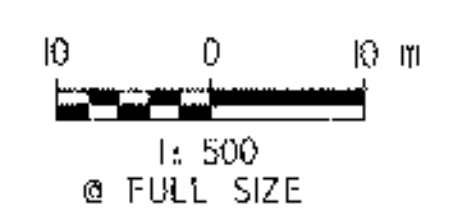

**SIGNING AND STRIPING PLAN**

SURVEYED BY	C.R.A. & V.S.E.	DATE	12/93
DESIGNED BY	D.W.E.	DATE	2/04
DRAWN BY	C.A.K.	DATE	2/04
CHECKED BY	D.E.G.	DATE	2/04
DESIGN FILE NO.	SSP04.DGN		
PROJ. NAME	BENNINGTON - HOOSICK D.P.I. 01461) C/6		
PROJ. NO.	P.J.N. 1306.60		
DWG NO.	SSP-4	SHEET	44 OF 83








KILOMETER MARKER, STATION, OR SIGN NUMBER	SIGN LEGEND	SIGN DIMENSIONS		NEW & SALVAGED SIGNS				EXIST POST REF. IN SALVAGE	NO. OF POSTS	FLANGED CHANNEL			SQUARE STEEL (mm)			ANCHOR SLEEVE	NEW SIGN POSTS TUBULAR ALUMINUM Ø (mm)			TUBULAR STEEL Ø (mm)				W-SHAPE STEEL			REMARKS	SIGN DETAIL							
		EA	WIDTH (mm)	HEIGHT (mm)	"A"	"B"	SALV SIGN			SALV TIS	1.7	3.0	4.5	44	50		63	75	100	100 MOD	GROUND ATION	75	89	100	125	FTG. SIZE		POST SIZE	DETAIL ON SHEET NUMBER	STD. SHEET NUMBER					
														kg/m	kg/m		kg/m					kg/m	600 mm	750 mm	MASS										
VT. ROUTE 279 CASTBOUND: 17+305.0, R1		1	150	200	0.03				1			X																						ESIGN ID CODE VD-701	E-134M
17+450.0, RT		1	750	600	0.45				1				X																					ESIGN ID CODE R8-73	E-142M
17+510.0, RT		1	750	375	0.28				2					X	X																			ESIGN ID CODE M3-2J ESIGN ID CODE M4-5J	E-136BM E-136AM
		1	1125	900	1.01																													ESIGN ID CODE MI-5J ESIGN ID CODE MI-4T	E-136BM E-136AM
17+584.0, LT		1	900	900	0.81				1					X	X																			ESIGN ID CODE R3-41	E-143M
17+602.3, RT		1	150	250	0.04				1			X																						ESIGN ID CODE VD-7001	E-138M
17+730.0, RT		1	900	1200	1.08				+																									ESIGN ID CODE R2-1) INSTALLED AND LATER REMOVED	E-142M
17+739.0, RT		1	150	200	0.03				1			X																						ESIGN ID CODE VD-701	E-134M
17+816.0, RT		1	150	200	0.03				1			X																						ESIGN ID CODE VD-701	E-134M
17+997.0, RT		1	900	900	0.81				2				X	X																				ESIGN ID CODE W12-11	E-151M
												m	m	m	EA	Kg	kg	kg	kg	kg	kg	kg	kg	kg	EA	EA	kg								
				<b>TOTALS</b>	5.66	m <sup>2</sup>	m <sup>2</sup>	EA	m <sup>2</sup>			m	38.6			kg	10.5	EA	kg				EA	EA	kg										

FILE NAME: \\M:\B1616\AD\CONTRACTS\TSS5501.dgn  
 DATE/TIME: 2/16/2004  
 USER: 2225

FINAL POST LENGTHS ARE TO BE DETERMINED IN THE FIELD. POST SIZES ARE COMPUTED BASED ON INFORMATION FURNISHED ON THE STANDARD SHEETS AND THE TRAFFIC & SAFETY DIVISION'S "SIGN POST DESIGN GUIDELINE."


PROJECT: BENNINGTON - HOOSICK	PROJECT NO.: D.P.L. 0146(1) C/6
DESIGN FILE NAME: TSS501.DGN	PLOT DATE: 2/04
PARM FILE NAME: N/A	SURVEY DATE: N/A
SURVEYED BY: N/A	DRAWN BY: C.A.K.
SQUAD LEADER: T.P.K.	SHEET: 48 OF 83
DWG. NO. TSS-4	



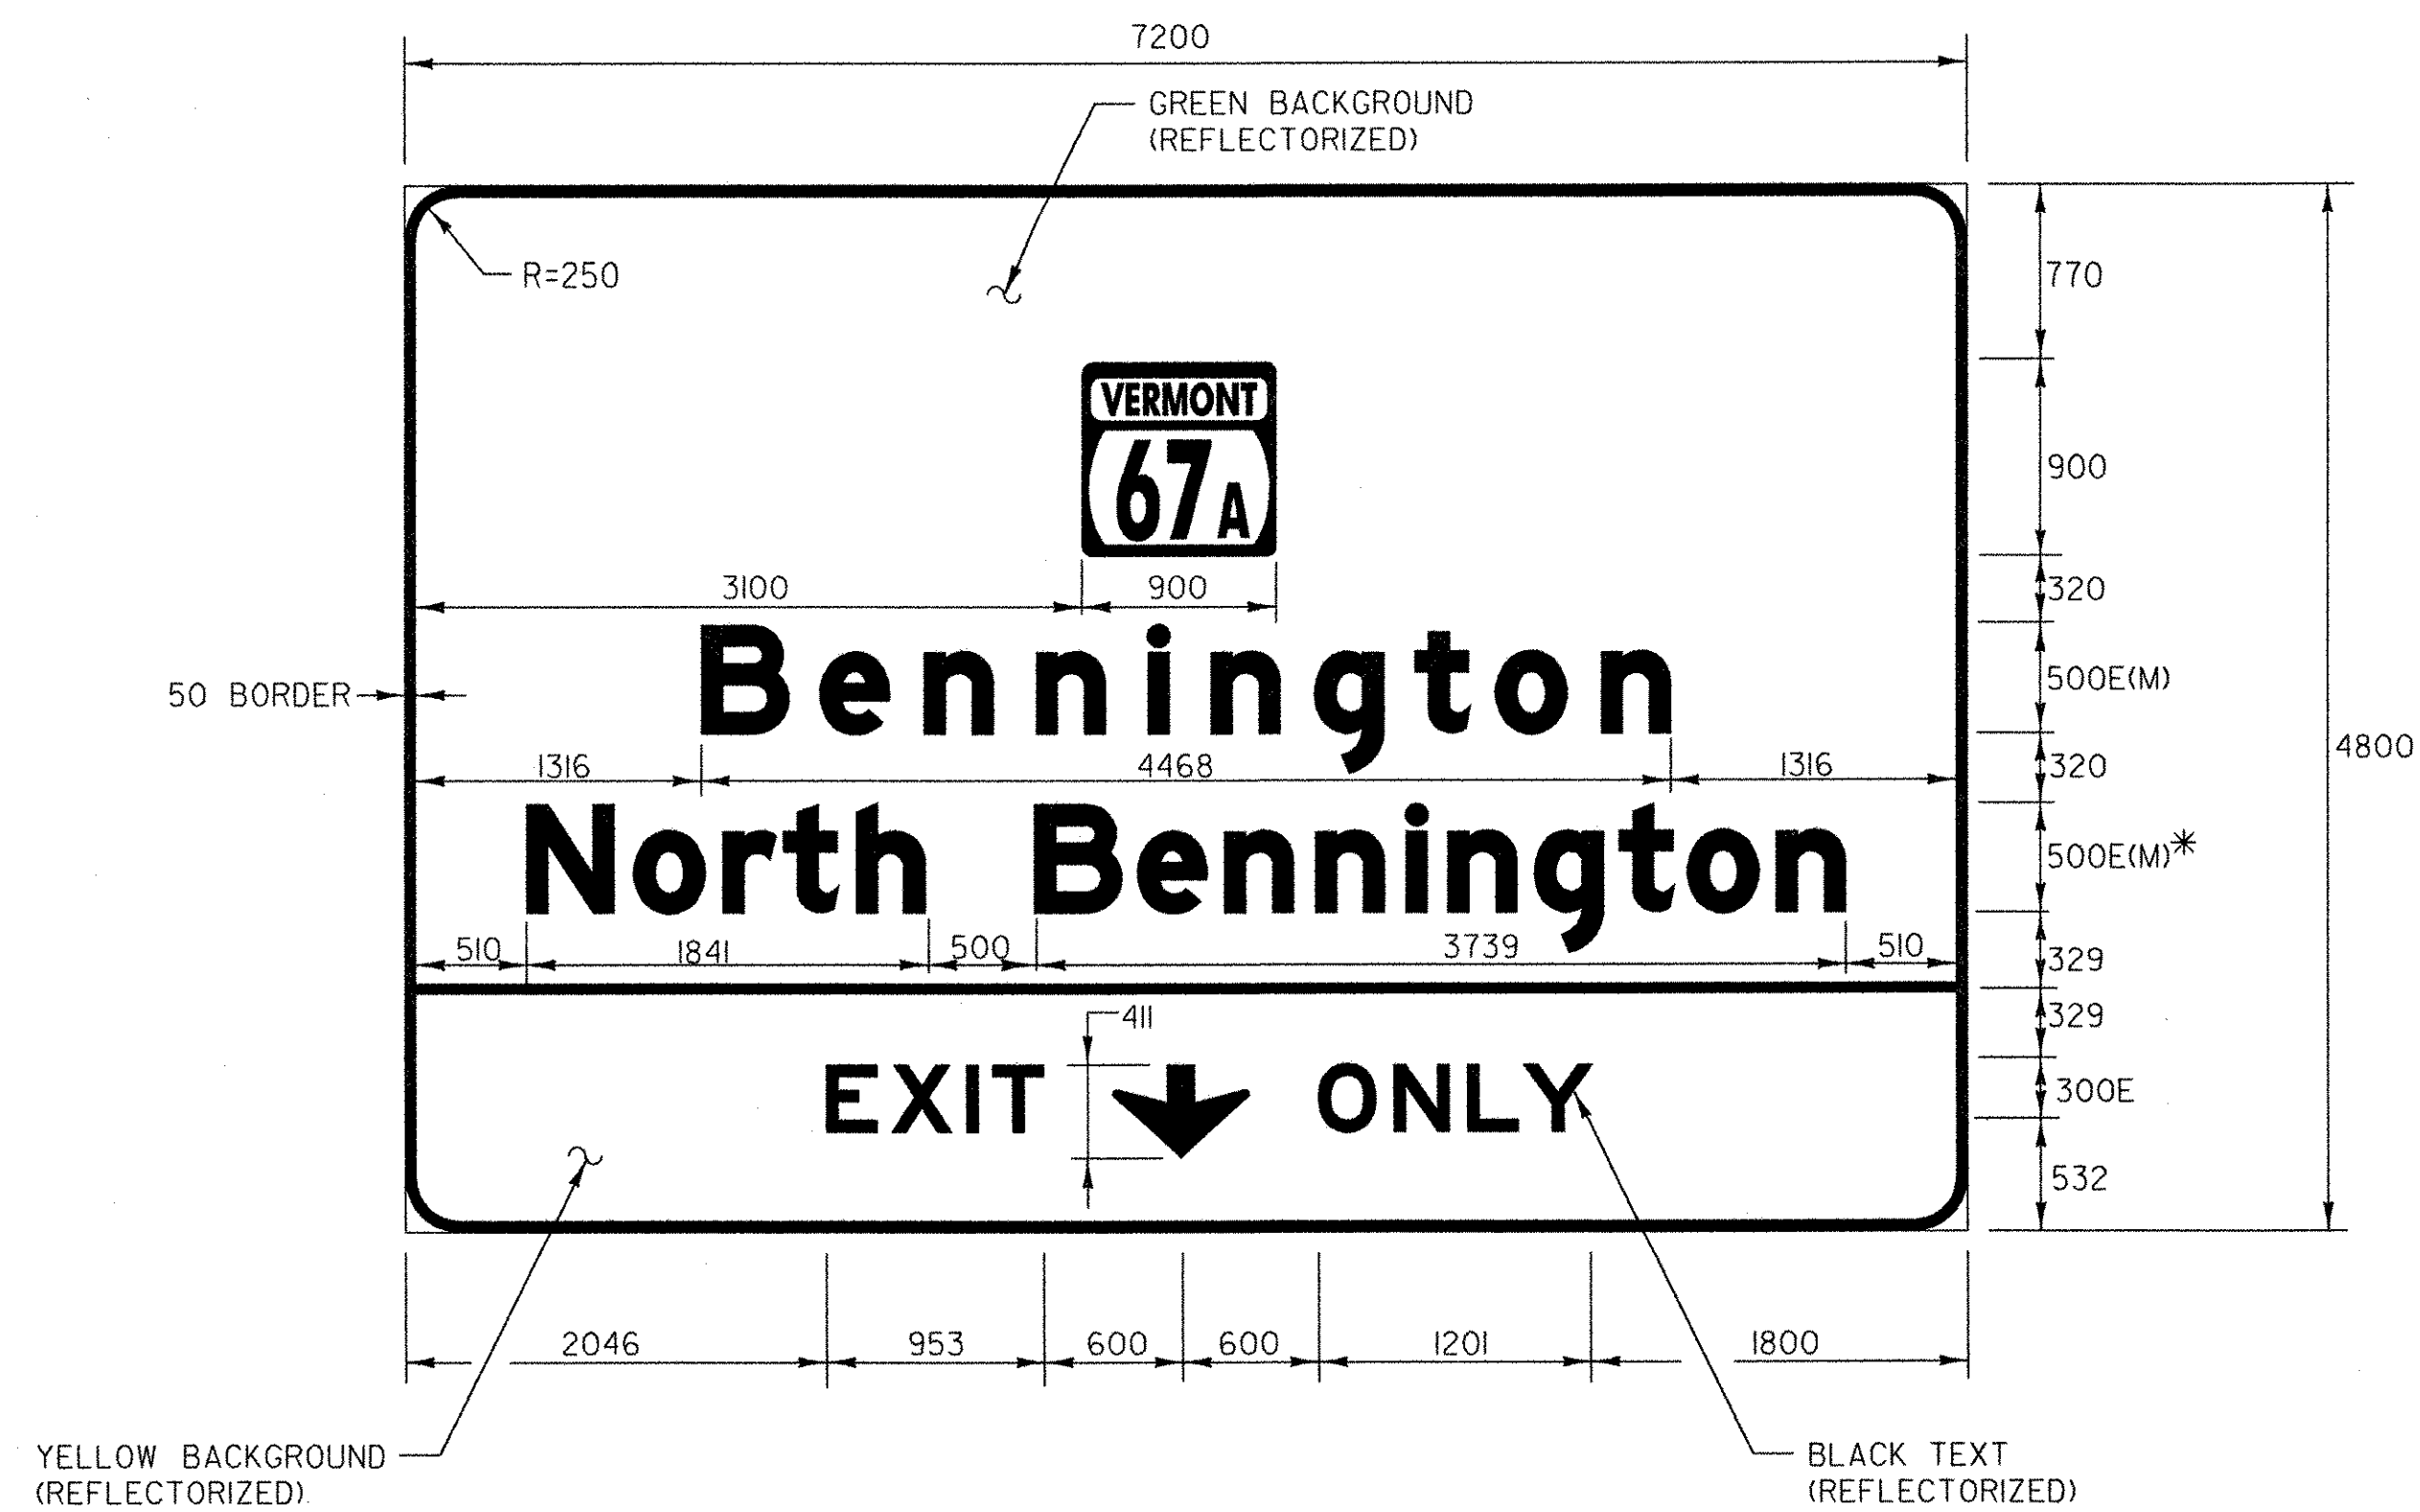


COLOR: WHITE BORDER & TEXT (REFLECTORIZED)  
 GREEN BACKGROUND (REFLECTORIZED)  
 BLACK TEXT (REFLECTORIZED)  
 YELLOW BACKGROUND (REFLECTORIZED)

MATERIAL: PER VAOT STANDARD E-131M  
 \*50% REDUCTION IN SPACING  
 SIGN - VT. ROUTE 279  
 W.B. STA. 17+530.3, LT

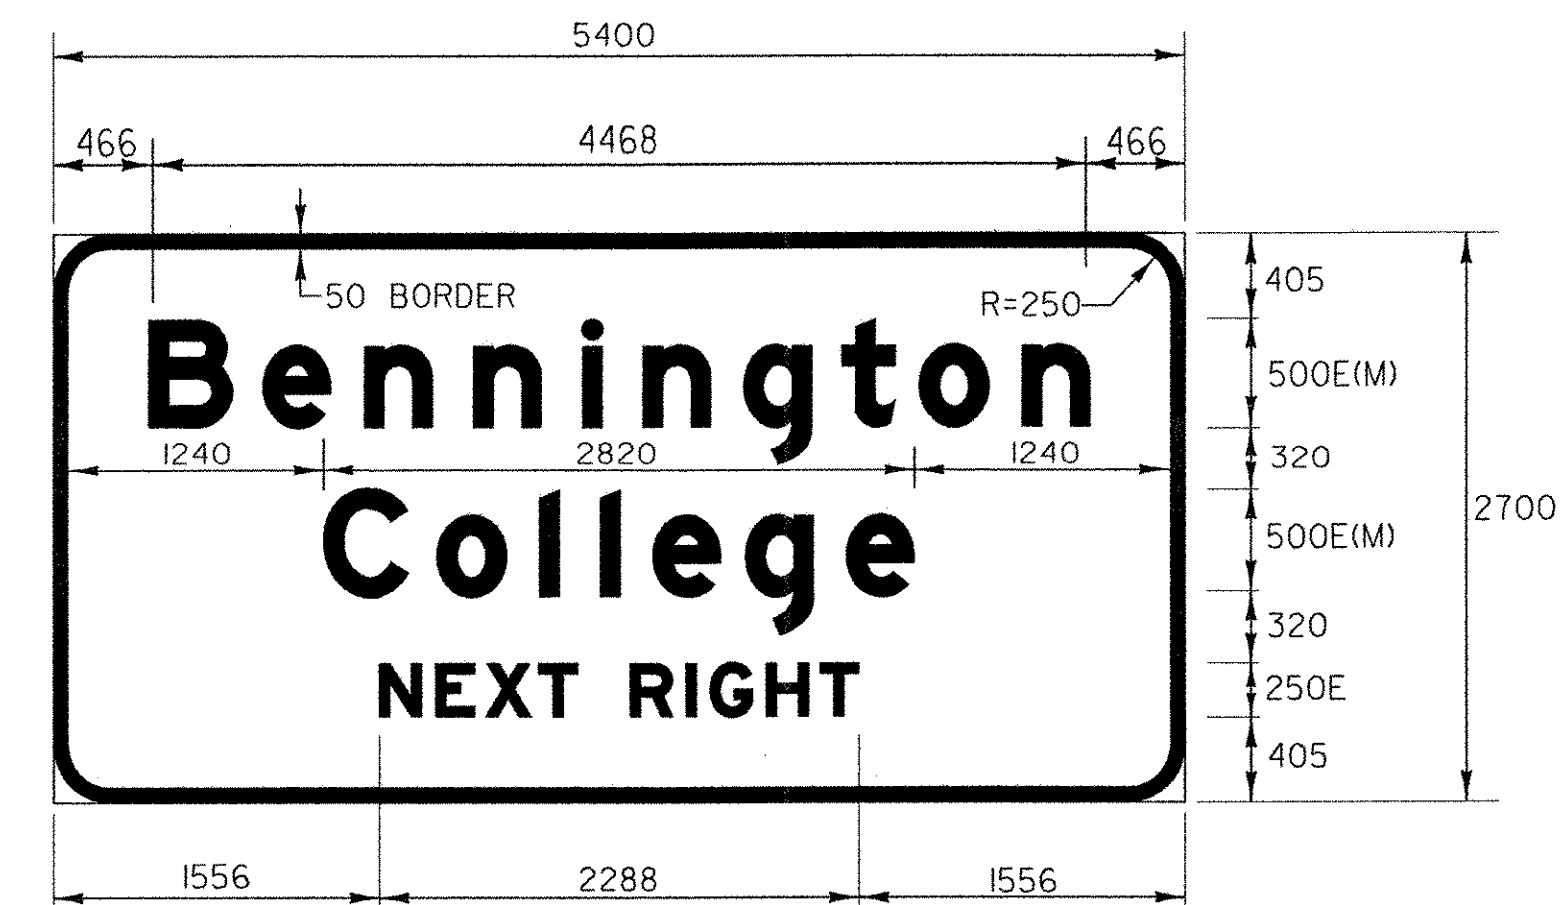


COLOR: WHITE BORDER & SYMBOL (REFLECTORIZED)  
 GREEN BACKGROUND (REFLECTORIZED)

MATERIAL: PER VAOT STANDARD E-131M  
 SIGN - VT ROUTE 279  
 STA. 15+390.0 RT

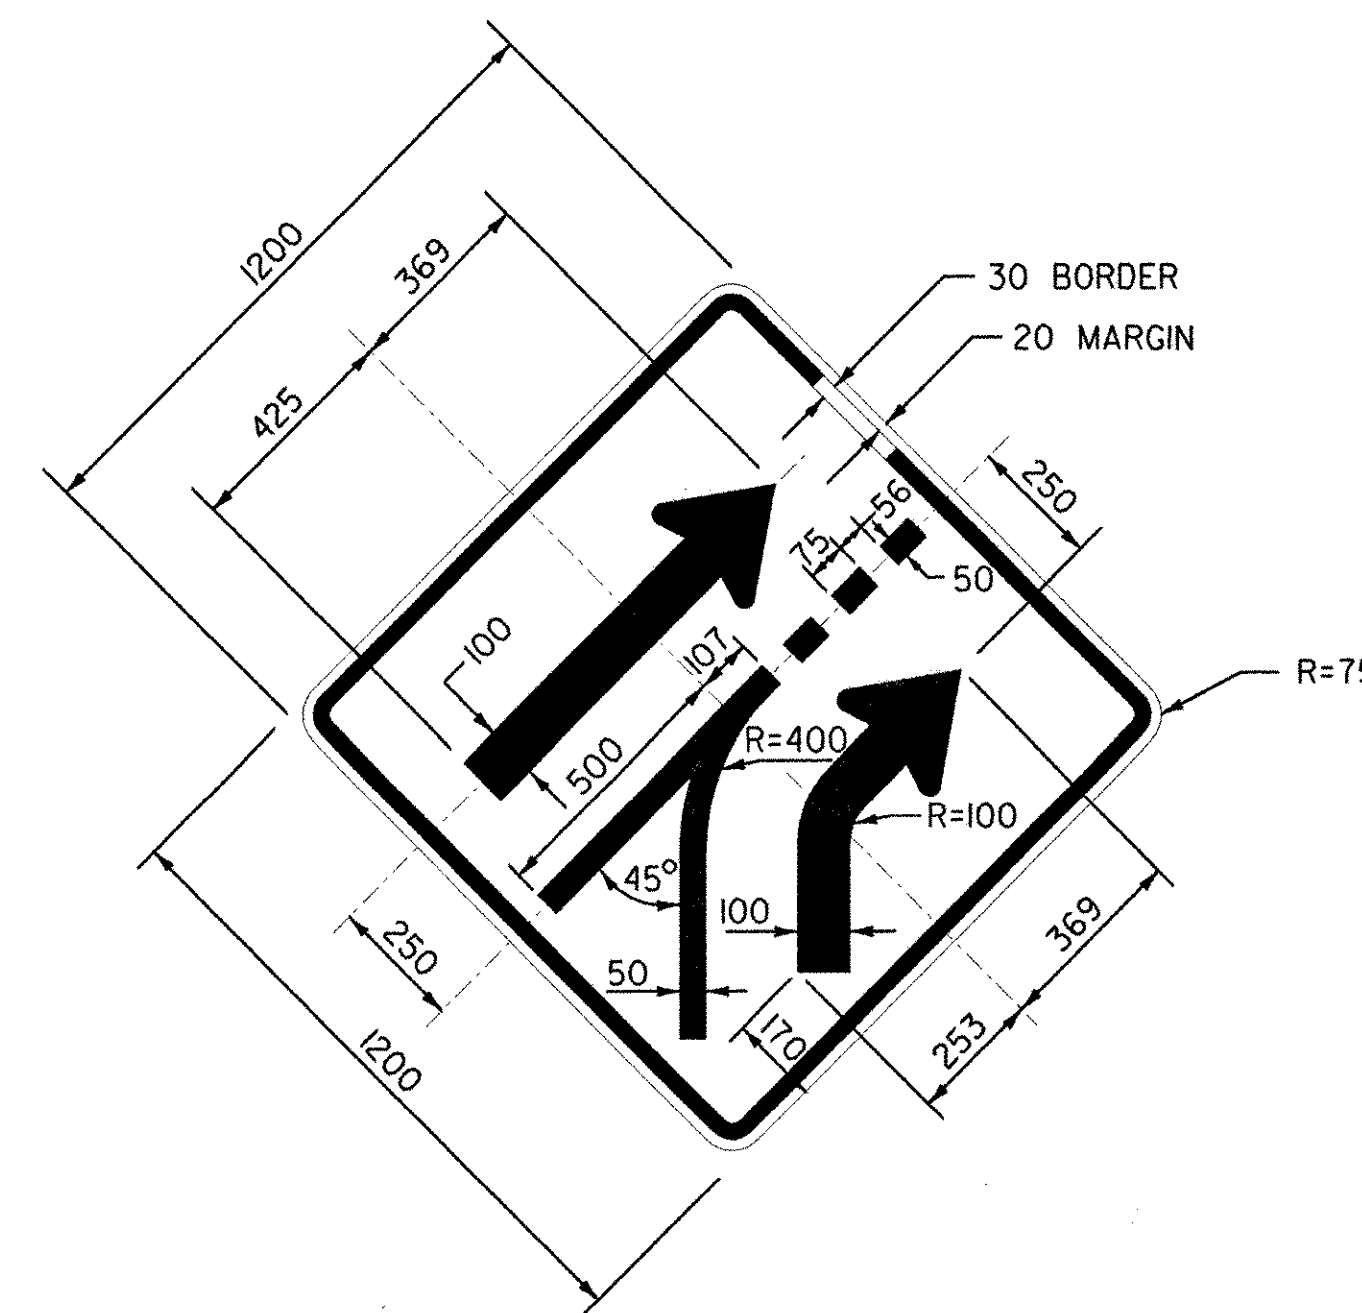


COLOR: BLACK BORDER & SYMBOL (REFLECTORIZED)  
 YELLOW BACKGROUND (REFLECTORIZED)

MATERIAL: PER VAOT STANDARD E-155M  
 SIGN - RAMP E  
 STA. E2+230.0 RT

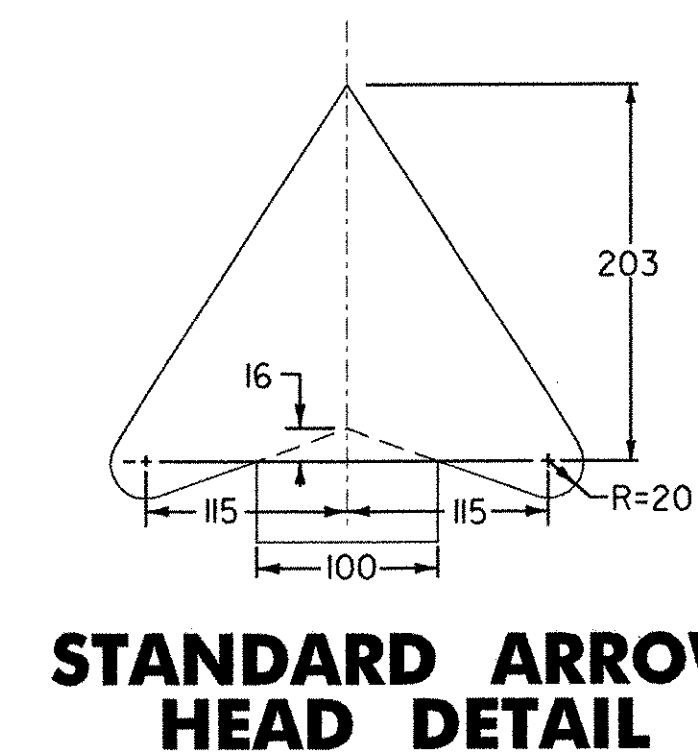

**STANDARD ARROW HEAD DETAIL**

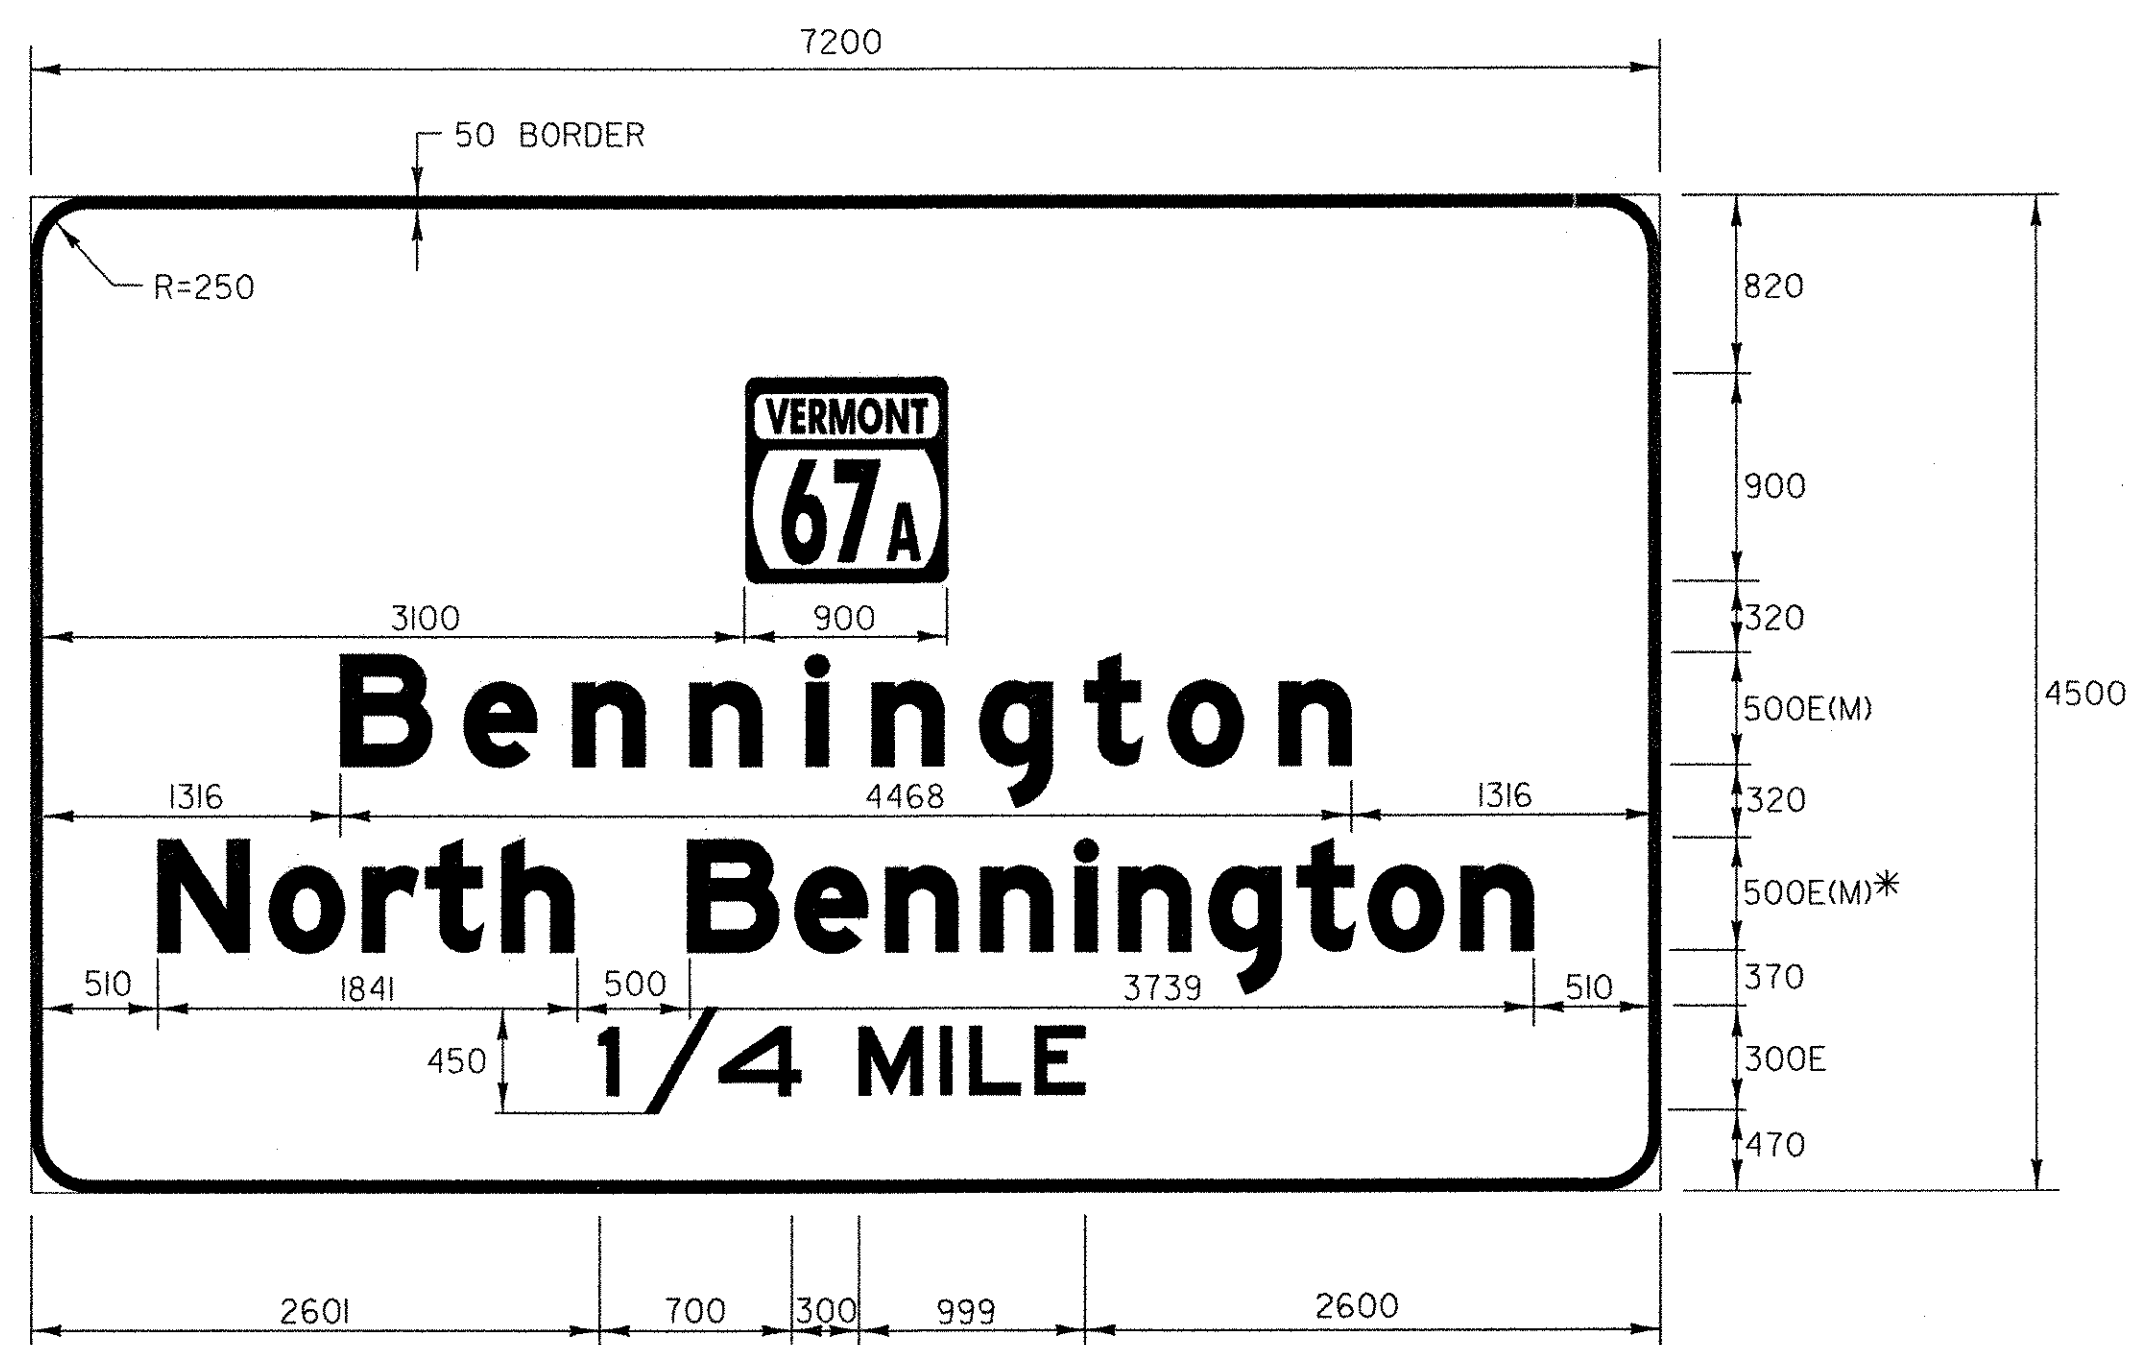

COLOR: WHITE BORDER & TEXT (REFLECTORIZED)  
 GREEN BACKGROUND (REFLECTORIZED)

MATERIAL: PER VAOT STANDARD E-131M  
 \*50% REDUCTION IN SPACING  
 SIGN - VT. ROUTE 279  
 W.B. STA. 17+670.0, LT

ALL DIMENSIONS IN MILLIMETERS UNLESS OTHERWISE NOTED.


**TRAFFIC SIGN DETAIL SHEET**

SURVEYED BY C.H.A. & V.S.E. DATE 12/93  
 DESIGNED BY D.W.E. DATE 2/04  
 DRAWN BY C.A.K. DATE 2/04  
 CHECKED BY D.E.G. DATE 2/04

DESIGN FILE NO. TSD01.DGN  
 PROJ. NAME BENNINGTON - HOOSICK  
D.P.I. 0146(II) C/6  
 PROJ. NO. P.I.N. 1306.60  
 DWG NO. TSD-1 SHEET 50 OF 83


TEXT LAYOUT DIMENSIONS ARE BASED ON THE 'LETTER & NUMERAL WIDTHS AND SPACE' TABLES FOUND IN THE 'STANDARD HIGHWAY SIGNS' BOOKLET. MINOR VARIATIONS IN TEXT DIMENSIONS ARE ACCEPTABLE BASED ON INDIVIDUAL MANUFACTURER'S LETTER FABRICATION. SIGNIFICANT CHANGES WHICH AFFECT SIGN APPEARANCE SHALL BE BROUGHT TO THE ATTENTION OF THE VAOT'S TRAFFIC OPERATIONS SECTION BEFORE FABRICATION.

DATUM	
VERTICAL	NAVD 88
HORIZONTAL	NAD 83 (1992)

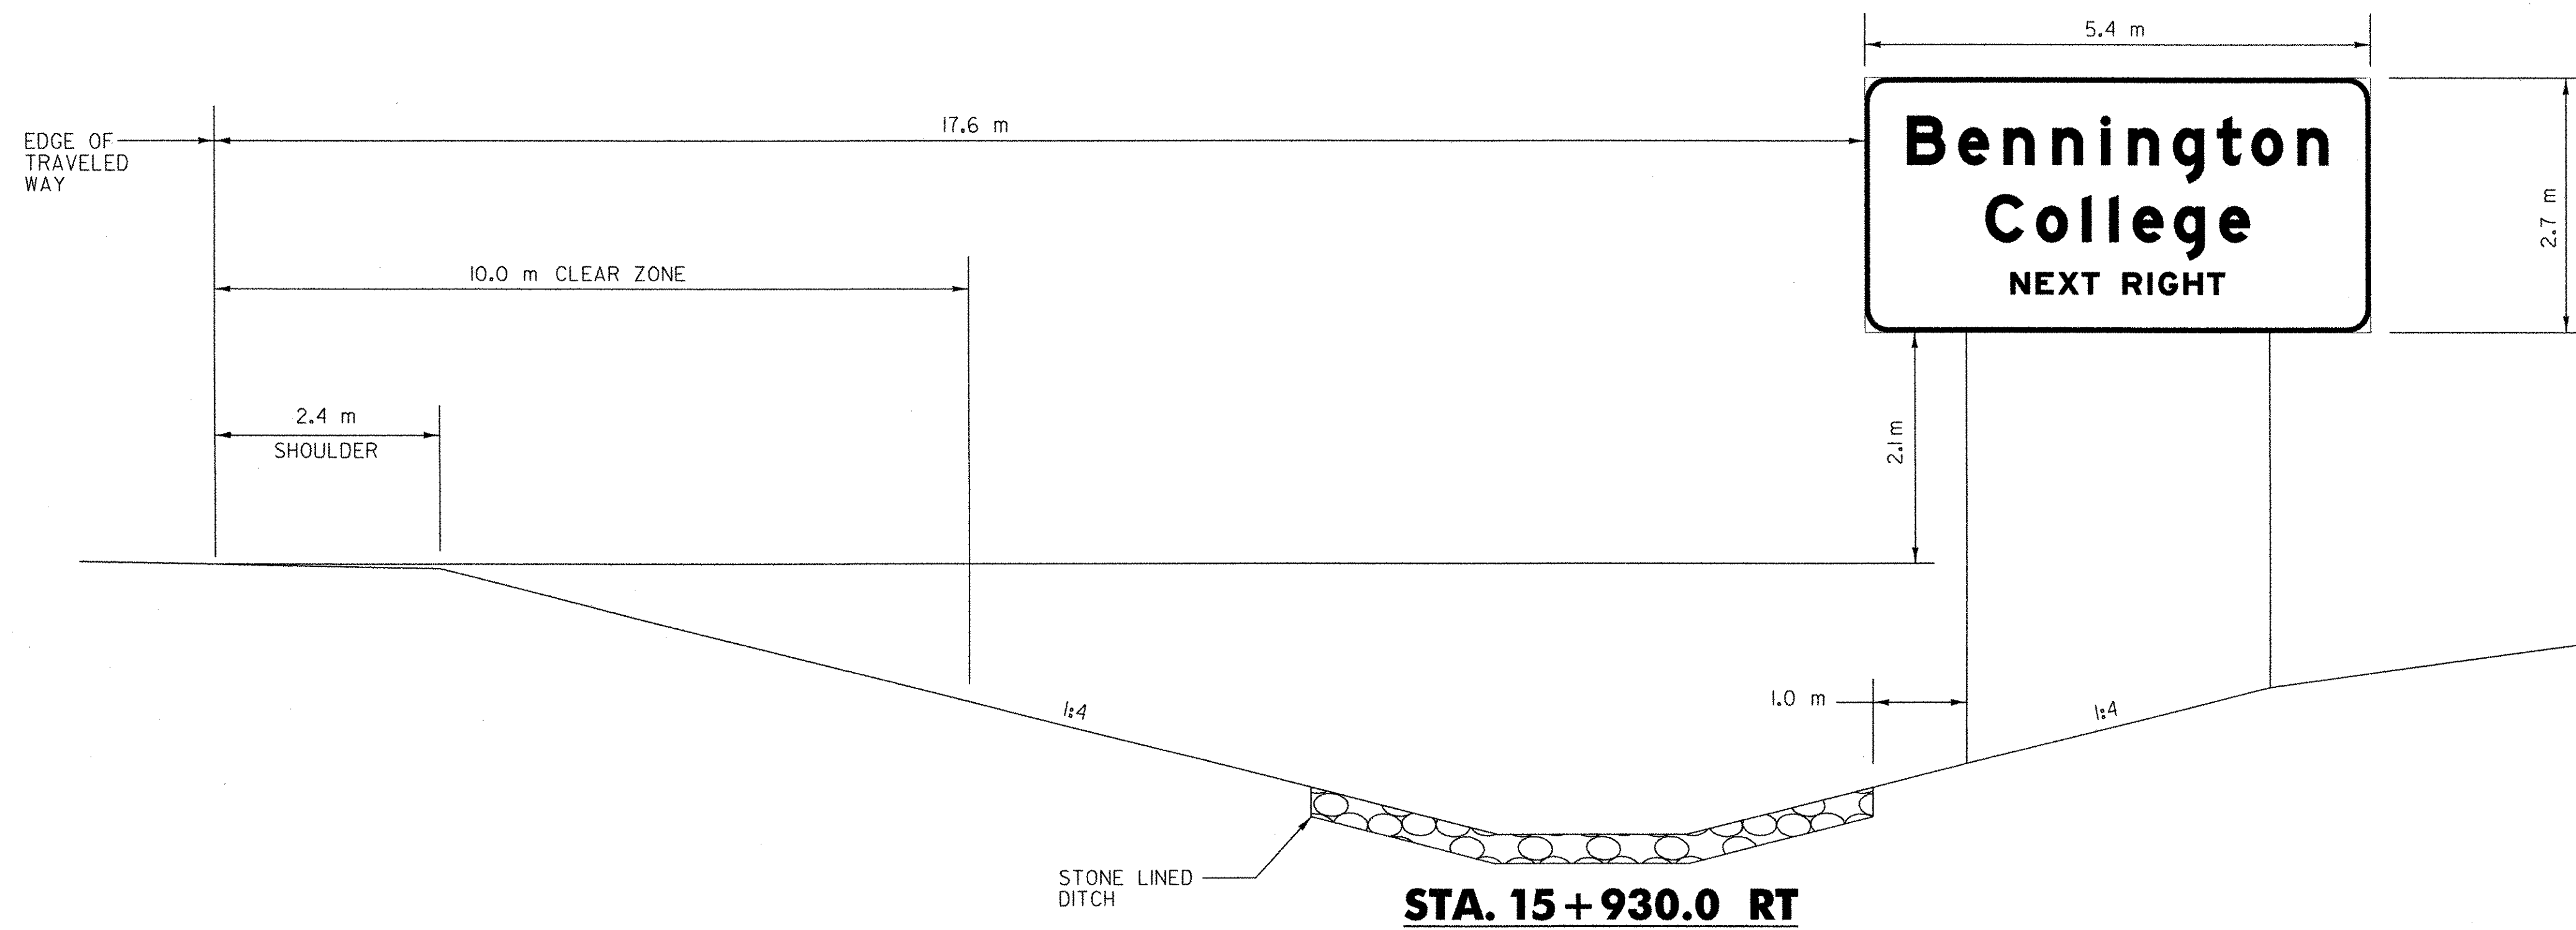

**STA. 15+930.0 RT**

NOTE: N.T.S.  
 1. THE CONTRACTOR SHALL FIELD VERIFY ALL DIMENSIONS PRIOR TO FABRICATION AND INSTALLATION OF THE PROPOSED SIGN.

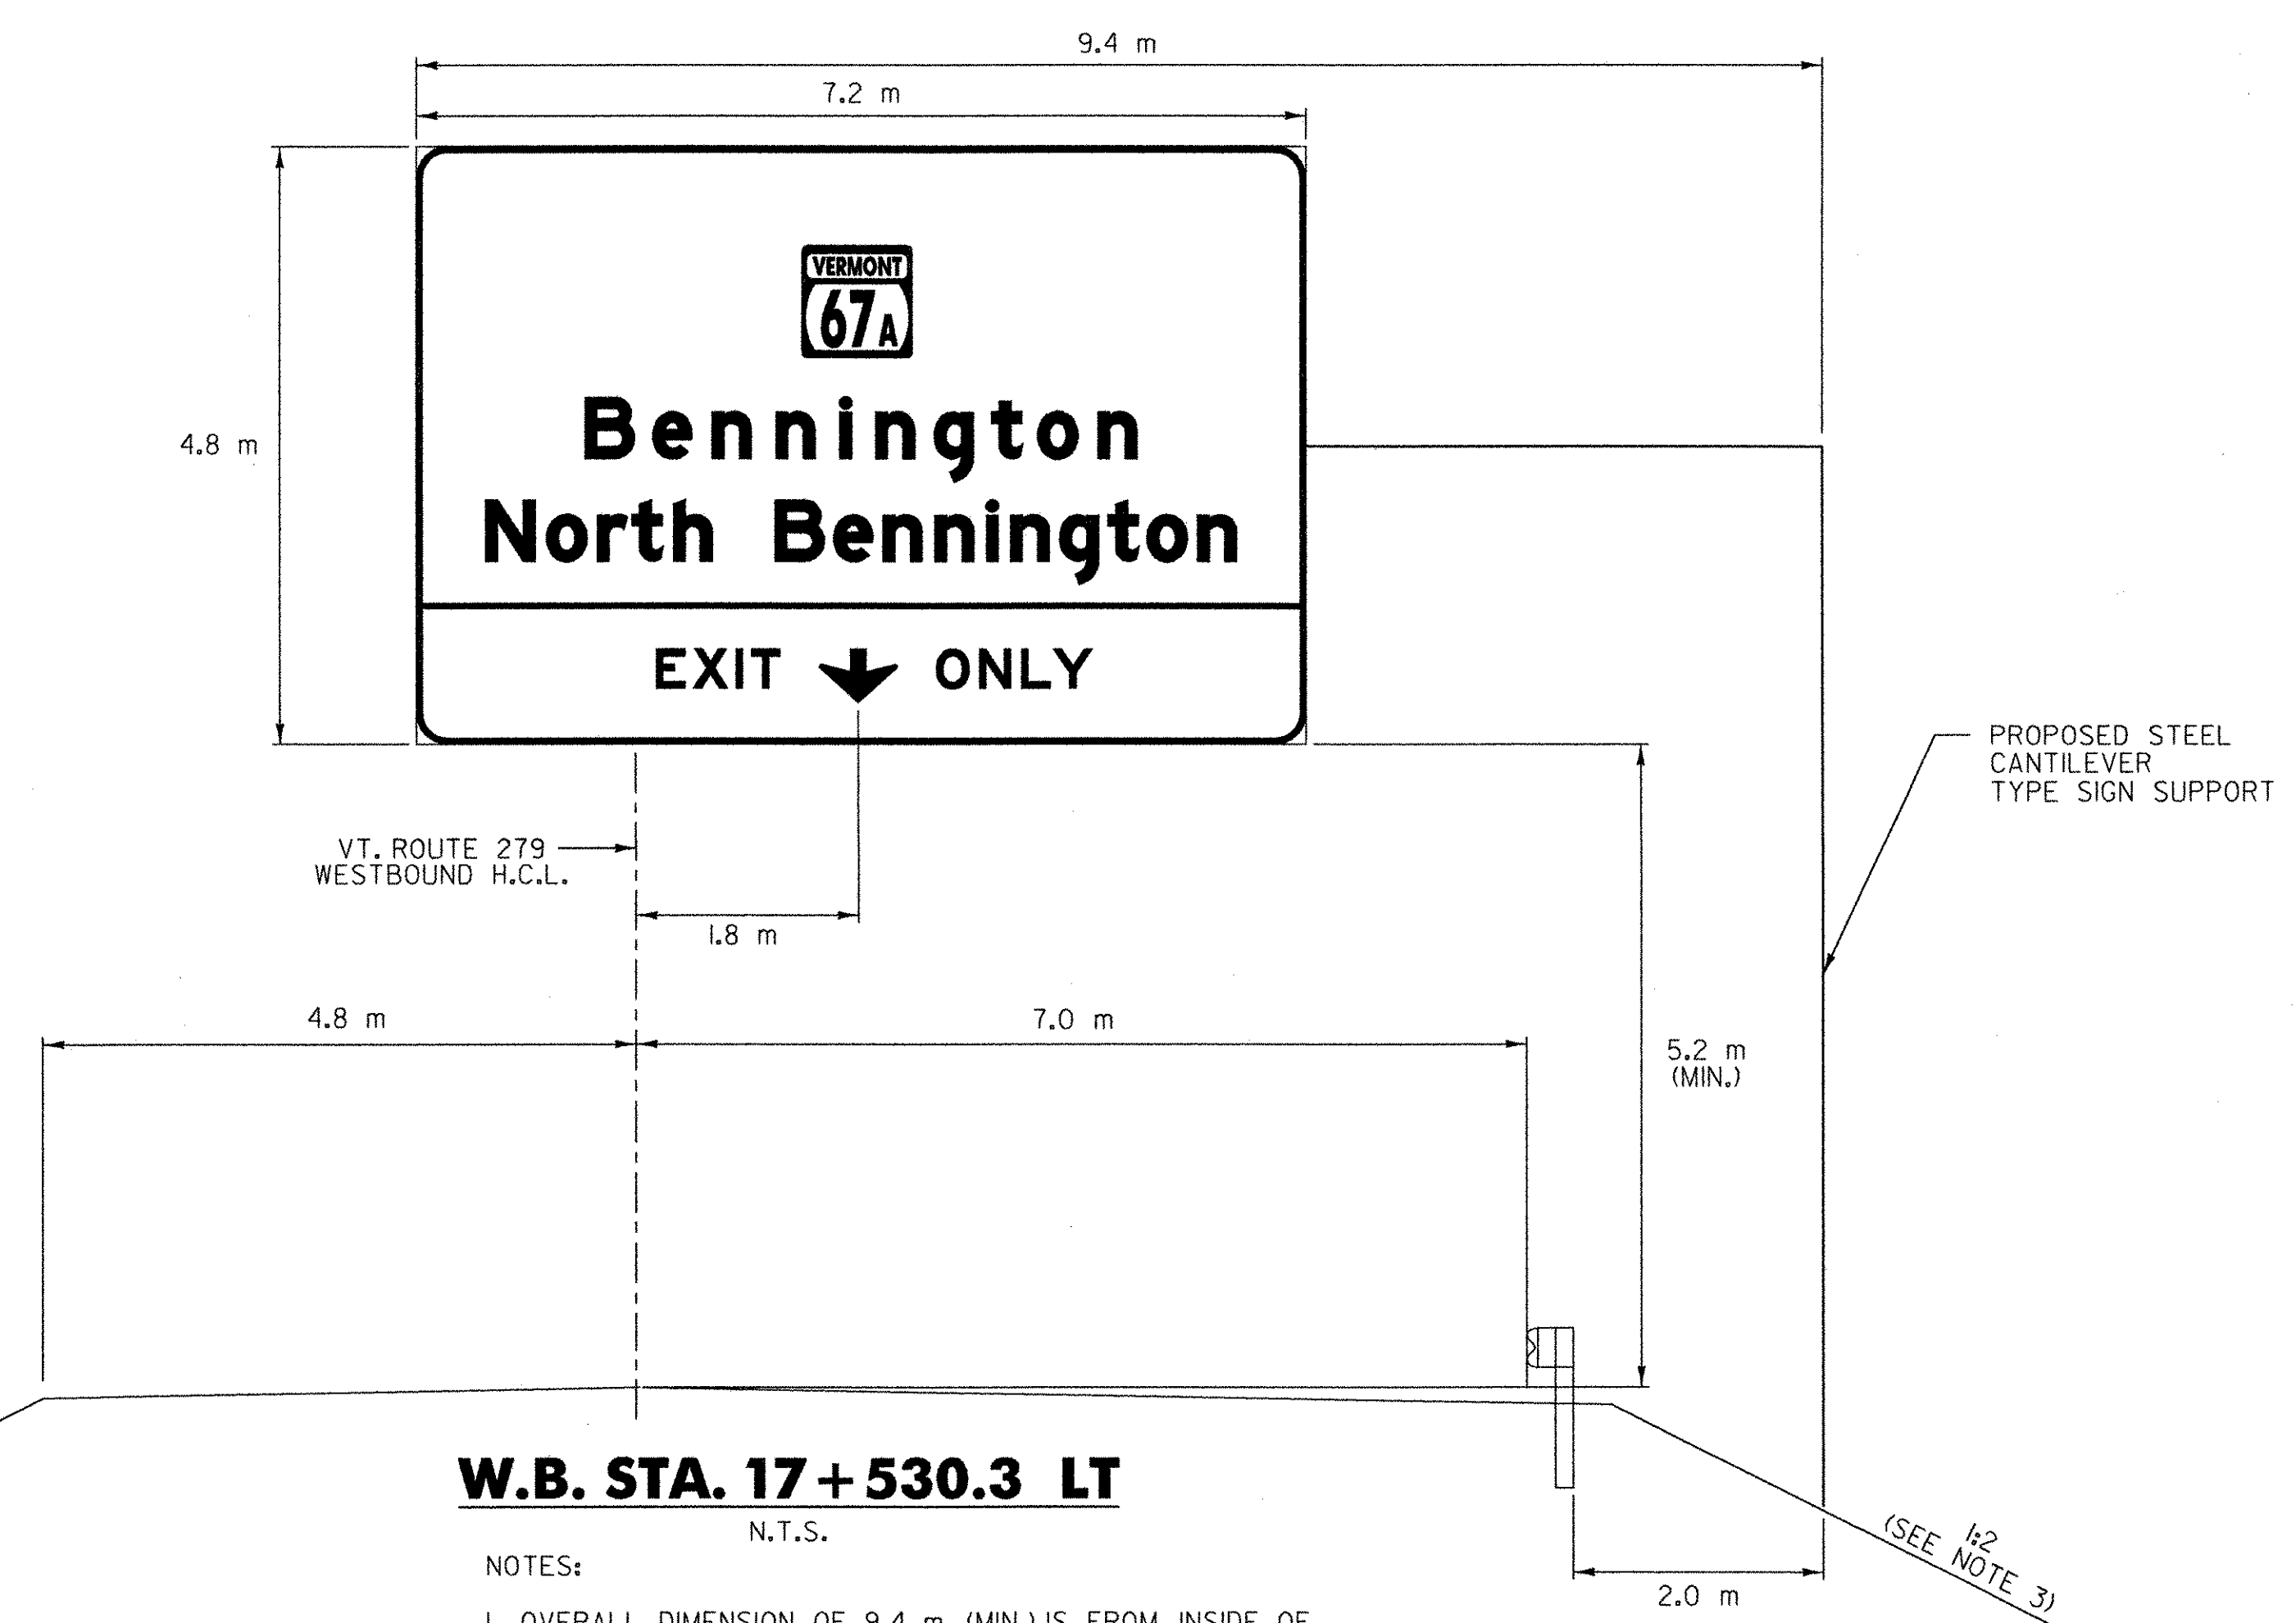


**W.B. STA. 17+530.3 LT**

NOTE: N.T.S.  
 1. OVERALL DIMENSION OF 9.4 m (MIN.) IS FROM INSIDE OF SUPPORT TO OUTSIDE EDGE OF SIGN FACE.  
 2. THIS STRUCTURE SHALL BE A STEEL CANTILEVER TYPE SIGN SUPPORT PAID FOR UNDER ITEM 677J2 OVERHEAD TRAFFIC SIGN SUPPORT, CANTILEVER.  
 3. THE CONTRACTOR SHALL FIELD VERIFY ALL DIMENSIONS TO ASSURE PROPER SUPPORT OF THE OVERHEAD SIGN STRUCTURE PRIOR TO FABRICATION.


DATUM	
VERTICAL	NAVD 88
HORIZONTAL	NAD 83 (1992)

<b>SIGN PLACEMENT DETAIL SHEET</b>	SURVEYED BY	C.H.A. & V.S.E.	DATE	12/93
	DESIGNED BY	D.W.E.	DATE	2/04
	DRAWN BY	C.A.K.	DATE	2/04
	CHECKED BY	D.E.G.	DATE	2/04
DESIGN FILE NO. TSD02.DGN				
PROJ. NAME BENNINGTON - HOOSICK D.P.I. 0146(II) C/6				
PROJ. NO. P.I.N. 1306.60				
DWG NO. SPD-1 SHEET 51 OF 83				


FILE NAME = u:\5116\svoot\contract6\tsd02.dgn  
 DATE / TIME = 1/16/2004 12:22:25  
 USER = 2225

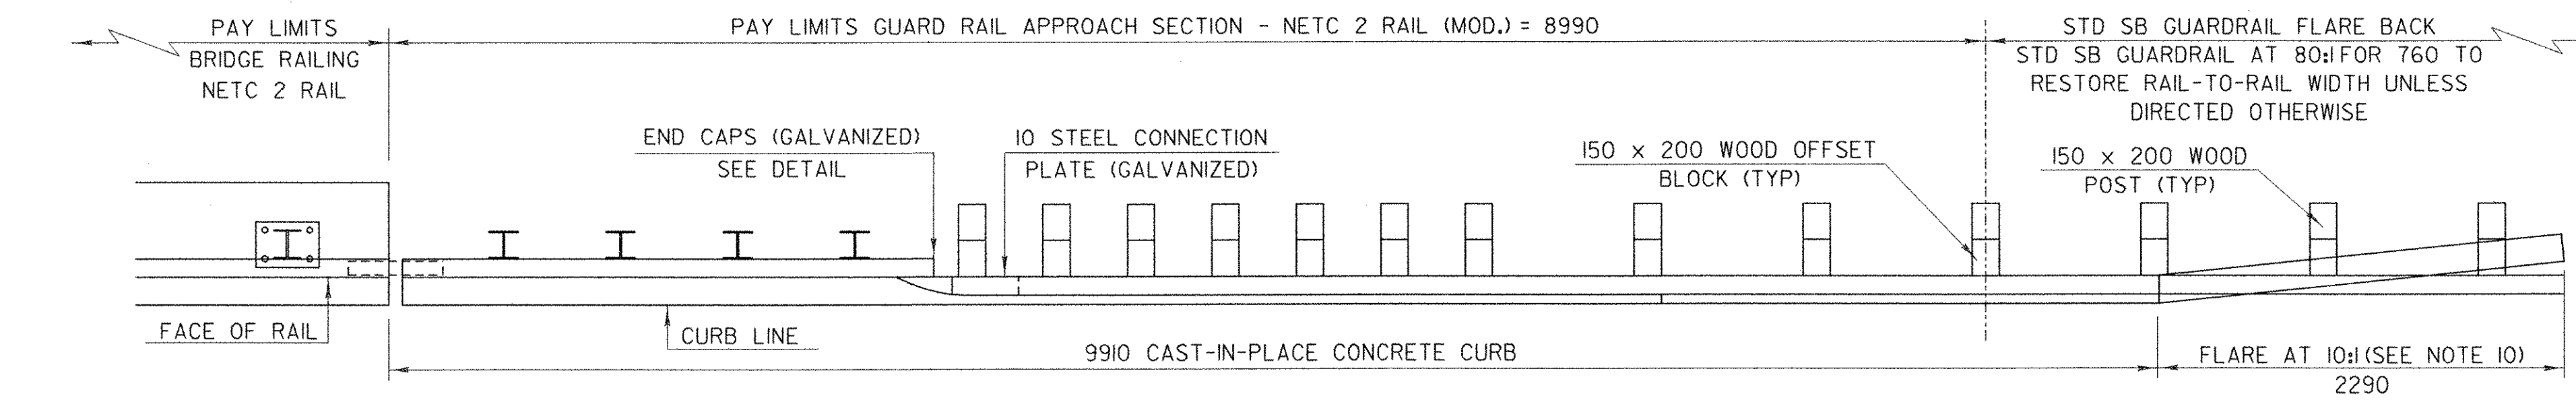


**RAILING TRANSITION PLAN**

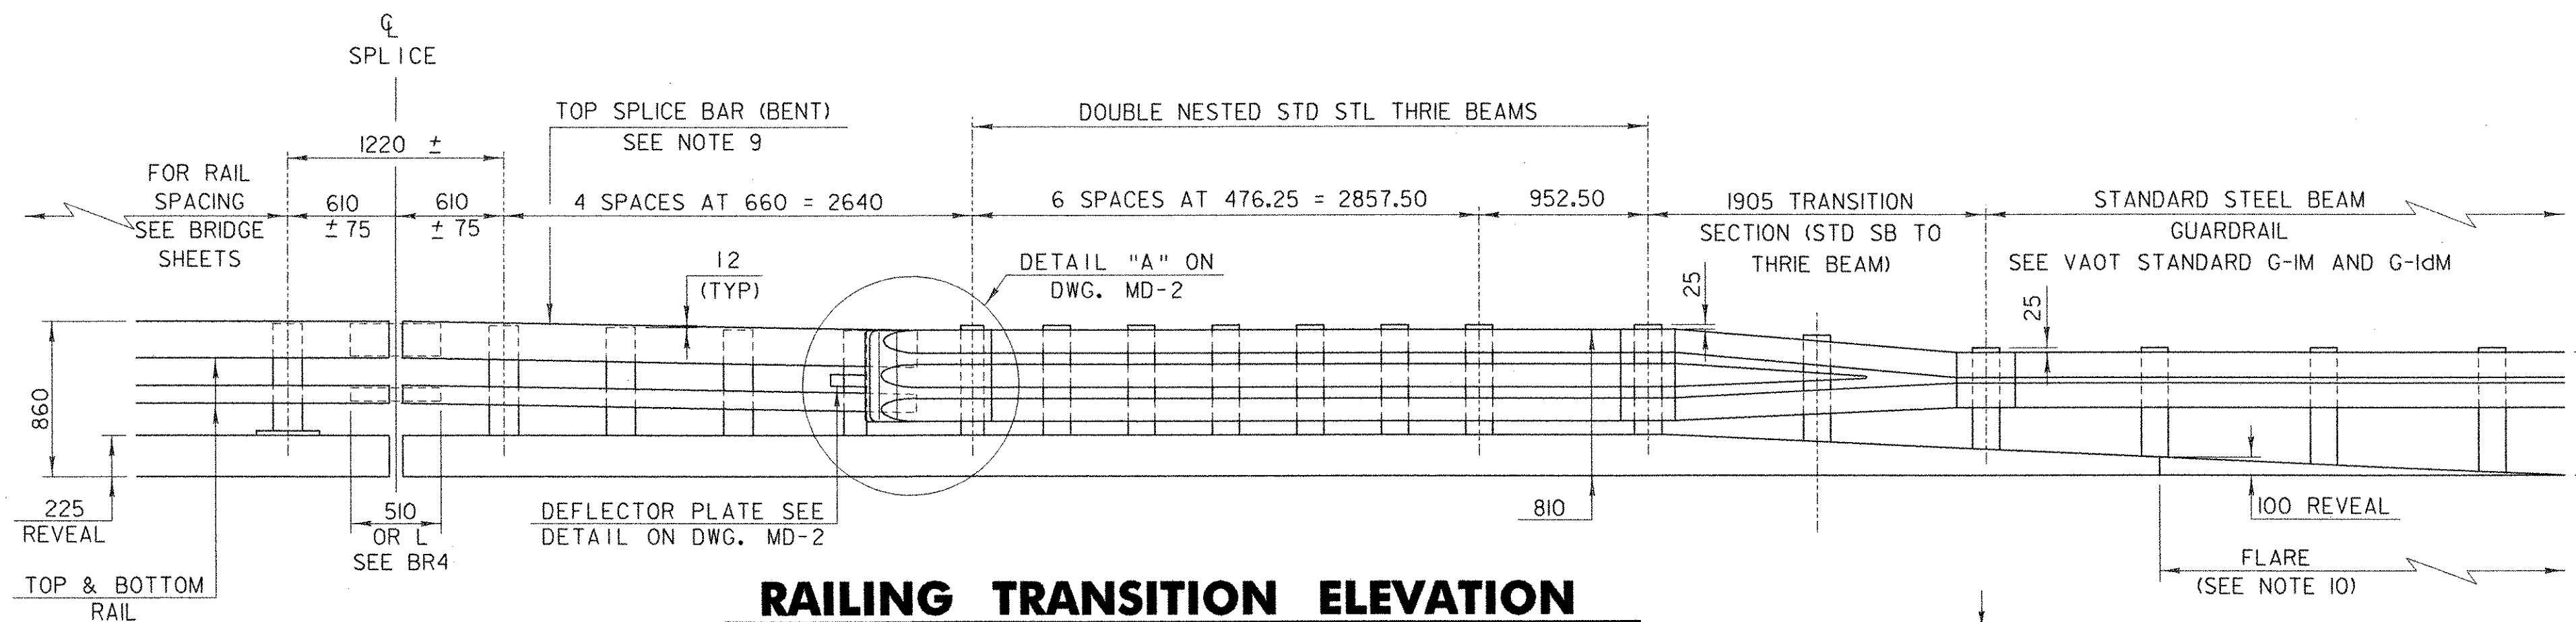

**RAILING TRANSITION ELEVATION**

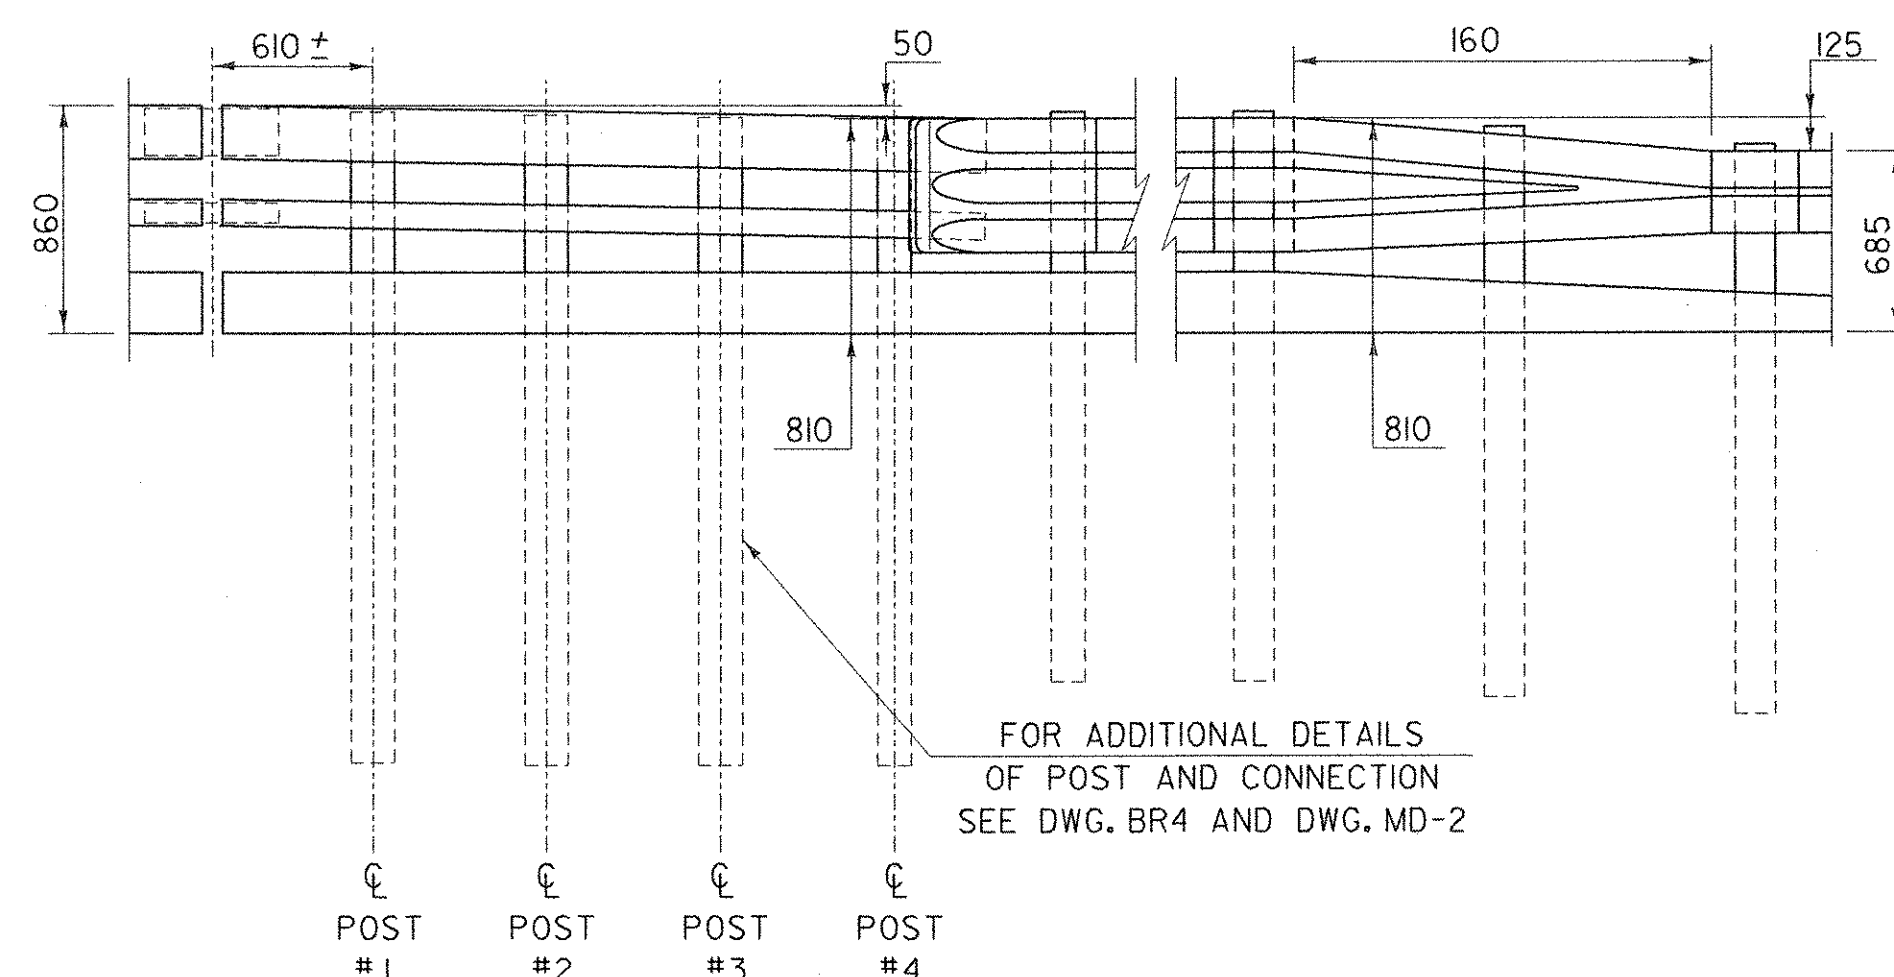

**ELEVATION**

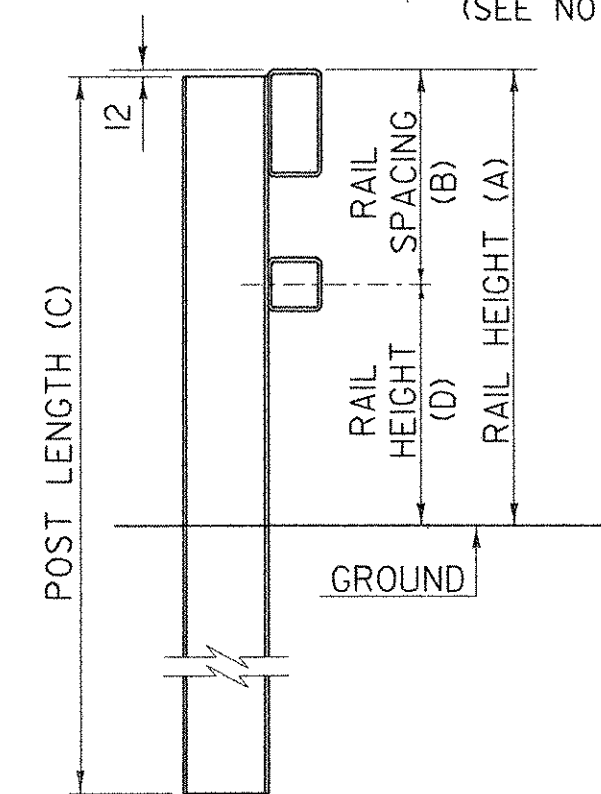


**TYPICAL SECTION**

POST NUMBER	RAIL HEIGHT (A)	RAIL SPACING (B)	POST LENGTH (C)	RAIL HEIGHT (D)
1	850	400	2440	450
2	840	395	2440	445
3	825	385	2440	440
4	810	375	2440	435

**NOTES**

1. REFER TO SHEET BR4 FOR ADDITIONAL DETAILS, NOTES AND MATERIAL SPECIFICATIONS.
2. PAYMENT FOR GUARDRAIL APPROACH SECTION - NETC 2 RAIL (MOD.) SHALL INCLUDE THE TERMINAL CONNECTOR, THE CONNECTION PLATE, THE DEFLECTOR PLATE, RAIL, POSTS, BLOCKS AND ATTACHMENT HARDWARE.
3. THE REFLECTORIZED ALUMINUM DELINEATION IS TO BE ERRECTED EVERY 9m (OR CLOSEST POST) WITH A M16 BOLT. DELINEATORS SHALL MEET SPECIFICATION REQUIREMENTS FOR ASTM B209 ALLOY 5052-H32.
4. REFLECTIVE MATERIAL SHALL MEET REQUIREMENTS OF SUBSECTION 750.08 AND SHALL BE OF ENCAPSULATED LENS SILVER OR AMBER. AMBER IS TO BE INSTALLED ON THE DRIVER'S LEFT AND SILVER ON THE IR RIGHT.
5. ALL APPROACH RAIL SPLICES SHALL BE LAPPED IN THE DIRECTION OF TRAFFIC FLOW.
6. ALL BRIDGE APPROACH RAIL MATERIALS, DIMENSION SIZES AND NOTES SHALL BE THE SAME AS THOSE OF THE BRIDGE RAIL, UNLESS OTHERWISE NOTED.
7. APPROACH RAIL BOLTS SHALL BE ASTM F568M, CLASS 4.6 AND NUTS SHALL BE AASHTO M291M (ASTM A563M GRADE A OR BETTER) (GALVANIZED). STEEL WASHERS SHALL BE ASTM F844M.
8. WELD TOP SPLICE BAR TO FIT BEND. USE COMPLETE PENETRATION WELD (B-U2).
9. THE CONCRETE CURB WILL BE PAID FOR AS ITEM 616.28 CAST-IN-PLACE CONCRETE CURB, TYPE B.
10. ELIMINATE CONCRETE CURB FLARE AT LOCATIONS WHERE BITUMINOUS CONCRETE CURB, TYPE B EXTENDS BEYOND THE CAST-IN-PLACE CONCRETE CURB. SEE DWG. PDT-1 FOR CURB TRANSITION DETAILS.

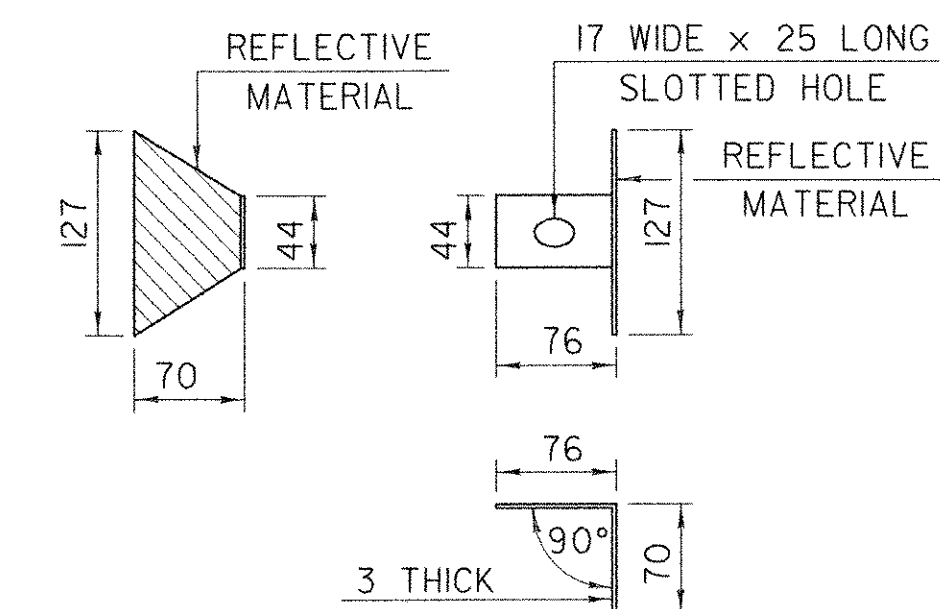


**DELINEATION DEVICE DETAILS**

ALL DIMENSIONS IN MILLIMETERS UNLESS OTHERWISE NOTED.


<b>APPROACH RAIL N.E.T.C. 2 RAIL DETAIL SHEET</b>	SURVEYED BY	C.H.A. & V.S.E.	DATE	12/93
	DESIGNED BY	D.W.E.	DATE	2/04
	DRAWN BY	C.A.K.	DATE	2/04
	CHECKED BY	D.E.G.	DATE	2/04
	DESIGN FILE NO.	MD01.DGN		
PROJ. NAME	BENNINGTON - HOOSICK D.P.I. 0146(1) C/6			
PROJ. NO.	P.I.N. 1306.60			
DWG NO.	MD-1	SHEET	52 OF 83	

FILE NAME = ur\5116\vaot\contract6\md01.dgn  
DATE/TIME = 2/16/2004  
USER = 2225


DATUM	
VERTICAL	NAVD 88
HORIZONTAL	NAD 83 (1992)

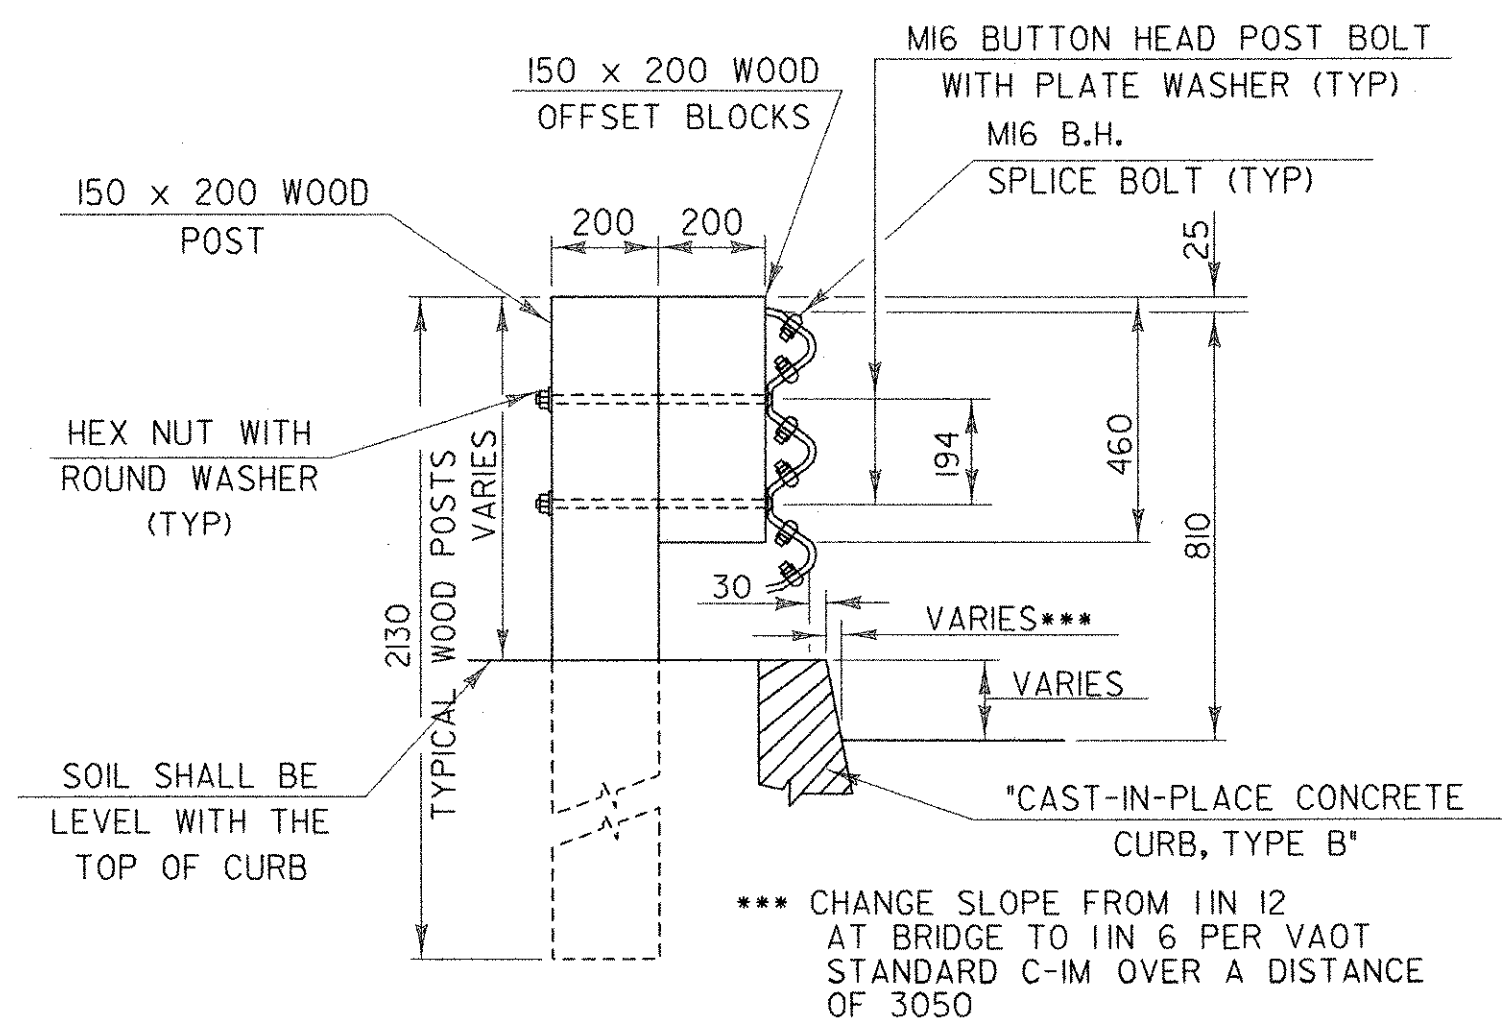


**WOOD POST-RAIL ASSEMBLY**

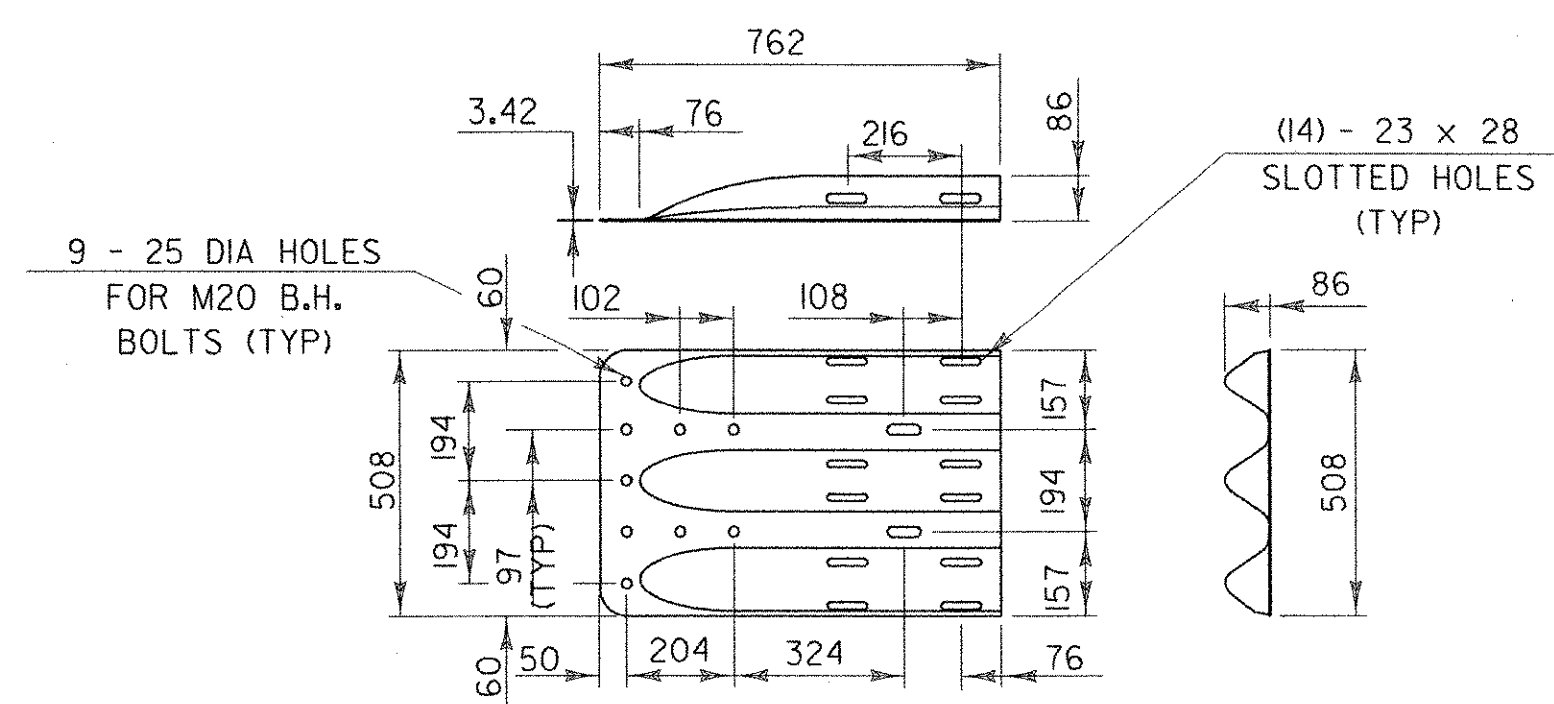


**THREE-BEAM TERMINAL CONNECTOR (HM-TF-13RE-67)**

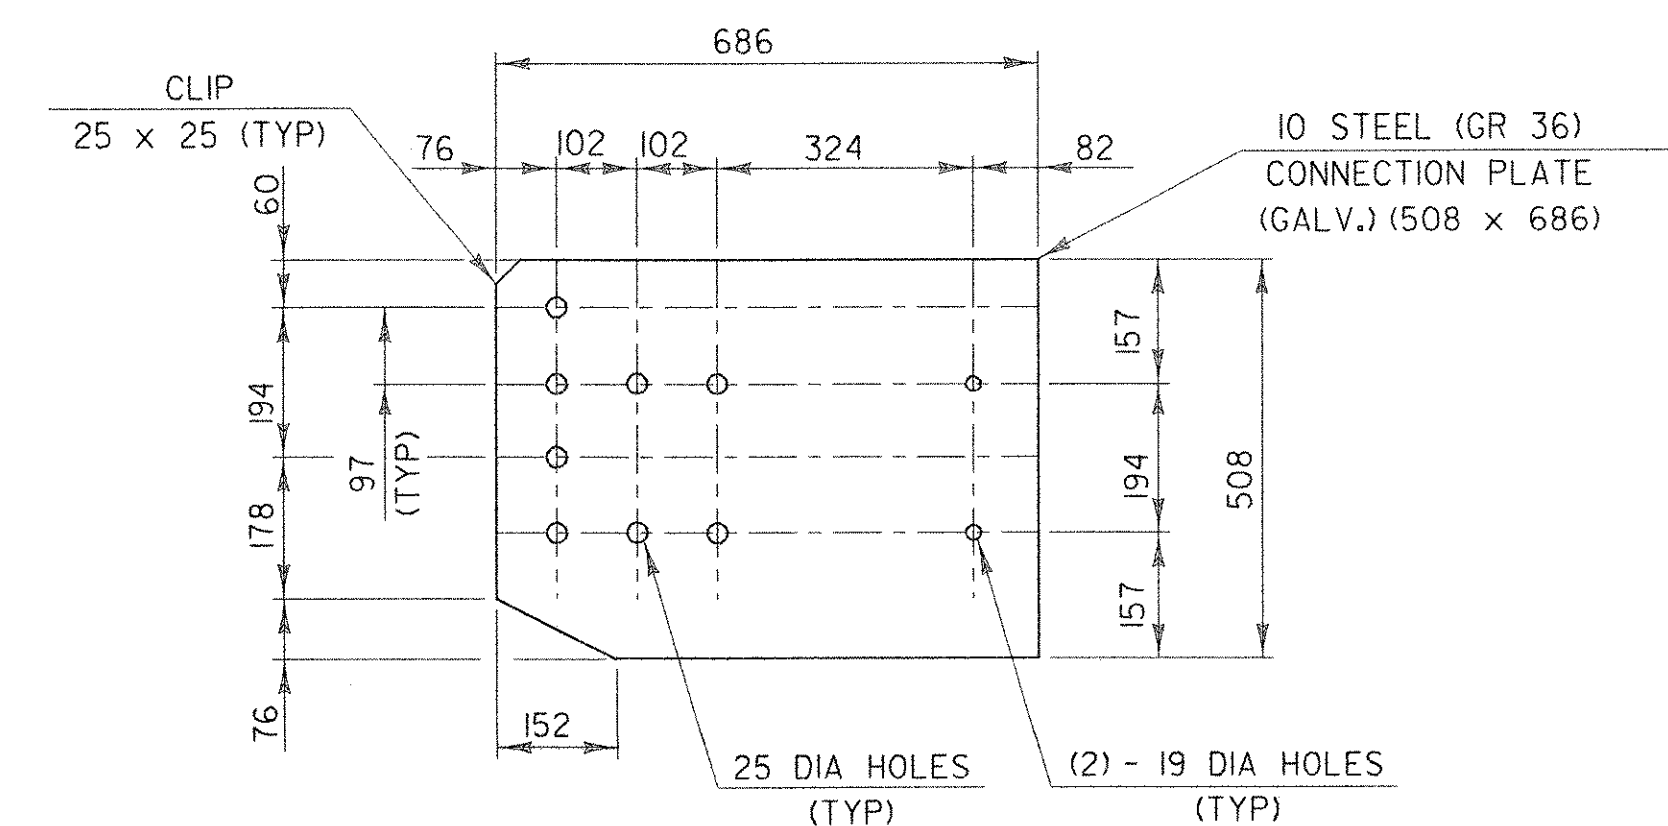


**CONNECTION PLATE**

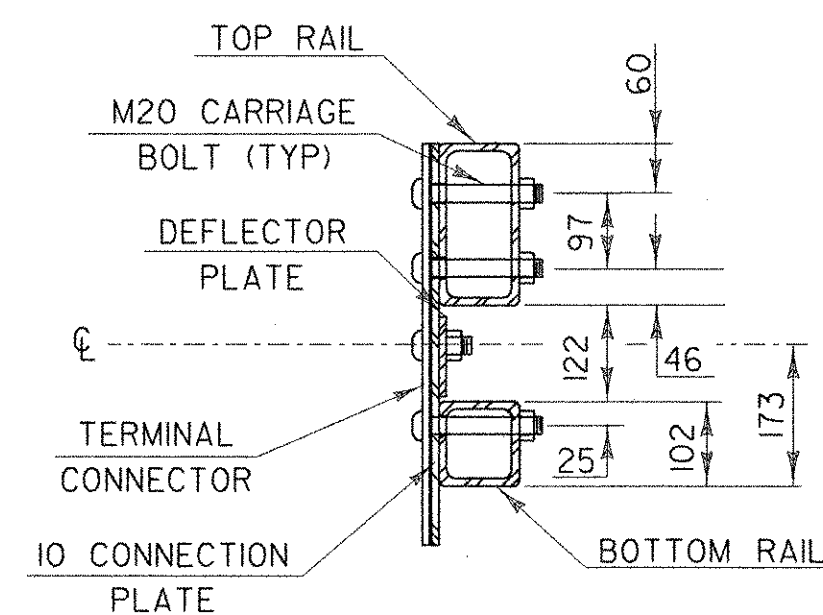

**SECTION C-C (CONNECTION PLATE)**

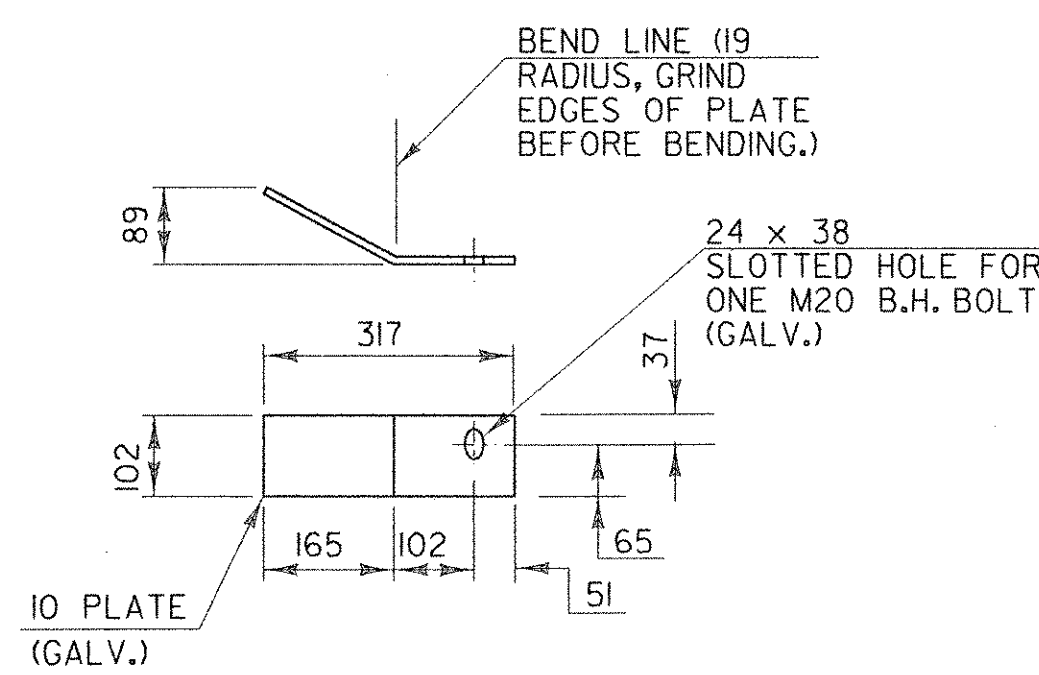


**DEFLECTOR PLATE DETAIL**

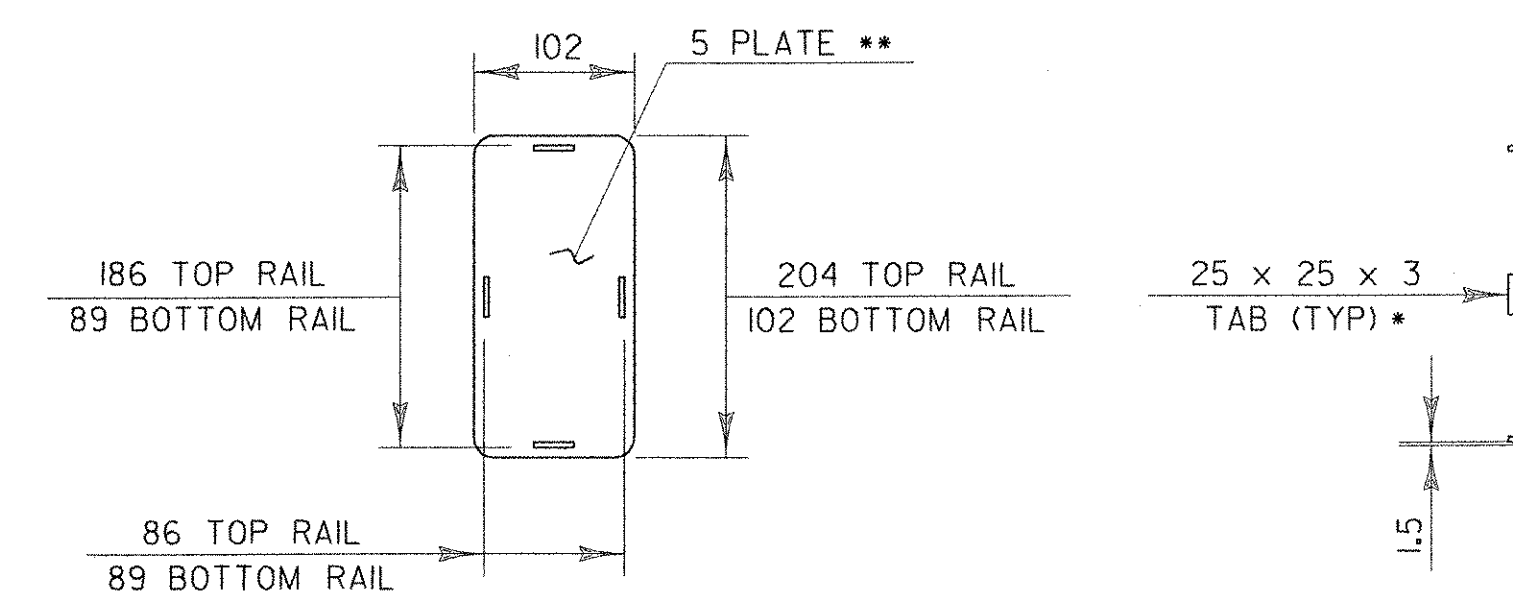


**END CAP DETAIL**


\* WELD TABS TO END CAP PLATE IN TAPERED POSITION SO CAP CAN BE JAMMED INTO END OF RAIL TUBE.  
 \*\* ROUND CORNERS 12 RADIUS (TYP)

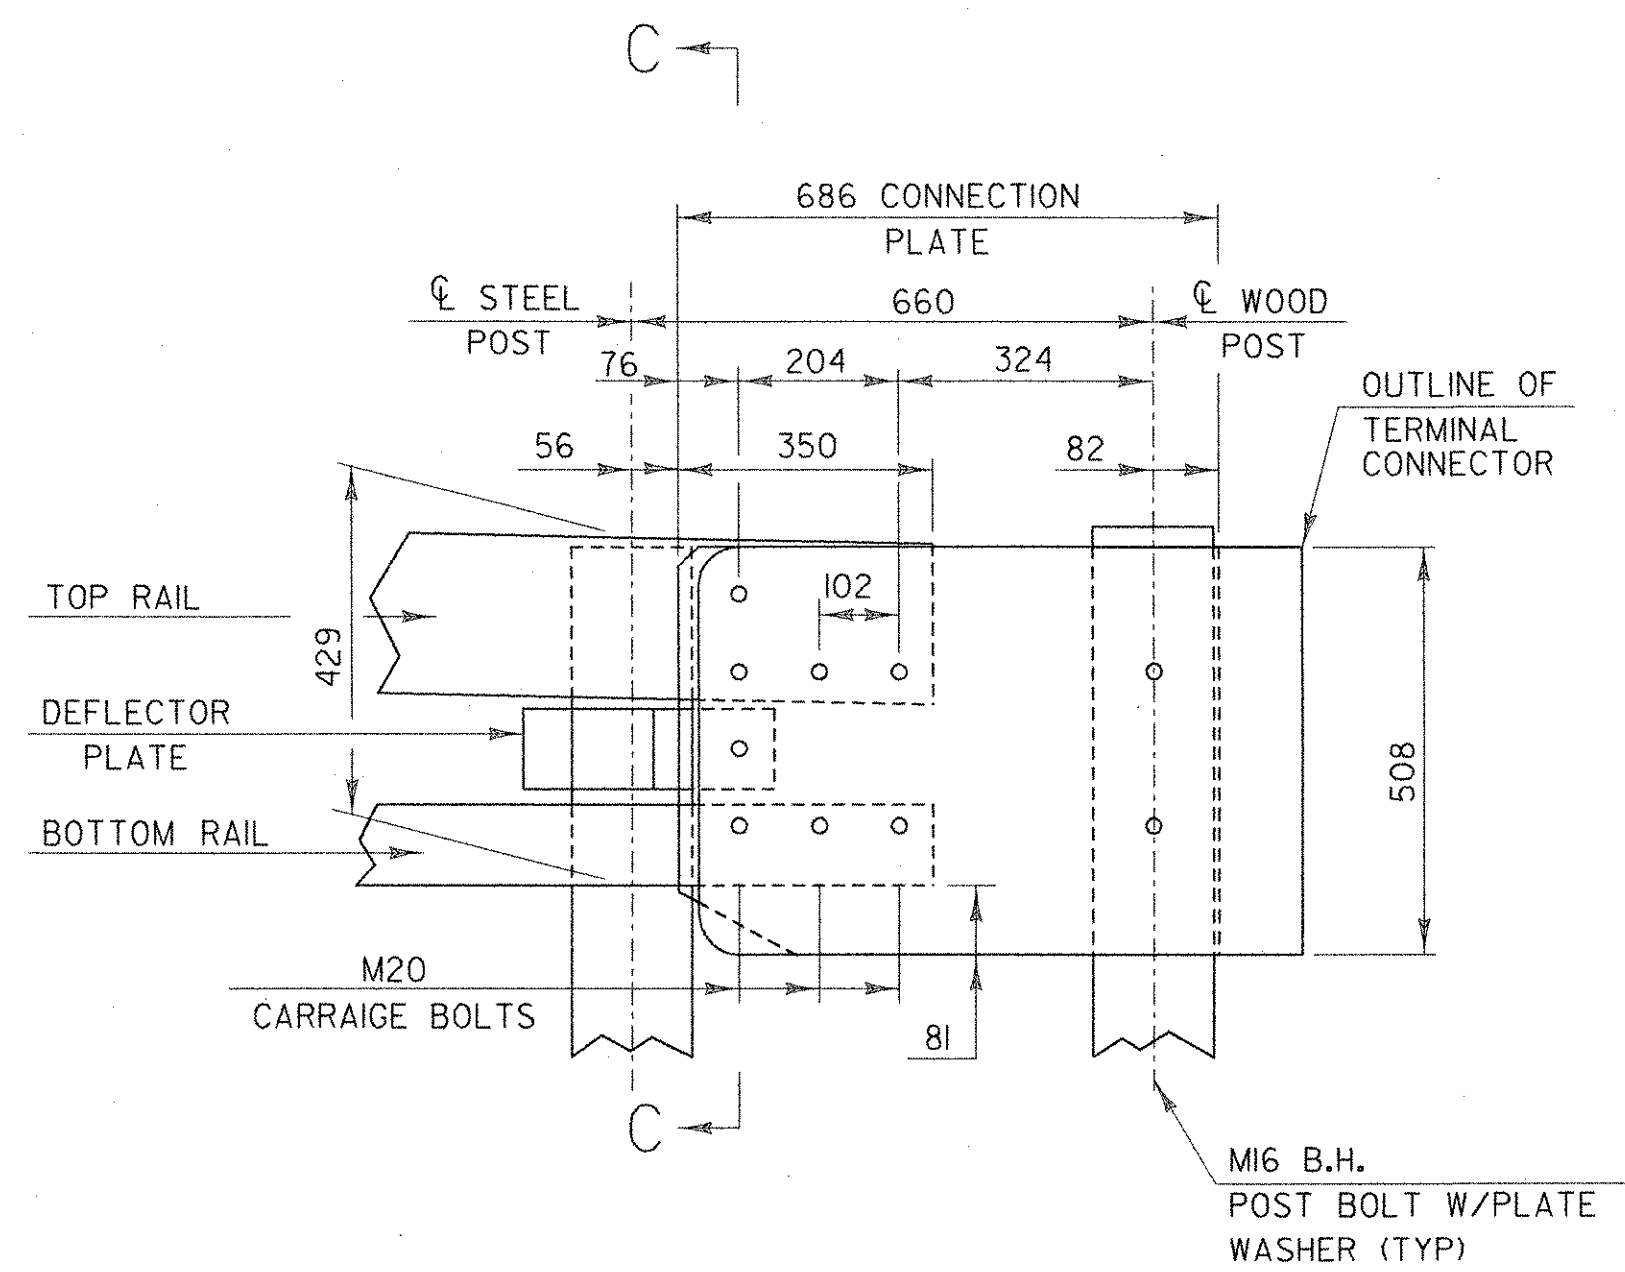

**DETAIL A**

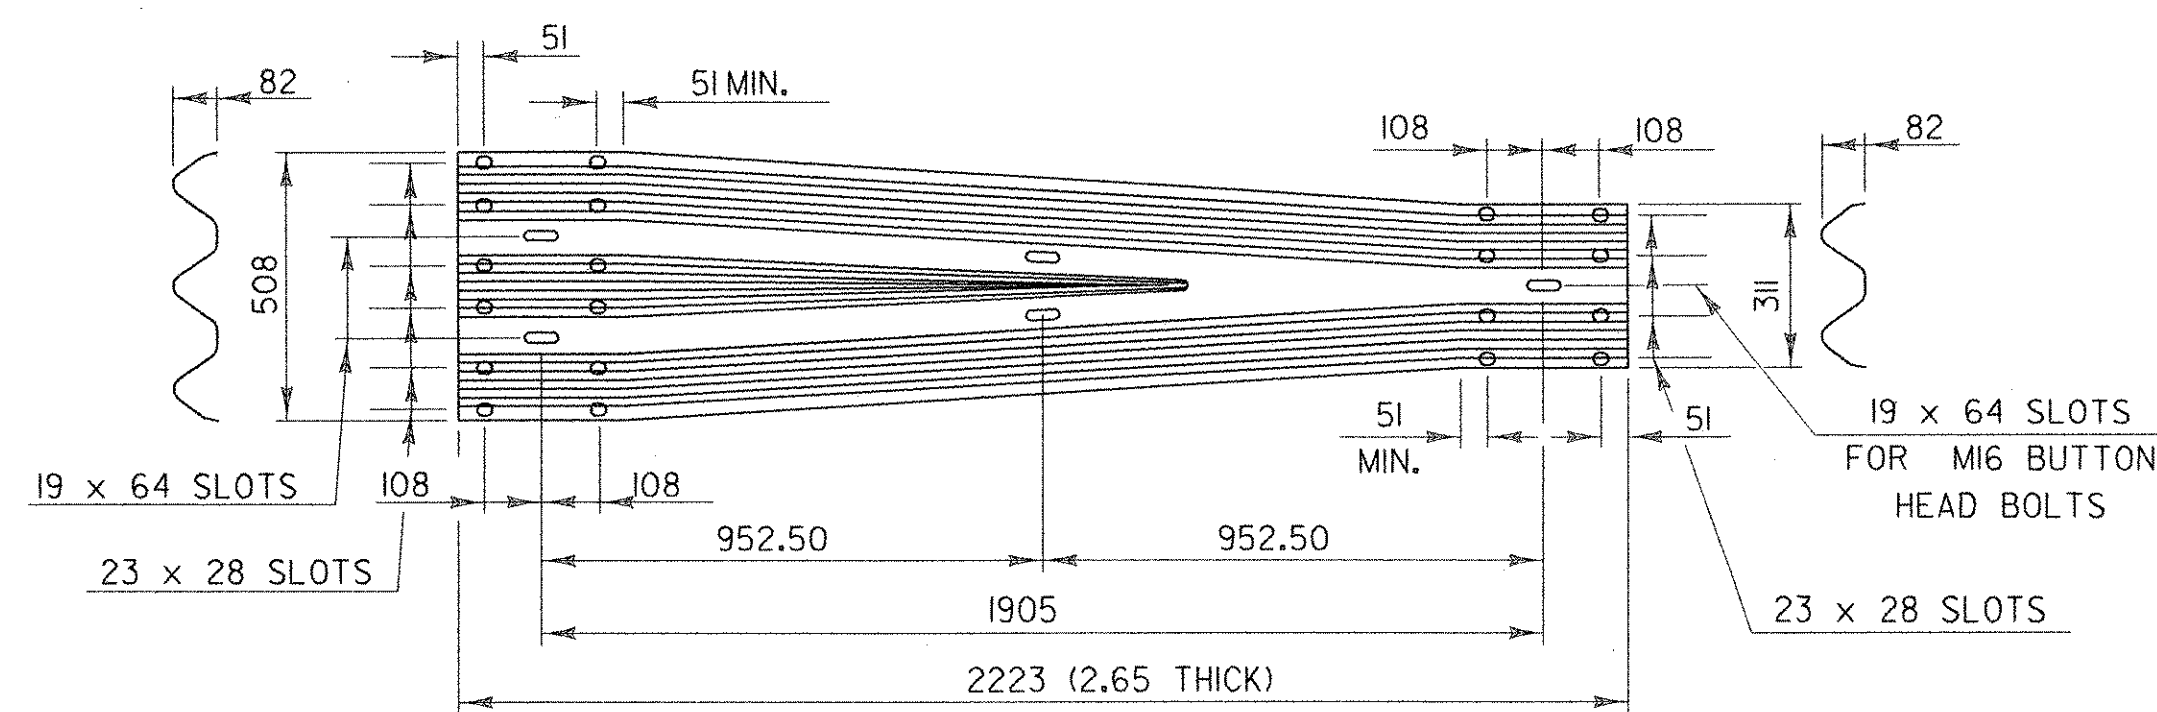

**THREE-BEAM TO STD SB TRANSITION SECTION (HM-TF-13RE-69)**

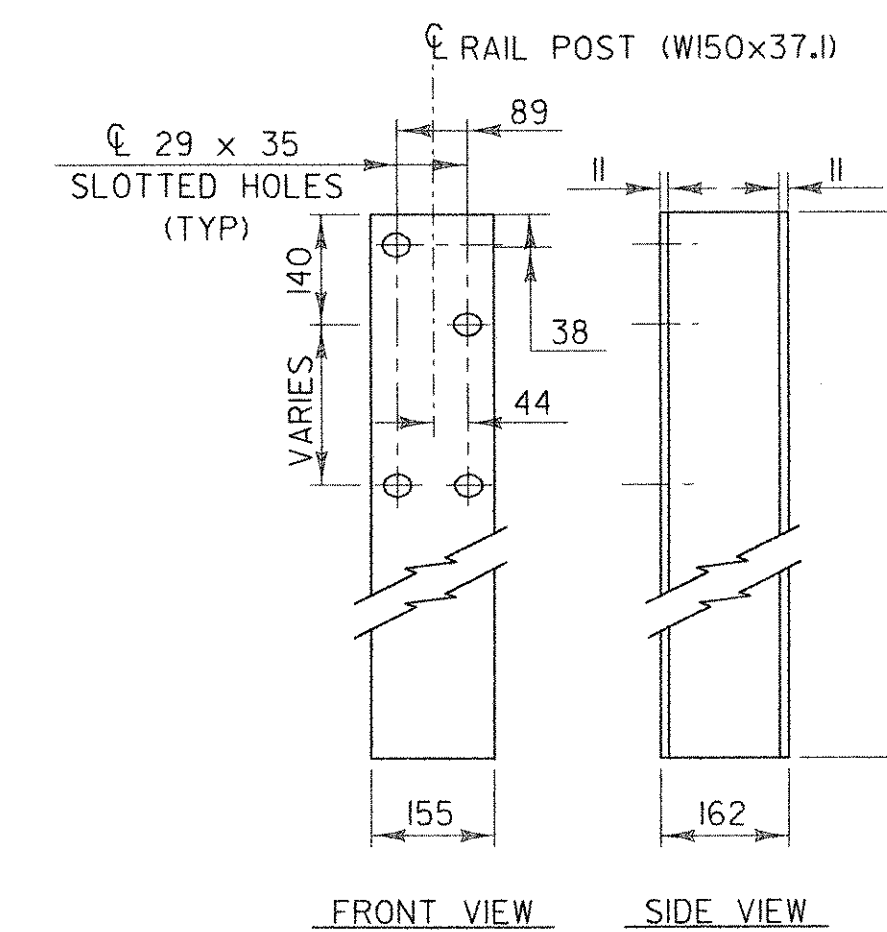

**RAIL POST**

ALL DIMENSIONS IN MILLIMETERS UNLESS OTHERWISE NOTED.

<b>APPROACH RAIL N.E.T.C. 2 RAIL DETAIL SHEET</b>	SURVEYED BY	C.H.A. & V.S.E.	DATE	12/93
	DESIGNED BY	D.W.E.	DATE	2/04
	DRAWN BY	C.A.K.	DATE	2/04
	CHECKED BY	D.E.G.	DATE	2/04
	DESIGN FILE NO.	MD02.DGN		
PROJ. NAME	BENNINGTON - HOOSICK D.P.I. 0146(II) C/6			
PROJ. NO.	P.I.N. 1306.60			
DWG NO.	MD-2	SHEET 53 OF 83		

FILE NAME = u:\5116\vaot\cont-act6\md02.dgn  
 DATE/TIME = 2/16/2004  
 USER = 2225

DATUM	
VERTICAL	NAVD 88
HORIZONTAL	NAD 83 (1992)

NOTE: UNLESS NOTED OTHERWISE, ALL STATIONS ARE IN KILOMETERS, ALL ELEVATIONS ARE IN METERS, AND ALL DIMENSIONS ARE IN MILLIMETERS.

**GENERAL NOTES:**

1. THE FOLLOWING NOTES SHALL APPLY UNLESS OTHERWISE NOTED ON THE PLANS.
2. ALL MATERIALS AND CONSTRUCTION SHALL CONFORM TO THE STATE OF VERMONT AGENCY OF TRANSPORTATION, STANDARD SPECIFICATIONS FOR HIGHWAY AND BRIDGE CONSTRUCTION - 2001 AND ITS LATEST REVISIONS, AND THE AASHTO STANDARD SPECIFICATIONS (17TH EDITION) FOR HIGHWAY BRIDGES, AND ITS LATEST REVISIONS.
3. ALL WELDING AND DIMENSIONAL TOLERANCES OF WELDED MEMBERS SHALL CONFORM TO THE LATEST ANSI/AASHTO/AWS WELDING CODE AND ITS LATEST REVISIONS.
4. MINIMUM COVER FOR REINFORCING STEEL IN SUBSTRUCTURE SHALL BE 50 mm ALONG BACK FACES OF WALLS AGAINST EARTH, AND 75 mm ELSEWHERE UNLESS NOTED OTHERWISE.
5. REINFORCEMENT PLACEMENT TOLERANCES SHALL BE:  
SPACING ±25 mm  
CLEARANCE ±5 mm
6. ALL EXPOSED EDGES OF CONCRETE SHALL BE CHAMFERED 25 mm BY 25 mm.
7. SURFACES OF BRIDGE SEATS UNDER BEARING DEVICES SHALL BE LEVEL. OTHER BRIDGE SEAT AREAS SHALL BE SLOPED 4%. THE ENTIRE BRIDGE SEAT SURFACE SHALL BE SMOOTH WITH FLOAT FINISH AS PER SUBSECTION 50J6.
8. ALL DIMENSIONS ARE HORIZONTAL OR VERTICAL, AND ARE GIVEN AT 20 DEGREES CELSIUS UNLESS OTHERWISE NOTED.
9. THE EXTENT OF SUPERSTRUCTURE AND SUBSTRUCTURE CONCRETE REPAIR, AND THE APPROPRIATE CONCRETE REPAIR ITEMS SHALL BE AS DETERMINED BY THE RESIDENT ENGINEER AT THE TIME OF CONSTRUCTION. REPAIRS SHALL BE PERFORMED IN ACCORDANCE WITH THE DETAILS SHOWN ON THE PLANS.
10. IF A COLD PLANNER IS USED TO STRIP PAVEMENT FROM THE APPROACH SLABS, CONCRETE PAVEMENT OR DECK, THE FINAL 12 mm SHALL BE REMOVED BY LOADER, GRADER OR EQUIPMENT APPROVED BY THE RESIDENT ENGINEER. THIS WORK SHALL ALL BE INCLUDED IN THE UNIT PRICE BID FOR "REMOVAL OF BRIDGE PAVEMENT". THE ENTIRE AREA OF APPROACH SLABS, CONCRETE PAVEMENT AND DECK SHALL BE STRIPPED TO BARE CONCRETE.
11. ALL DIMENSIONS OF EXISTING MATERIAL SHALL BE CONFIRMED BY THE CONTRACTOR PRIOR TO START OF WORK.
12. WATER REPELLENT SHALL BE APPLIED TO ALL EXPOSED NEW CONCRETE SURFACES.
13. SHOP DRAWINGS ARE TO BE SENT TO DALE GOZALKOWSKI AT CLOUGH, HARBOUR & ASSOCIATES, LLP AND TO JEFF CLARK OF THE STATE OF VERMONT AGENCY OF TRANSPORTATION FOR REVIEW.
14. THIS WORK WILL BE PERFORMED ABOVE A RAILROAD AND TWO ROADS, THE CONTRACTOR SHALL EXERCISE CARE TO AVOID DROPPING ANY MATERIALS ON THESE UNDER FEATURES.
15. EXISTING DECK WEEPS EXPOSED BY REMOVAL OF THE BRIDGE PAVEMENT SHALL HAVE ANY REMAINING ASPHALT CLEARED FROM THEIR OPENINGS. CARE SHALL BE TAKEN NOT TO COVER THE WEEPS WITH SHEET MEMBRANE WATERPROOFING AND THEIR ENDS SHALL BE FILLED WITH STEEL WOOL.

**MEMBRANE INFORMATION:**

1. BEFORE APPLYING THE SHEET MEMBRANE WATERPROOFING, THE EXISTING DECK SURFACE SHALL BE MADE SMOOTH TO THE SATISFACTION OF THE RESIDENT ENGINEER, USING ONE OR BOTH OF THE FOLLOWING METHODS:  
  
FILL IN ALL POCK MARKS, GOUGES OR OTHER DEPRESSIONS WITH "RAPID SETTING CONCRETE REPAIR MATERIAL", ITEM 580J7, CONTACT VERMONT AGENCY OF TRANSPORTATION MATERIALS SECTION TO OBTAIN A LIST OF ACCEPTABLE MATERIALS FOR "RAPID SETTING CONCRETE REPAIR MATERIAL". ANY RAPID SET CONCRETE USED SHALL BE INSTALLED BY THE METHOD AND TO THE LIMITS AS GIVEN BY THE MANUFACTURER AND AS DIRECTED BY THE RESIDENT ENGINEER.  
  
GRIND SMOOTH ALL ROUGH AREAS, RIDGES, OR OTHER HIGH SPOTS UNDER THE ITEM 580J6, "SURFACE PREPARATION FOR MEMBRANE".
2. THE MEMBRANE IS TO BE INSTALLED ACCORDING TO THE SPECIFICATIONS CALLED FOR UNDER ITEM 519.20, SHEET MEMBRANE WATERPROOFING (TORCH APPLIED) (MOD).

**NOTES CONCERNING PATCHING EXISTING CONCRETE DECKS:**

1. DECK AREAS TO BE REPAIRED SHALL BE MARKED ON THE STRIPPED DECK BY VERMONT AGENCY OF TRANSPORTATION PERSONNEL. THE METHODS USED FOR DEFINING AREAS NEEDING REPAIR MAY BE VISUAL INSPECTION, THE CHAIN DRAG METHOD, HAMMER SOUNDING, HALF-CELL POTENTIAL, ETC. THE RESIDENT ENGINEER MAY ORDER ANY OR ALL OF THESE TESTING METHODS. THE CONTRACTOR SHALL EMPLOY QUALIFIED PERSONNEL TO PERFORM THE TESTS. PAYMENT FOR TESTING SHALL BE SUBSIDIARY TO THE "REPAIR OF CONCRETE SUPERSTRUCTURE SURFACE" ITEMS. ALL NECESSARY CLEANING OF THE DECK SURFACE PRIOR TO MARKING OF THE DECK REPAIR AREAS WILL BE PERFORMED BY THE CONTRACTOR AS DIRECTED BY THE RESIDENT ENGINEER. THIS WILL ALSO INCLUDE ADDITIONAL CLEANINGS AT OTHER TIMES AS THE WORK PROGRESSES. PAYMENT FOR CLEANING WILL BE CONSIDERED SUBSIDIARY TO ALL OTHER PAY ITEMS.
2. DECK SURFACE IS TO BE REPAIRED AS NECESSARY UNDER ITEMS 580J0, 580J1 OR 580J2, "REPAIR OF CONCRETE SUPERSTRUCTURE SURFACE, CLASS I, II OR III". ALL EDGES OF REPAIRED AREAS ARE TO BE SAW CUT SQUARE AND A MINIMUM OF 25 mm DEEP. "REPAIR OF CONCRETE SUPERSTRUCTURE SURFACE CLASS I" SHALL INCLUDE REMOVAL OF CONCRETE TO A MAXIMUM DEPTH AS DETERMINED BY THE TOP OF THE TOP BAR OF THE TOP MAT OF REINFORCING STEEL AND IS GENERALLY INTENDED FOR USE ONLY IN THOSE AREAS OF SURFACE SPALLING, APPROACH SLAB REPAIR, AND REPAIR UNDER CURB LINES AS LONG AS THE DEPTH LIMITS FOR CLASS I ARE NOT EXCEEDED.

**BEARING NOTES:**


1. BEARINGS SHALL CONFORM TO REQUIREMENTS OF SECTION 531. COMPONENTS SHALL CONFORM TO DESIGN, FABRICATION AND MATERIAL REQUIREMENTS OF THE APPLICABLE SUBSECTIONS OF SECTION 731-BEARING PADS FOR STRUCTURES.
2. BEARINGS SHALL BE PAID FOR UNDER ITEM 531J0 "BEARING DEVICE ASSEMBLY".
3. SHOP DRAWINGS CONFORMING TO SUBSECTION 531.03 SHALL INCLUDE WELDING AND BONDING PROCEDURES. SHOP DRAWINGS SHALL ALSO INDICATE WHETHER BEARING COMPONENTS ARE GALVANIZED OR METALIZED. IF METALIZED IS USED, THE SHOP DRAWINGS SHALL DENOTE THE TYPE OF SEAL COATING THAT WILL BE PLACED ON THE METALIZING. SEE GENERAL NOTE 13 ON THIS SHEET FOR SHOP DRAWING DISTRIBUTION LIST.
4. SOLE PLATES AND WASHERS ARE TO BE GALVANIZED OR METALIZED AS PER SUBSECTION 506J5 (a) OR (b) OF THE STANDARD SPECIFICATIONS.
5. THE WELD BETWEEN THE SOLE PLATE AND BOTTOM FLANGE SHALL BE SMAW 8018 (C3). AREAS OF GALVANIZING ON THE SOLE PLATE DESTROYED IN THE WELDING PROCESS SHALL BE PAINTED WITH AN APPROVED SEALER. REFER TO SUPPLEMENTAL SPECIFICATION 513.
6. THE CONCRETE SURFACE UNDER THE BEARING SHALL BE LEVEL.
7. ANCHOR BOLTS SHALL HAVE A 380 mm MINIMUM EMBEDMENT INTO CONCRETE. ANCHOR BOLTS, NUTS AND WASHERS SHALL CONFORM TO SECTION 714.08 OF THE STANDARD SPECIFICATIONS.
8. PLATES AND PLATE WASHERS SHALL CONFORM TO AASHTO M 270M GRADE 250.
9. ALL WORK REQUIRED TO REMOVE THE EXISTING BEARINGS SHALL BE SUBSIDIARY TO PARTIAL REMOVAL OF STRUCTURE, ITEM 529.20.
10. THE ELASTOMER MATERIAL USED IN THE BEARING SHALL HAVE A SHORE A HARDNESS OF 50 - DUROMETER, SHEAR MODULUS OF 0.62 MPa AND A LOW TEMPERATURE GRADE OF 3.
11. FINISHED BEARINGS SHALL CONFORM TO THE DESIGN DIMENSIONS, TOLERANCES AND DETAILS LISTED BELOW:

BEARING TOLERANCES	
DIMENSION	TOLERANCE
OVERALL VERTICAL	-0,3 mm
OVERALL HORIZONTAL	-0,6 mm
POSITION OF HOLES AND SLOTS CENTERLINE	± 1,6 mm FROM CENTERLINE
SIZE OF HOLES, SLOTS AND INTERNAL STEEL PLATES	-0,16 mm
EDGE COVER OVER EXTERNAL STEEL PLATES	3 mm MIN.
BEDDING SURFACE (TOP AND BOTTOM) OVER INTERNAL STEEL PLATES	6 mm MIN.


- A. NO EDGE COVER WILL BE REQUIRED OVER INTERNAL DETAILS THAT WILL NOT BE EXPOSED AFTER ERECTION. (I.E. - VERTICAL HOLES COVERED BY BEARING SEATS OR FLANGES).
- B. THE INTERNAL STEEL PLATES SHALL BE CHECKED FOR PARALLELISM BY MEASURING THE DISTANCE BETWEEN EACH INDIVIDUAL STEEL PLATE, AND BETWEEN THE TOP OR BOTTOM EDGE OF THE BEARING TO THE FIRST ADJACENT STEEL PLATE. THE MEASUREMENTS WILL BE TAKEN AT THE MIDPOINT OF EACH SIDE. THE SMALLEST OF THE FOUR MEASUREMENTS SHALL BE RECORDED FOR EACH PLATE. THE CUMULATIVE OF THESE MEASUREMENTS SHALL NOT BE LESS THAN 75% OF THE DESIGN EFFECTIVE RUBBER THICKNESS.
- C. THE AVERAGE THICKNESS OF THE INDIVIDUAL LAYERS OF THE ELASTOMER SHALL NOT VARY MORE THAN ± 20% OF THE DESIGN THICKNESS AND IN NO CASE EXCEED THE DESIGN THICKNESS BY 3 mm. AVERAGE THICKNESS WILL BE CALCULATED FROM MEASUREMENTS TAKEN AT THE MIDPOINT OF EACH SIDE.

**STATE OF VERMONT  
AGENCY OF TRANSPORTATION**


Town of	BENNINGTON	Bridge No.	BRI100 & BRI200
Highway No.	VT. RTE. 279	Log Sta.	
		Surv. Sta.	17+331
VT. RTE. 279			
GENERAL NOTES AND DETAILS			
Designed By	D. STECIAK	Drawn by	K. RAPELLO
Checked By	Date	Bridge Design Supervisor	Date
M.W. OLSTAD	02/04	M.W. OLSTAD	02/04
PROJECT	BENNINGTON-HOOSICK	PROJECT NO.	D.P.I. 0146(1) C/6
I.G.C. Info.			
Bridge Sheet No.	BRI	Sheet	57 OF 83

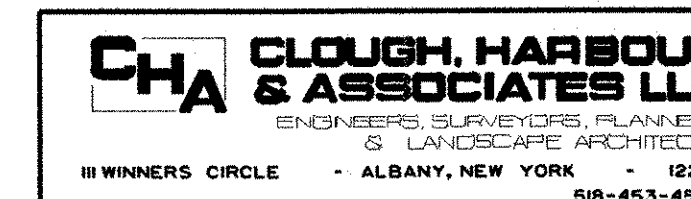

NOTE: UNLESS NOTED OTHERWISE, ALL STATIONS ARE IN KILOMETERS, ALL ELEVATIONS ARE IN METERS, AND ALL DIMENSIONS ARE IN MILLIMETERS.

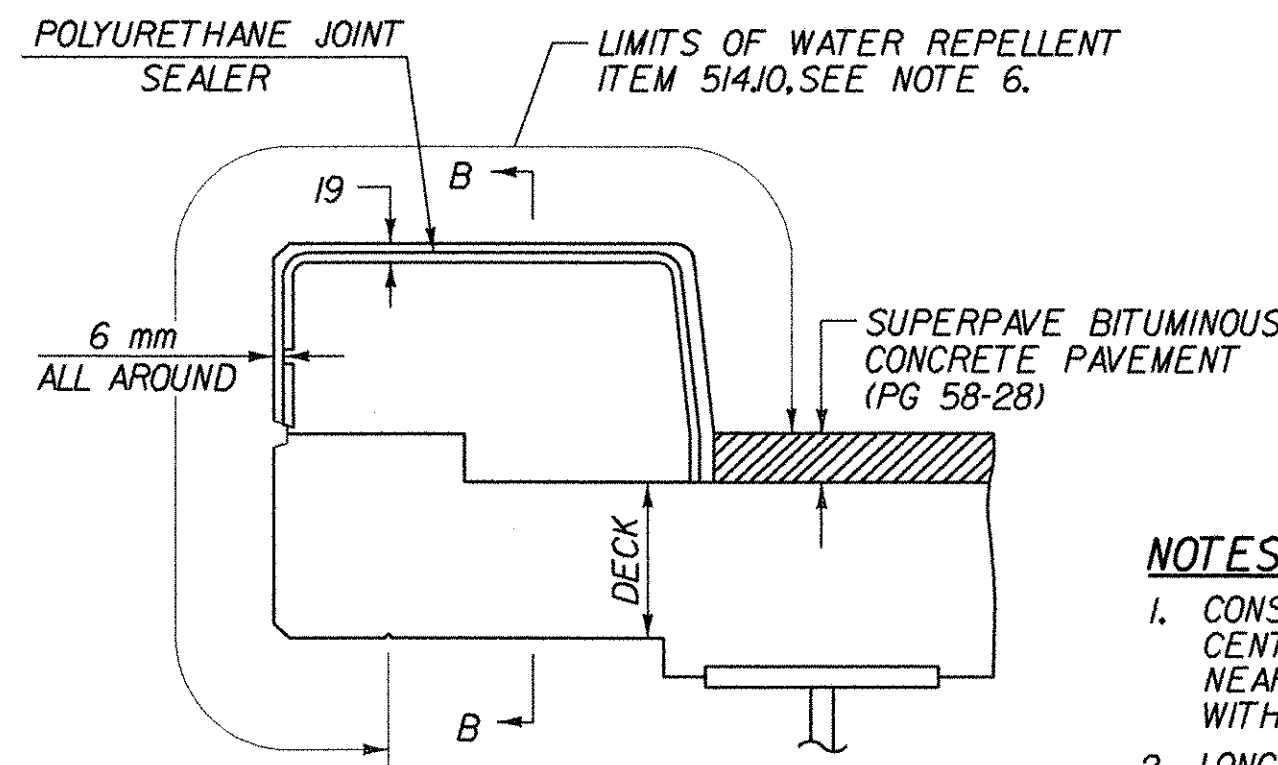


**TYPICAL SECTION THROUGH CONCRETE CURB CONSTRUCTION JOINT**  
N.T.S.

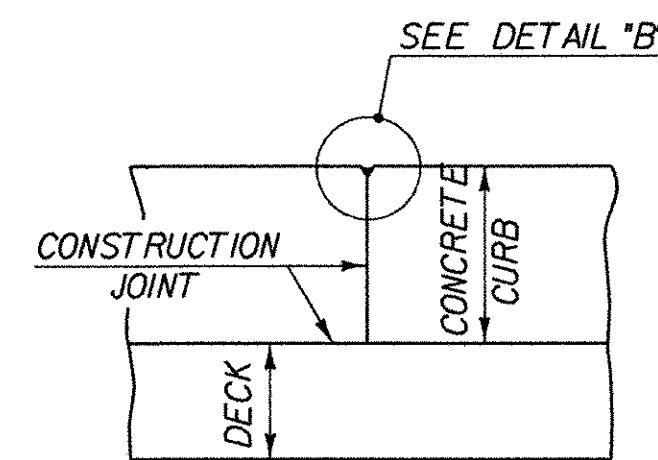

**SECTION B - B**  
N.T.S.


POLYURETHANE JOINT SEALER PER SUBSECTION 524.06C. COLOR TO MATCH CONCRETE. COST TO BE INCLUDED IN THE UNIT PRICE BID FOR CONCRETE.

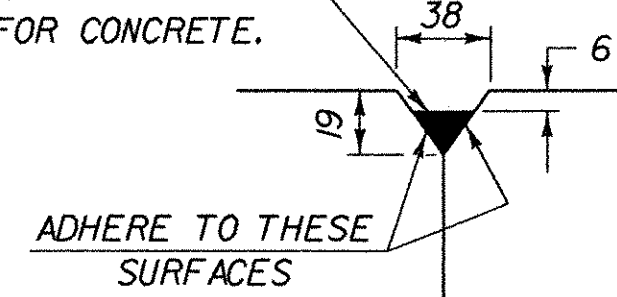


**DETAIL B**  
N.T.S.

**NOTES:**


- CONSTRUCTION JOINTS THROUGH CONCRETE CURBS SHALL BE SPACED MAXIMUM 4.5 m CENTER TO CENTER AND SHALL BE 560 mm MINIMUM FROM THE CENTER OF THE NEAREST BRIDGE RAIL POST. CONCRETE SHALL BE PLACED IN ALTERNATING SECTIONS WITH A MINIMUM OF 48 HOURS DELAY BETWEEN ADJACENT POURS.
- LONGITUDINAL REINFORCING SHALL PASS THROUGH CONCRETE CURB CONSTRUCTION JOINTS.
- TWO COMPONENT POLYURETHANE MATERIAL SHALL BE PLACED 100 mm WIDE ALONG DECK, 75 mm UP FACE OF CURB AND ALONG CONCRETE SHOULDER AT EXPANSION JOINT. SEE SPEC. 519.05 (b). POLYURETHANE MATERIAL AND BLAST CLEANING SHALL BE INCLUDED IN UNIT BID FOR SHEET MEMBRANE WATERPROOFING (TORCH APPLIED) (MOD.).
- BLAST CLEAN 1000 mm FROM FACE OF CURB AND 95 mm UP CURB FACE PRIOR TO PLACING MEMBRANE.
- A 15 mm RADIUS MAY BE USED IN LIEU OF THE 25 mm BY 25 mm CHAMFER ON THE TOP INSIDE CORNER OF CURBS.
- THE LIMITS OF WATER REPELLENT SHALL EXTEND FROM THE TOP OF PAVEMENT TO THE GROUND LINE ON THE WINGWALL AND CONCRETE PAVEMENT CURB SECTIONS.

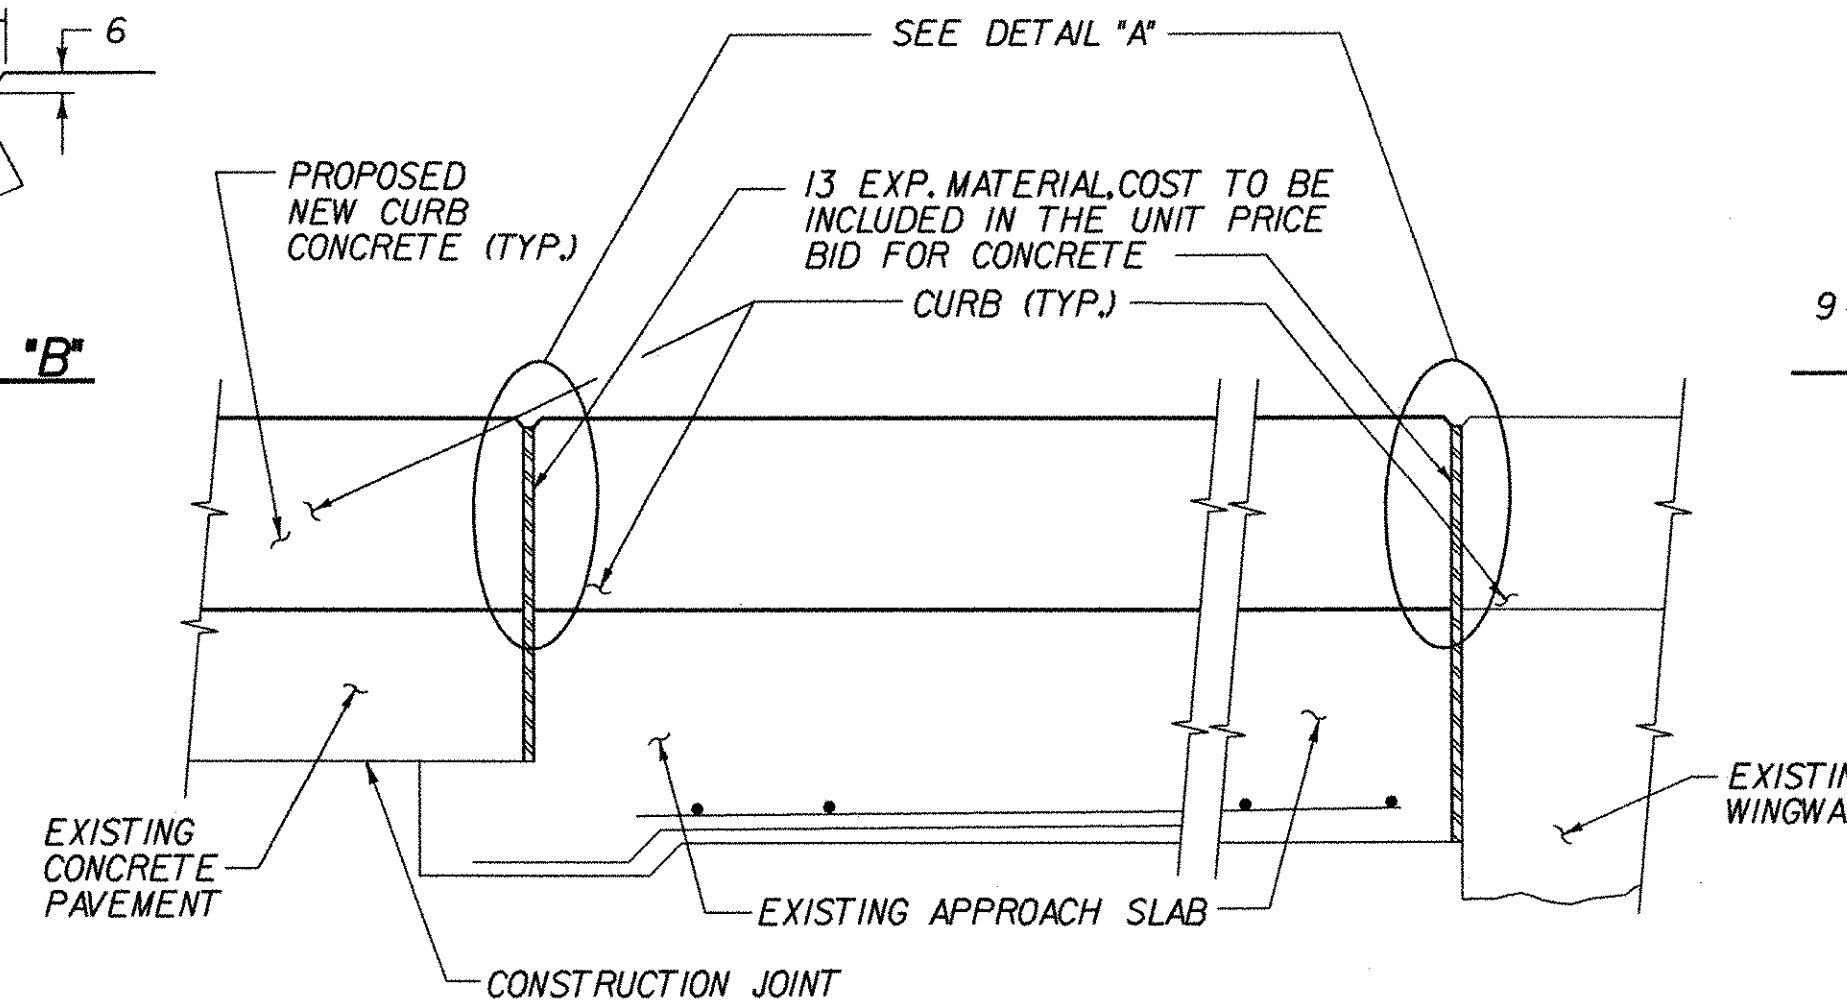


**SECTION THROUGH FASCIA**  
N.T.S.

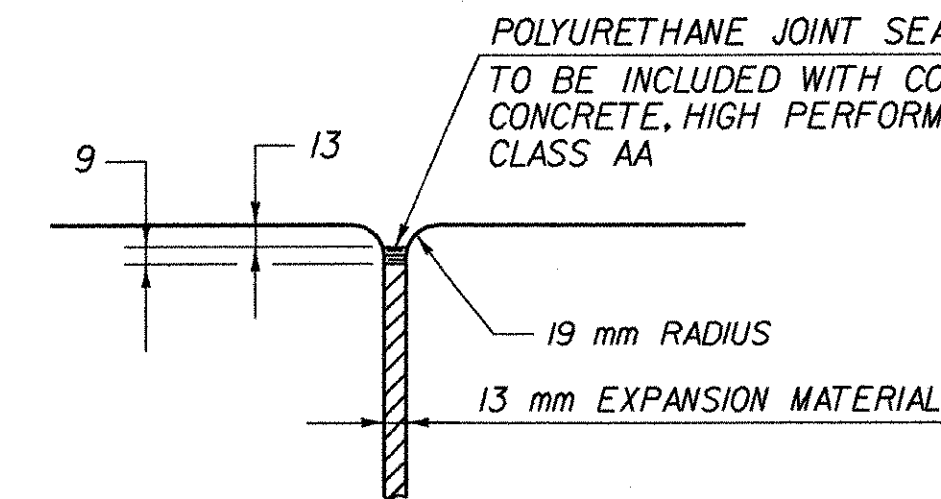


**DETAIL A**  
N.T.S.

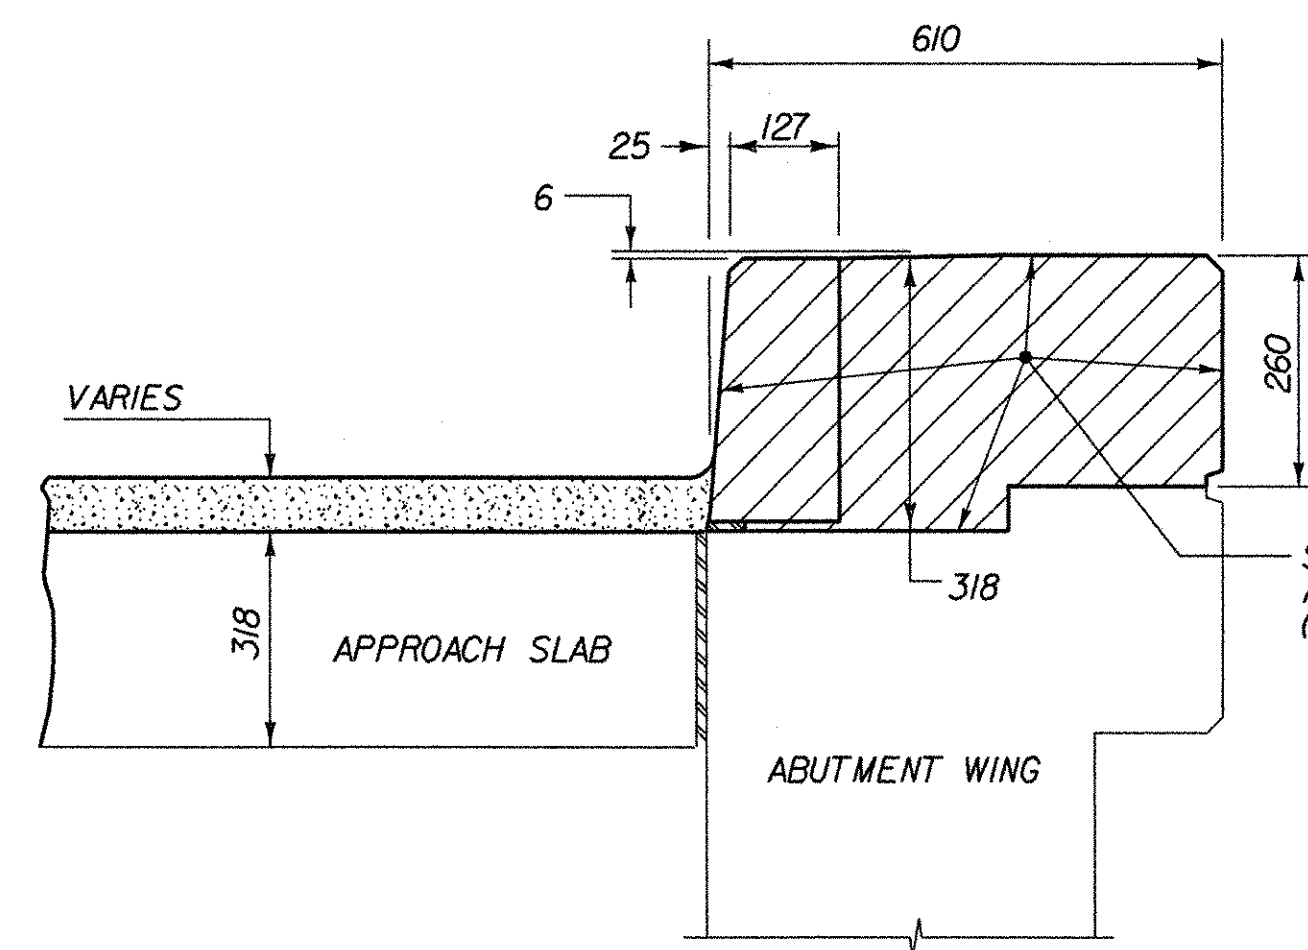


**EXISTING WINGWALL FASCIA**  
N.T.S.

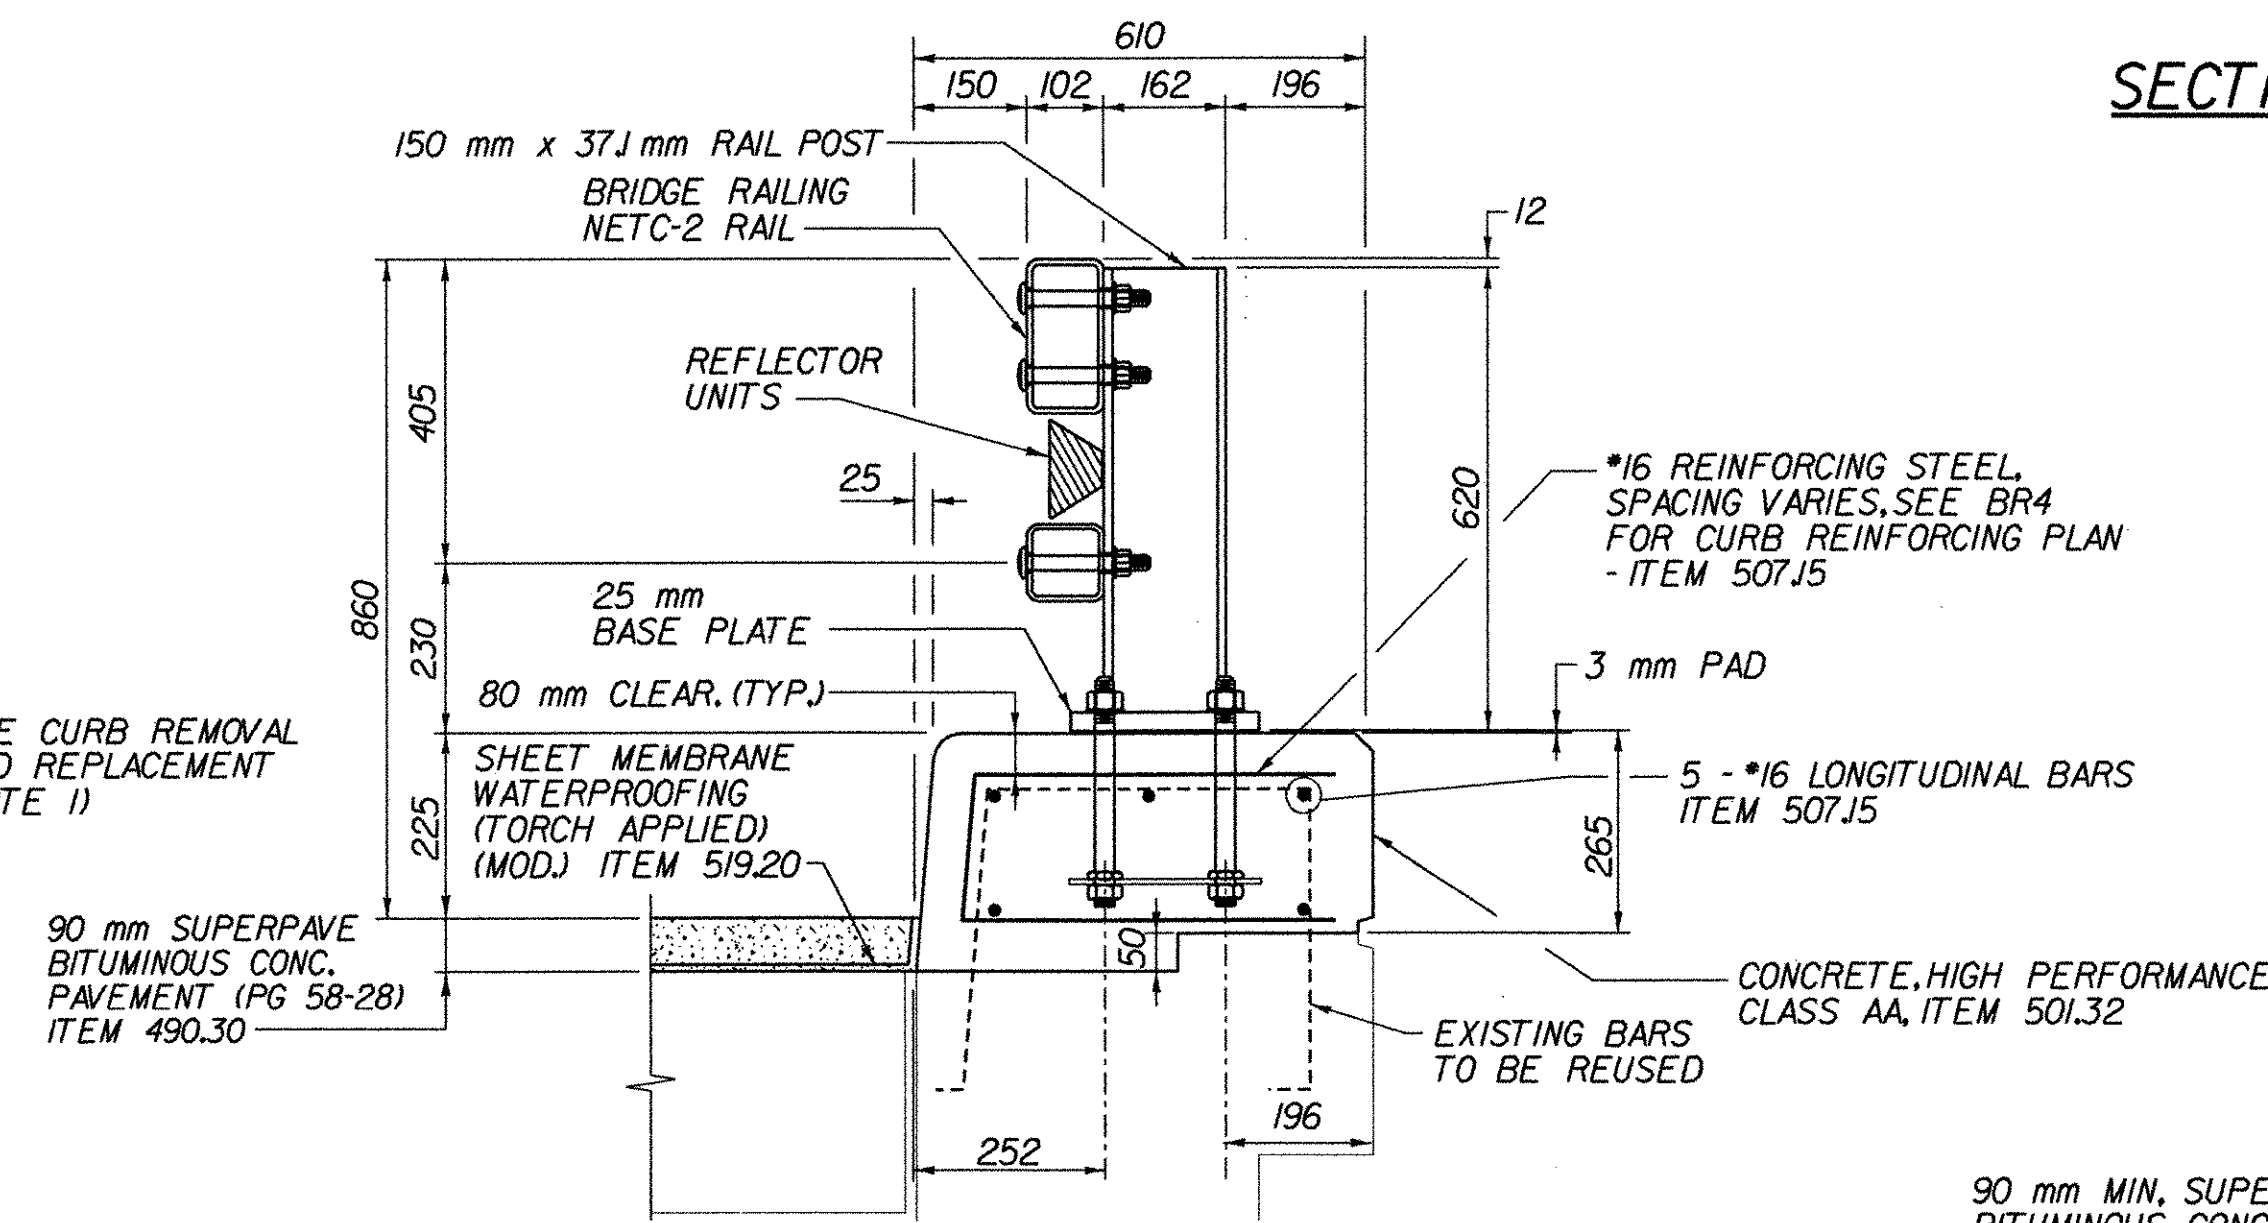



**PROPOSED BRIDGE AND WINGWALL FASCIA SECTION**

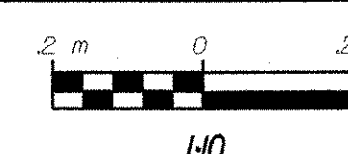


90 mm MIN. SUPERPAVE BITUMINOUS CONCRETE (PG 58-28), SET THICKNESS IN FIELD TO CORRECT FOR SETTLEMENT OF EXISTING PAVEMENT ITEM 490.30

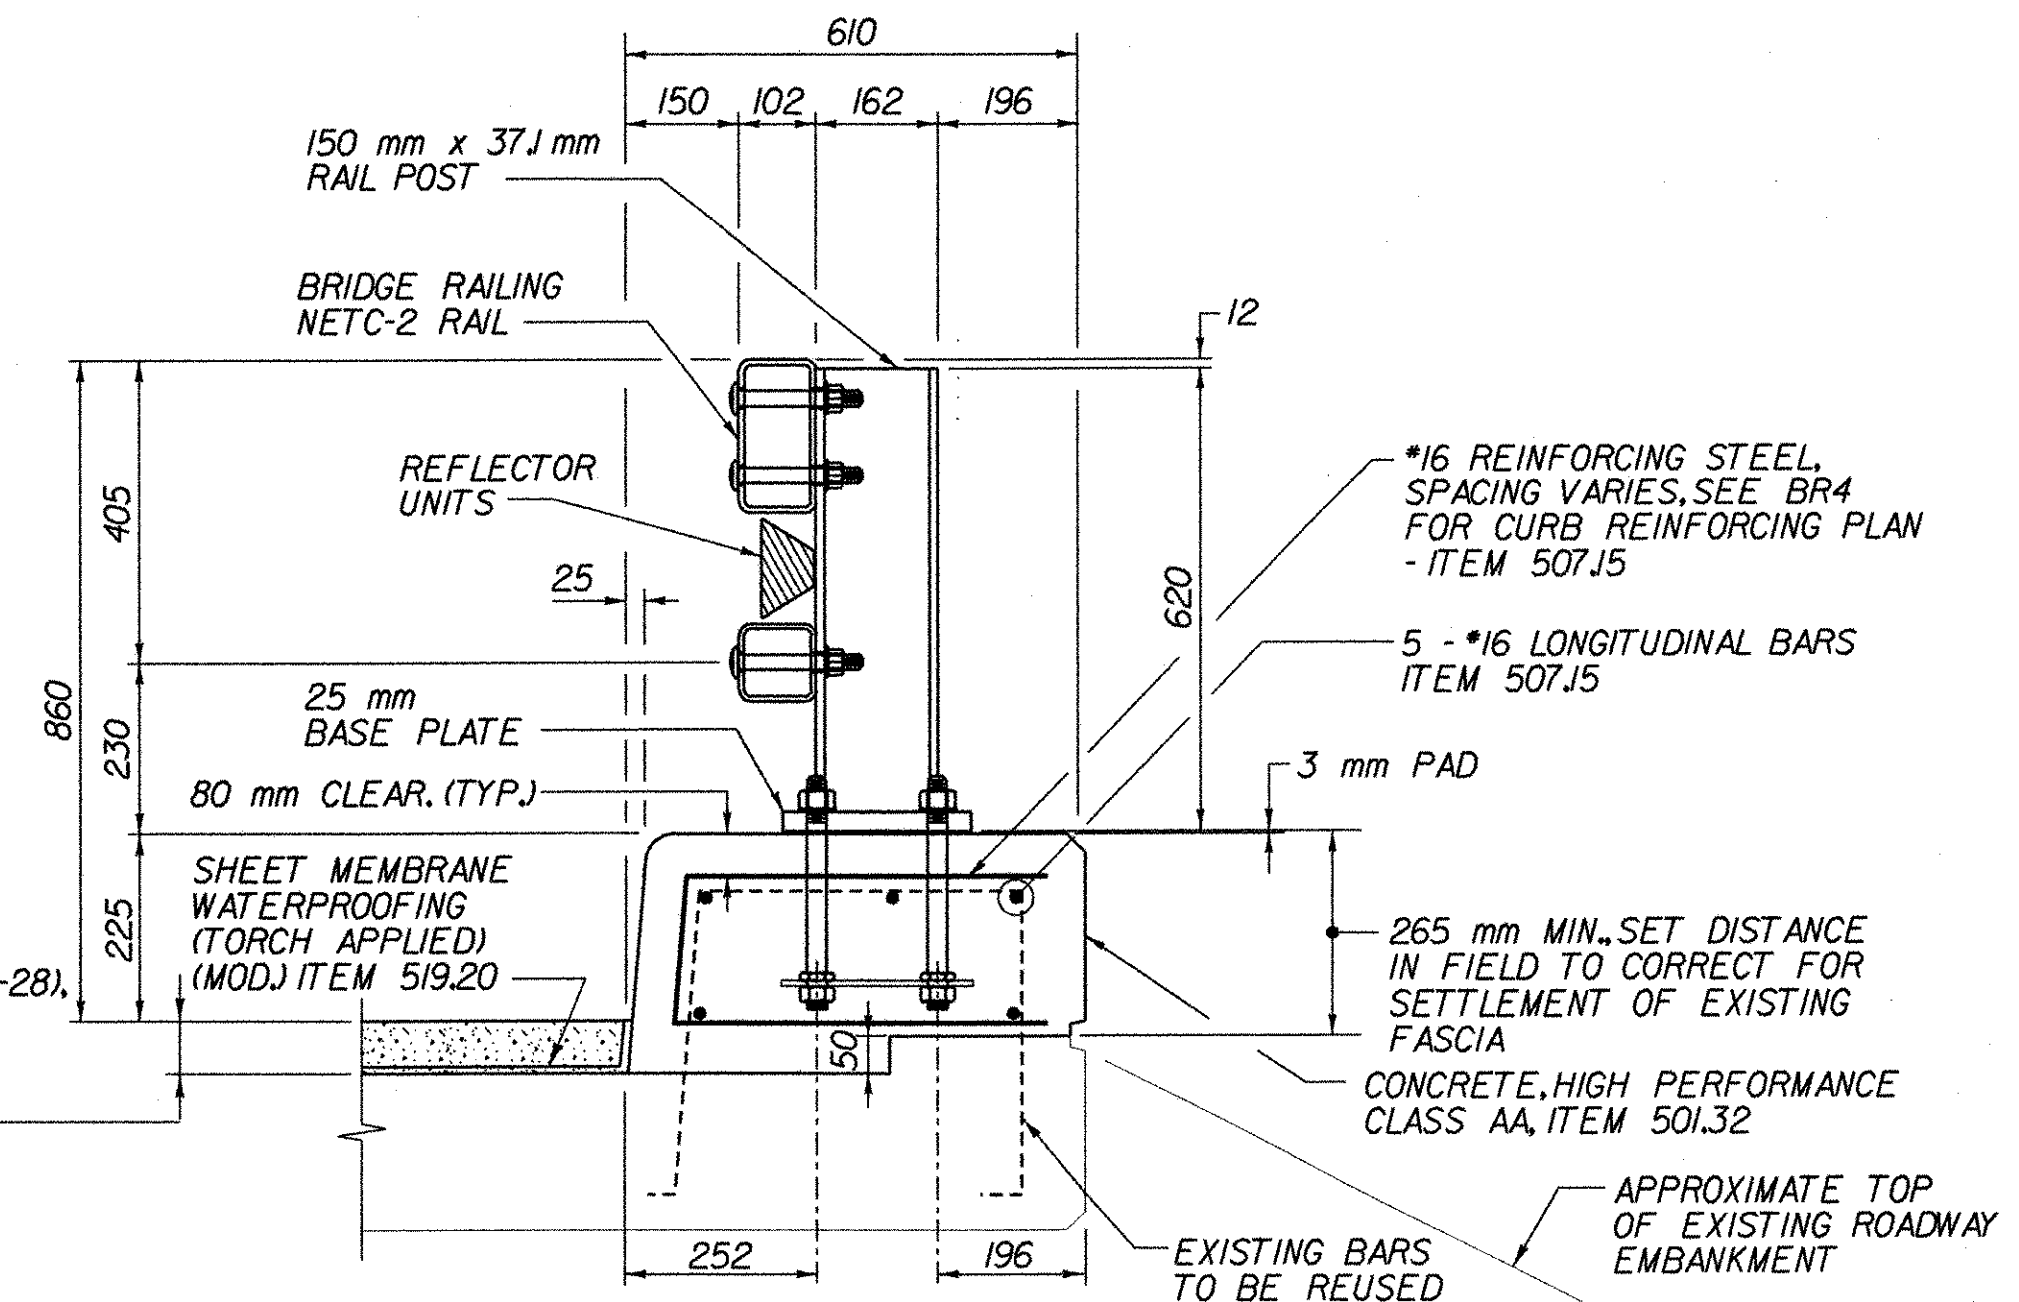

**PROPOSED CONCRETE PAVEMENT FASCIA SECTION**

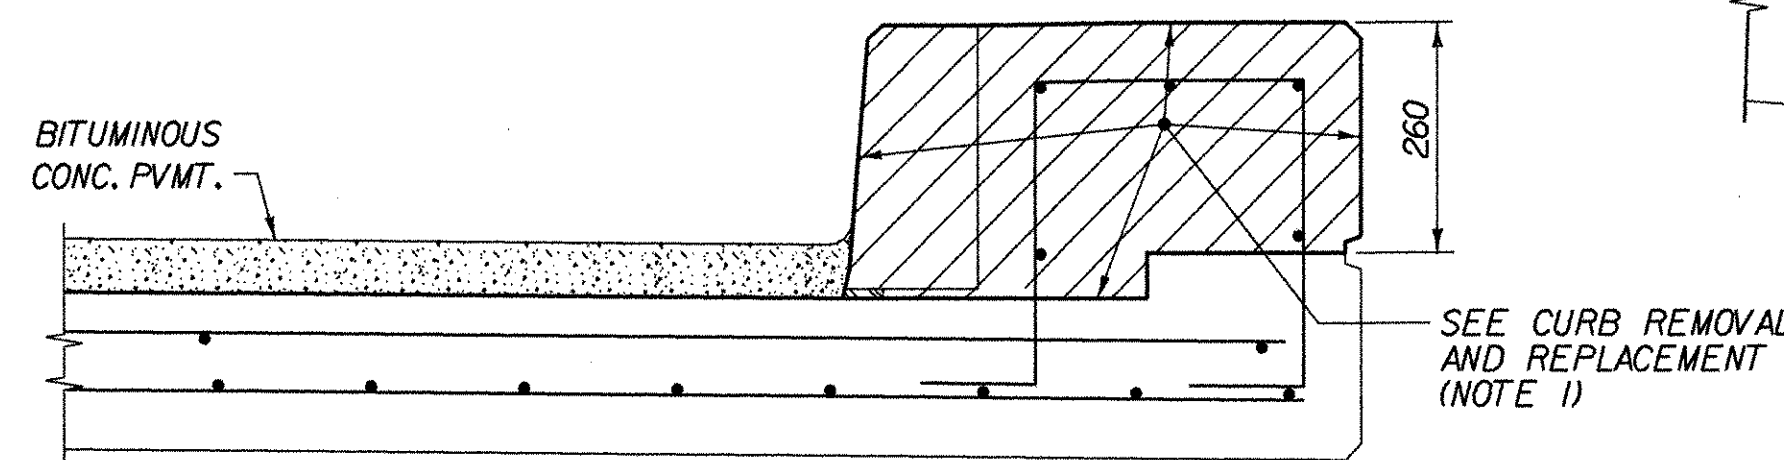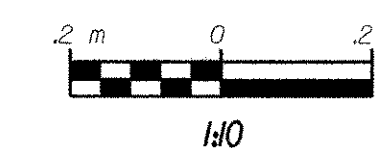


**EXISTING CONCRETE PAVEMENT FASCIA**  
N.T.S.

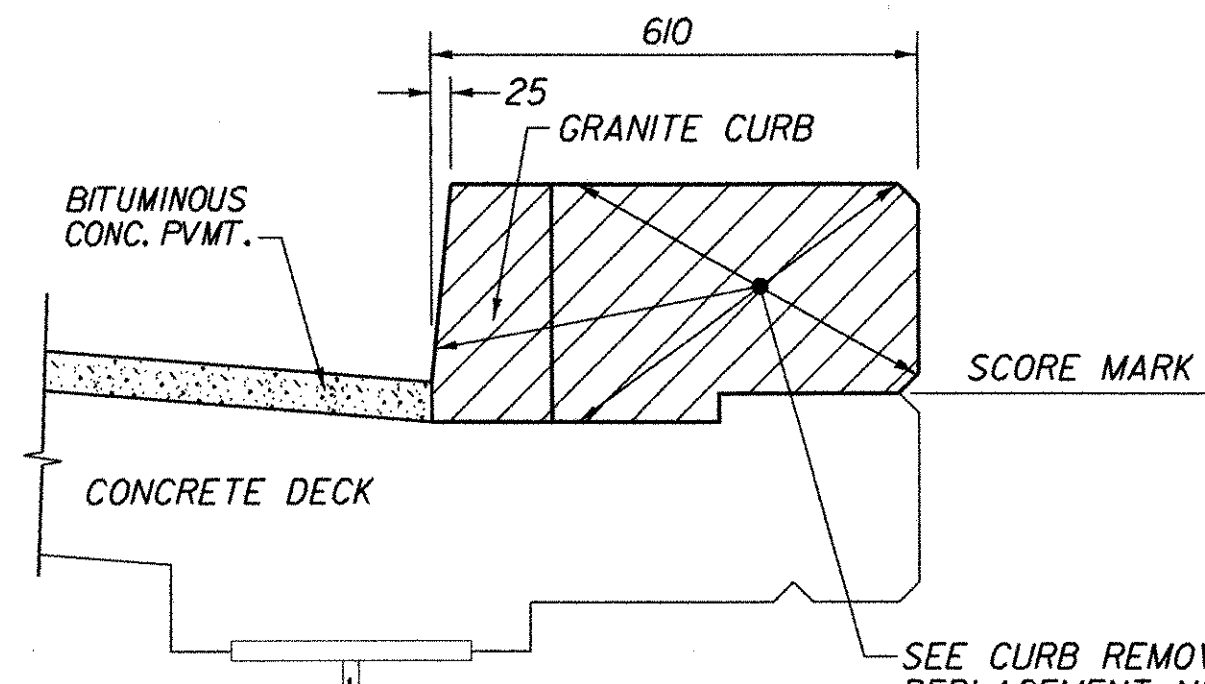

**CURB DETAIL**

**CURB REMOVAL DETAIL**  
N.T.S.

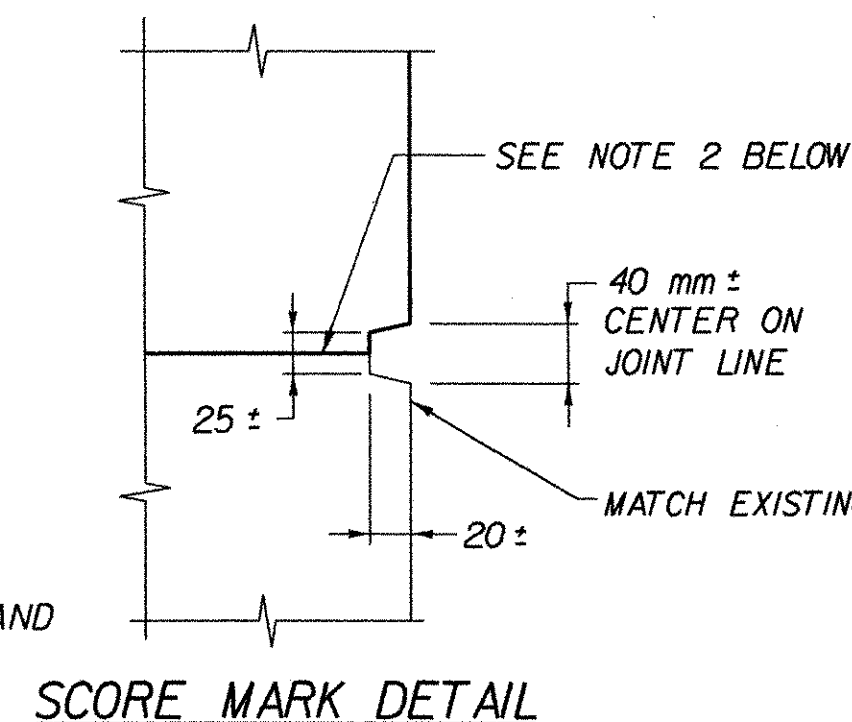

**SCORE MARK DETAIL**


**CURB REMOVAL AND REPLACEMENT NOTES:**

- THE SHADED AREA IN THE CURB DETAIL SHALL BE REMOVED AS REMOVAL OF CONCRETE OR MASONRY (ITEM 529.25).
- THE CONTRACTOR BEFORE REMOVING OLD CONCRETE DOWN TO SCORE MARK, SHOULD SAW CUT 25 mm DEEP IN THE CENTER OF SCORE MARK, CARE SHALL BE EXERCISED IN THE REMOVAL OF CONCRETE SO AS NOT TO DAMAGE THE EXISTING VERTICAL REINFORCING STEEL THAT IS TO REMAIN IN PLACE.
- HORIZONTAL REINFORCING STEEL SHALL BE REPLACED.
- THE ANCHOR BOLTS SHOULD BE CAST IN AS SHOWN ON SHT. BR4.
- NEW CONCRETE IN CURB SECTIONS SHALL BE CONCRETE, HIGH PERFORMANCE CLASS AA, ITEM 501.32.


**STATE OF VERMONT AGENCY OF TRANSPORTATION**

Town of	BENNINGTON	Bridge No.	BR200
Highway No.	VT. RTE. 279	Log Sta.	
		Surv. Sta.	17+853
VT. RTE. 279			
SECTIONS AND DETAILS			
Designed By	D. STECIAK	Drawn by	K. RAPELLO/B. WEATHERBY
Checked By	M. W. OLSTAD	Bridge Design Supervisor	M. W. OLSTAD
	Date 02/04	Date	02/04
PROJECT	BENNINGTON-HOOSICK	PROJECT NO.	D.P.I. 0146(I) C/6
I.G.C. Info.			
Bridge Sheet No.	BR2	Sheet	58 OF 83

NOTE: UNLESS NOTED OTHERWISE, ALL STATIONS ARE IN KILOMETERS, ALL ELEVATIONS ARE IN METERS, AND ALL DIMENSIONS ARE IN MILLIMETERS.

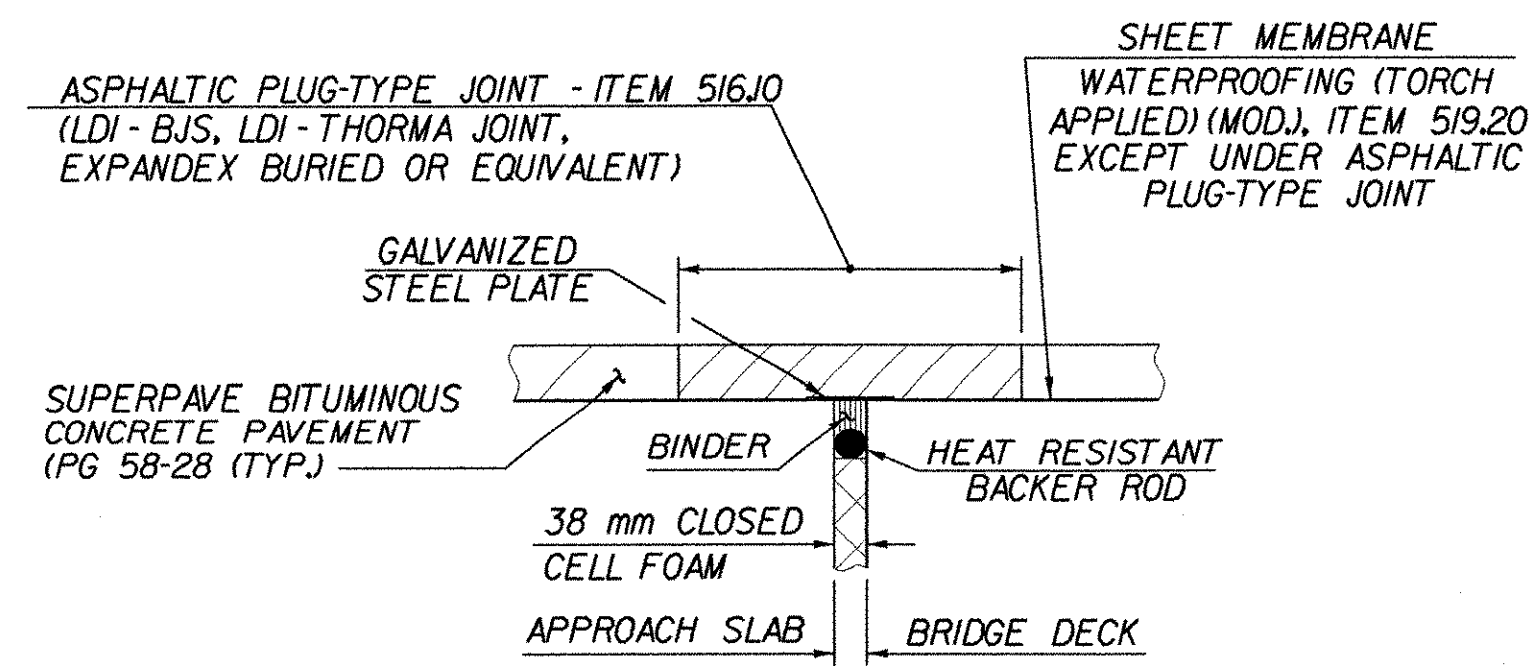


**ASPHALTIC PLUG-TYPE JOINT DETAIL**  
N.T.S.

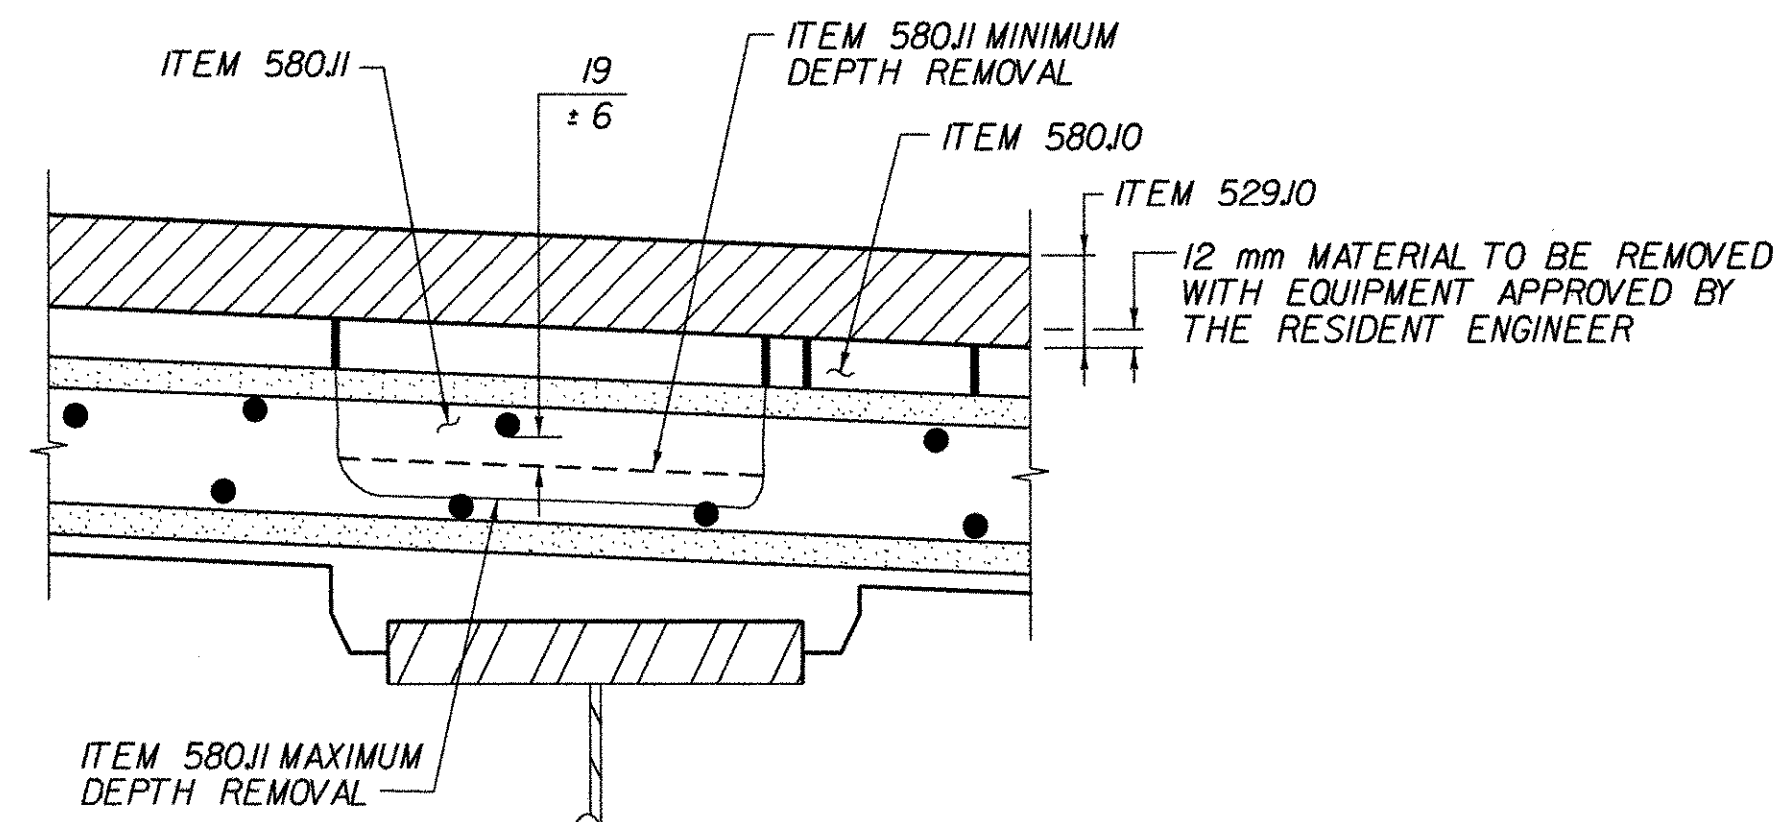


**TYPICAL LIMITS FOR REMOVAL ITEMS**  
N.T.S.

**DECK SLAB CONCRETE REMOVAL & REPAIR NOTES:**

1. ALL EDGES OF REPAIR AREAS ARE TO BE SAW CUT SQUARE AND A MINIMUM OF 25 mm DEEP.
2. ITEM 580J0 "REPAIR OF CONCRETE SUPERSTRUCTURE SURFACE CLASS I" SHALL INCLUDE REMOVAL OF CONCRETE TO A MAXIMUM DEPTH AS DETERMINED BY THE TOP OF THE TOP BARS OF THE TOP MAT OF REINFORCING STEEL.
3. ITEM 580J1 "REPAIR OF CONCRETE SUPERSTRUCTURE CLASS II" SHALL INCLUDE REMOVAL OF CONCRETE TO A MAXIMUM DEPTH AS DETERMINED BY THE TOP OF THE TOP BARS OF THE BOTTOM MAT OF REINFORCING STEEL.
4. REMOVAL OF EXISTING CONCRETE TO A DEPTH GREATER THAN SPECIFIED FOR ITEM 580J1 SHALL BE PAID FOR UNDER ITEM 580J2 "REPAIR OF CONCRETE SUPERSTRUCTURE SURFACE CLASS III"
5. SEE ADDITIONAL NOTES ON BRI.

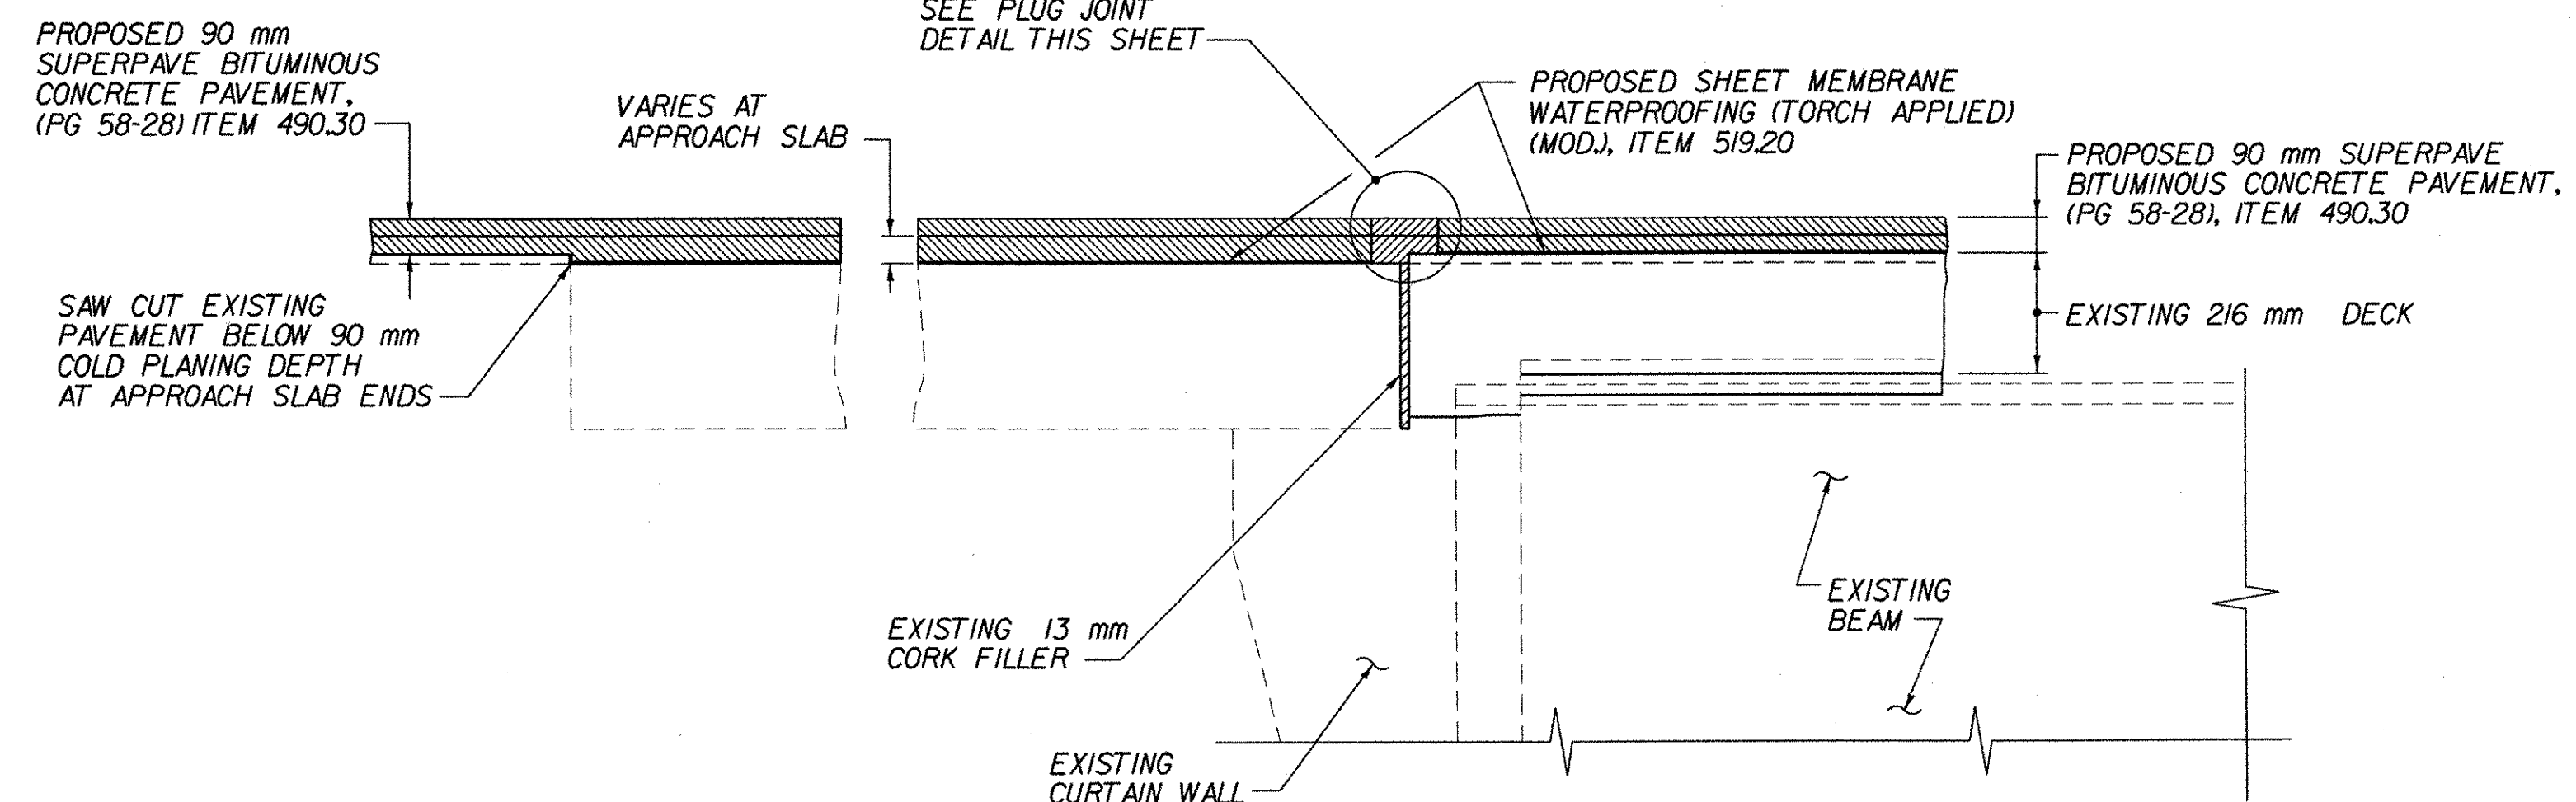


**FIXED END OF BRIDGE BR100 & BR200 AT ABUTMENTS  
BOTH ENDS OF BRIDGE BR800 AT ABUTMENTS**  
N.T.S.

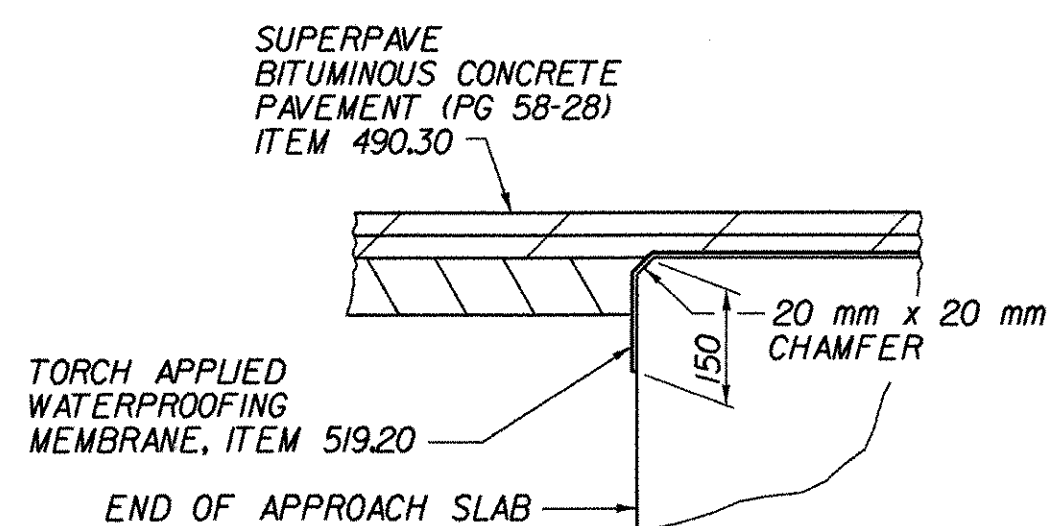


**DETAIL FOR JOINT IN PAVEMENT AND SHEET MEMBRANE AT END OF APPROACH SLAB**  
N.T.S.

<b>STATE OF VERMONT AGENCY OF TRANSPORTATION</b>			
Town of	BENNINGTON	Bridge No.	BR100
Highway No.	VT. RTE. 279	Log Sta.	
		Surv. Sta.	17+780
VT. RTE. 279			
<b>PAVEMENT AND CURB DETAILS</b>			
Designed By	D. STECIAK	Drawn by	K. RAPELLO
Checked By	M.W. OLSTAD	Date	02/04
		Bridge Design Supervisor	M.W. OLSTAD
		Date	02/04
PROJECT	BENNINGTON-HOOSICK		PROJECT NO. D.P.I. 0146(1) C/6
I.G.C. Info.			
Bridge Sheet No.	BR3	Sheet	59 OF 83


NOTE: UNLESS NOTED OTHERWISE, ALL STATIONS ARE IN KILOMETERS, ALL ELEVATIONS ARE IN METERS, AND ALL DIMENSIONS ARE IN MILLIMETERS.

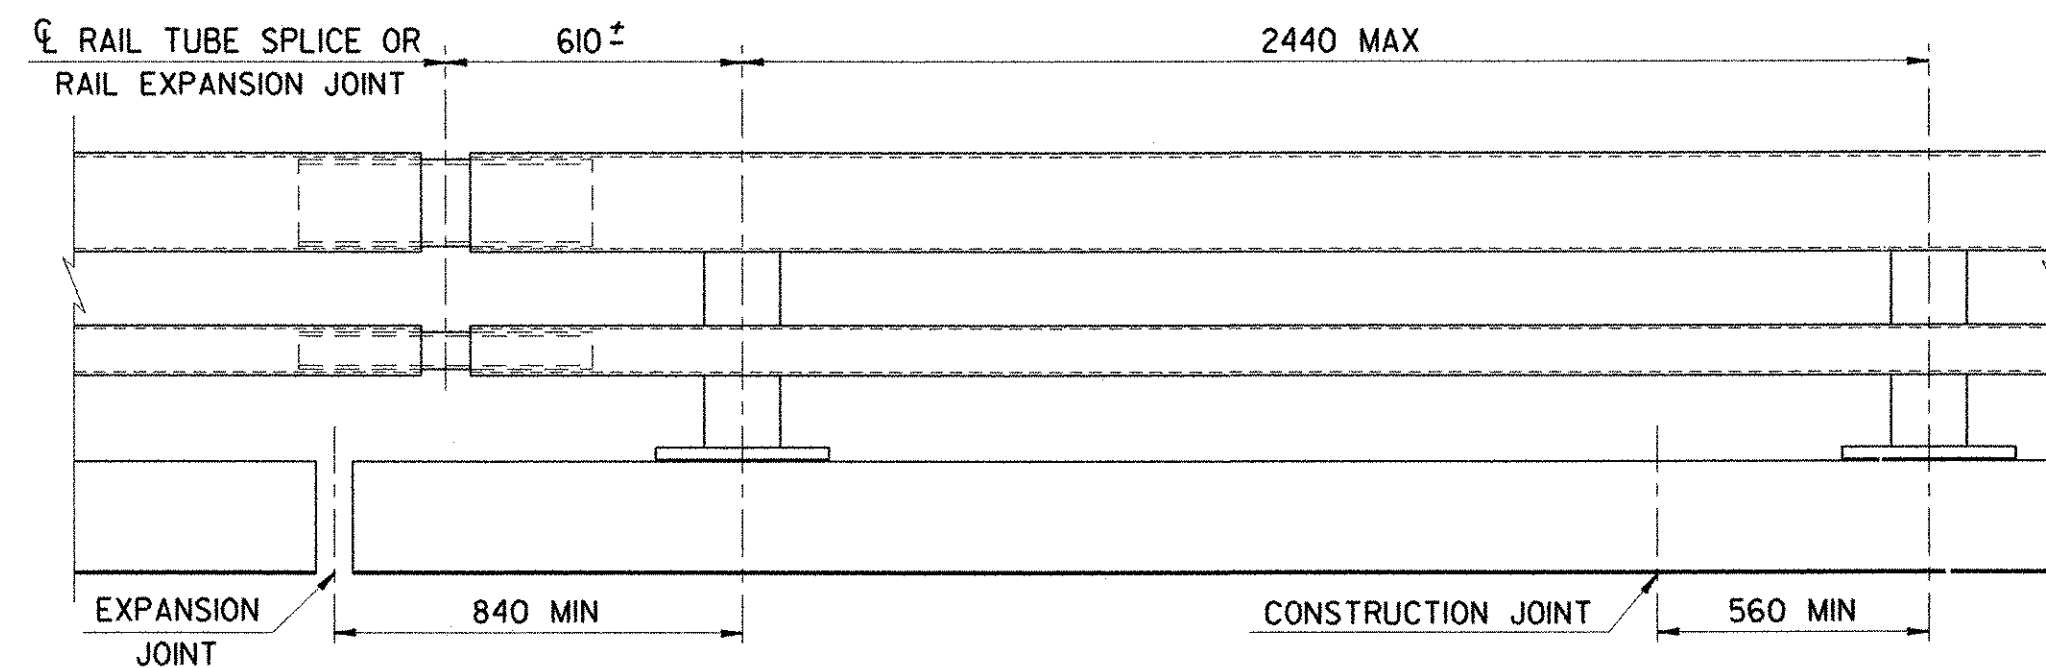


BRIDGE RAILING ELEVATION

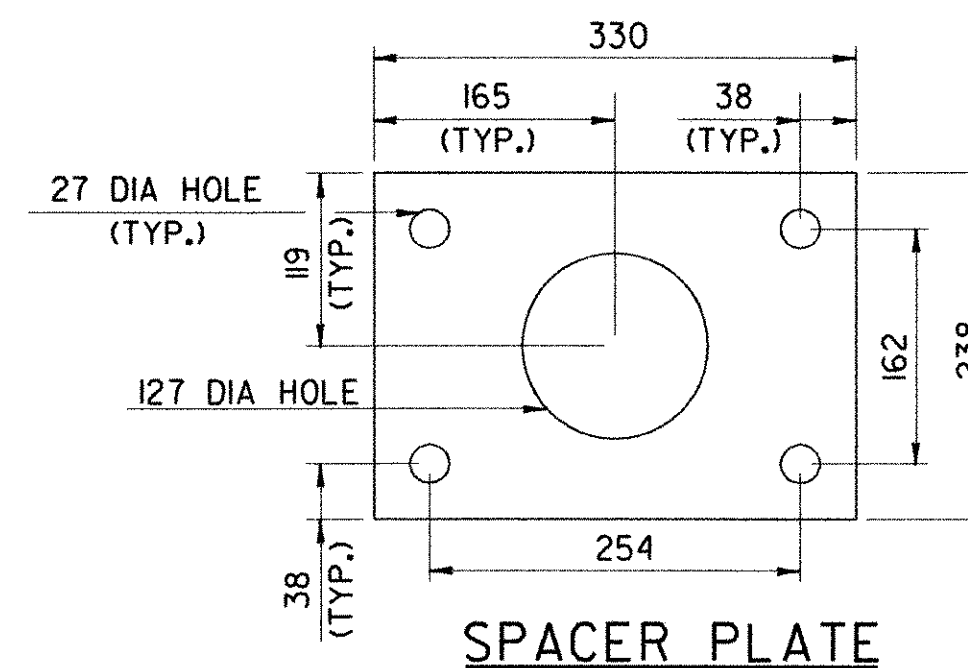

SPACER PLATE

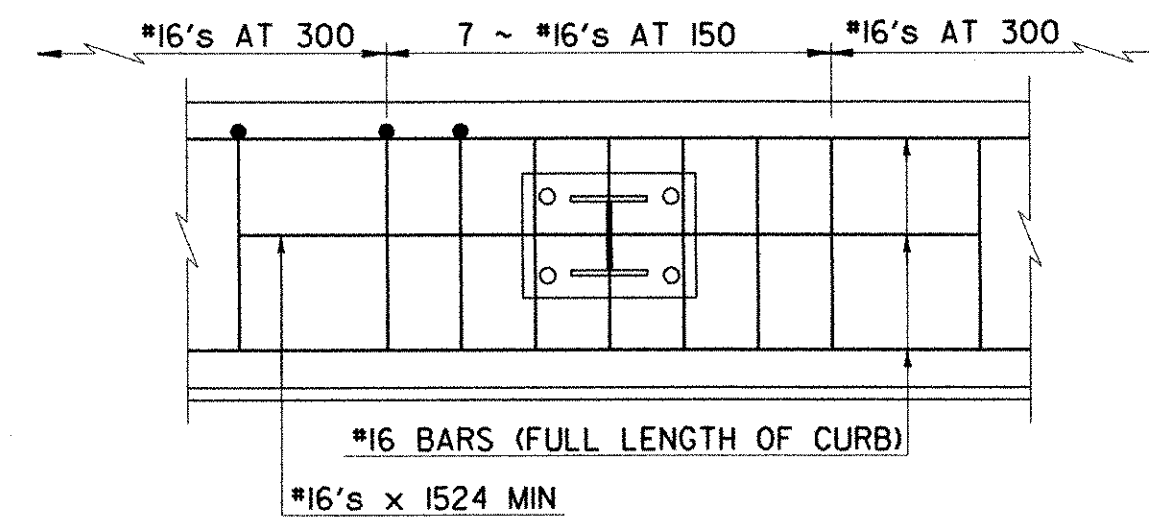

CURB REINFORCING PLAN

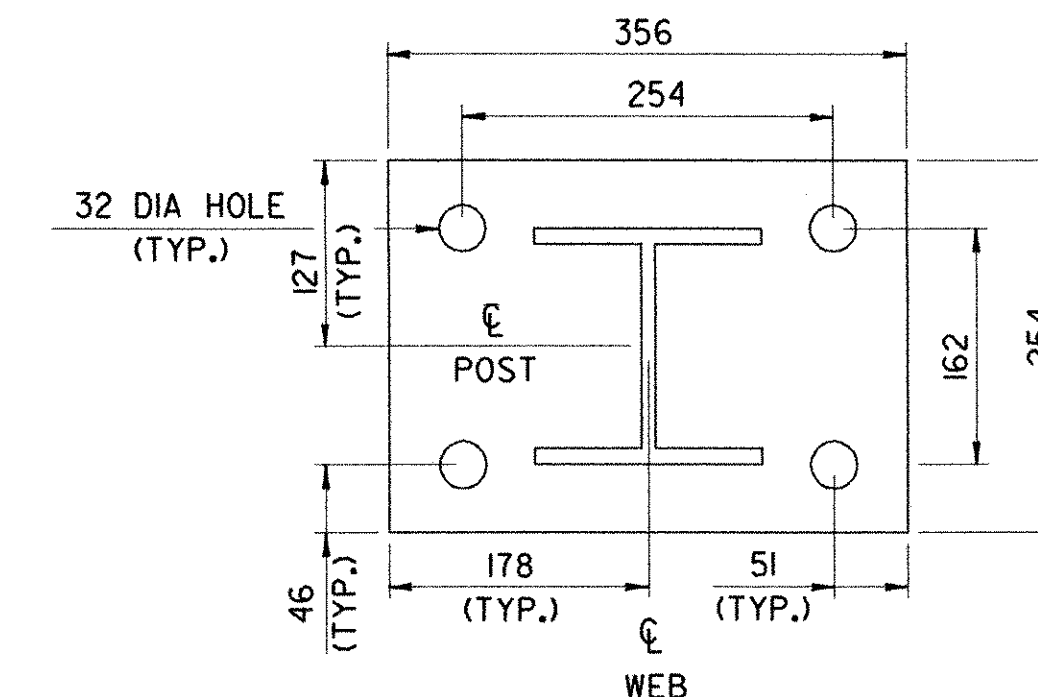

POST AND BASE PLATE

NOTES

1. ALL WORK AND MATERIALS SHALL CONFORM TO THE PROVISIONS OF SECTION 525, "RAILINGS" OF THE STANDARD SPECIFICATION FOR CONSTRUCTION.
2. TUBING AND POSTS SHALL MEET THE REQUIREMENTS OF SECTION 732, "RAILING" MATERIALS OF THE STANDARD SPECIFICATIONS FOR CONSTRUCTION, EXCEPT THAT THE DROP-WEIGHT TEAR TEST IN SECTION 732 SHALL NOT APPLY TO THE STRUCTURAL TUBING IN THIS STANDARD.
3. ALL EXPOSED CUT OR SHEARED EDGES SHALL BE ROUNDED TO A 2 mm RADIUS AND BE FREE OF BURRS.
4. RAIL POSTS SHALL BE SET NORMAL TO GRADE.
5. SECTIONS OF RAIL TUBE SHALL BE ATTACHED TO A MINIMUM OF TWO (2) RAIL POSTS AND PREFERABLY TO AT LEAST FOUR (4) POSTS.
6. RAIL TUBE EXPANSION JOINTS SHALL BE PROVIDED IN ANY RAIL BAY SPANNING A SUPERSTRUCTURE EXPANSION JOINT. EXPANSION JOINT WIDTH SHALL BE "X" AT 7°C AND WILL BE ADJUSTED IN THE FIELD BY THE RESIDENT ENGINEER FOR OTHER TEMPERATURES.
7. ALL PARTS SHALL BE GALVANIZED AFTER FABRICATION IN ACCORDANCE WITH AASHTO M111, EXCEPT THAT HARDWARE SHALL MEET THE REQUIREMENTS OF AASHTO M232M.
8. RAIL POSTS ANCHORING NUTS SHALL BE TIGHTENED TO A SNUG FIT AND GIVEN AN ADDITIONAL ONE-EIGHTH TURN.
9. RAIL TUBES SHALL BE ATTACHED USING M20 FULL DIAMETER BODY AASHTO M164 (TYPE 1) ROUND HEAD BOLTS INSERTED THROUGH THE FACE OF THE TUBE. HOLES IN POSTS SHALL BE 2 mm LARGER THAN THE BOLT SIZE.
10. HOLES IN RAILS FOR RAIL TUBE ATTACHMENT MAY BE FIELD-DRILLED. HOLES SHALL BE COATED WITH AN APPROVED ZINC-RICH PAINT PRIOR TO ERECTION.
11. ANY BENDING OF RAIL SHALL BE BY SHOP PROCEDURE ONLY.
12. THE FABRICATOR SHALL SUBMIT SHOP DRAWINGS INCLUDING WELDING PROCEDURES FOR APPROVAL IN ACCORDANCE WITH THE PROVISION OF 506.04, SHOP DRAWINGS. ALL WELDING SHALL CONFORM WITH SECTION 506.10. SEE NOTE 13 ON SHEET NO. BR1 FOR SHOP DRAWINGS DISTRIBUTION LIST.
13. RAIL POST AND BASE PLATES SHALL BE TESTED FOR IMPACT PROPERTIES IN ACCORDANCE WITH ASTM A370 CHARPY IMPACT TESTING USING TYPE A SPECIMENS.

MATERIALS

RAIL TUBES.....ASTM A500, GRADE B OR ASTM A501  
 RAIL POSTS AND BASE PLATE.....ASTM A709/A709M, GRADE 345  
 ALL OTHER SHAPES AND PLATES.....ASTM A709/A709M, GRADE 250  
 ANCHOR STUDS.....ASTM F568M CLASS 8.8  
 ALL OTHER BOLTS (UNLESS NOTED).....AASHTO M164M, TYPE 1


NUTS FOR AASHTO M164 BOLTS AND ANCHOR STUDS SHALL COMPLY WITH AASHTO M291M (ASTM A563M).

WASHERS SHALL COMPLY WITH AASHTO M293M (ASTM F436M) SPECIFICATIONS.

3mm PAD SHALL COMPLY WITH STANDARD SPECIFICATION SUBSECTION 731.01 OR 731.02.

SPLICE TABLE					
T	A	B	C	L	X
NA	100	50	--	510	20
EXPANSION JOINT TABLE					
<100	100	50	65	510	65
>100 <165	140	60	90	605	105
>165 <230	165	85	230*	705	130
>230 <330	215	110	280*	860	180


T = TOTAL MOVEMENT BETWEEN BRIDGE EXPANSION JOINTS. SEE NOTE 6  
 \* = SINGLE SLOT

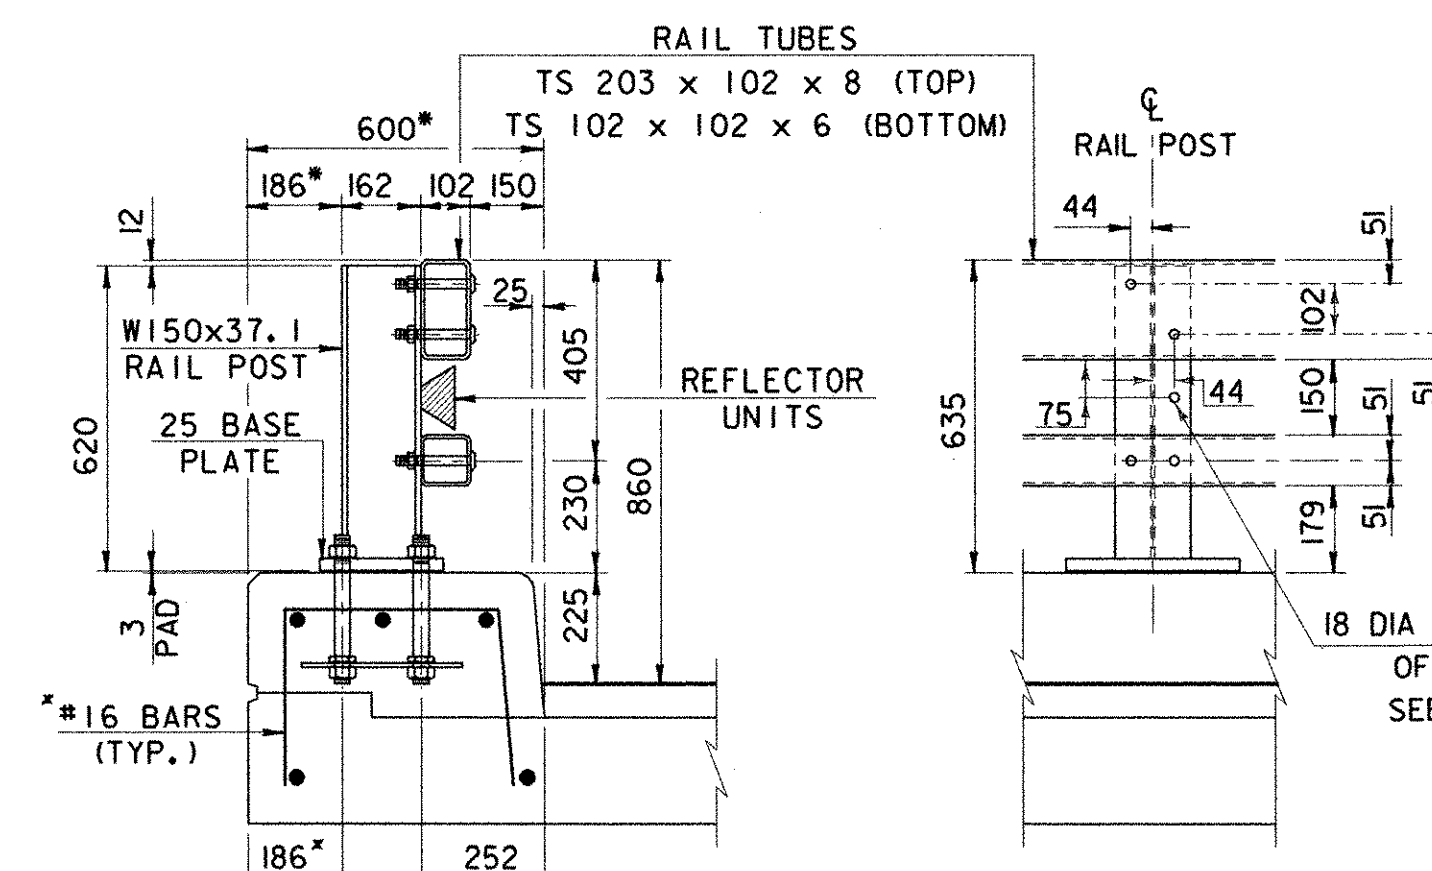

TYPICAL SECTION


ELEVATION

REFER TO SHEET BR2 FOR DIMENSION AND REINFORCEMENT MODIFICATIONS.

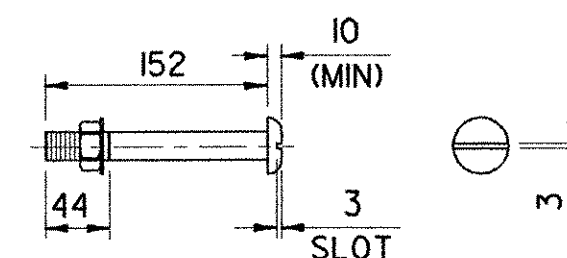


M20 DIA M164 (TYPE 1) ROUND HEAD BOLT

(WITH WASHER AND PREVAILING TORQUE TYPE LOCK NUT) (SEE NOTE #9)  
 ONLY FULL DIAMETER BODY BOLTS WILL BE ALLOWED.

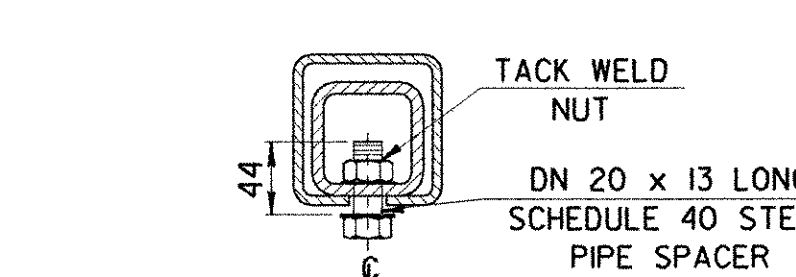


EXPANSION JOINT SECTION


FOR DETAILS NOT SHOWN SEE "RAIL TUBE SPLICE SECTION"

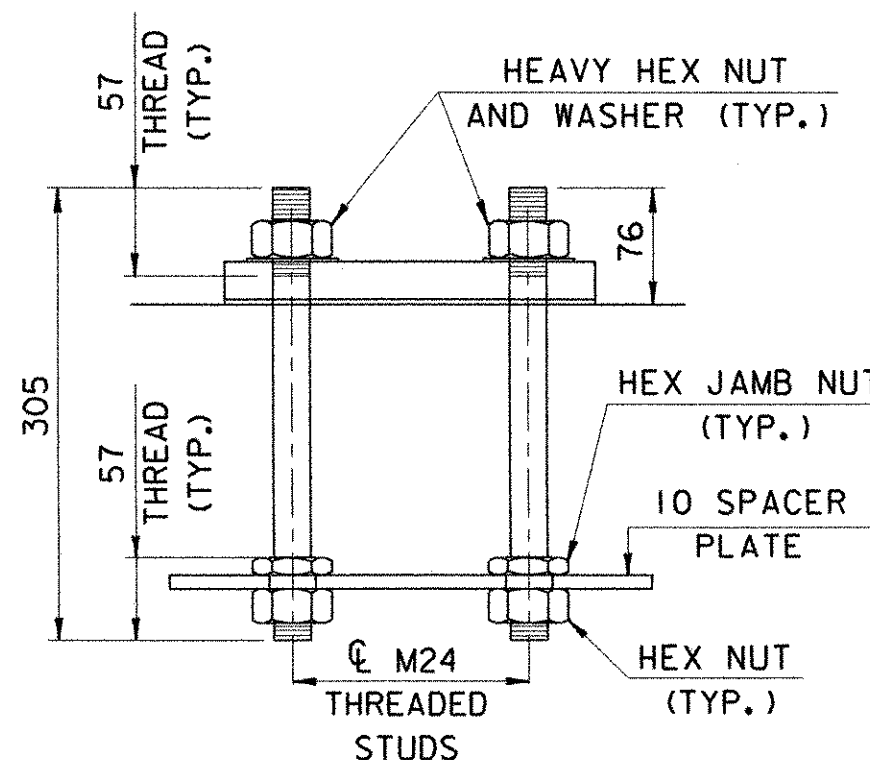


RAIL POST ANCHORAGE

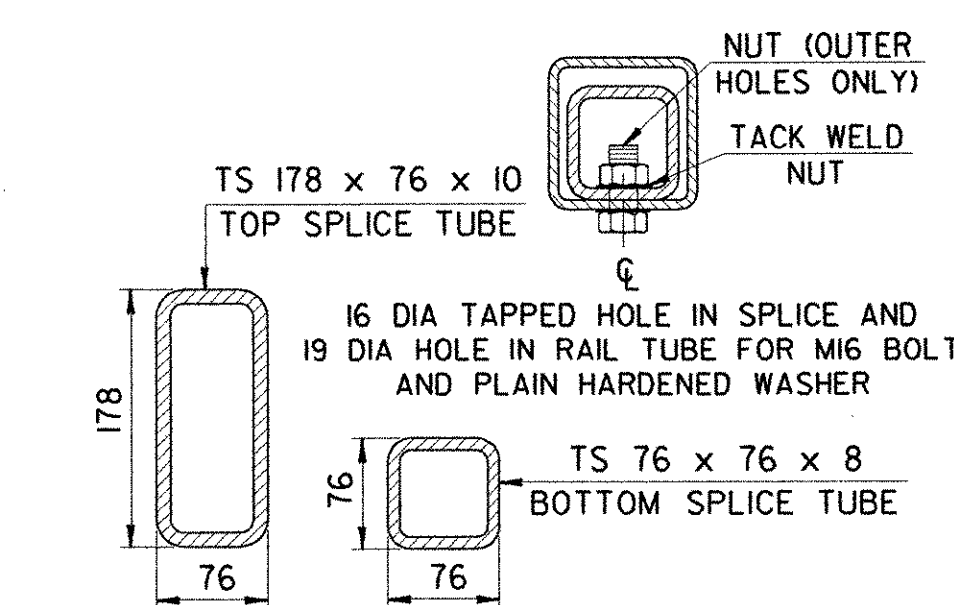

RAIL TUBE SPLICE SECTION

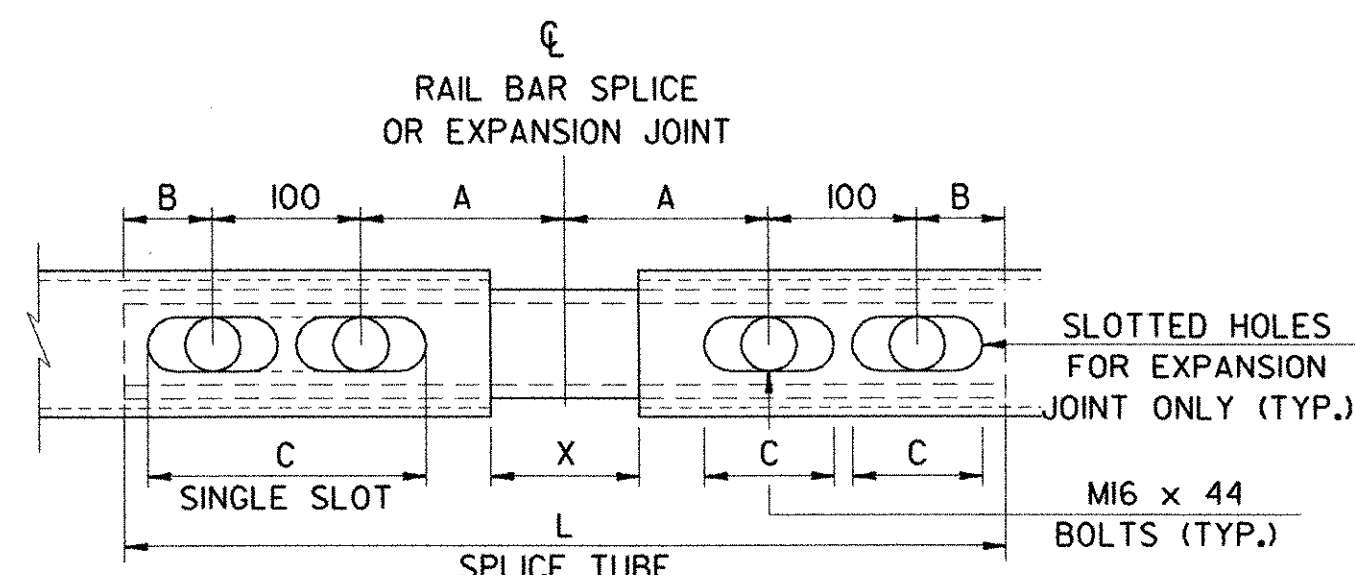

RAIL TUBE SPLICE AND RAIL EXPANSION JOINT DETAIL (BOTTOM VIEW)

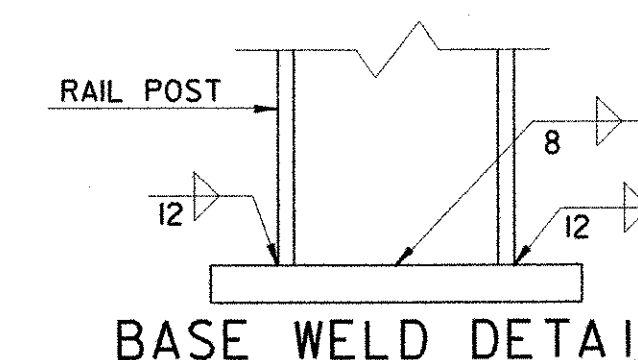


BASE WELD DETAIL

STATE OF VERMONT AGENCY OF TRANSPORTATION


Town of	BENNINGTON	Bridge No.	BR1200
Highway No.	VT. RTE. 279	Log Sta.	
		Surv. Sta.	17+853
VT. RTE. 279 OVER HISTORIC VT. ROUTE 7A			
BRIDGE RAILING - N.E.T.C. 2 RAIL			
Designed By	D. STECIAK	Drawn by	K. RAPELLO
Checked By	Date	Bridge Design Supervisor	
M. W. OLSTAD	02/04	M. W. OLSTAD	Date 02/04
PROJECT	BENNINGTON-HOOSICK	PROJECT NO.	D.P.I. 0146(I) C/6
I.G.C. Info.			
Bridge Sheet No.	BR4	Sheet	60 OF 83

NOTE: UNLESS NOTED OTHERWISE, ALL STATIONS ARE IN KILOMETERS, ALL ELEVATIONS ARE IN METERS, AND ALL DIMENSIONS ARE IN MILLIMETERS.

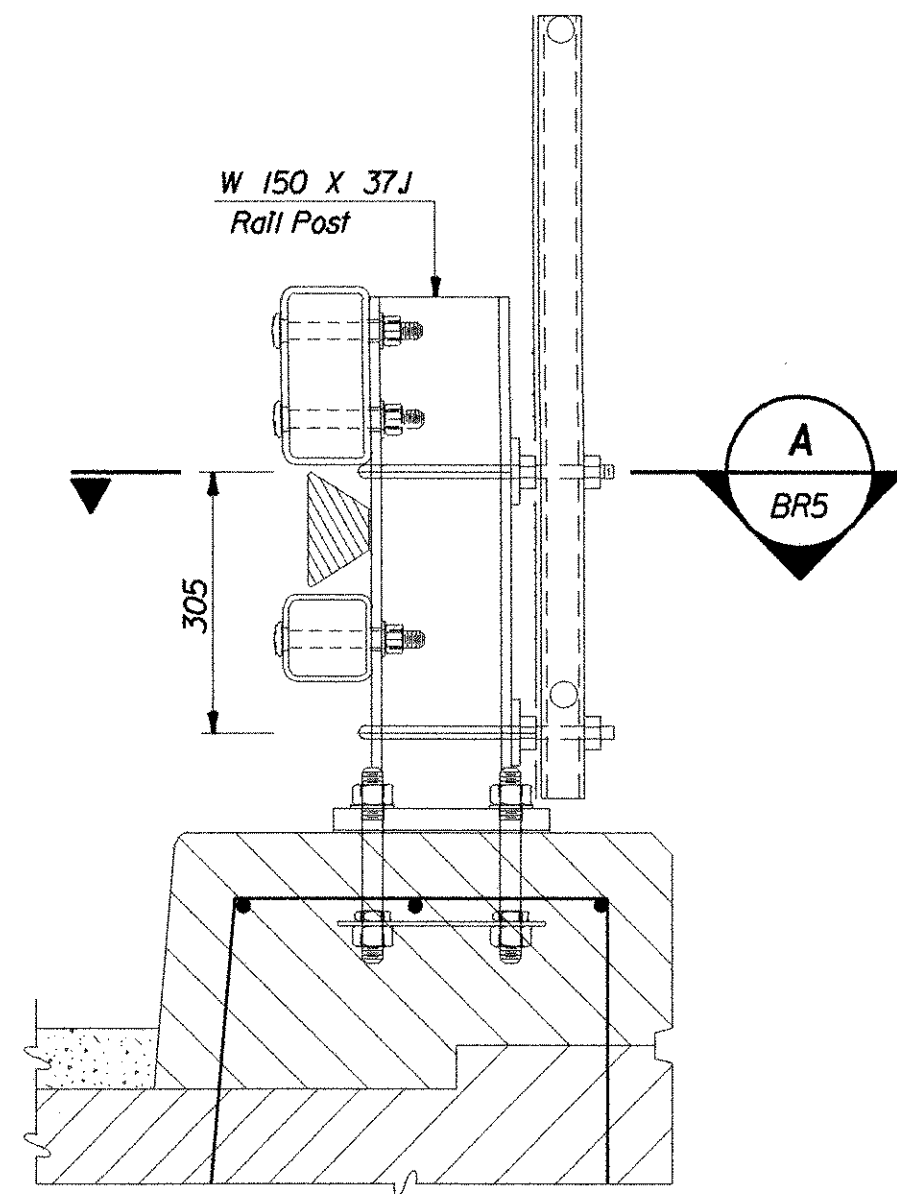


TYPICAL SECTION


NOTE: FOR DIMENSIONS SEE SHEETS BR2 AND BR4

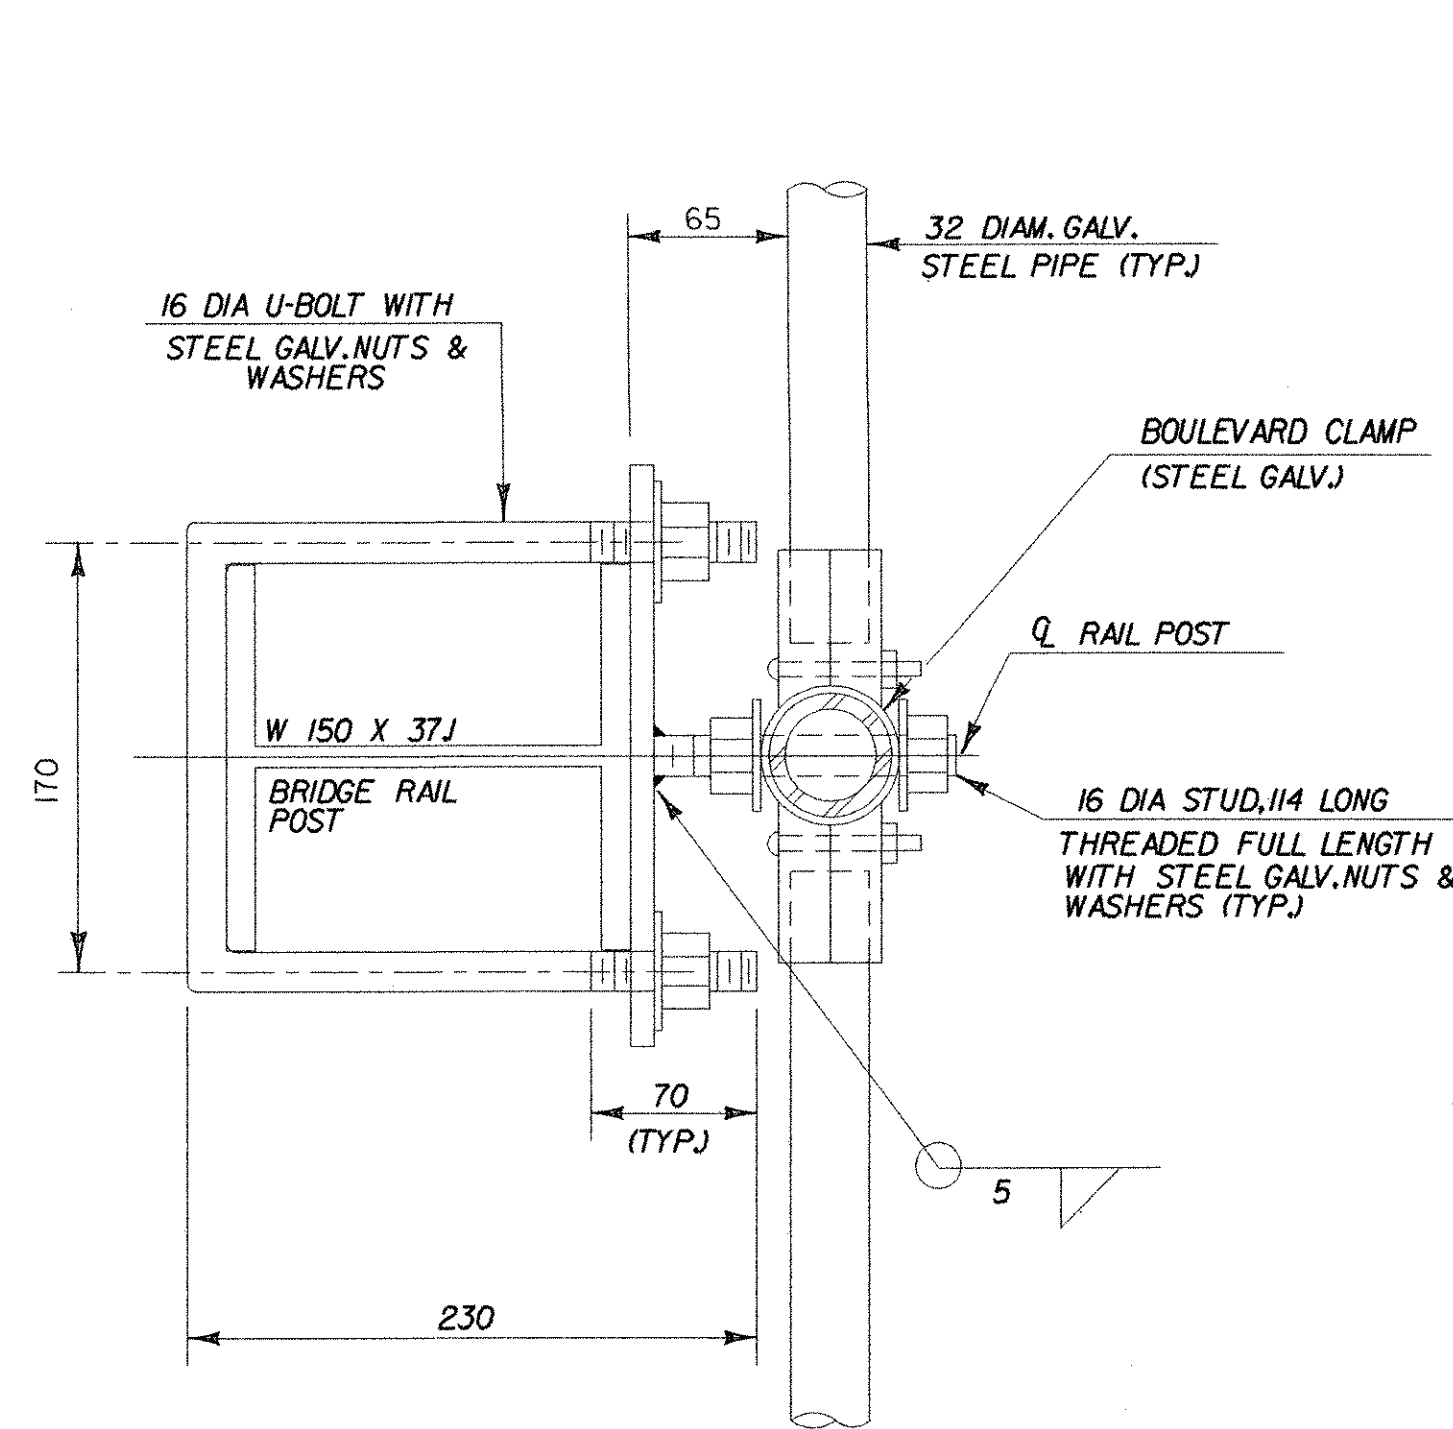

BRIDGE RAILPOST SECTION  
BR5  
N.T.S.

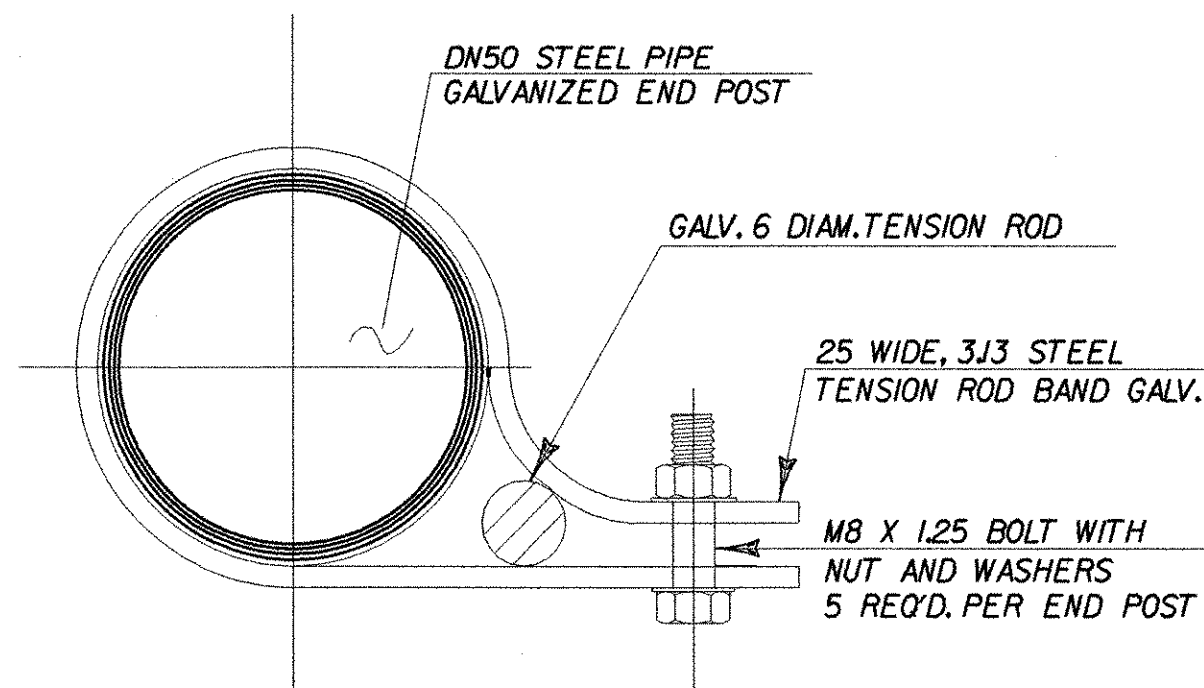


TENSION ROD BAND

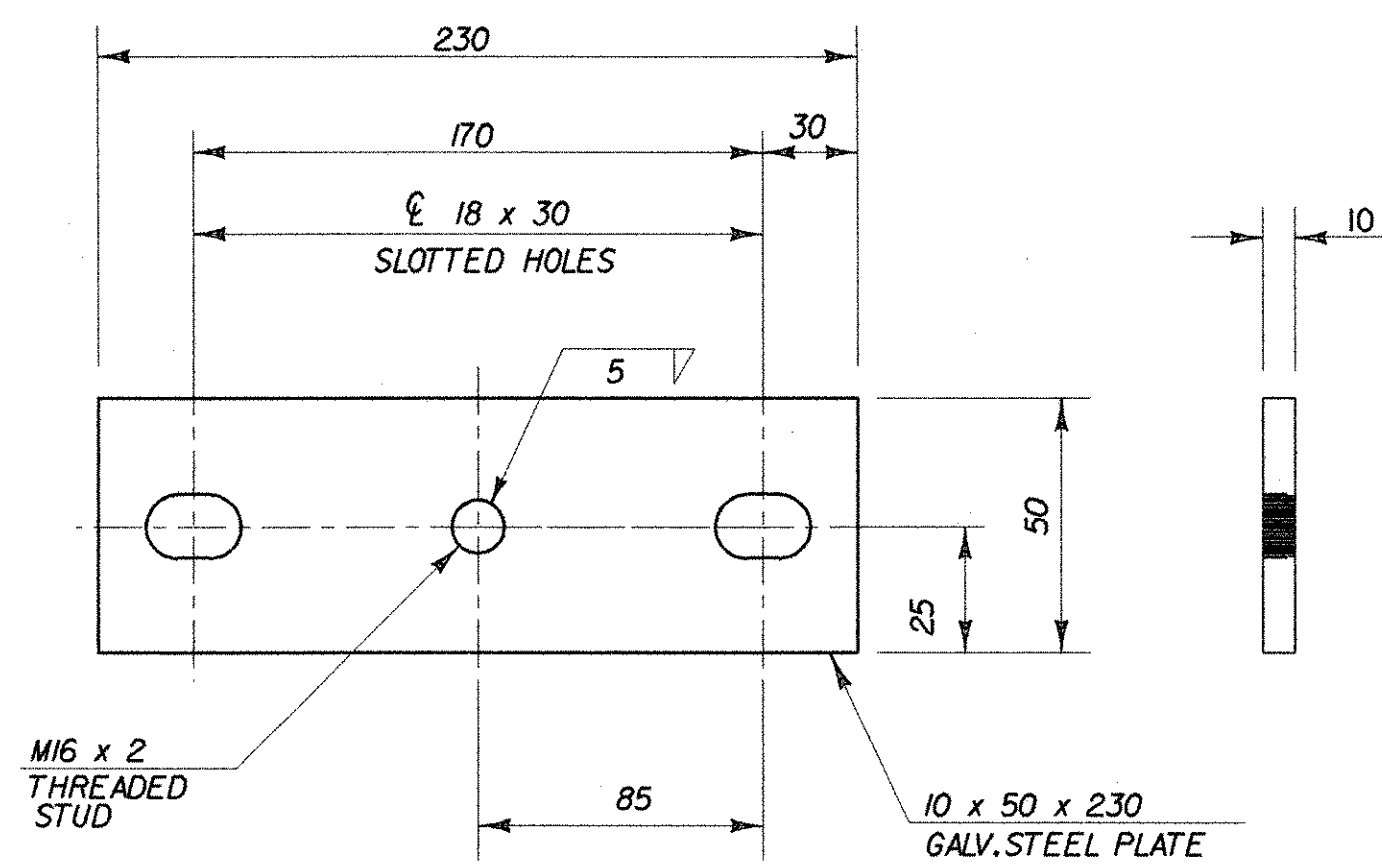


PLAN VIEW AT END POST

M16 x 2 THREADED STUD


PLATE DETAILS

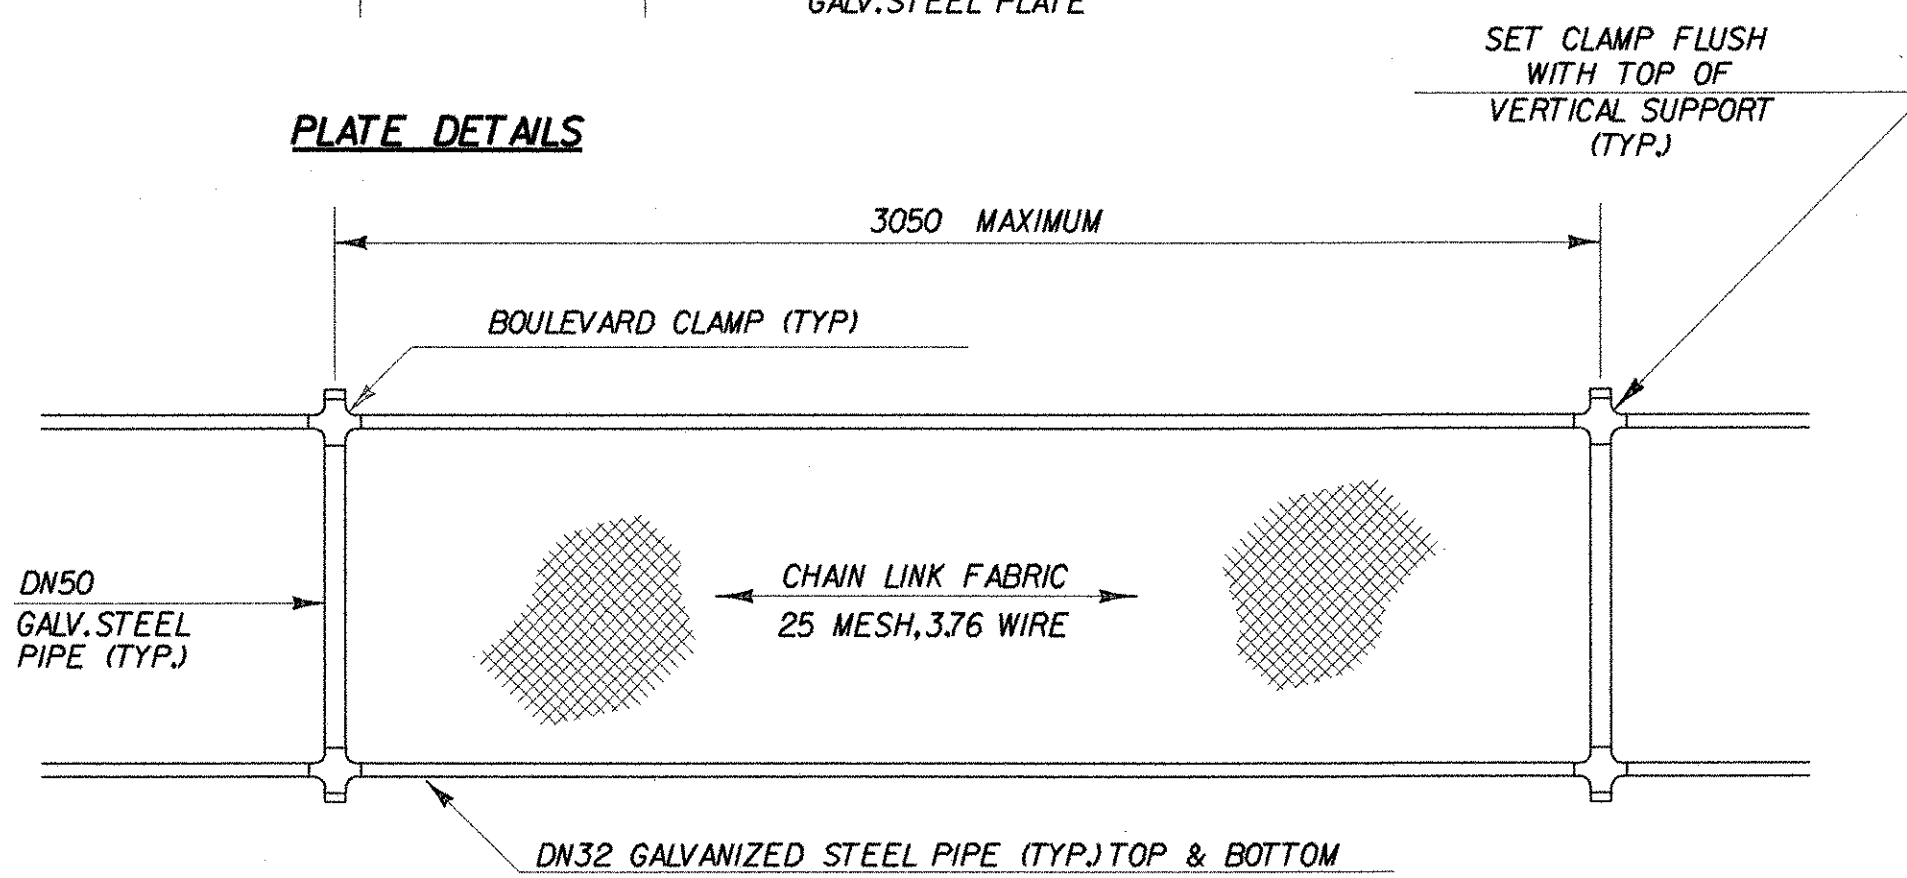


ELEVATION SNOW BARRIER

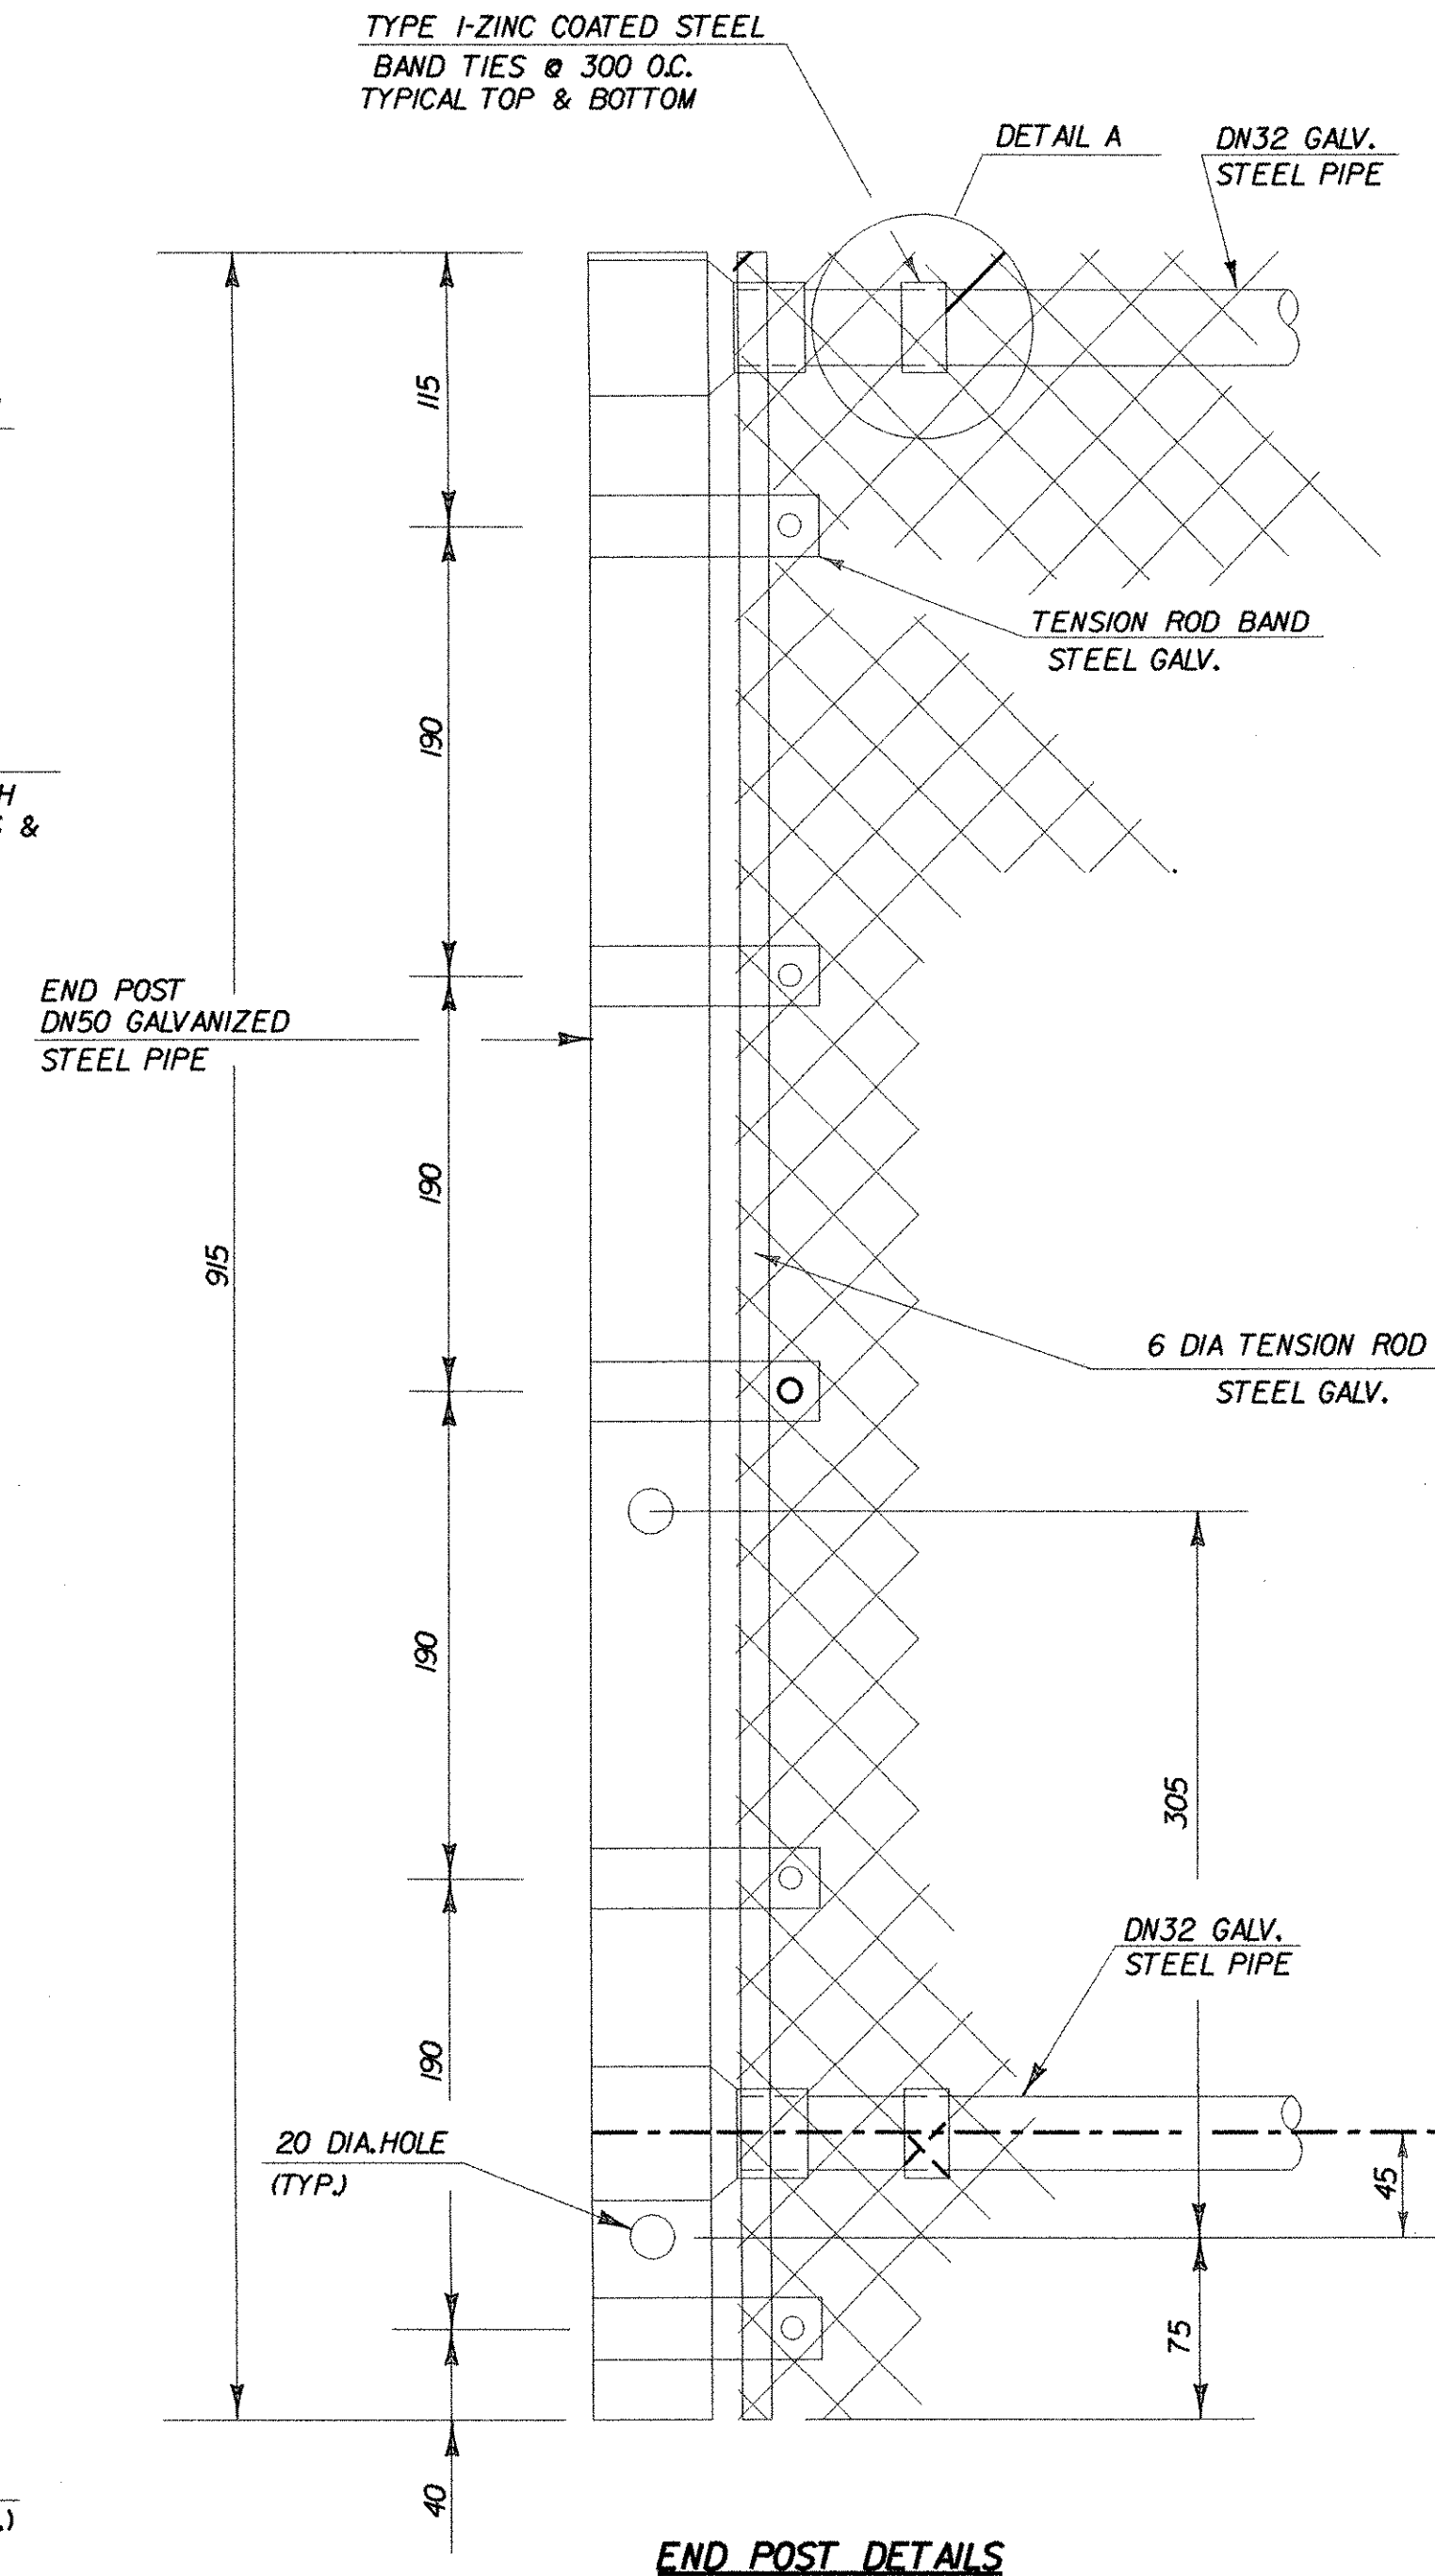

END POST DETAILS

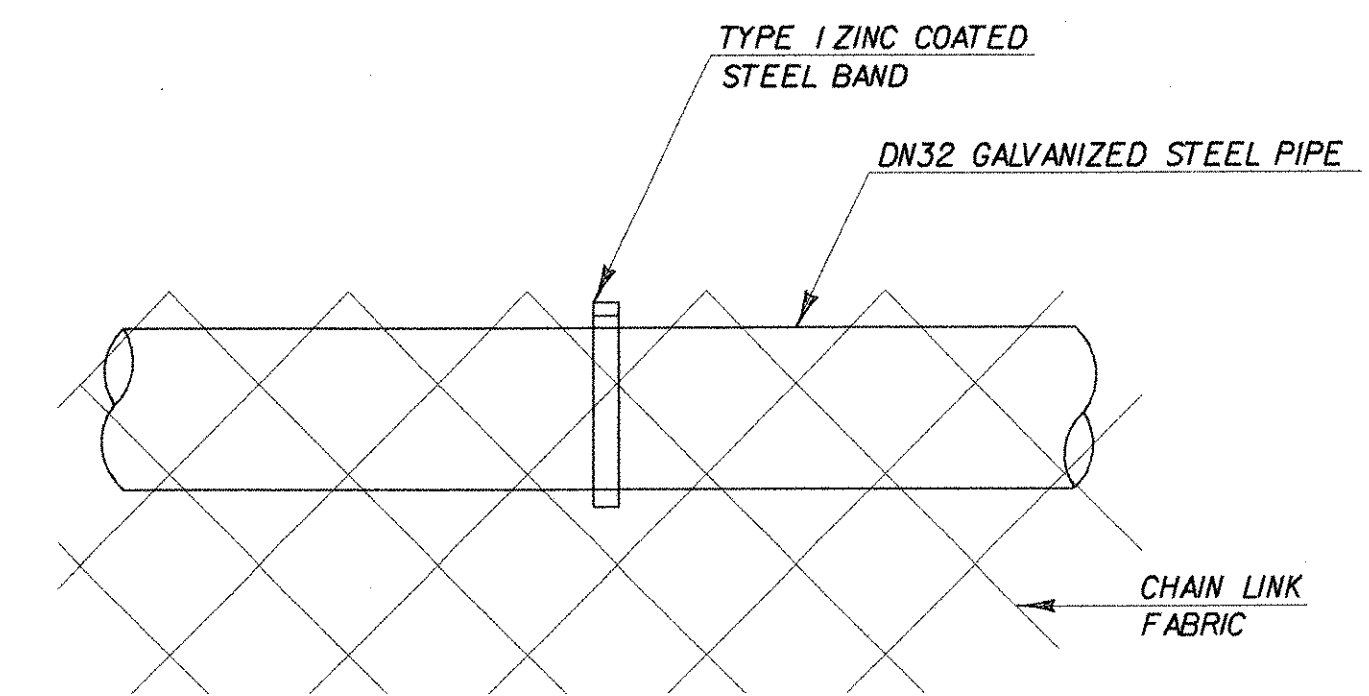

DETAIL A

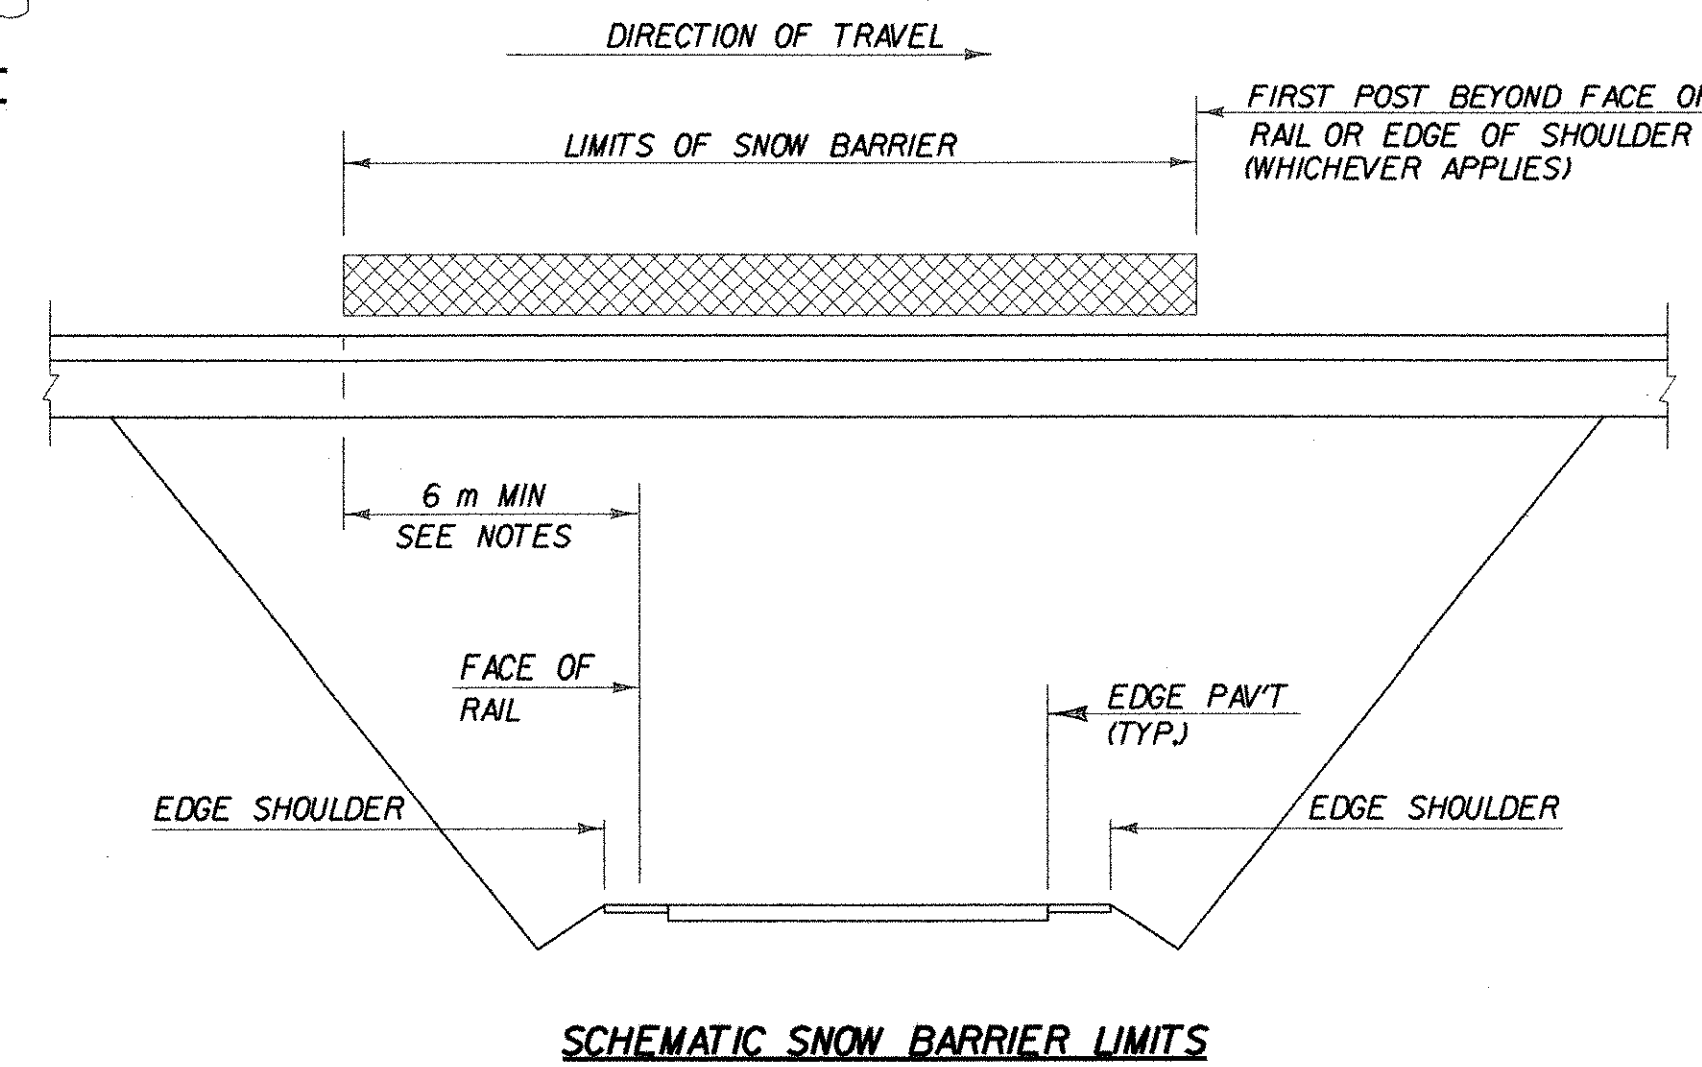

SCHEMATIC SNOW BARRIER LIMITS



NOTES

1. THREADS OF STUDS AND U-BOLTS TO BE M16 x 2.
2. ALL CONNECTION PLATES TO BE GALVANIZED AFTER FABRICATION.
3. DN 32 PIPE LENGTH SHALL BE FIELD CUT TO FIT POST SPACING.
4. CHAIN LINK FABRIC TO BE KNUCKLED TOP AND BOTTOM.
5. ALL BOLTS, THREADED STUDS AND WASHERS SHALL CONFORM TO THE SPECIFICATIONS FOR AASHTO M164M, TYPE 1. NUTS SHALL CONFORM TO AASHTO M291M.
6. ALL STEEL PLATES SHALL CONFORM TO THE SPECIFICATION FOR AASHTO M270/M270M, GRADE 250.
7. ALL GALVANIZING SHALL CONFORM TO THE REQUIREMENTS OF AASHTO M-181 WITH HARDWARE AND FITTINGS CONFORMING TO THE REQUIREMENTS OF AASHTO M-111 OR AASHTO M-232 WHICHEVER IS APPLICABLE. ALL BOLTS, NUTS AND WASHERS SHALL BE EITHER HOT-DIP GALVANIZED IN ACCORDANCE WITH THE ABOVE AASHTO REQUIREMENTS OR MECHANICALLY GALVANIZED USING A MECHANICALLY DEPOSITED PROCESS CONFORMING TO THE REQUIREMENTS OF AASHTO M-298, CLASS 110.
8. GALVANIZED CHAIN-LINK FABRIC SHALL BE TYPE 1 (ZINC) CLASS D AS SPECIFIED IN AASHTO M181.
9. SNOW BARRIER SHALL BEGIN AT THE BRIDGE RAIL POST WHICH WILL PROVIDE A MINIMUM DISTANCE OF 6 m (AS SHOWN) OR AS DIRECTED BY THE RESIDENT ENGINEER.
10. ALL DN (I.E. DIAMETER NOMINAL) REFERENCES TO GALVANIZED STEEL PIPE SHALL REFER TO THE NOMINAL PIPE SIZE.
11. ALL POSTS, RAILS AND HARDWARE SHALL BE ZINC COATED AND CONFORM TO THE REQUIREMENTS OF AASHTO M81, GRADE 1 OR GRADE 2.

STATE OF VERMONT  
AGENCY OF TRANSPORTATION



Town of	BENNINGTON	Bridge No.	BR800 & BR200
Highway No.	VT. RTE. 279	Log Sta.	
		Surv. Sta.	17+853
VT. RTE. 279			
SNOW FENCE FOR BRIDGE RAILING - N.E.T.C. 2 RAIL			
Designed By	D. STECIAK	Drawn by	K. RAPELLO
Checked By	M. W. OLSTAD	Date	02/04
		Bridge Design Supervisor	M. W. OLSTAD
		Date	02/04
PROJECT	BENNINGTON-HOOSICK		PROJECT NO.
			D.P.I. 0146(1) C/6
I.G.C. Info.			
Bridge Sheet No.	BR5	Sheet	61 OF 83

NOTE: UNLESS NOTED OTHERWISE, ALL STATIONS ARE IN KILOMETERS, ALL ELEVATIONS ARE IN METERS, AND ALL DIMENSIONS ARE IN MILLIMETERS.

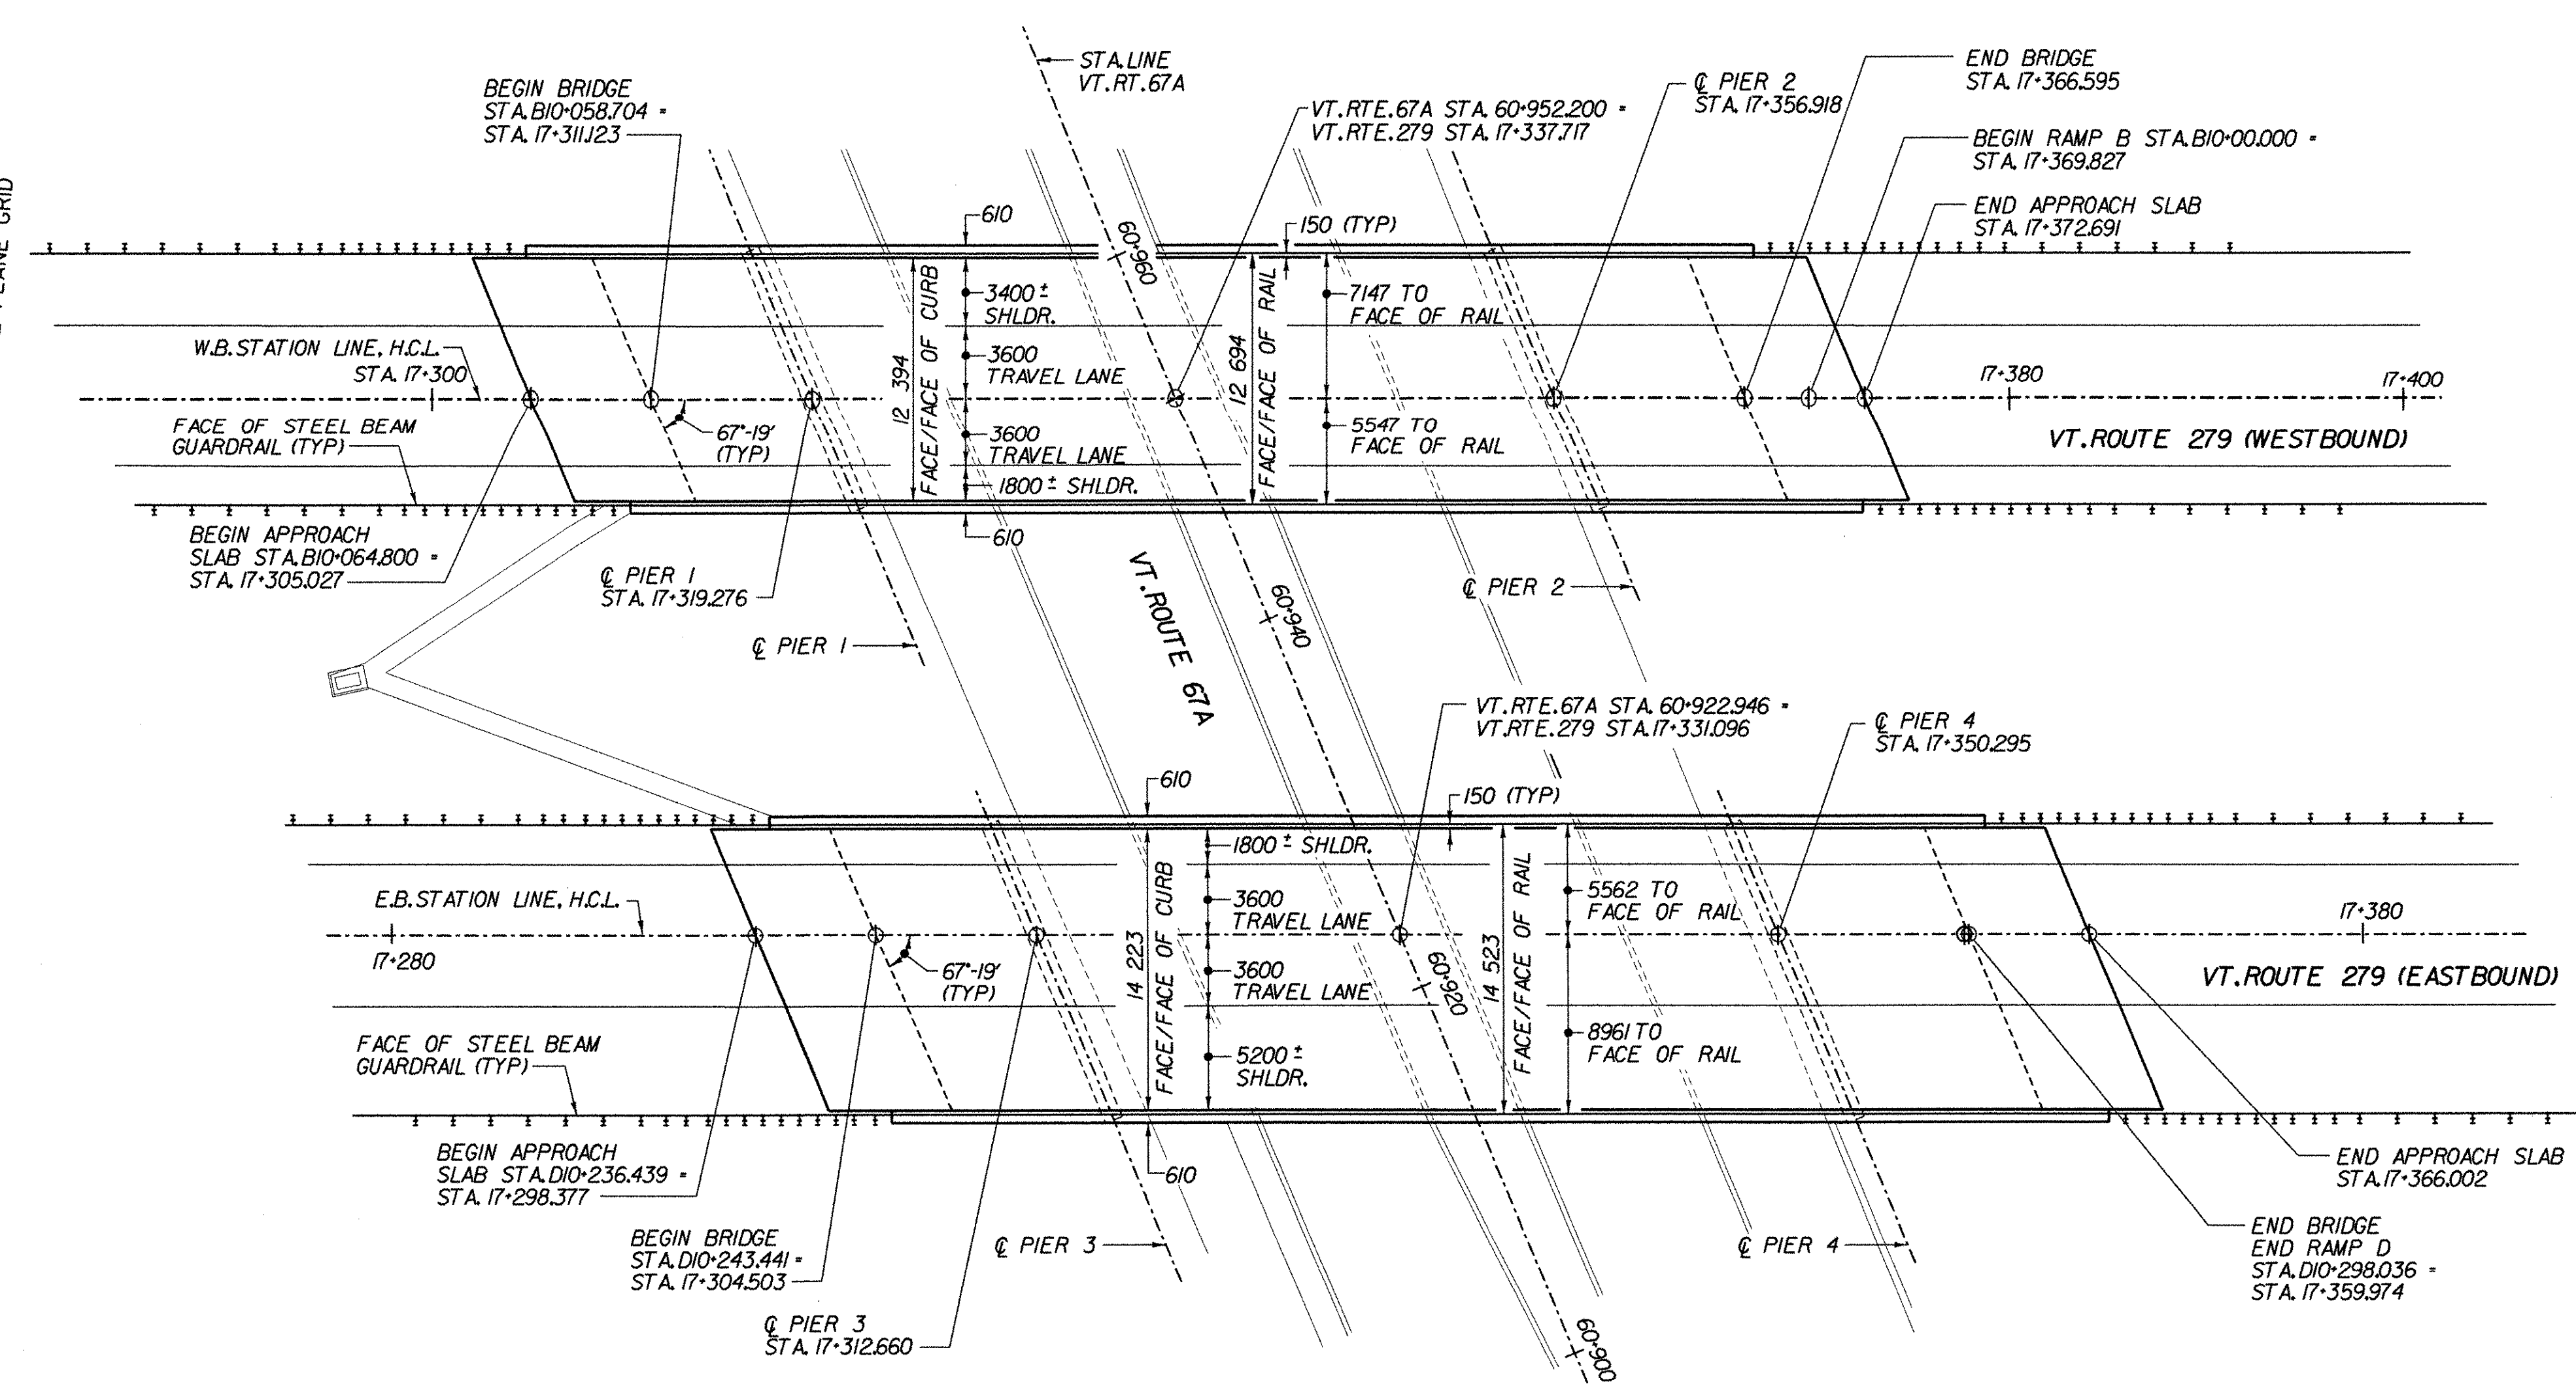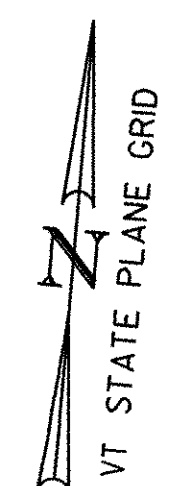


THESE CONTRACT DOCUMENTS HAVE BEEN PREPARED BASED ON LIMITED FIELD INVESTIGATION AND RECORD DRAWINGS AVAILABLE AT THE TIME. ACTUAL FIELD CONDITIONS MAY REQUIRE MODIFICATIONS TO THE CONSTRUCTION DETAILS AND WORK QUANTITIES. THE CONTRACTOR SHALL PERFORM THE WORK IN ACCORDANCE WITH FIELD CONDITIONS. ALL DIMENSIONS AND JOINT LOCATIONS SHALL BE FIELD CHECKED BY THE CONTRACTOR PRIOR TO SUBMISSION OF FABRICATION DRAWINGS FOR APPROVAL.

LIST OF BRIDGE SHEETS	
BR800	PLAN AND ELEVATION
BR801	EXISTING TRANSVERSE BRIDGE SECTIONS
BR802	BRIDGE QUANTITY SHEET
BR803	BRIDGE RAILING AND CURB DETAILS
BR804	FRAMING PLAN AND STEEL DETAILS

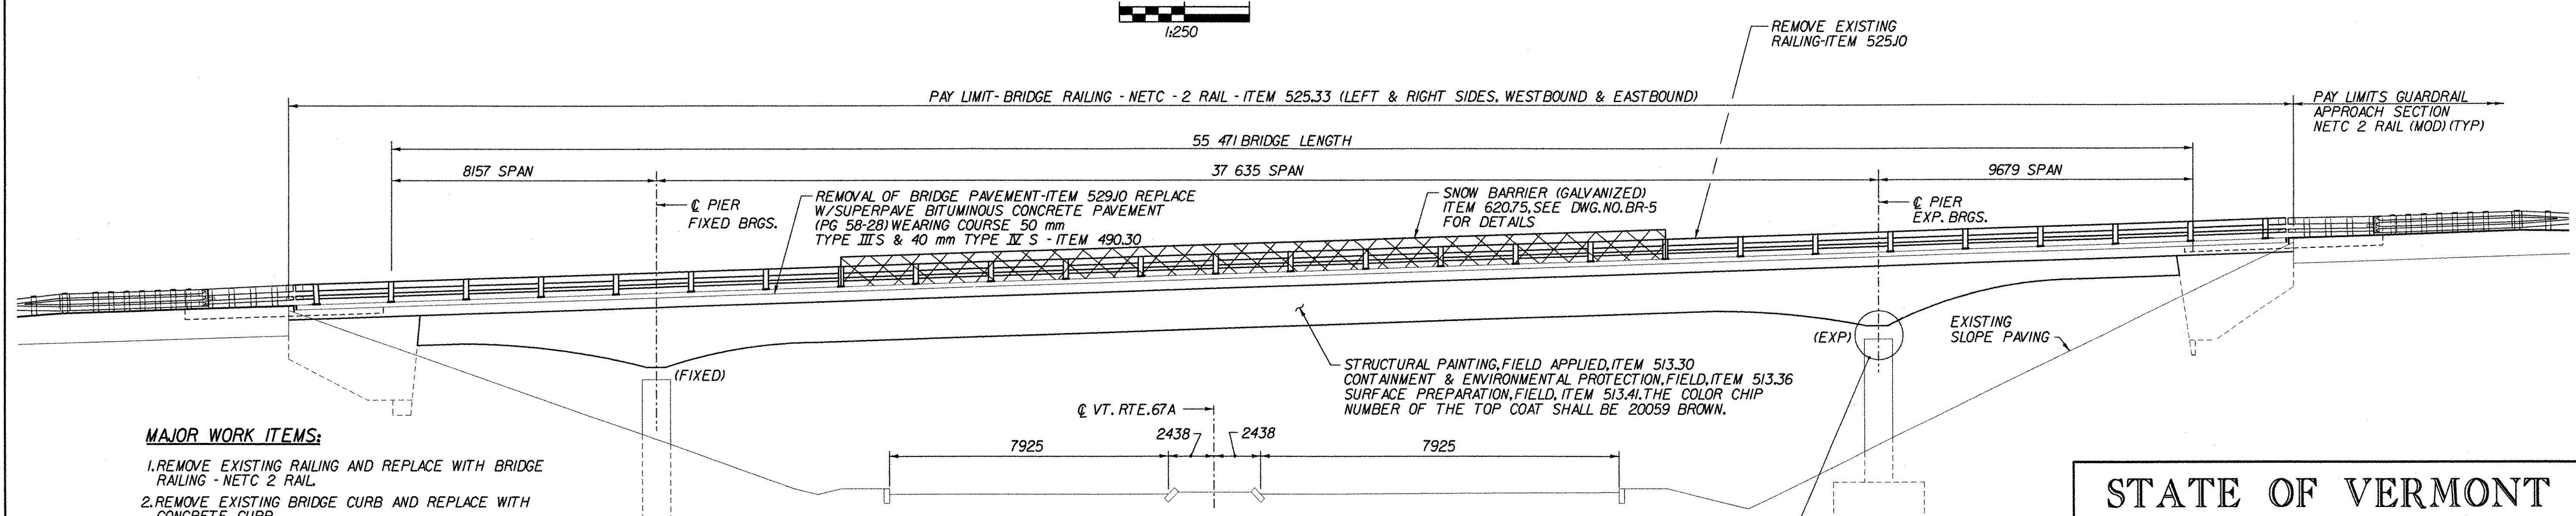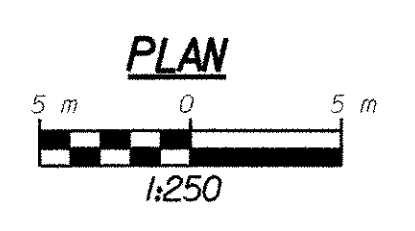

ELEVATION ALONG RIGHT FASCIA (EB SHOWN)

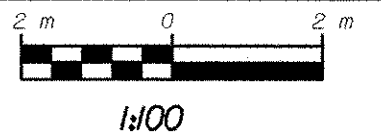


**MAJOR WORK ITEMS:**

1. REMOVE EXISTING RAILING AND REPLACE WITH BRIDGE RAILING - NETC 2 RAIL.
2. REMOVE EXISTING BRIDGE CURB AND REPLACE WITH CONCRETE CURB.
3. REMOVE EXISTING BITUMINOUS PAVEMENT AND REPLACE WITH SUPERPAVE BITUMINOUS PAVEMENT.
4. REPAIR CONCRETE DECK AS NEEDED.
5. CLEAN AND PAINT SUPERSTRUCTURE.
6. SHORE SUPERSTRUCTURE AND RESET PIERS 2 & 4 BEARINGS.


**STATE OF VERMONT  
AGENCY OF TRANSPORTATION**

Town of	BENNINGTON	Bridge No.	BR1100 & BR1200
Highway No.	VT. RTE. 279	Log Sta.	
		Surv. Sta.	17+331
VT. RTE. 279 OVER VT. ROUTE 67A			
PLAN AND ELEVATION			
Designed By	D. STECIAK	Drawn by	K. RAPELLO
Checked By	M.W. OLSTAD	Date	02/04
		Bridge Design Supervisor	M.W. OLSTAD
		Date	02/04
PROJECT	BENNINGTON-HOOSICK	PROJECT NO.	D.P.I. 0146(II) C/6
I.G.C. Info.			
Bridge Sheet No.	BR800	Sheet	62 OF 83


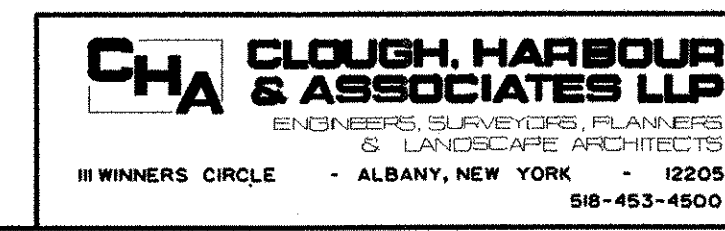


FILE NAME = ut\12502\mstn\final\67a\brg\67a-pl.epl.t  
DATE/TIME = 2/17/2004  
USER = 2225


NOTE: UNLESS NOTED OTHERWISE, ALL STATIONS ARE IN KILOMETERS, ALL ELEVATIONS ARE IN METERS, AND ALL DIMENSIONS ARE IN MILLIMETERS.

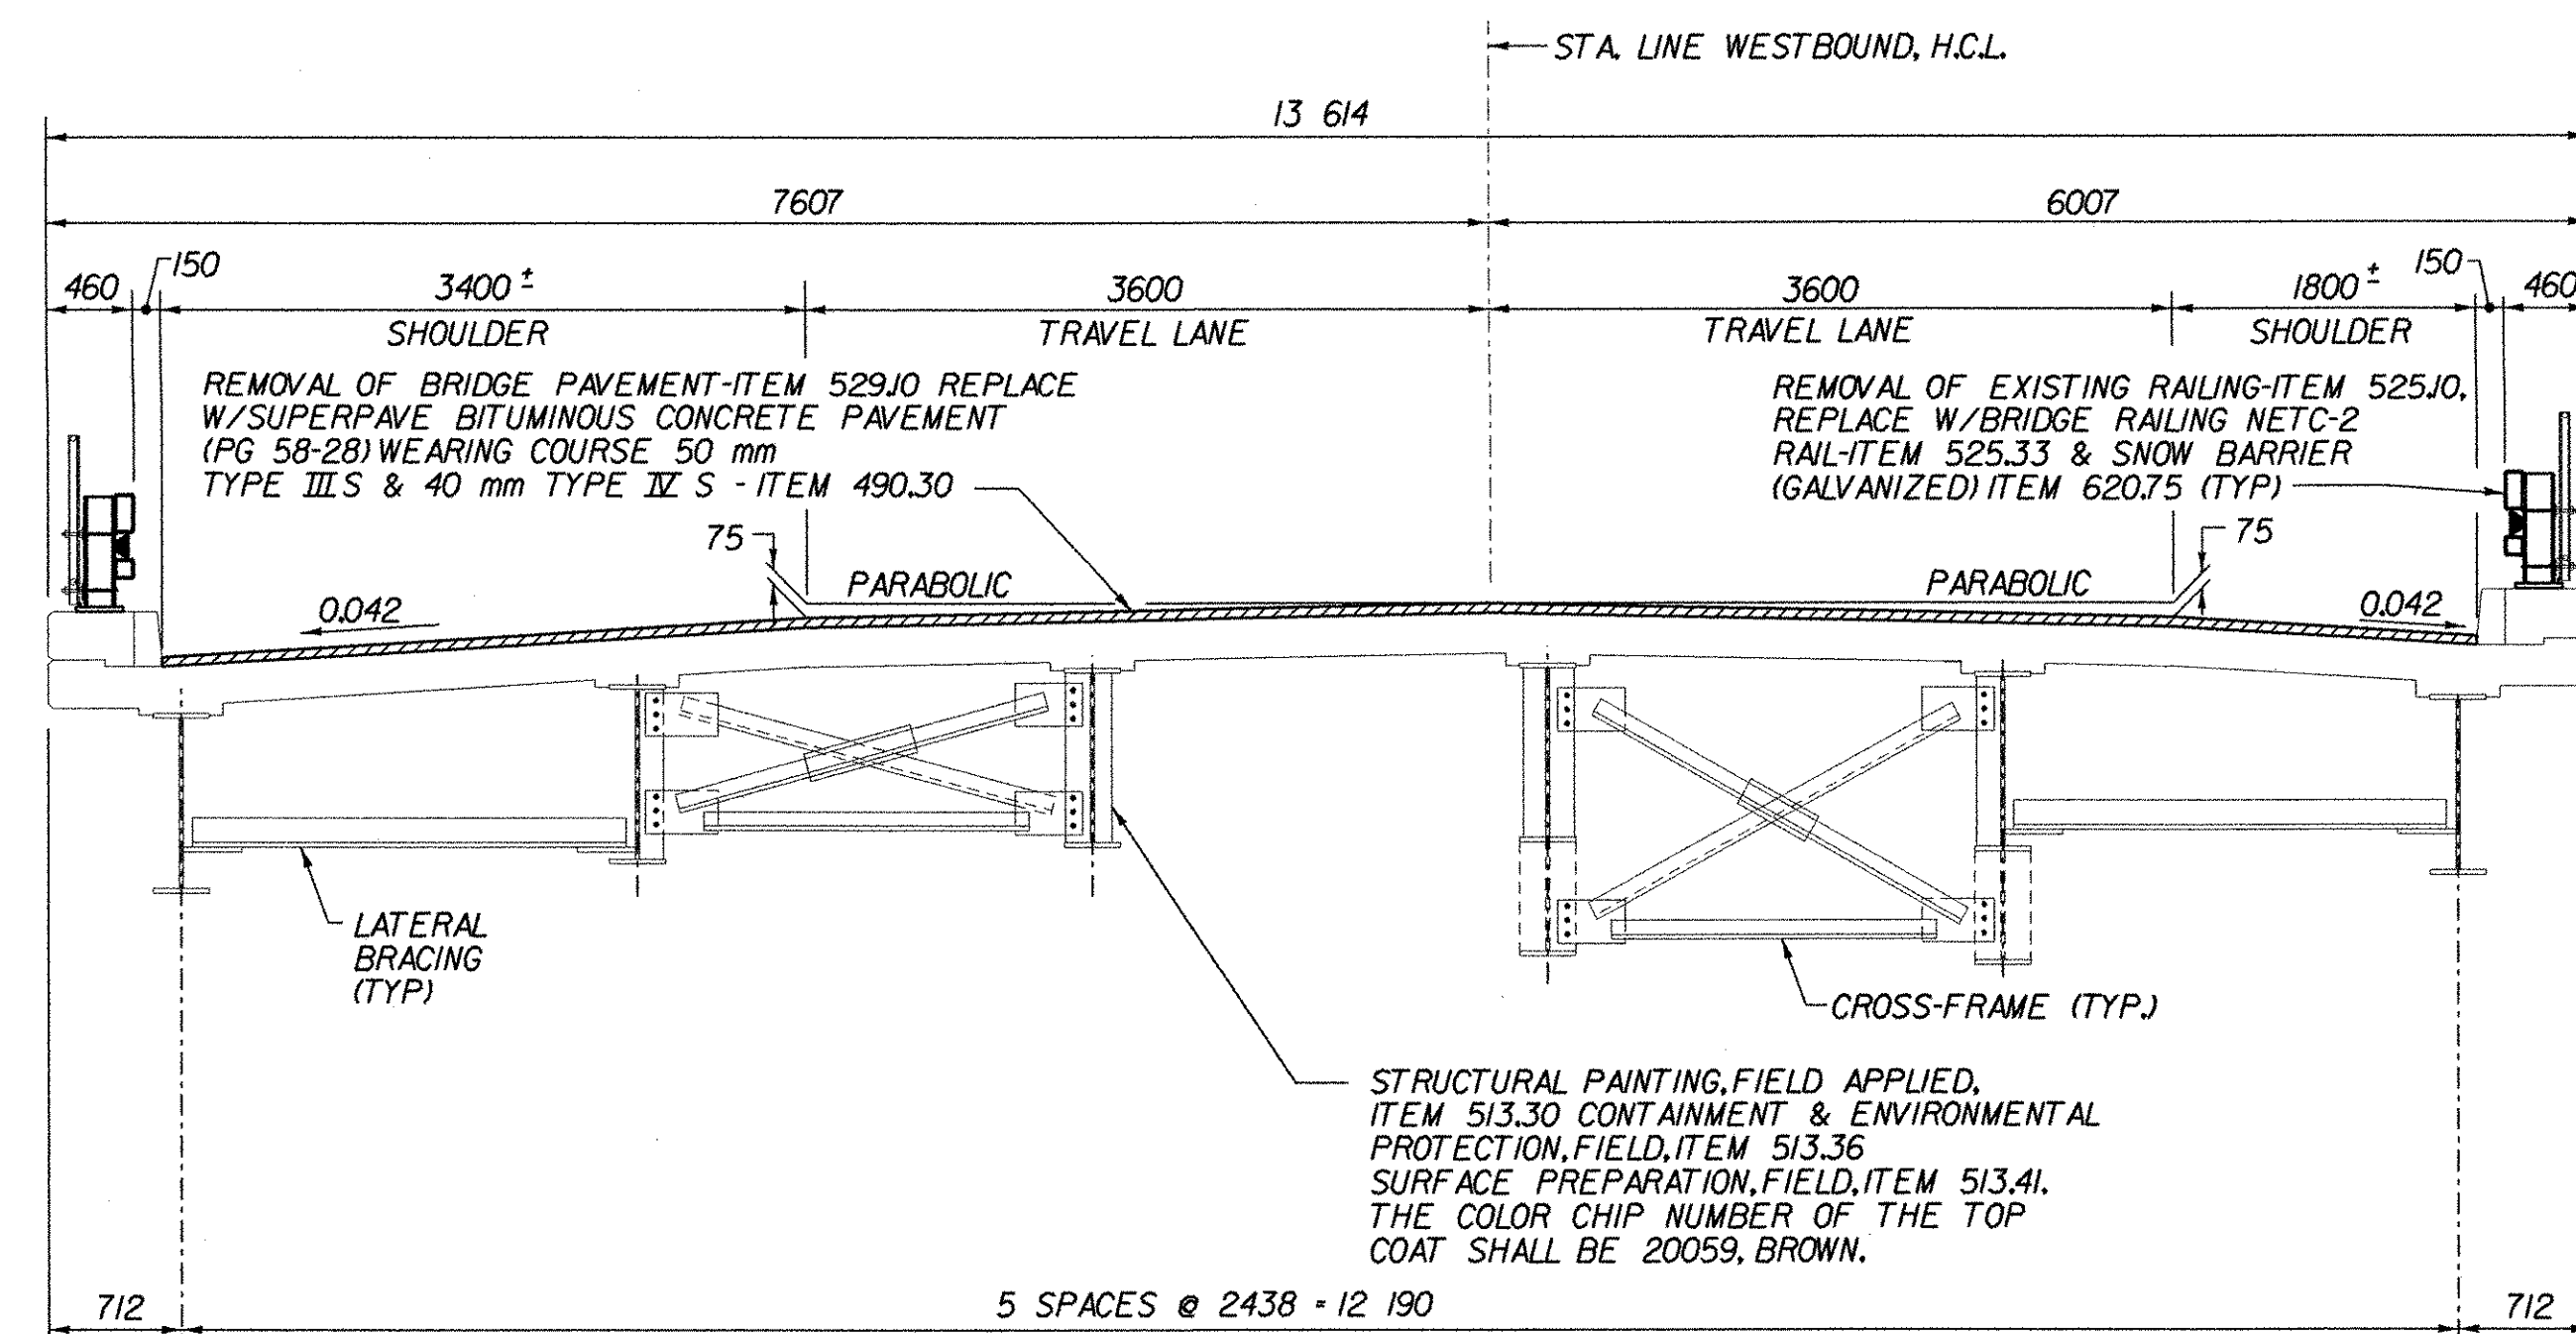

TYPICAL BRIDGE SECTION (WESTBOUND)

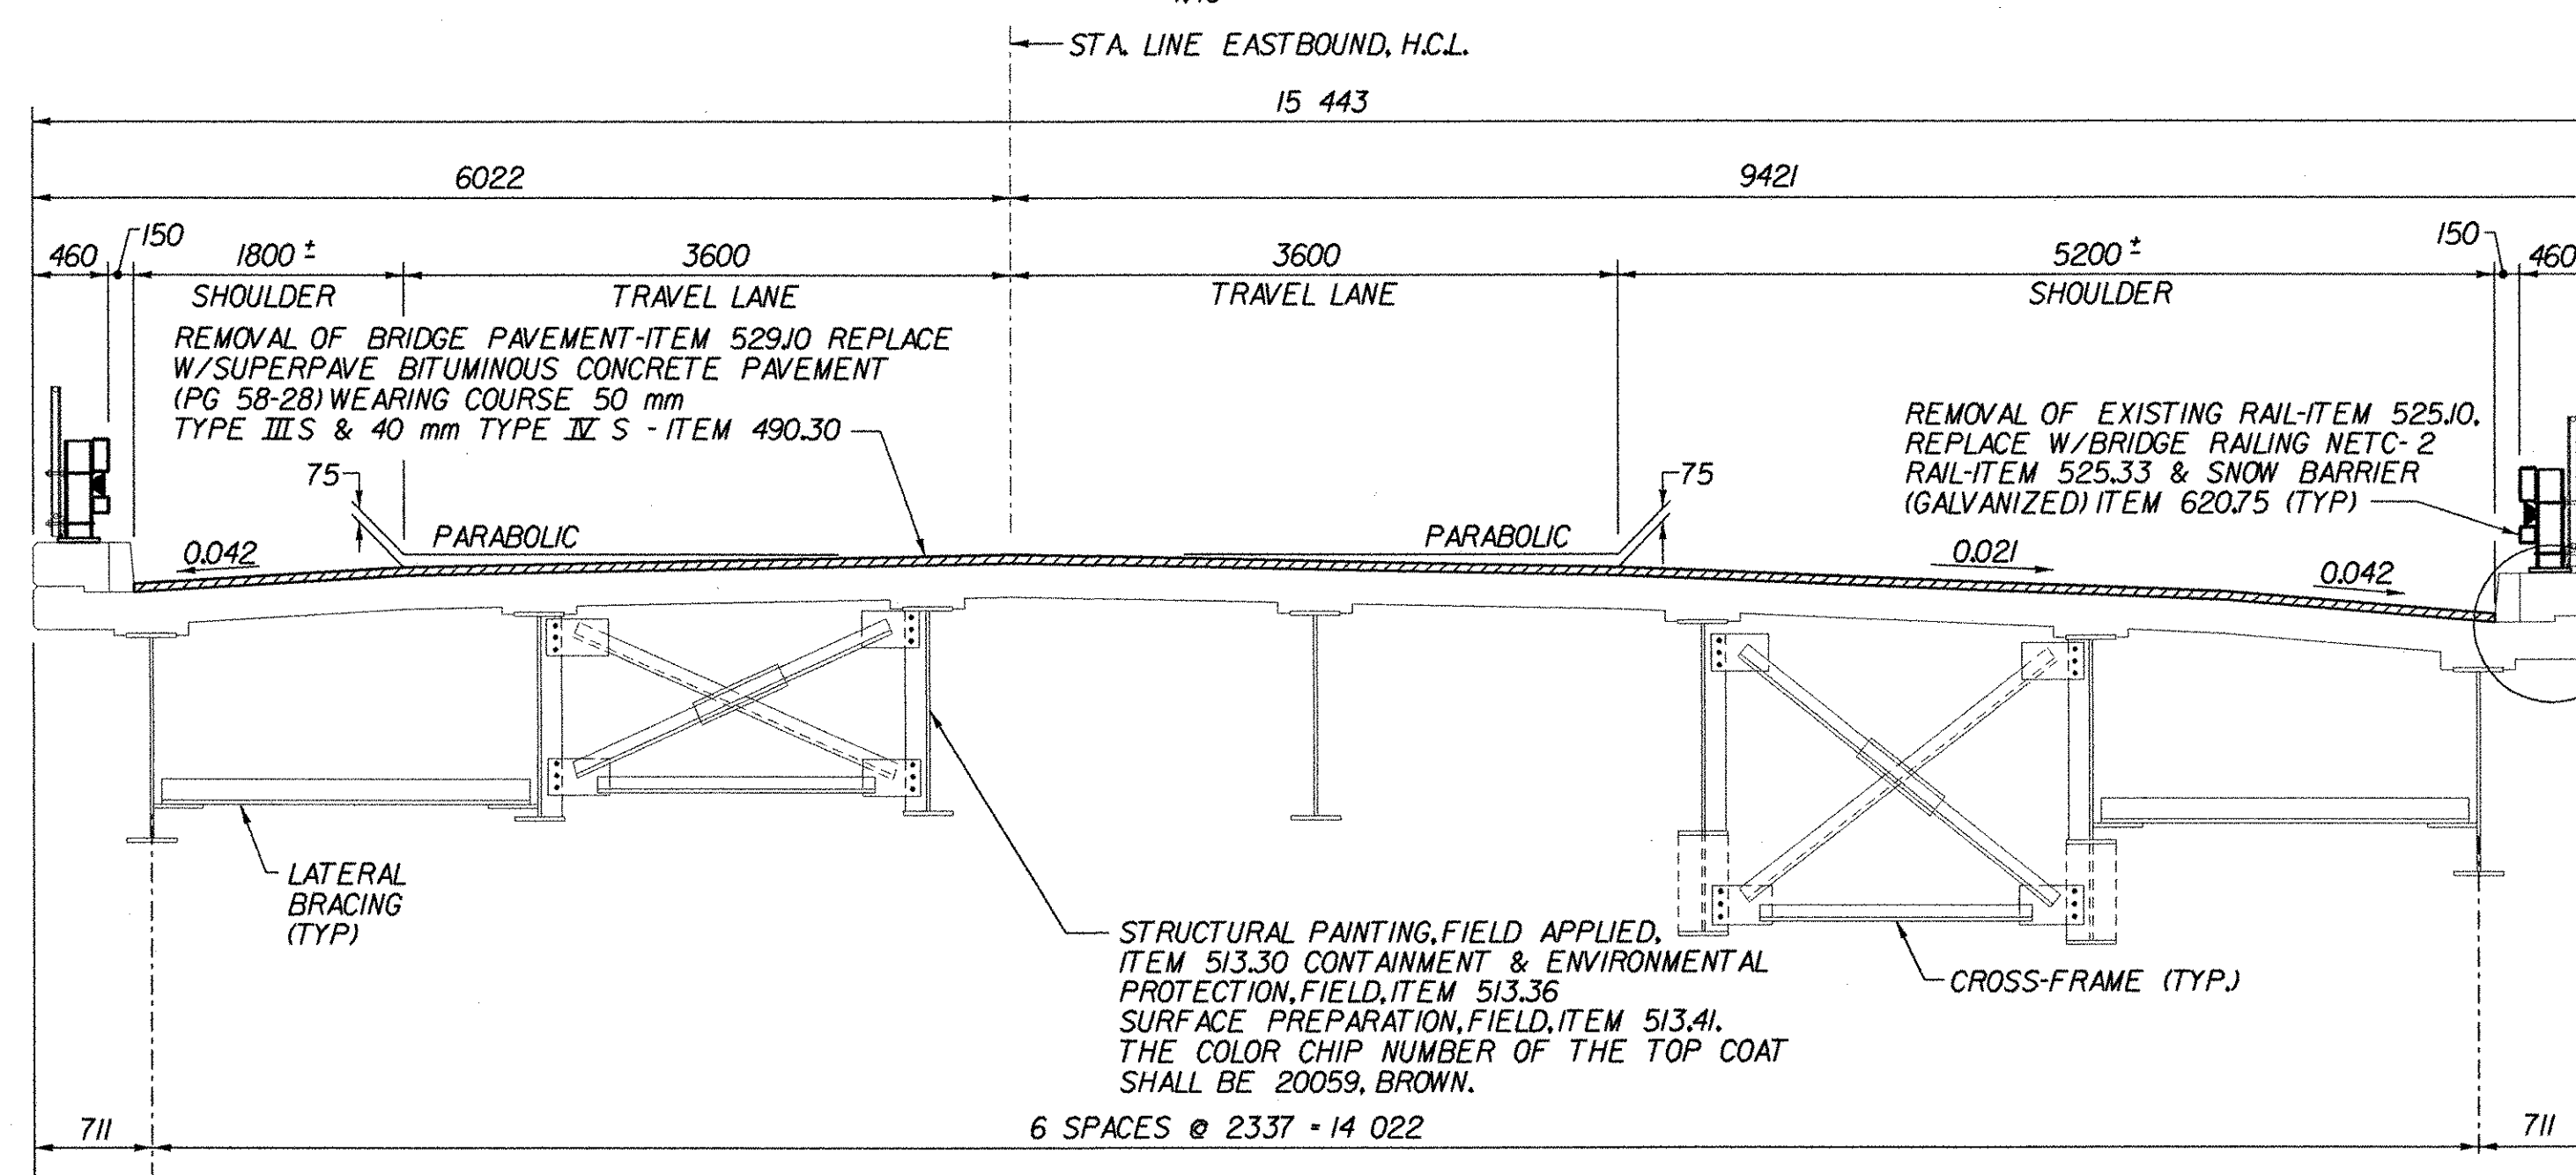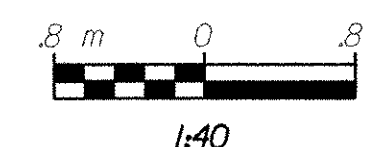

TYPICAL BRIDGE SECTION (EASTBOUND)

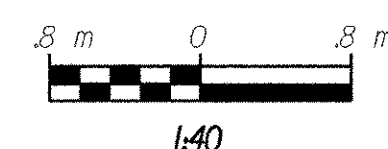

**RAILING ANCHORAGE NOTES:**


- NEW ASTM A449-22 mm DIAMETER ANCHOR BOLTS TO BE CAST-IN-PLACE SHALL BE FURNISHED WITH TWO NUTS AND ONE WASHER. BOLTS, NUTS AND WASHERS SHALL BE FURNISHED UNDER ITEM 525.33 BRIDGE RAILING-NETC 2 RAIL.

**BEARING NOTES:**

THE EXPANSION BEARINGS AT PIERS 2 & 4 OF THE EXISTING STRUCTURE SHALL BE RESET FOR ALL GIRDERS AS PER THE FOLLOWING PROCEDURE UNLESS DIRECTED OTHERWISE BY THE RESIDENT ENGINEER:

- REMOVE NUTS AND WASHERS FROM ANCHOR BOLTS.
- JACK GIRDER AND BLOCK AS REQUIRED TO REPOSITION SOLE PLATE
- GRIND OFF EXISTING WELD TO LOOSEN SOLE PLATE FROM THE BOTTOM FLANGE OF GIRDER.
- LOOSEN THE SLIDING PLATE FROM THE MASONRY PLATE.
- CLEAN ALL SURFACES OF ALL BEARING PLATES WITH SOLVENT TO REMOVE OLD GREASE.
- LUBRICATE TOP FACE OF MASONRY PLATE, TOP AND BOTTOM FACES OF SLIDING PLATE AND BOTTOM FACE OF SOLE PLATE WITH SILICON GREASE.
- REPOSITION SOLE PLATE AS PER DIMENSION 'A' AS SHOWN IN TABLE AND WELD INTO PLACE (14mm FILLET WELD EACH SIDE OF BOTTOM FLANGE).
- LOWER GIRDER TO ORIGINAL POSITION, MAINTAINING THE EXISTING ROADWAY PROFILE AND ELEVATION.
- REINSTALL WASHERS AND NUTS.

THE COST OF ALL WORK AND MATERIALS AS NOTED FOR RESETTING BEARINGS SHALL BE SUBSIDIARY TO SHORING SUPERSTRUCTURE BEARINGS, ITEM 502J1.

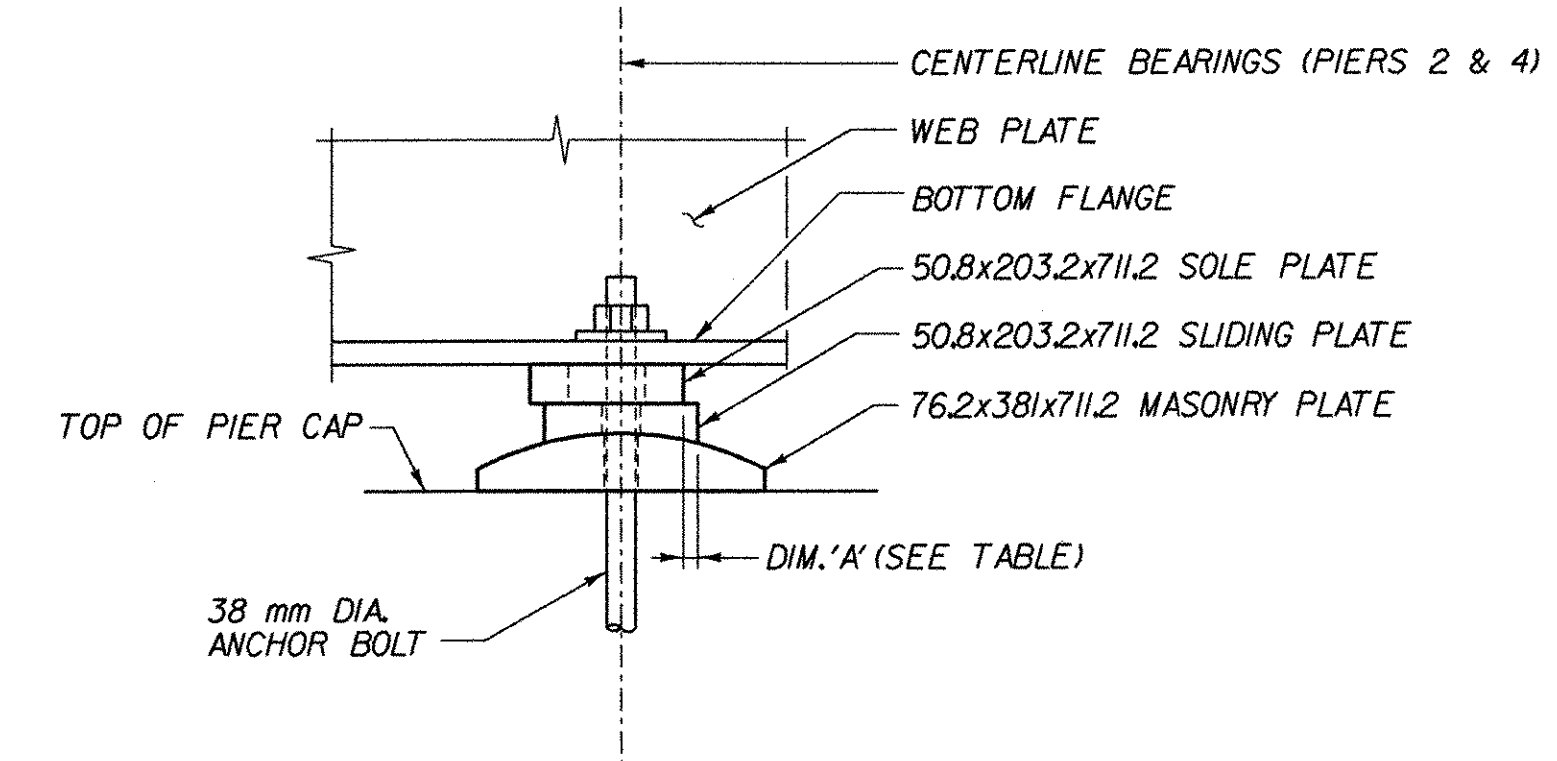

BEARING RESET @ TEMP BELOW 7°C (LOOKING NORTH)



TEMP °C	DIM 'A' IN MILLIMETERS
40	14
30	10
20	6
10	1
0	-3
-10	-7
-20	-12

**NOTES:**

- SEE SHEET NO. BR3 FOR ASPHALT OVERLAY REMOVAL AND REPLACEMENT NOTES AND FOR DECK SLAB REPAIR DETAILS.
- SEE SHEET NO. BR2 FOR CURB REMOVAL AND REPLACEMENT DETAILS.

LOADING LEVELS (LOAD FACTOR)	LOAD FACTOR LOAD RATING (METRIC TONS)						
	M	MS	3S2	6 AXLE	3A.STR.	4A.STR.	5A.SEMI
INVENTORY A = 2.17, B = 1.00	22	37					
POSTED A = 1.55, B = 1.80	34	57	73		51	44	*72
OPERATING A = 1.30, B = 1.67		53	61	113	43	54	

PROJECTED TRAFFIC DATA					
YEAR	ADT	DHV	% D	% T	ADTT
2000	5300	-	-	-	-
2020	6600	840	52%	7%	460


20 YEAR ESAL FOR FLEXIBLE PAVEMENT FROM 2000 TO 2020 = 4,825,000  
 40 YEAR ESAL FOR FLEXIBLE PAVEMENT FROM 2000 TO 2040 = 17,229,000  
 DESIGN SPEED: 100 km/h

**STATE OF VERMONT  
AGENCY OF TRANSPORTATION**


Town of	BENNINGTON	Bridge No.	BR100 & BR100
Highway No.	VT. RTE. 279	Log Sta.	
		Surv. Sta.	17+331
VT. RTE. 279 OVER VT. ROUTE 67A			
EXISTING TRANSVERSE BRIDGE SECTIONS			
Designed By	D. STECIAK	Drawn by	K. RAPELLO
Checked By	Date	Bridge Design Supervisor	
M.W. OLSTAD	02/04	M.W. OLSTAD	Date 02/04
PROJECT	BENNINGTON-HOOSICK	PROJECT NO.	D.P.I. 0146(I) C/6
I.G.C. Info.			
Bridge Sheet No.	BR801	Sheet	63 OF 83



NOTE: UNLESS NOTED OTHERWISE, ALL STATIONS ARE IN KILOMETERS, ALL ELEVATIONS ARE IN METERS, AND ALL DIMENSIONS ARE IN MILLIMETERS.

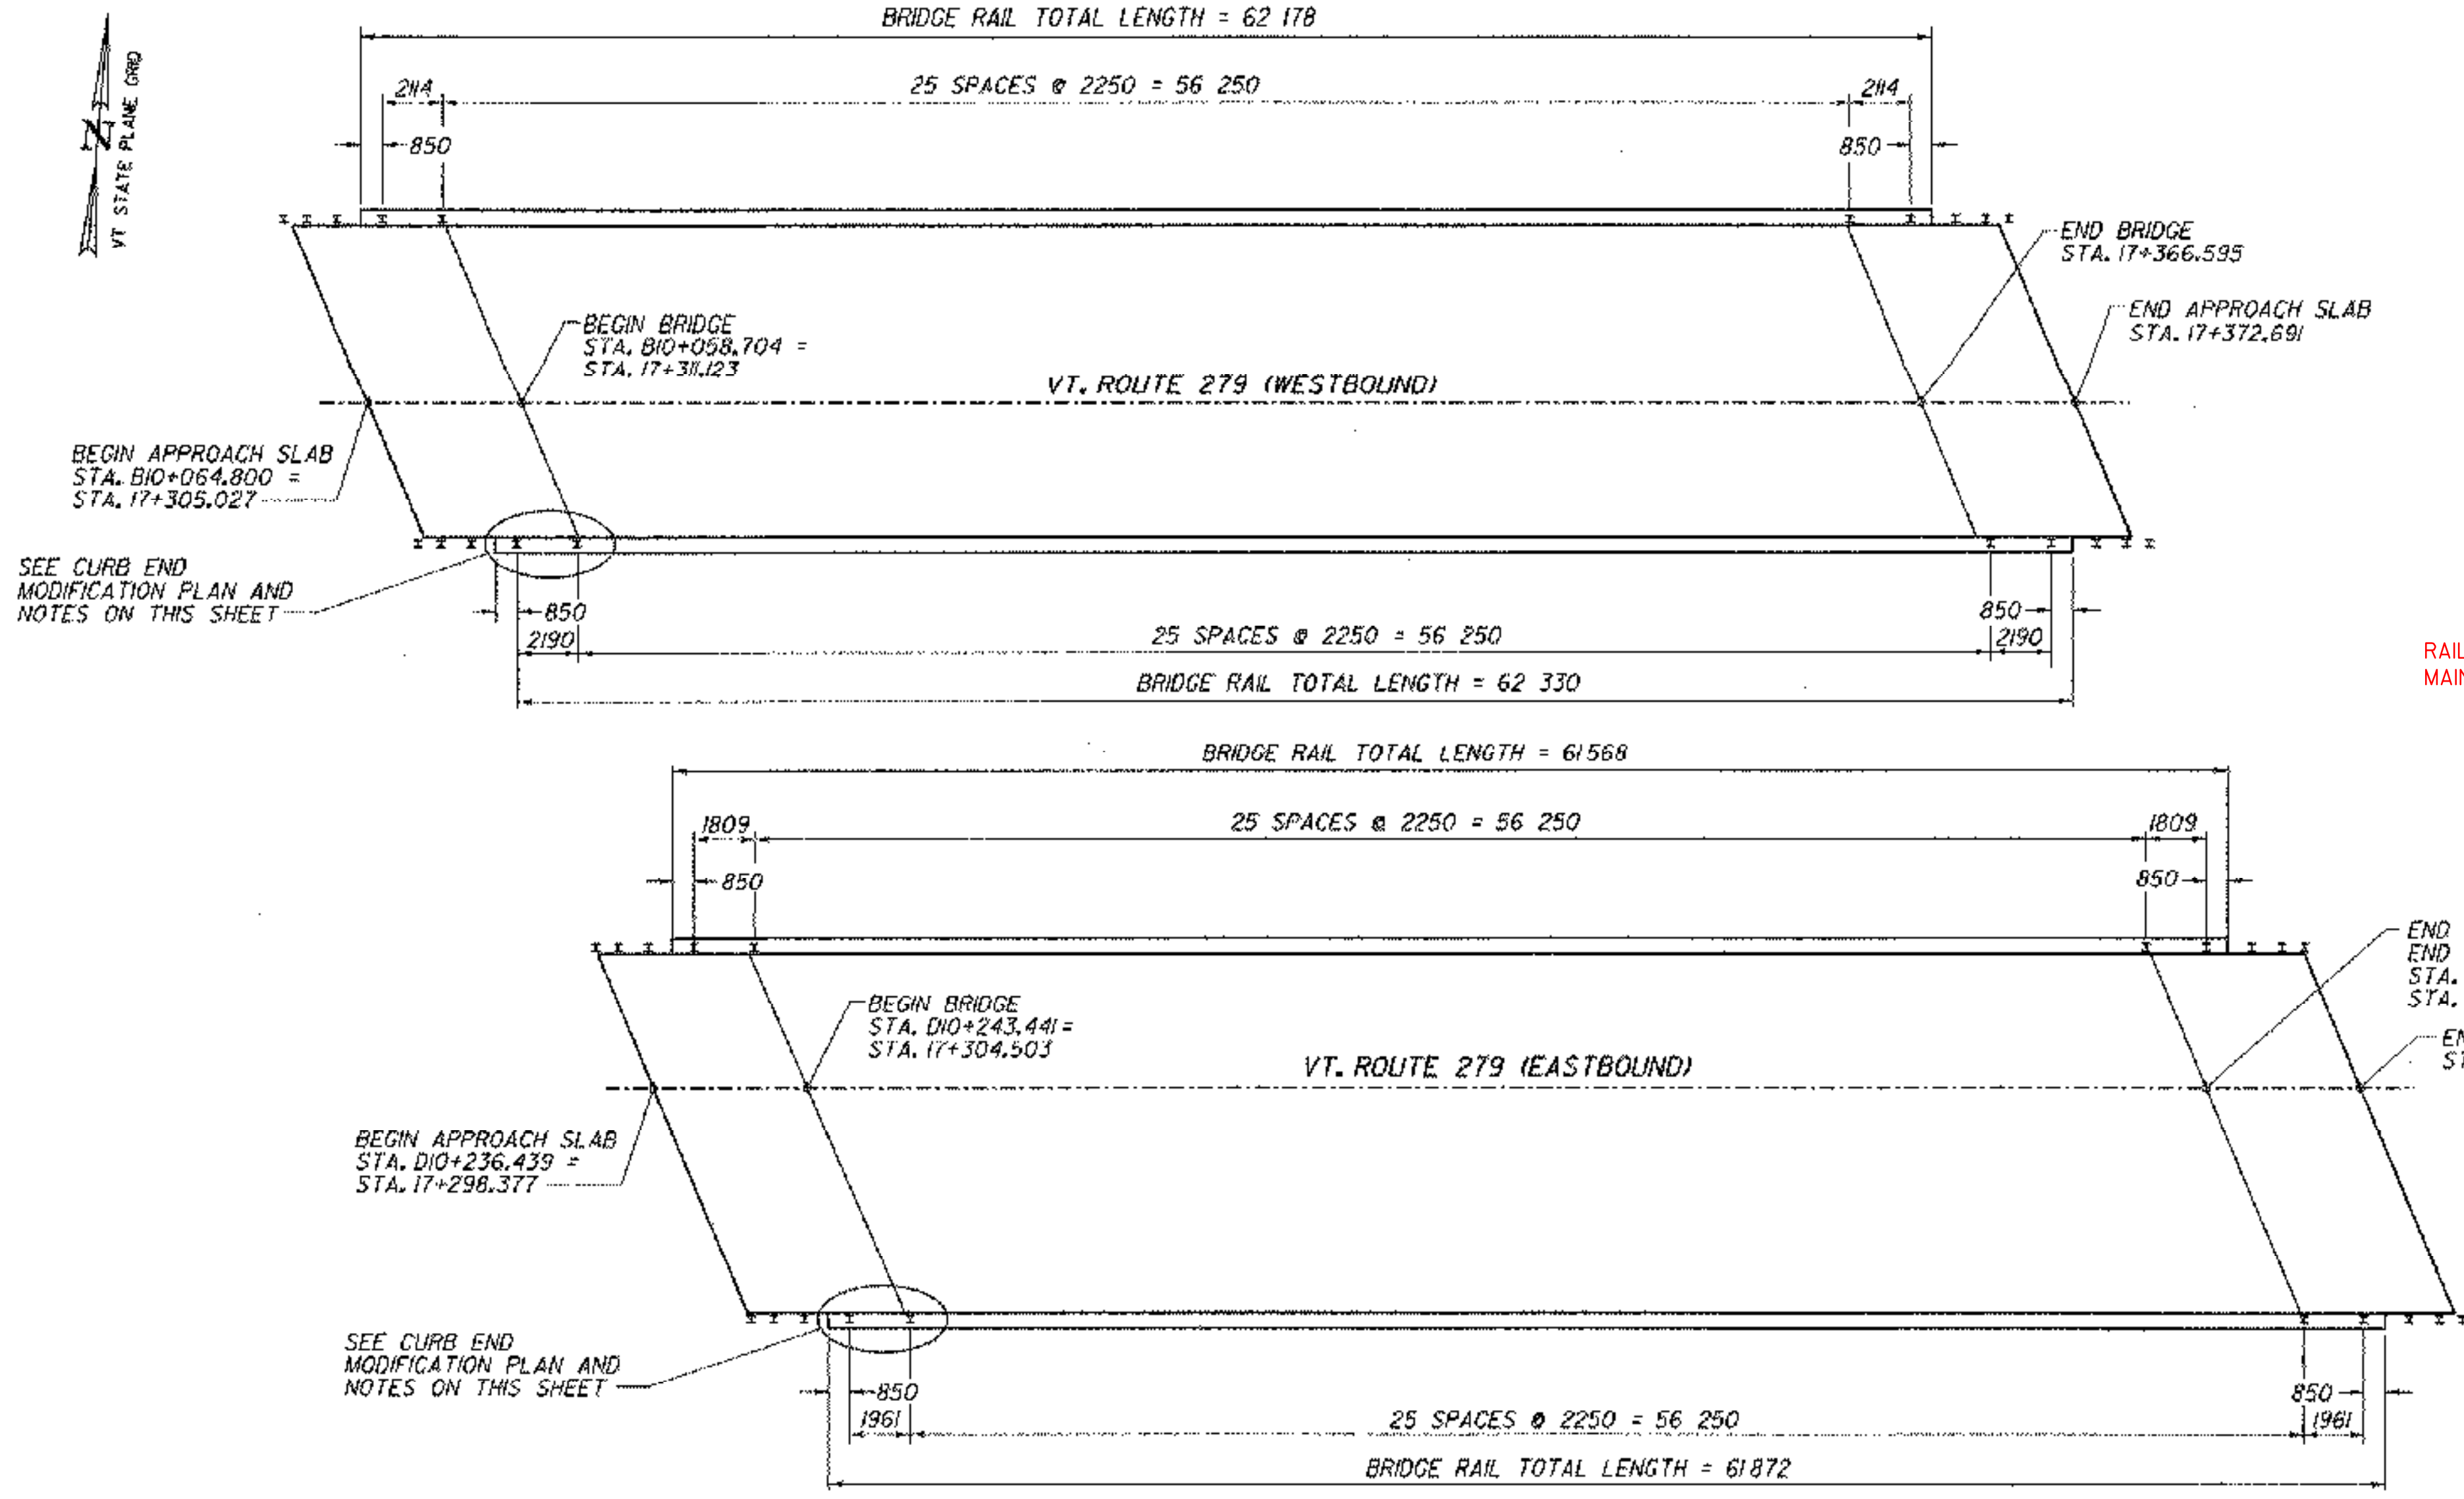

RAILING LAYOUT PLAN  
1:200

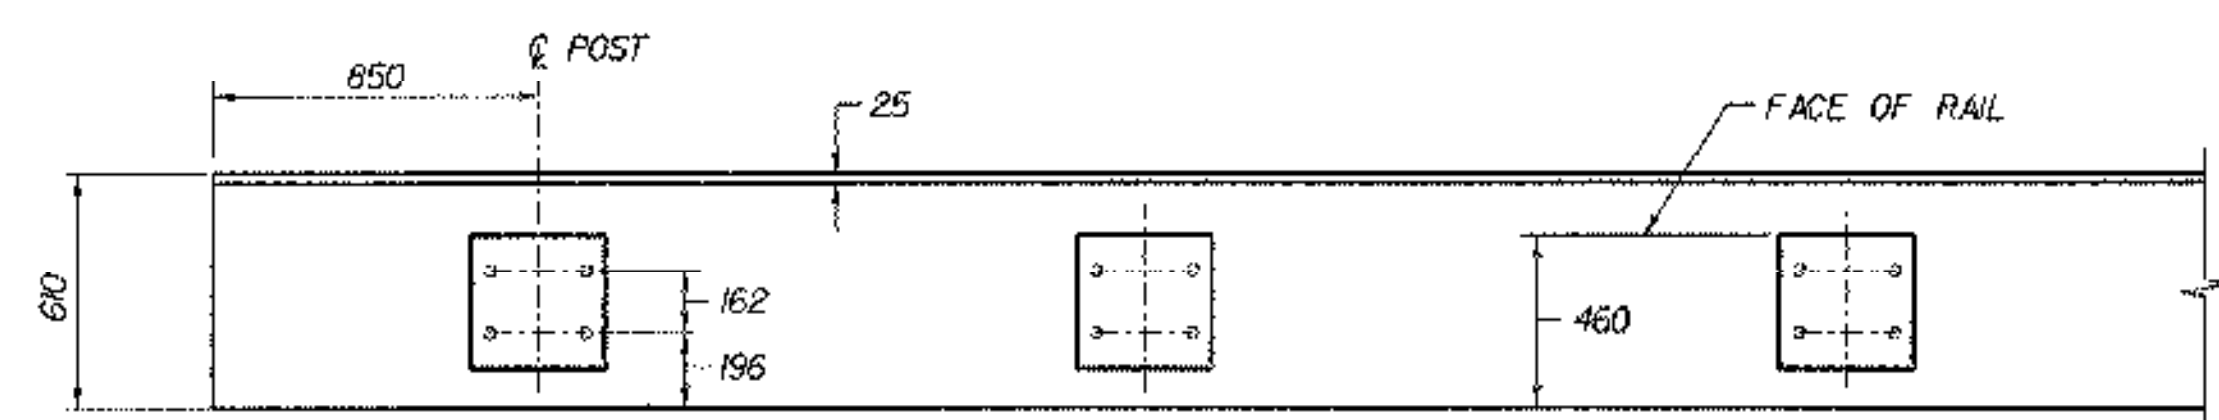

TYPICAL CURB END MODIFICATION PLAN  
1:200

**CURB END MODIFICATION NOTES:**


1. EXISTING CONCRETE SHALL BE SAW CUT 25 mm DEEP AT ENDS AND ALONG CENTER OF SCORE MARK BEFORE REMOVING.
2. REMOVAL OF CURBING AND CONCRETE AT EACH CORNER OF BRIDGE WILL BE PAID FOR UNDER ITEM 529.25, REMOVAL OF CONCRETE OR MASONRY.
3. EXISTING CONCRETE SHALL BE THOROUGHLY COATED WITH NEAT CEMENT PASTE BEFORE NEW CONCRETE IS POURED AS PER SUBSECTION 501J3B.
4. NEW CONCRETE IN CURB SECTIONS WILL BE CONCRETE, HIGH PERFORMANCE CLASS AA, ITEM 501J3C.

FILE NAME = s:\12592\instn\final\67a\br-g\railling.rvt  
DATE/TIME = 2/17/2004  
USER = 22226

**CHA CLOUGH, HARBOUR & ASSOCIATES LLP**  
ENGINEERS, ARCHITECTS, PLANNERS,  
LANDSCAPE ARCHITECTS  
WINNERS CIRCLE ALBANY, NEW YORK 12208  
518-453-4500

<b>STATE OF VERMONT AGENCY OF TRANSPORTATION</b>			
Town Of	BENNINGTON	Bridge No.	BR100 & BR200
Highway No.	VT. RTE. 279	Log Sta.	
		Surv. Sta.	17+331
VT. RTE. 279 OVER VT. ROUTE 67A			
<b>BRIDGE RAILING AND CURB DETAILS</b>			
Designed By	D. STECIAK	Drawn by	K. RAPELLO
Checked By	M.W. OLSTAD	Date	02/04
		Bridge Design Supervisor	M.W. OLSTAD
		Date	02/04
PROJECT	BENNINGTON-HOOSICK		PROJECT NO.
			D.P.J. 014610 C/6
I.G.C. Info.			
Bridge Sheet No.	BR803	Sheet 65 OF 83	

NOTE: UNLESS NOTED OTHERWISE, ALL STATIONS ARE IN KILOMETERS, ALL ELEVATIONS ARE IN METERS, AND ALL DIMENSIONS ARE IN MILLIMETERS.

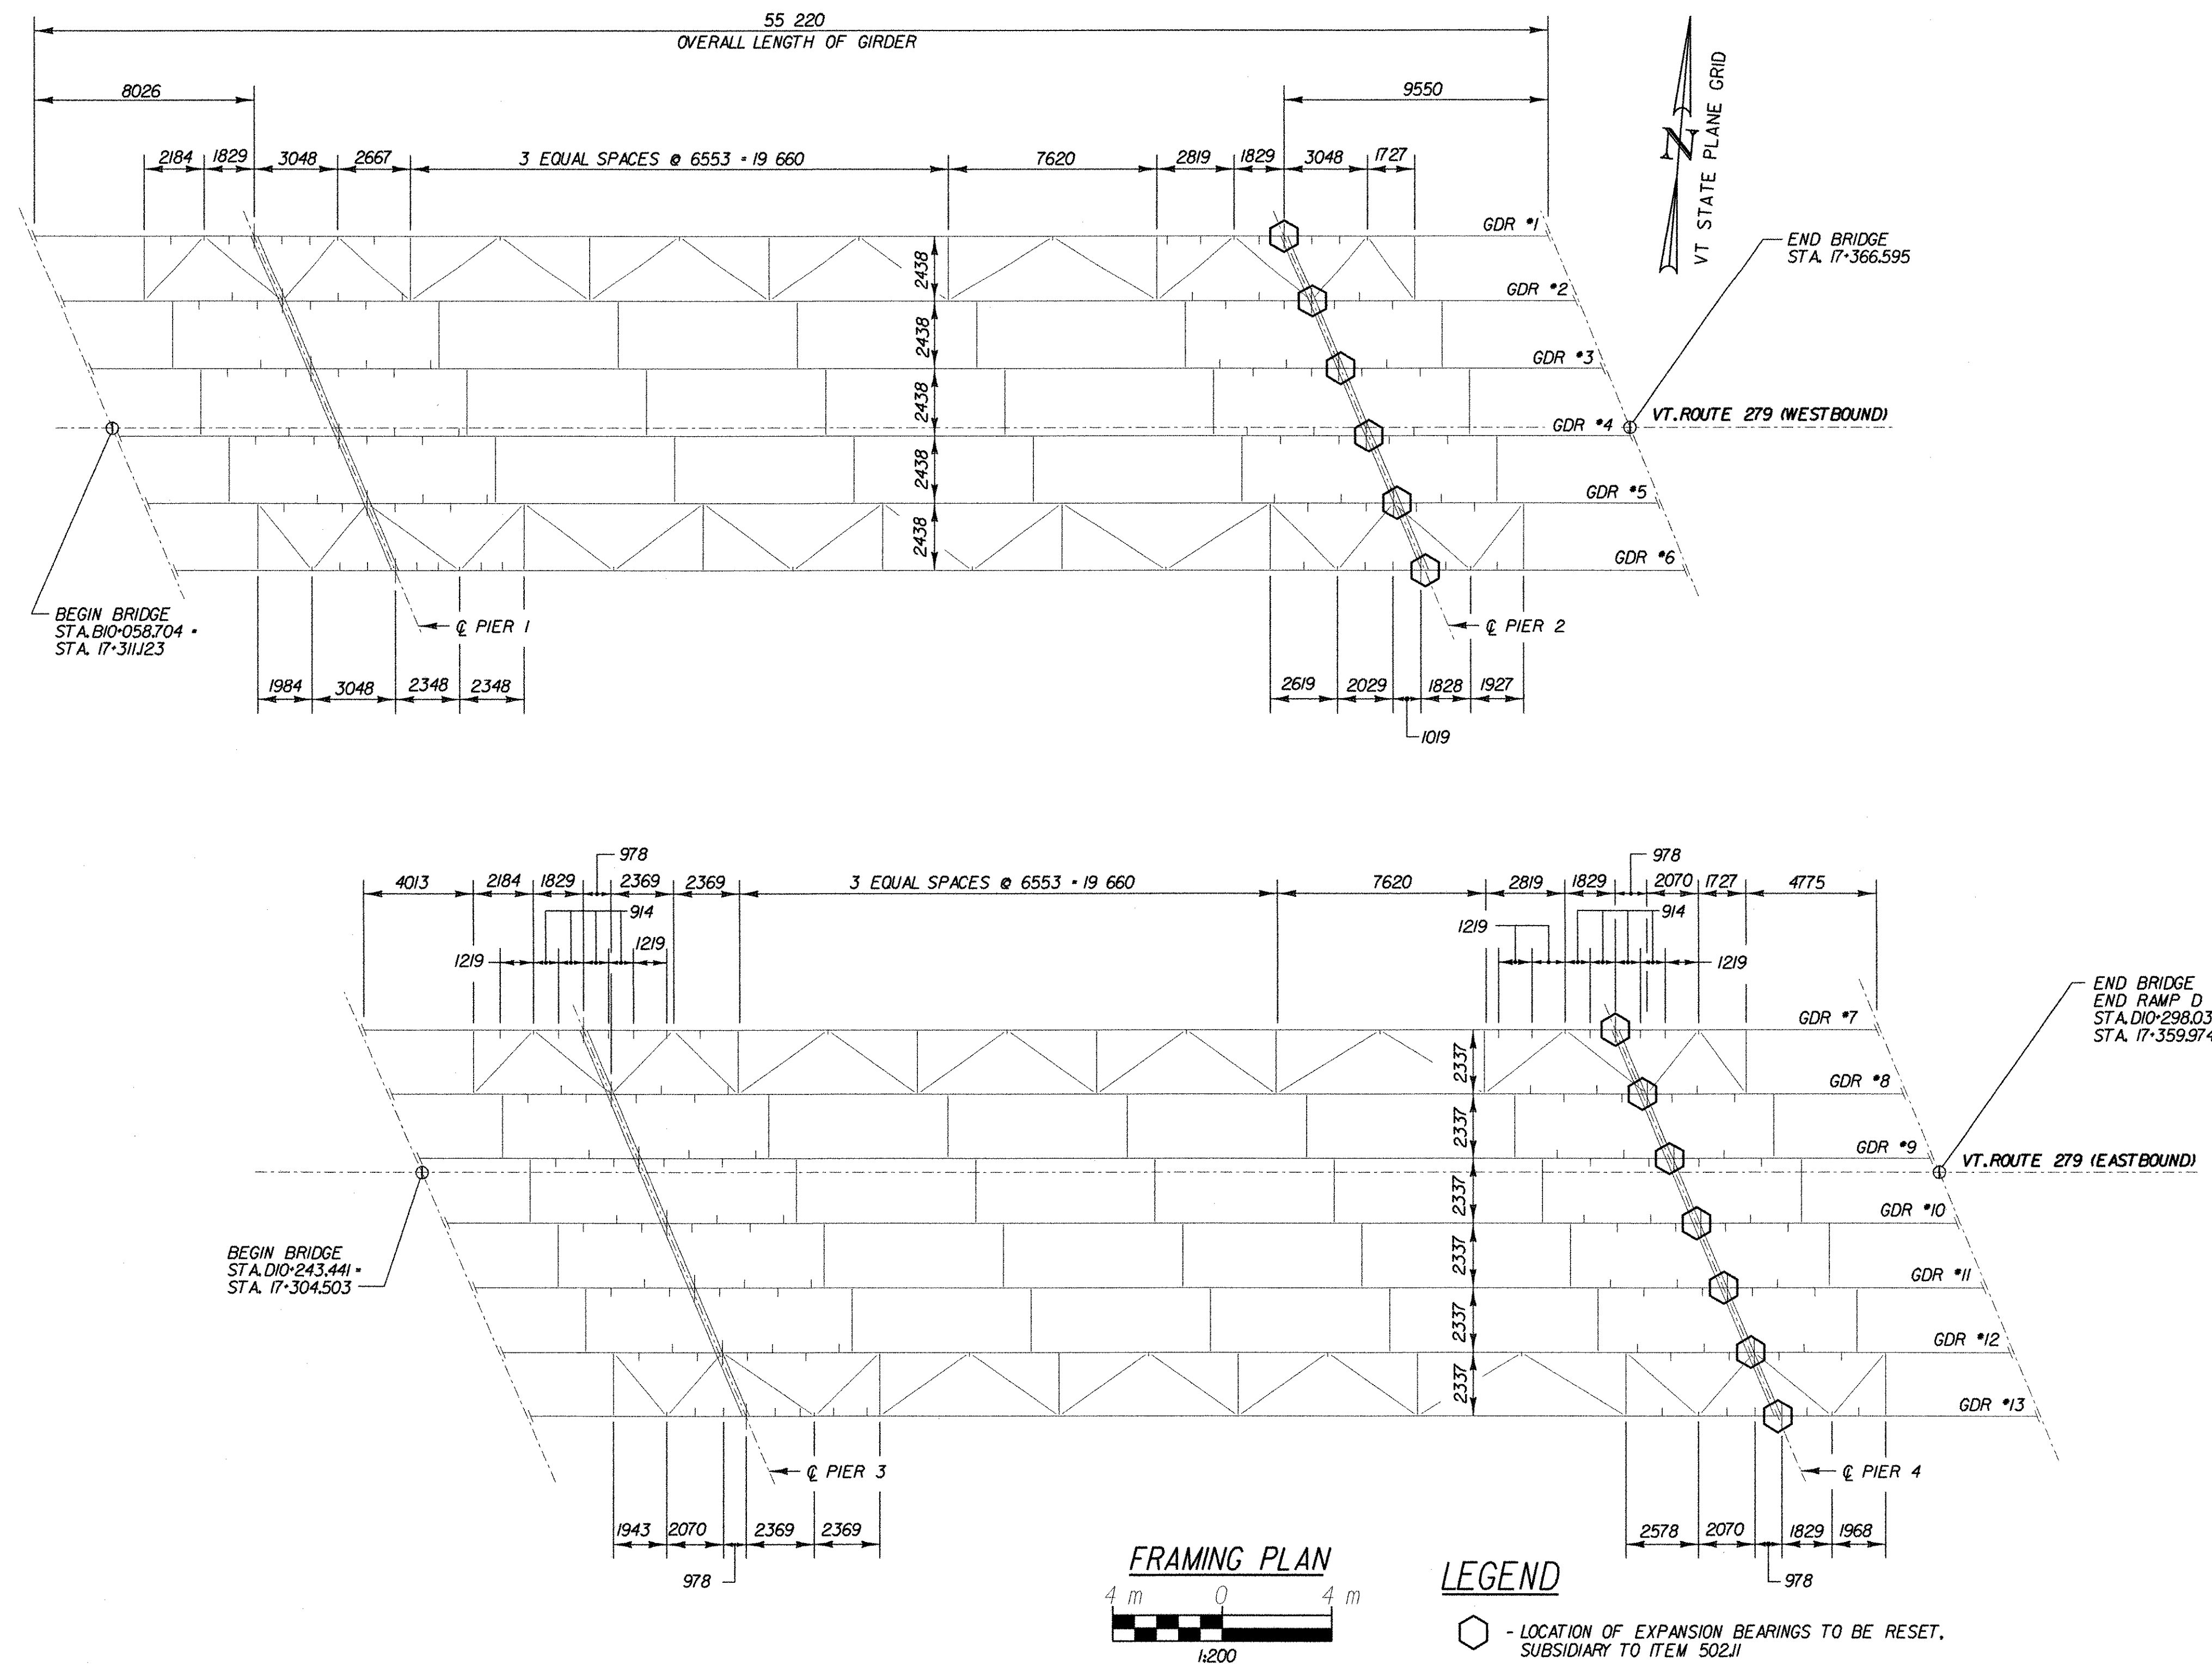


**NOTES:**

1. THE CONTRACTOR SHALL PROVIDE WELDING PROCEDURES TO THE VTRANS WELDING INSPECTOR FOR APPROVAL PRIOR TO STARTING ANY WELDING ON THE BRIDGE.
2. NO WELDING SHALL TAKE PLACE UNLESS THE VTRANS WELDING INSPECTOR OR HIS REPRESENTATIVE IS PRESENT.
3. BEARING SOLE PLATE IS TO BE REATTACHED TO THE GIRDER BOTTOM FLANGE WITH A 1/2" FILLET FIELD WELD ON EACH SIDE.
4. DEADLOAD JACKING FORCE IS APPROXIMATELY 785 kN PER BEARING.


<b>STATE OF VERMONT AGENCY OF TRANSPORTATION</b>			
Town Of	BENNINGTON	Bridge No.	BRI00 & BRI200
Highway No.	VT. RTE. 279	Log Sta.	
		Surv. Sta.	17+331
VT. RTE. 279 OVER VT. ROUTE 67A			
<b>FRAMING PLAN AND STEEL DETAILS</b>			
Designed By	D. STECIAK	Drawn by	K. RAPELLO
Checked By	M.W. OLSTAD	Date	02/04
		Bridge Design Supervisor	M.W. OLSTAD
		Date	02/04
PROJECT	BENNINGTON-HOOSICK		PROJECT NO. D.P.I. 0146(I) C/6
I.G.C. Info.			
Bridge Sheet No.	BR804	Sheet	66 OF 83

NOTE: UNLESS NOTED OTHERWISE, ALL STATIONS ARE IN KILOMETERS, ALL ELEVATIONS ARE IN METERS, AND ALL DIMENSIONS ARE IN MILLIMETERS.

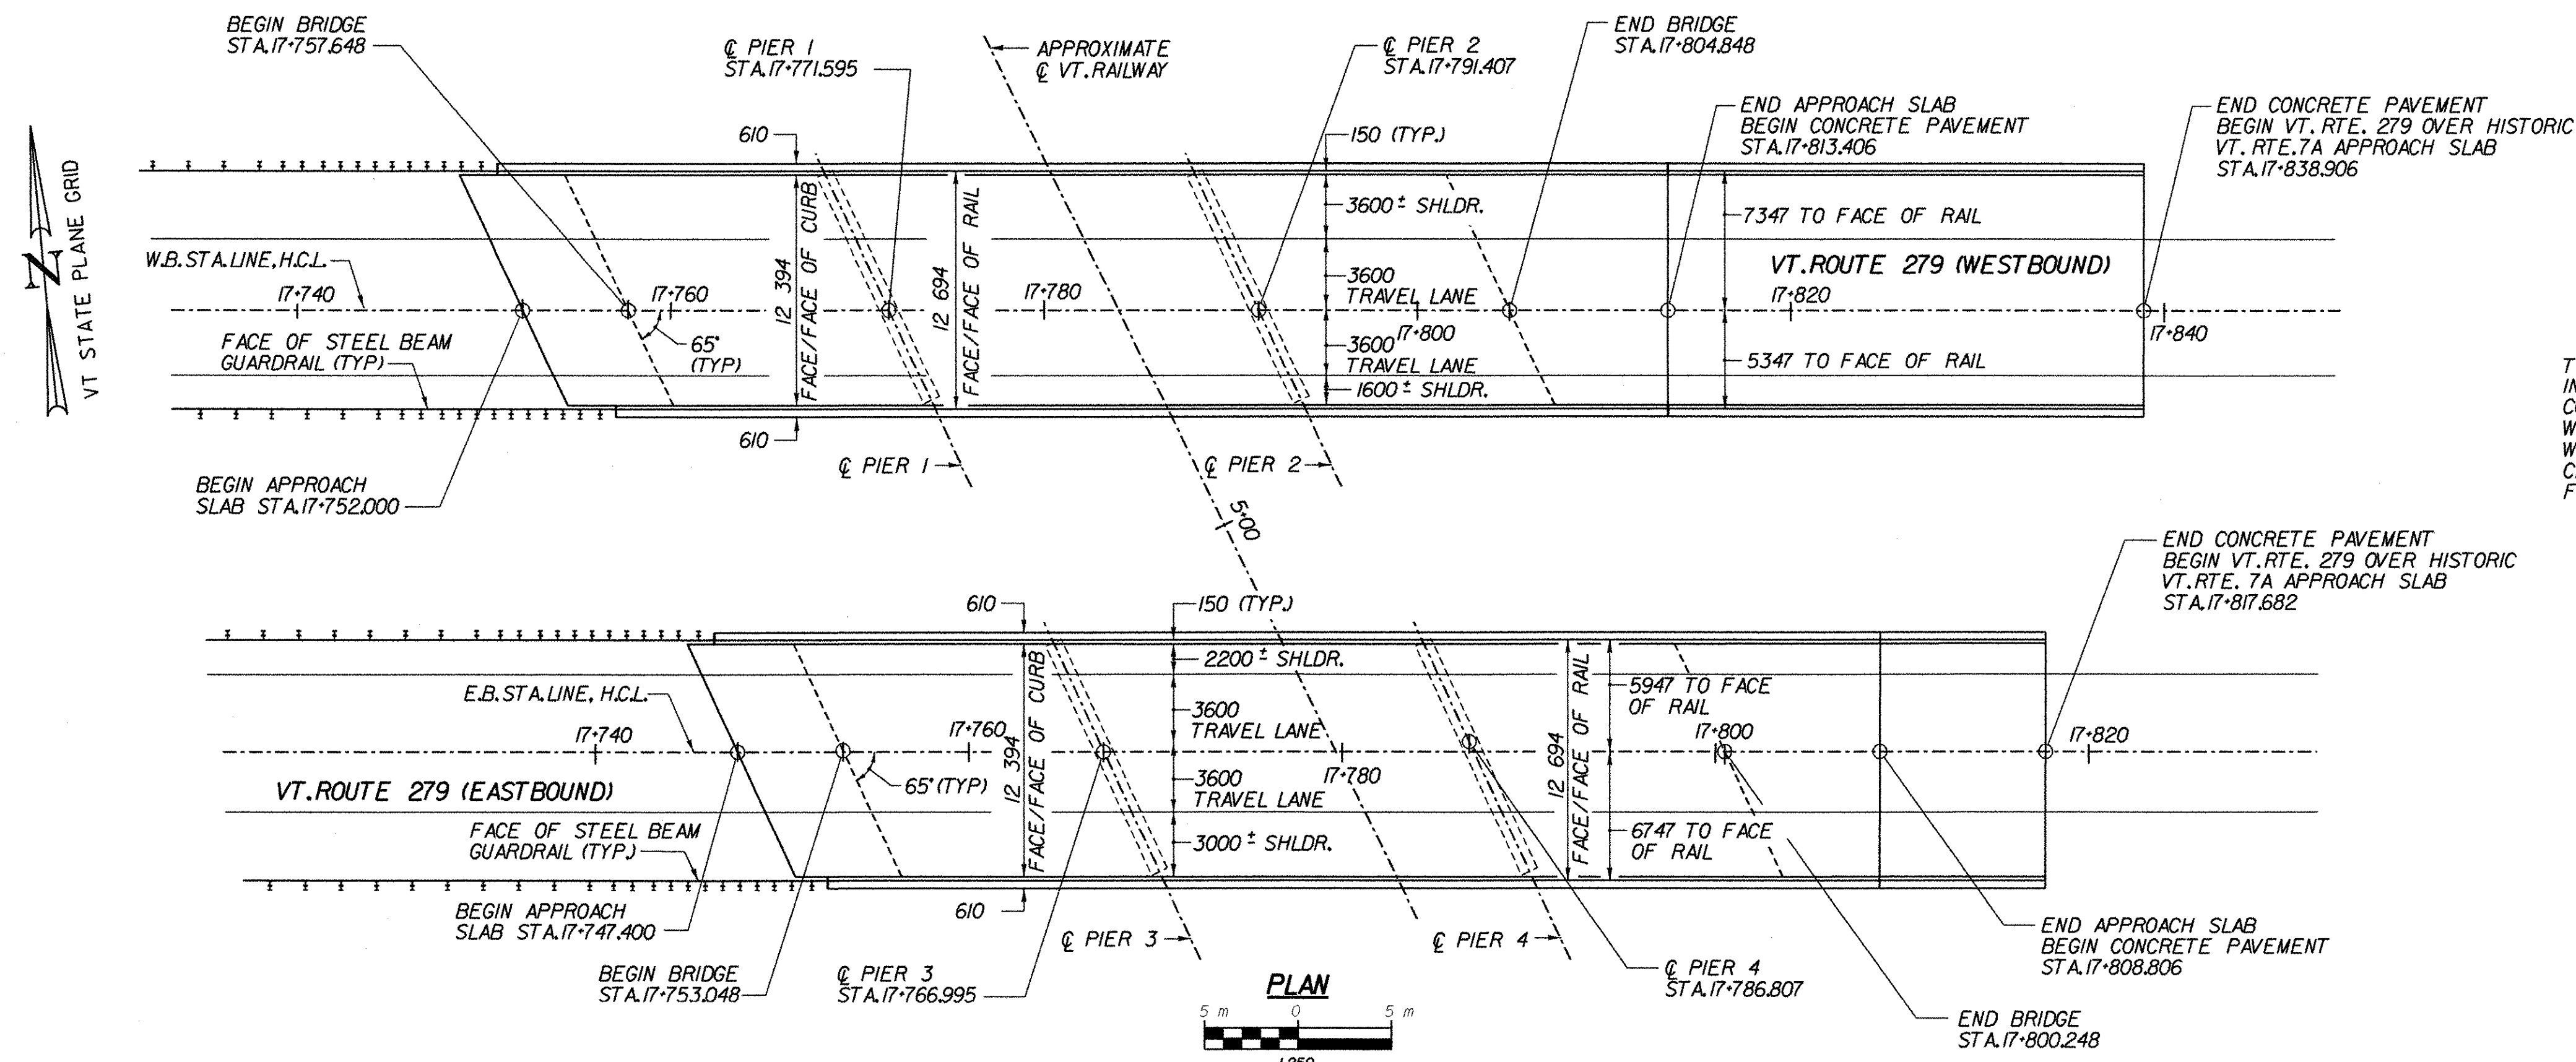

THESE CONTRACT DOCUMENTS HAVE BEEN PREPARED BASED ON LIMITED FIELD INVESTIGATION AND RECORD DRAWINGS AVAILABLE AT THE TIME. ACTUAL FIELD CONDITIONS MAY REQUIRE MODIFICATIONS TO THE CONSTRUCTION DETAILS AND WORK QUANTITIES. THE CONTRACTOR SHALL PERFORM THE WORK IN ACCORDANCE WITH FIELD CONDITIONS. ALL DIMENSIONS AND JOINT LOCATIONS SHALL BE FIELD CHECKED BY THE CONTRACTOR PRIOR TO SUBMISSION OF FABRICATION DRAWINGS FOR APPROVAL.

LIST OF BRIDGE SHEETS	
BRI100	PLAN AND ELEVATION
BRI101	EXISTING TRANSVERSE BRIDGE SECTIONS
BRI102	BRIDGE QUANTITY SHEET
BRI103	BRIDGE RAILING AND CURB DETAILS
BRI104	EXPANSION JOINTS AT WEST ABUTMENTS
BRI105	JOINT DETAILS
BRI106	BEARING LAYOUT PLAN AND DETAILS
BRI107	PEDESTAL DETAILS

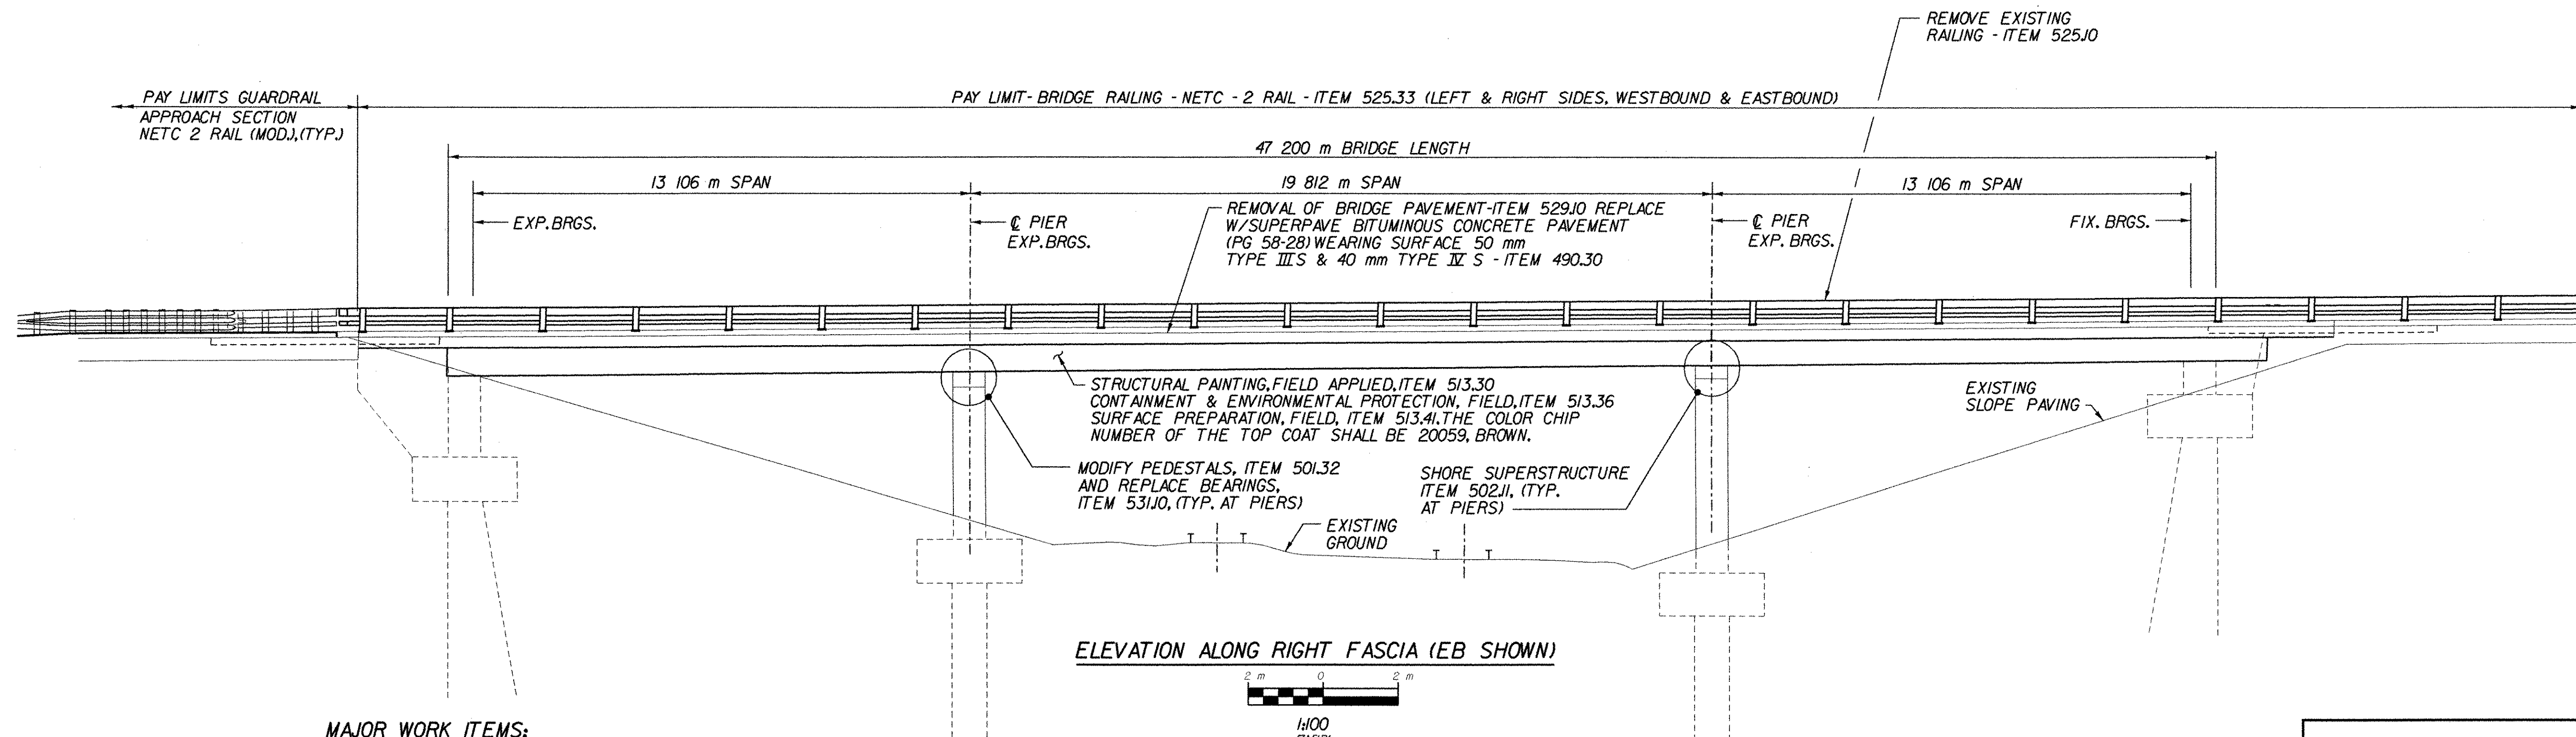

- MAJOR WORK ITEMS:**
1. REMOVE EXISTING RAILING AND REPLACE WITH BRIDGE RAILING - NETC 2 RAIL.
  2. REMOVE EXISTING BRIDGE CURB AND REPLACE WITH CONCRETE CURB.
  3. REMOVE EXISTING BITUMINOUS PAVEMENT AND REPLACE WITH SUPERPAVE BITUMINOUS PAVEMENT.
  4. REPAIR CONCRETE DECK AS NEEDED.
  5. CLEAN AND PAINT SUPERSTRUCTURE.
  6. SHORE SUPERSTRUCTURE, MODIFY ALL PIER PEDESTALS AND REPLACE ALL PIER BEARINGS.


**STATE OF VERMONT  
AGENCY OF TRANSPORTATION**

Town Of	BENNINGTON	Bridge No.	BRI100
Highway No.	VT. RTE. 279	Log Sta.	
		Surv. Sta.	17+780
VT. RTE. 279 OVER VT. RAILWAY			
PLAN AND ELEVATION			
Designed By	D. STECIAK	Drawn by	K. RAPELLO
Checked By	M.W. OLSTAD	Date	02/04
		Bridge Design Supervisor	M.W. OLSTAD
		Date	02/04
PROJECT	BENNINGTON-HOOSICK		PROJECT NO. D.P.I. 0146(I) C/6
I.G.C. Info.			
Bridge Sheet No.	BRI100	Sheet	67 OF 83


**CHA CLOUGH, HARBOUR & ASSOCIATES LLP**  
ENGINEERS, SURVEYORS, PLANNERS & LANDSCAPE ARCHITECTS  
11 WINNERS CIRCLE - ALBANY, NEW YORK - 12205  
518-453-4500

FILE NAME = s:\12502\mstn\final\rr\brg\rr-ple1.pit  
DATE/TIME = 2/17/2004  
USER = 2225

NOTE: UNLESS NOTED OTHERWISE, ALL STATIONS ARE IN KILOMETERS, ALL ELEVATIONS ARE IN METERS, AND ALL DIMENSIONS ARE IN MILLIMETERS.

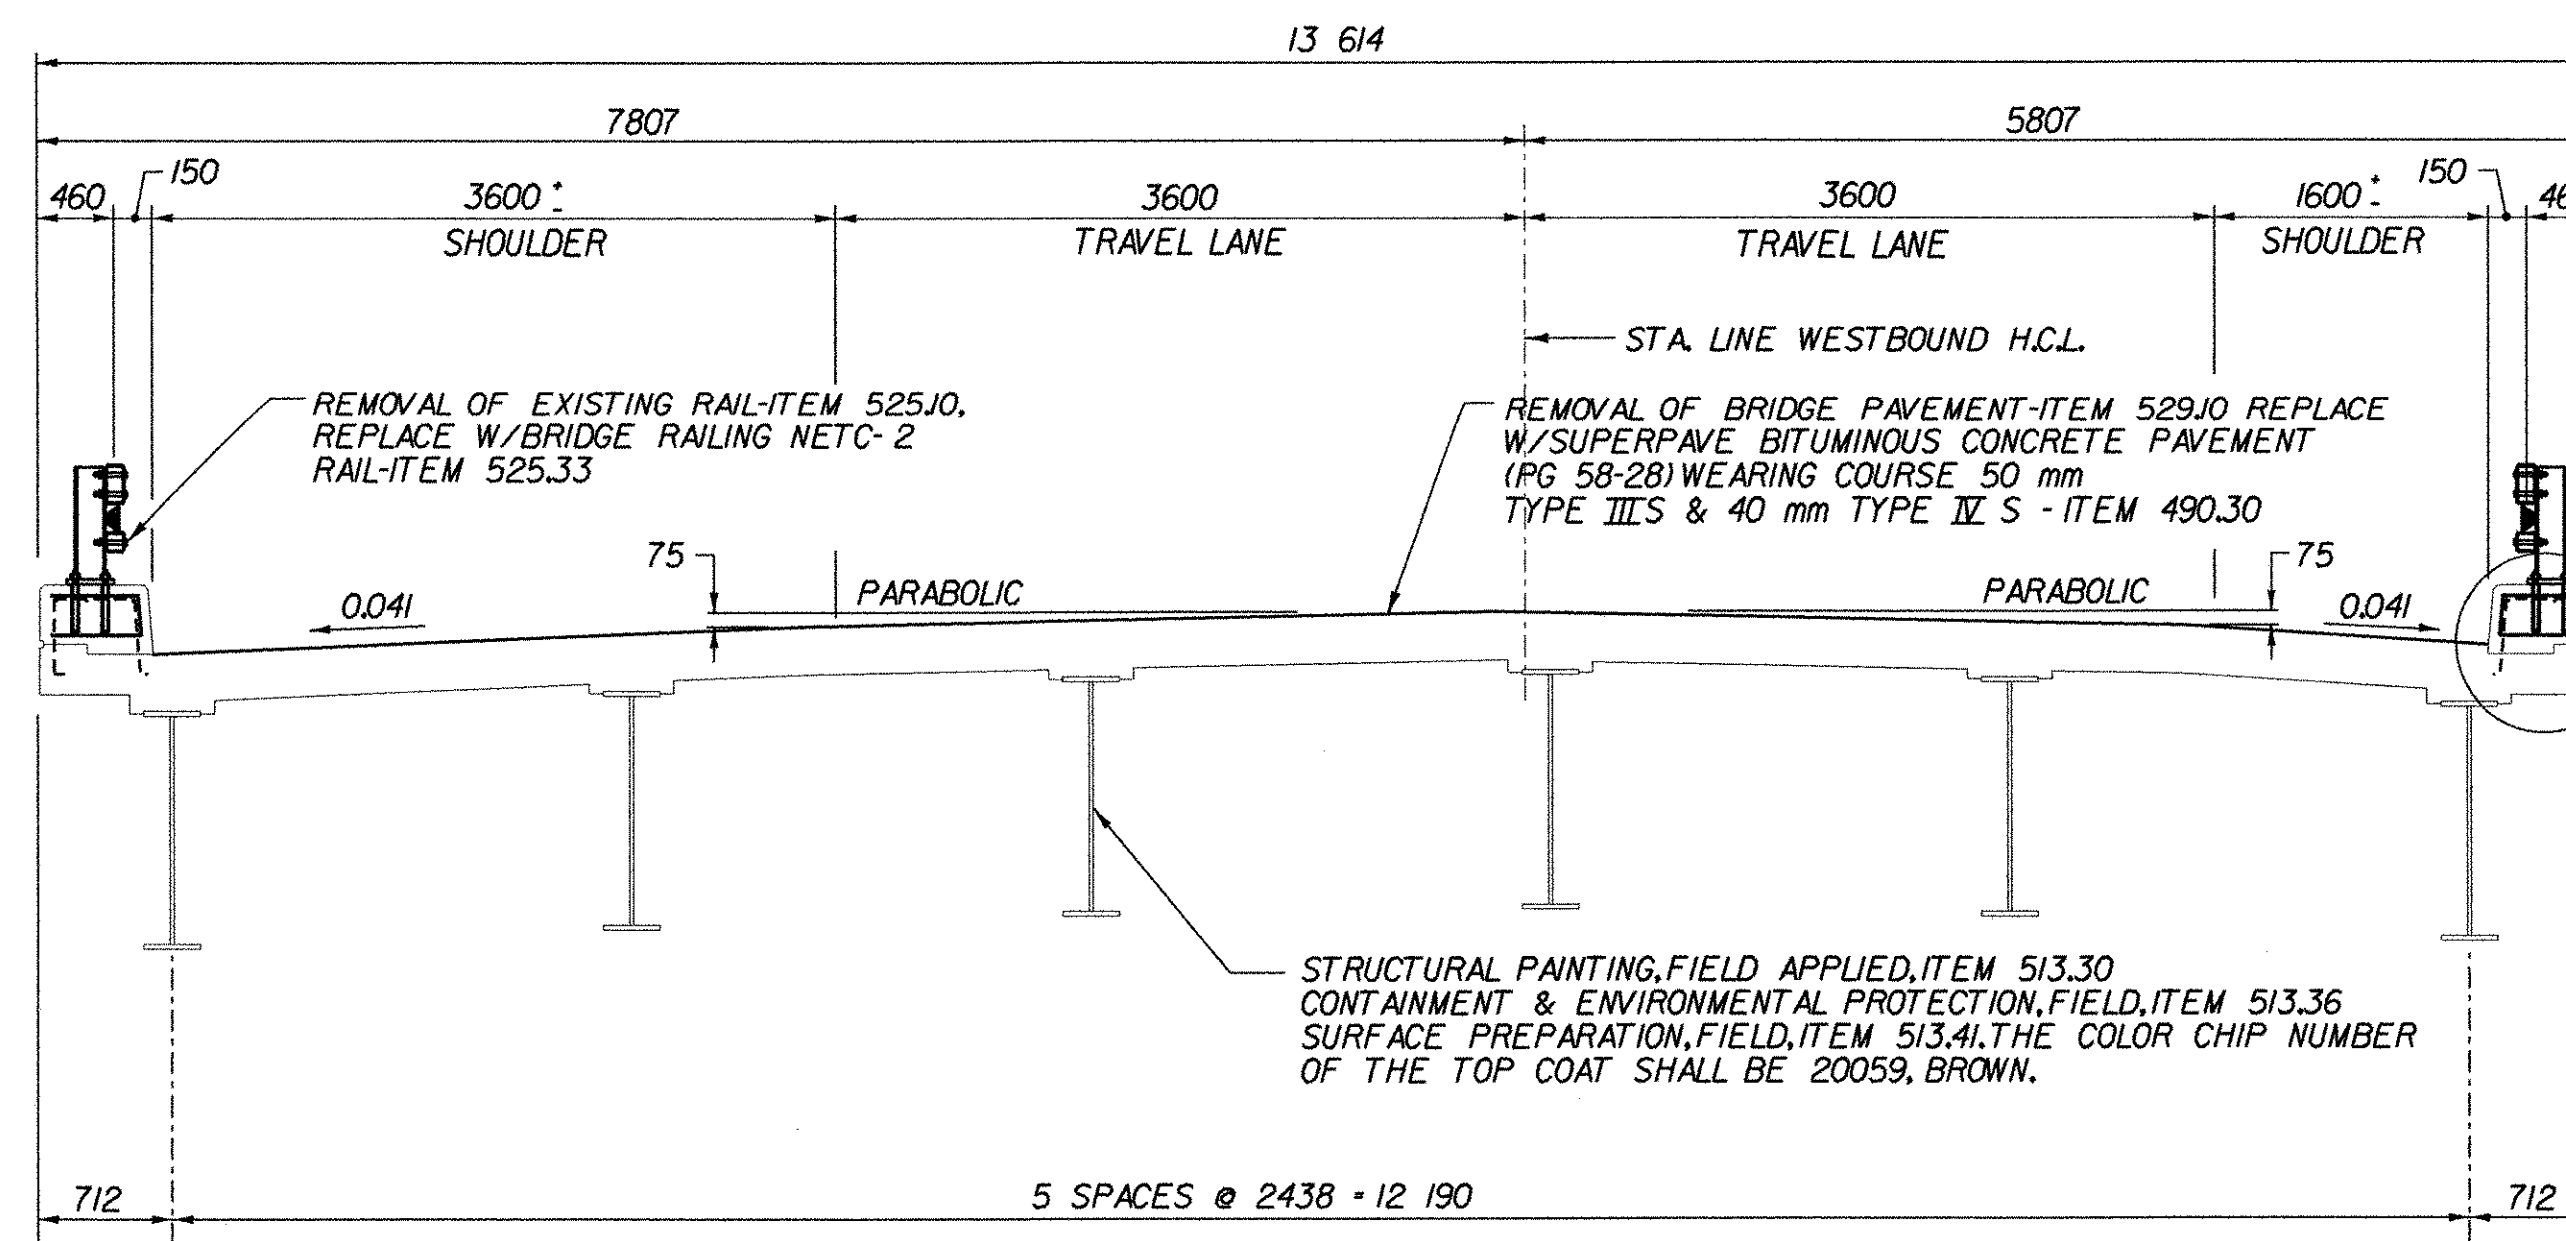


TYPICAL BRIDGE SECTION (WESTBOUND)

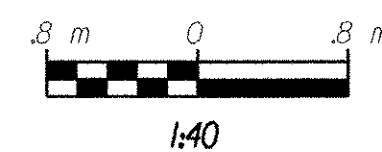


**RAILING ANCHORAGE NOTES:**

- NEW ASTM A449-22 mm DIAMETER ANCHOR BOLTS TO BE CAST-IN-PLACE SHALL BE FURNISHED WITH TWO NUTS AND ONE WASHER. BOLTS, NUTS AND WASHERS SHALL BE FURNISHED UNDER ITEM 525.33. BRIDGE RAILING-NETC 2 RAIL.

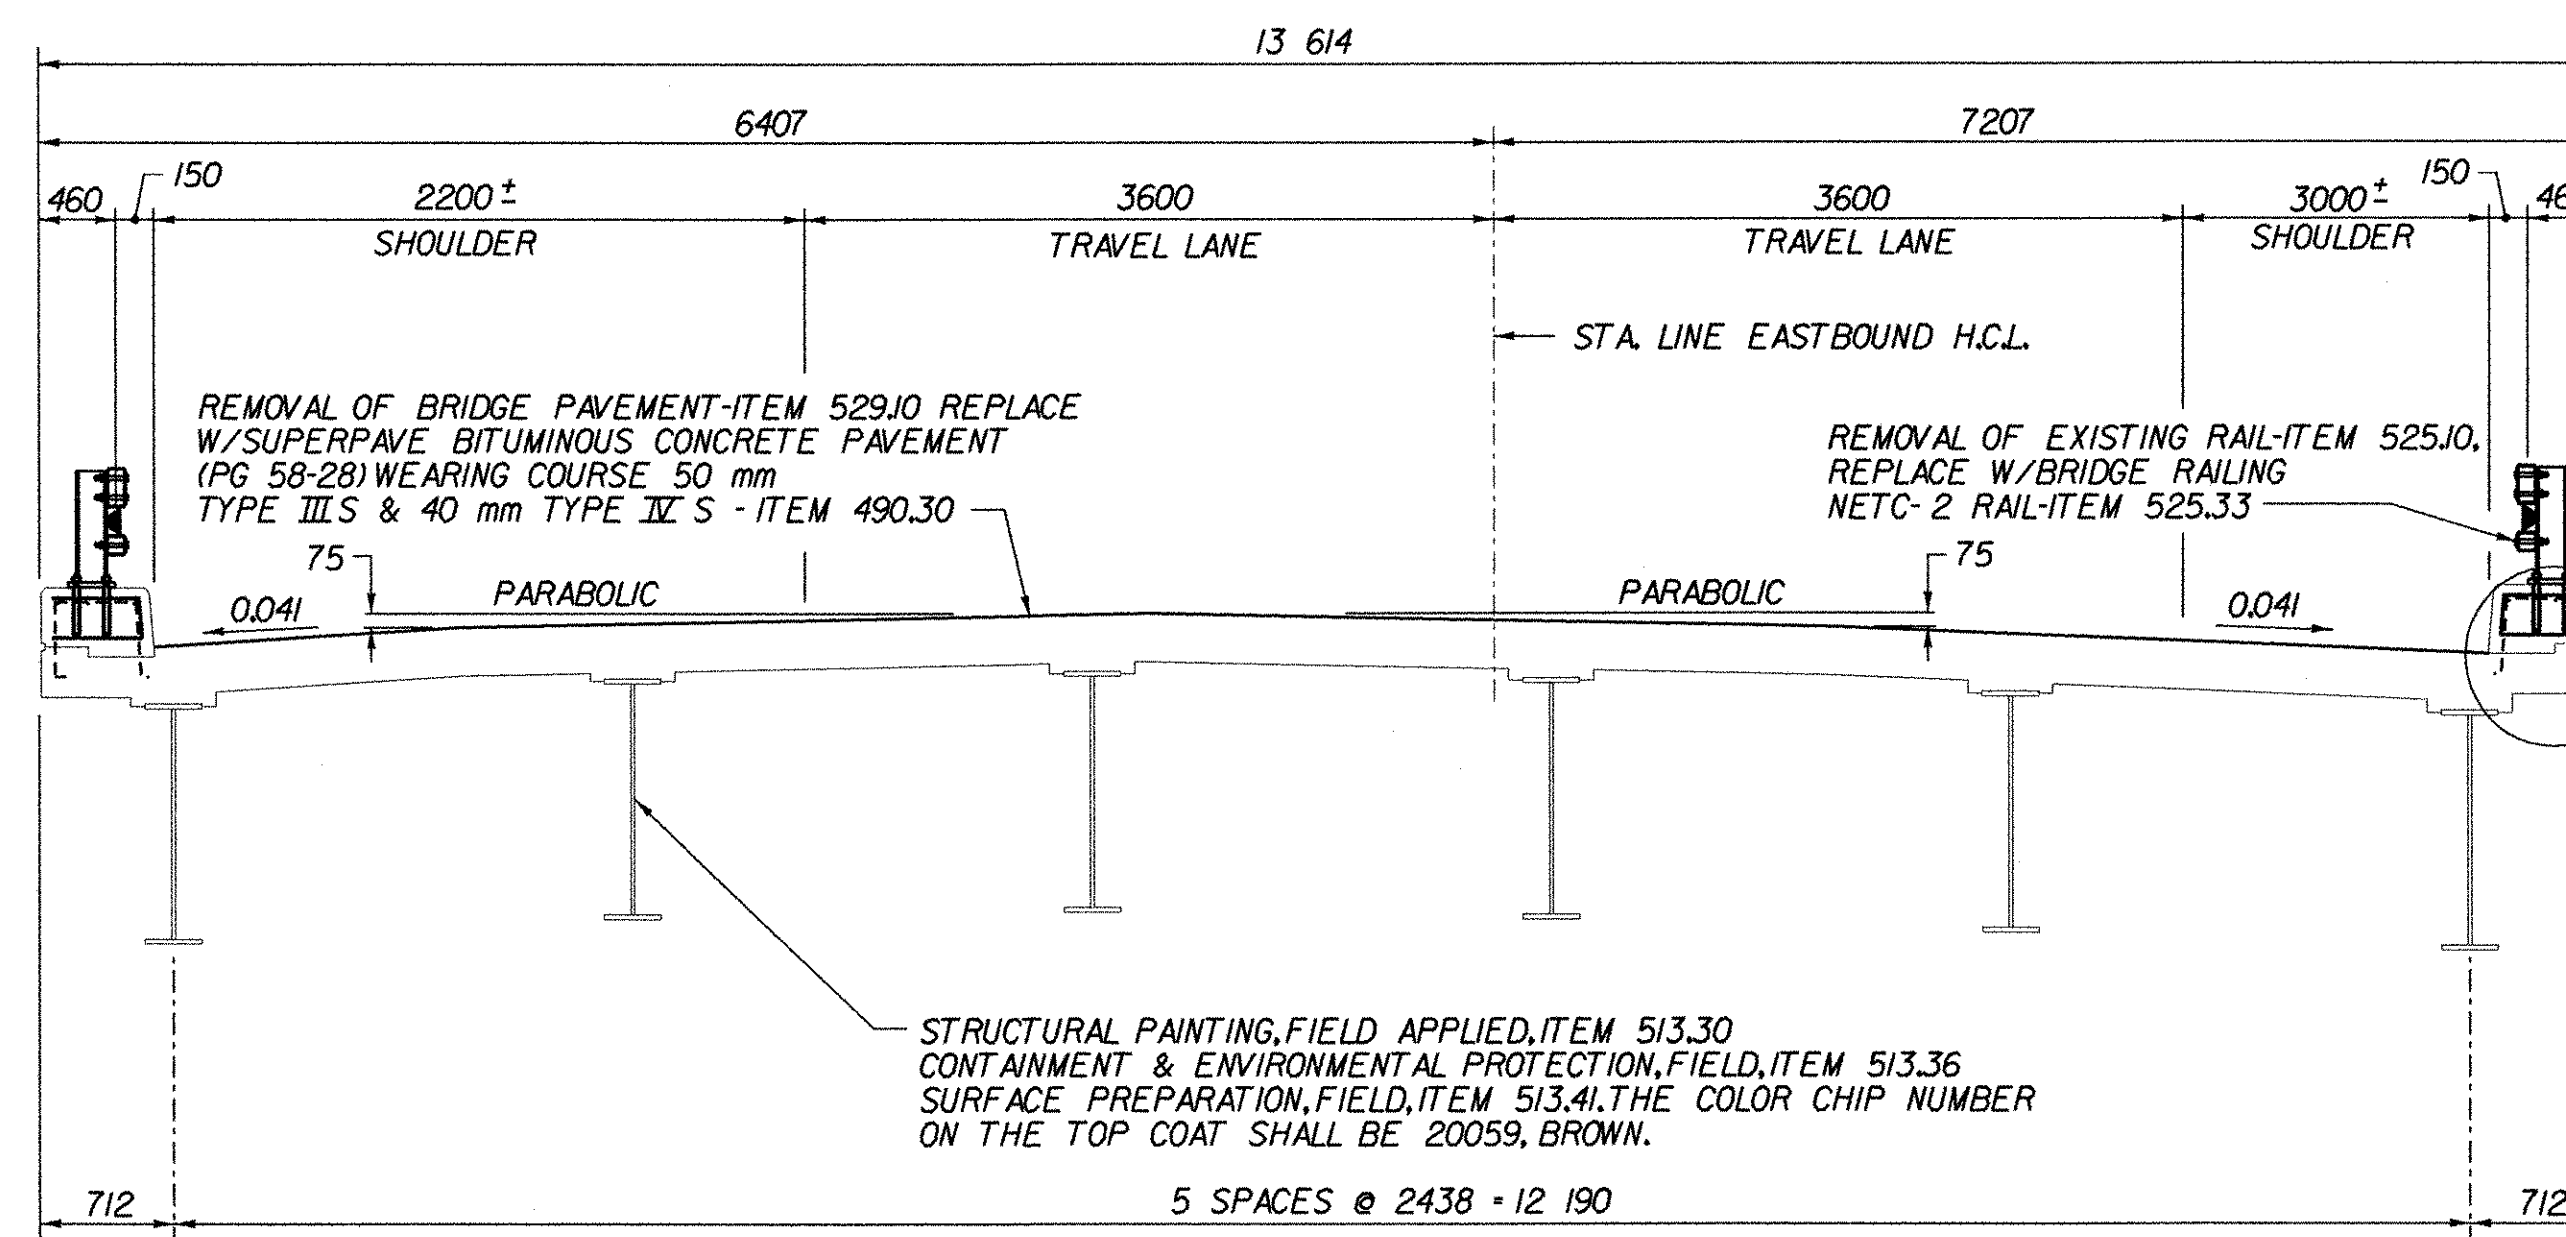

TYPICAL BRIDGE SECTION (EASTBOUND)

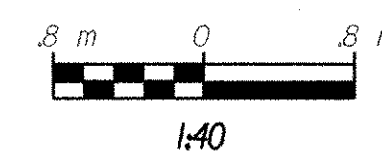

**NOTES:**

- SEE SHEET NO. BR3 FOR ASPHALT OVERLAY REMOVAL AND REPLACEMENT NOTES AND FOR DECK SLAB REPAIR DETAILS.
- SEE SHEET NO. BR2 FOR CURB REMOVAL AND REPLACEMENT DETAILS.

LOADING LEVELS (LOAD FACTOR)	LOAD FACTOR LOAD RATING (METRIC TONS)						
	M	MS	3S2	6 AXLE	3A,STR.	4A,STR.	5A,SEMI
INVENTORY							
A = 2.17, B = 1.00	20	36					
POSTED							
A = 1.55, B = 1.80	28	51	56		50	55	62
OPERATING							
A = 1.30, B = 1.67		61	67	66	54	58	
$RF = \frac{\phi M_n - 1.3 M_{DL}}{A \times M_{LL} + I}$ $*SERVICEABILITY RF = B \left[ \frac{.95 F_y S_{LL} + I - M_{DL} \frac{S_{LL} + I}{S_{DL}} - M_{SOL} \frac{S_{LL} + I}{S_{SDL}}}{1.67 M_{LL} + I} \right]$							
PROJECTED TRAFFIC DATA							
YEAR	ADT	DHV	% D	% T	ADTT		
2000	5300	-	-	-	-		
2020	6600	840	52%	7%	460		

20 YEAR ESAL FOR FLEXIBLE PAVEMENT FROM 2000 TO 2020 = 4,625,000  
40 YEAR ESAL FOR FLEXIBLE PAVEMENT FROM 2000 TO 2040 = 17,229,000  
DESIGN SPEED: 100 km/h

**STATE OF VERMONT**  
**AGENCY OF TRANSPORTATION**





Town Of	BENNINGTON	Bridge No.	BRI100
Highway No.	VT. RTE. 279	Log Sta.	
		Surv. Sta.	17+780
VT. RTE. 279 OVER VT. RAILWAY			
EXISTING TRANSVERSE BRIDGE SECTIONS			
Designed By	D. STECIAK	Drawn by	K. RAPELLO
Checked By	M.W. OLSTAD	Date	02/04
		Bridge Design Supervisor	M.W. OLSTAD
		Date	02/04
PROJECT	BENNINGTON-HOOSICK		PROJECT NO.
			D.P.I. 0146(1) C/6
I.G.C. Info.			
Bridge Sheet No.	BRI101	Sheet	68 OF 83

**CHA CLOUGH, HARBOUR & ASSOCIATES LLP**  
ENGINEERS, SURVEYORS, PLANNERS & LANDSCAPE ARCHITECTS  
111 WINNERS CIRCLE - ALBANY, NEW YORK 12205  
518-453-4500

FILE NAME = ut\125002\mstn\final\rr\brg\transht.plt  
DATE/TIME = 2/17/2004  
USER = 2225



NOTE: UNLESS NOTED OTHERWISE, ALL STATIONS ARE IN KILOMETERS, ALL ELEVATIONS ARE IN METERS, AND ALL DIMENSIONS ARE IN MILLIMETERS.

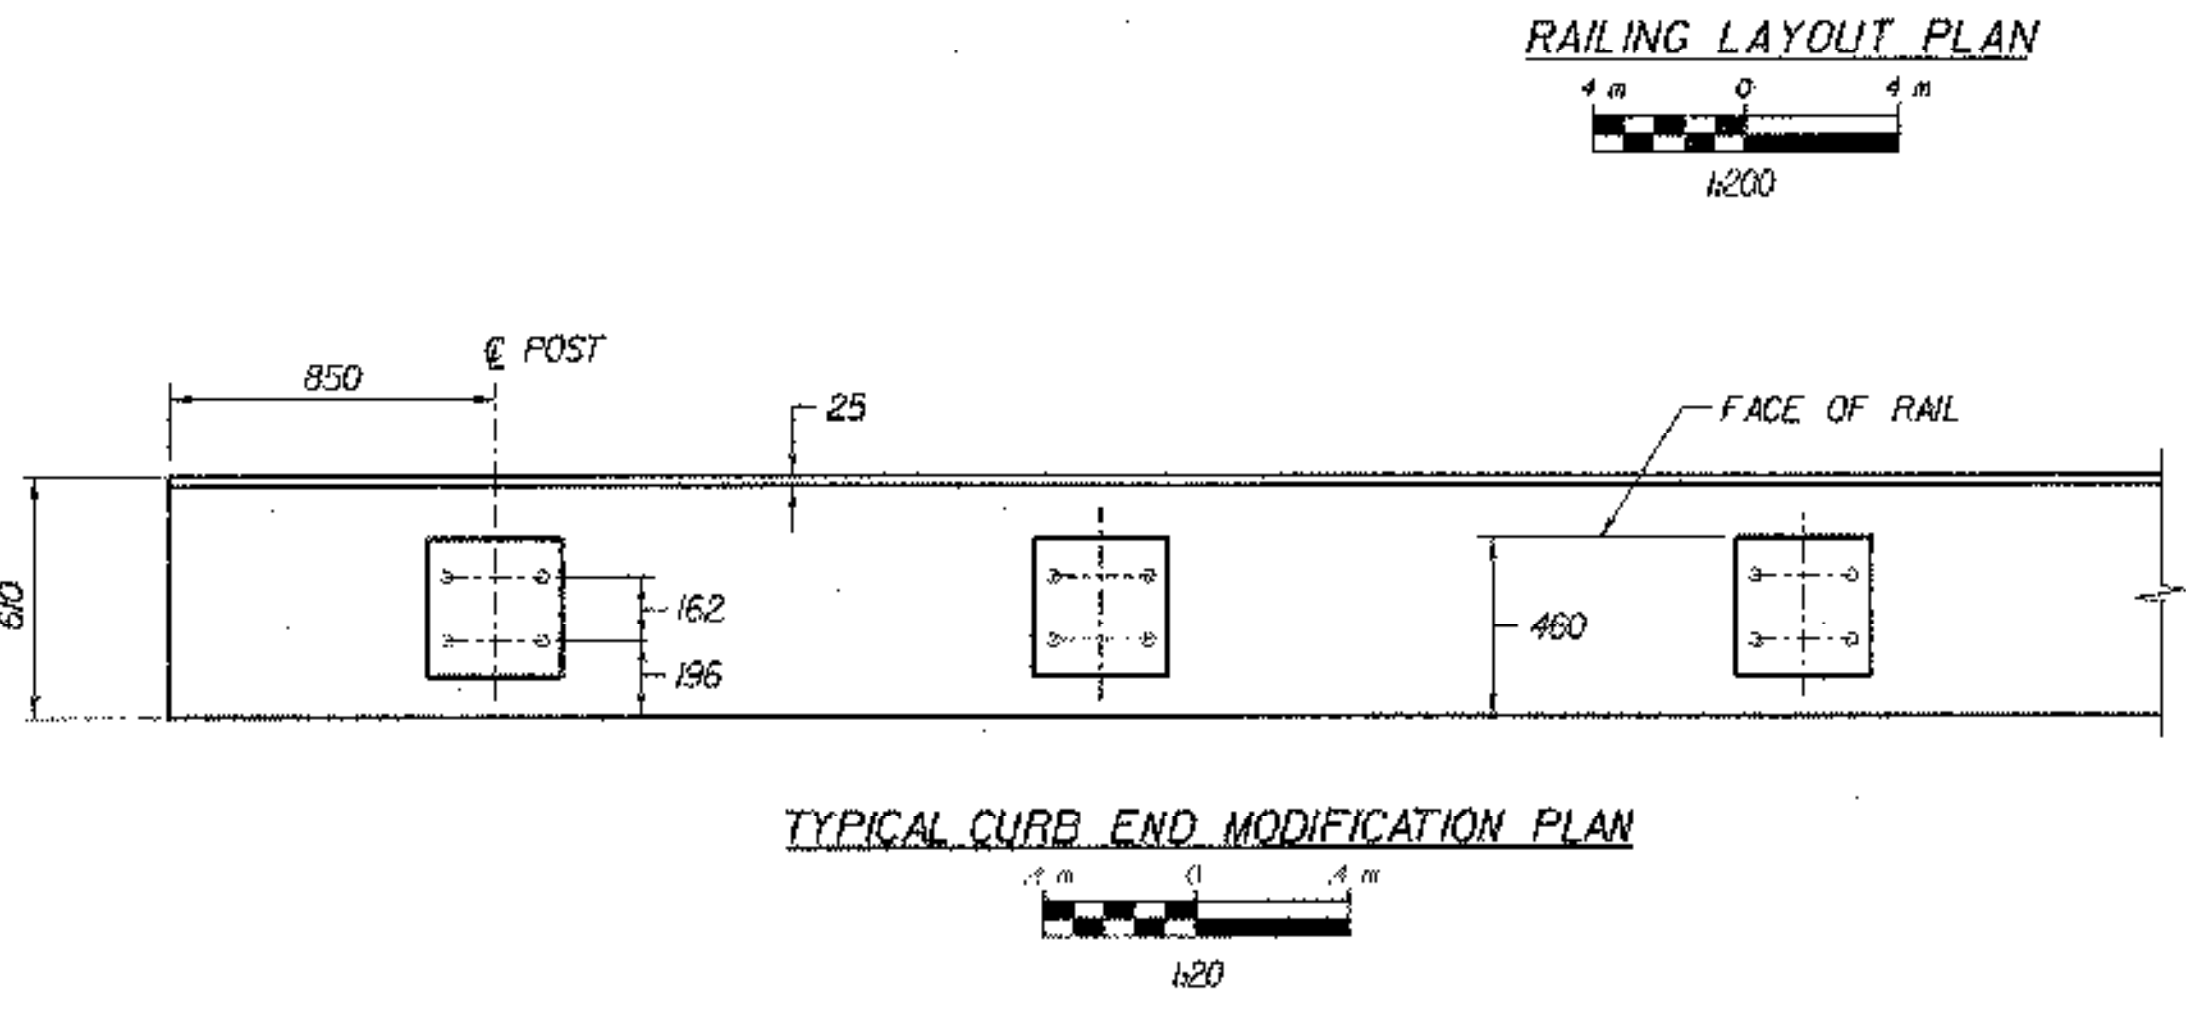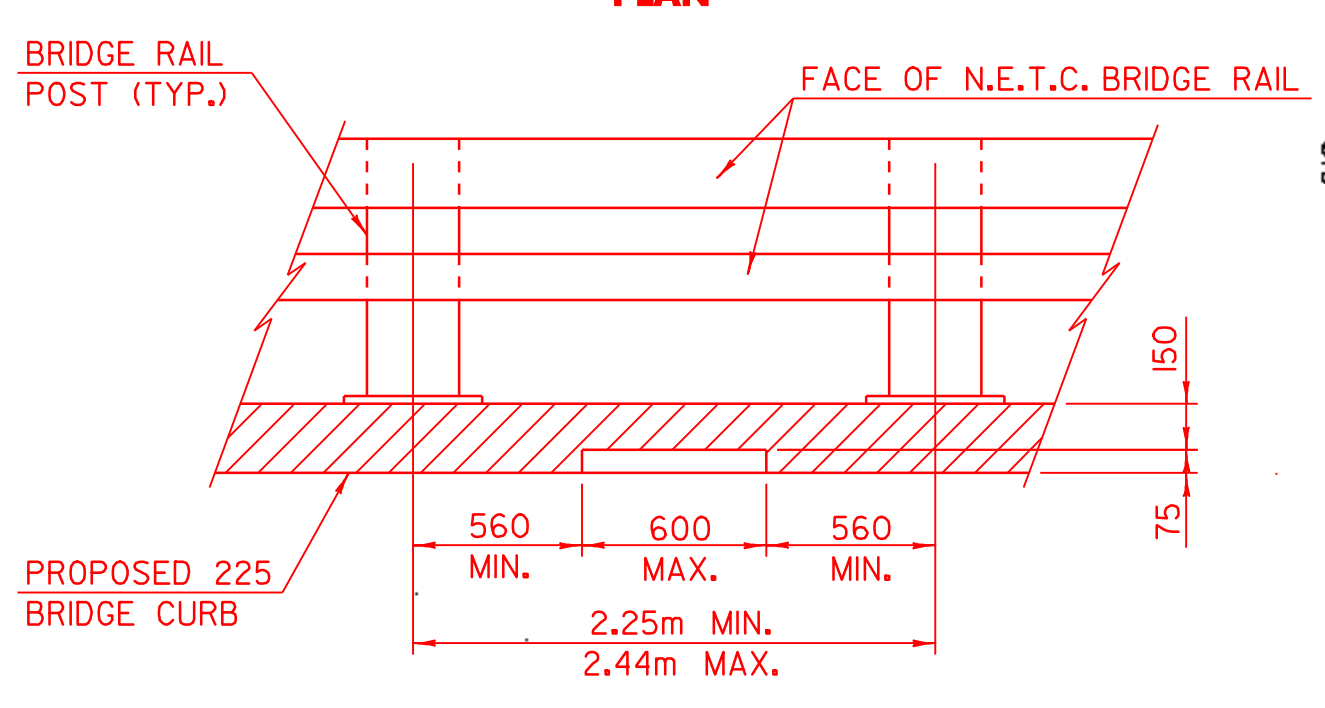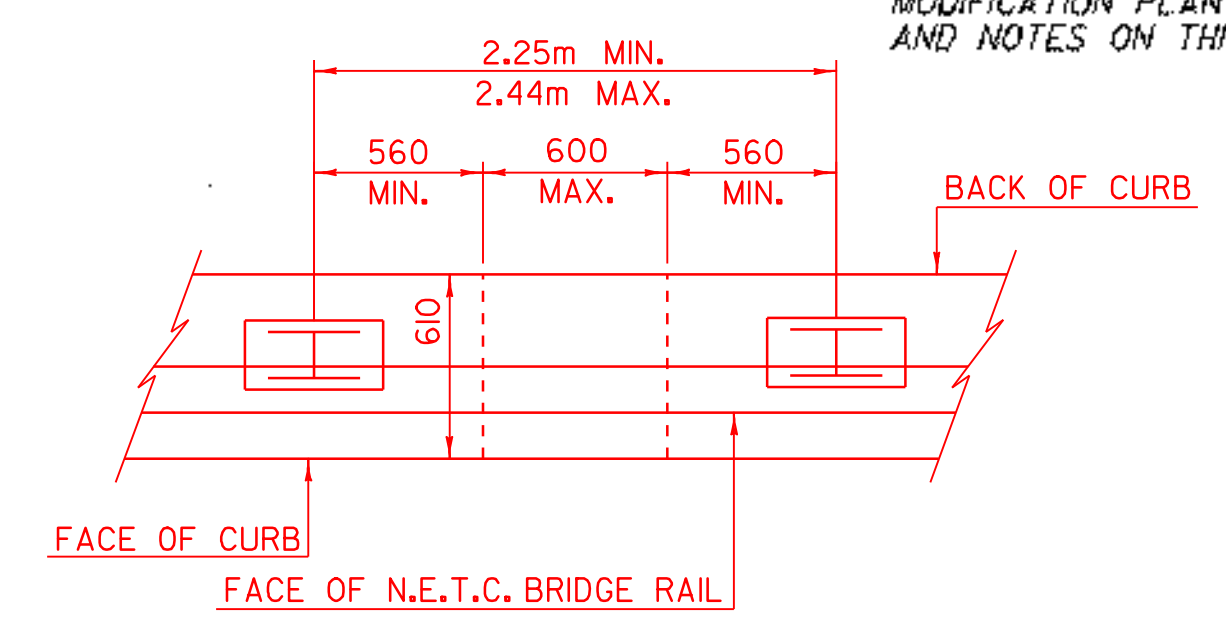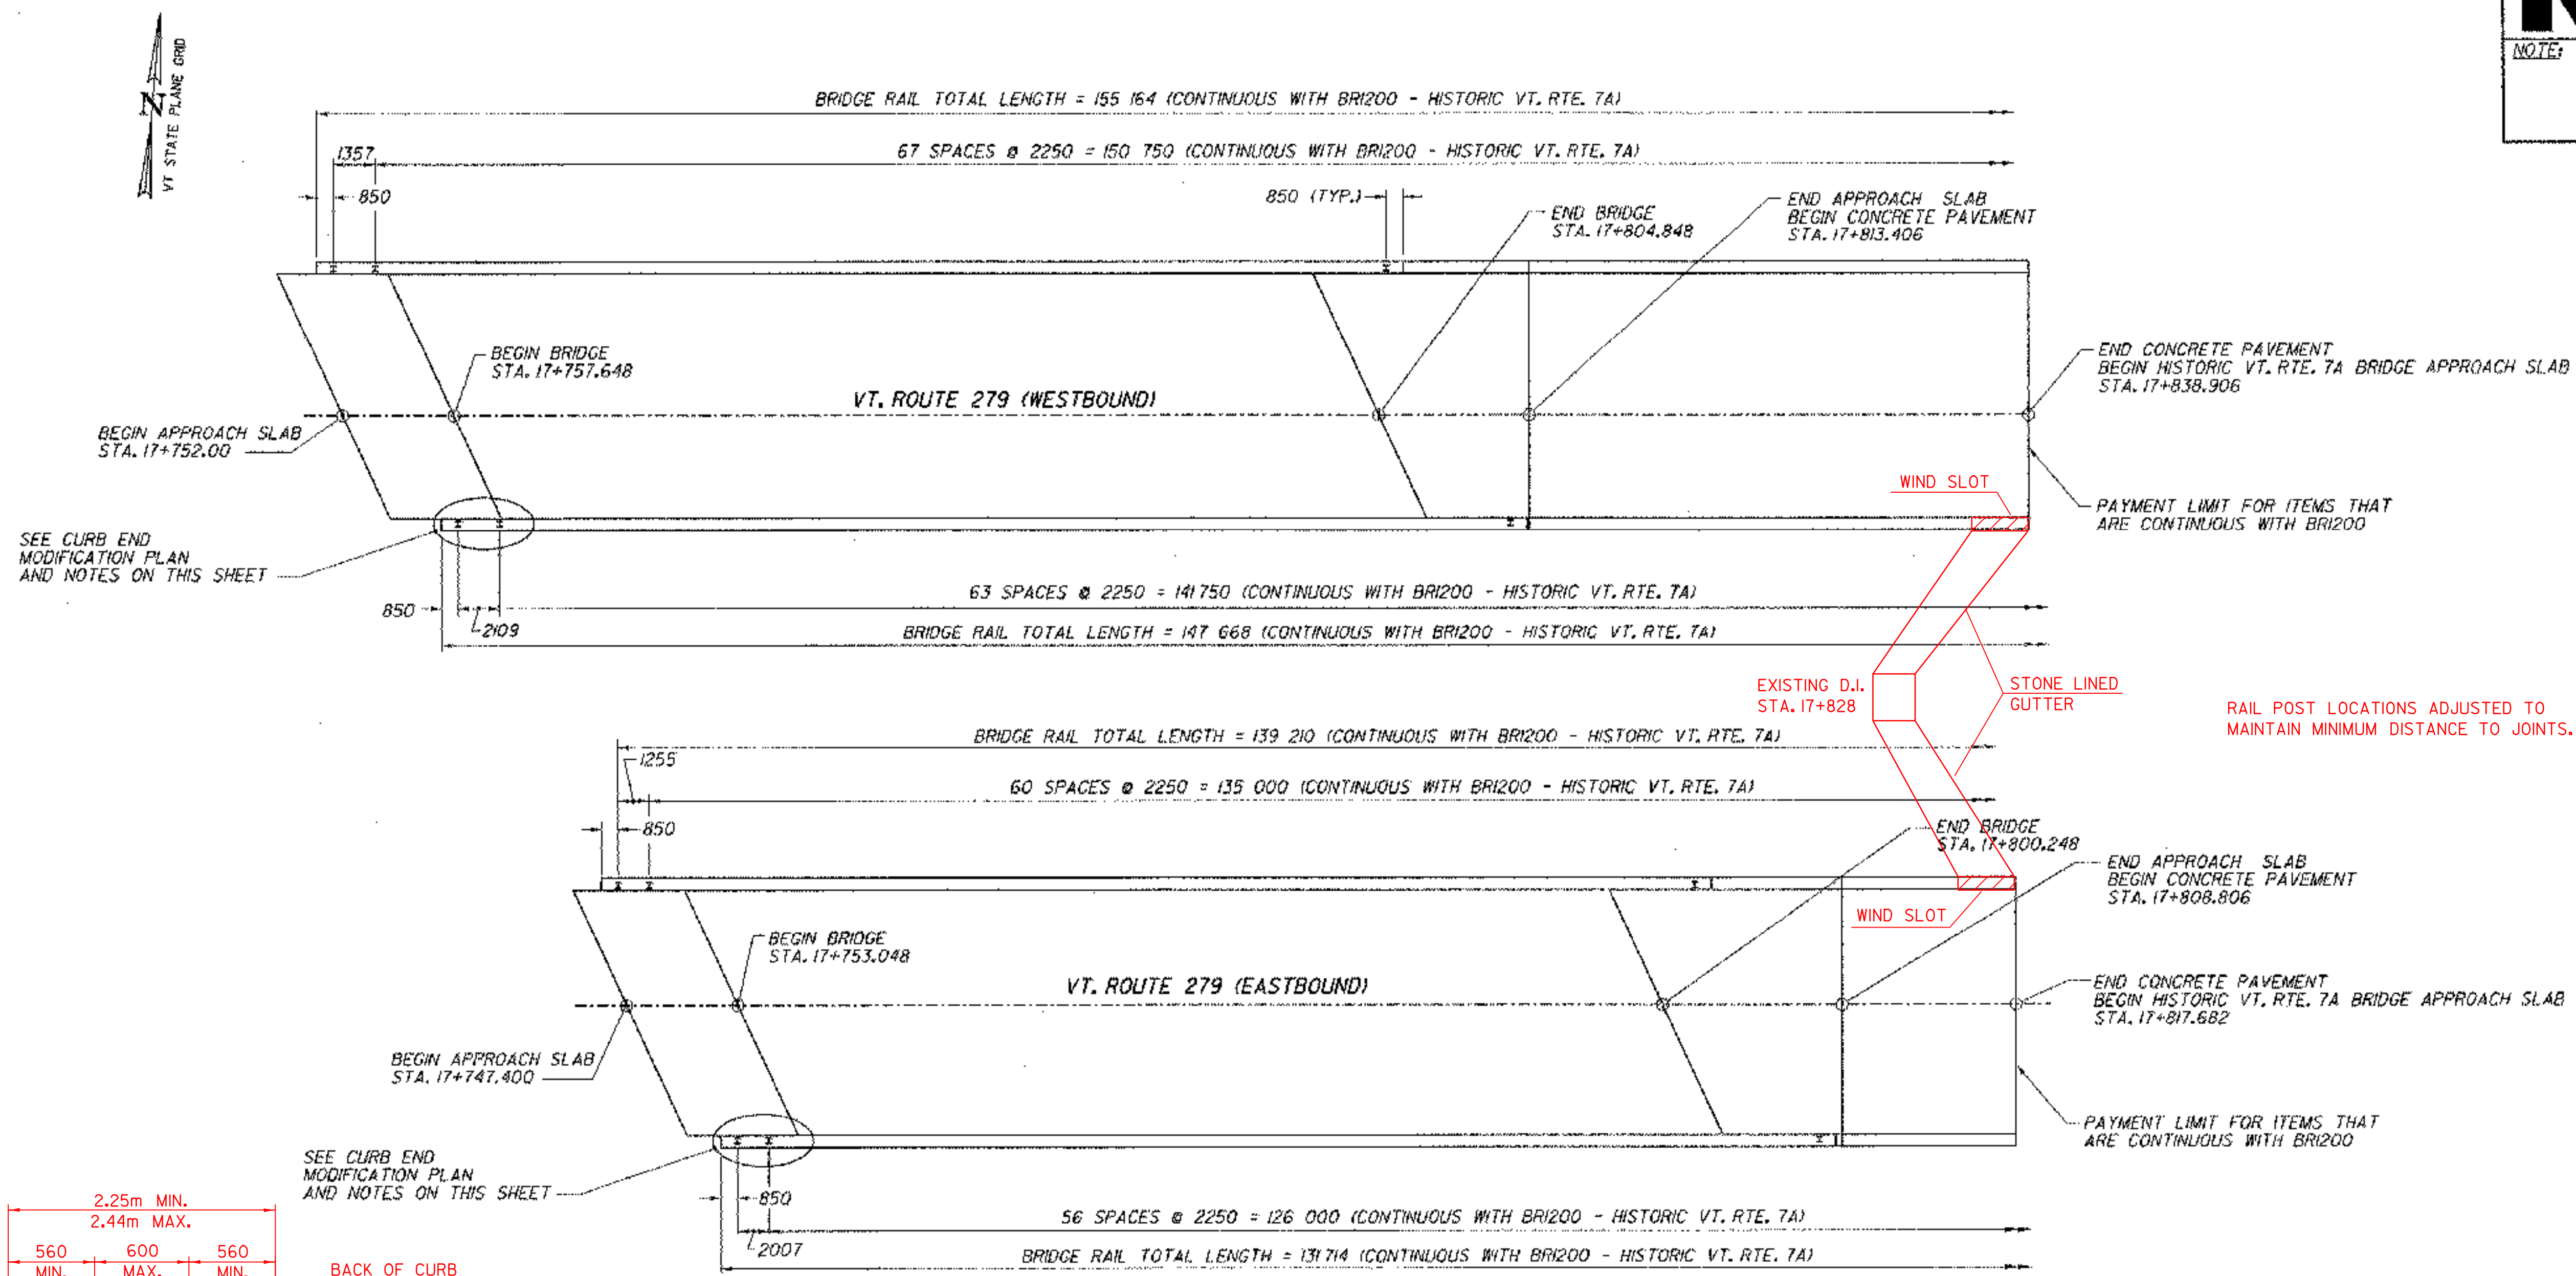

- CURB END MODIFICATION NOTES:**
- EXISTING CONCRETE SHALL BE SAW CUT 25 mm DEEP AT ENDS AND ALONG CENTER OF SCORE MARK BEFORE REMOVING.
  - REMOVAL OF CURBING AND CONCRETE AT EACH CORNER OF BRIDGE WILL BE PAID FOR UNDER ITEM 529.25, REMOVAL OF CONCRETE OR MASONRY.
  - EXISTING CONCRETE SHALL BE THOROUGHLY COATED WITH NEAT CEMENT PASTE BEFORE NEW CONCRETE IS POURED AS PER SUBSECTION 501.3B.
  - NEW CONCRETE IN CURB SECTIONS WILL BE CONCRETE, HIGH PERFORMANCE CLASS AA, ITEM 501.32

NOTE:  
1. SEE SHEET BR1203 FOR CONTINUATION OF BRIDGE RAIL LAYOUT.

## STATE OF VERMONT AGENCY OF TRANSPORTATION


Town Of	BENNINGTON	Bridge No.	BR100
Highway No.	VT. RTE. 279	Log Sta.	
		Surv. Sta.	17+780
VT. RTE. 279 OVER VT. RAILWAY			
BRIDGE RAILING AND CURB DETAILS			
Designed By	D. STECIAK	Drawn by	K. RAPELLO
Checked By	M.W. OLSTAD	Date	02/04
		Bridge Design Supervisor	M.W. OLSTAD
		Date	02/04
PROJECT	BENNINGTON-HOOSICK	PROJECT NO.	D.P.L. 0146(1) C/6
I.G.C. Info.			
Bridge Sheet No.	BR103	Sheet 70 OF 83	



FILE NAME = M:\2602\K5\ST\W\ST\W\FINAL\_VRR\brg\raillshk.plt  
DATE/TIME = 2/17/2004  
USER = 222

NOTE: UNLESS NOTED OTHERWISE, ALL STATIONS ARE IN KILOMETERS, ALL ELEVATIONS ARE IN METERS, AND ALL DIMENSIONS ARE IN MILLIMETERS.


THREADED CONCRETE ANCHOR FURNISHED WITH CLOSED END FERRULE

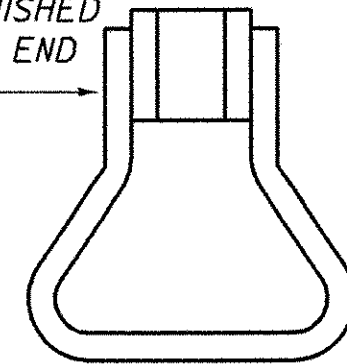

NOTE:


THREADED CONCRETE ANCHORS MAY BE SUBSTITUTED FOR CLOSED THREADED FERRULES. CLOSED THREADED FERRULES MUST BE TACK WELDED TO JOINT ANGLE.

ANCHOR FERRULE DETAIL  
N.T.S.

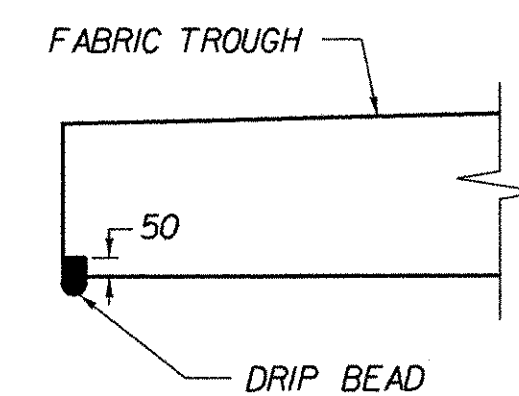



A DRIP BEAD, FABRICATED FROM PREFORMED MATERIAL IS TO BE MADE ON THE UNDERSIDE OF THE FABRIC TROUGH AS SHOWN WITH THE COST TO BE SUBSIDIARY TO ITEM 516J0 'BRIDGE EXPANSION JOINT' (VERMONT TYPE) (MOD.)

2 DRIP BEAD DETAIL  
BRI105  
N.T.S.

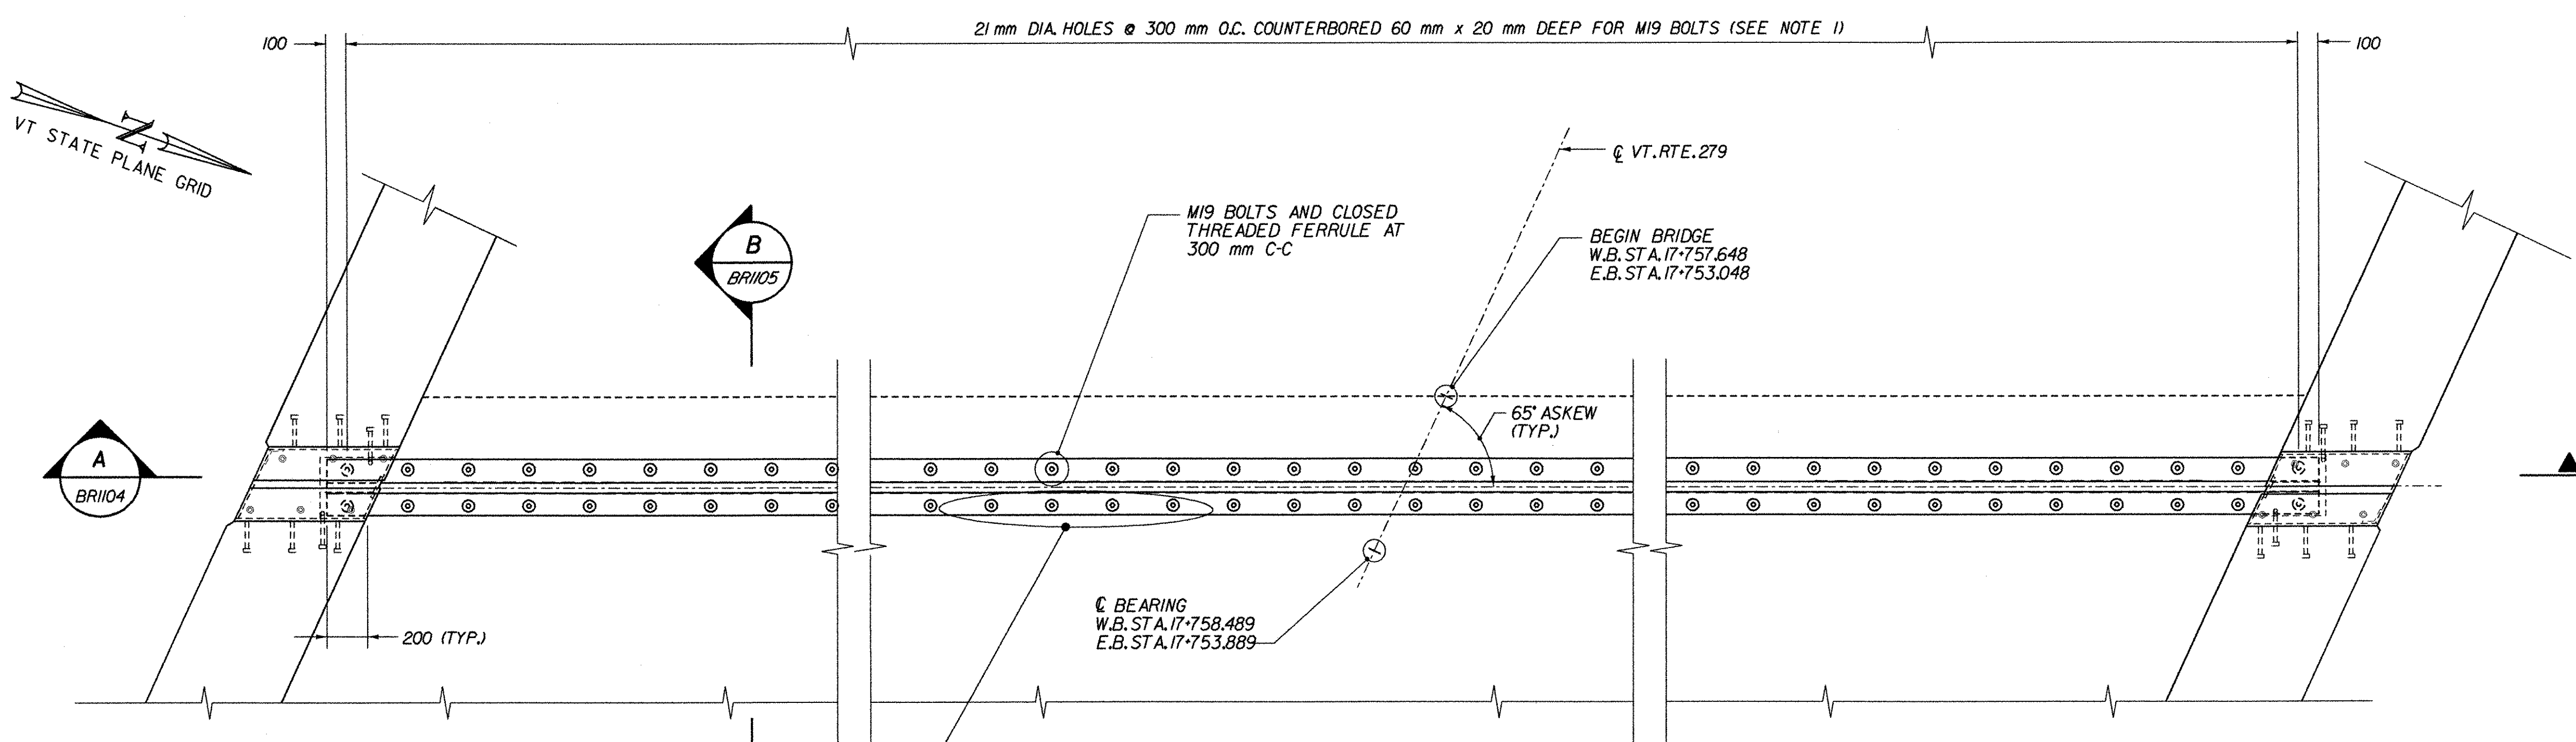


APPROXIMATE LOCATION OF DAMAGED JOINT ON WESTBOUND BRIDGE, SEE BELOW FOR REPAIR DETAILS. THE COST TO REPAIR THE DAMAGED JOINT SHALL BE SUBSIDIARY TO ITEM 516J0 (MOD.)

BRIDGE EXPANSION JOINT AT ABUTMENTS 1 & 3

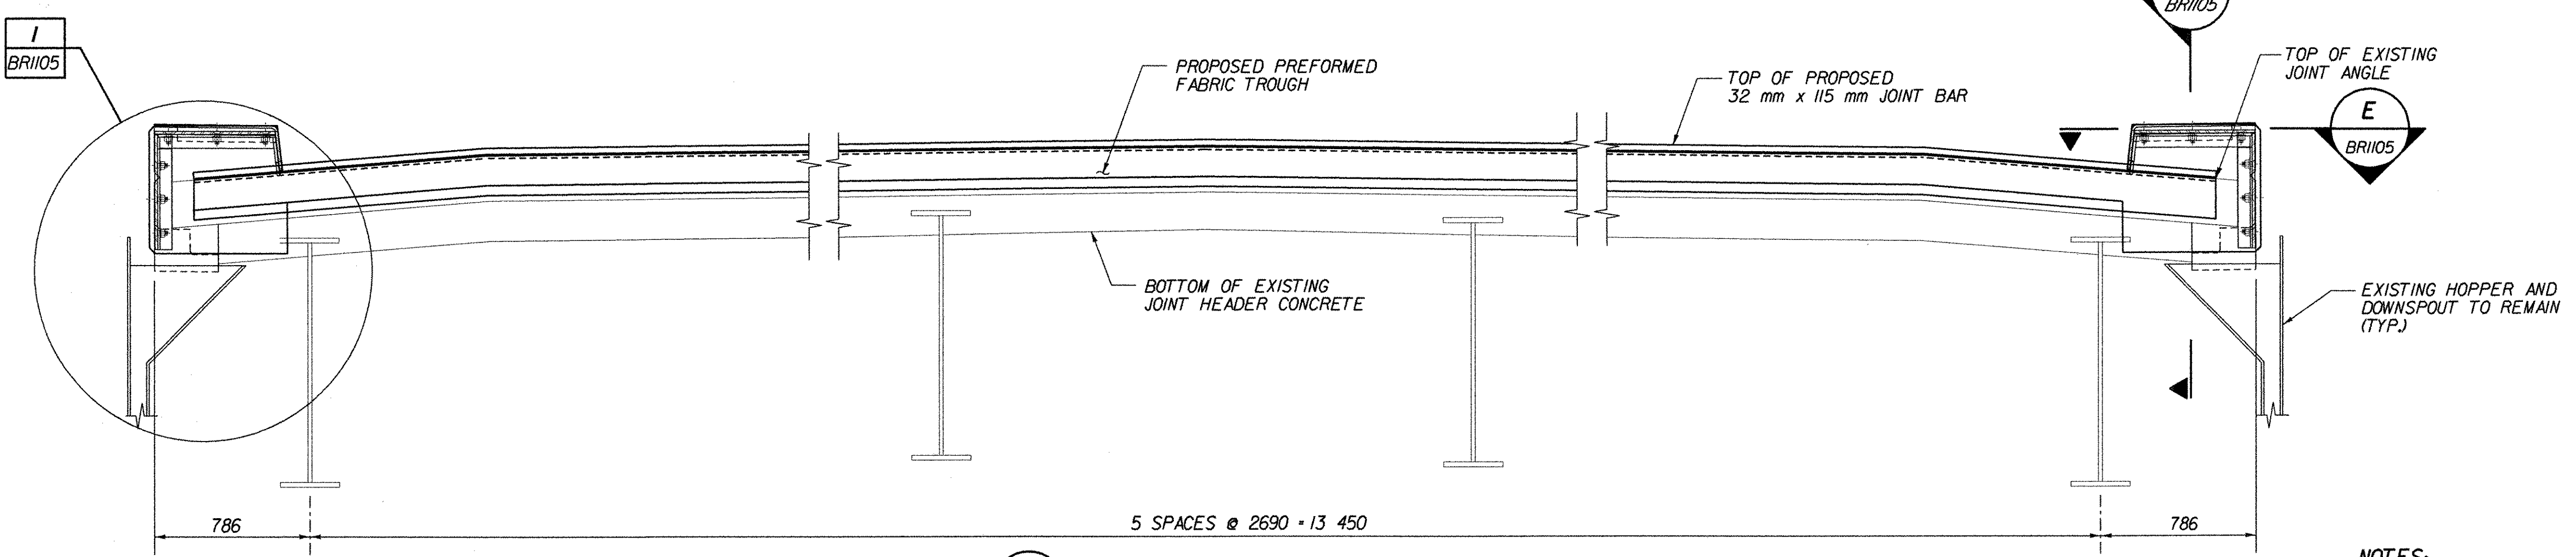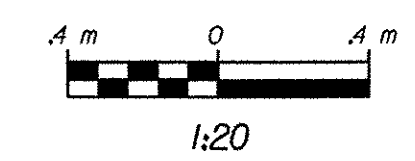


A BRIDGE SECTION AT JOINT  
BRI104

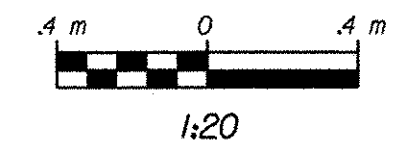


NOTES:


- ADJUST SPACING OF 21 mm DIA. HOLES, WELDED STUDS, AND CLOSED THREADED FERRULES FOR CLEARANCE IN AREAS OF EXISTING BRACKETS AND ANCHOR STUDS.
- ALL WORK REQUIRED TO PERFORM THE MODIFICATION OF THE EXPANSION JOINTS SHALL BE INCLUDED IN ITEM 516J0 BRIDGE EXPANSION (VERMONT TYPE) (MOD.).

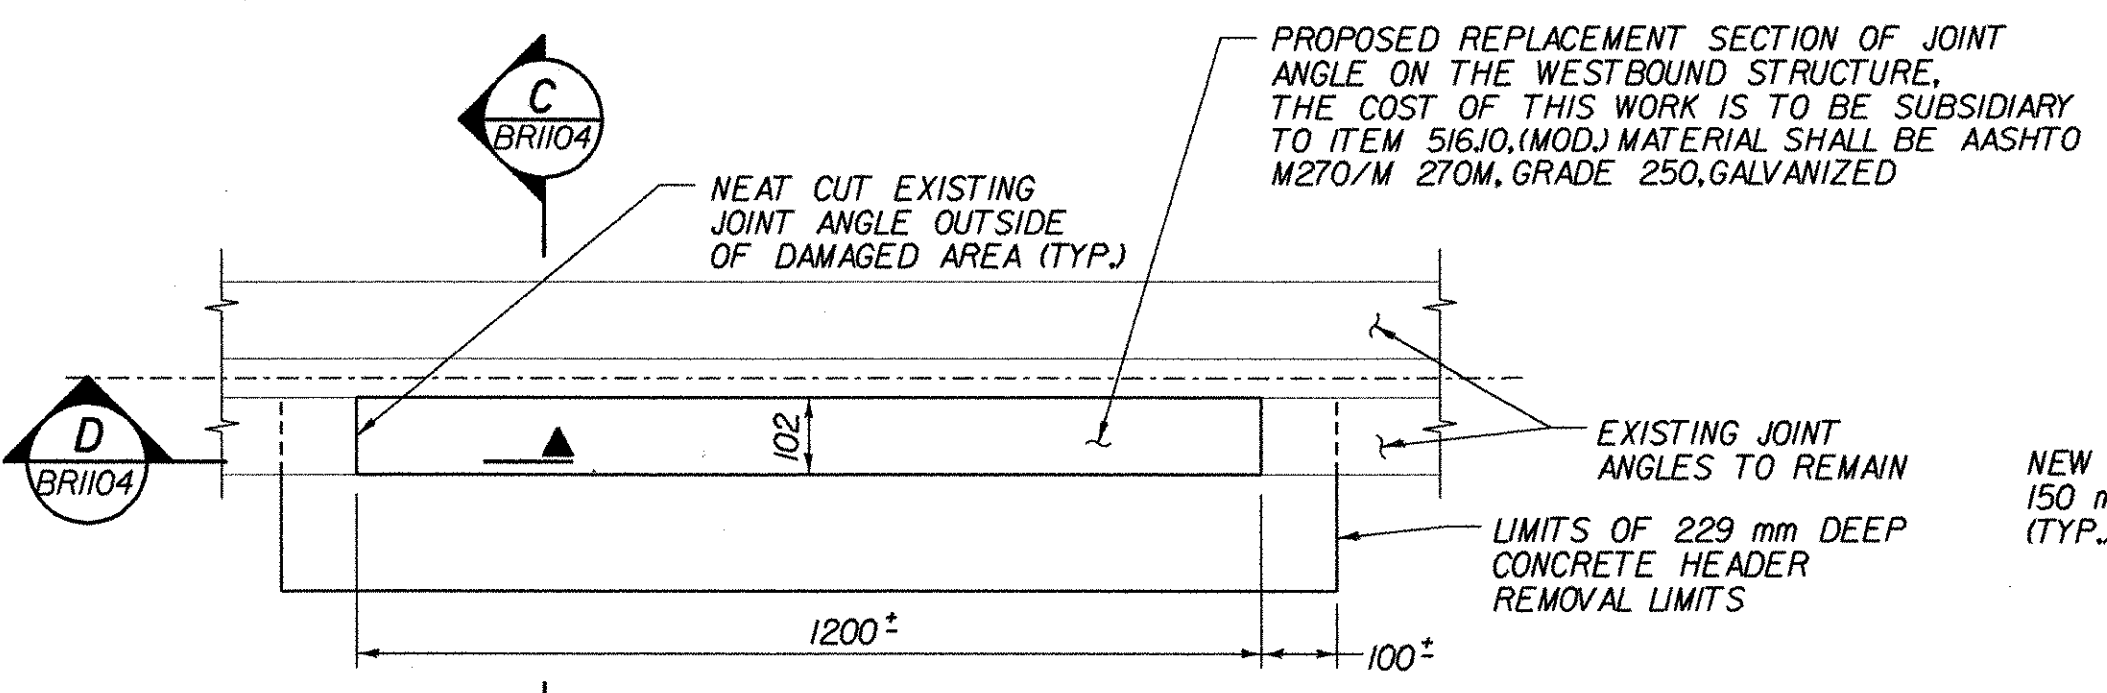

JOINT REPAIR DETAIL PLAN  
N.T.S.

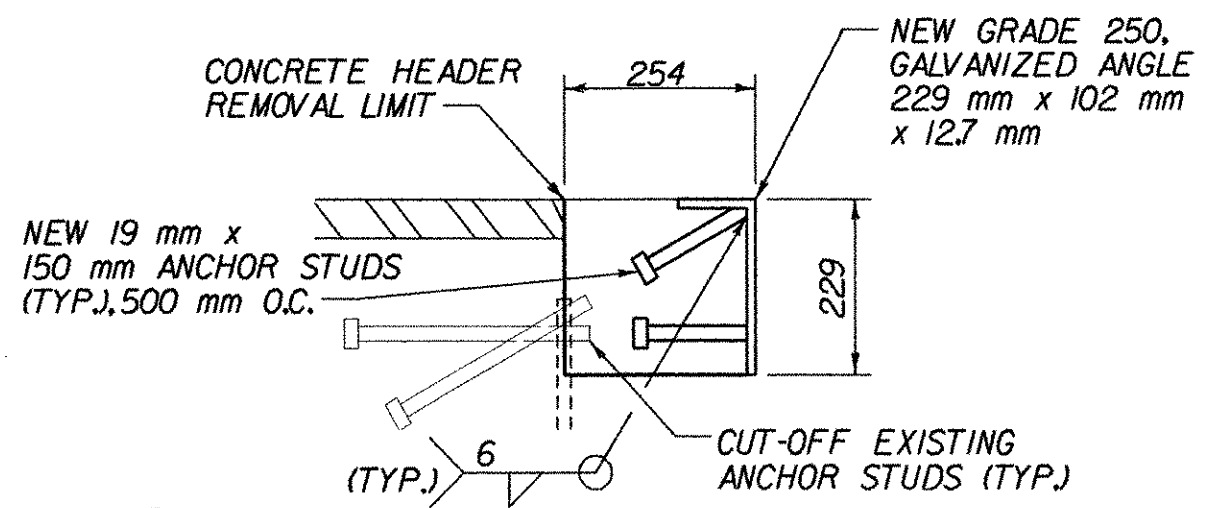

C PROPOSED REPLACEMENT SECTION OF ANGLE  
BRI104  
N.T.S.

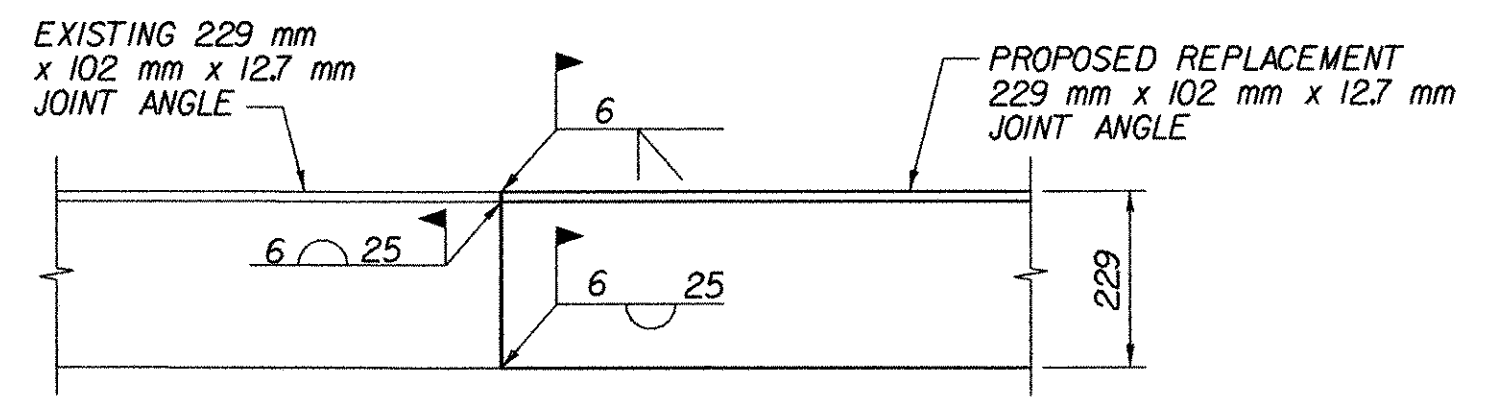




D PROPOSED ANGLE WELDS  
BRI104  
N.T.S.

## STATE OF VERMONT AGENCY OF TRANSPORTATION


Town of	BENNINGTON	Bridge No.	BRI100
Highway No.	VT. RTE. 279	Log Sta.	
		Surv. Sta.	17+780
VT. RTE. 279 OVER VT. RAILWAY			
EXPANSION JOINTS AT WEST ABUTMENTS			
Designed By	D. STECIAK	Drawn by	K. RAPELLO/B. WEATHERBY
Checked By	M.W. OLSTAD	Date	02/04
		Bridge Design Supervisor	M.W. OLSTAD
		Date	02/04
PROJECT	BENNINGTON-HOOSICK	PROJECT NO.	D.P.I. 0146(I) C/6
I.G.C. Info.			
Bridge Sheet No.	BRI104	Sheet	71 OF 83




NOTE: UNLESS NOTED OTHERWISE, ALL STATIONS ARE IN KILOMETERS, ALL ELEVATIONS ARE IN METERS, AND ALL DIMENSIONS ARE IN MILLIMETERS.

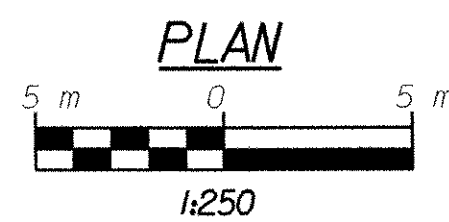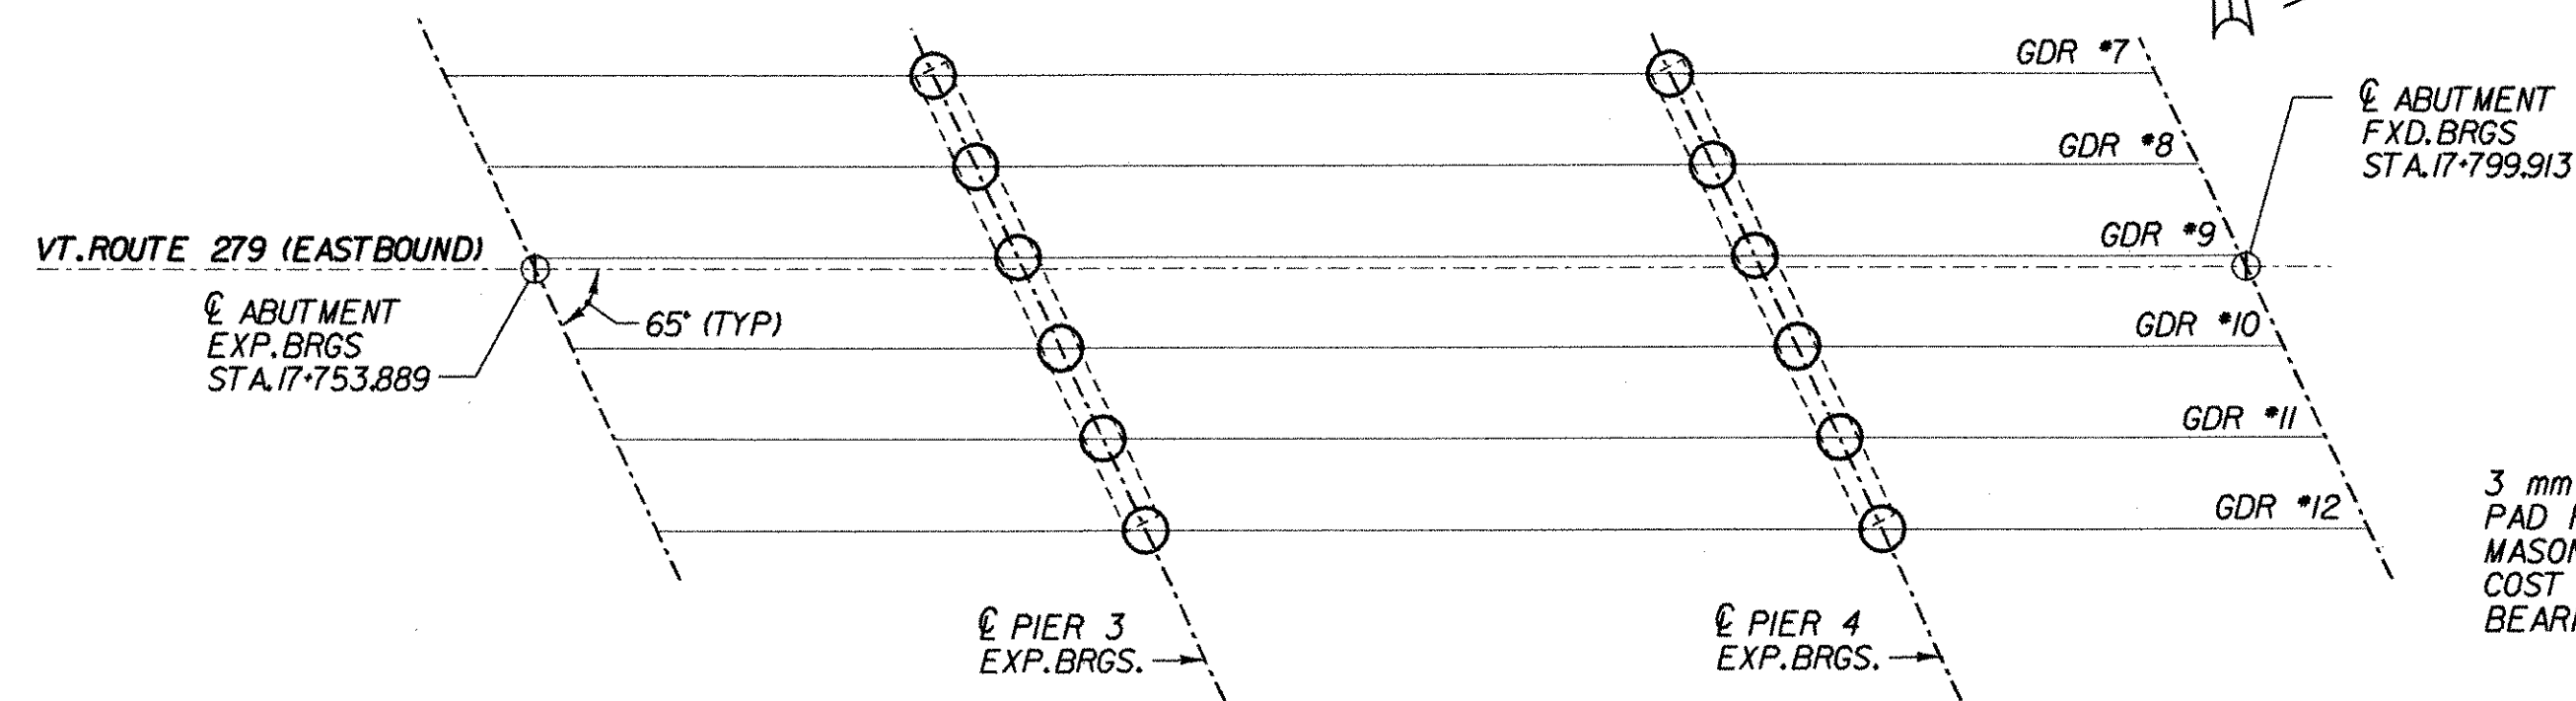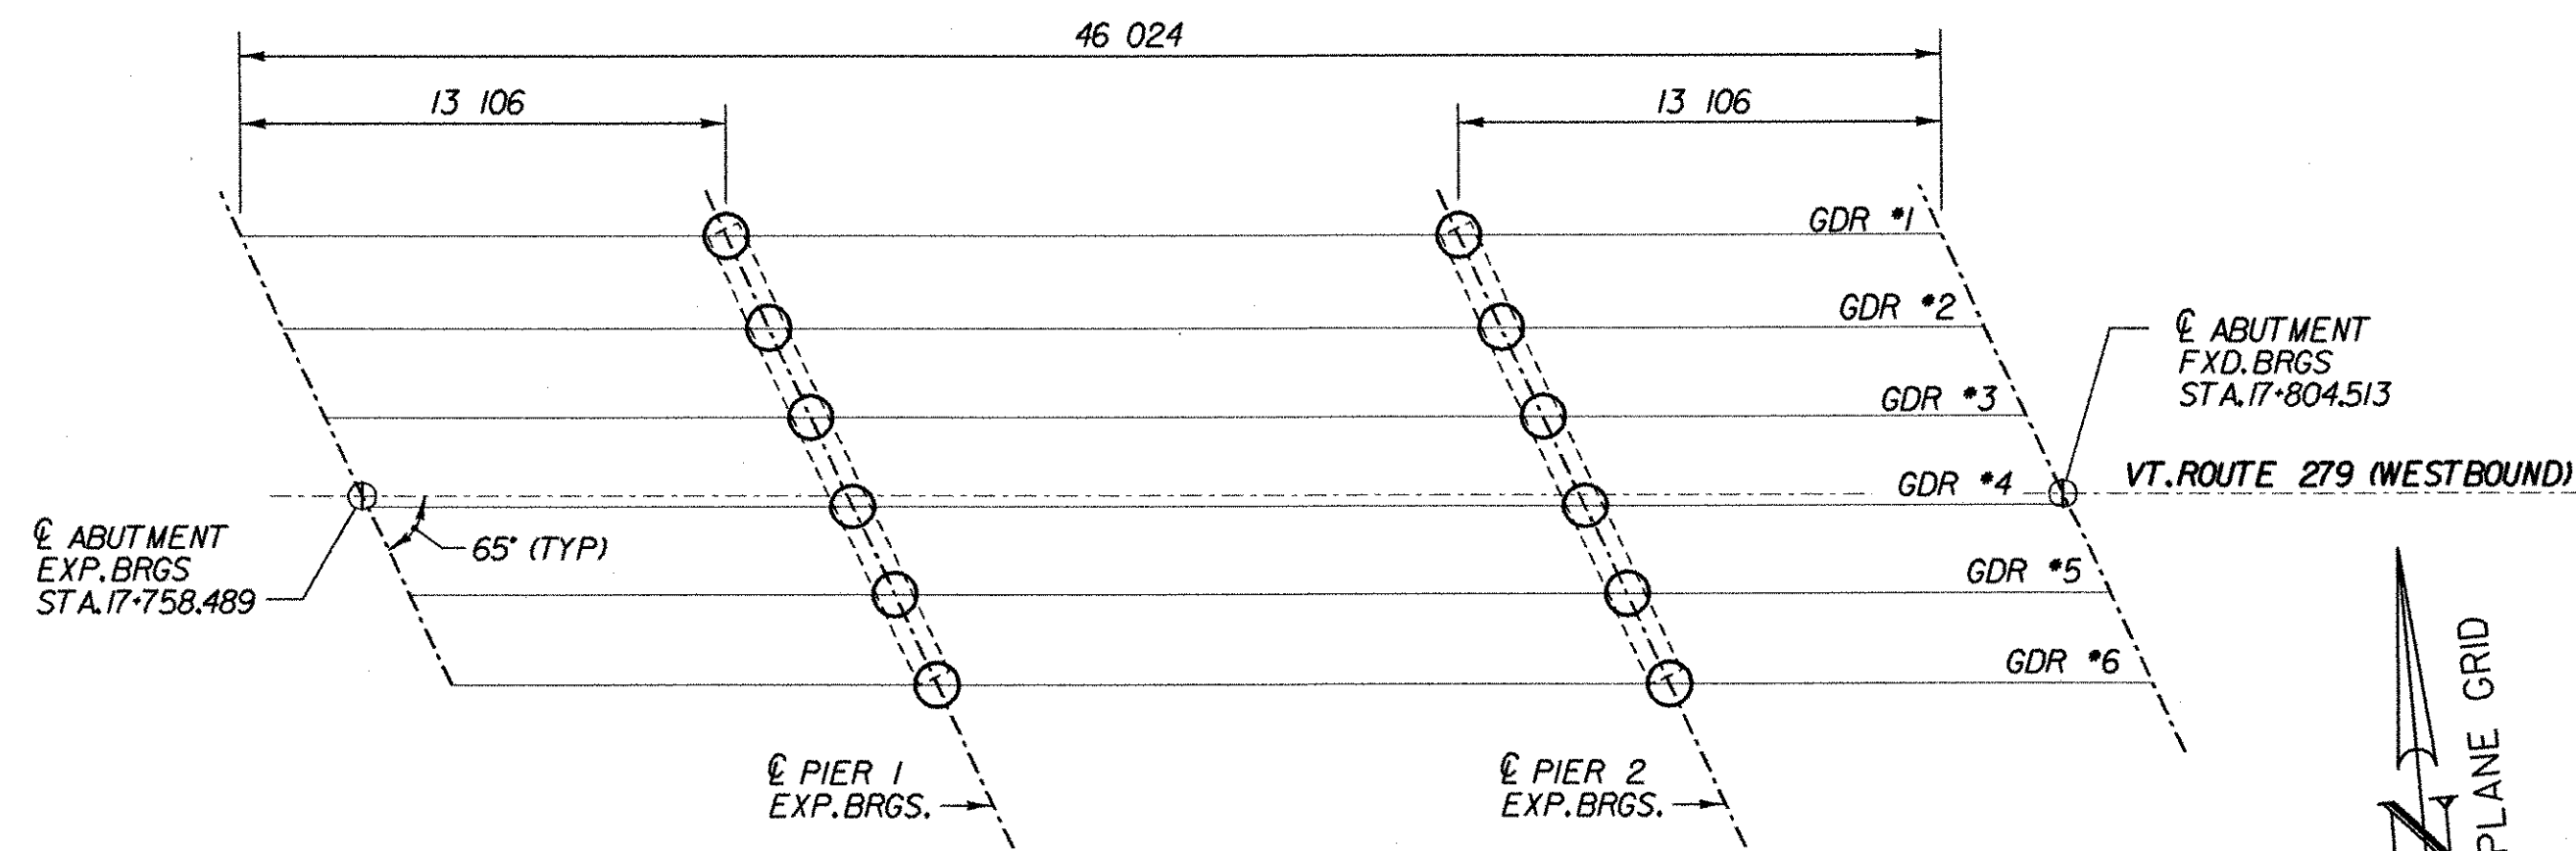


**LEGEND**  
 ○ - LOCATION OF BEARING REPLACEMENT AND PEDESTAL WORK

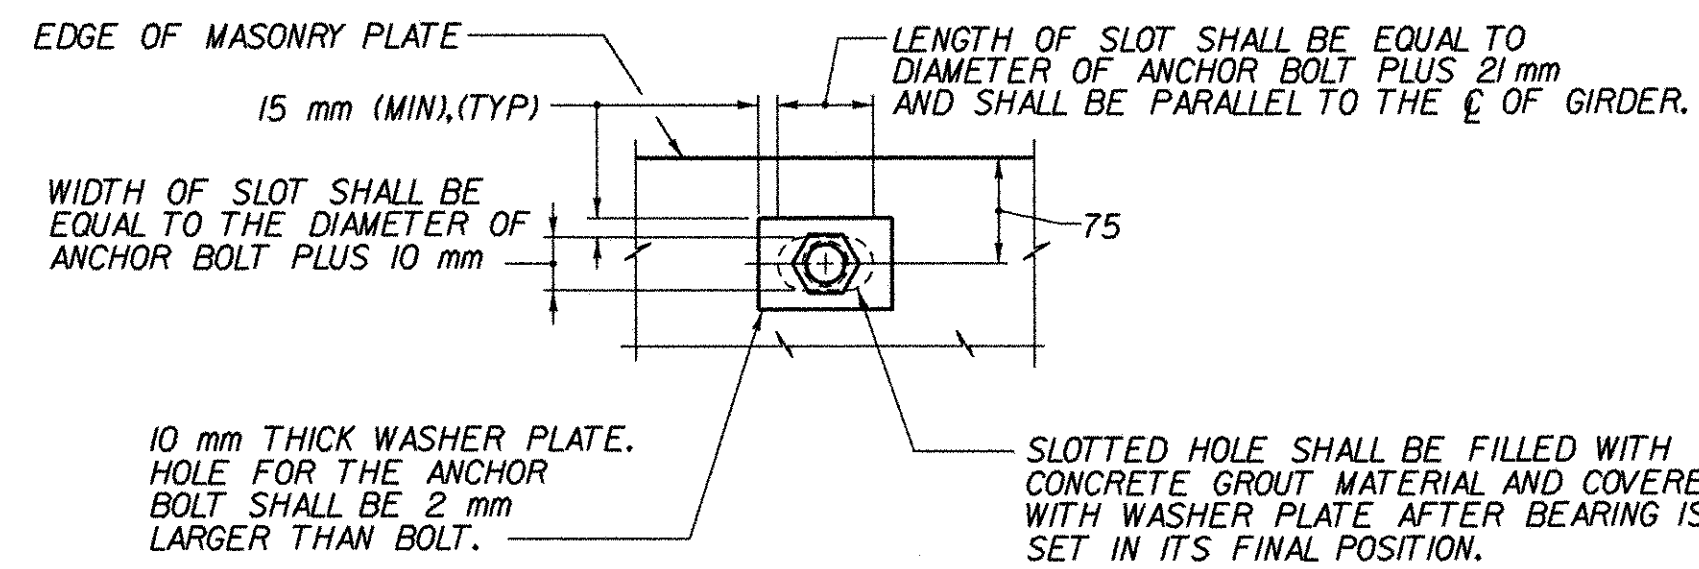


TYPICAL ANCHOR BOLT DETAIL FOR MASONRY PLATE

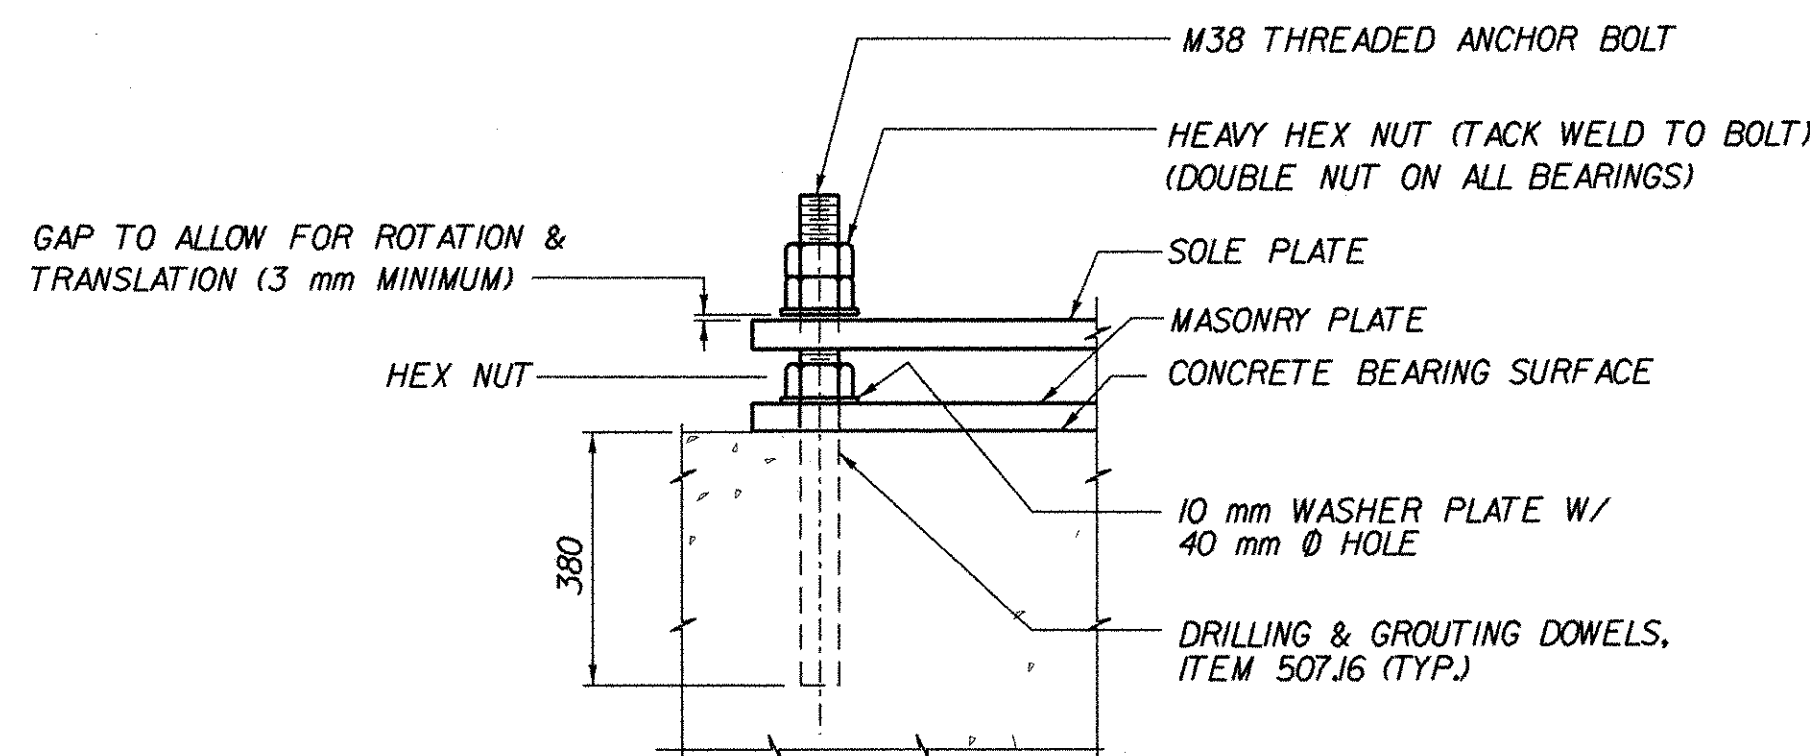

TYPICAL ANCHOR BOLT DETAIL

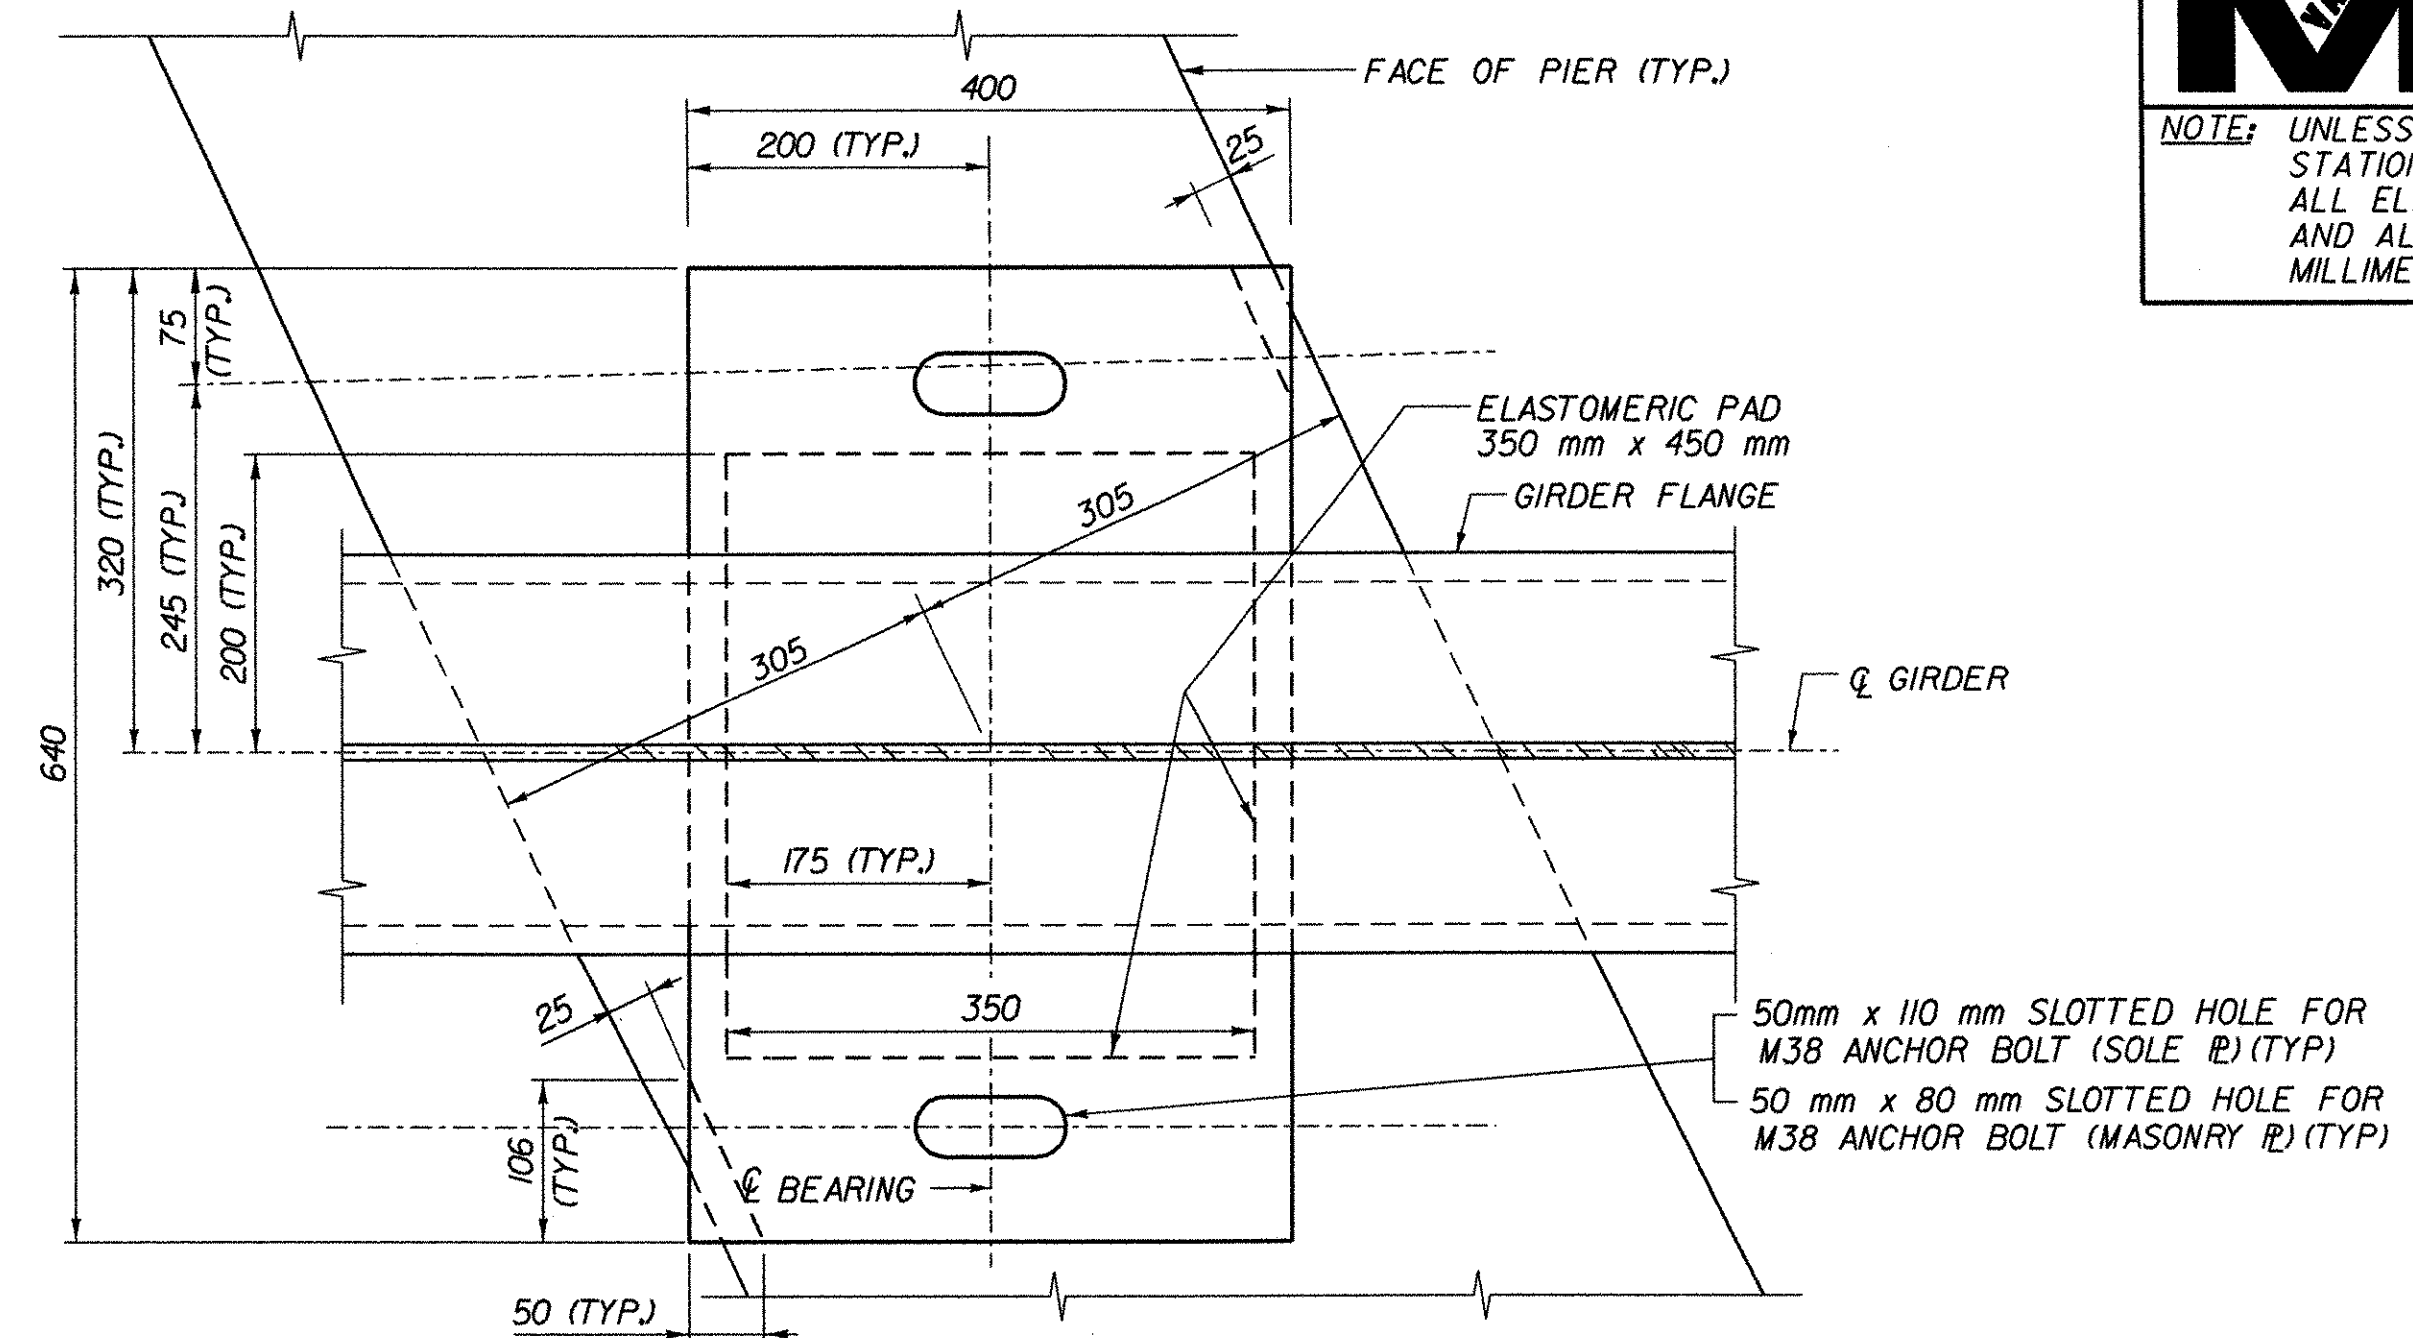


PLAN VIEW

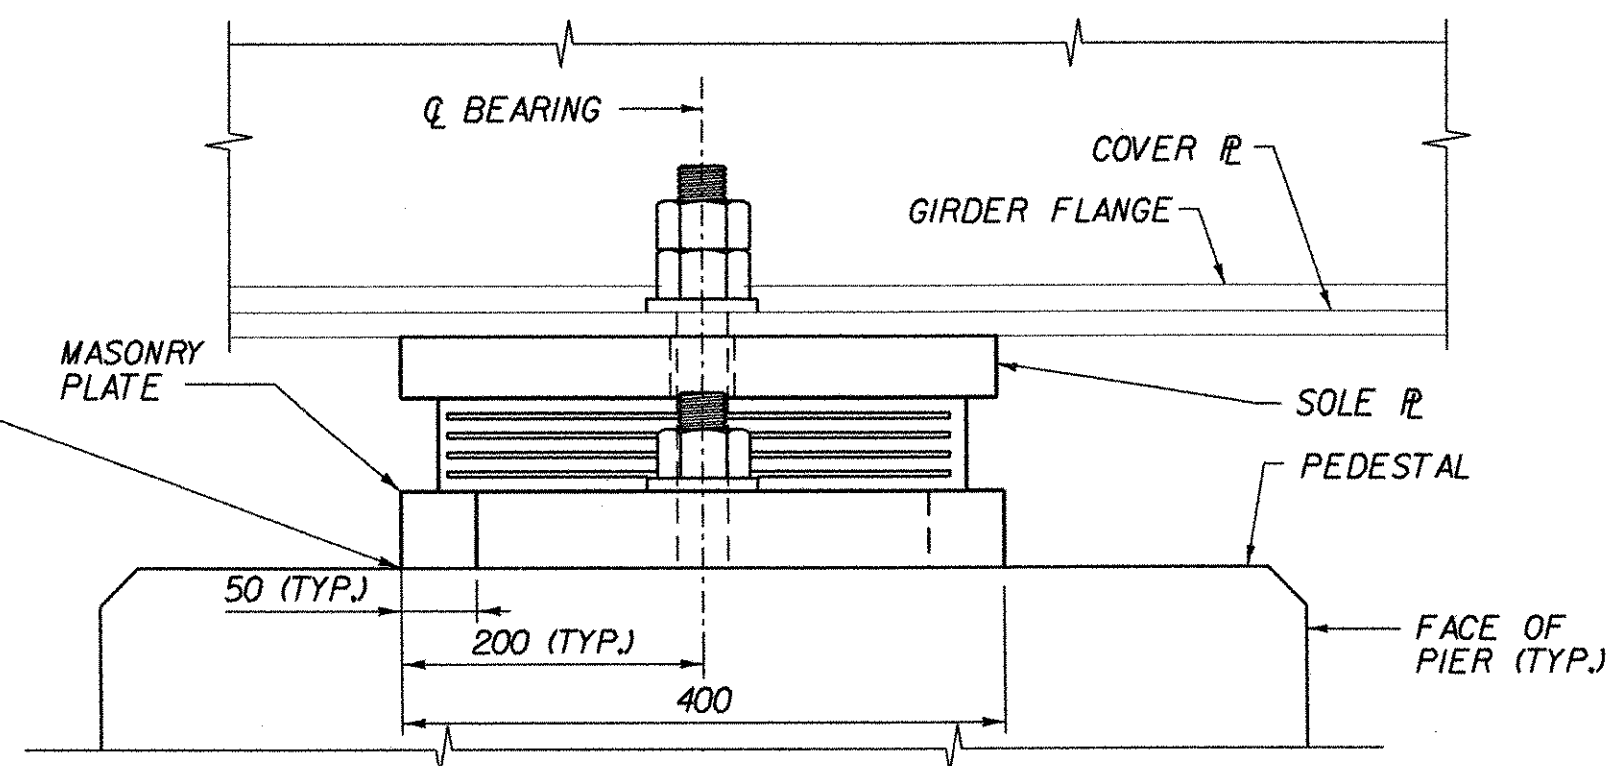


ELEVATION

3 mm ELASTOMERIC PAD PLACED UNDER MASONRY PLATE, (TYP.), COST TO BE INCLUDED IN BEARING ITEM

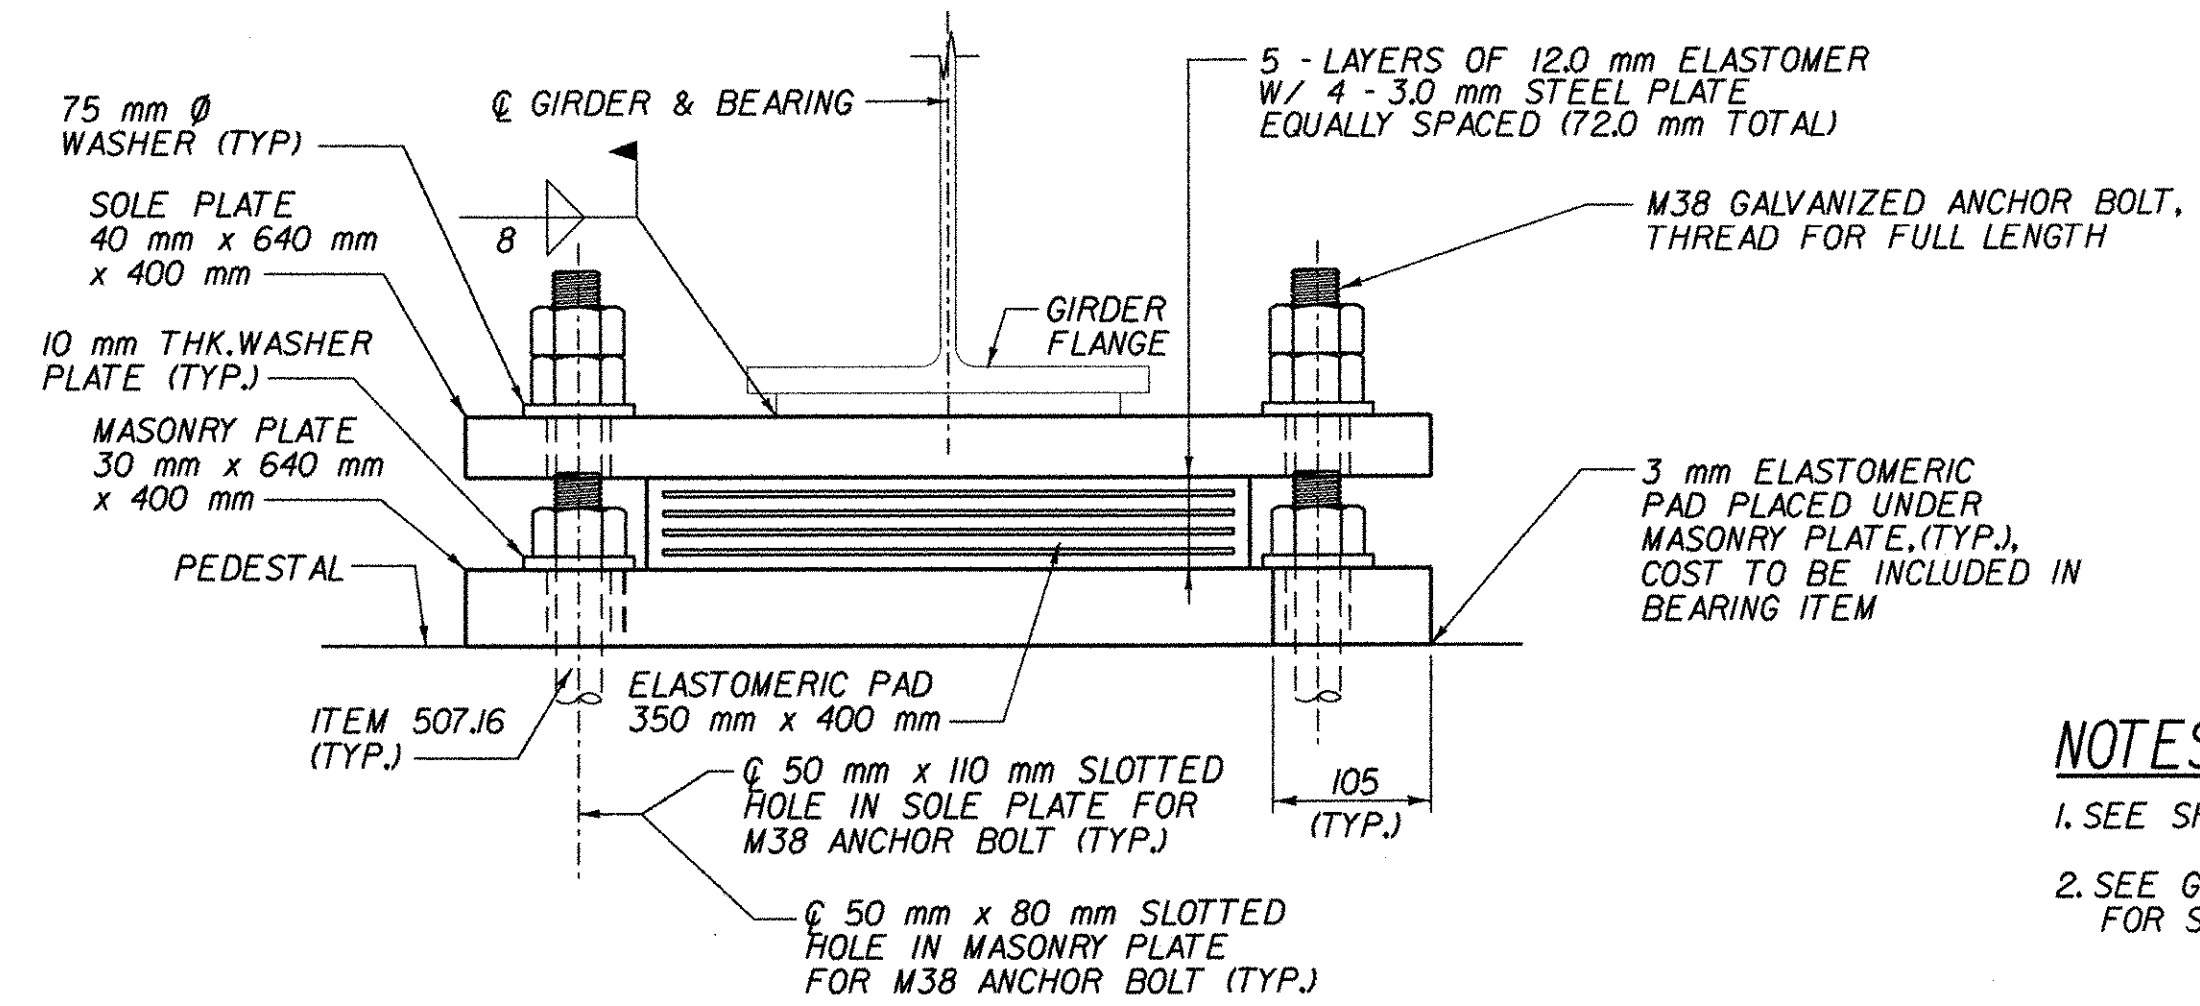

EXPANSION BEARING AT PIERS (FRONT VIEW)  
 BEARING DETAILS

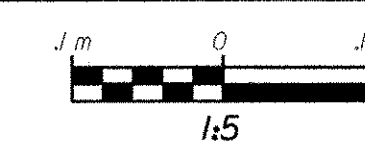

BEARING TABLE						
LOCATION	TYPE	ITEM NO.	QUANTITY REQUIRED	CAPACITY (KN)	SHAPE FACTOR	MAX. REACTION (KN)
PIERS	EXP.	53110	24	674	7.35	633

**NOTE:**  
 THE DEAD LOAD JACKING FORCE IS APPROXIMATELY 396 KN PER BEARING.


**NOTES:**

- SEE SHEET NO. BRI FOR BEARING NOTES.
- SEE GENERAL NOTE 13 ON SHEET NO. BRI FOR SHOP DRAWING DISTRIBUTION LIST.



**STATE OF VERMONT  
 AGENCY OF TRANSPORTATION**

Town of	BENNINGTON	Bridge No.	BRI100
Highway No.	VT. RTE. 279	Log Sta.	
		Surv. Sta.	17+780
VT. RTE. 279 OVER VT. RAILWAY			
BEARING LAYOUT PLAN AND DETAILS			
Designed By	D. STECIAK	Drawn by	K. RAPELLO/B. WEATHERY
Checked By	M.W. OLSTAD	Date	02/04
		Bridge Design Supervisor	M.W. OLSTAD
		Date	02/04
PROJECT	BENNINGTON-HOOSICK	PROJECT NO.	D.P.I. 0146(I) C/6
I.G.C. Info.			
Bridge Sheet No.	BRI106	Sheet	73 OF 83


NOTE: UNLESS NOTED OTHERWISE, ALL STATIONS ARE IN KILOMETERS, ALL ELEVATIONS ARE IN METERS, AND ALL DIMENSIONS ARE IN MILLIMETERS.

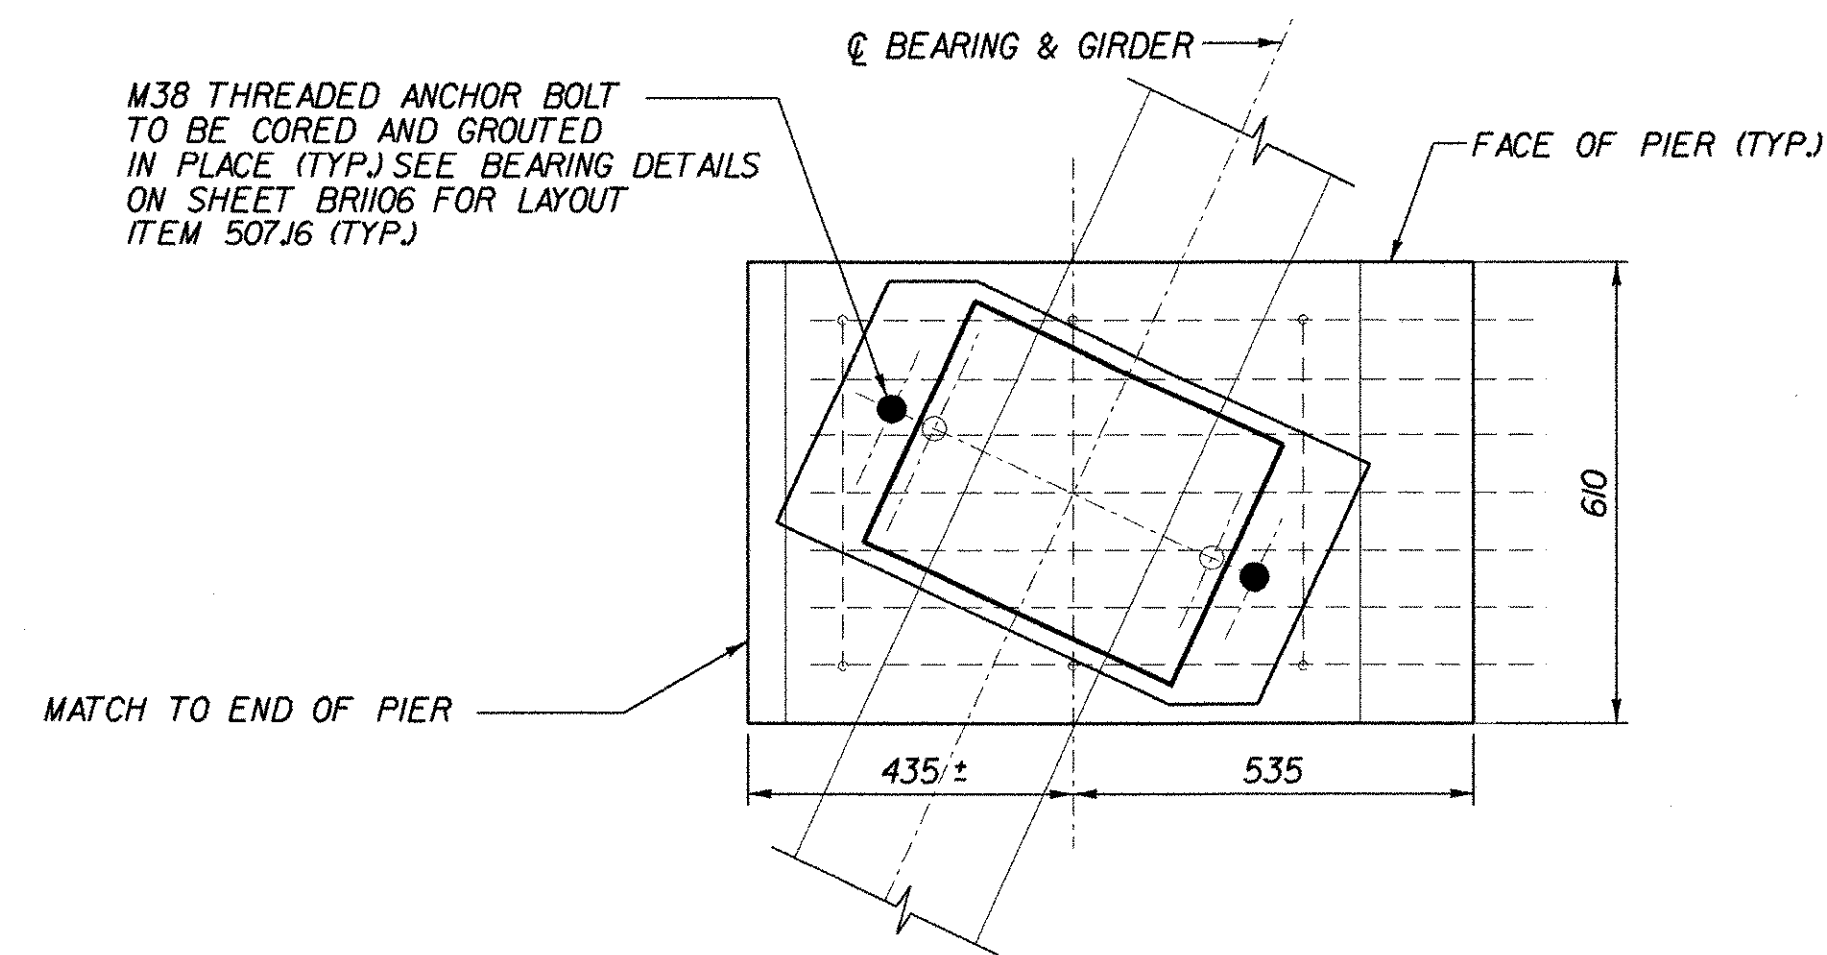



**FASCIA PEDESTAL PLAN**

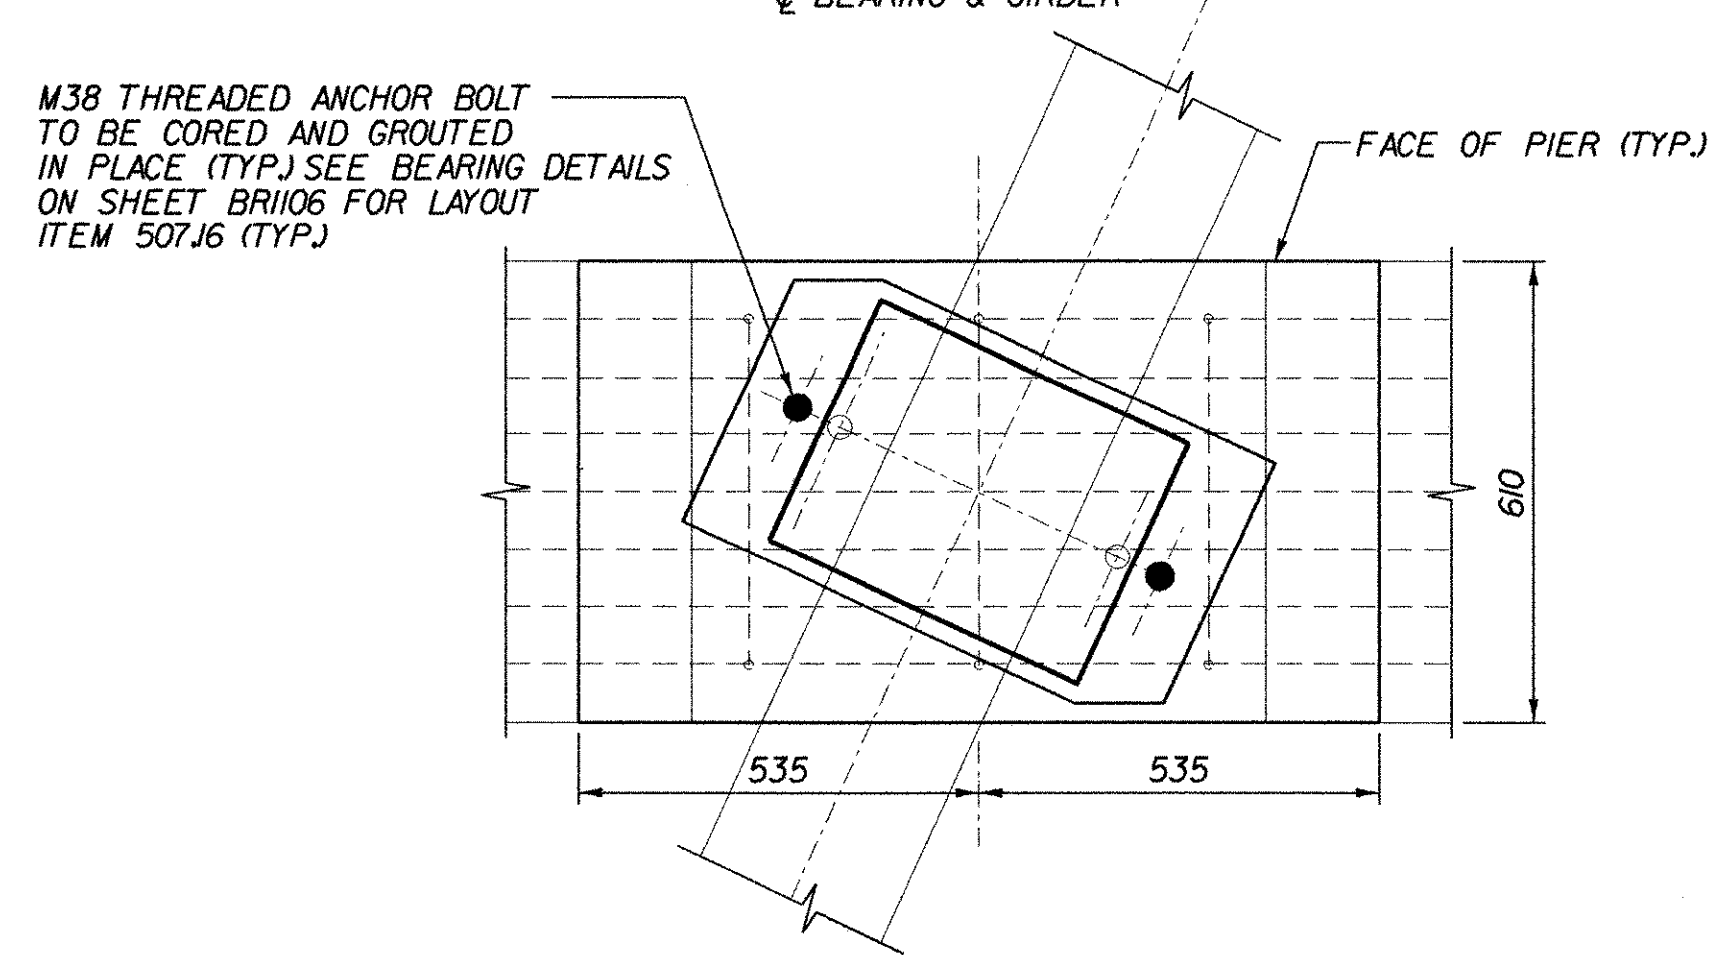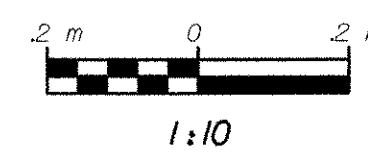



**INTERIOR PEDESTAL PLAN**

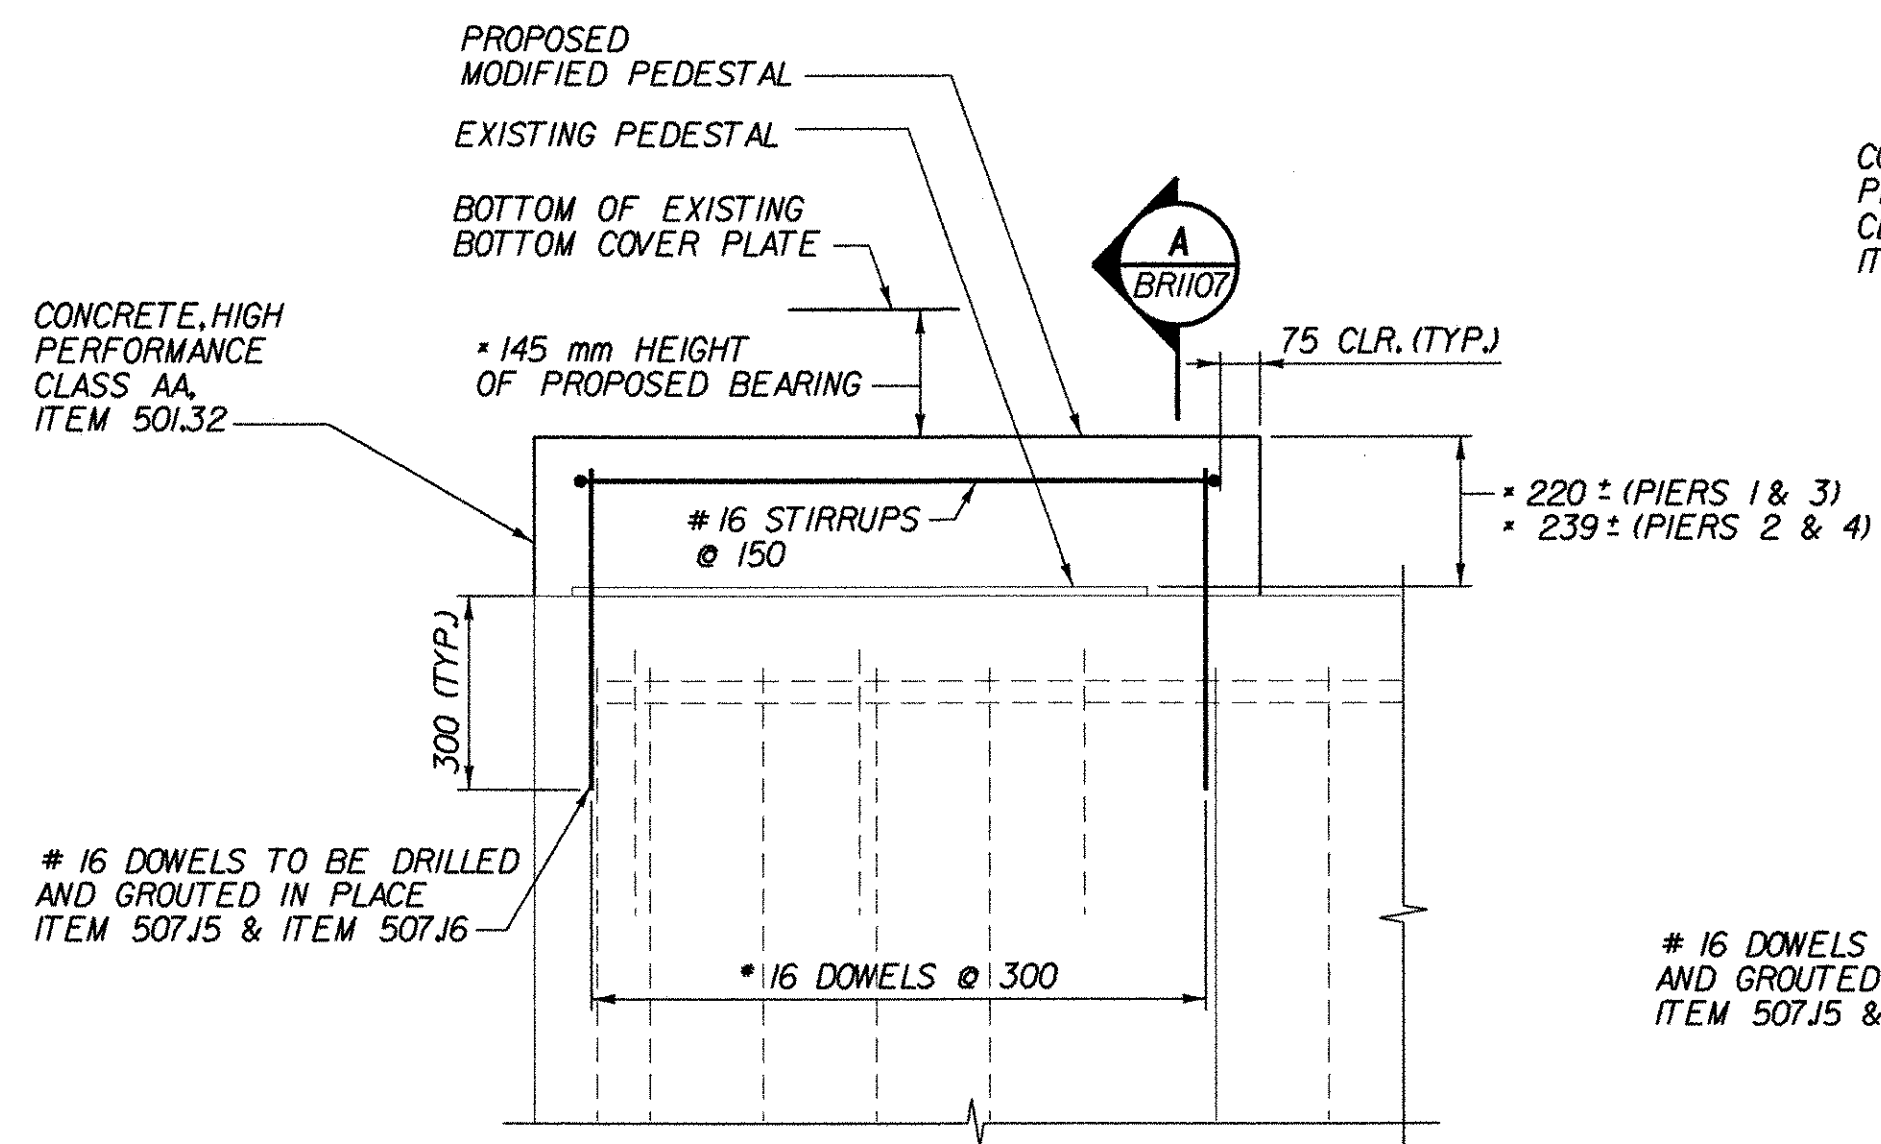



**FASCIA PEDESTAL ELEVATION**

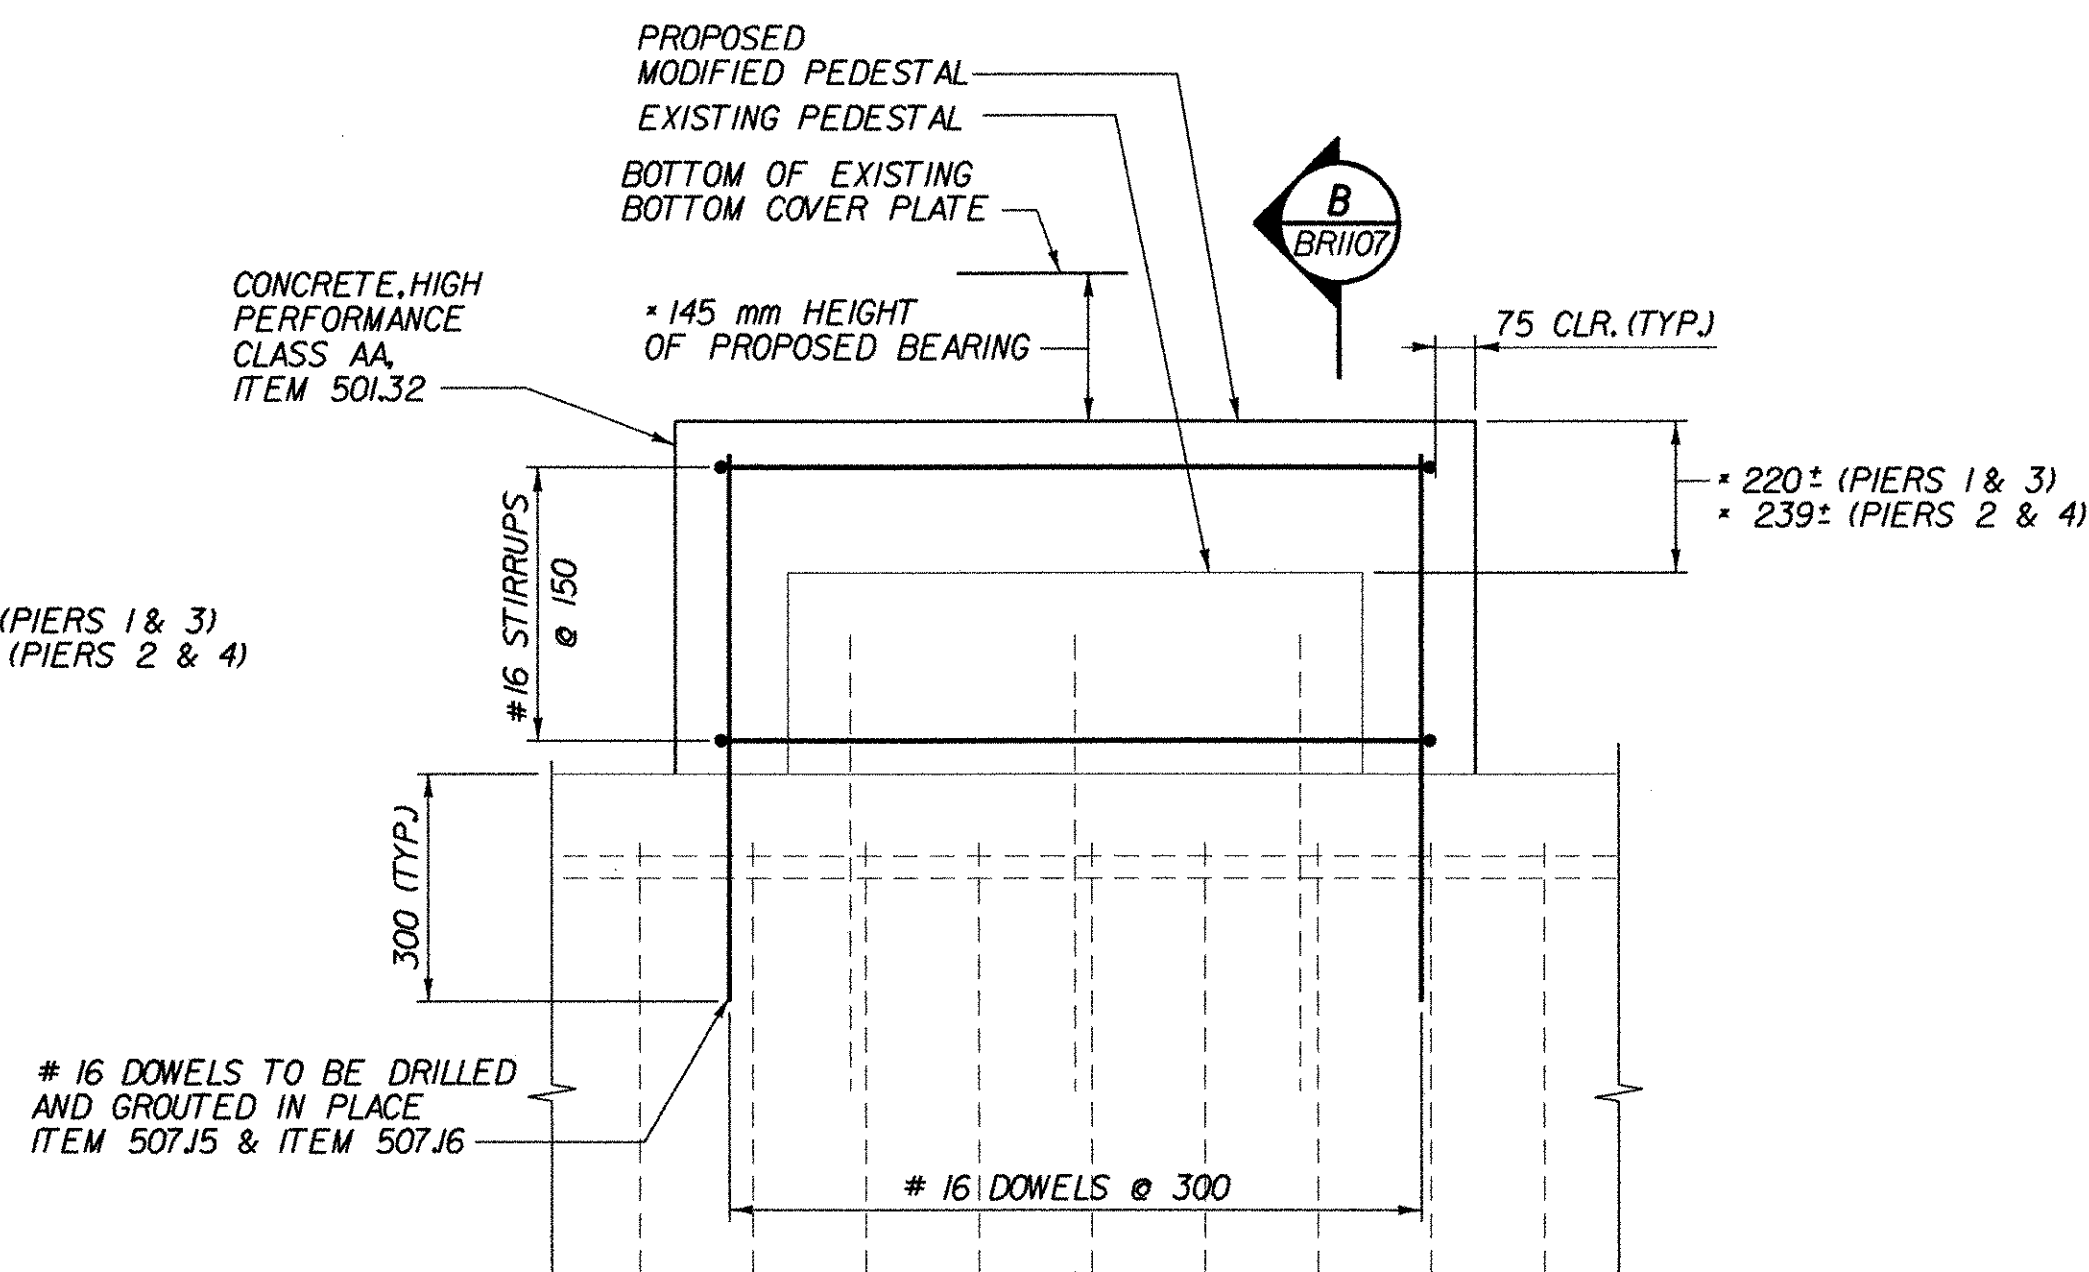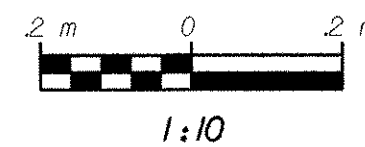


**INTERIOR PEDESTAL ELEVATION**

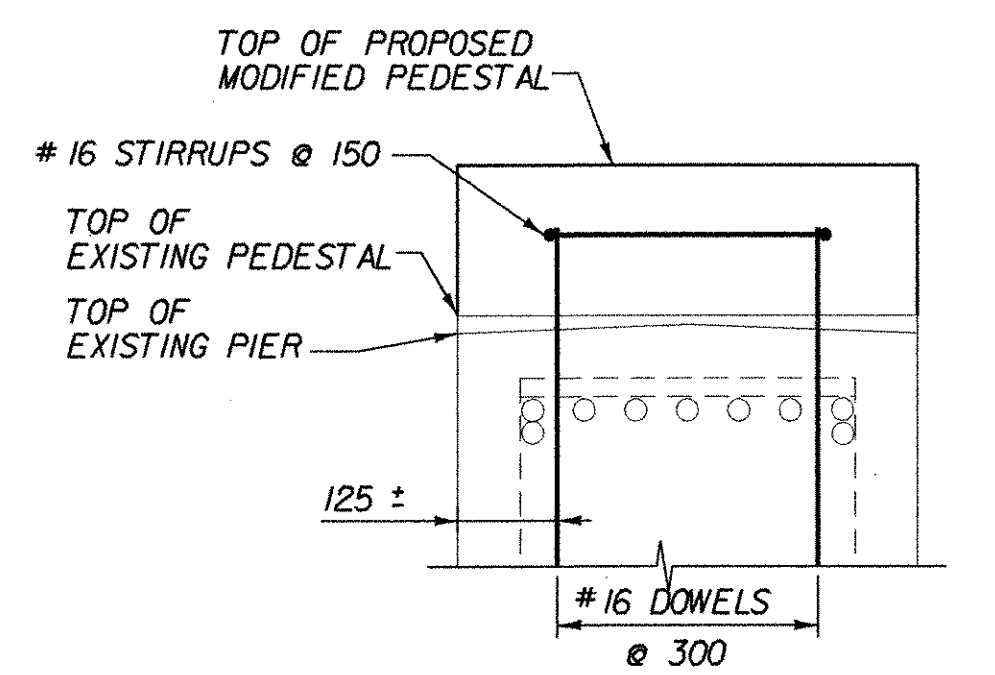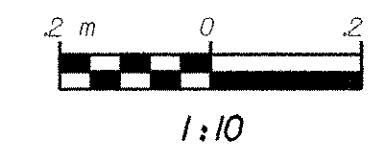

**FASCIA PEDESTAL SECTION**

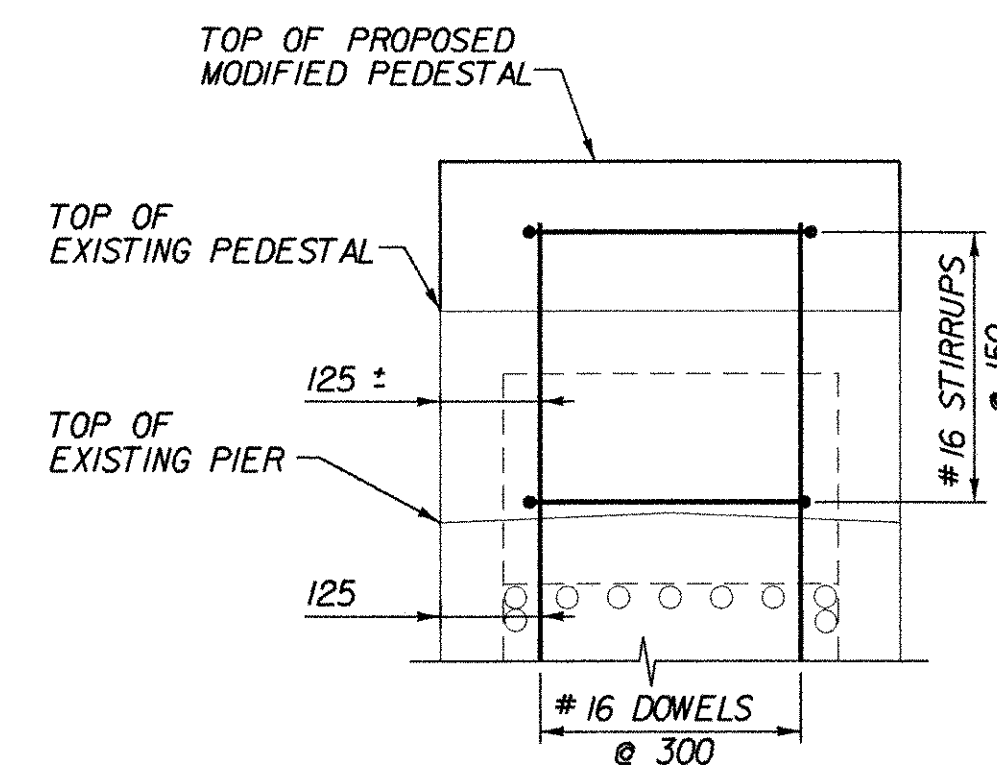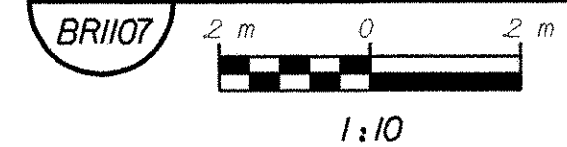

**INTERIOR PEDESTAL SECTION**

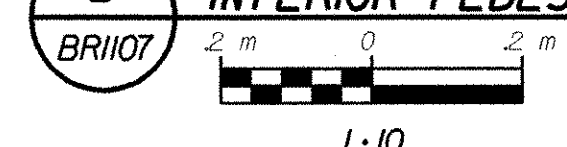

**NOTES:**

1. TOP OF EXISTING ANCHOR BOLTS SHALL BE CUT OFF TO MAINTAIN A MINIMUM OF 50 mm COVER IF NECESSARY, COST TO BE SUBSIDIARY TO ITEM 531J0.
2. TOP OF PROPOSED PEDESTALS SHALL BE ADJUSTED TO MATCH EXISTING GIRDER ELEVATIONS AND TO FIT THE ACTUAL BEARING SUPPLIED BY THE CONTRACTOR.
3. EXISTING CONCRETE SHALL BE THOROUGHLY COATED WITH NEAT CEMENT PASTE BEFORE NEW CONCRETE IS POURED AS PER SUBSECTION 501J3B.



**STATE OF VERMONT  
AGENCY OF TRANSPORTATION**

Town of	BENNINGTON	Bridge No.	BRI100
Highway No.	VT. RTE. 279	Log Sta.	
		Surv. Sta.	17+780
VT. RTE. 279 OVER VT. RAILWAY			
<b>PEDESTAL DETAILS</b>			
Designed By	D. STECIAK	Drawn by	B. WEATHERBY
Checked By	M.W. OLSTAD	Date	02/04
		Bridge Design Supervisor	M.W. OLSTAD
		Date	02/04
PROJECT	BENNINGTON-HOOSICK	PROJECT NO.	D.P.I. 0146(I) C/6
I.G.C. Info.			
Bridge Sheet No.	BRI107	Sheet	74 OF 83

NOTE: UNLESS NOTED OTHERWISE, ALL STATIONS ARE IN KILOMETERS, ALL ELEVATIONS ARE IN METERS, AND ALL DIMENSIONS ARE IN MILLIMETERS.

THESE CONTRACT DOCUMENTS HAVE BEEN PREPARED BASED ON LIMITED FIELD INVESTIGATION AND RECORD DRAWINGS AVAILABLE AT THE TIME. ACTUAL FIELD CONDITIONS MAY REQUIRE MODIFICATIONS TO THE CONSTRUCTION DETAILS AND WORK QUANTITIES. THE CONTRACTOR SHALL PERFORM THE WORK IN ACCORDANCE WITH FIELD CONDITIONS. ALL DIMENSIONS AND JOINT LOCATIONS SHALL BE FIELD CHECKED BY THE CONTRACTOR PRIOR TO SUBMISSION OF FABRICATION DRAWINGS FOR APPROVAL.

LIST OF BRIDGE SHEETS	
BR1200	PLAN AND ELEVATION
BR1201	EXISTING TRANSVERSE BRIDGE SECTIONS
BR1202	BRIDGE QUANTITY SHEET
BR1203	BRIDGE RAILING AND CURB DETAILS
BR1204	EXPANSION JOINTS AT EAST ABUTMENTS
BR1205	JOINT DETAILS
BR1206	BEARING LAYOUT PLAN AND DETAILS
BR1207	BEARING DETAILS
BR1208	PEDESTAL DETAILS

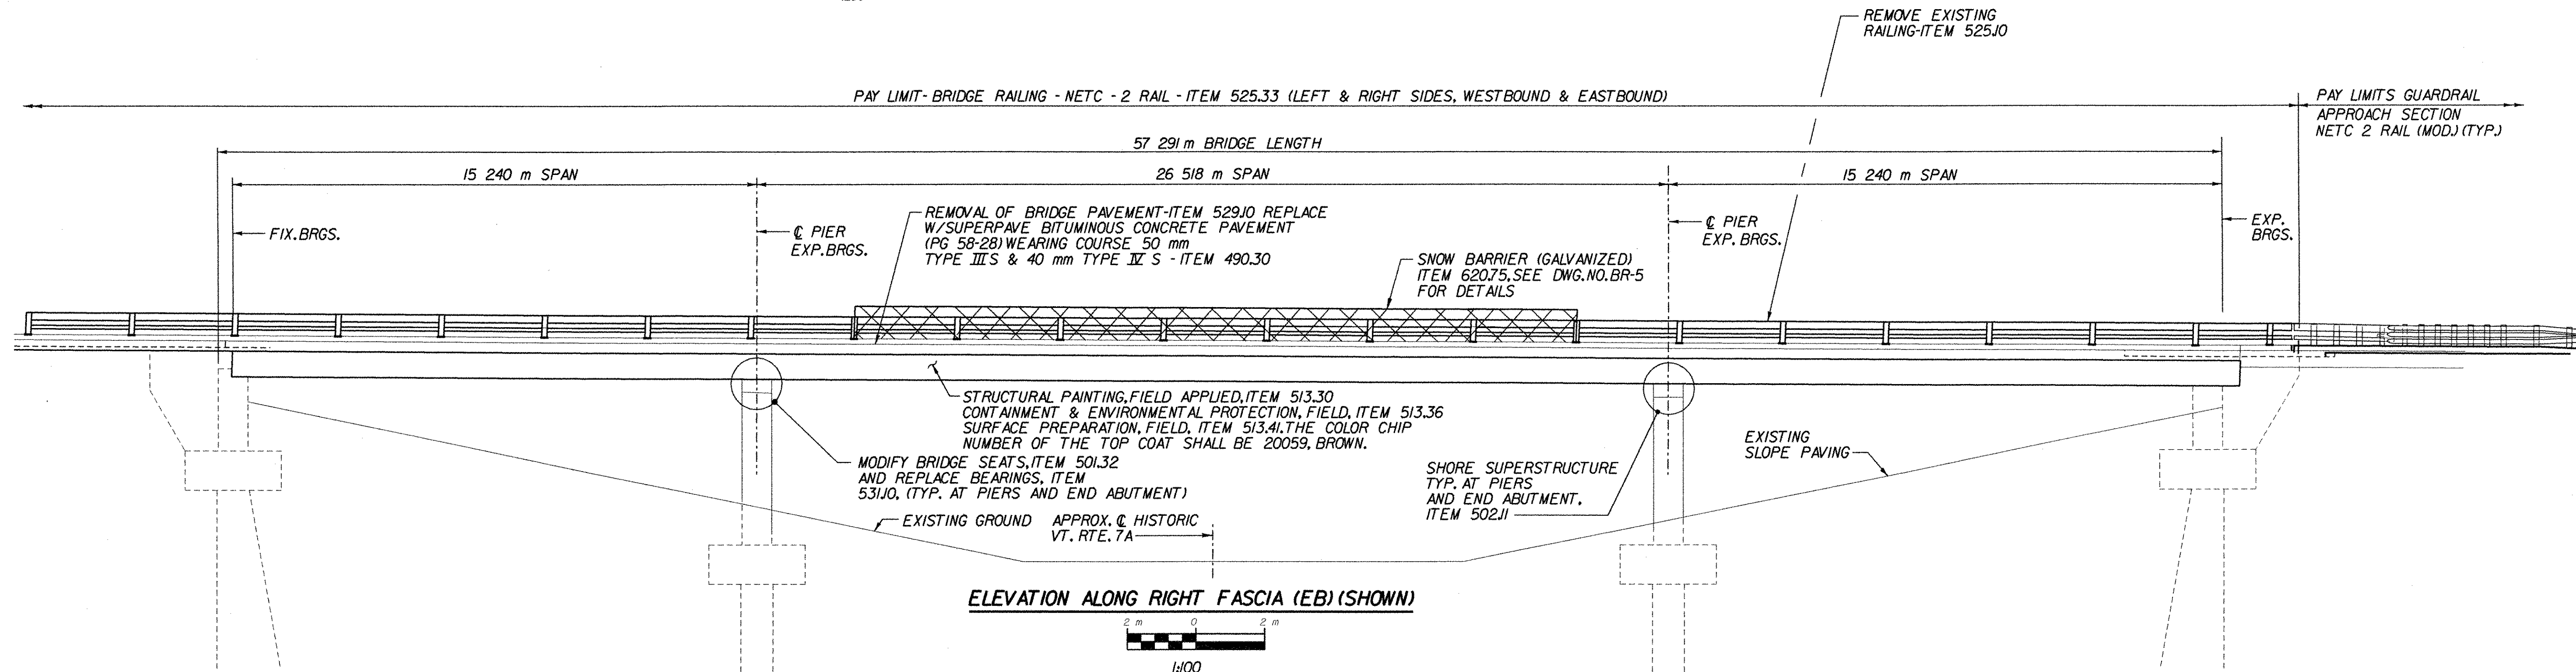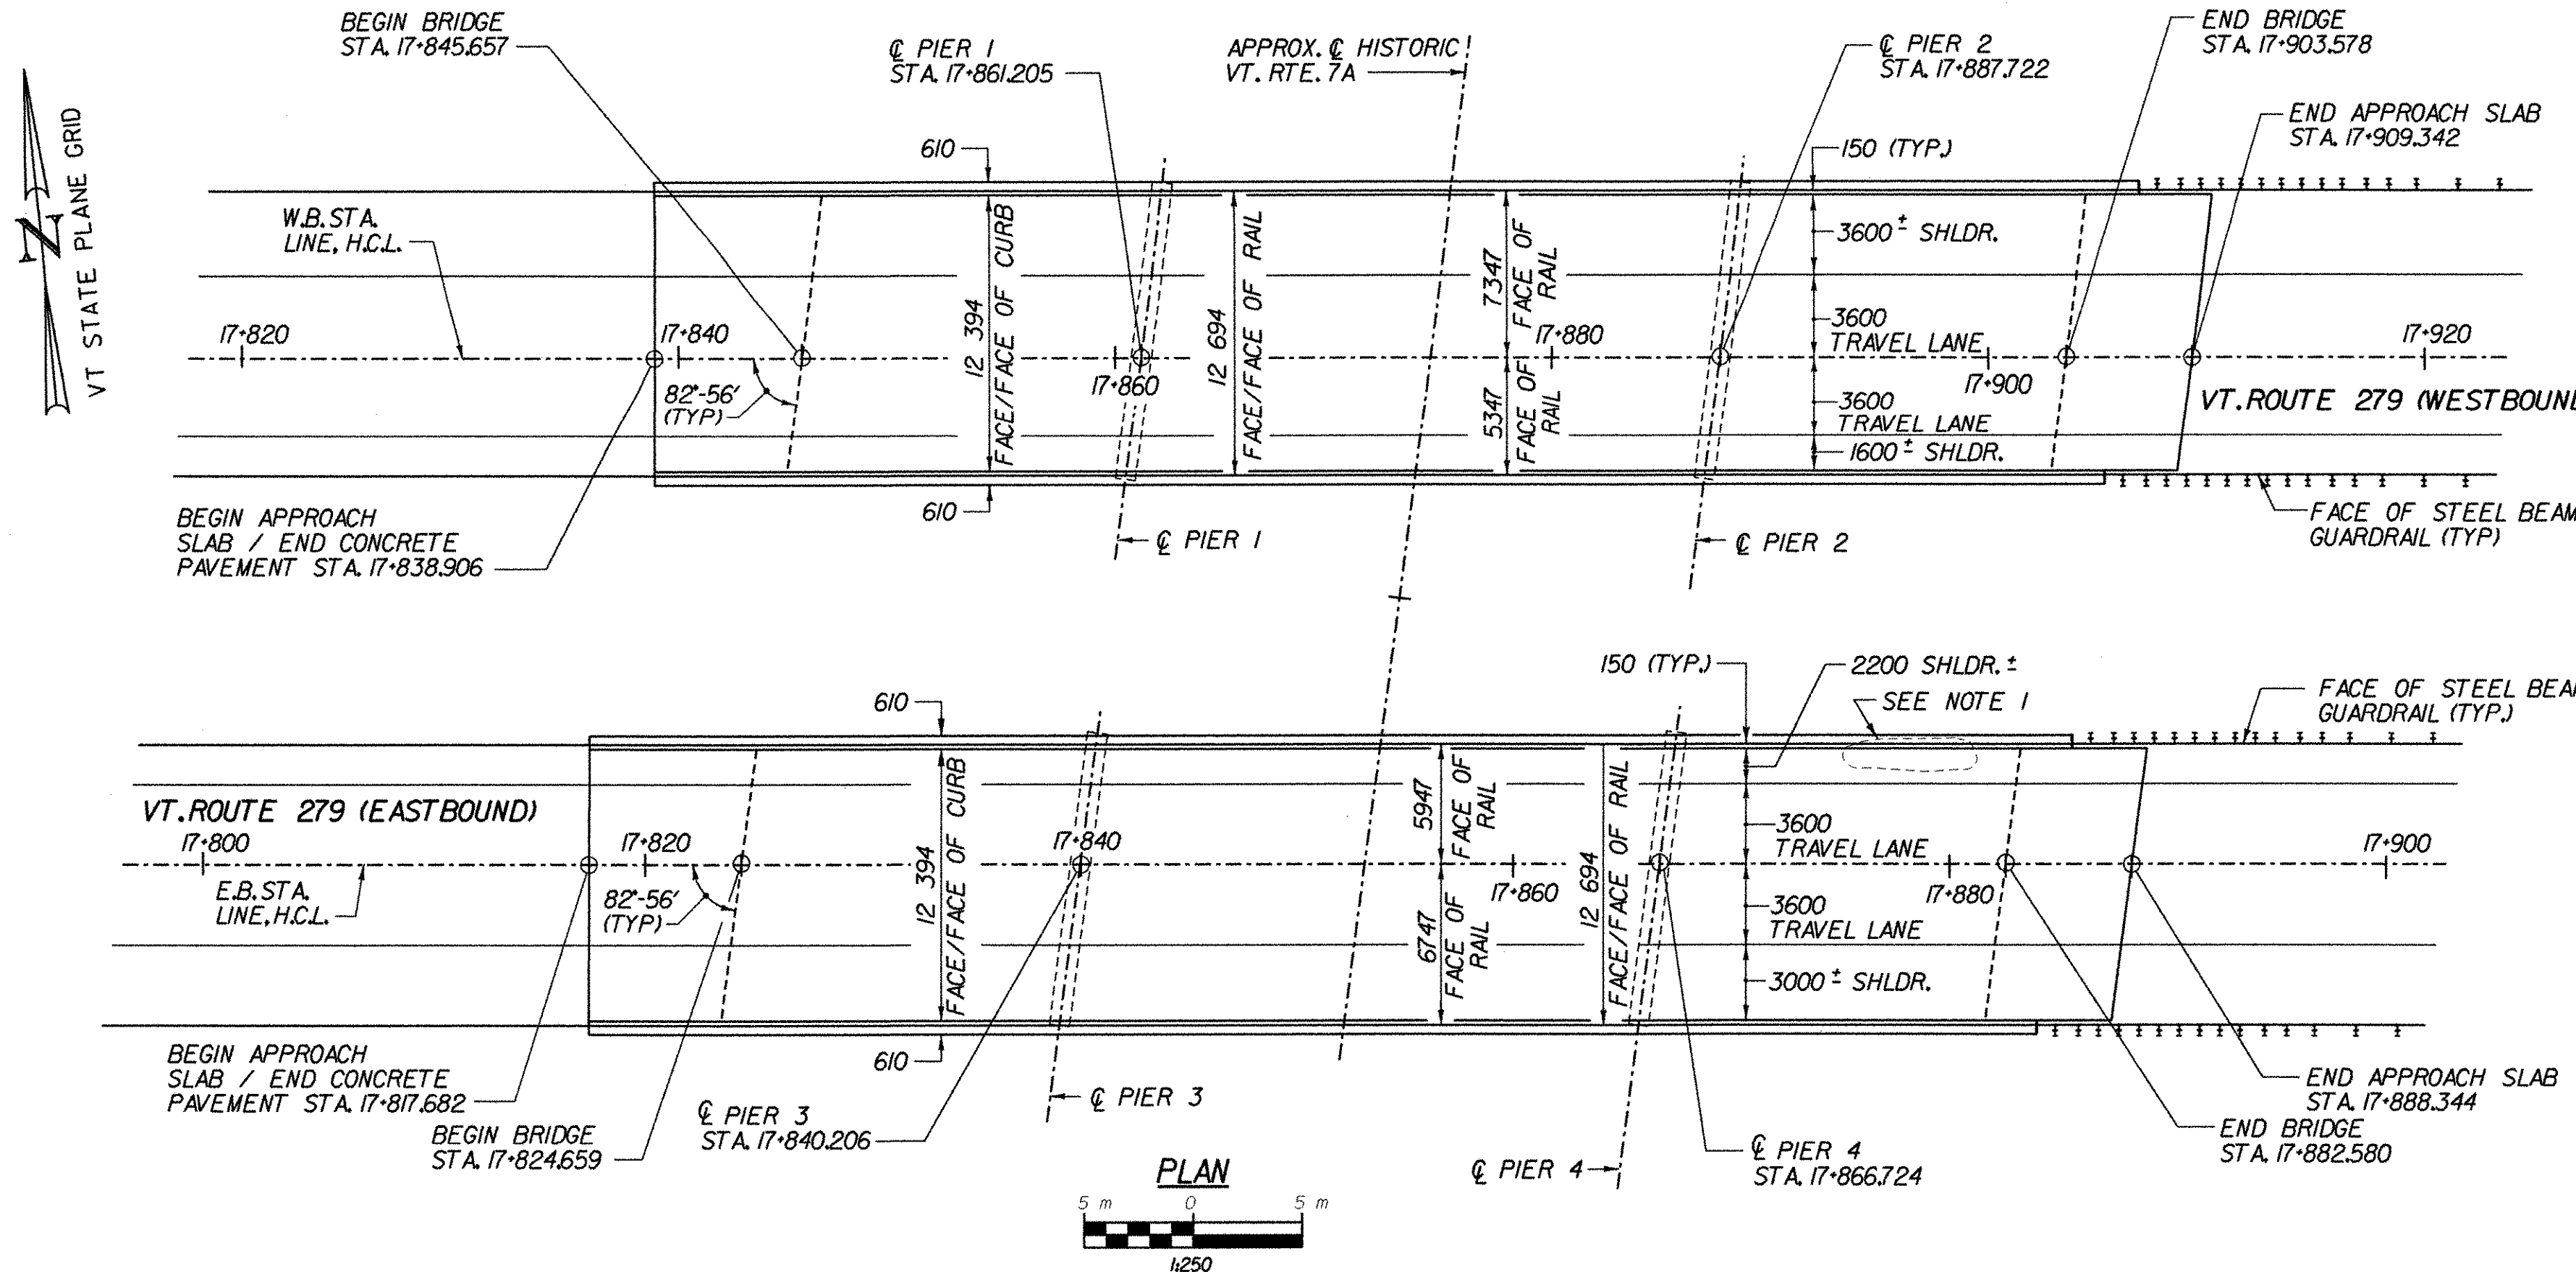


- MAJOR WORK ITEMS:**
1. REMOVE EXISTING RAILING AND REPLACE WITH BRIDGE RAILING - NETC 2 RAIL.
  2. REMOVE EXISTING BRIDGE CURB AND REPLACE WITH CONCRETE CURB.
  3. REMOVE EXISTING BITUMINOUS PAVEMENT AND REPLACE WITH SUPERPAVE BITUMINOUS PAVEMENT.
  4. REPAIR CONCRETE DECK AS NEEDED.
  5. CLEAN AND PAINT SUPERSTRUCTURE.
  6. SHORE SUPERSTRUCTURE, MODIFY PIER AND END ABUTMENT BRIDGE SEATS, AND REPLACE ALL PIER AND END ABUTMENT BEARINGS

**NOTE:**  
 1. SETTLED PAVERS TO BE RESET ITEM 613.20, AS DIRECTED BY RESIDENT ENGINEER.  
 SPALLED PAVERS TO BE REPLACED, ITEM 613.20, AS DIRECTED BY RESIDENT ENGINEER.



**STATE OF VERMONT  
 AGENCY OF TRANSPORTATION**

Town Of	BENNINGTON	Bridge No.	BR1200
Highway No.	VT. RTE. 279	Log Sta.	
		Surv. Sta.	17+853
VT. RTE. 279 OVER HISTORIC VT. ROUTE 7A			
PLAN AND ELEVATION			
Designed By	D. STECIAK	Drawn by	K. RAPELLO
Checked By	M. W. OLSTAD	Date	02/04
		Bridge Design Supervisor	M. W. OLSTAD
		Date	02/04
PROJECT	BENNINGTON-HOOSICK	PROJECT NO.	D.P.I. 0146(1) C/6
I.C.C. Info.			
Bridge Sheet No.	BR1200	Sheet	75 OF 83


NOTE: UNLESS NOTED OTHERWISE, ALL STATIONS ARE IN KILOMETERS, ALL ELEVATIONS ARE IN METERS, AND ALL DIMENSIONS ARE IN MILLIMETERS.

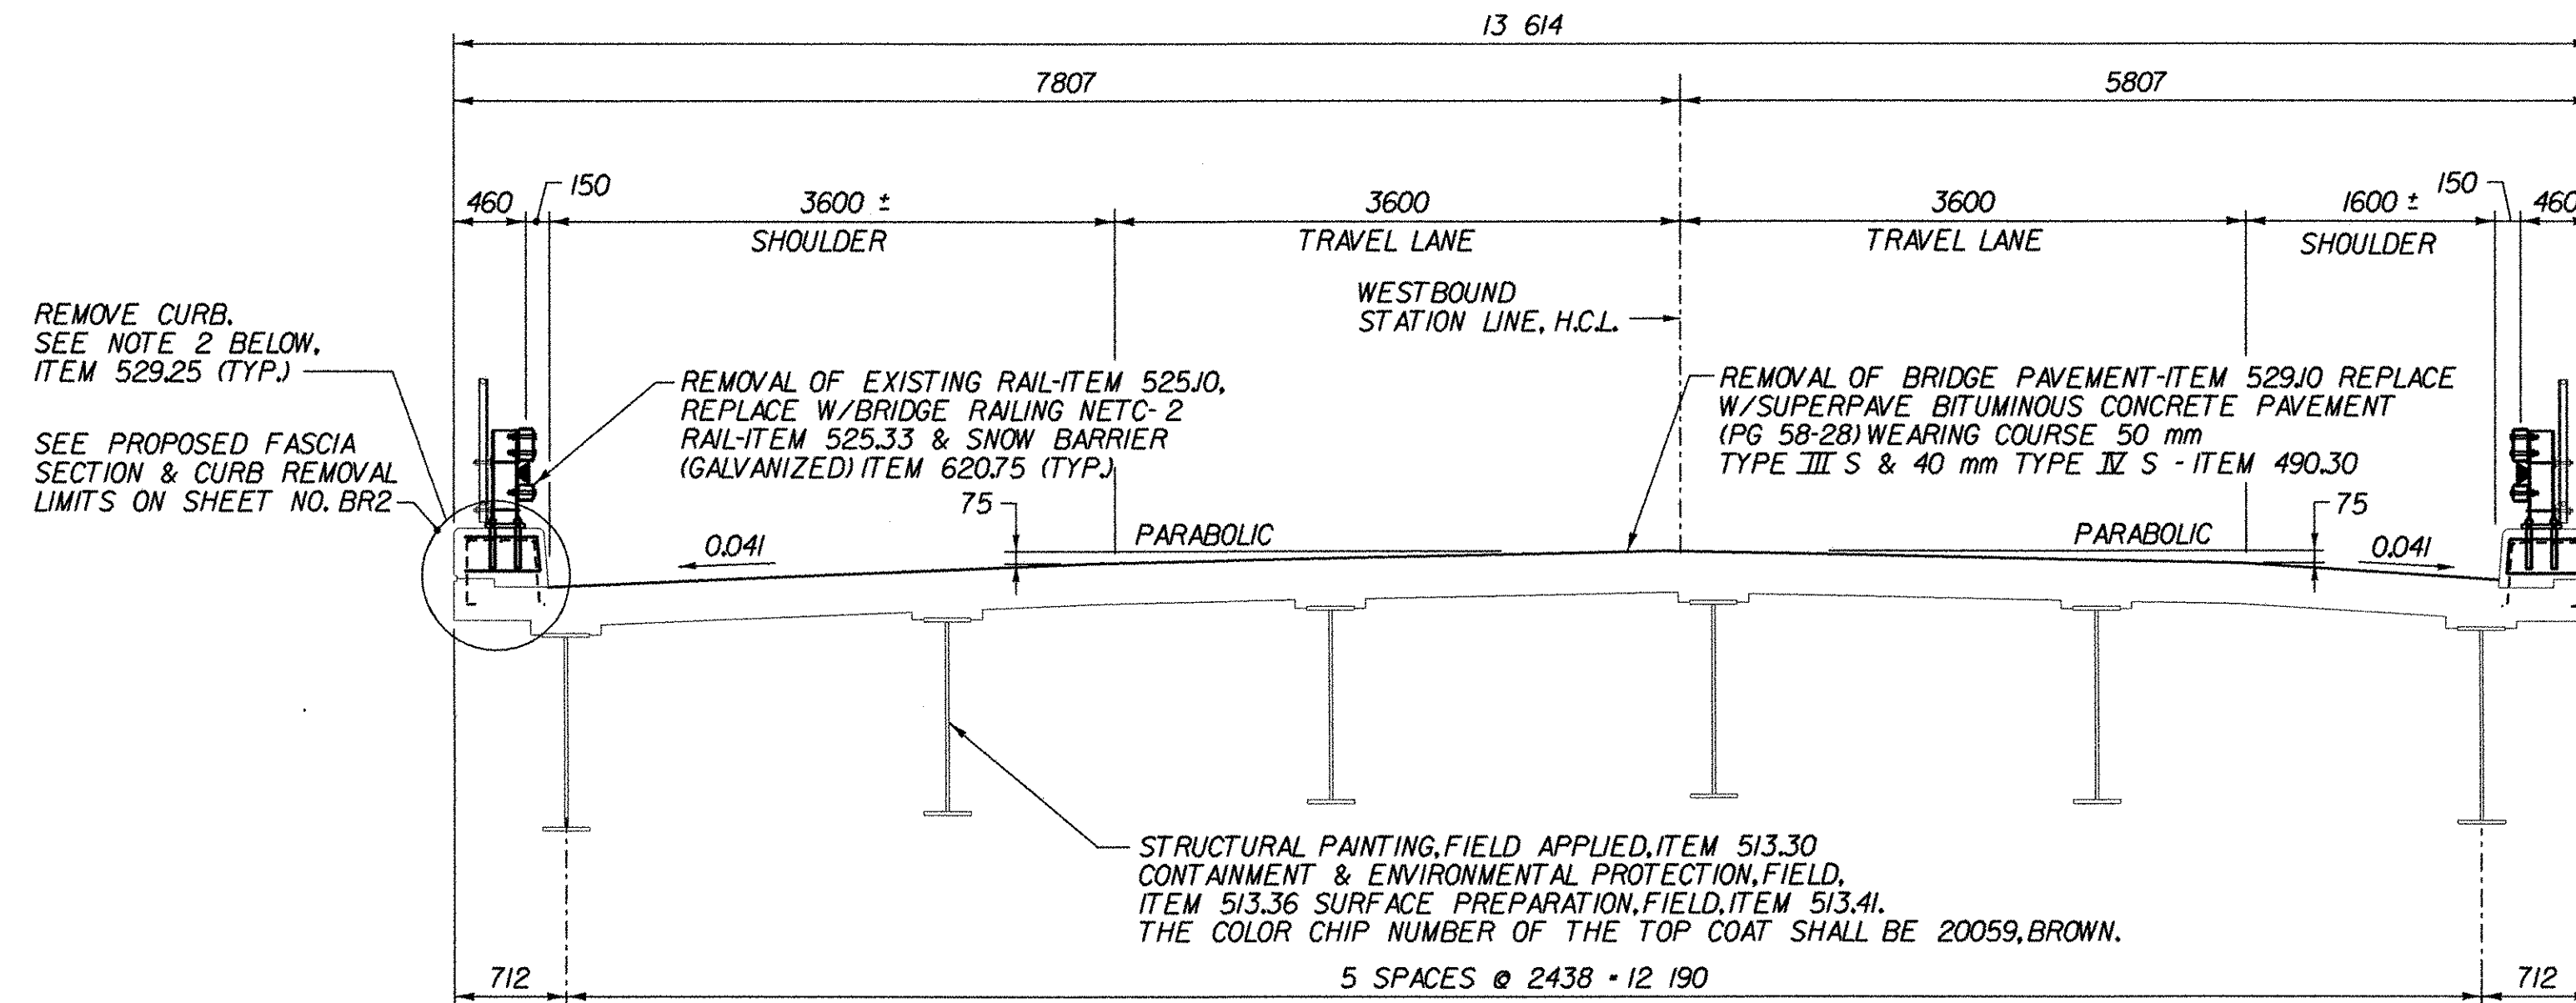

TYPICAL BRIDGE SECTION (WESTBOUND)

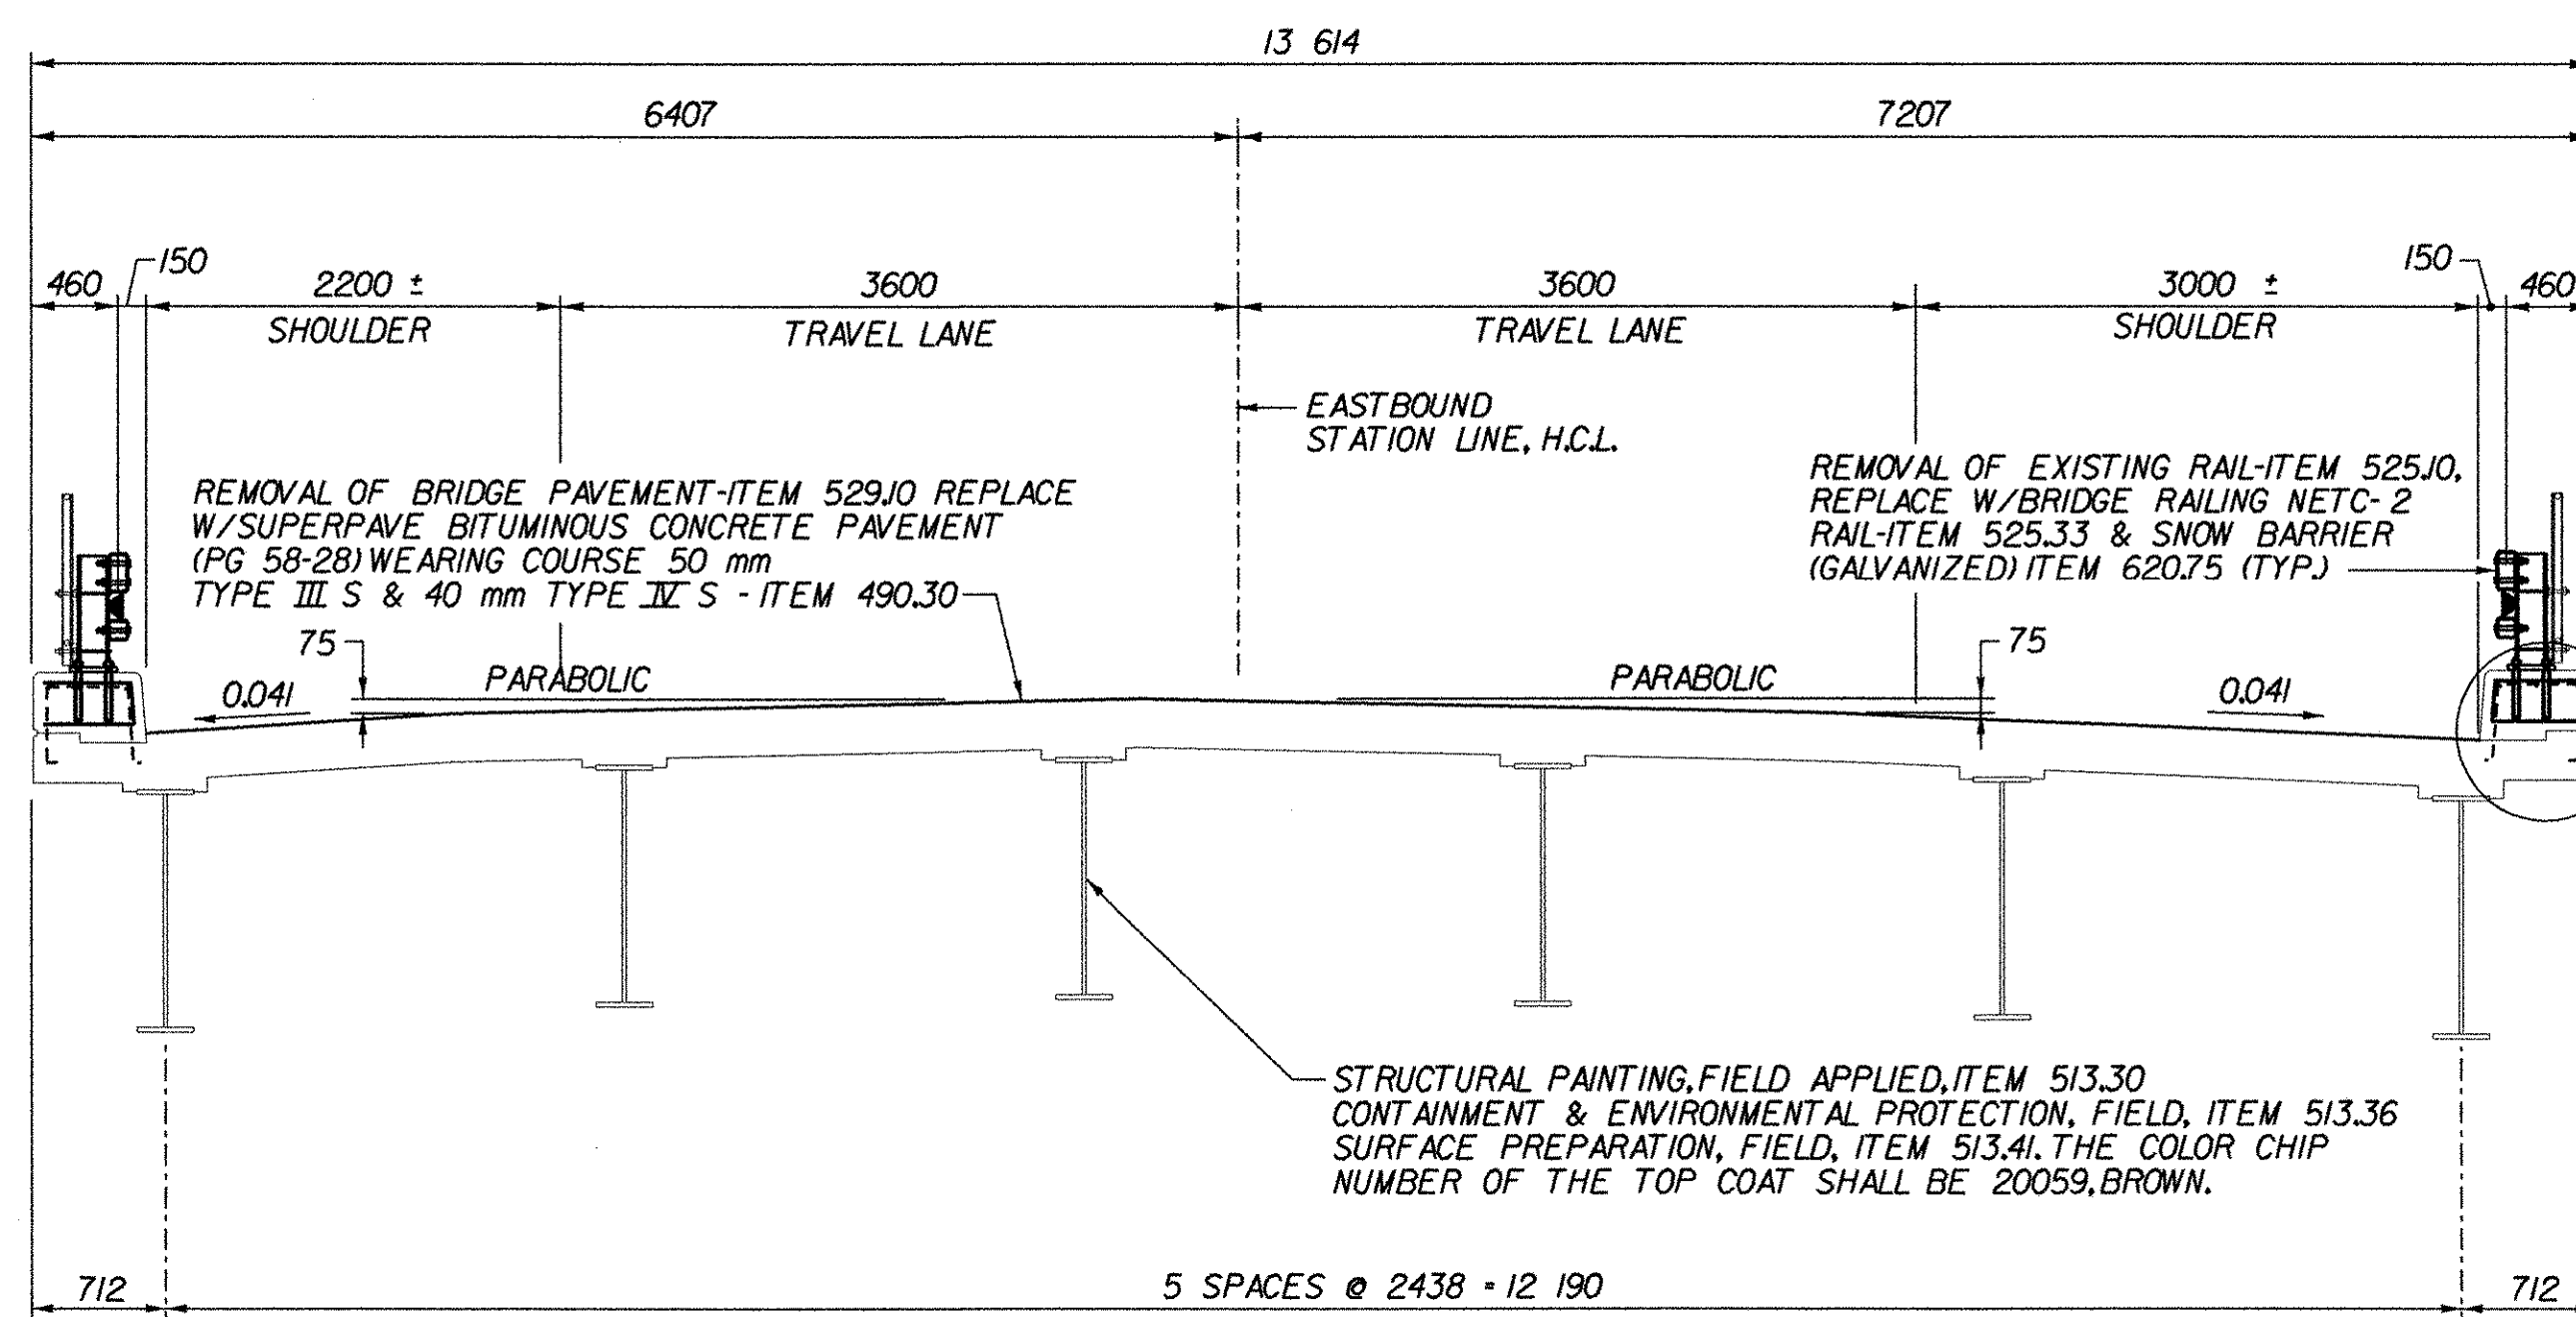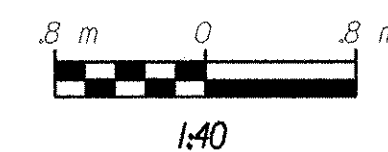

TYPICAL BRIDGE SECTION (EASTBOUND)

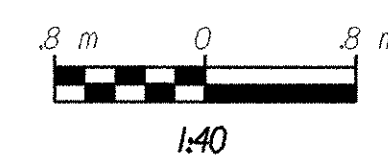

RAILING ANCHORAGE NOTE:

- NEW ASTM A449-22 mm DIAMETER ANCHOR BOLTS TO BE CAST-IN-PLACE SHALL BE FURNISHED WITH TWO NUTS AND ONE WASHER. BOLTS, NUTS AND WASHERS SHALL BE FURNISHED UNDER ITEM 525.33. BRIDGE RAILING NETC - 2 RAIL.

LOADING LEVELS (LOAD FACTOR)	LOAD FACTOR LOAD RATING (METRIC TON)						
	M	MS	3S2	6 AXLE	3A.STR.	4A.STR.	5A.SEMI
INVENTORY A = 2.17, B = 1.00	19	35					
POSTED A = 1.55, B = 1.80	26	49	65		56	54	61
OPERATING A = 1.30, B = 1.67		58	77	77	63	64	

RF = $\phi M_n - 1.3 M_{DL}$	*SERVICEABILITY RF = B	$.95 F_y S_{LL} + I - M_{DL}$	$\frac{S_{LL} + I}{S_{DL}} - M_{SDL}$	$\frac{S_{LL} + I}{S_{SDL}}$	
$A \times M_{LL} + I$	PROJECTED TRAFFIC DATA	$1.67 M_{LL} + I$			
YEAR	ADT	DHV	% D	% T	ADTT
2000	5300	-	-	-	-
2020	6600	840	52%	7%	460

20 YEAR ESAL FOR FLEXIBLE PAVEMENT FROM 2000 TO 2020 : 4,825,000  
40 YEAR ESAL FOR FLEXIBLE PAVEMENT FROM 2000 TO 2040 : 17,229,000  
DESIGN SPEED: 100 km/h

NOTES:



- SEE SHEET NO. BR3 FOR ASPHALT OVERLAY REMOVAL AND REPLACEMENT NOTES FOR DECK SLAB REPAIR DETAILS.
- SEE SHEET NO. BR2 FOR CURB REMOVAL AND REPLACEMENT DETAILS.

STATE OF VERMONT  
AGENCY OF TRANSPORTATION


Town Of	BENNINGTON	Bridge No.	BR1200
Highway No.	VT. RTE. 279	Log Sta.	
		Surv. Sta.	17+853
VT. RTE. 279 OVER HISTORIC VT. ROUTE 7A			
EXISTING TRANSVERSE BRIDGE SECTIONS			
Designed By	D. STECIAK	Drawn by	K. RAPELLO/WM. WEATHERBY
Checked By	Date	Bridge Design Supervisor	
M.W. OLSTAD	02/04	M.W. OLSTAD	Date 02/04
PROJECT	BENNINGTON-HOOSICK	PROJECT NO.	D.P.I. 0146(I) C/6
I.G.C. Info.			
Bridge Sheet No.	BR1201	Sheet	76 OF 83




NOTE: UNLESS NOTED OTHERWISE, ALL STATIONS ARE IN KILOMETERS, ALL ELEVATIONS ARE IN METERS, AND ALL DIMENSIONS ARE IN MILLIMETERS.

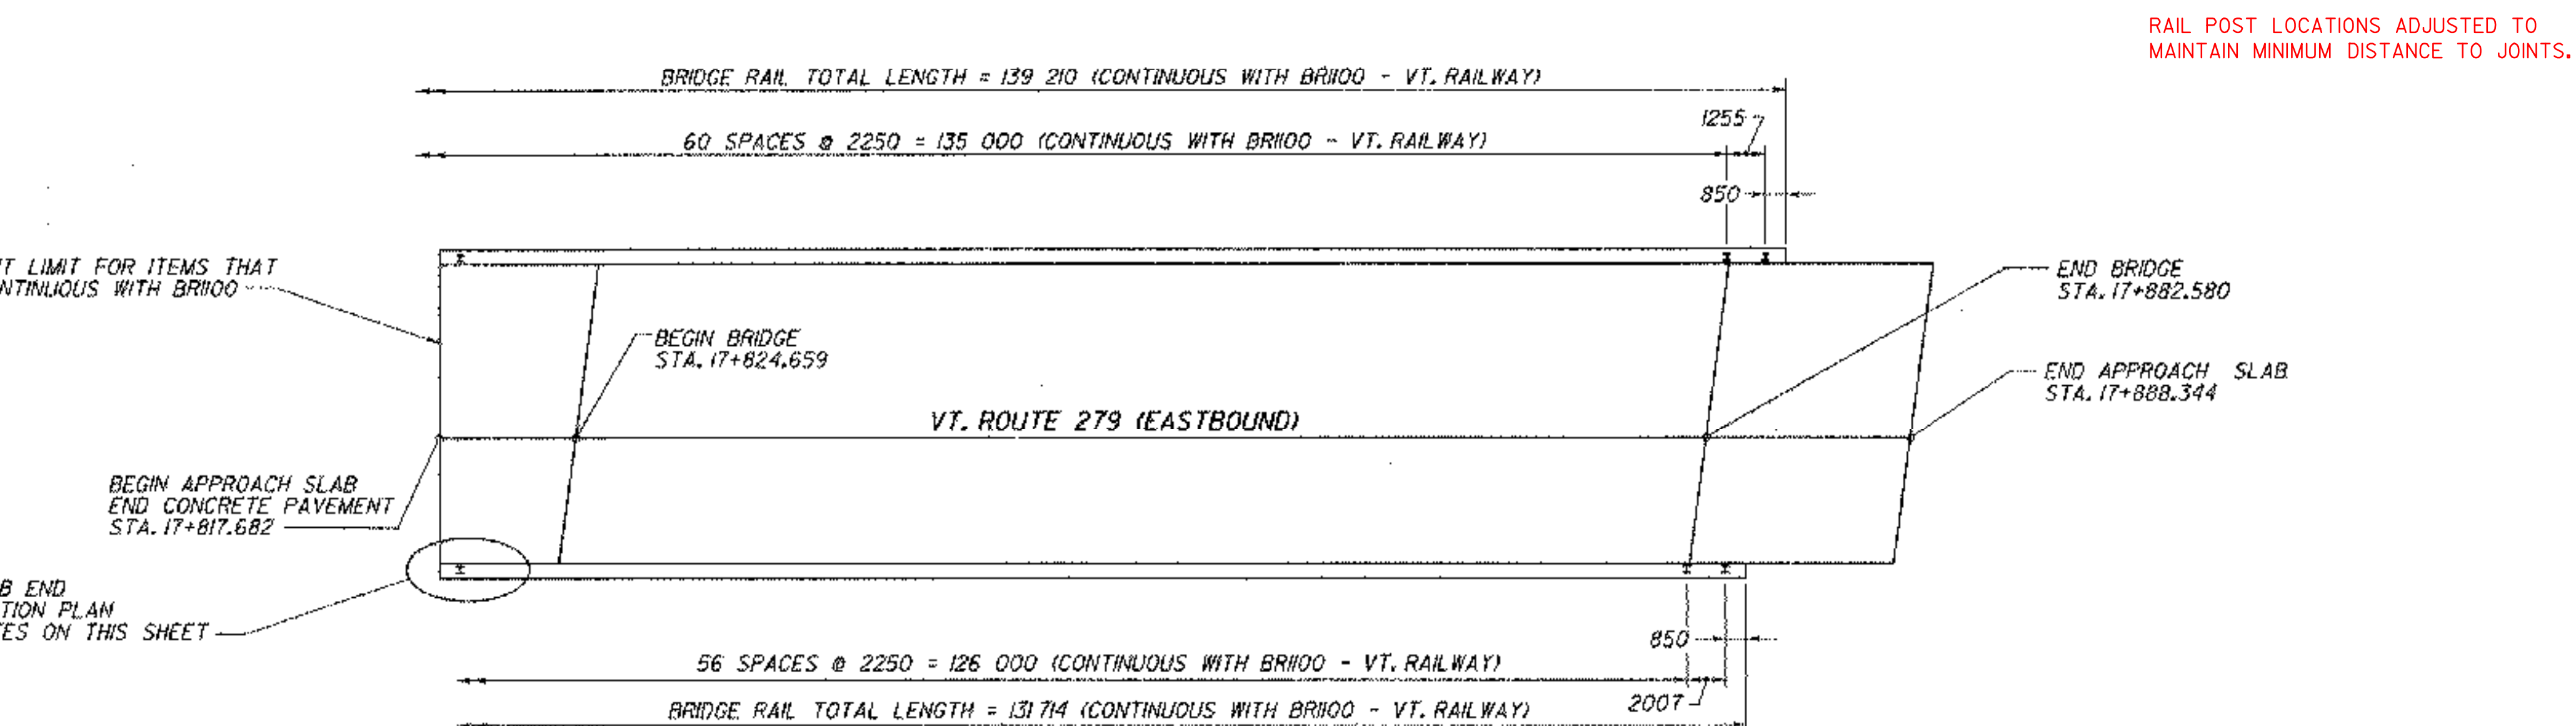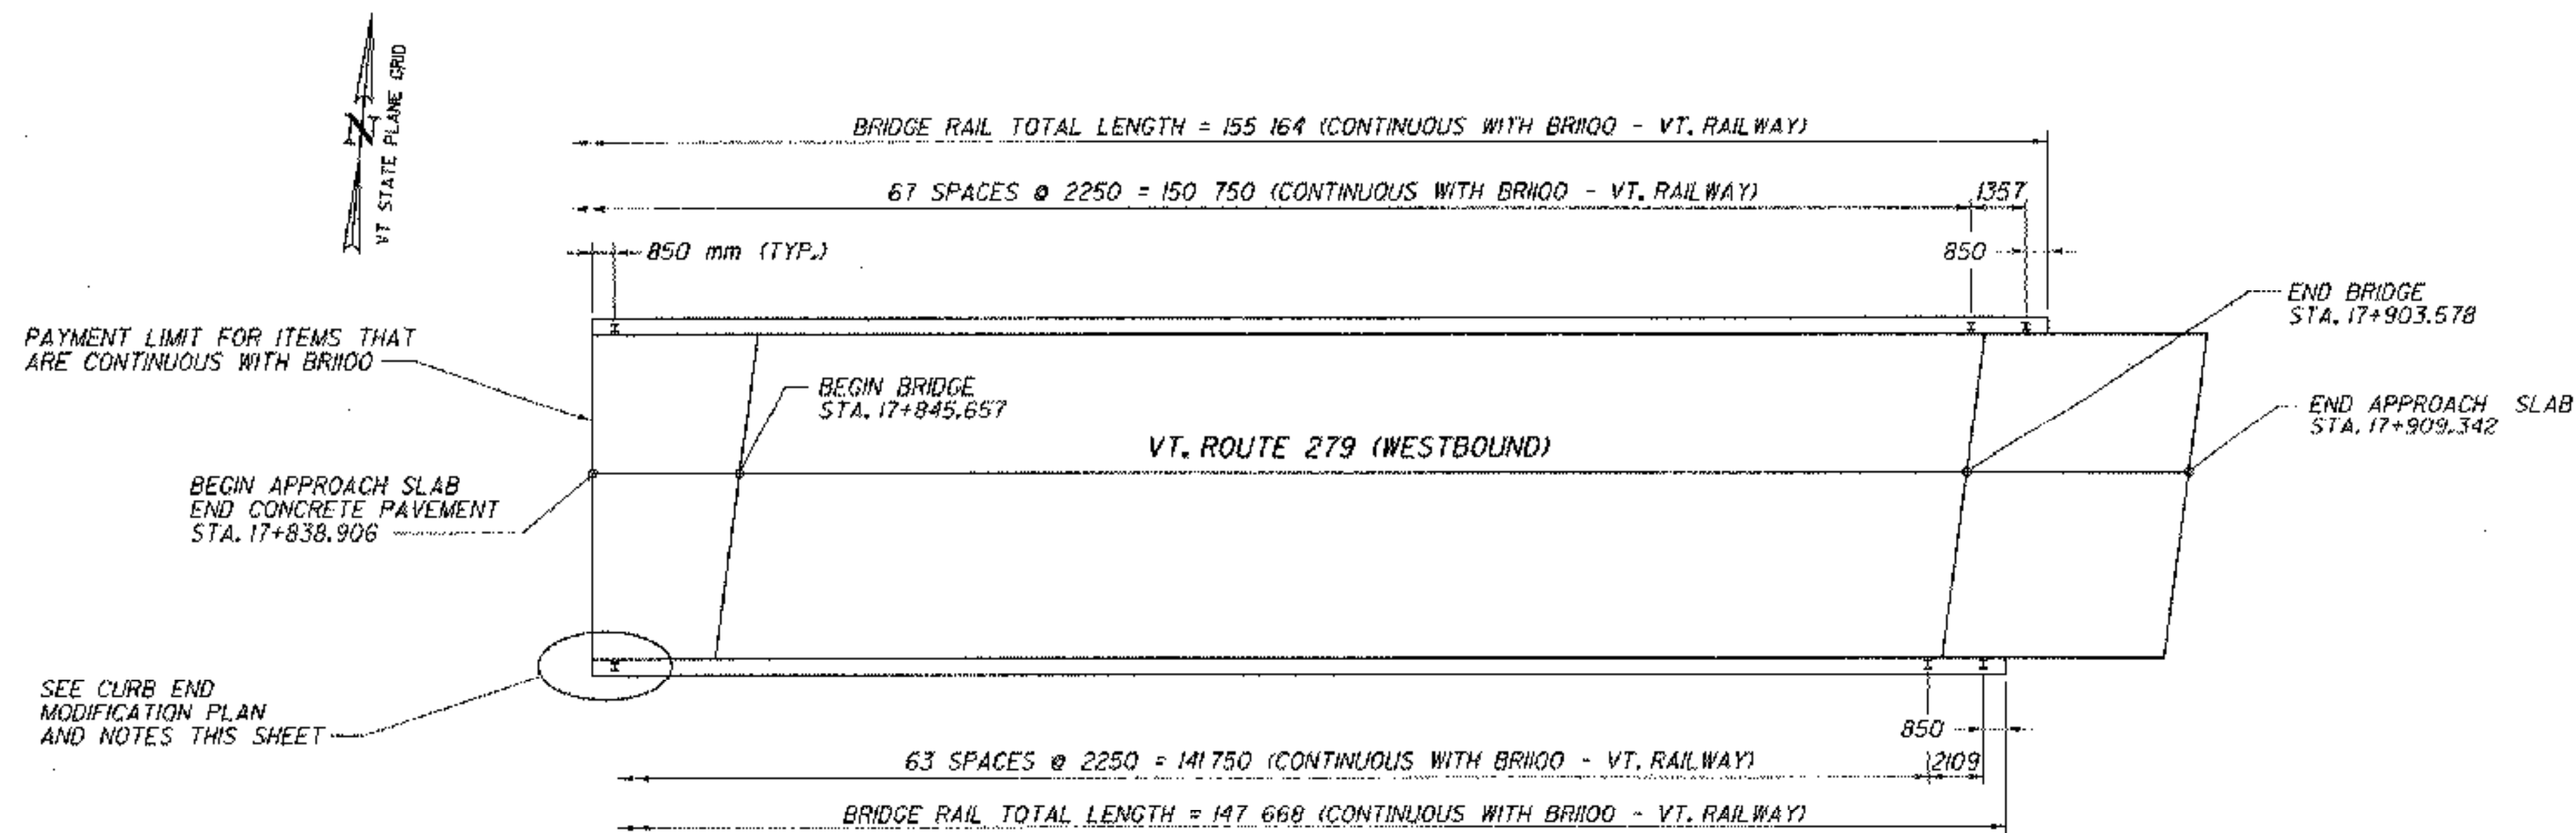

RAILING LAYOUT PLAN

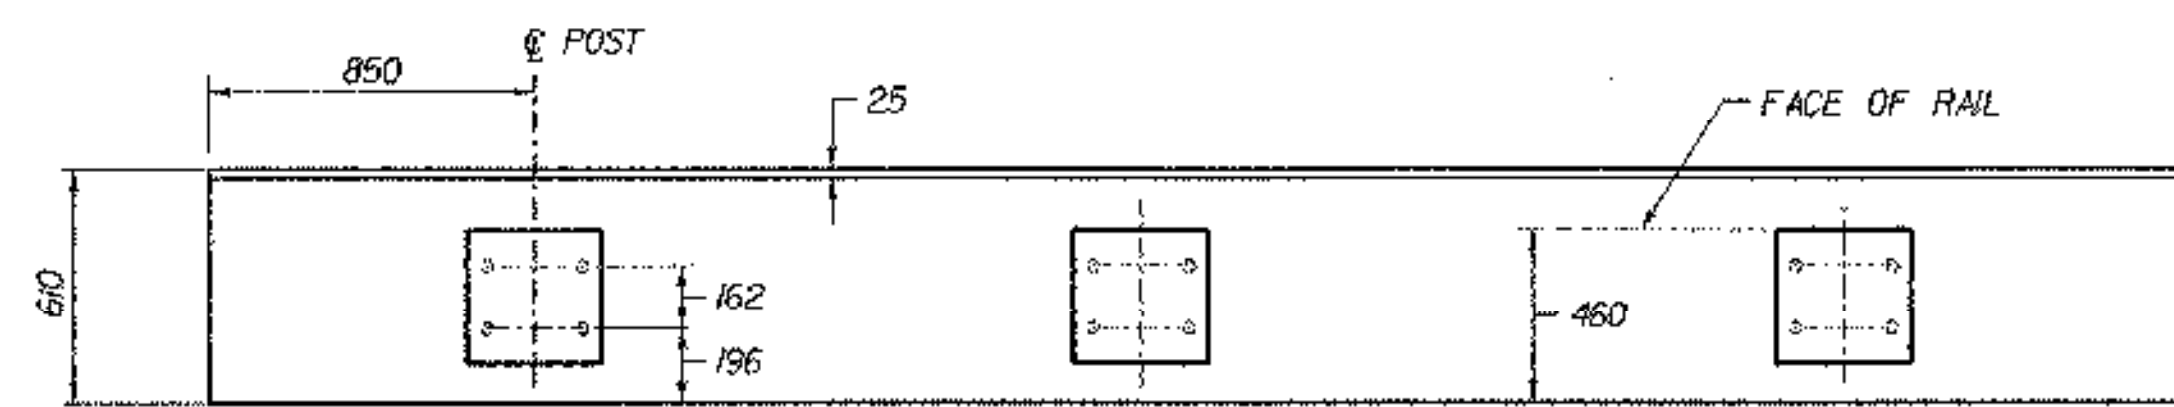

TYPICAL CURB END MODIFICATION PLAN

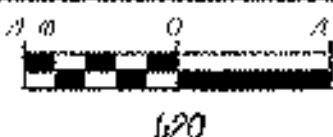

**CURB END MODIFICATION NOTES:**



- EXISTING CONCRETE SHALL BE SAW CUT 25 mm DEEP AT ENDS AND ALONG CENTER OF SCORE MARK BEFORE REMOVING.
- REMOVAL OF CURBING AND CONCRETE AT EACH CORNER OF BRIDGE WILL BE PAID FOR UNDER ITEM 529.25, REMOVAL OF CONCRETE OR MASONRY.
- EXISTING CONCRETE SHALL BE THOROUGHLY COATED WITH NEAT CEMENT PASTE BEFORE NEW CONCRETE IS POURED AS PER SUBSECTION 501.3B.
- NEW CONCRETE IN CURB SECTIONS WILL BE CONCRETE, HIGH PERFORMANCE CLASS AA ITEM 501.32.

NOTE:  
1. SEE SHEET BR103 FOR CONTINUATION OF BRIDGE RAIL LAYOUT.

**STATE OF VERMONT  
AGENCY OF TRANSPORTATION**


Town Of	BENNINGTON	Bridge No.	BR1200
Highway No.	VT. RTE. 279	Log Sta.	
		Surv. Sta.	17+853
VT. RTE. 279 OVER HISTORIC VT. ROUTE 7A			
<b>BRIDGE RAILING AND CURB DETAILS</b>			
Designed By	D. STECIAK	Drawn by	K. RAPELLO
Checked By	M. W. OLSTAD	Date	02/04
		Bridge Design Supervisor	M. W. OLSTAD
		Date	02/04
PROJECT	BENNINGTON-HOOSICK		PROJECT NO.
			D.P.I. 014611 C/6
L.G.C. Info.			
Bridge Sheet No.	BR1203	Sheet 78 OF 83	

NOTE: UNLESS NOTED OTHERWISE, ALL STATIONS ARE IN KILOMETERS, ALL ELEVATIONS ARE IN METERS, AND ALL DIMENSIONS ARE IN MILLIMETERS.

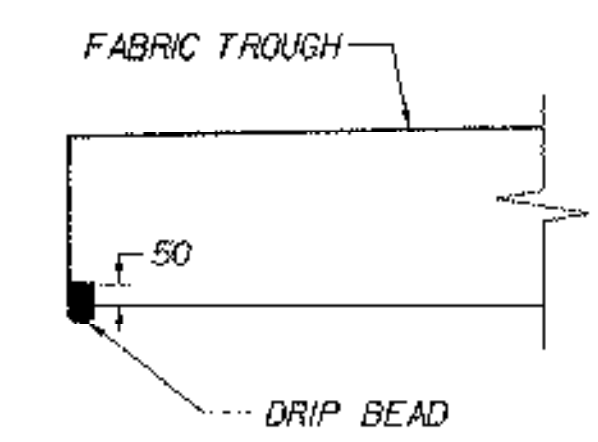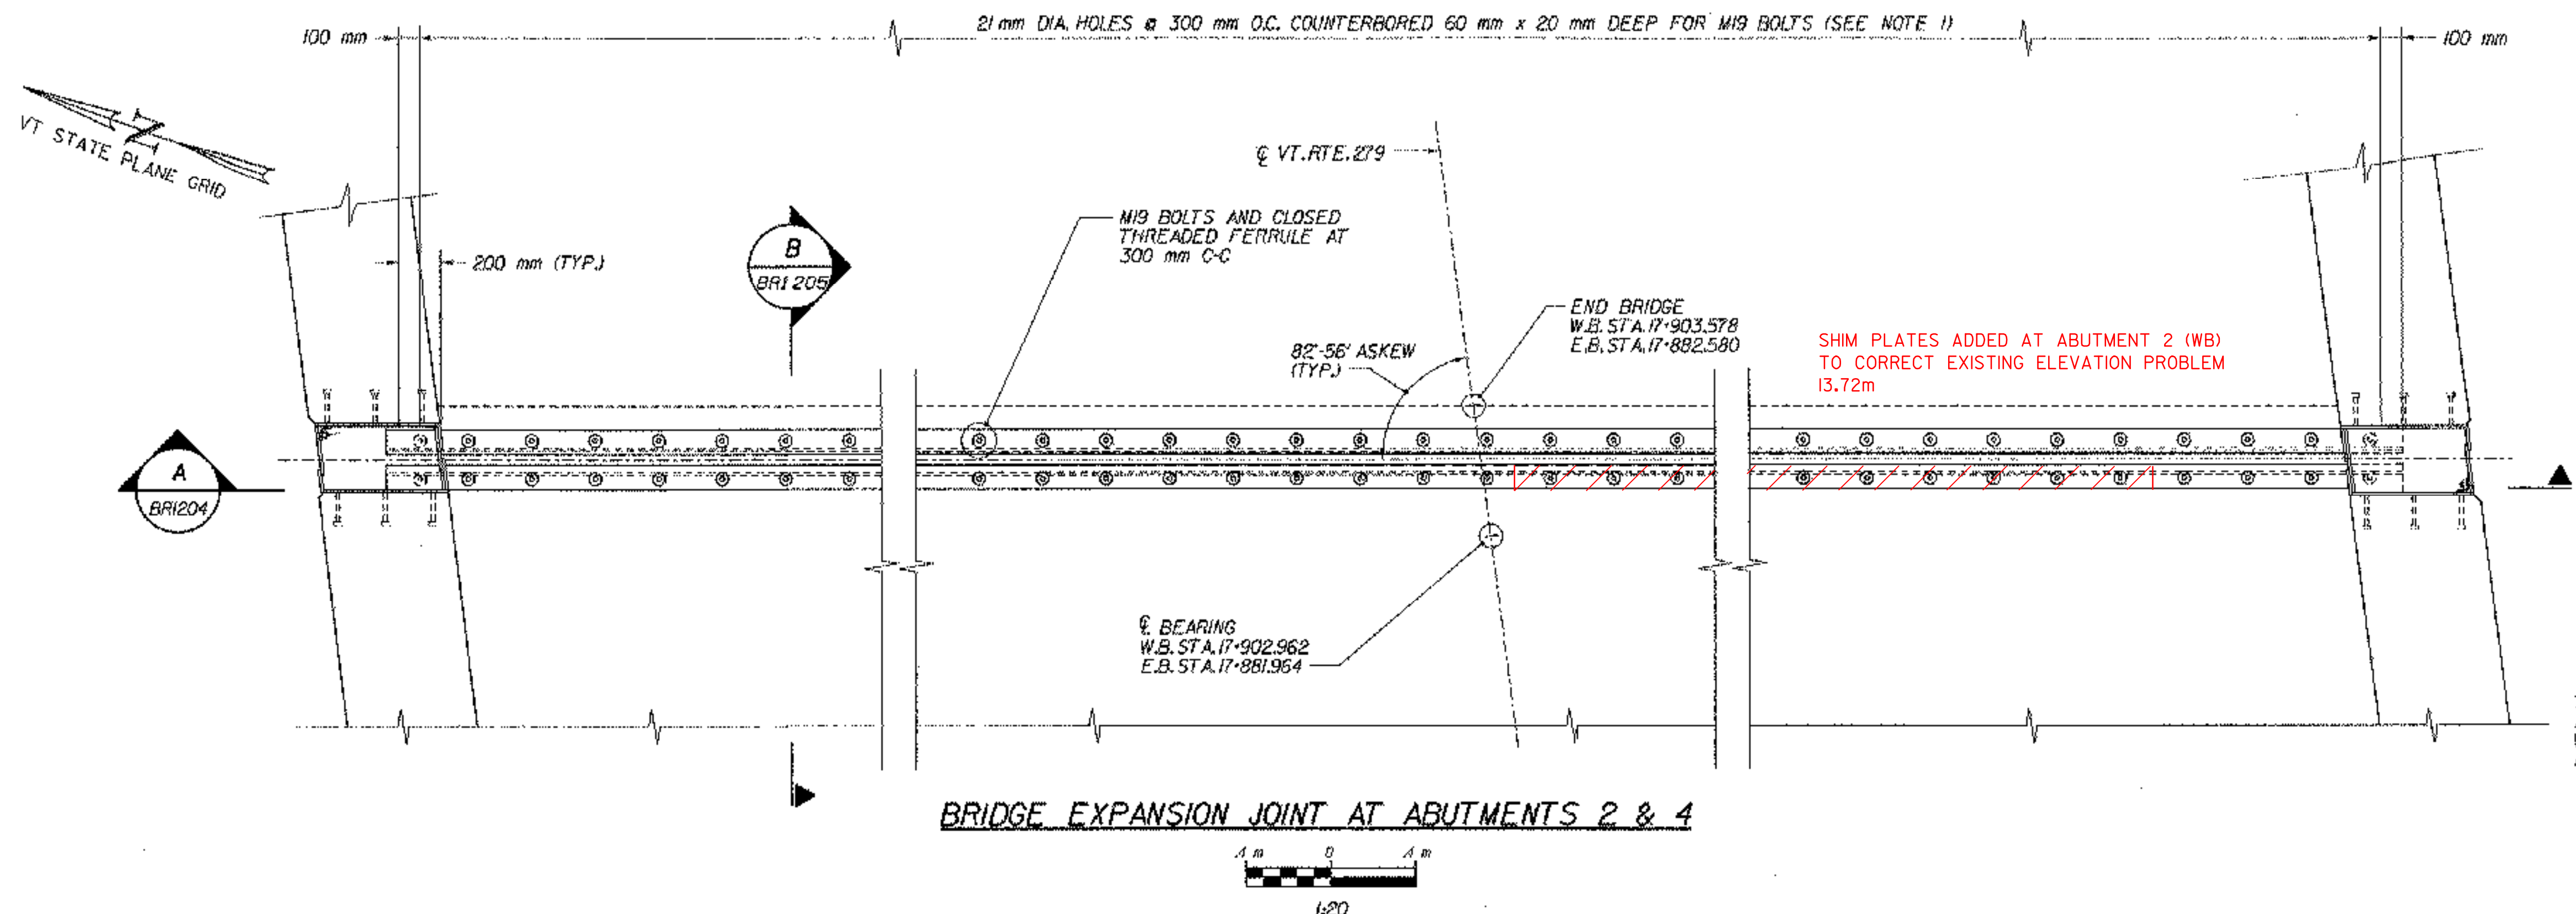


A DRIP BEAD, FABRICATED FROM PREFORMED MATERIAL, IS TO BE MADE ON THE UNDERSIDE OF THE FABRIC TROUGH AS SHOWN, WITH THE COST TO BE SUBSIDIARY TO ITEM 516.10 'BRIDGE EXPANSION JOINT', (VERMONT TYPE) (MOD.)

**2 DRIP BEAD DETAIL**  
BR1205 N.T.S.

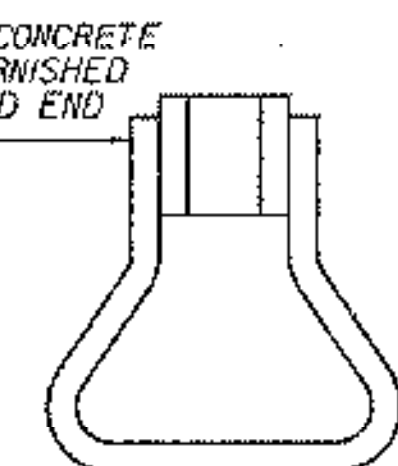

NOTE: THREADED CONCRETE ANCHORS MAY BE SUBSTITUTED FOR CLOSED THREADED FERRULES. CLOSED THREADED FERRULES MUST BE TACK WELDED TO JOINT ANGLE.

**ANCHOR FERRULE DETAIL**  
N.T.S.

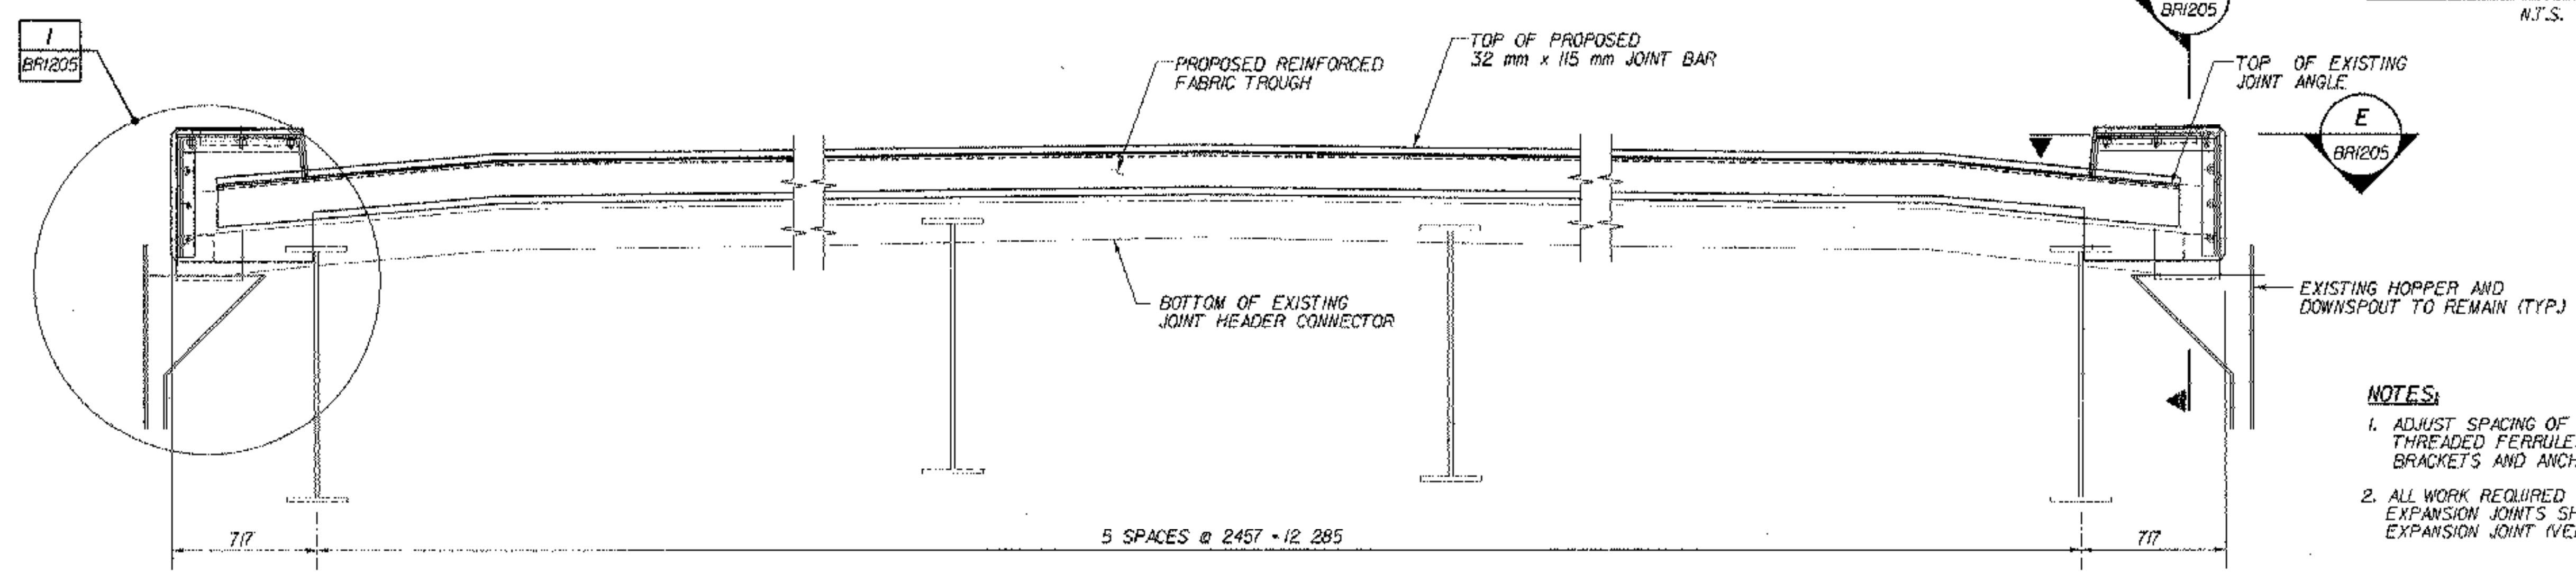

- NOTES:
1. ADJUST SPACING OF 21 mm DIA. HOLES, WELDED STUDS, AND THREADED FERRULES FOR CLEARANCE IN AREAS OF EXISTING BRACKETS AND ANCHOR STUDS.
  2. ALL WORK REQUIRED TO PERFORM THE MODIFICATION OF THE EXPANSION JOINTS SHALL BE INCLUDED IN ITEM 516.10 BRIDGE EXPANSION JOINT (VERMONT TYPE), (MOD.).


**A BRIDGE SECTION AT JOINT**  
BR1204 1:20

<b>STATE OF VERMONT AGENCY OF TRANSPORTATION</b>		
Town Of	BENNINGTON	Bridge No. BR1200
Highway No.	VT. RTE. 279	Log Sta. 17+853
VT. RTE. 279 OVER HISTORIC VT. ROUTE 7A		
EXPANSION JOINTS AT EAST ABUTMENTS		
Designed By	D. STECIAK	Drawn by K. RAPELLO/B. WEATHERBY
Checked By	M. W. OLSTAD	Date 02/04
		Bridge Design Supervisor M. W. OLSTAD Date 02/04
PROJECT	BENNINGTON-HOOSICK	PROJECT NO. D.P.J. 0146D C/6
I.G.C. Info.		
Bridge Sheet No.	BR1204	Sheet 79 OF 83


**CHA CLOUGH, HARBOUR & ASSOCIATES LLP**  
ENGINEERS, ARCHITECTS, PLANNERS  
& LANDSCAPE ARCHITECTS  
WINNERS CIRCLE - ALBANY, NEW YORK - 12208  
518-458-4900

FILE NAME: s:\12502\AMSTN\FINAL\7a\brs\untahd\up17  
DATE/TIME: 2/17/2004  
USER: 52225


NOTE: UNLESS NOTED OTHERWISE, ALL STATIONS ARE IN KILOMETERS, ALL ELEVATIONS ARE IN METERS, AND ALL DIMENSIONS ARE IN MILLIMETERS.

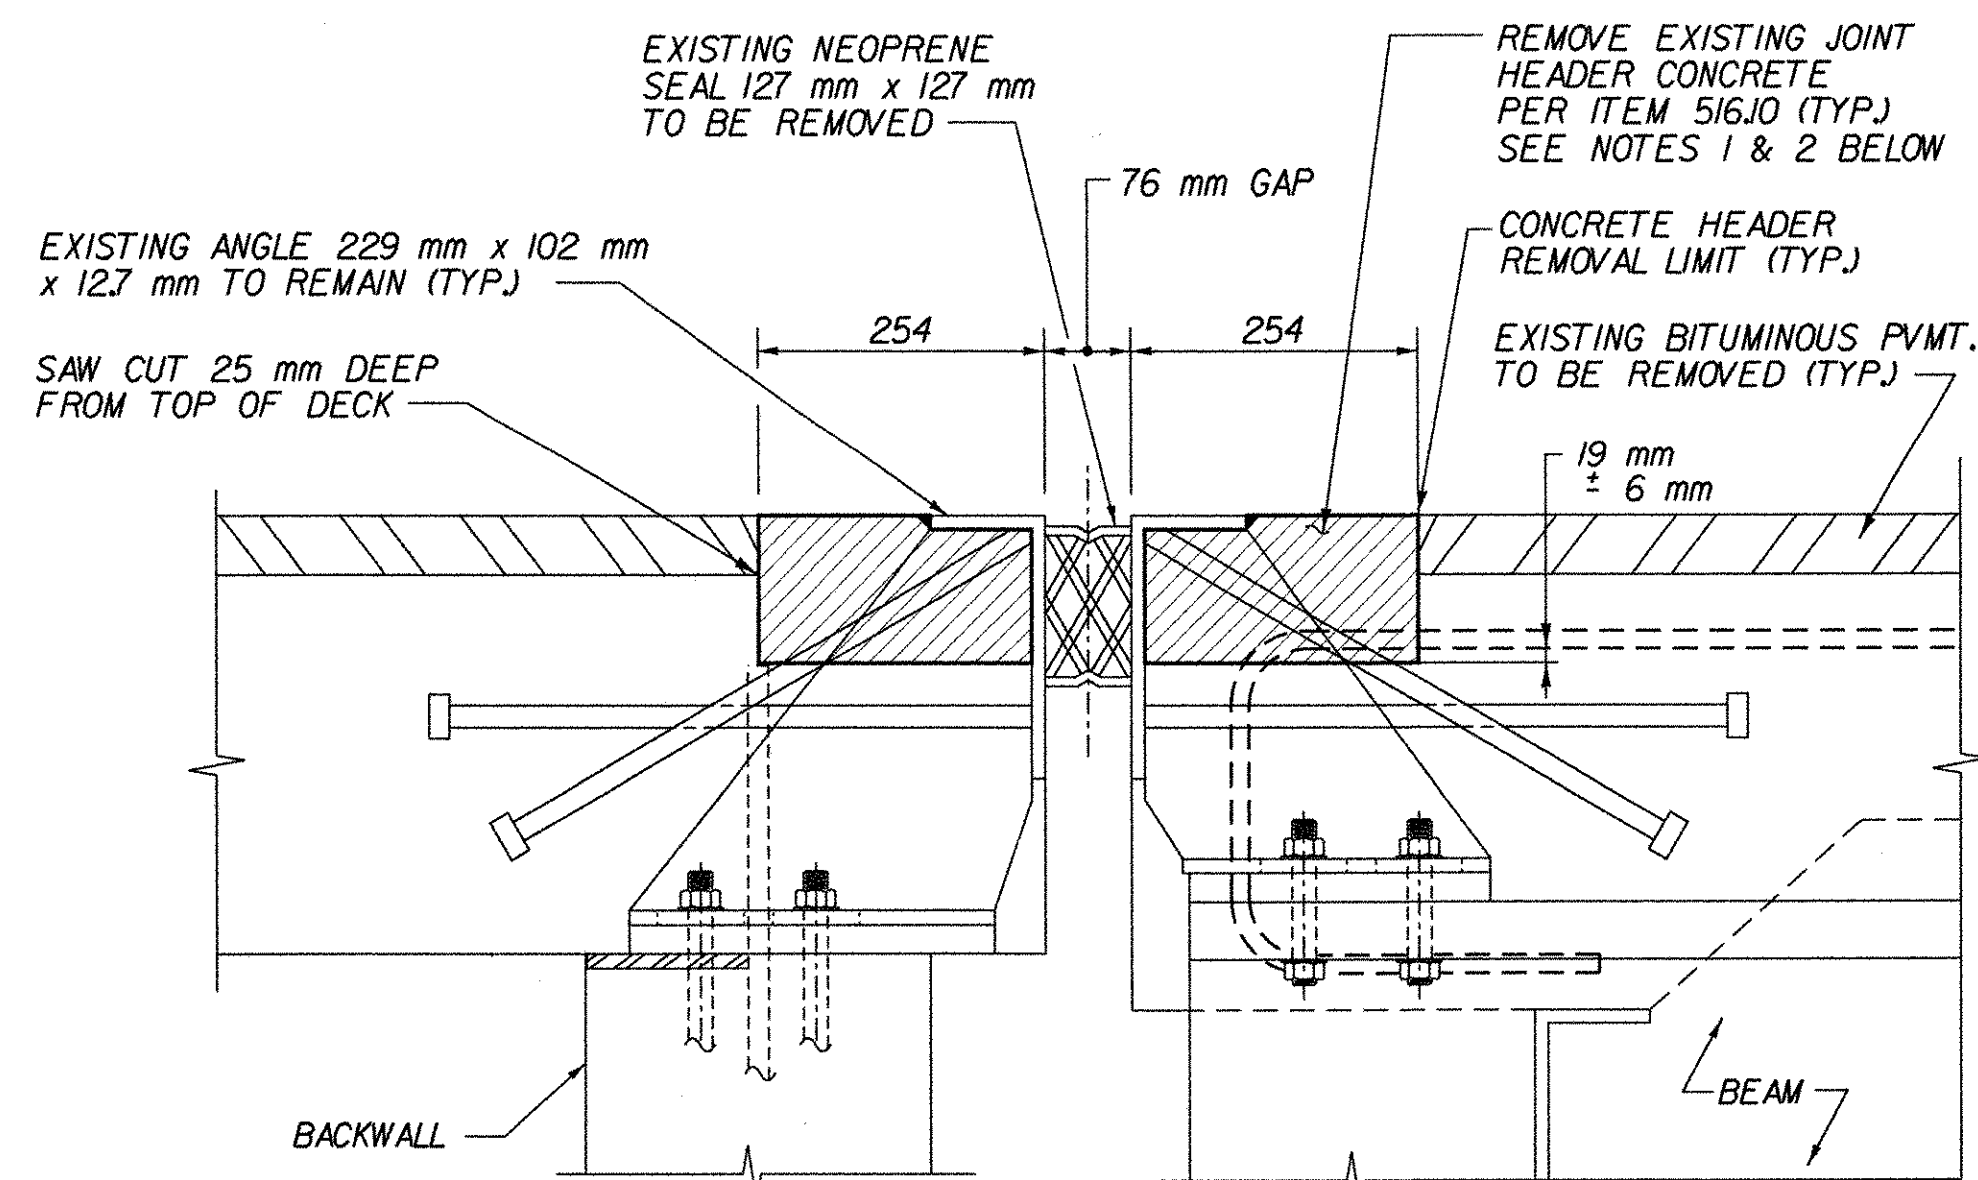


**B EXISTING SECTION**  
BRI204 N.T.S.

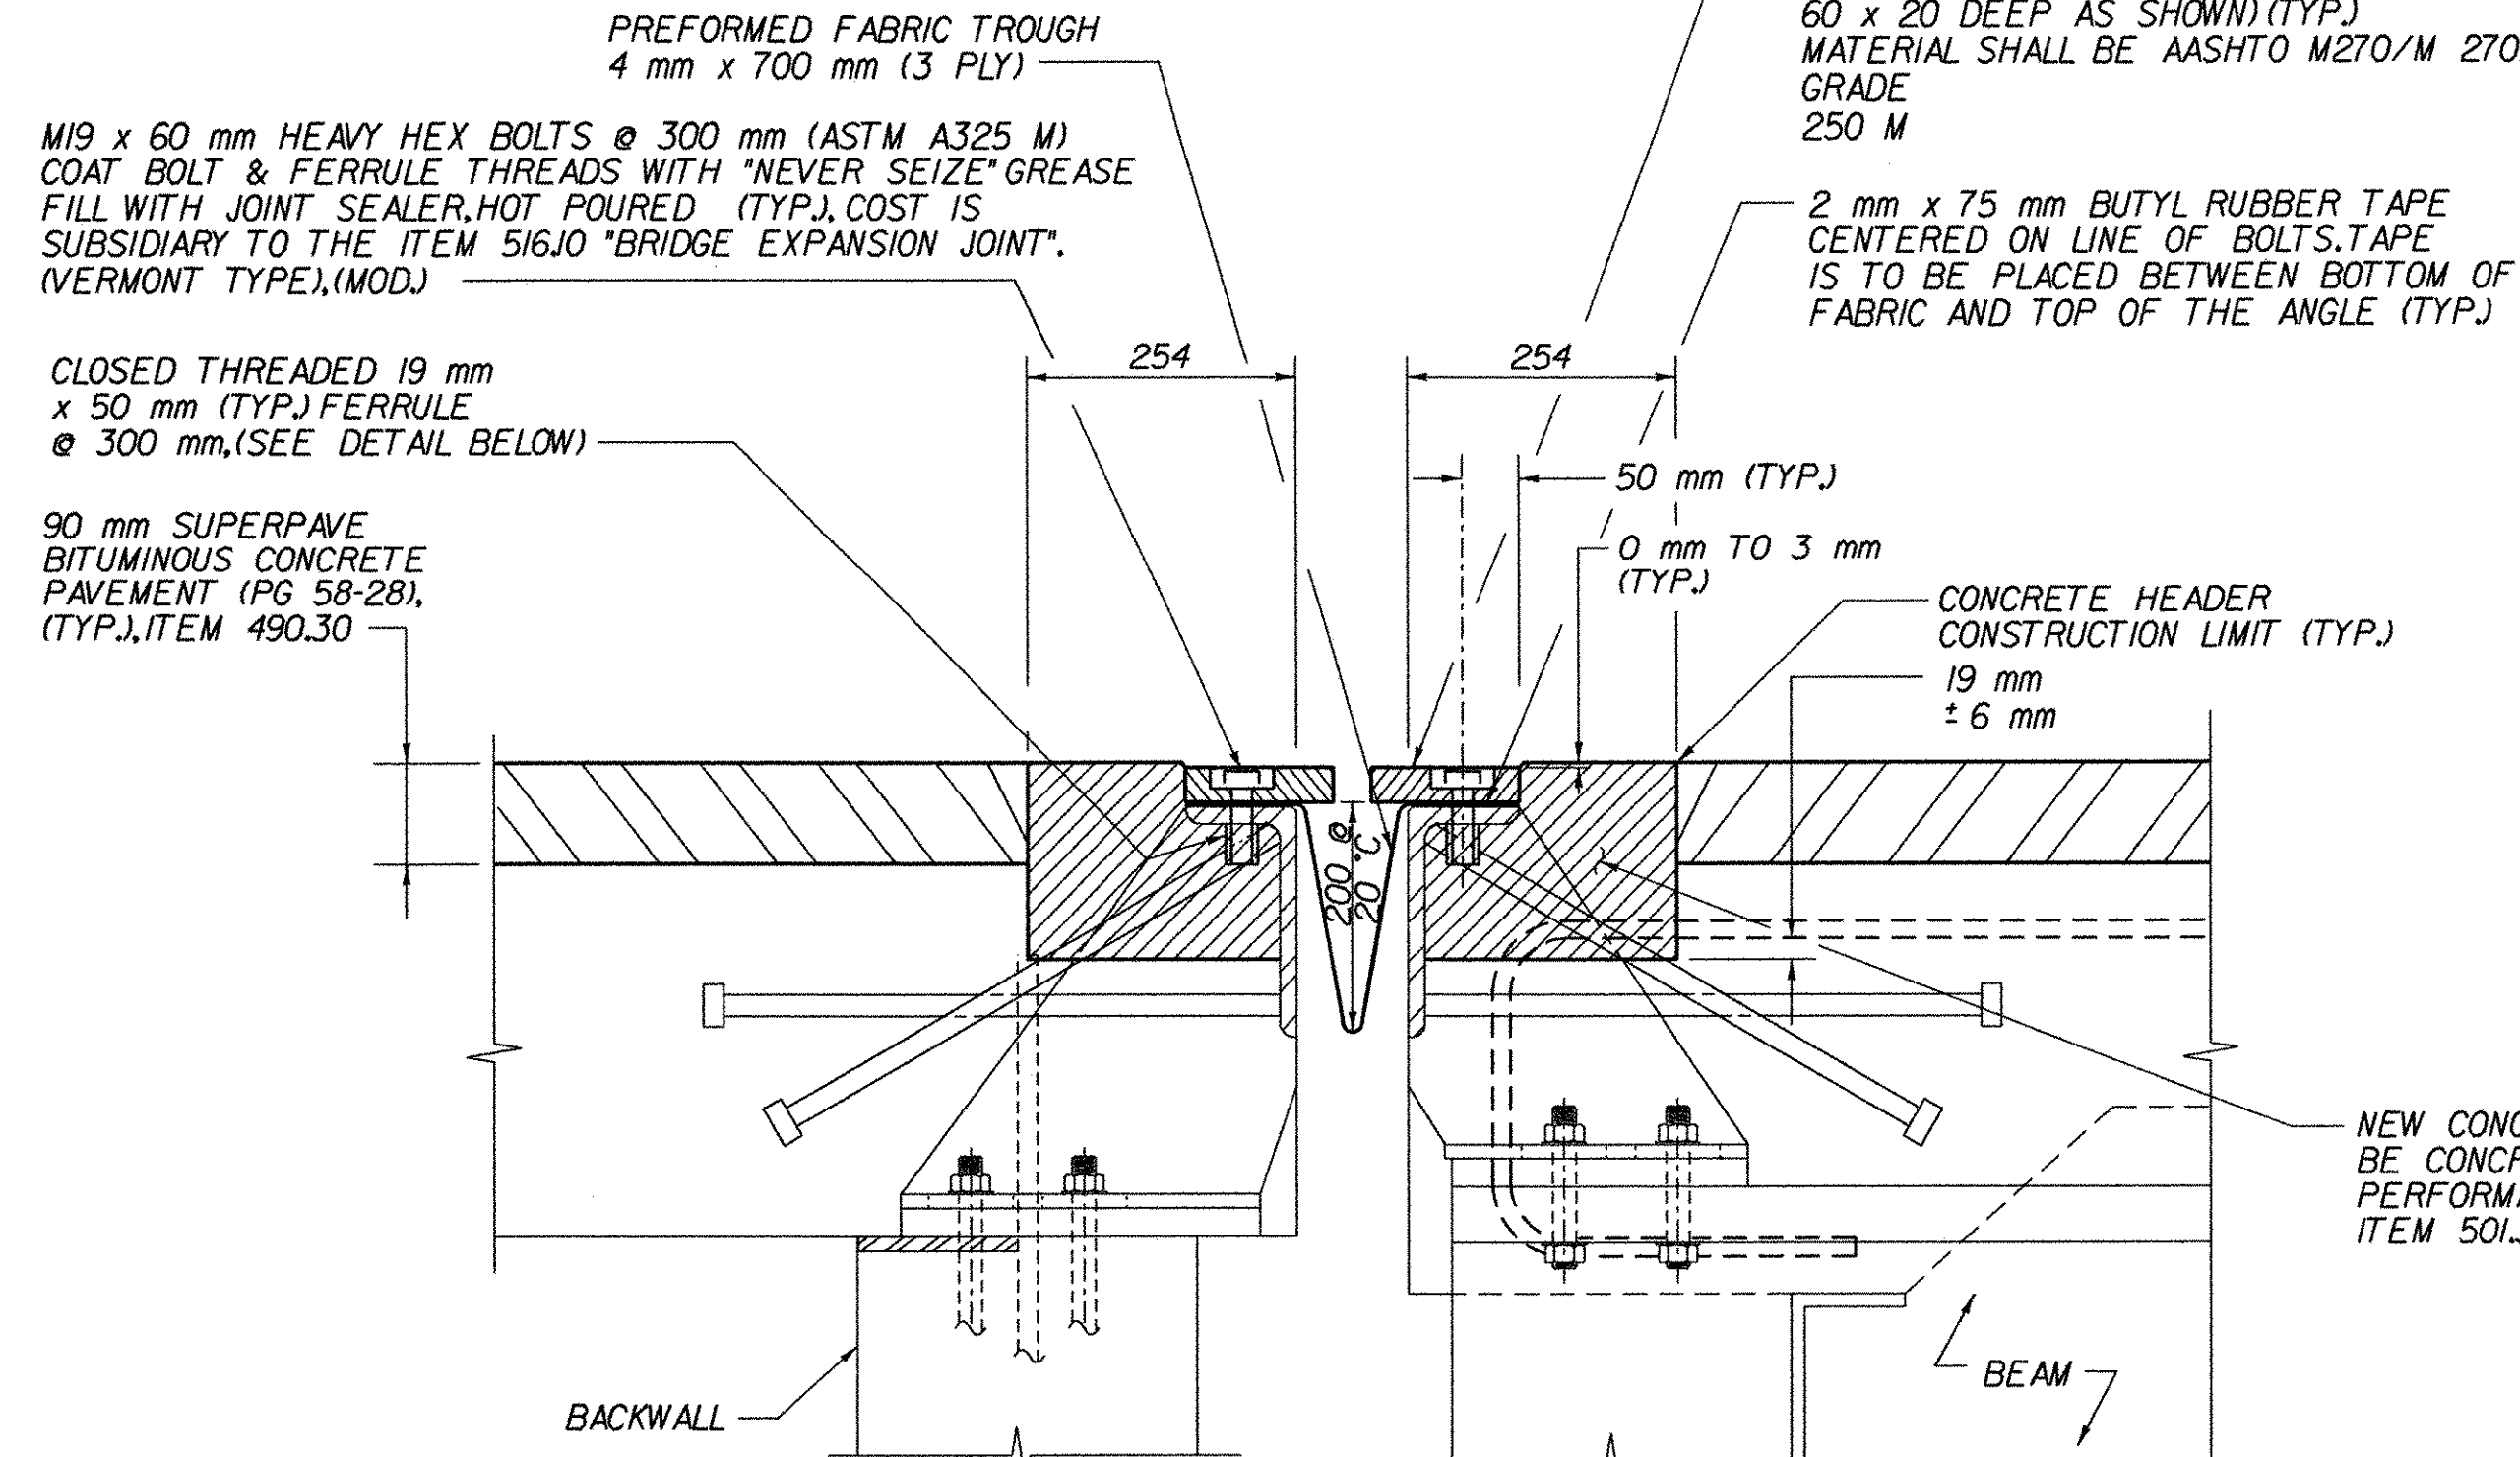


**B PROPOSED SECTION**  
BRI204 N.T.S.

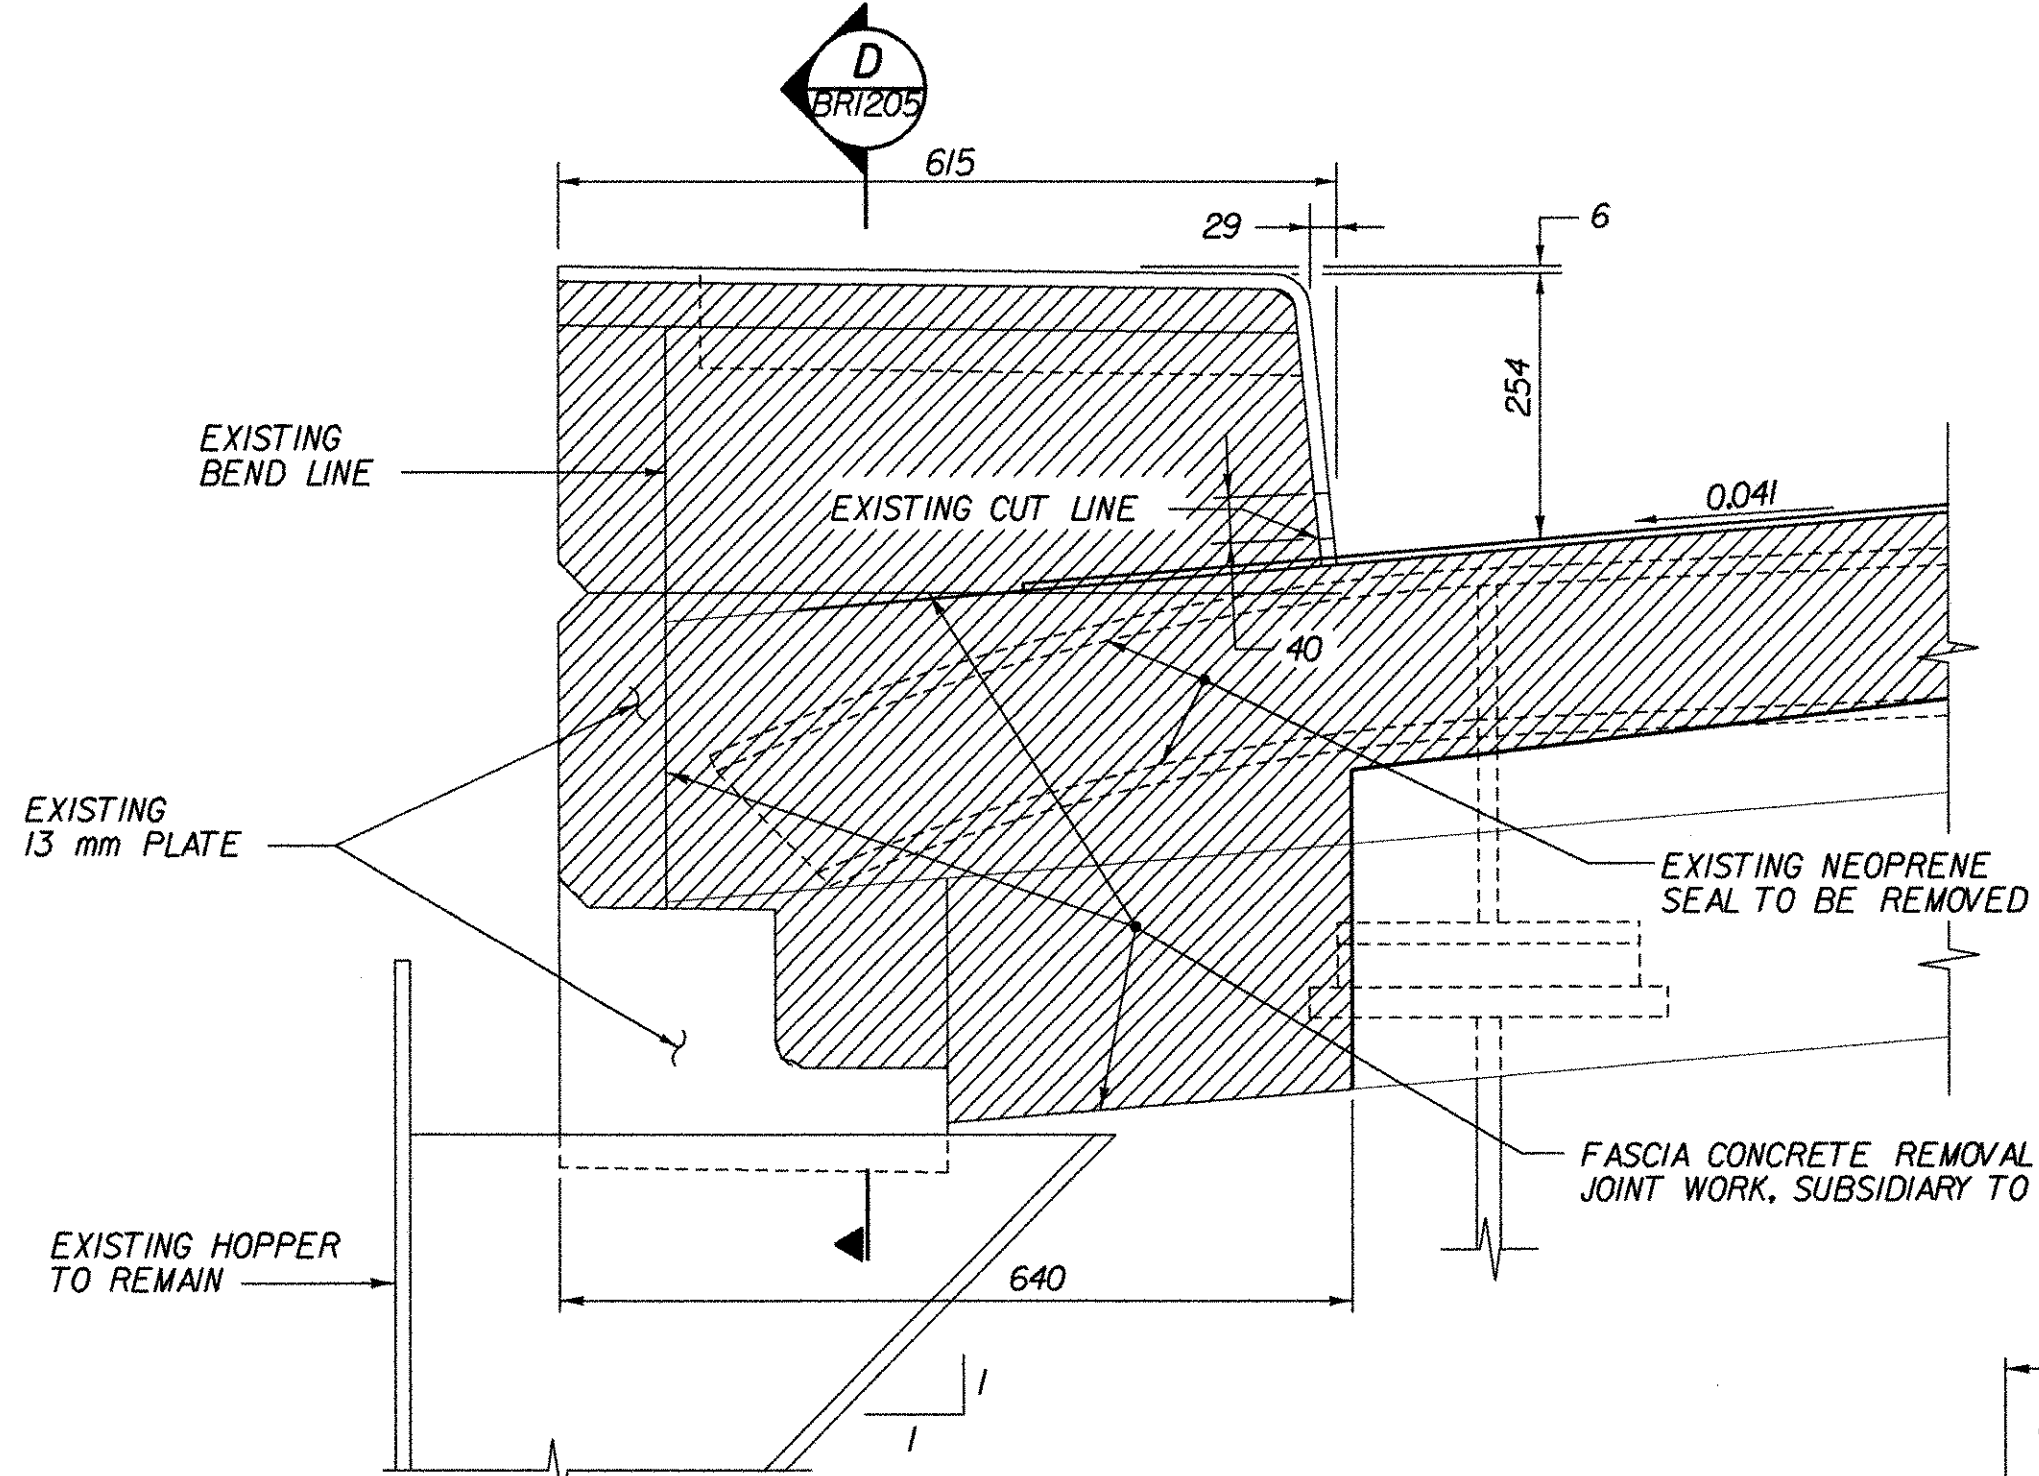


**D EXISTING JOINT SECTION AT CURB**  
BRI205 N.T.S.

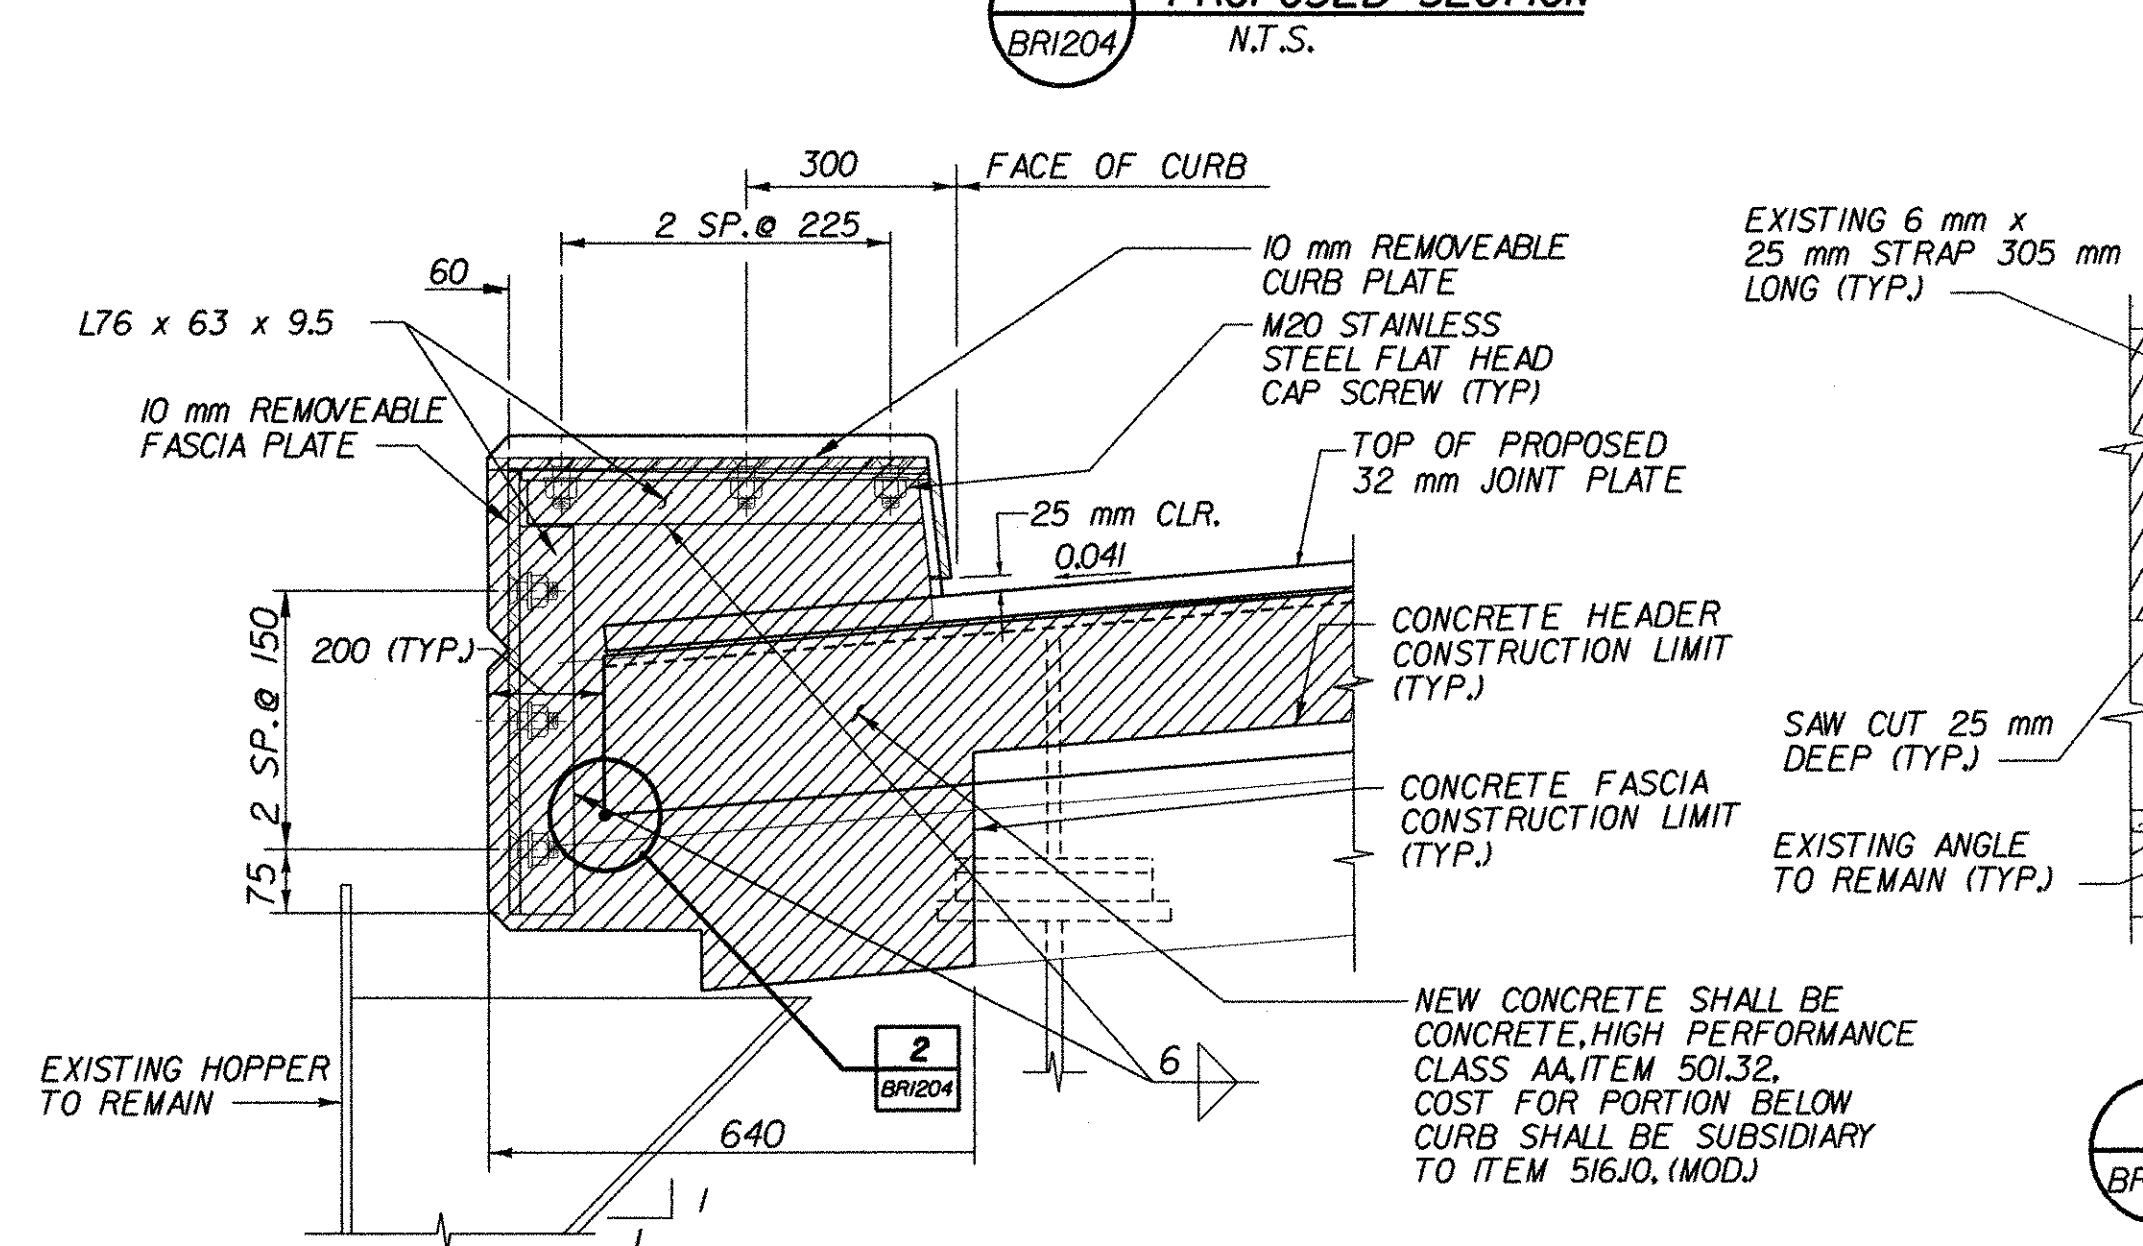


**I PROPOSED FASCIA DETAIL**  
BRI204 N.T.S.

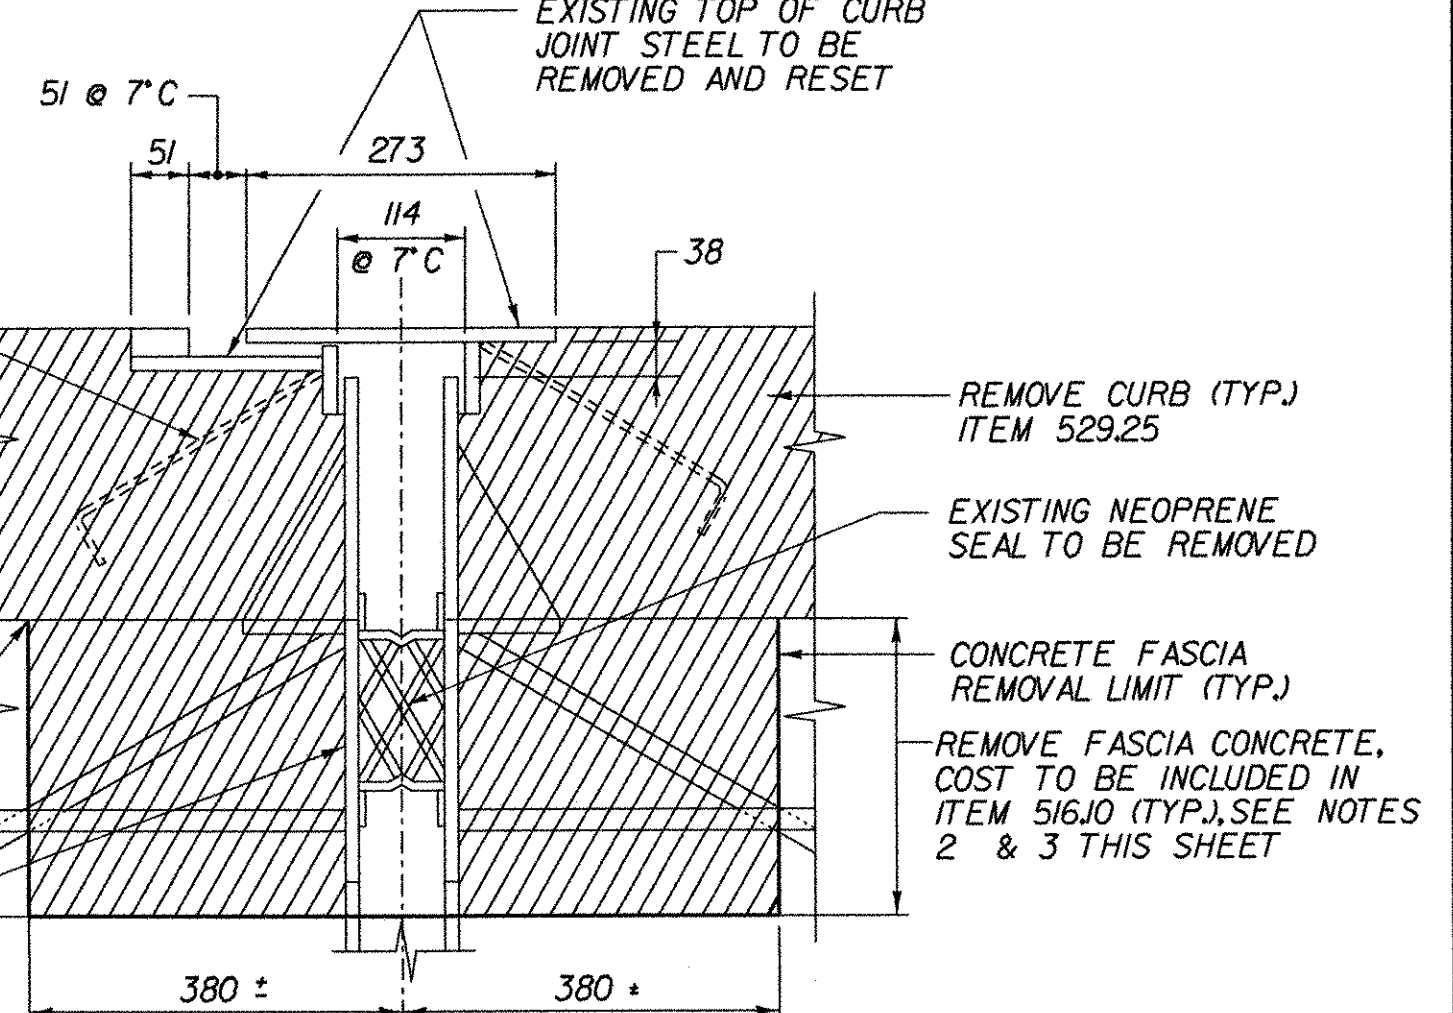


**D EXISTING JOINT SECTION AT CURB**  
BRI205 N.T.S.

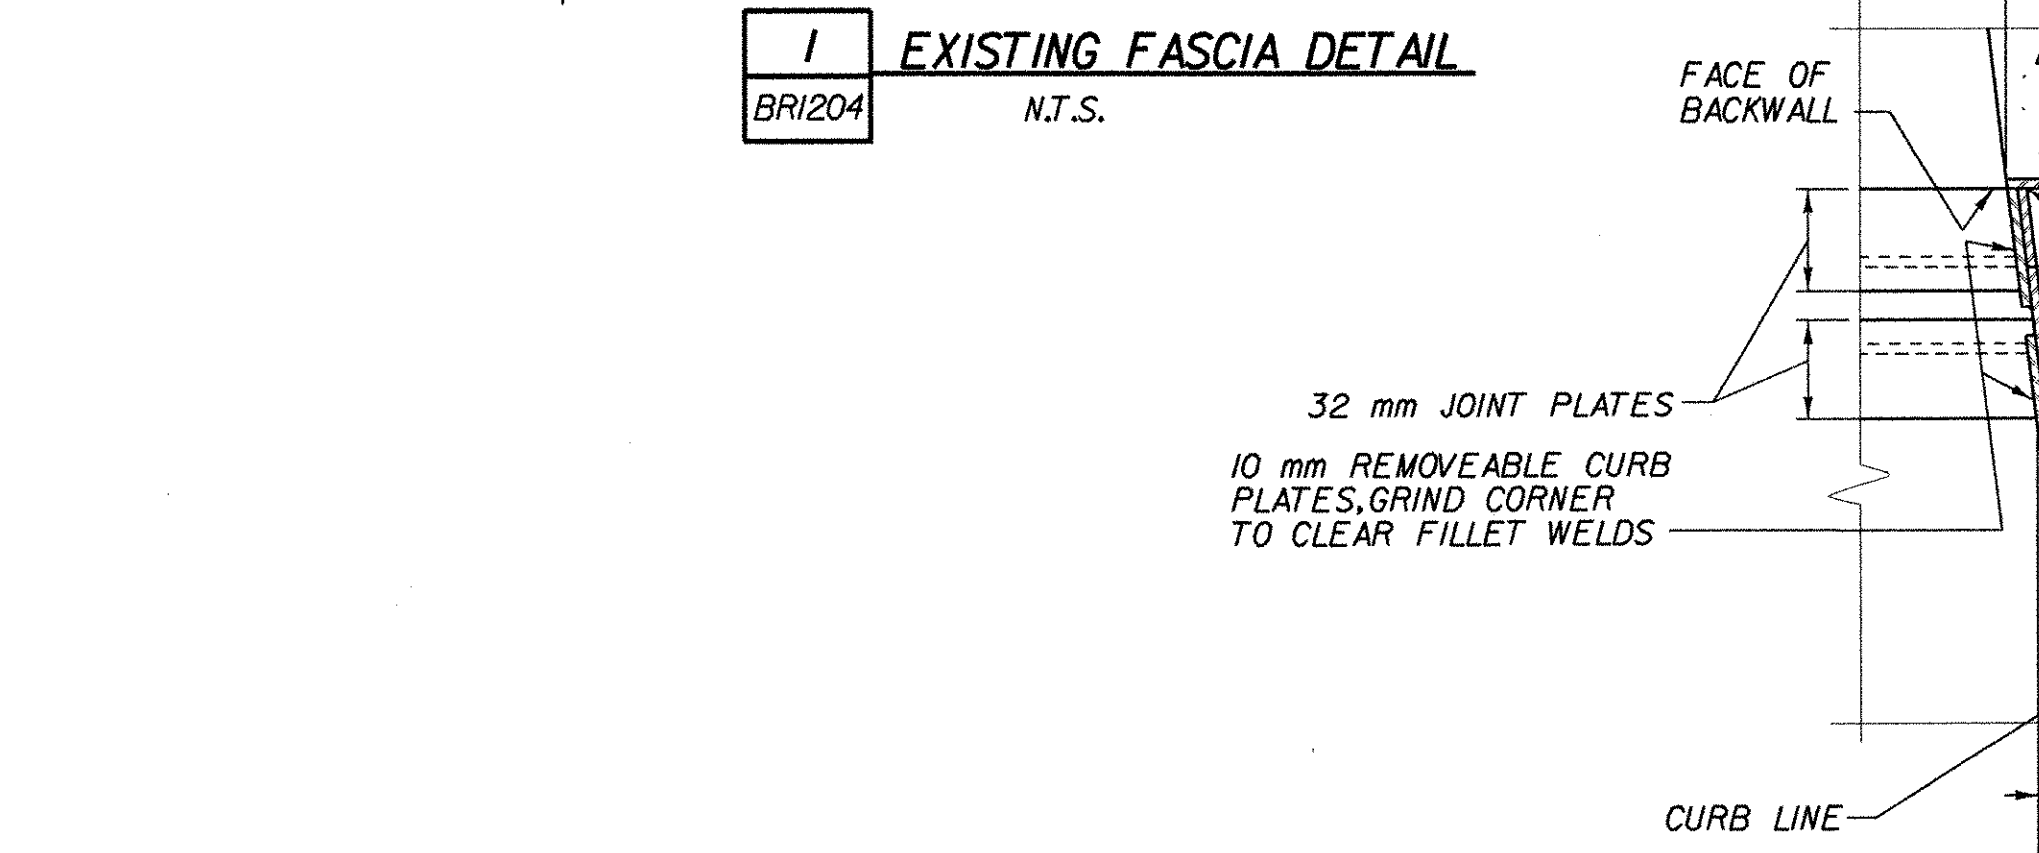

**I EXISTING FASCIA DETAIL**  
BRI204 N.T.S.

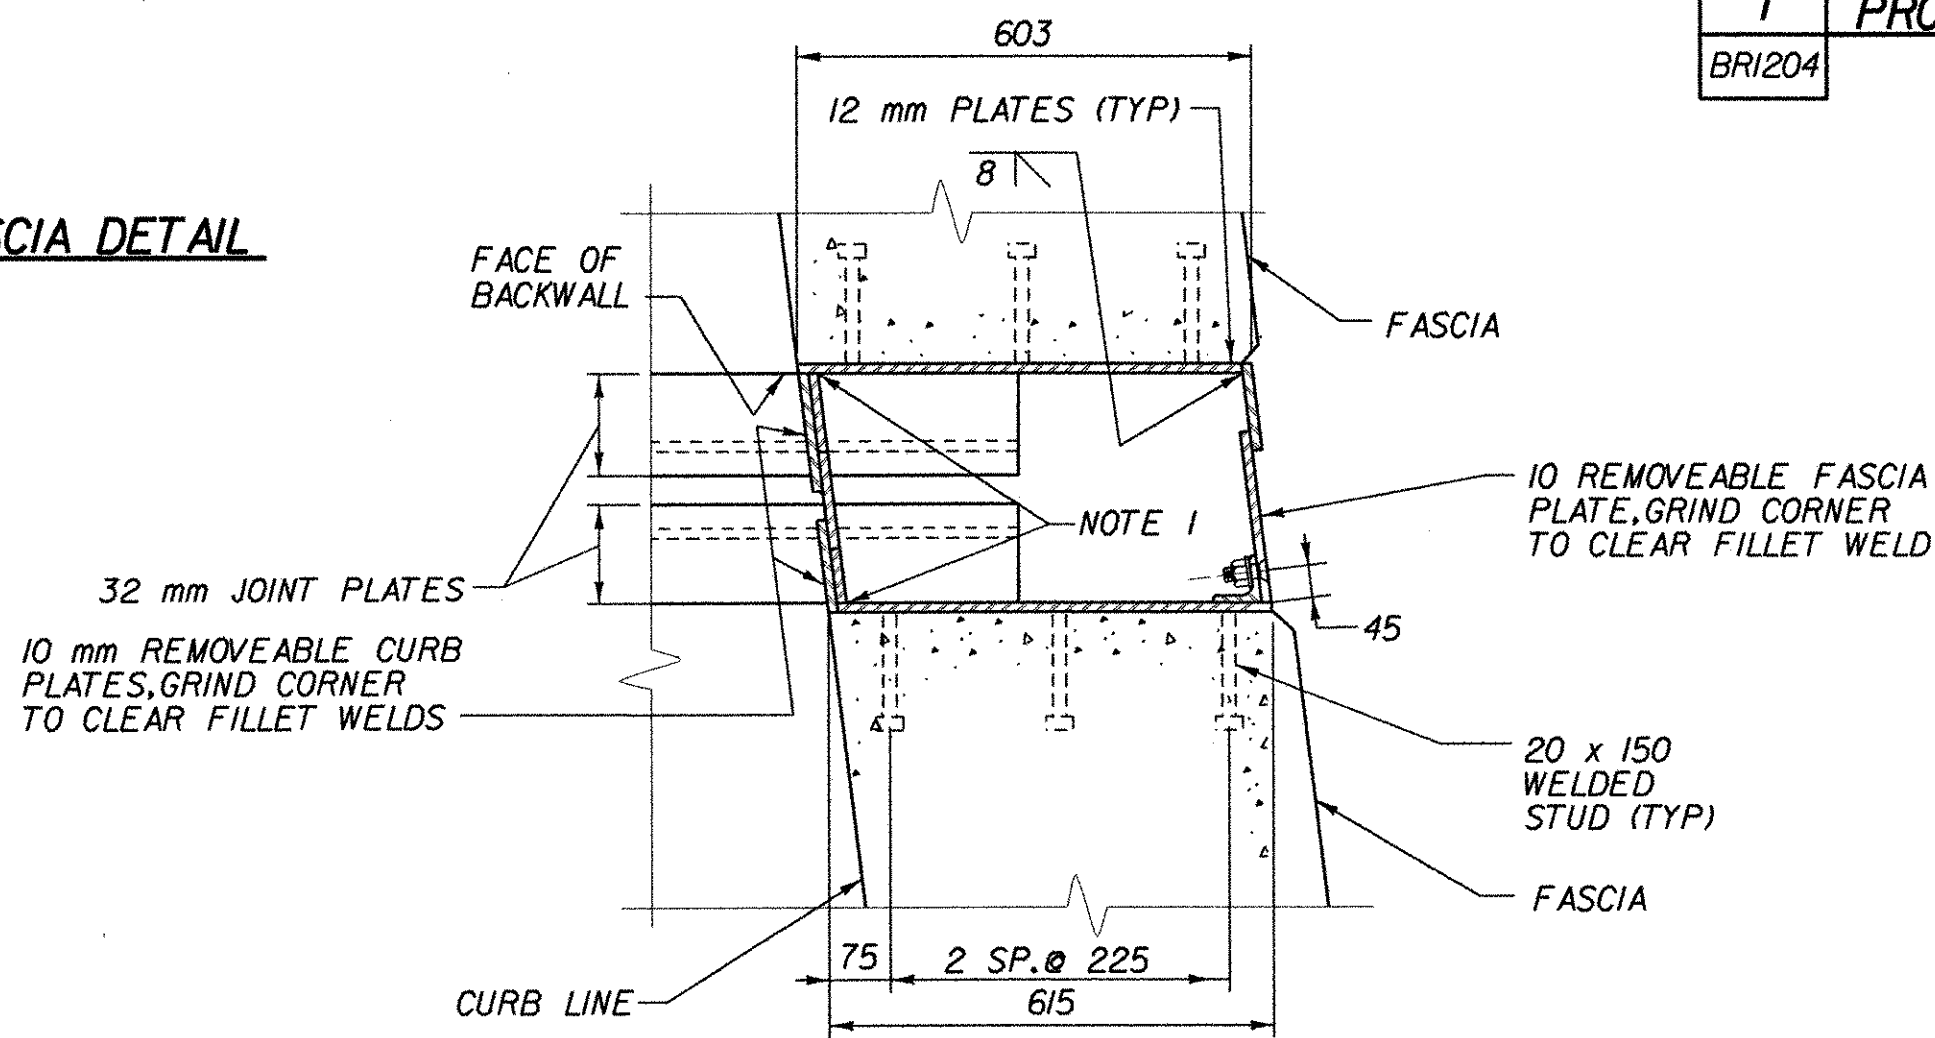

**E PROPOSED PARTIAL JOINT PLAN**  
BRI204 N.T.S.



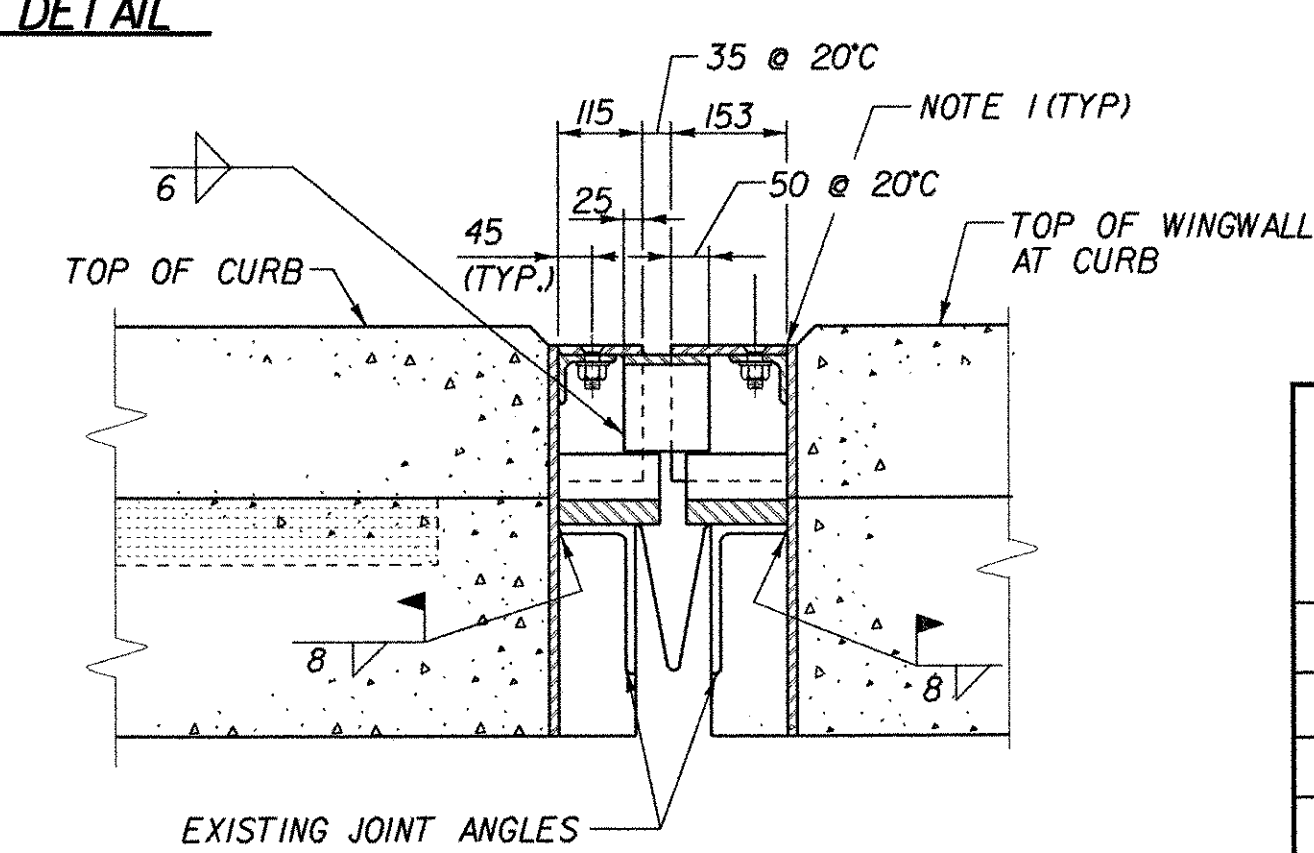


**F PROPOSED JOINT SECTION AT CURB**  
BRI204 N.T.S.


- NOTES:**
1. SEAL JOINTS BETWEEN PLATES WITH SILICONE SEALANT. COST TO BE INCLUDED IN ITEM 516JO, (MOD.)
  2. CONTRACTOR SHALL USE CARE NOT TO DAMAGE THE EXISTING JOINT COMPONENTS DURING CONCRETE HEADER REMOVAL OPERATIONS.
  3. THE MAXIMUM SIZE AIR HAMMER USED TO REMOVE JOINT HEADER CONCRETE SHALL BE 7 kg.

STATE OF VERMONT AGENCY OF TRANSPORTATION			
Town of	BENNINGTON	Bridge No.	BRI200
Highway No.	VT. RTE. 279	Log Sta.	
		Surv. Sta.	17+853
VT. RTE. 279 OVER HISTORIC VT. ROUTE 7A			
JOINT DETAILS			
Designed By	D. STECIAK	Drawn by	K. RAPELLO/B. WEATHERBY
Checked By	M. W. OLSTAD	Date	02/04
		Bridge Design Supervisor	M. W. OLSTAD
		Date	02/04
PROJECT	BENNINGTON-HOOSICK	PROJECT NO.	D.P.I. 0146(1) C/6
I.G.C. Info.			
Bridge Sheet No.	BRI205	Sheet	80 OF 83

NOTE: UNLESS NOTED OTHERWISE, ALL STATIONS ARE IN KILOMETERS, ALL ELEVATIONS ARE IN METERS, AND ALL DIMENSIONS ARE IN MILLIMETERS.

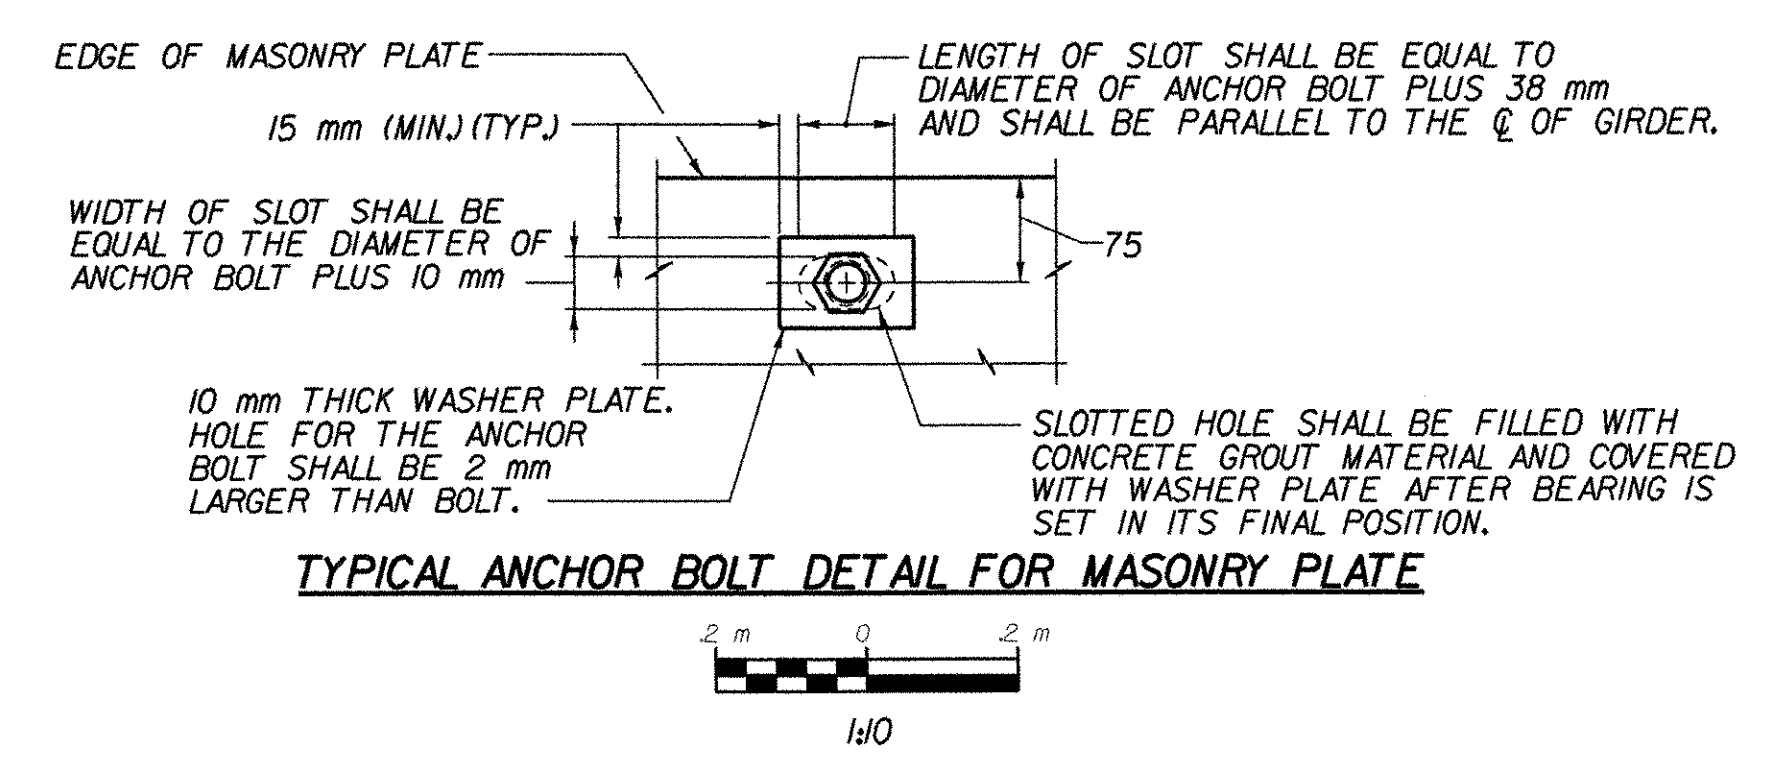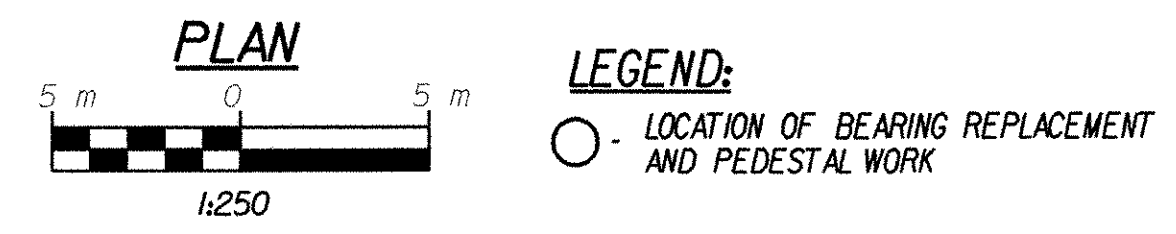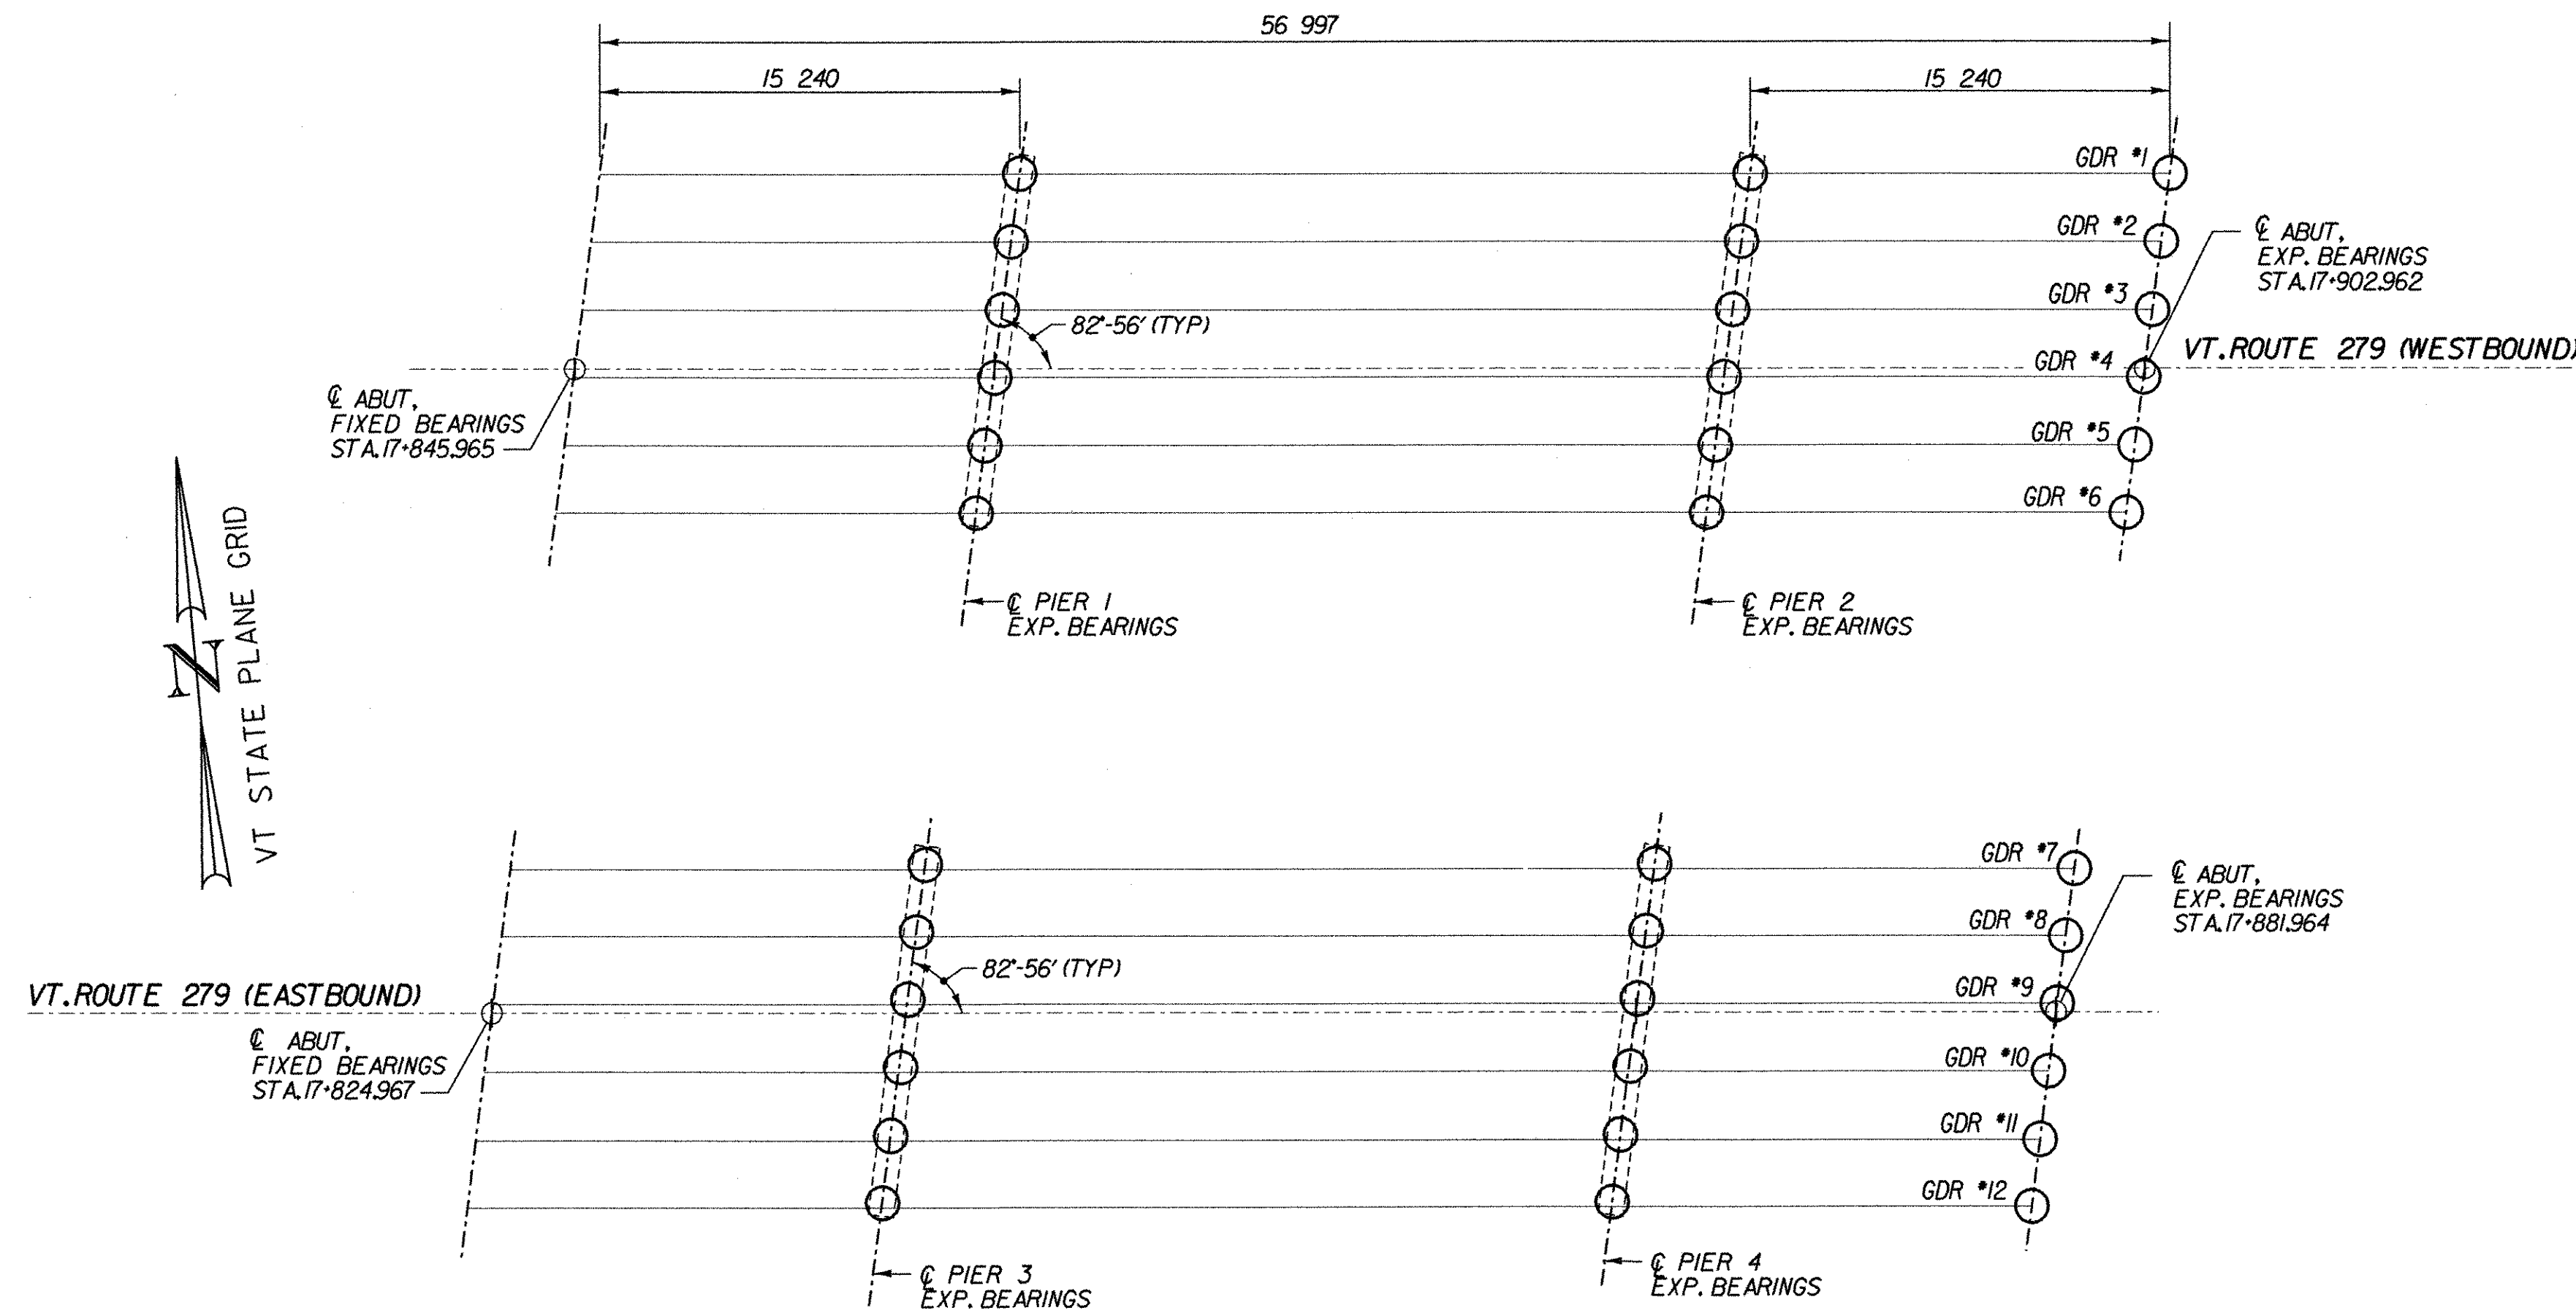

NOTE: I. SEE SHEET NO. B1 FOR BEARING NOTES.

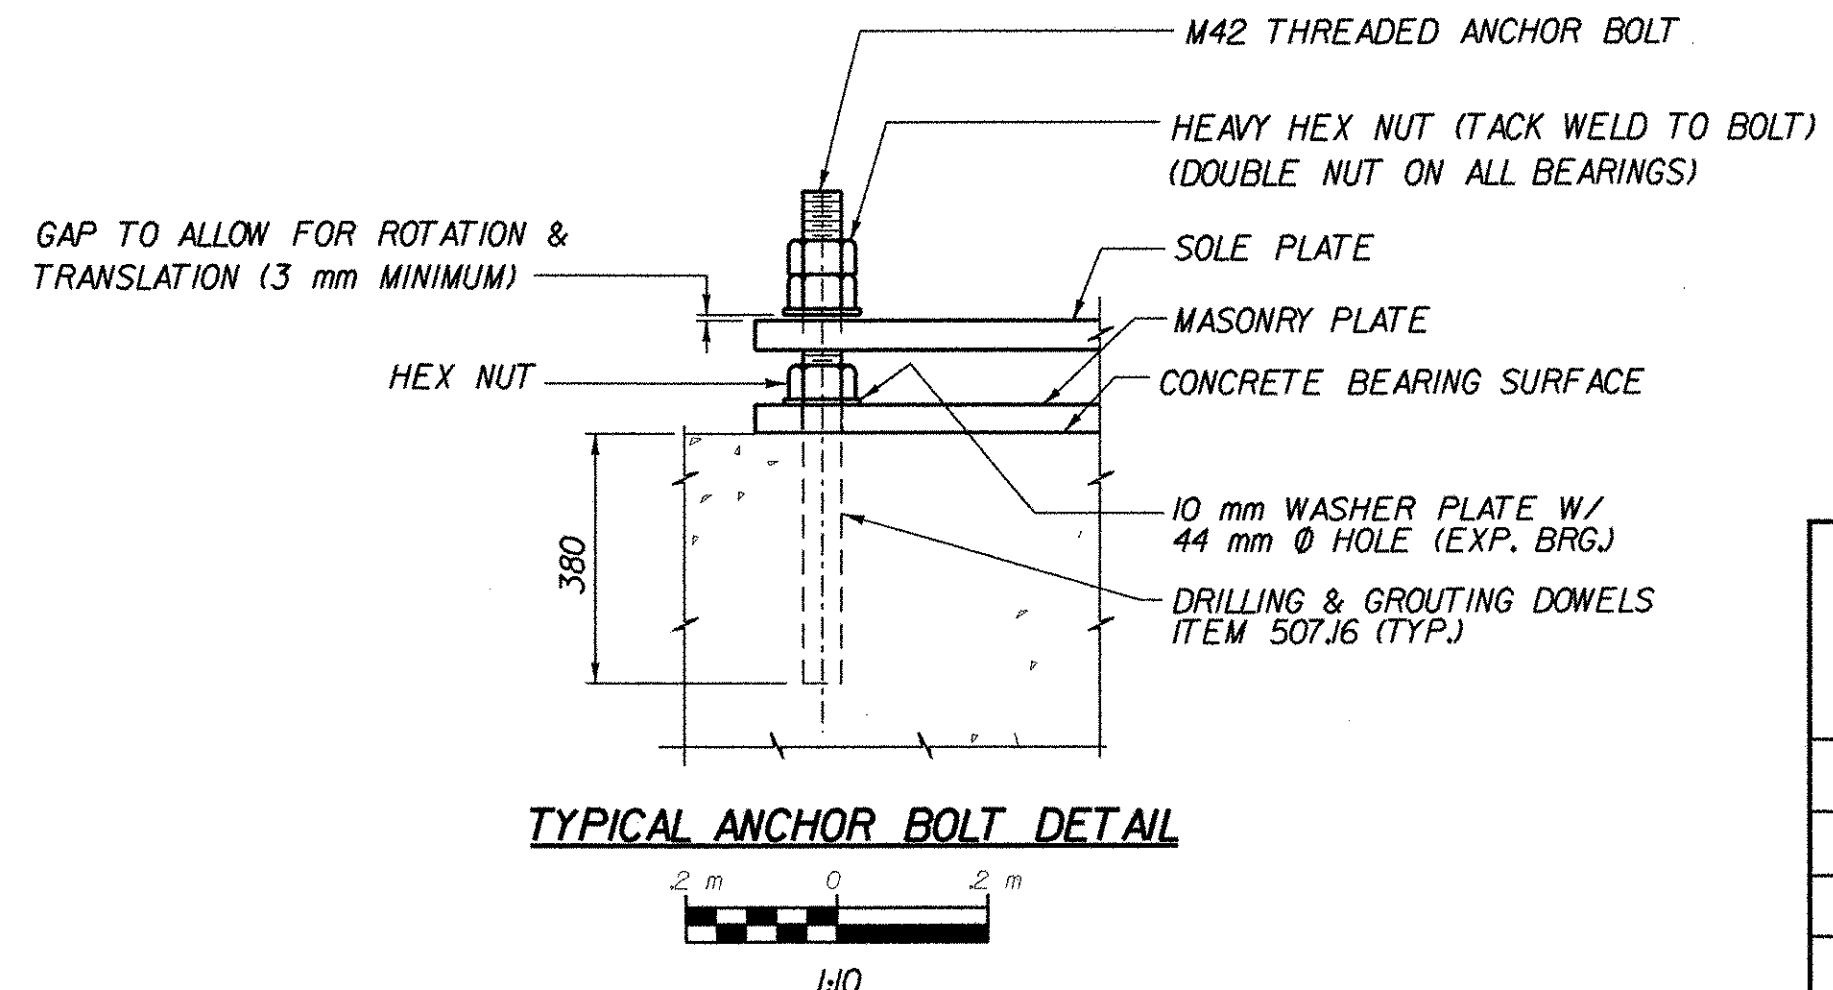






BEARING TABLE						
LOCATION	TYPE	ITEM NO.	QUANTITY REQUIRED	CAPACITY (KN)	SHAPE FACTOR	MAX. REACTION (KN)
PIERS	EXP.	531J0	24	800	7.75	781
END ABUTS.	EXP.	531J0	12	302	6.76	299

NOTE: THE DEADLOAD JACKING FORCE IS APPROXIMATELY 532 KN PER PIER BEARING AND APPROXIMATELY 95 KN PER ABUTMENT BEARING.

### STATE OF VERMONT AGENCY OF TRANSPORTATION

Town of	BENNINGTON	Bridge No.	BR1200
Highway No.	VT. RTE. 279	Log Sta.	
		Surv. Sta.	17+853
VT. RTE. 279 OVER HISTORIC VT. ROUTE 7A			
BEARING LAYOUT PLAN AND DETAILS			
Designed By	D. STECIAK	Drawn by	K. RAPELLO
Checked By	M. W. OLSTAD	Date	02/04
		Bridge Design Supervisor	M. W. OLSTAD
		Date	02/04
PROJECT	BENNINGTON-HOOSICK	PROJECT NO.	D.P.I. 0146(I) C/6
I.G.C. Info.			
Bridge Sheet No.	BR1206	Sheet	81 OF 83


NOTE: UNLESS NOTED OTHERWISE, ALL STATIONS ARE IN KILOMETERS, ALL ELEVATIONS ARE IN METERS, AND ALL DIMENSIONS ARE IN MILLIMETERS.

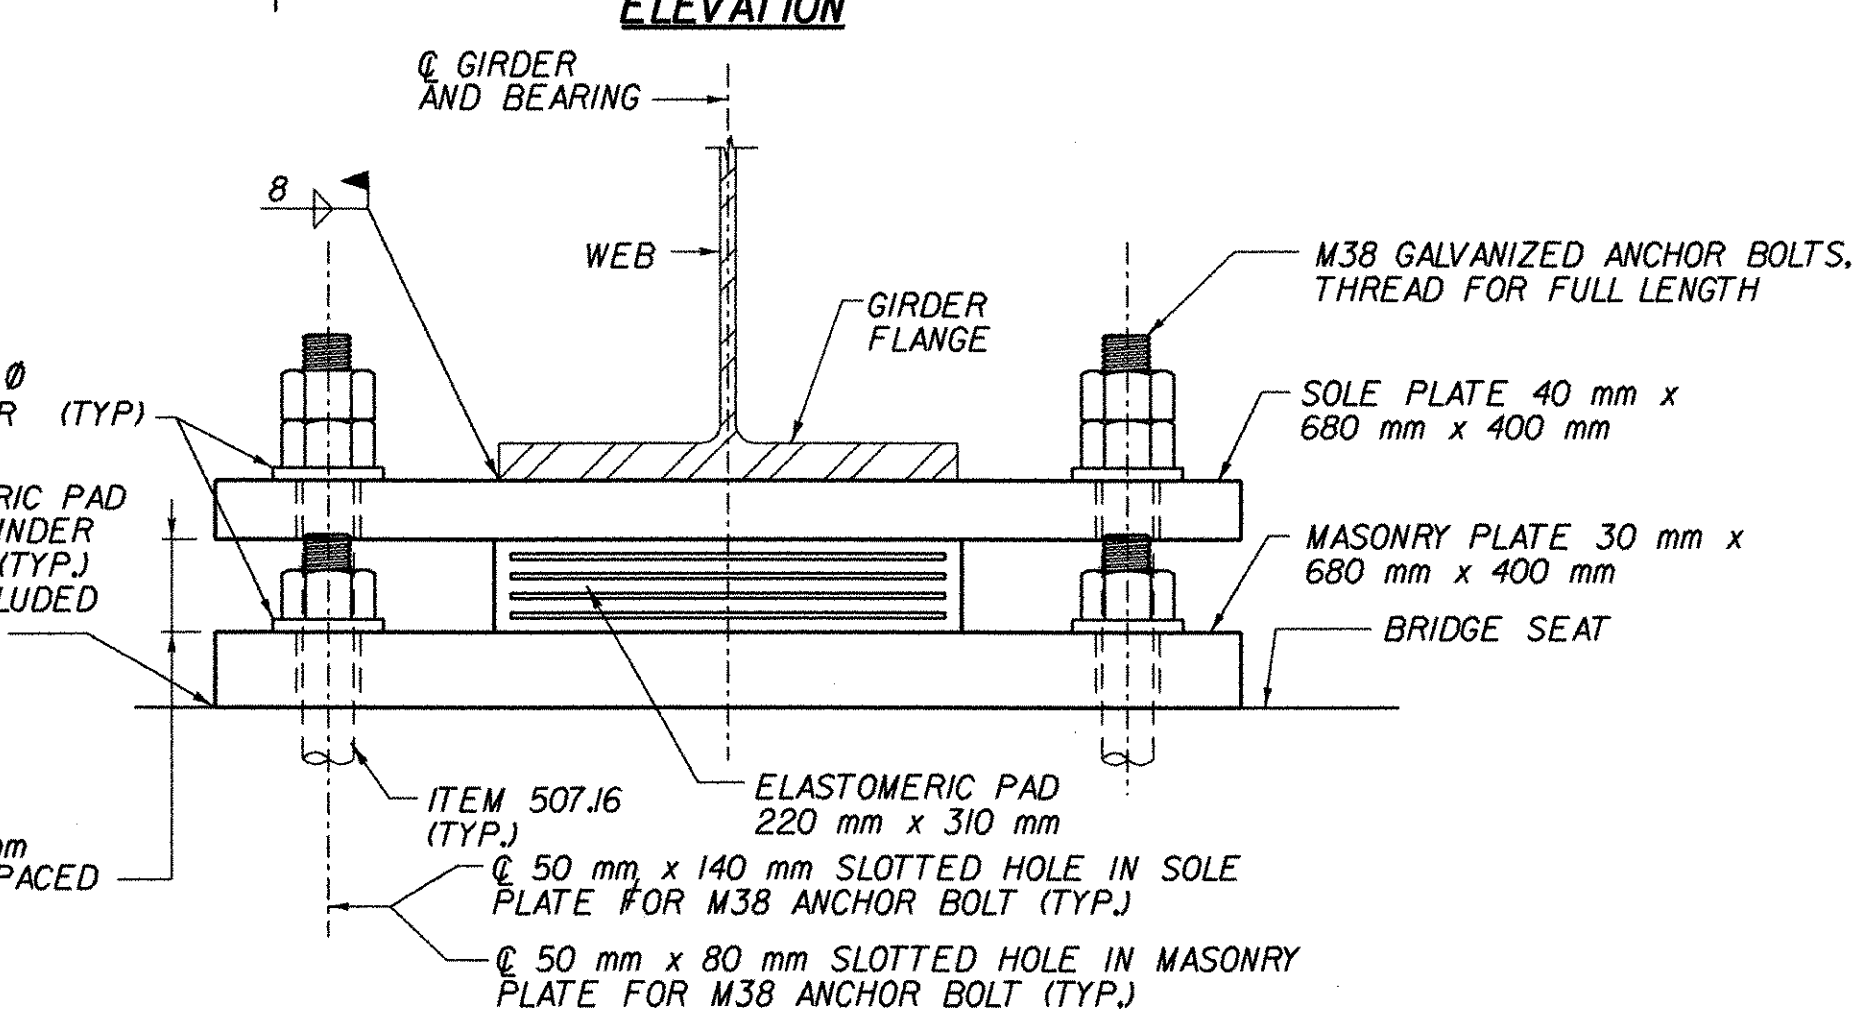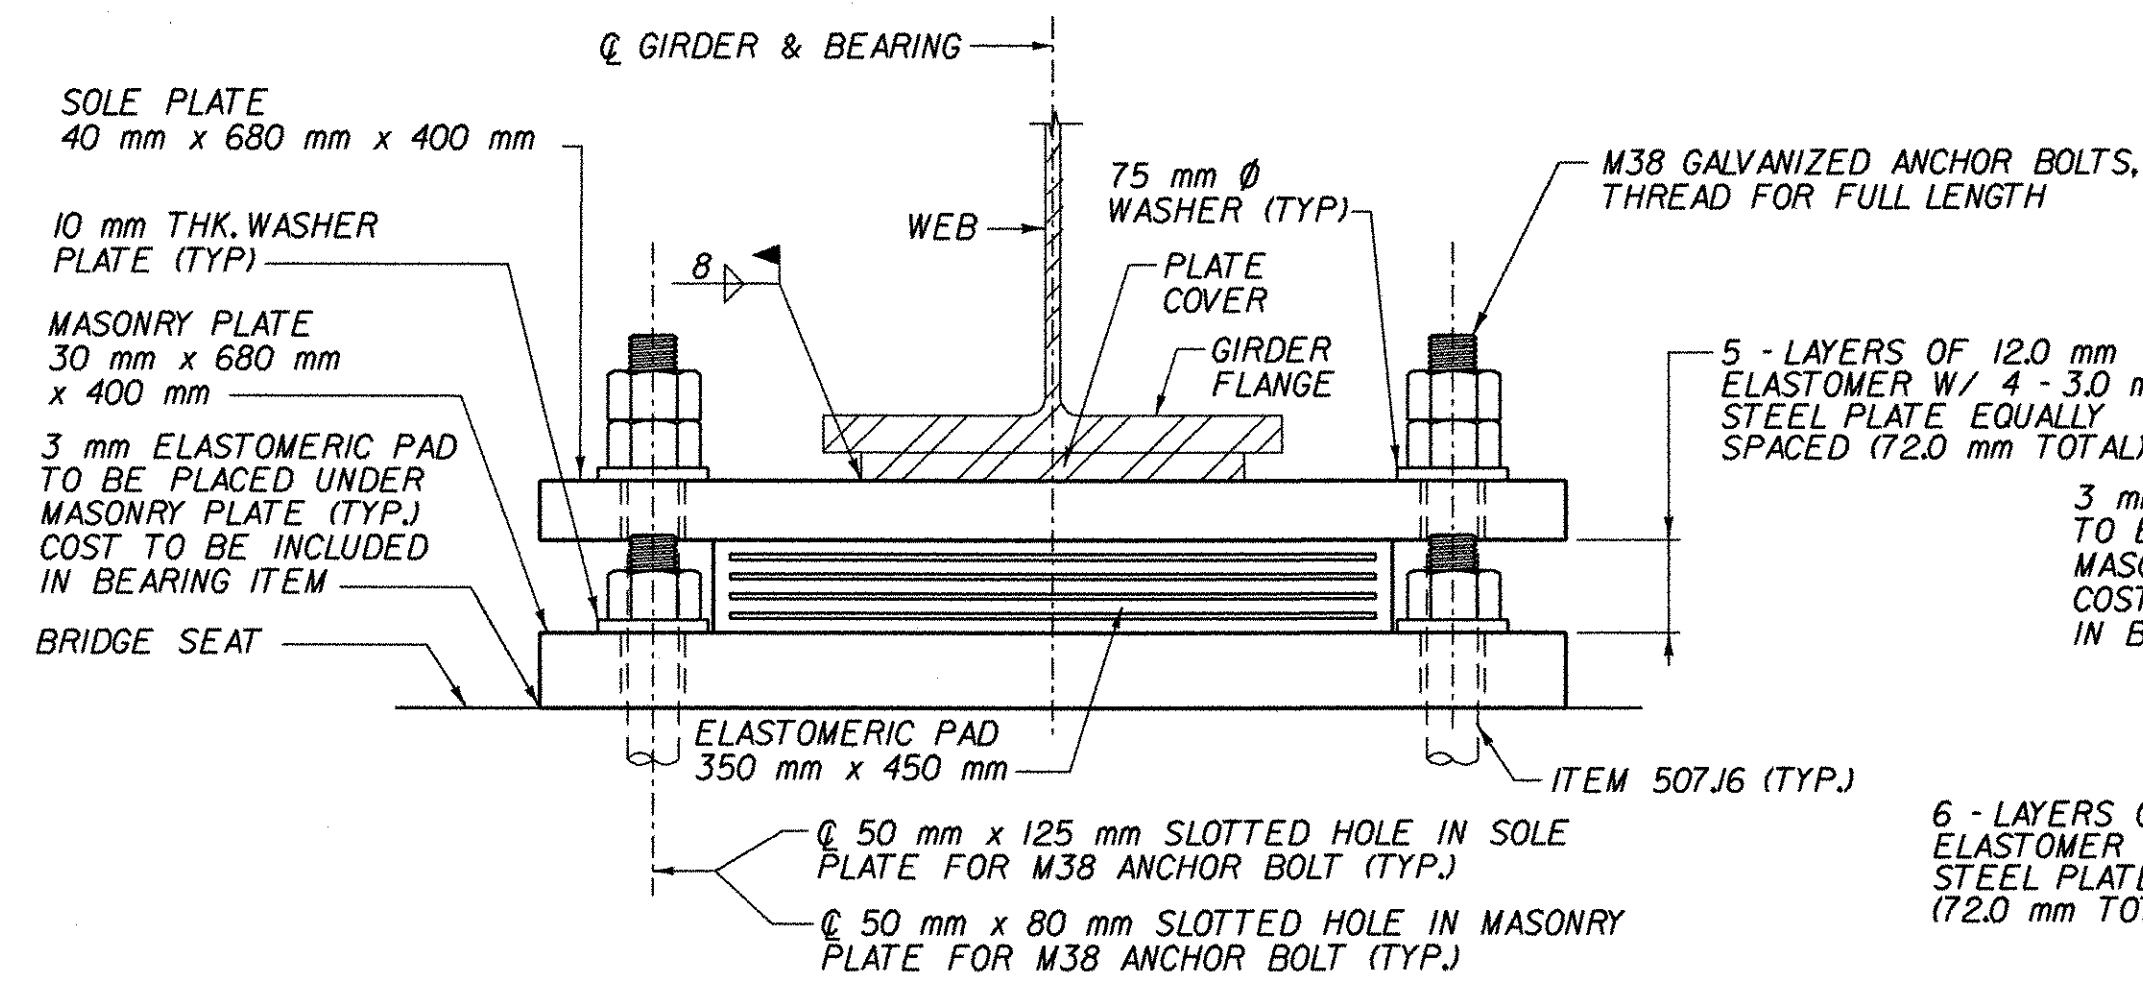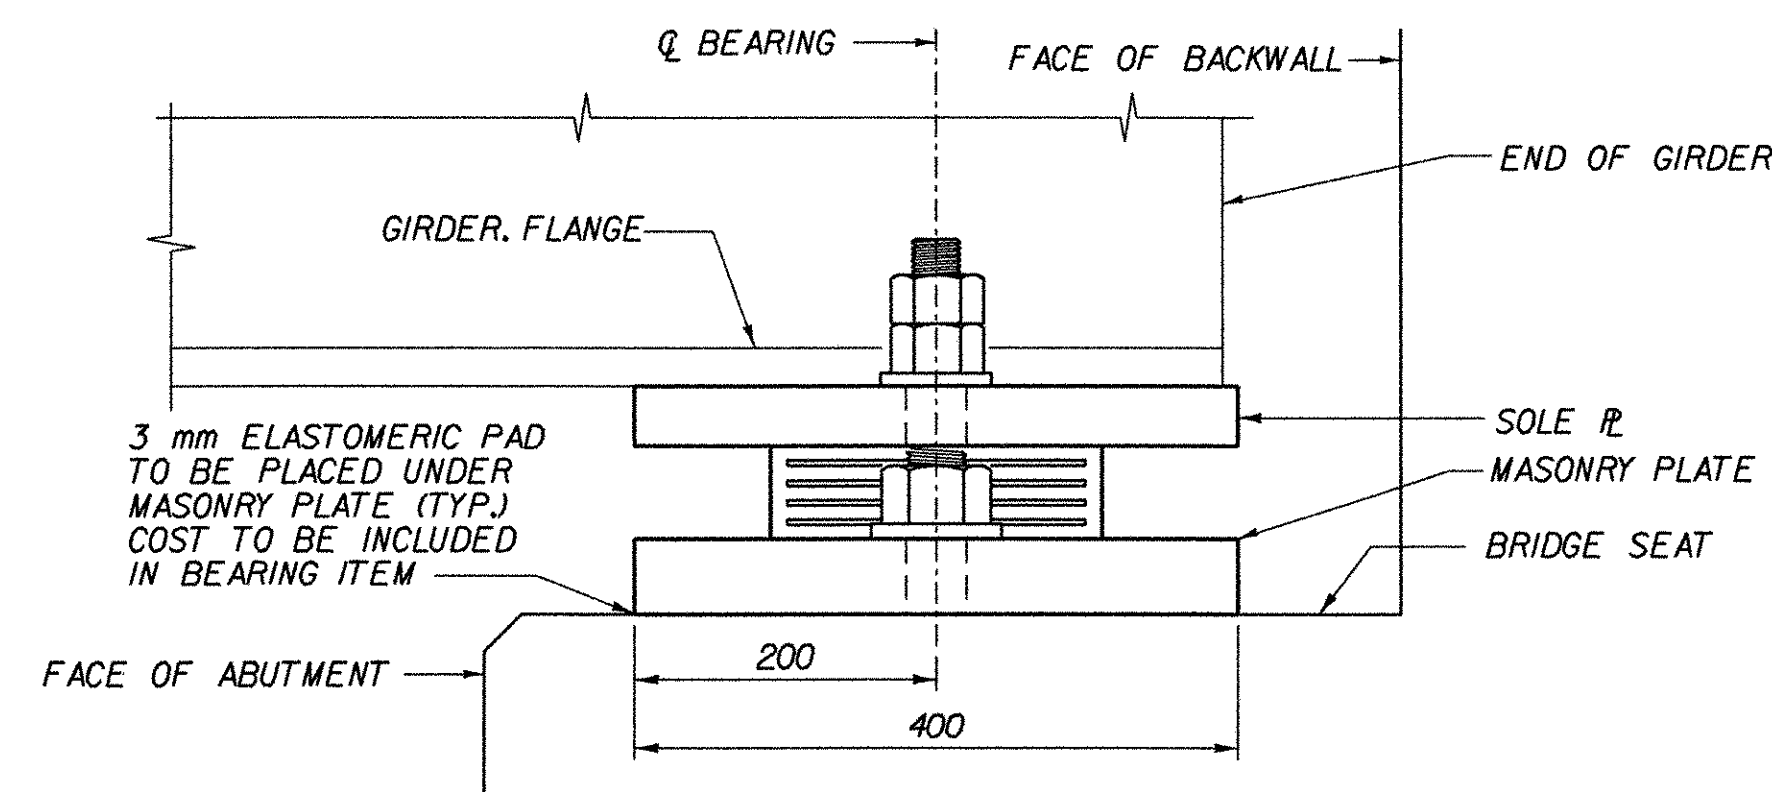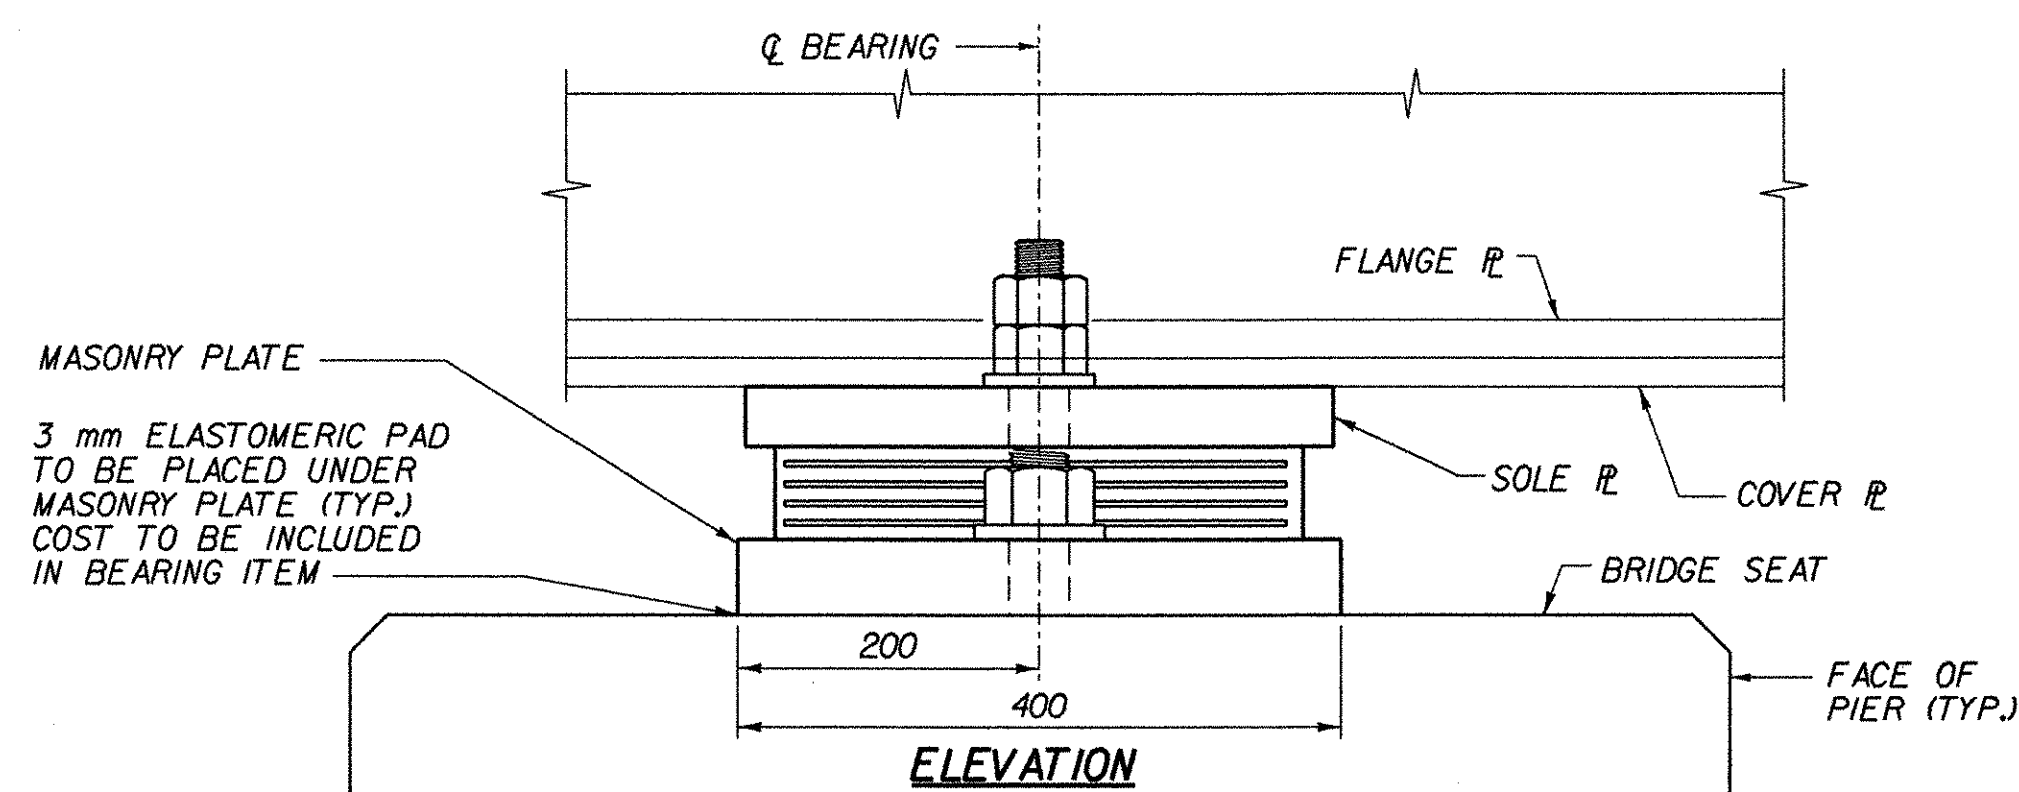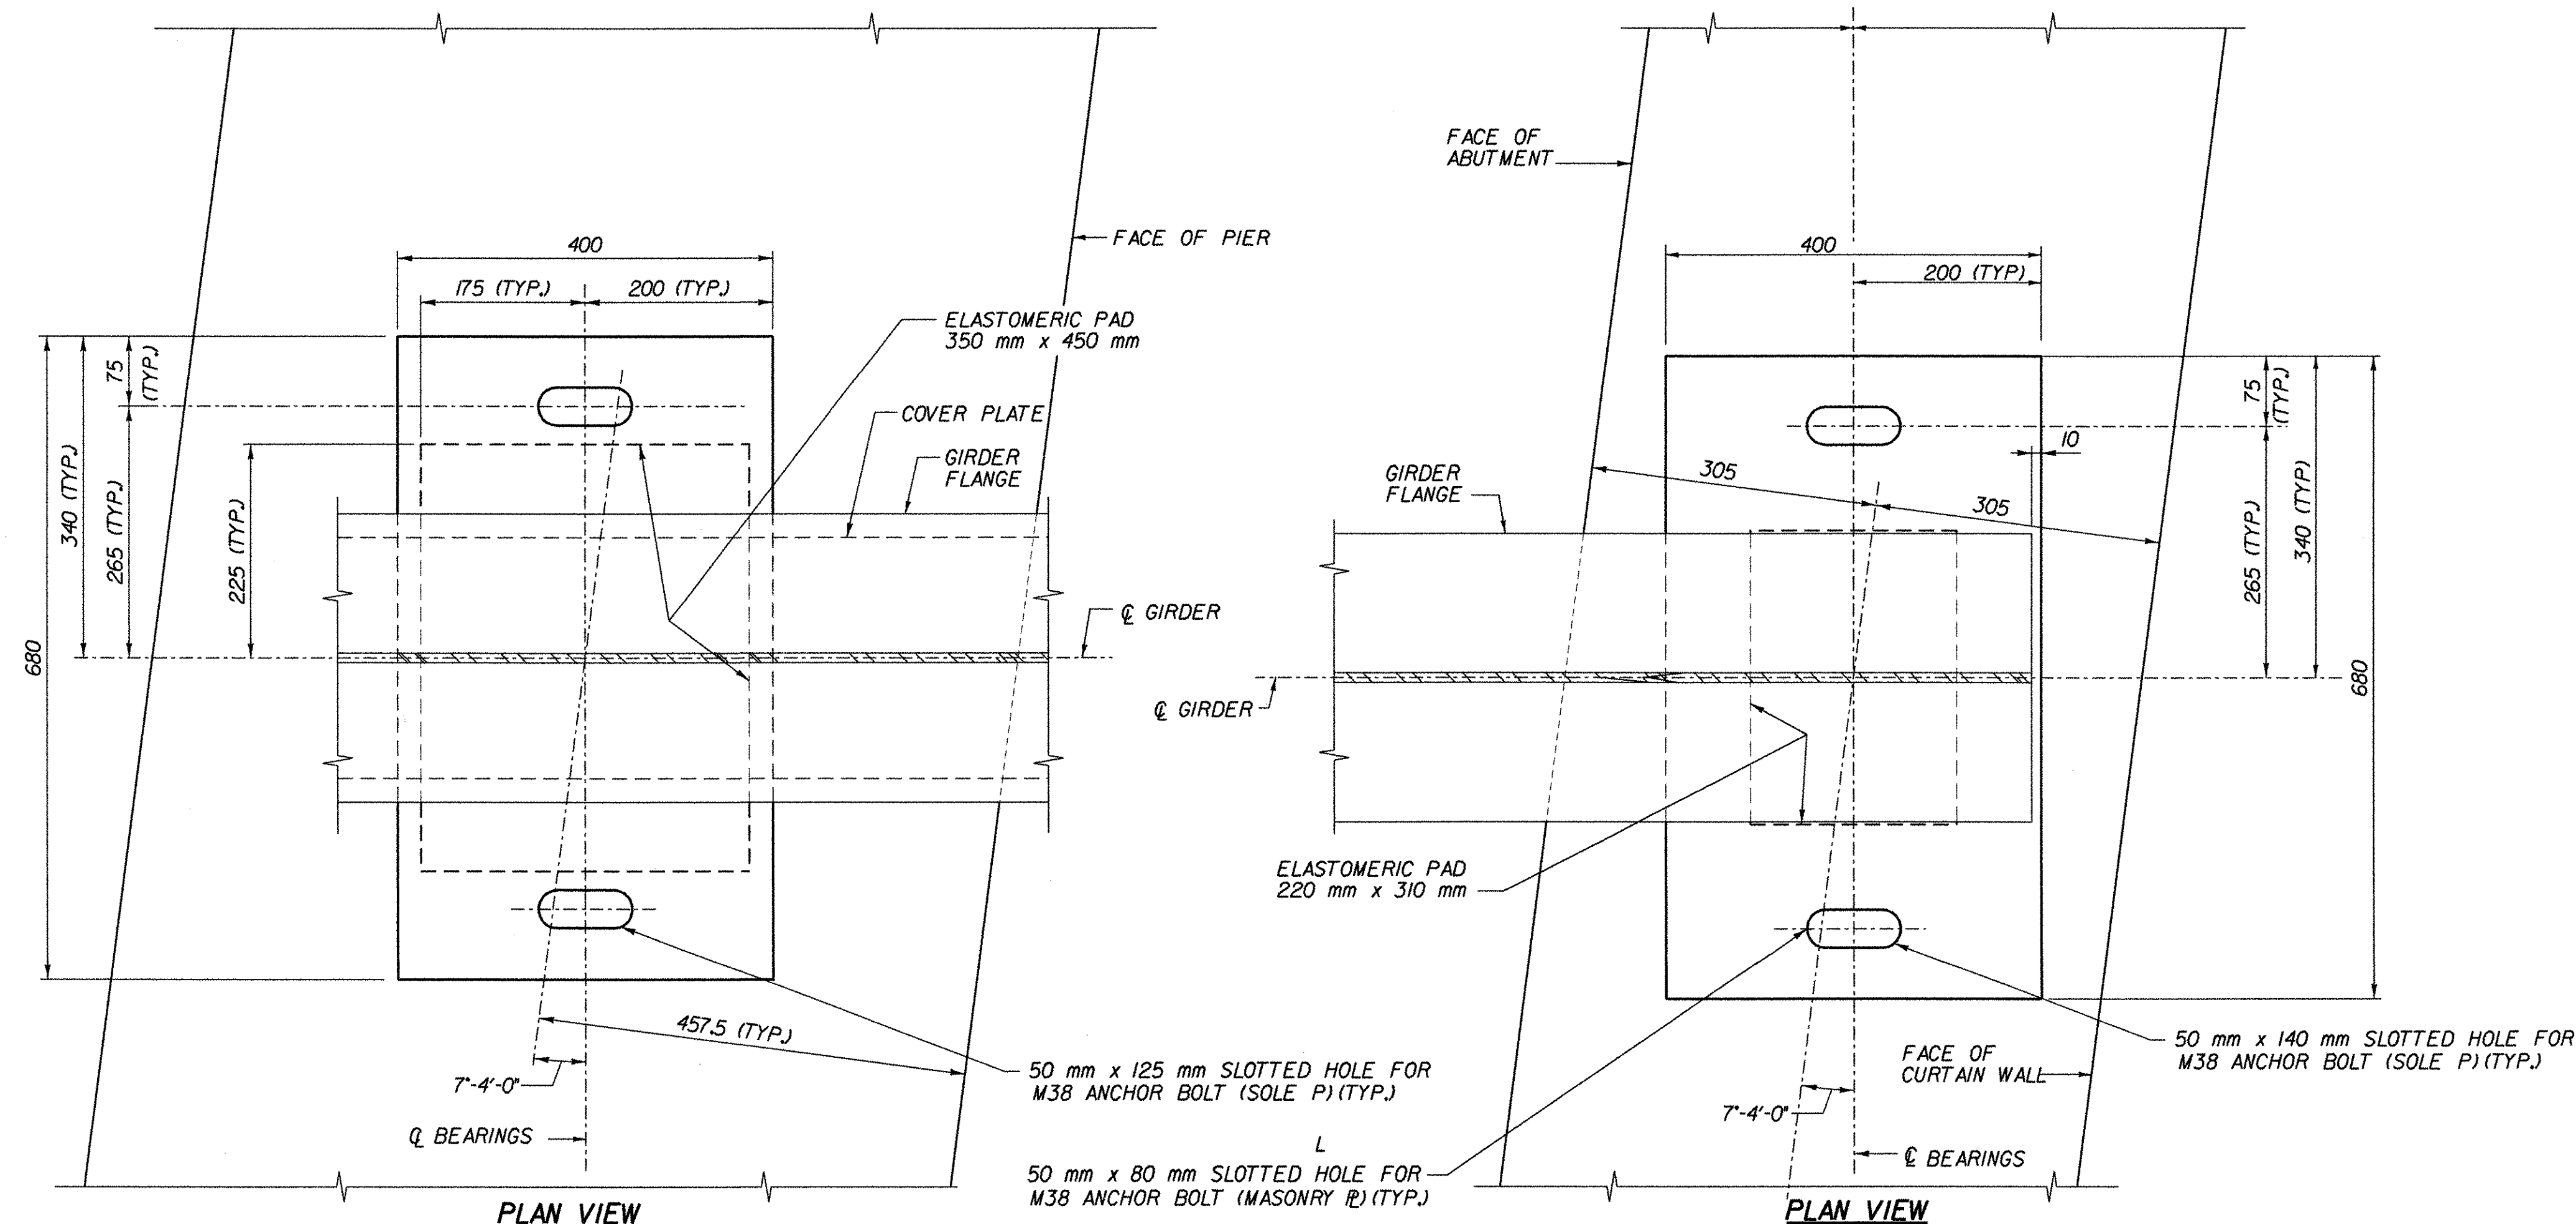

EXPANSION BEARING AT PIERS (FRONT VIEW)

BEARING DETAILS

EXPANSION BEARING AT ABUTMENTS 2 & 4 (FRONT VIEW)

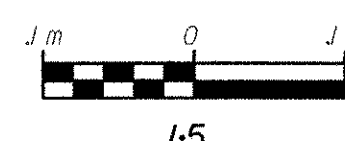


NOTES:

- SEE SHEET NO. BRI FOR BEARING NOTES.
- SEE GENERAL NOTE 13 ON SHEET NO. BRI FOR SHOP DRAWING DISTRIBUTION LIST.


STATE OF VERMONT  
AGENCY OF TRANSPORTATION

Town Of	BENNINGTON	Bridge No.	BRI200
Highway No.	VT. RTE. 279	Log Sta.	
		Surv. Sta.	17+853
VT. RTE. 279 OVER HISTORIC VT. ROUTE 7A			
BEARING DETAILS			
Designed By	D. STECIAK	Drawn by	K. RAPELLO/B. WEATHERBY
Checked By	Date	Bridge Design Supervisor	
M. W. OLSTAD	02/04	M. W. OLSTAD	Date 02/04
PROJECT	BENNINGTON-HOOSICK	PROJECT NO.	D.P.I. 0146(I) C/6
I.G.C. Info.			
Bridge Sheet No.	BRI207	Sheet	82 OF 83


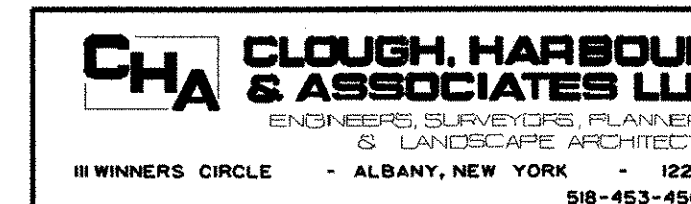


FILE NAME = s:\12502\mstn\frna\7a\brg\brgsh2.plt  
DATE/TIME = 2/17/2004  
USER = 2225



NOTE: UNLESS NOTED OTHERWISE, ALL STATIONS ARE IN KILOMETERS, ALL ELEVATIONS ARE IN METERS, AND ALL DIMENSIONS ARE IN MILLIMETERS.

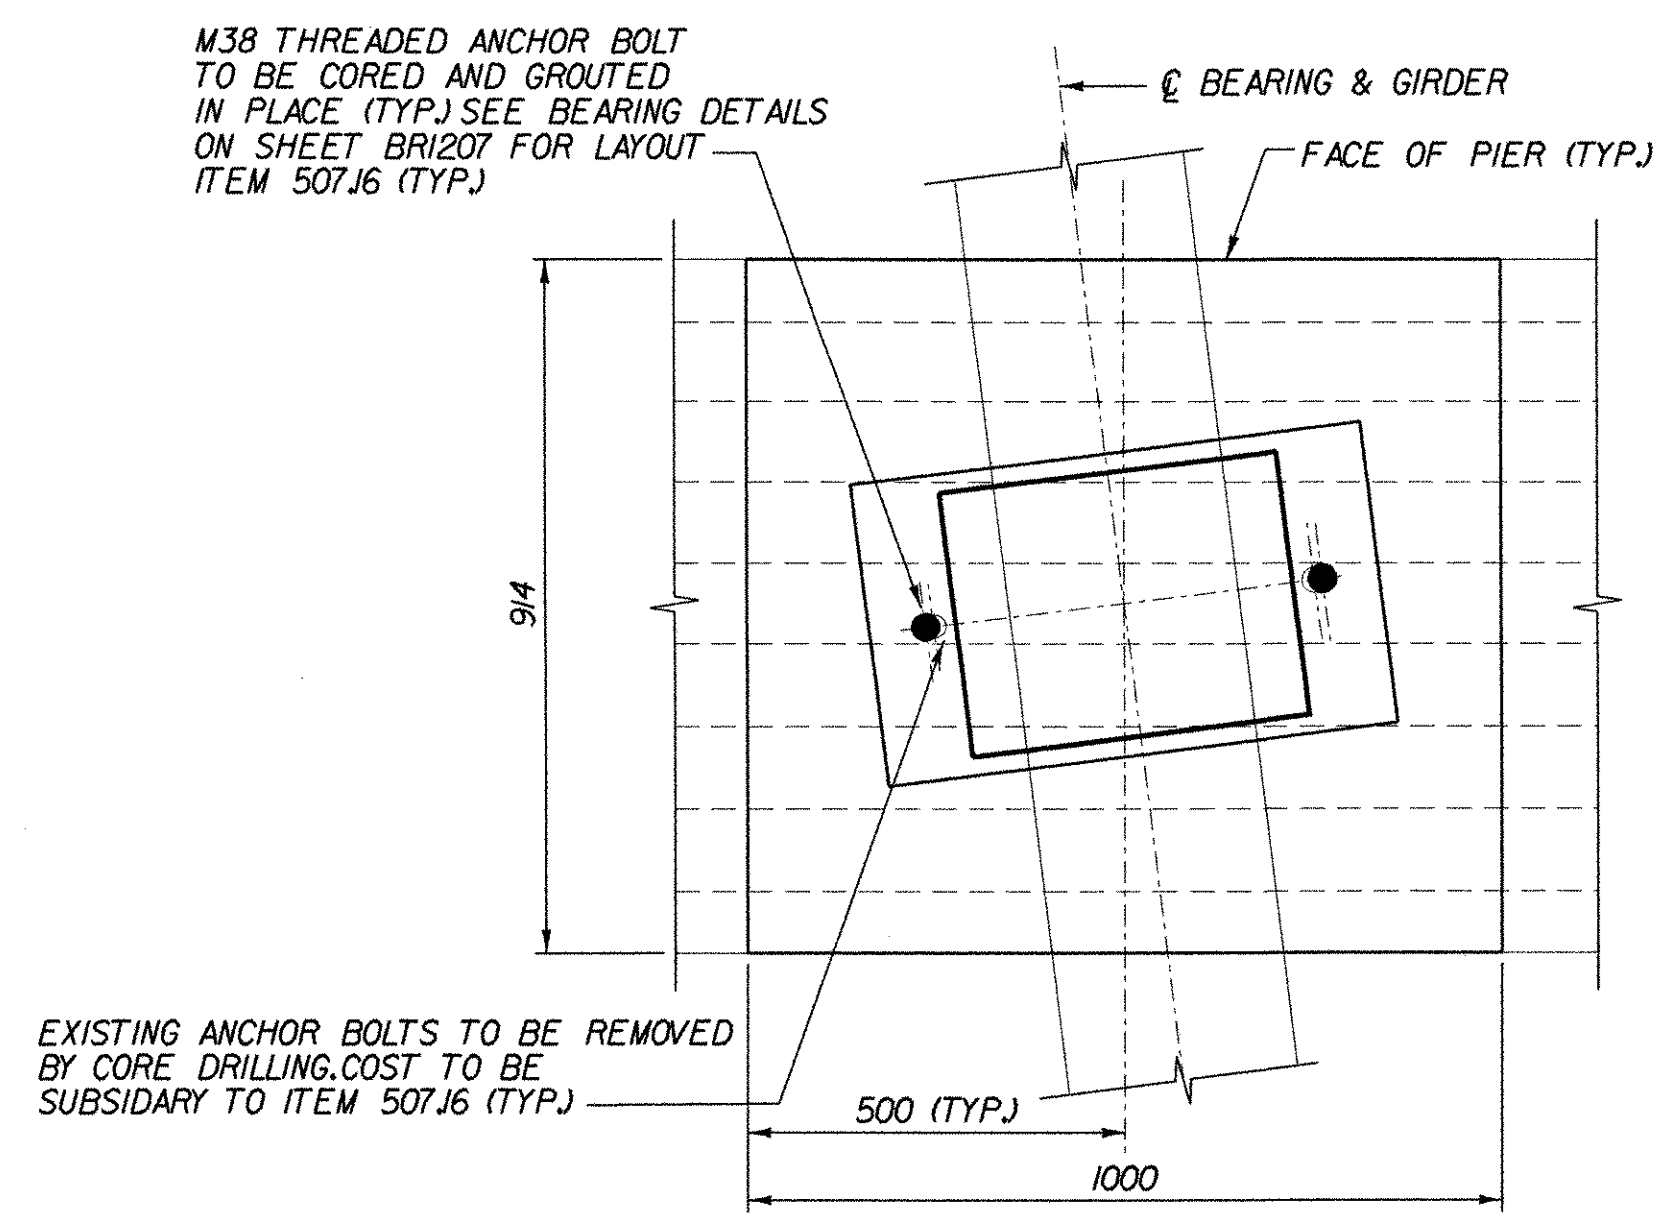



PIER PEDESTAL PLAN

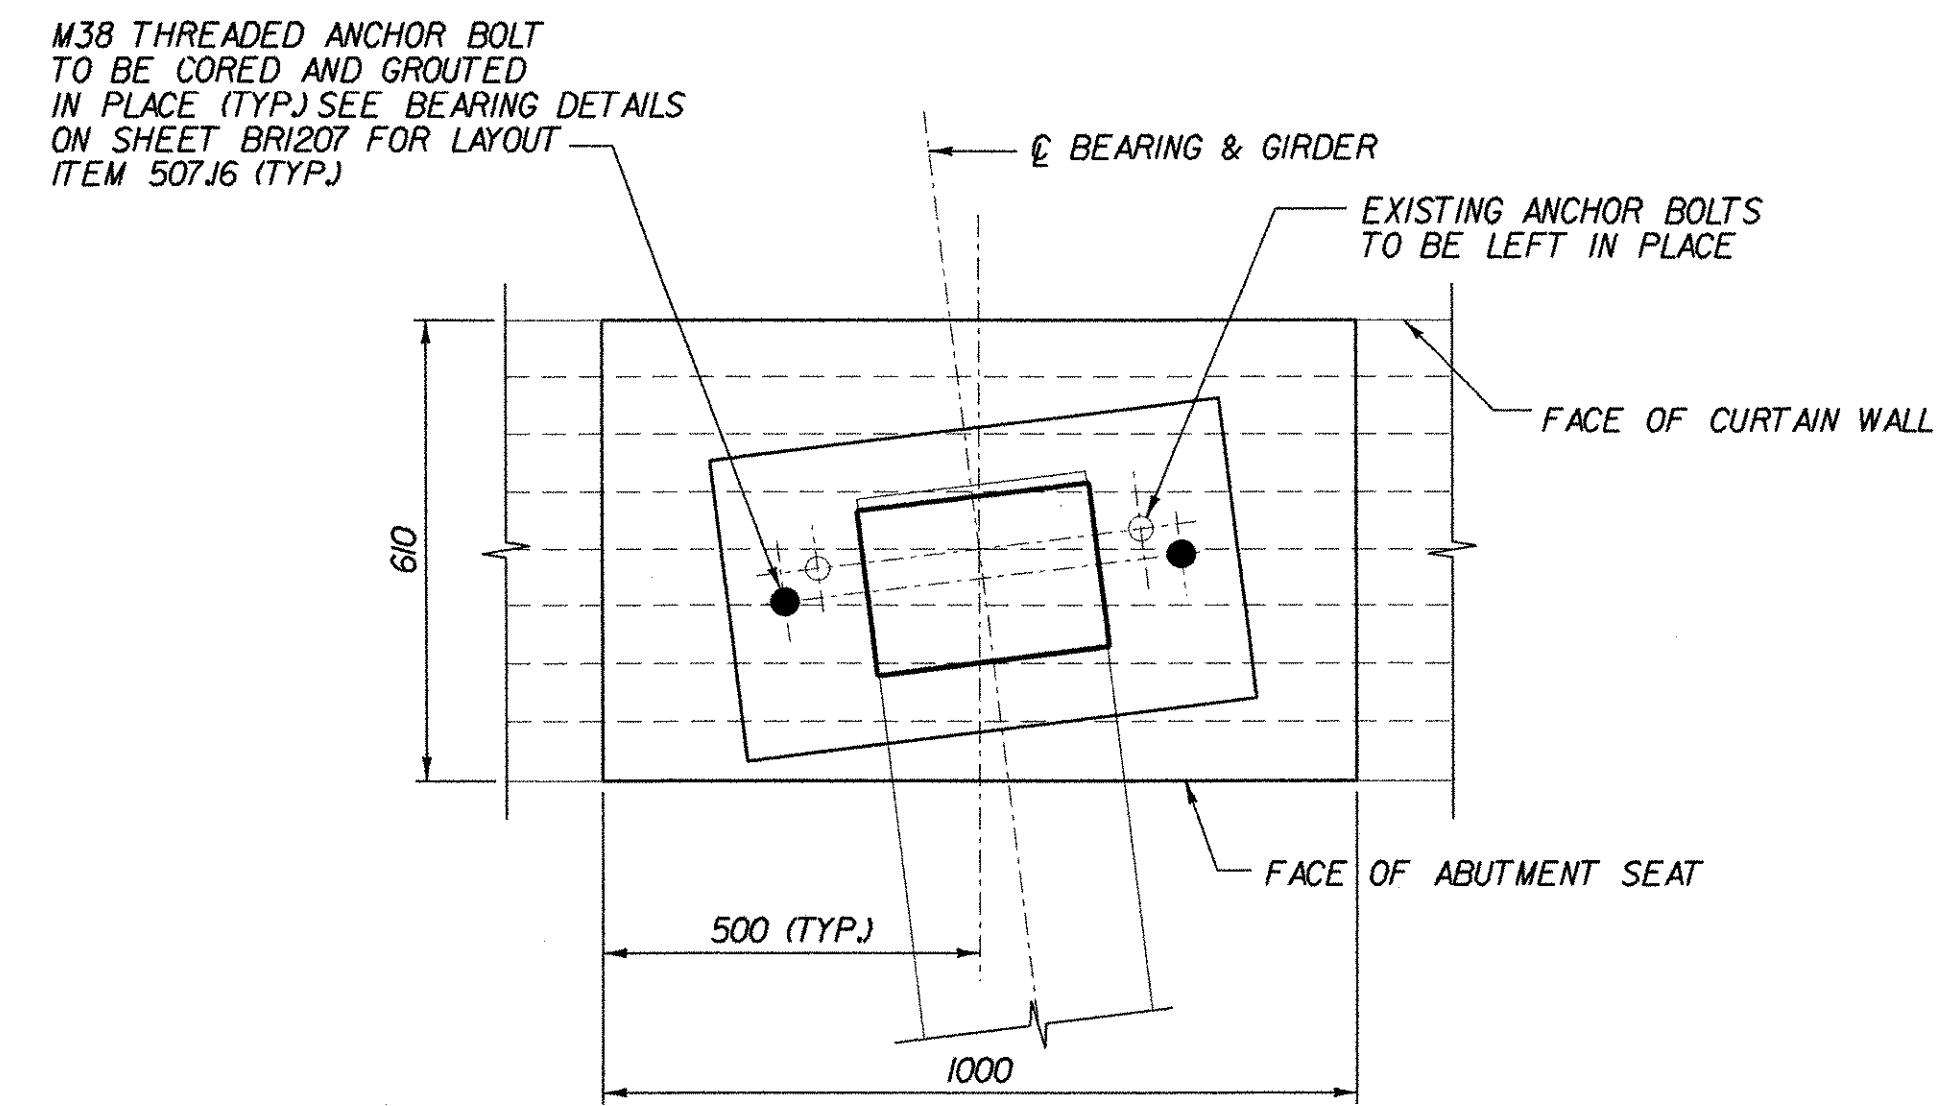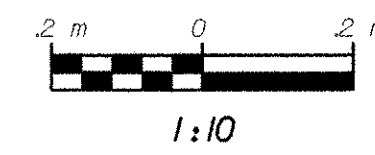



ABUTMENTS 2 & 4 PEDESTAL PLAN

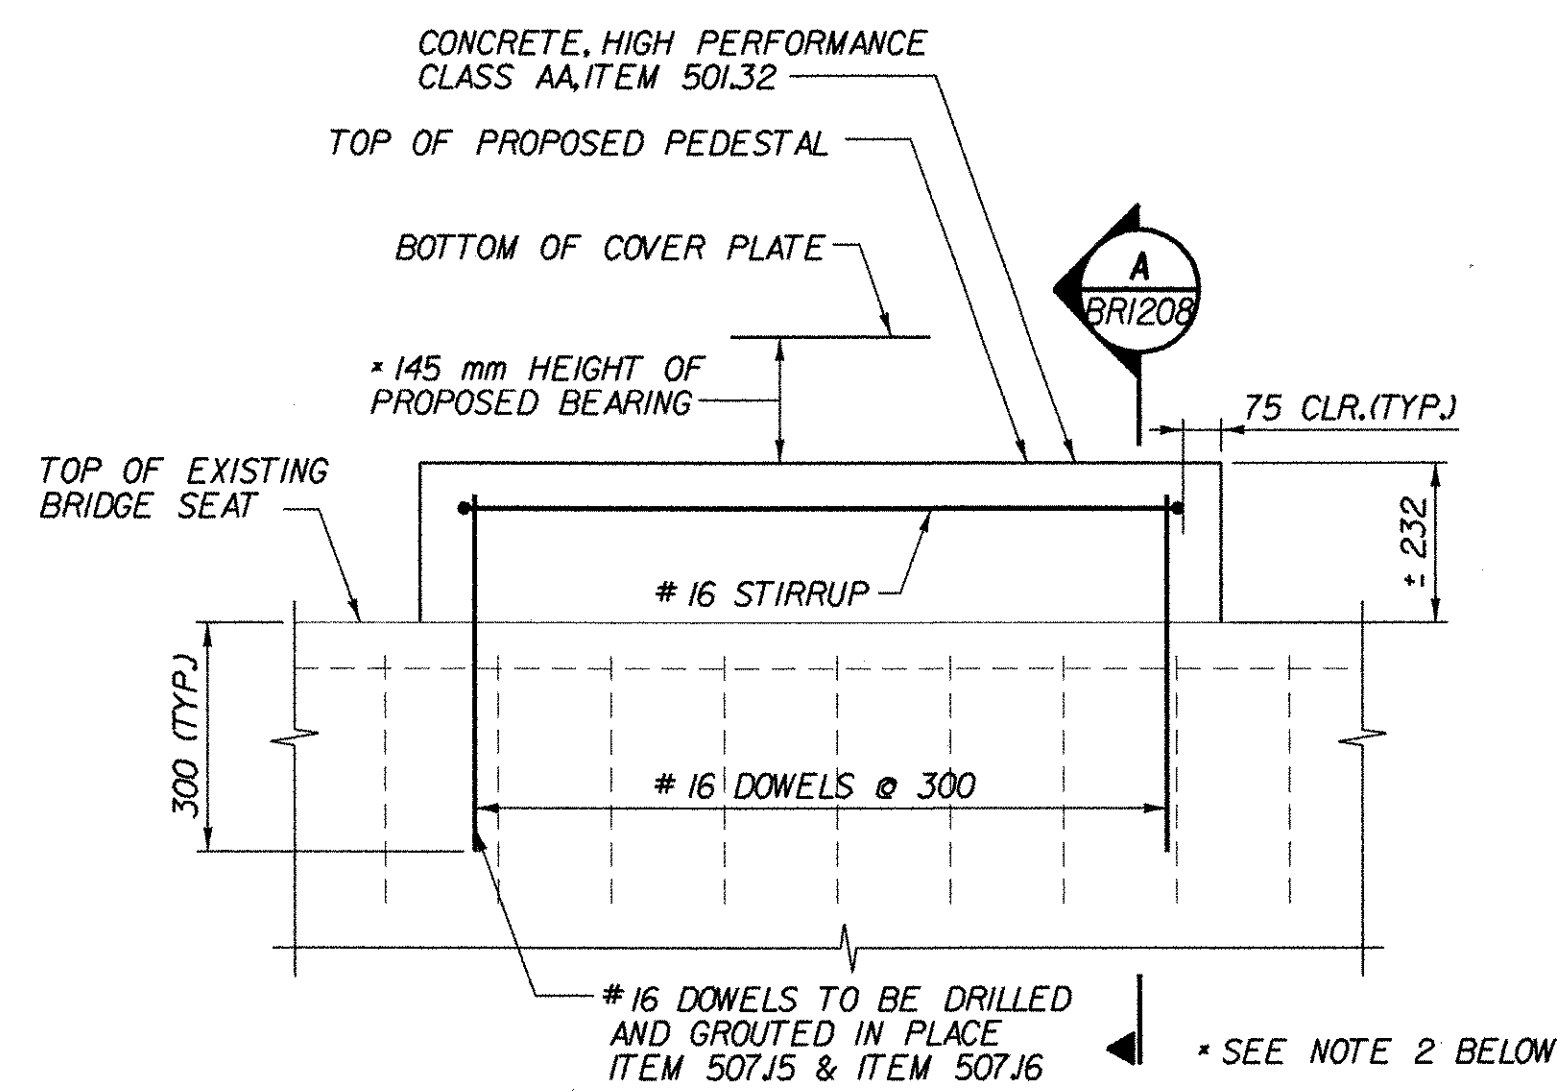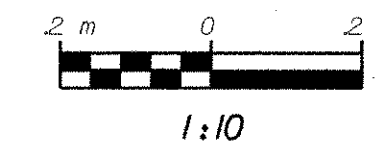


PIER PEDESTAL ELEVATION

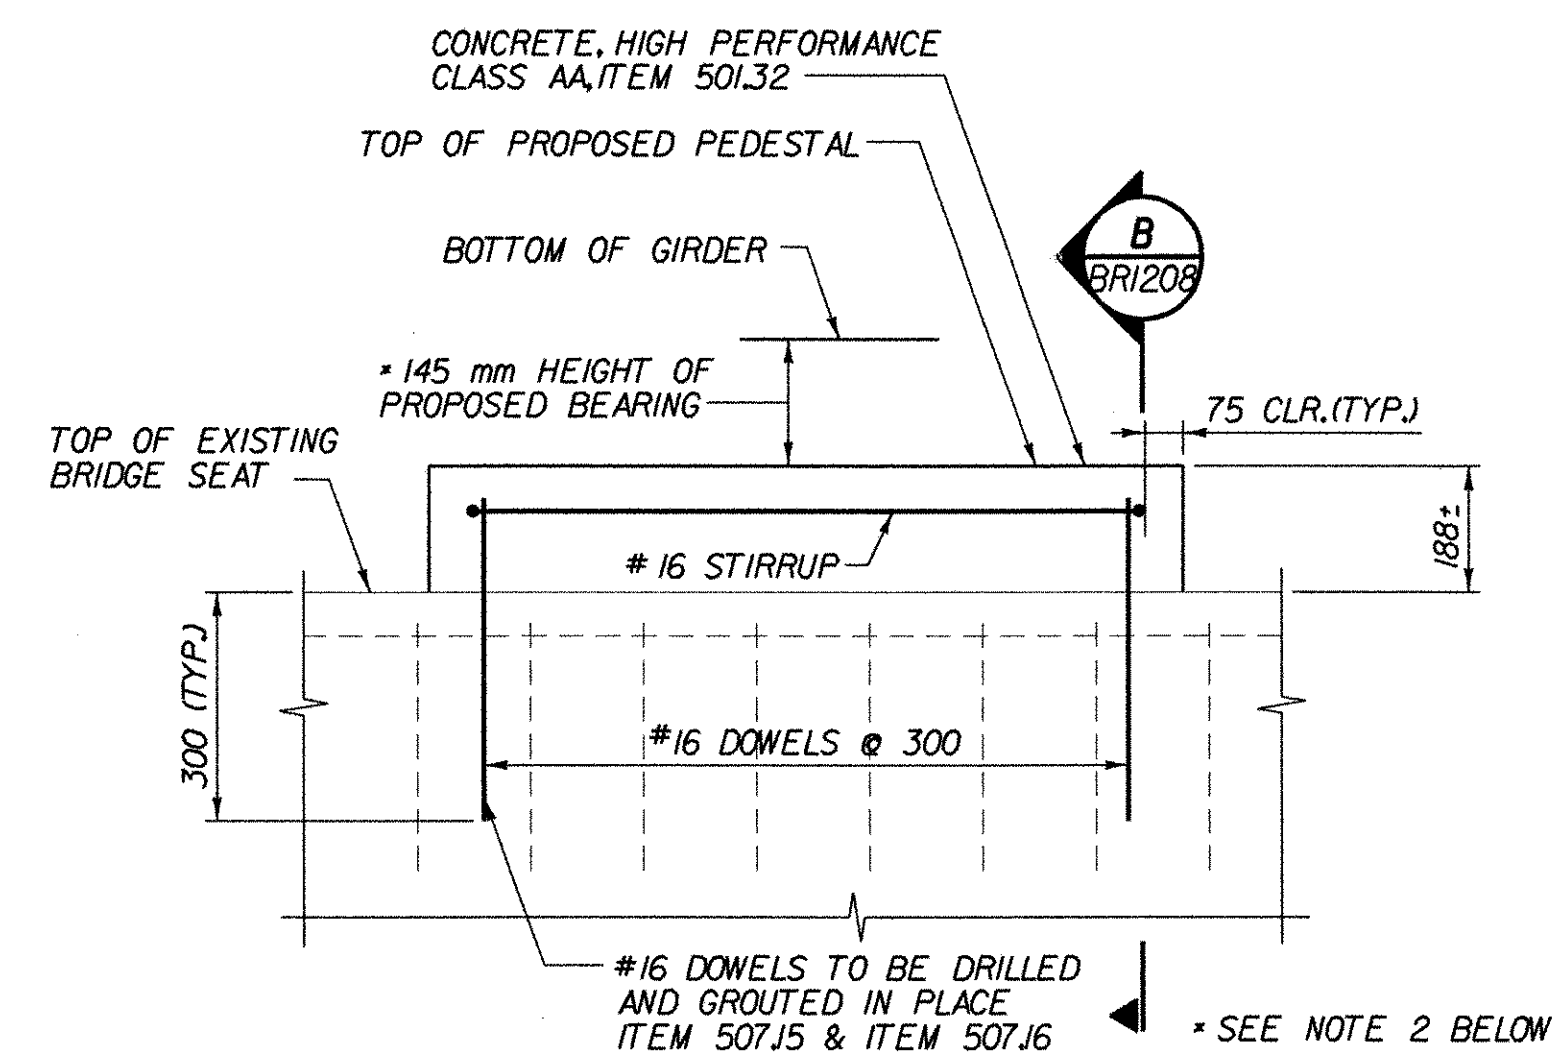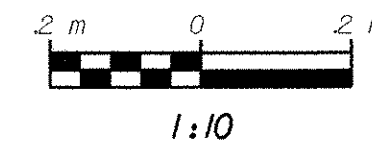


ABUTMENTS 2 & 4 PEDESTAL ELEVATION

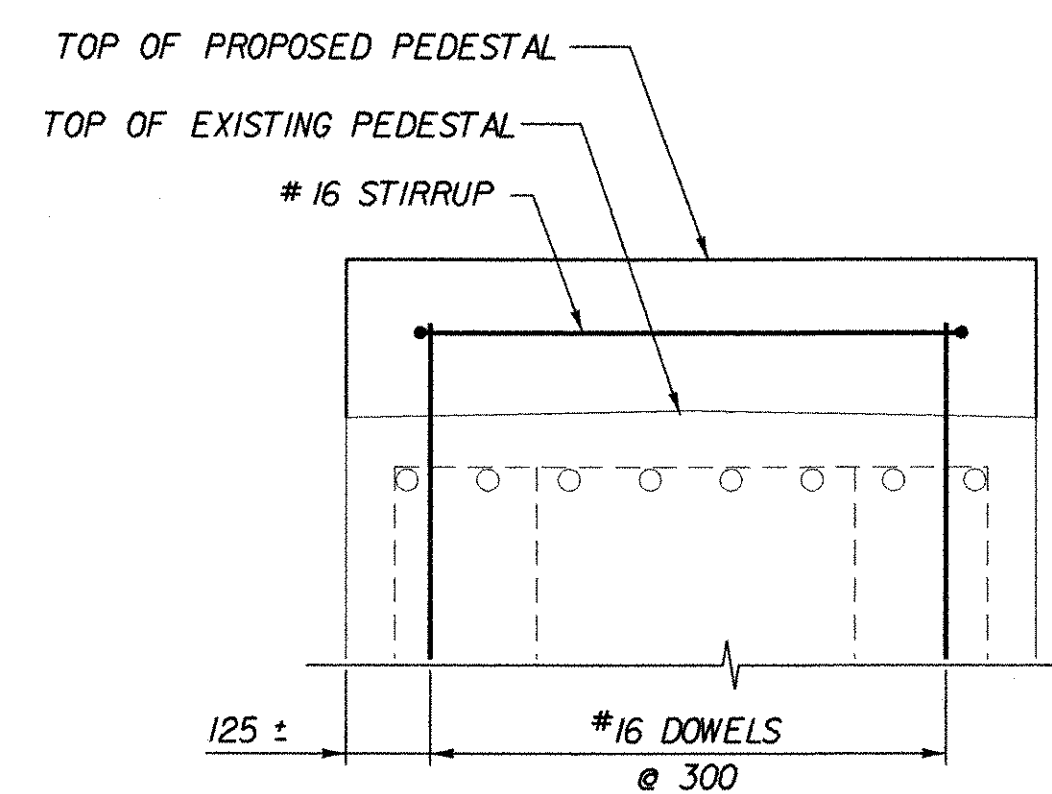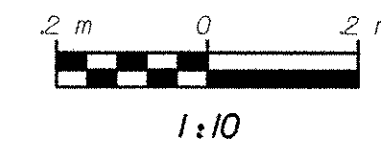

PIER PEDESTAL SECTION

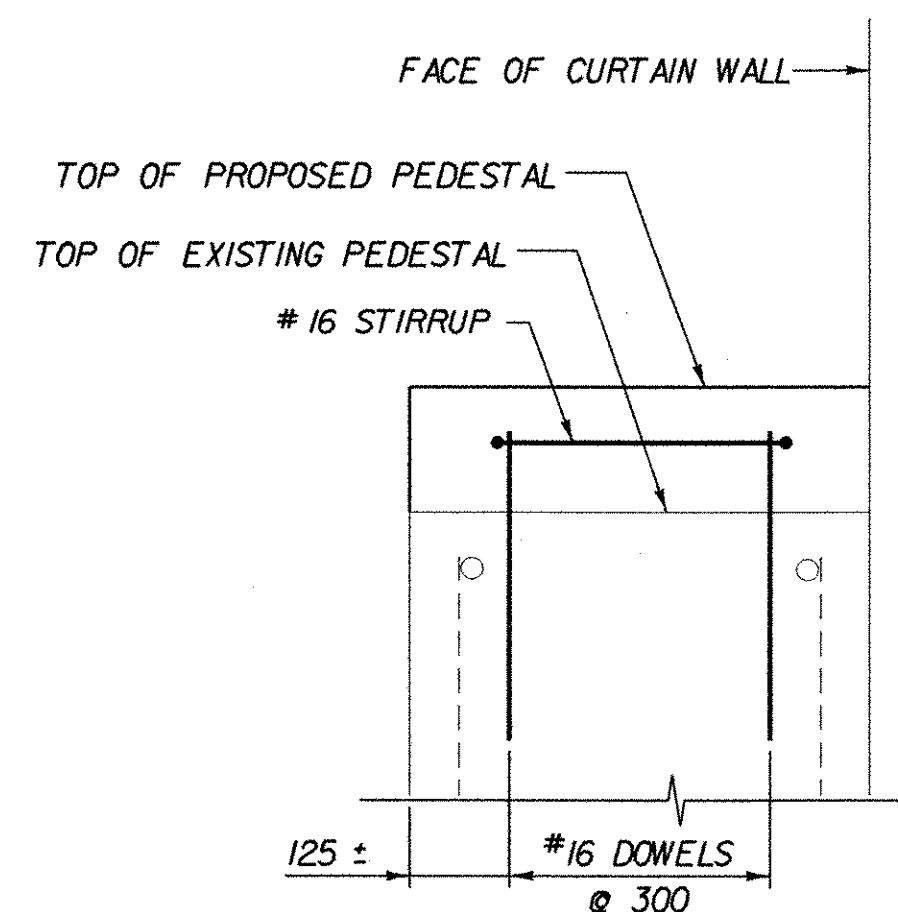

ABUTMENTS 2 & 4 PEDESTAL SECTION

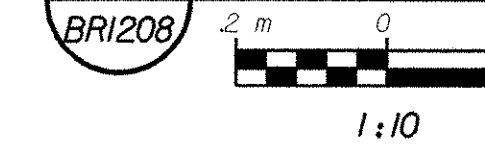

NOTES:

1. TOP OF EXISTING ANCHOR BOLTS SHALL BE CUT OFF TO MAINTAIN A MINIMUM OF 50 mm COVER IF NECESSARY, COST TO BE SUBSIDIARY TO ITEM 531U.
2. TOP OF PROPOSED PEDESTALS SHALL BE ADJUSTED TO MATCH EXISTING GIRDER ELEVATIONS AND TO FIT THE ACTUAL BEARING SUPPLIED BY THE CONTRACTOR.
3. EDGES OF FASCIA GIRDER PEDESTALS SHALL BE MATCHED TO THE EXISTING END OF PIER OR ABUTMENT SEAT.
4. EXISTING CONCRETE SHALL BE THOROUGHLY COATED WITH NEAT CEMENT PASTE BEFORE NEW CONCRETE IS POURED AS PER SUBSECTION 501J3B.

STATE OF VERMONT  
AGENCY OF TRANSPORTATION

Town Of	BENNINGTON	Bridge No.	BR1200
Highway No.	VT. RTE. 279	Log Sta.	
		Surv. Sta.	17+853
VT. RTE. 279 OVER HISTORIC VT. ROUTE 7A			

PEDESTAL DETAILS

Designed By	D. STECIAK	Drawn by	B. WEATHERBY
Checked By	M. W. OLSTAD	Date	02/04
		Bridge Design Supervisor	M.W. OLSTAD
		Date	02/04
PROJECT	BENNINGTON-HOOSICK		PROJECT NO.
			D.P.I. 0146(I) C/6