


646.414 DURABLE 150 mm WHITE LINE

W.B. STA. 17+540.000 - W.B. STA. 17+840.000 DASHED C (LANE LINE)
 W.B. STA. 17+540.000 - W.B. STA. 17+840.000 SOLID LT (EDGE LINE)
 E.B. STA. 17+522.100 - E.B. STA. 17+822.000 DASHED C (LANE LINE)
 E.B. STA. 17+522.100 - E.B. STA. 17+822.000 SOLID RT (EDGE LINE)

646.415 DURABLE 150 mm YELLOW LINE

W.B. STA. 17+540.000 - W.B. STA. 17+840.000 SOLID RT (EDGE LINE)
 E.B. STA. 17+522.100 - E.B. STA. 17+822.000 SOLID LT (EDGE LINE)

675.50 REMOVING SIGNS AS SHOWN - R

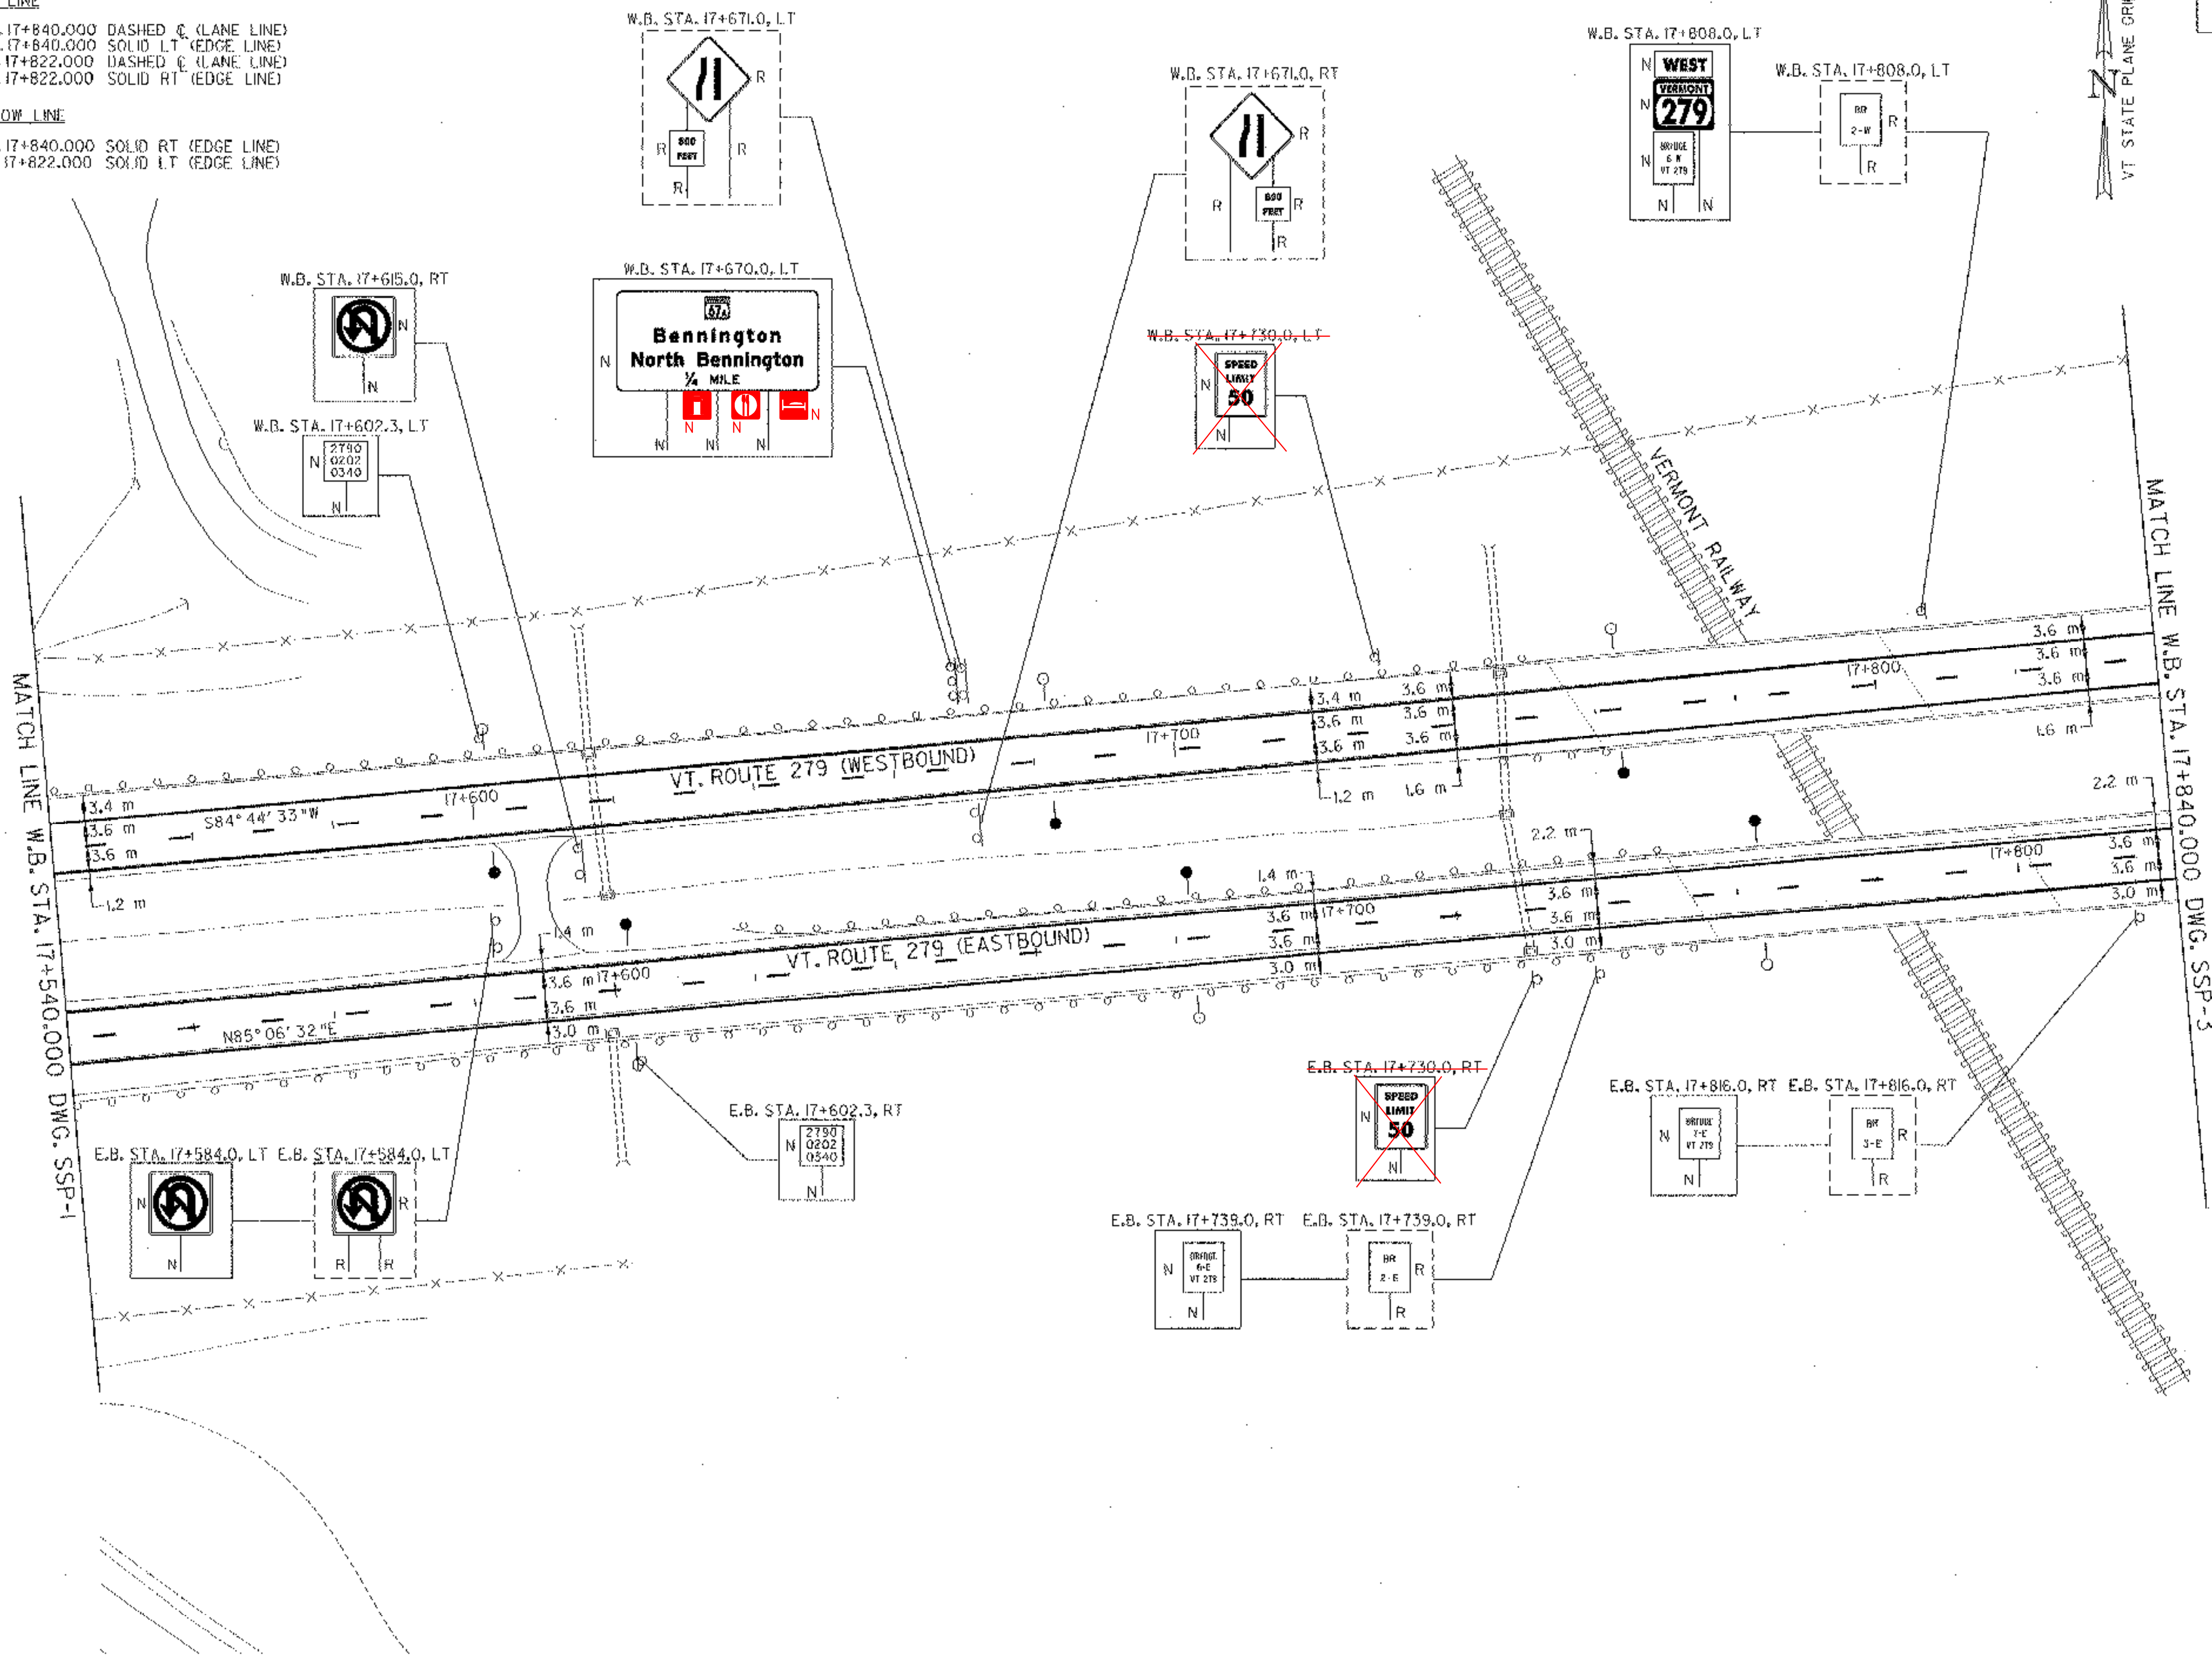

FILE NAME = \\A1115\vac\contract\asp02.dgn
 DATE/TIME = 2/16/2004
 USER = 2225

DATUM	
VERTICAL	NAVD 88
HORIZONTAL	NAD 83 (9992)

LEGEND	
●	TYPE I, WHITE
○	TYPE I, AMBER
○	TYPE II, WHITE

676.10 DELINEATORS, W/STEEL POSTS

○	TYPE I, WHITE	○	TYPE I, AMBER
W.B. STA. 17+602.3 LT	W.B. STA. 17+602.3 RT	W.B. STA. 17+682.3 LT	W.B. STA. 17+682.3 RT
W.B. STA. 17+763.3 LT	W.B. STA. 17+763.3 RT	E.B. STA. 17+602.3 RT	E.B. STA. 17+602.3 LT
E.B. STA. 17+682.3 RT	E.B. STA. 17+682.3 LT	E.B. STA. 17+763.3 RT	E.B. STA. 17+763.3 LT



SIGNING AND STRIPING PLAN	SURVEYED BY	C.H.A. & V.S.E.	DATE	12/93
	DESIGNED BY	D.W.E.	DATE	2/04
	DRAWN BY	C.A.K.	DATE	2/04
	CHECKED BY	D.E.G.	DATE	2/04
DESIGN FILE NO.		SSP02.DGN		
PROJ. NAME		BENNINGTON - HOOSICK D.P.J. 014611 C/G		
PROJ. NO.		P.I.N. 1306.60		
DWG. NO.		SSP-2		
		SHEET 12 OF 83		

SIGN LEGEND	
R	REMOVE
S	SALVAGE
N	NEW
RET	RETAIN
B-B	BACK TO BACK
EXISTING	EXISTING
NEW	NEW