

646.414 DURABLE 150 mm WHITE LINE

W.B. STA. 17+840.000	-	W.B. STA. 17+938.000	DASHED C (LANE LINE)
W.B. STA. 17+840.000	-	W.B. STA. 17+941.584	SOLID LT (EDGE LINE)
W.B. STA. 17+982.000	-	W.B. STA. 18+000.000	SOLID LT (EDGE LINE)
E.B. STA. 17+822.000	-	E.B. STA. 17+860.000	DASHED C (LANE LINE)
E.B. STA. 17+822.000	-	E.B. STA. 17+860.000	SOLID RT (EDGE LINE)
E.B. STA. 17+987.900	-	E.B. STA. 18+000.000	SOLID RT (EDGE LINE)
STA. E2+320.000	-	STA. E2+471.417	SOLID RT (EDGE LINE)
STA. F2+000.000	-	STA. F2+100.000	SOLID RT (EDGE LINE)



646.415 DURABLE 150 mm YELLOW LINE

W.B. STA. 17+840.000	-	W.B. STA. 18+000.000	SOLID RT (EDGE LINE)
E.B. STA. 17+822.000	-	E.B. STA. 18+000.000	SOLID LT (EDGE LINE)
STA. E2+320.000	-	STA. E2+434.500	SOLID LT (EDGE LINE)
STA. F2+076.100	-	STA. F2+100.000	SOLID LT (EDGE LINE)

646.44 DURABLE 300 mm WHITE LINE

W.B. STA. 17+938.000	-	W.B. STA. 17+982.000	SOLID C (CORE LINE)
E.B. STA. 17+860.000	-	E.B. STA. 17+987.900	SOLID C (CORE LINE)
E.B. STA. 17+950.000	-	E.B. STA. 17+987.900	DIAGONALS RT (GORE AREA)
STA. E2+434.500	-	STA. E2+461.000	SOLID LT (GORE LINE)
STA. F2+000.000	-	STA. F2+075.600	SOLID LT (GORE LINE)

675.50 REMOVING SIGNS
AS SHOWN - 9

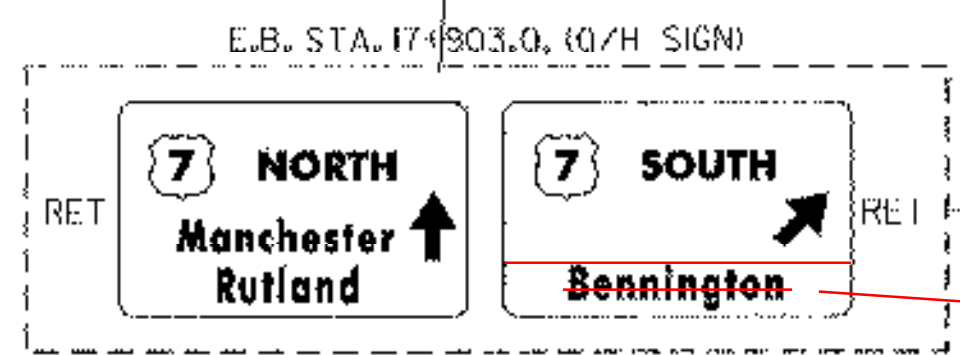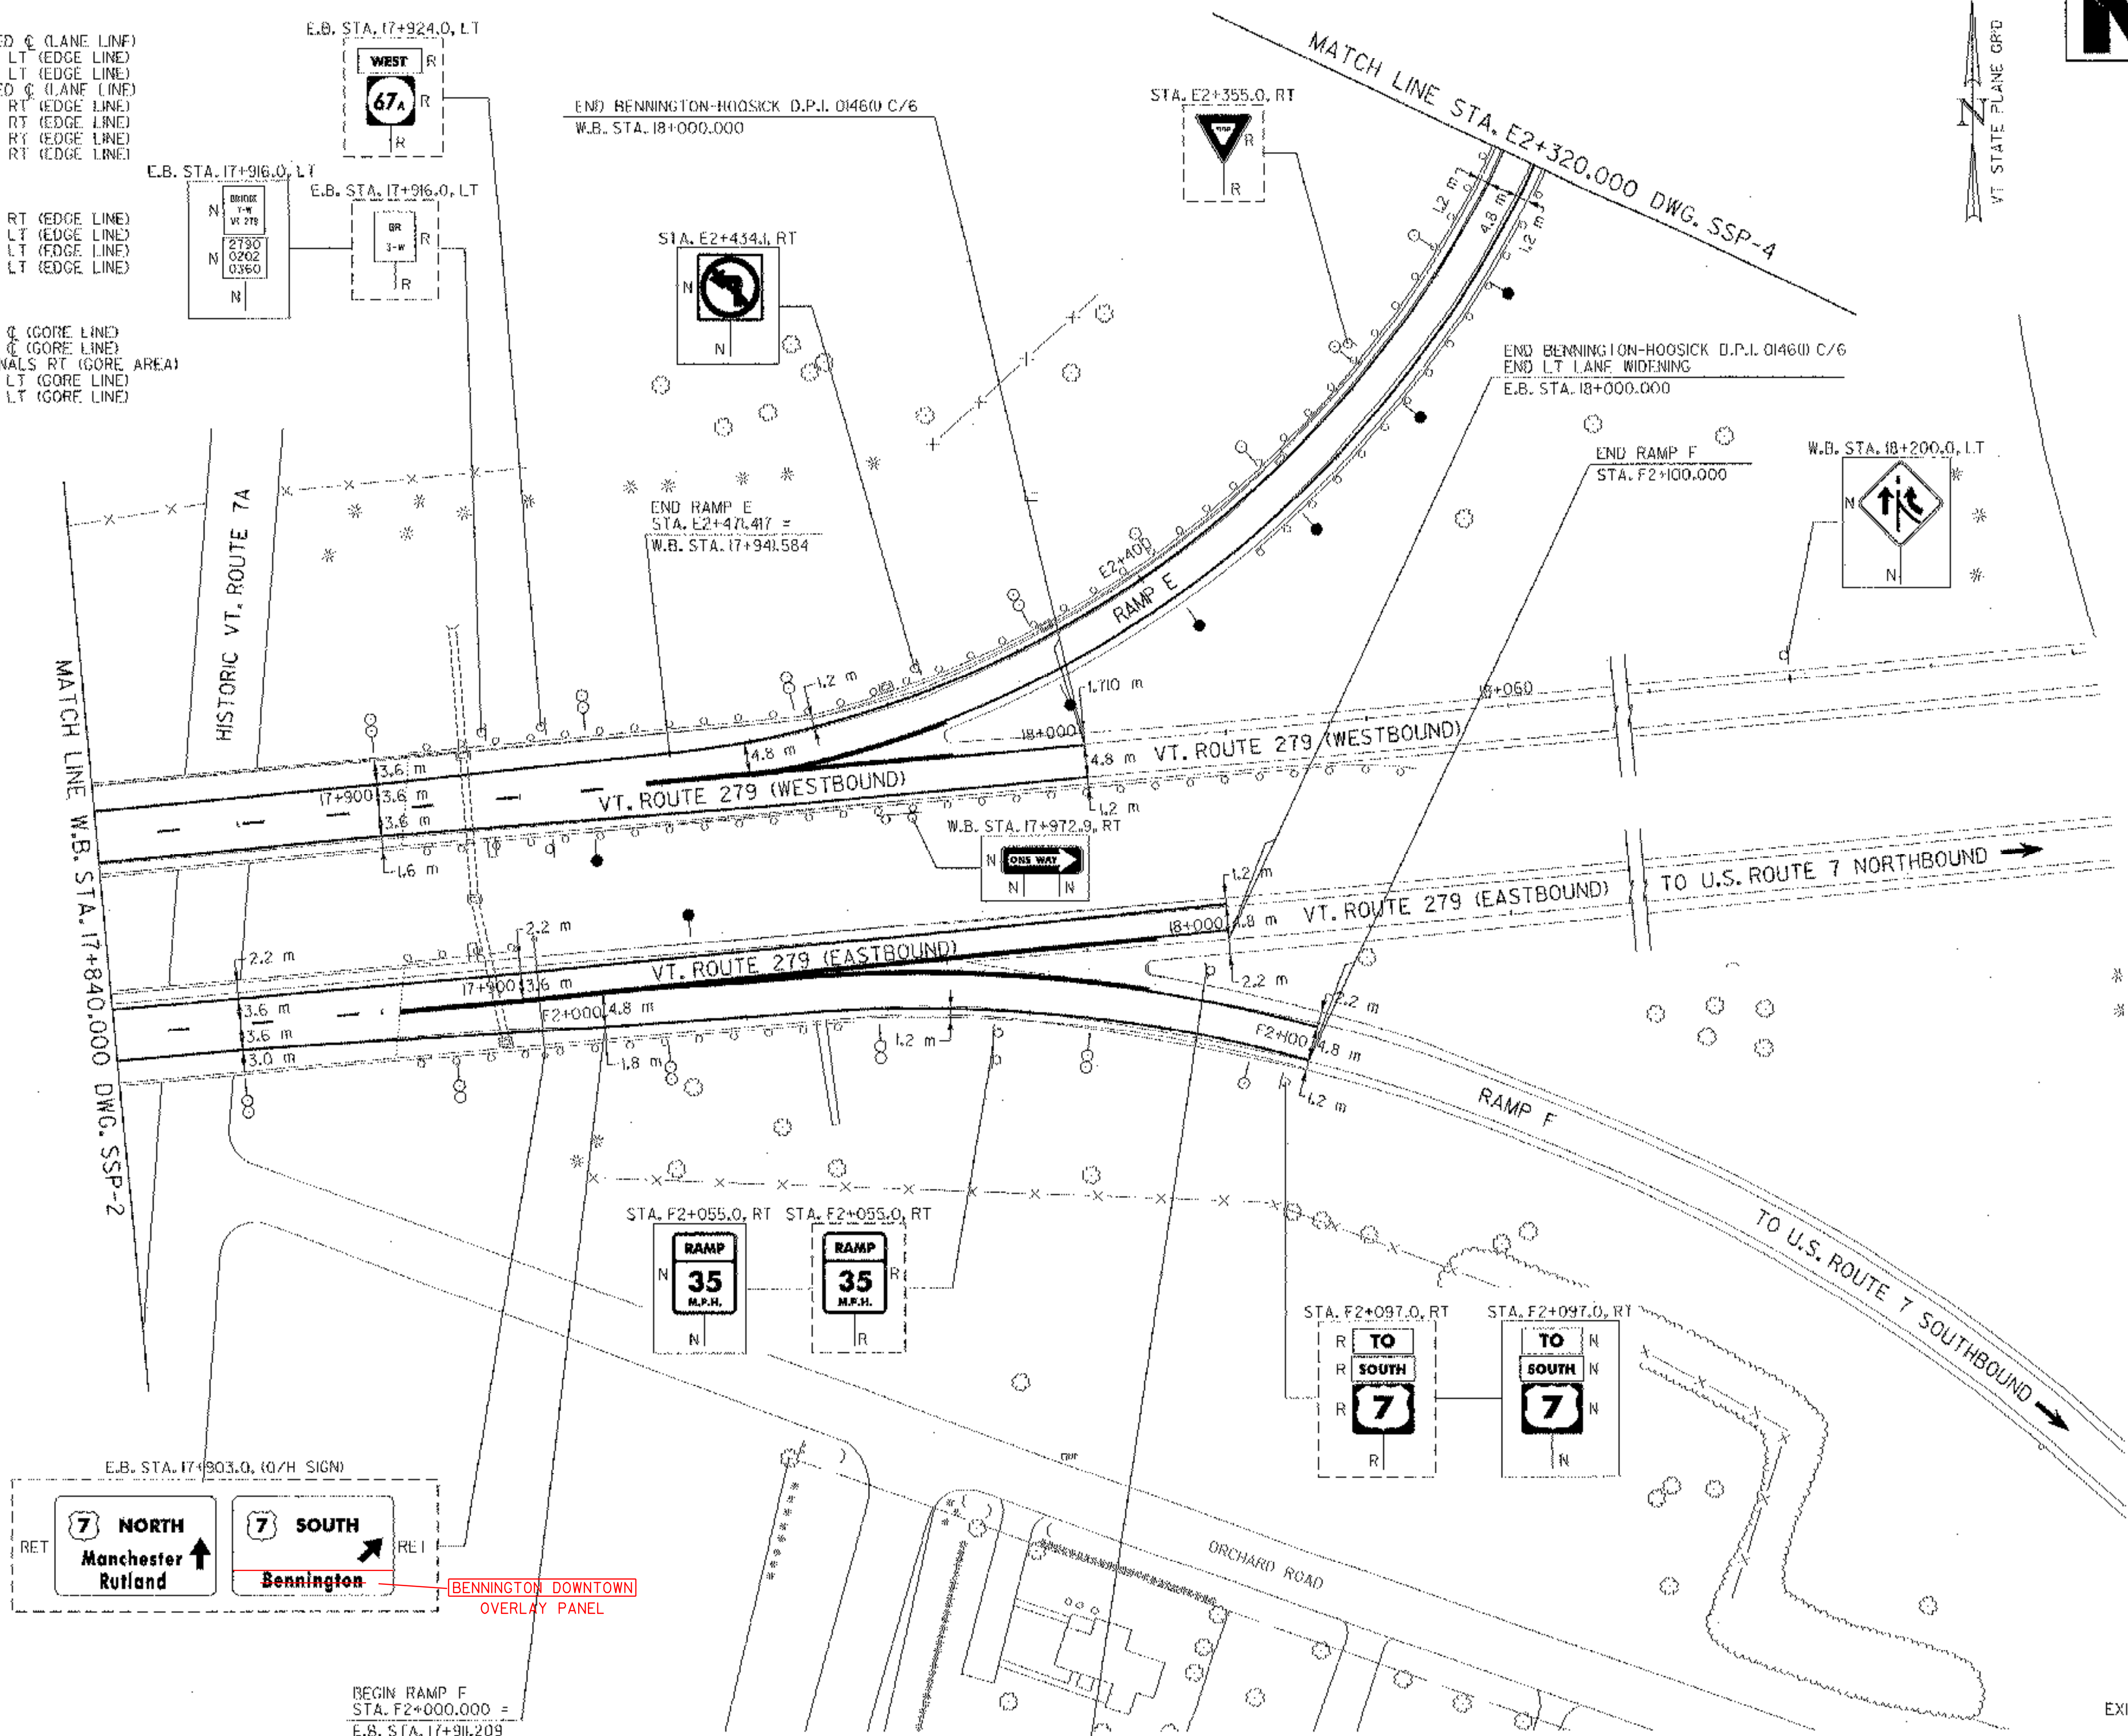

676.10 DELINEATORS W/STEEL POSTS

TYPE I, WHITE	TYPE I, AMBER	TYPE II, WHITE
STA. E2+337.0 RT	W.B. STA. 17+930.0 RT	W.B. STA. 17+900.0 LT
STA. E2+357.0 RT	E.B. STA. 17+924.3 LT	W.B. STA. 17+930.0 LT
STA. E2+377.0 RT	STA. E2+337.0 LT	E.B. STA. 17+860.0 RT
STA. E2+397.0 RT	STA. E2+357.0 LT	E.B. STA. 17+890.0 RT
STA. F2+091.8 RT	STA. E2+377.0 LT	STA. E2+417.0 RT
	STA. E2+397.0 LT	STA. E2+453.0 RT
	STA. E2+417.0 LT	STA. F2+008.8 RT
		STA. F2+038.8 RT
		STA. F2+068.8 RT

SIGN LEGEND

- R = REMOVE
- S = SALVAGE
- N = NEW
- RET = RETAIN
- B-B = BACK TO BACK
- EXISTING = - - - - -
- NEW = ————

SIGNING AND STRIPING PLAN

SURVEYED BY C.H.A. & V.S.E. DATE 12/93
 DESIGNED BY D.W.E. DATE 2/04
 DRAWN BY C.A.K. DATE 2/04
 CHECKED BY D.E.G. DATE 2/04

DESIGN FILE NO. SSP03.DGN

PROJ. NAME BENNINGTON - HOOSICK D.P.L. 0146(D) C/6
 PROJ. NO. P.I.N. 1306.60
 DWG NO. SSP-3 SHEET 43 OF 83

FILE NAME = ur\5116\sect\contract\6\ssp03.dgn
 DATE/TIME = 2/16/2004
 USER = 2225

DATUM

VERTICAL	NAVD 88
HORIZONTAL	NAD 83 (0992)

LEGEND

- TYPE I, WHITE
- TYPE I, AMBER
- TYPE II, WHITE

