



NOTE: UNLESS NOTED OTHERWISE, ALL STATIONS ARE IN KILOMETERS, ALL ELEVATIONS ARE IN METERS, AND ALL DIMENSIONS ARE IN MILLIMETERS.

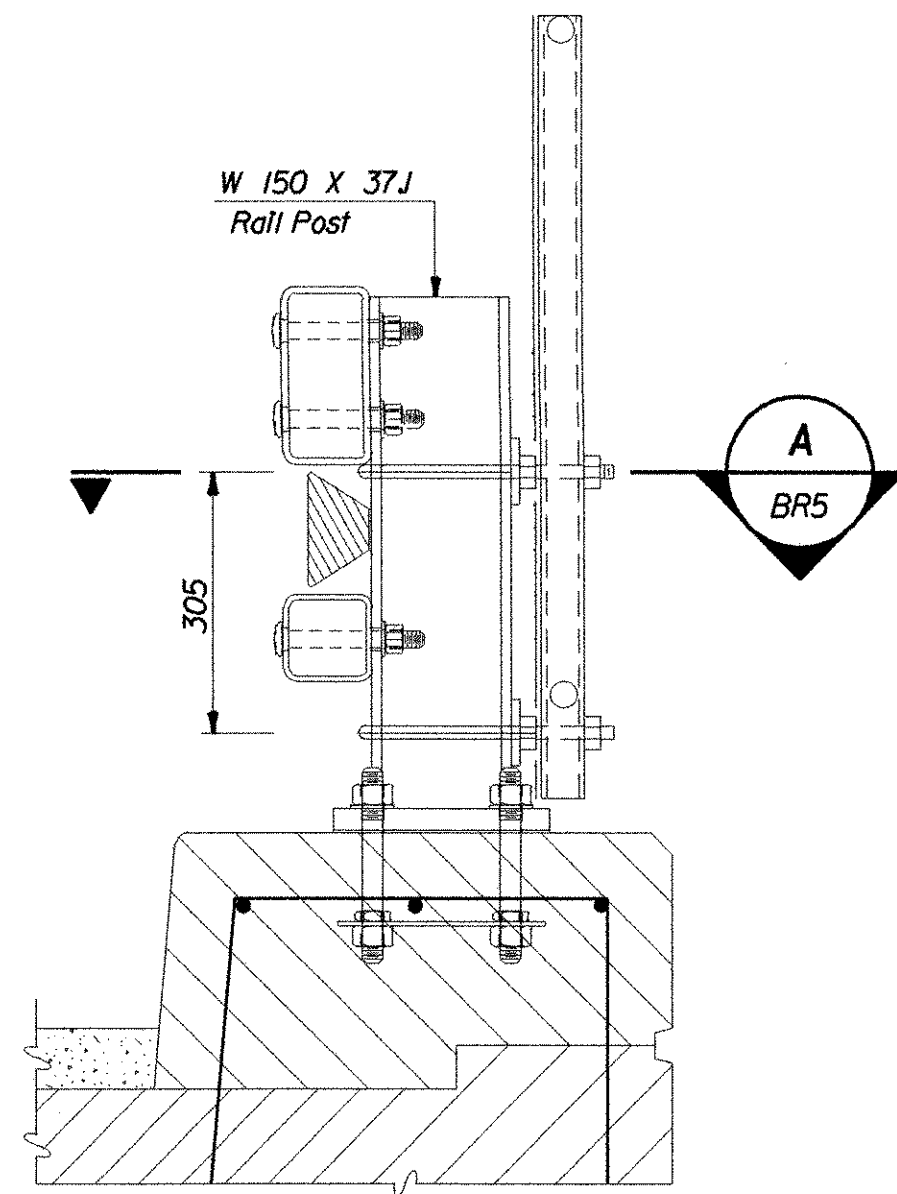


TYPICAL SECTION


NOTE: FOR DIMENSIONS SEE SHEETS BR2 AND BR4

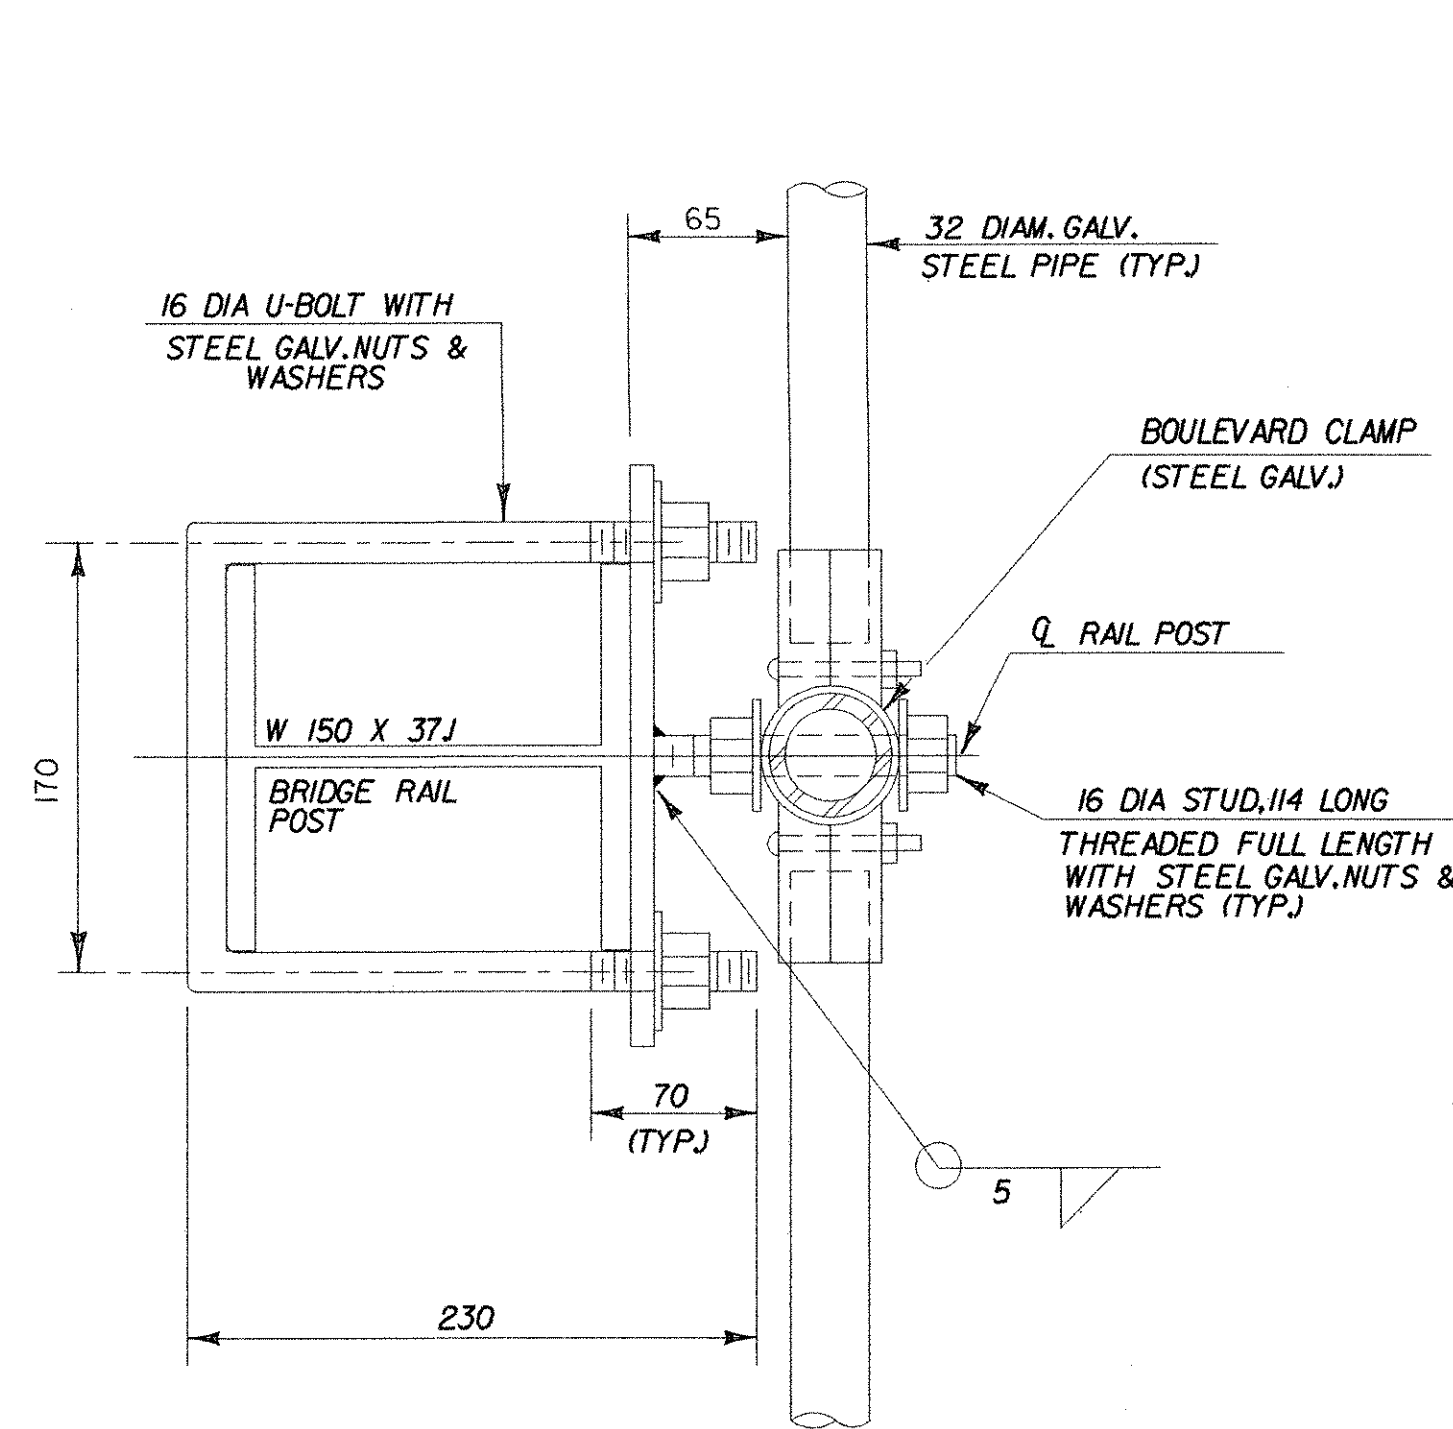


BRIDGE RAILPOST SECTION
BR5
N.T.S.

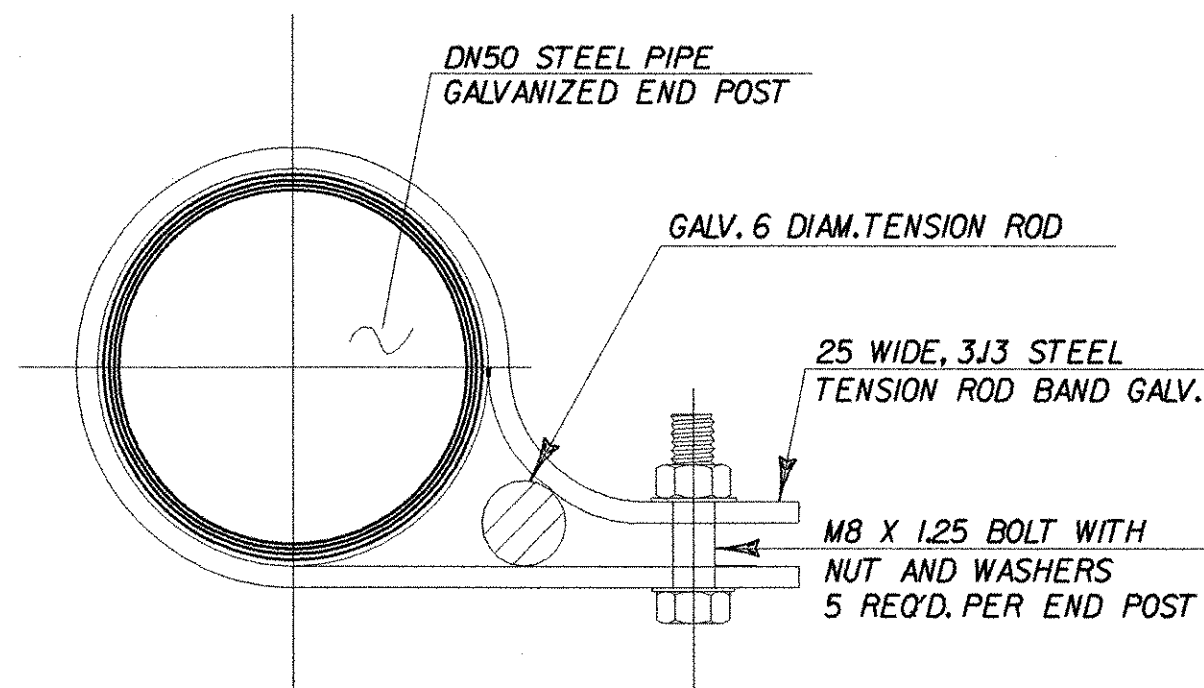


TENSION ROD BAND

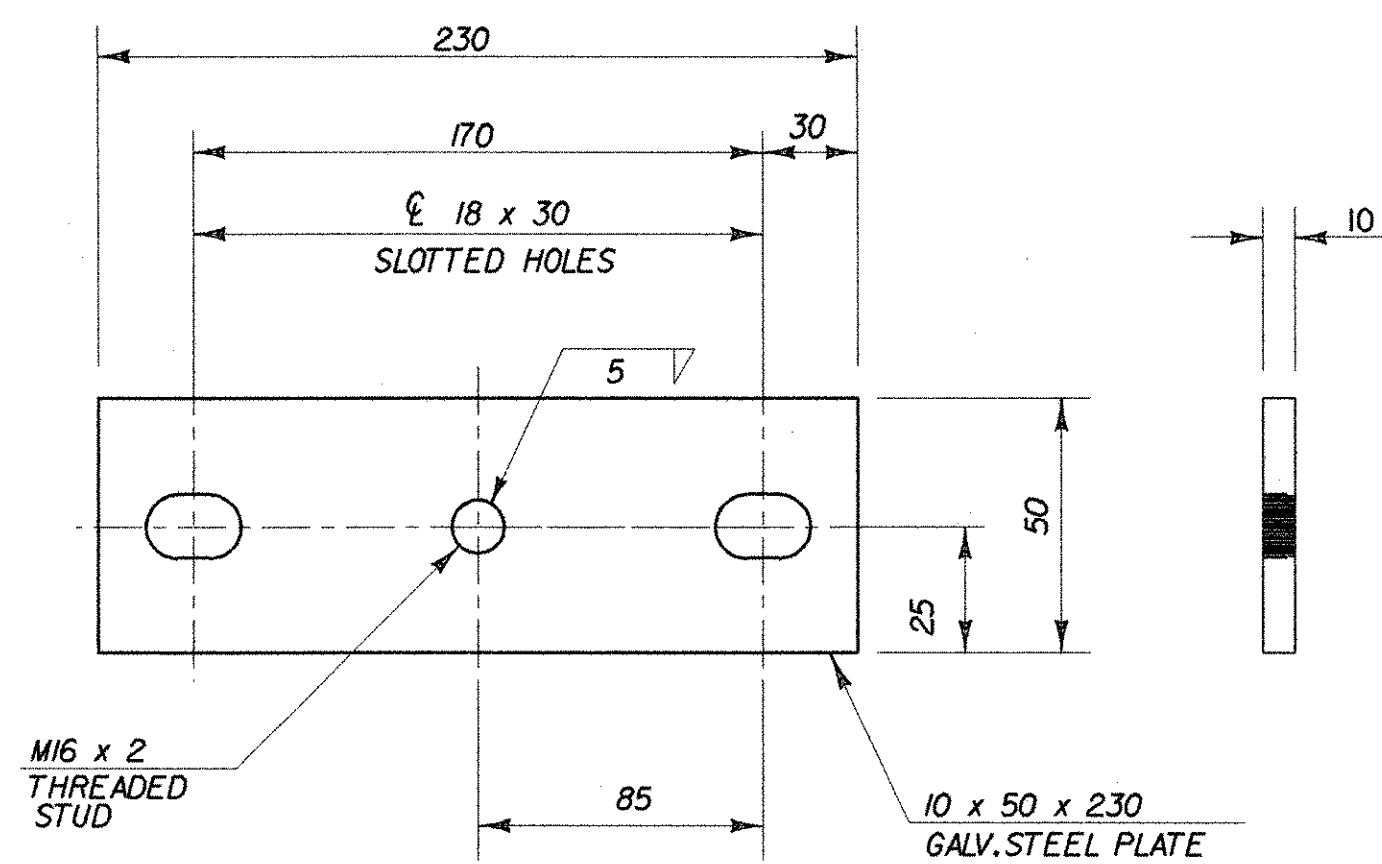


PLAN VIEW AT END POST

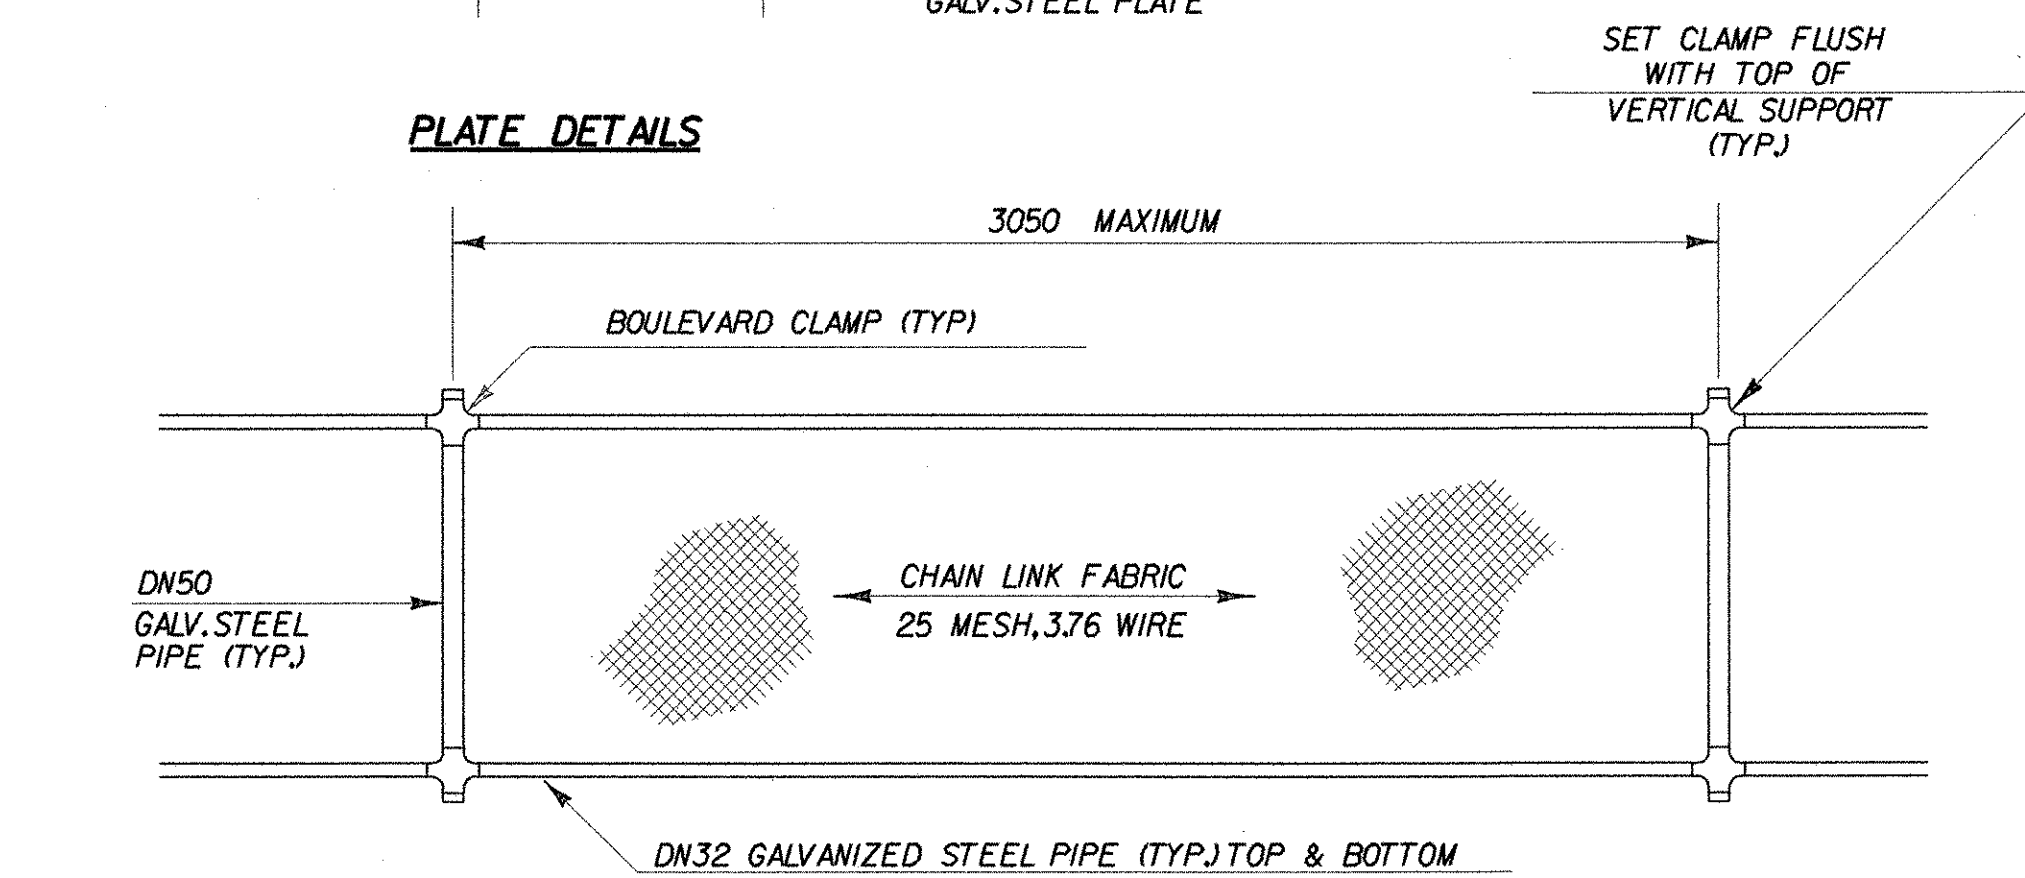

ELEVATION SNOW BARRIER

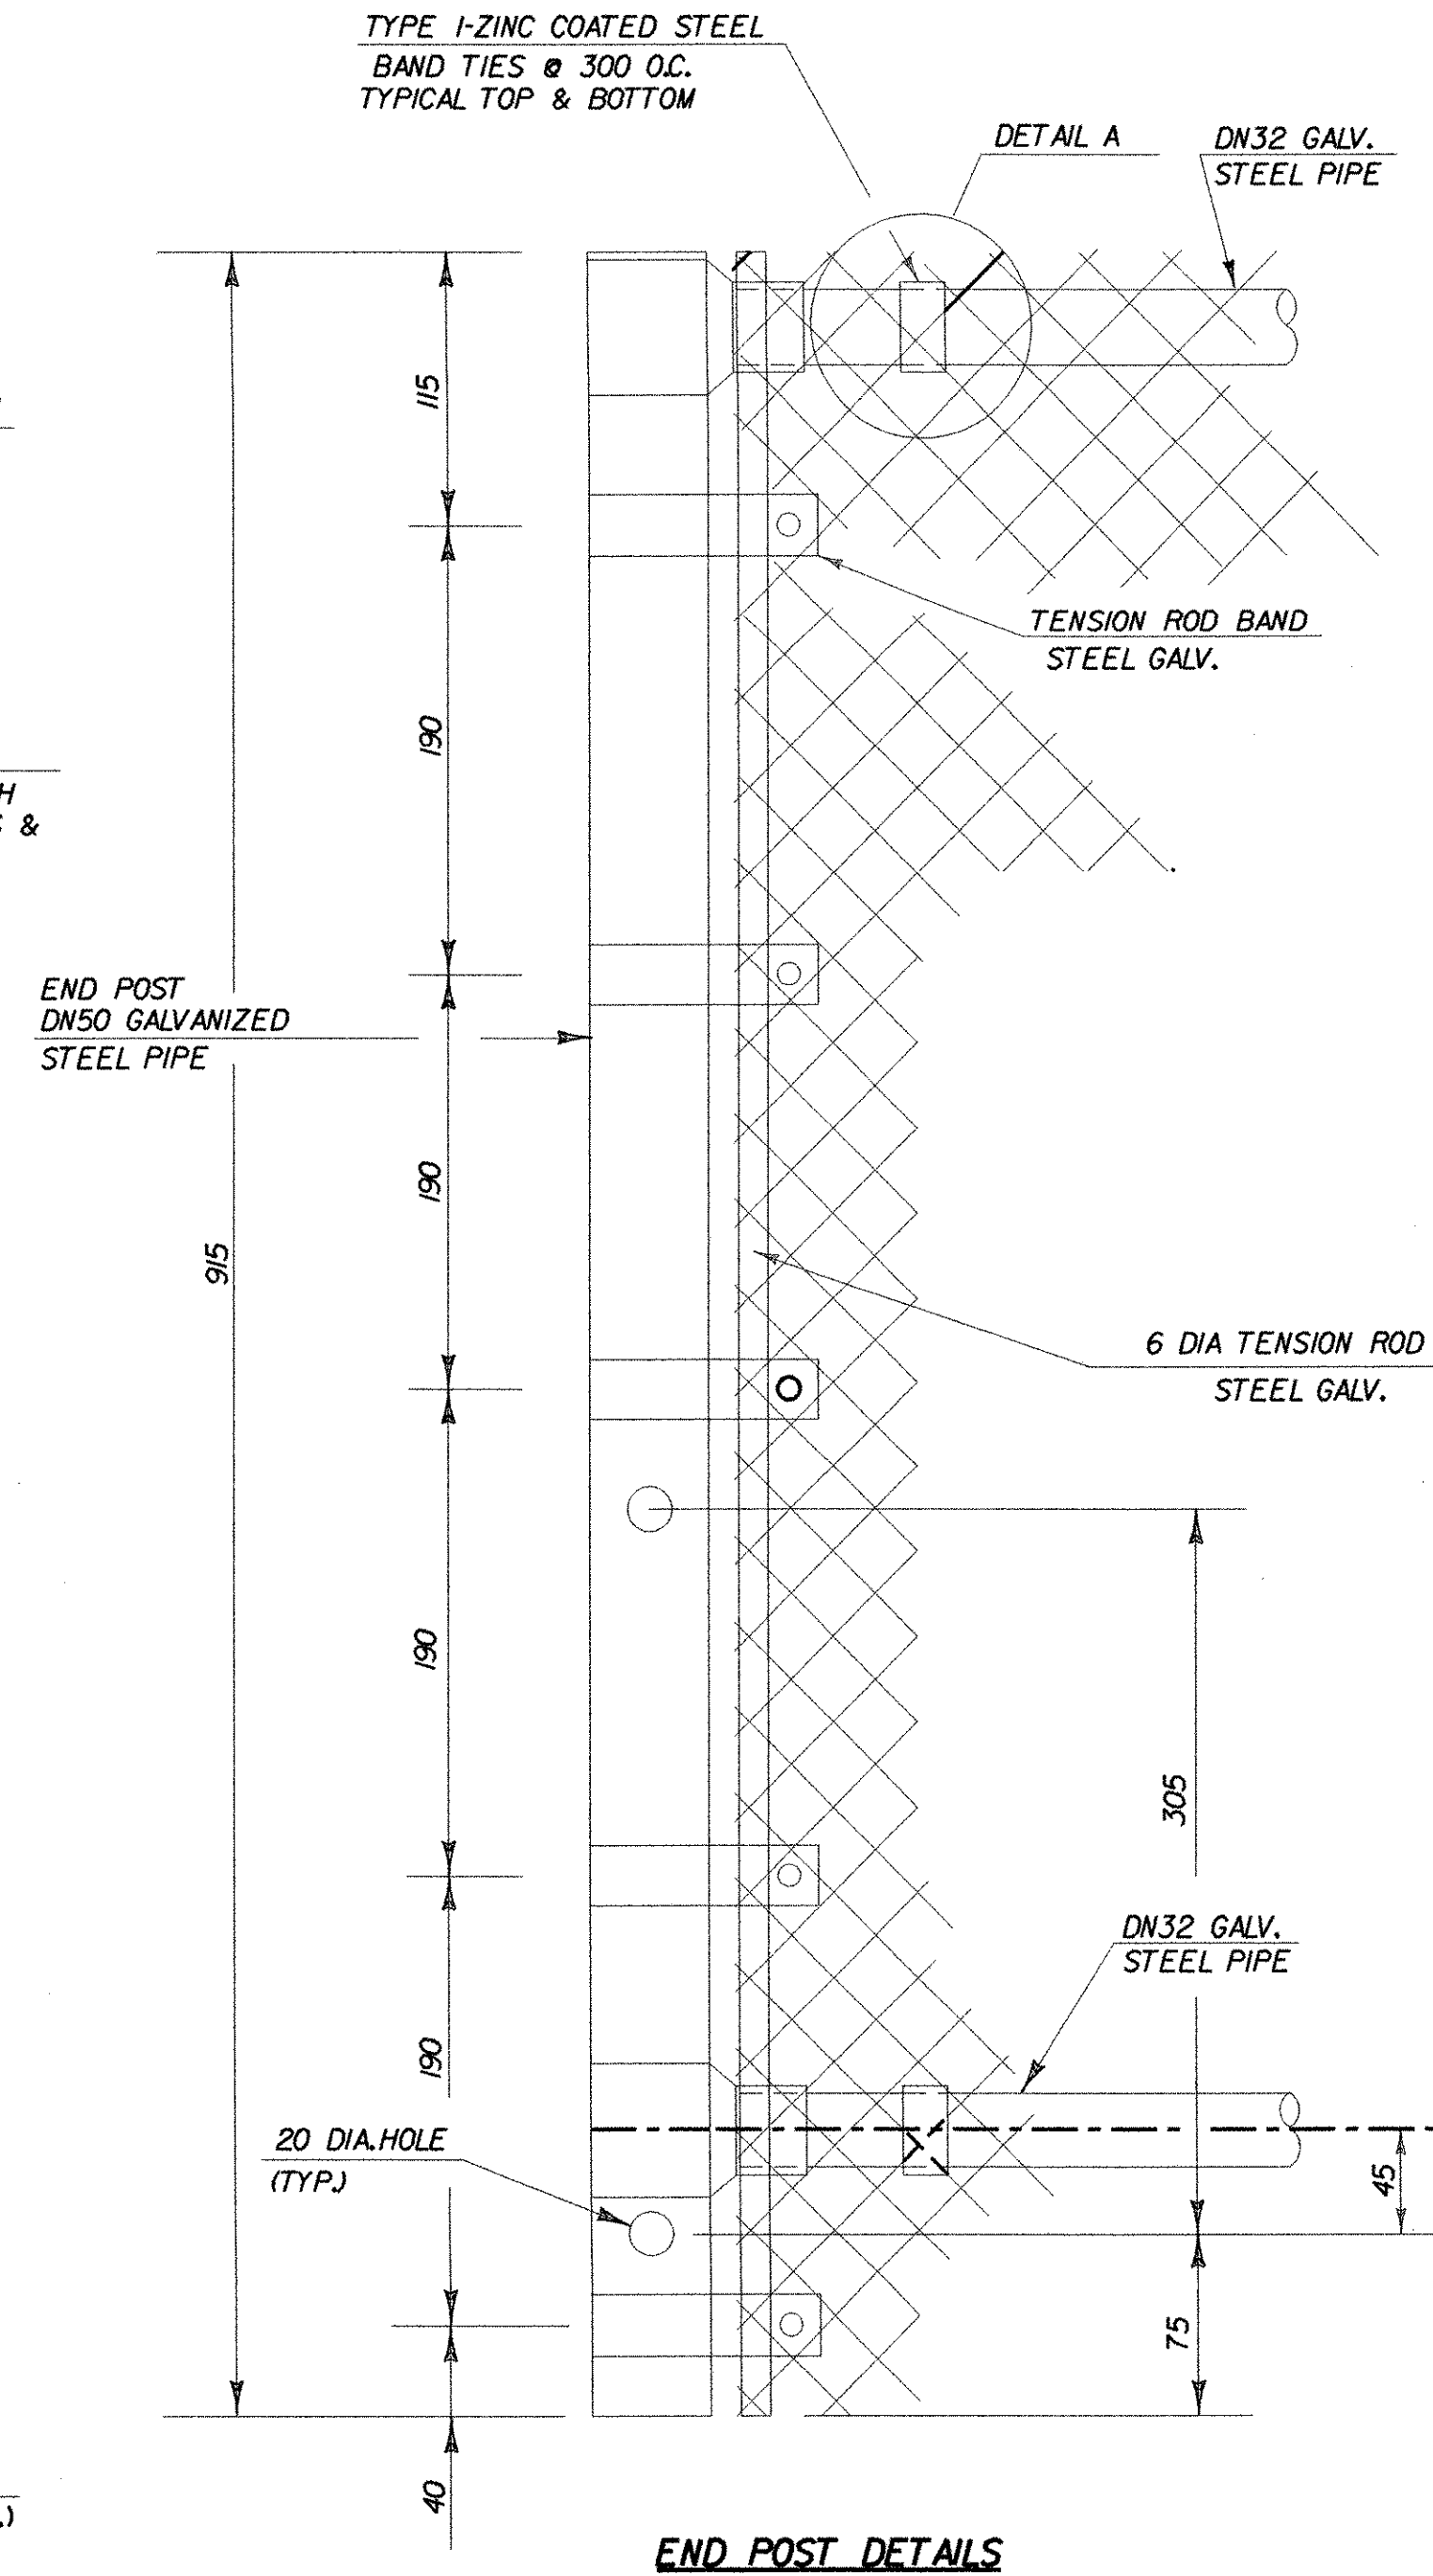


END POST DETAILS

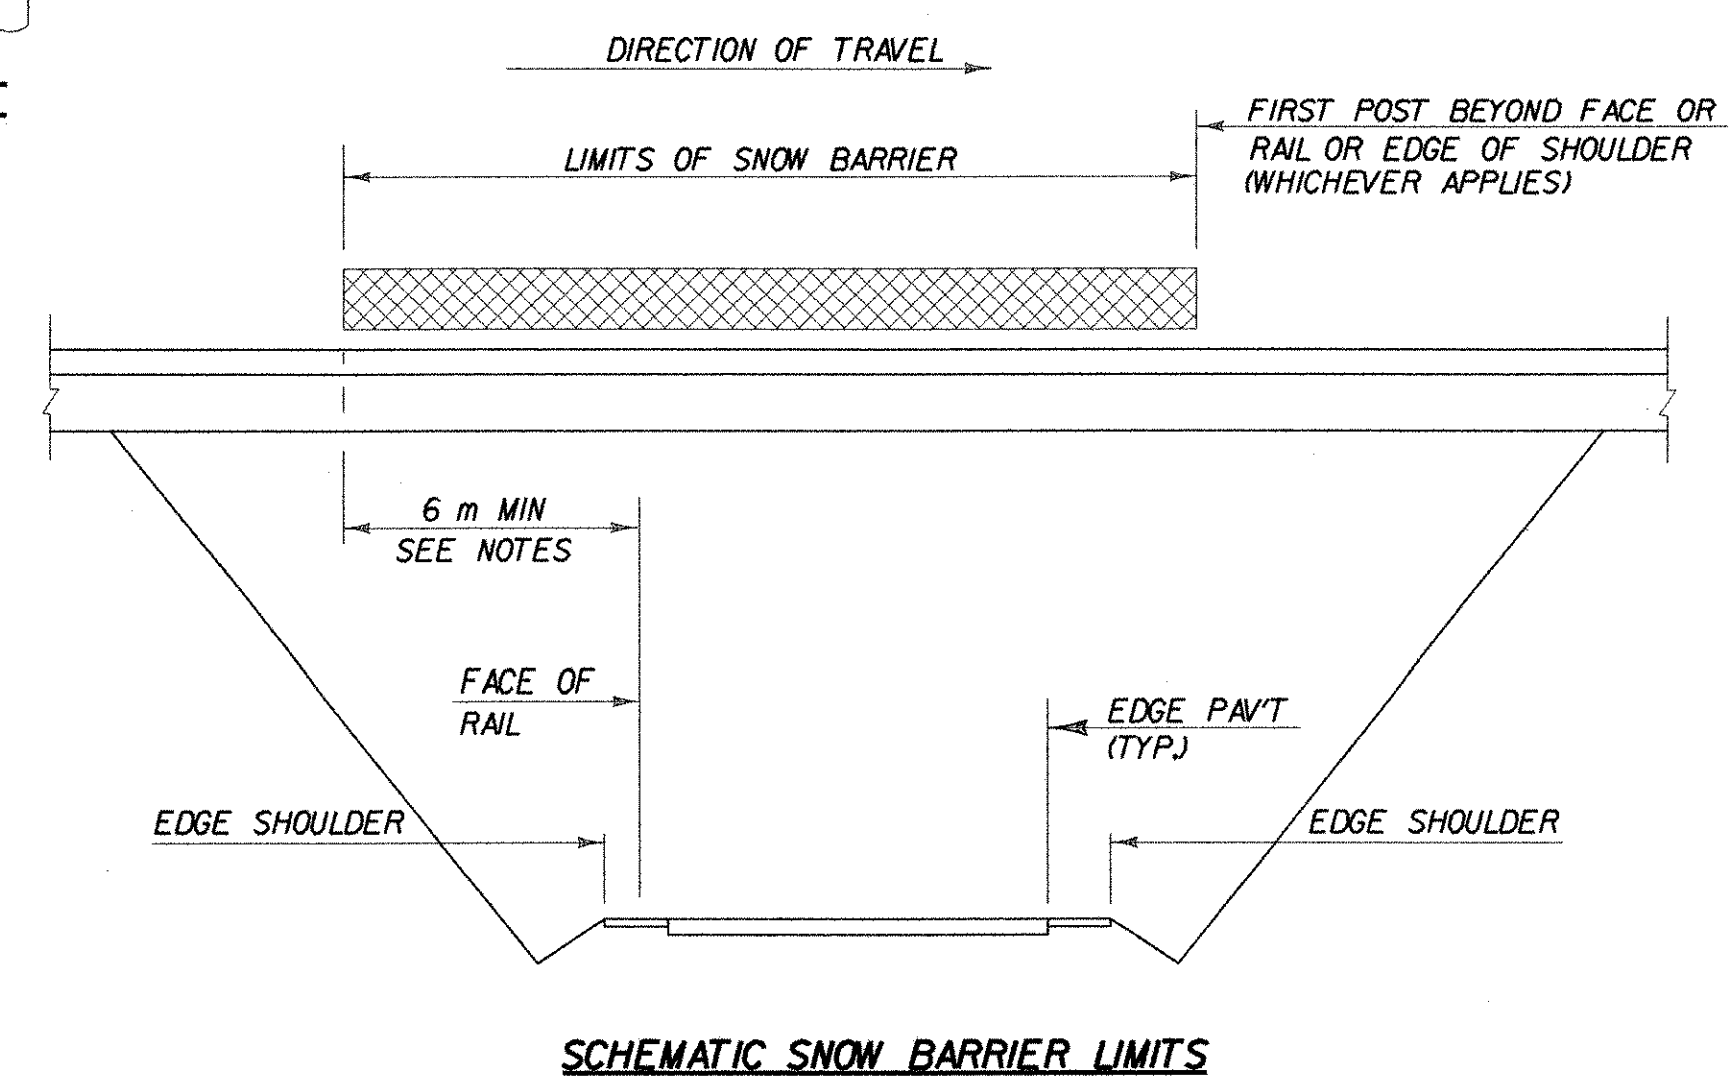

SCHEMATIC SNOW BARRIER LIMITS

NOTES

1. THREADS OF STUDS AND U-BOLTS TO BE M16 x 2.
2. ALL CONNECTION PLATES TO BE GALVANIZED AFTER FABRICATION.
3. DN 32 PIPE LENGTH SHALL BE FIELD CUT TO FIT POST SPACING.
4. CHAIN LINK FABRIC TO BE KNUCKLED TOP AND BOTTOM.
5. ALL BOLTS, THREADED STUDS AND WASHERS SHALL CONFORM TO THE SPECIFICATIONS FOR AASHTO M164M, TYPE 1. NUTS SHALL CONFORM TO AASHTO M291M.
6. ALL STEEL PLATES SHALL CONFORM TO THE SPECIFICATION FOR AASHTO M270/M270M, GRADE 250.
7. ALL GALVANIZING SHALL CONFORM TO THE REQUIREMENTS OF AASHTO M-181 WITH HARDWARE AND FITTINGS CONFORMING TO THE REQUIREMENTS OF AASHTO M-111 OR AASHTO M-232 WHICHEVER IS APPLICABLE. ALL BOLTS, NUTS AND WASHERS SHALL BE EITHER HOT-DIP GALVANIZED IN ACCORDANCE WITH THE ABOVE AASHTO REQUIREMENTS OR MECHANICALLY GALVANIZED USING A MECHANICALLY DEPOSITED PROCESS CONFORMING TO THE REQUIREMENTS OF AASHTO M-298, CLASS 110.
8. GALVANIZED CHAIN-LINK FABRIC SHALL BE TYPE 1 (ZINC) CLASS D AS SPECIFIED IN AASHTO M181.
9. SNOW BARRIER SHALL BEGIN AT THE BRIDGE RAIL POST WHICH WILL PROVIDE A MINIMUM DISTANCE OF 6 m (AS SHOWN) OR AS DIRECTED BY THE RESIDENT ENGINEER.
10. ALL DN (I.E. DIAMETER NOMINAL) REFERENCES TO GALVANIZED STEEL PIPE SHALL REFER TO THE NOMINAL PIPE SIZE.
11. ALL POSTS, RAILS AND HARDWARE SHALL BE ZINC COATED AND CONFORM TO THE REQUIREMENTS OF AASHTO M81, GRADE 1 OR GRADE 2.

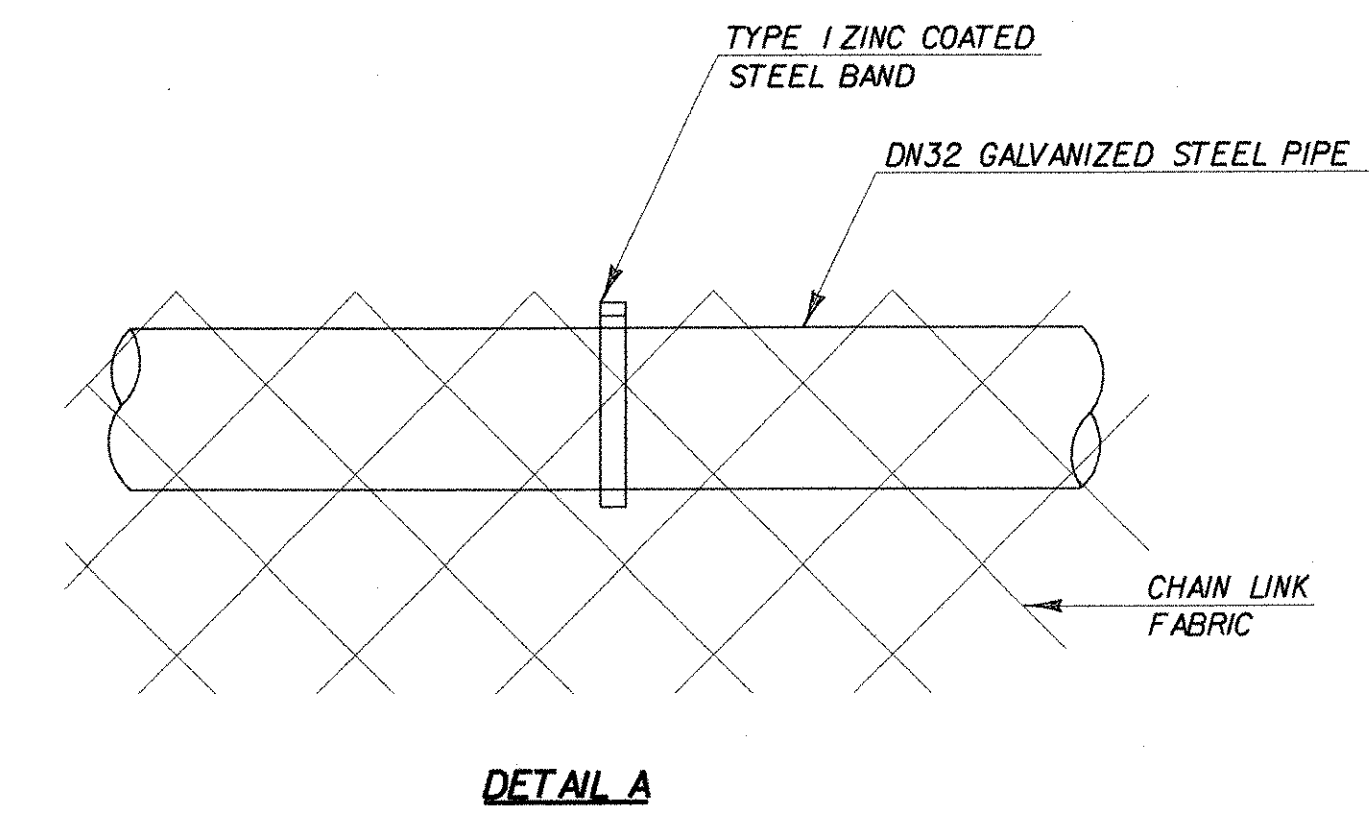

DETAIL A

STATE OF VERMONT
AGENCY OF TRANSPORTATION

Town of	BENNINGTON	Bridge No.	BR800 & BR200
Highway No.	VT. RTE. 279	Log Sta.	
		Surv. Sta.	17+853
VT. RTE. 279			
SNOW FENCE FOR BRIDGE RAILING - N.E.T.C. 2 RAIL			
Designed By	D. STECIAK	Drawn by	K. RAPELLO
Checked By	Date	Bridge Design Supervisor	
M. W. OLSTAD	02/04	M. W. OLSTAD	Date 02/04
PROJECT	BENNINGTON-HOOSICK	PROJECT NO.	D.P.I. 0146(1) C/6
I.G.C. Info.			
Bridge Sheet No.	BR5	Sheet	61 OF 83

FILE NAME = ur\12502\mstn\final\7a\brg\brgsdsh2.dgn
DATE/TIME = 2/17/2004
USER = 2225