


INDEX OF SHEETS

- TITLE SHEET
- L1 QUANTITY SHEET
- L2 PLANT LIST
- L3 PLANTING DETAIL SHEET
- L4 LANDSCAPE PLAN STA 13+820 TO STA 14+160
- L5 LANDSCAPE PLAN STA 14+160 TO STA 14+500
- L6 LANDSCAPE PLAN STA 14+840 TO STA 15+200
- L7 LANDSCAPE PLAN STA 15+200 TO STA 15+560
- L8 LANDSCAPE PLAN STA 16+580 TO STA 16+960
- L9 LANDSCAPE PLAN STA 16+960 TO RAMP A & B
- L10 LANDSCAPE PLAN STA 17+060 TO RAMP C & D
- L11 PLANTING SUMMARY SHEET
- L12 PLANTING SUMMARY SHEET

STATE OF VERMONT
AGENCY OF TRANSPORTATION



PROPOSED IMPROVEMENT
TOWN OF BENNINGTON
COUNTY OF BENNINGTON
LANDSCAPE PLANS FOR
BENNINGTON-HOOSICK D.P.I. 0146(1) C/73

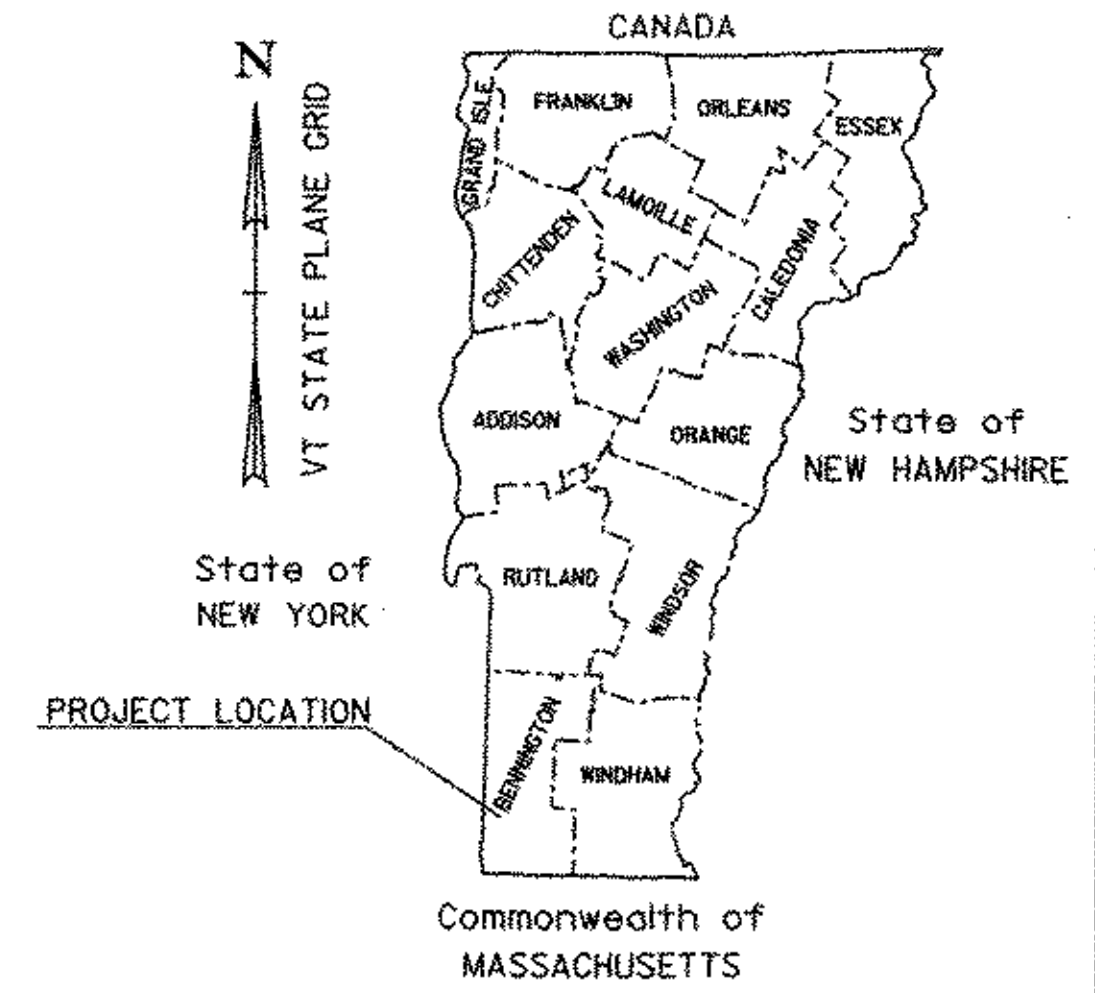


PROJECT DESCRIPTION PLANTING PLAN FOR THE VERMONT PORTION OF THE BENNINGTON BYPASS, BENNINGTON - HOOSICK D.P.I. 0146(1) CONTRACT 7 INCLUDING PLANTING OF TREES, SHRUBS AND OTHER LANDSCAPE MATERIALS, SEEDING, RESEEDING AND STREAMBANK RESTORATION PLANTING.

PROJECT LOCATION VERMONT ROUTE 279, NEW YORK/VERMONT STATE BORDER (STA 12+130.455) PROCEEDING EASTERLY TO THE INTERSECTION OF VERMONT STATE ROUTE 67A (STA 17+300) AND RAMP A & CD. PROJECT LENGTH IS 5.17 KILOMETERS (3.2 MILES).

*part 2!
THIS CONTRACT WAS ADDED TO CONTRACT 73
BY CHANGE OF DESIGN #7. (JPM 2/10/04)*

PROJECT LOCATION

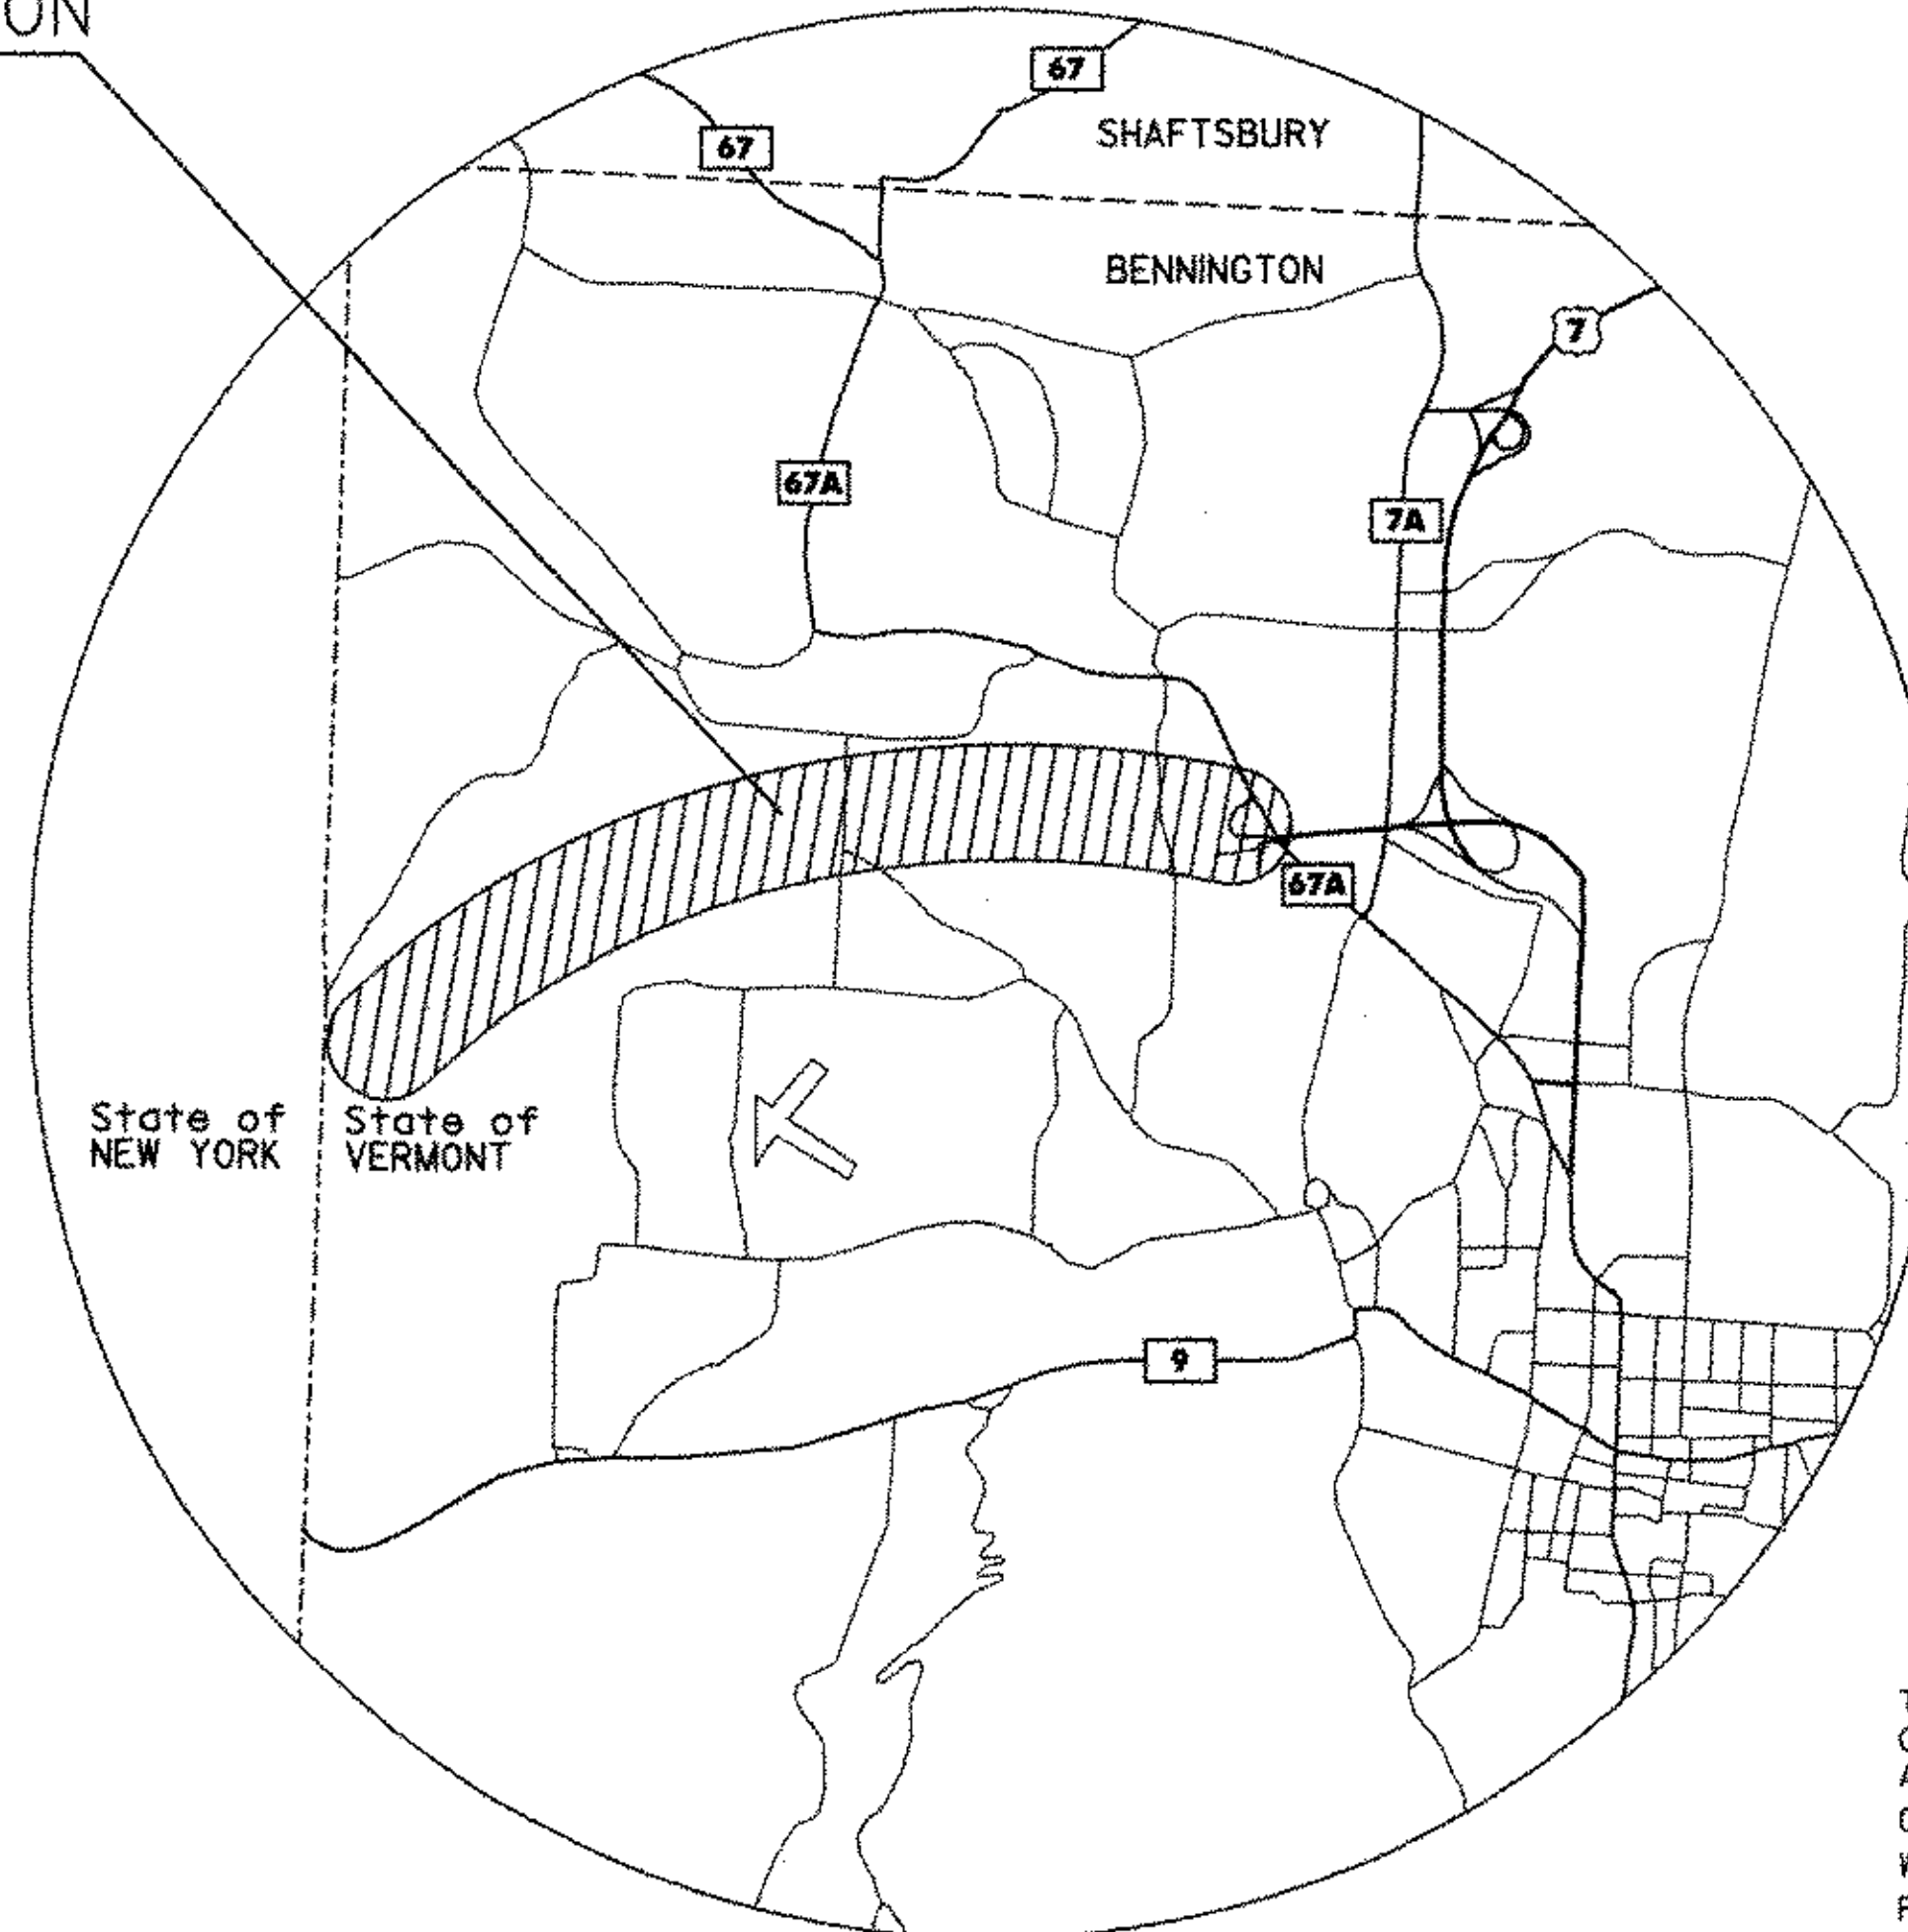

CONVENTIONAL SIGNS

COUNTY LINE	---
TOWN LINE	- - - -
LIMITS OF ACCESS	—○—○—
POINT OF ACCESS	X
FENCE LINE	-x-x-
STONE WALL	o-o-o-o-o
TRAVELED WAY	—○—○—
GUARD RAIL	—○—○—
RAILROAD	—+—+—
SURVEY LINE	—+—+—
CULVERT	—+—+—
POWER POLE	□
TELEPHONE POLE	○
TREES	⊗ ⊛
CONTROL OF ACCESS	—+—+—
PROPERTY LINE	—+—+—
R.O.W. TAKING LINE	—+—+—
SLOPE RIGHTS	—+—+—
TOP OF CUT	—+—+—
TOE OF SLOPE	—+—+—

DATUM

VERTICAL	_____
HORIZONTAL	_____

PLANS PREPARED BY:



RECORD PLANS

CONTRACTOR: KUBRICKY CONSTRUCTION CORP. - GLENS FALLS, NY

RESIDENT ENGINEER: RON LEMAIRE

CONSTRUCTION BEGAN: MAY 3, 2002

CONSTRUCTION COMPLETE: MAY 11, 2005

RECORD PLANS BY: RON LEMAIRE & JUDY GILMORE

I HEREBY CERTIFY THAT ALL THE CONSTRUCTION REQUIRED BY THIS SET OF DRAWINGS HAS BEEN ACCOMPLISHED AS INDICATED HEREIN.

BY *Ron Lemaire* RESIDENT ENGINEER

DATE 04/17/07

NOTE: Any further information concerning final quantities, amounts or other details relative to this project may be found at Central Files in the electronic archives.

**CONTRACT PLANS
MARCH 10, 2004**

UNLESS OTHERWISE NOTED ALL DRAWINGS AND DETAILS ON THESE PLANS ARE DRAWN "NOT TO SCALE"



THESE PLANS ARE SUBJECT TO SUCH ENGINEERING CHANGES AS MAY BE REQUIRED BY THE FEDERAL HIGHWAY ADMINISTRATION OR THE CHIEF ENGINEER. CONSTRUCTION IS TO BE CARRIED ON IN ACCORDANCE WITH THESE PLANS AND THE STANDARD SPECIFICATIONS FOR CONSTRUCTION DATED 2001, AS APPROVED BY THE FEDERAL HIGHWAY ADMINISTRATION ON JANUARY 4, 2001 FOR USE ON THIS PROJECT, INCLUDING ALL SUBSEQUENT REVISIONS AND SUCH REVISED SPECIFICATIONS AND SPECIAL PROVISIONS AS ARE INCORPORATED IN THESE PLANS.

APPROVED *[Signature]* DATE 3/10/04
DIRECTOR OF PROGRAM DEVELOPMENT

DEPARTMENT OF TRANSPORTATION
FEDERAL HIGHWAY ADMINISTRATION

APPROVED _____ DATE _____
DIVISION ADMINISTRATOR

PROJECT BENNINGTON-HOOSICK
D.P.I. 0146 (1) C/73

SHEET 1 OF 13 SHEETS