

950 SM WILDFLOWER MIX BY VAOT, STA 14+330 TO STA 14+500 (1:4 SLOPE) CONTRACTOR TO PROVIDE TOPSOIL TO A MINIMUM DEPTH OF 100. CONTRACTOR SHALL NOTIFY THE STATE WITHIN 48 HRS IN ADVANCE OF PLACING TOPSOIL AND SEED WITH 'RURAL CONSERVATION MIX' IF STATE WORK CREWS CANNOT PLANT WILDFLOWERS IN A TIMELY MANNER TO PREVENT SOIL EROSION.

NOTE:


1. PRECISE LOCATION OF WOODY PLANTINGS IN STREAMBANK RESTORATION AREA (STA 14+080 TO 14+200) TO BE DETERMINED IN THE FIELD AS DIRECTED BY THE RESIDENT ENGINEER IN CONSULTATION WITH VAOT'S FIELD NATURALIST AT THE TIME OF PLANTING, AND IN RESPONSE TO THE ACTUAL FIELD CONDITIONS AT THAT TIME.
2. STREAMBANK RESTORATION SEEDING WILL OCCUR AS NEEDED TO STABILIZE AREAS CURRENTLY UNDER CONSTRUCTION.

LEGEND

AMC.01 (9)	DECIDUOUS SHRUB GROUPING WITH PLANT TYPE AND (QUANTITY)		EXISTING DECIDUOUS TREE
AR.01 (3)	DECIDUOUS TREE GROUPING WITH PLANT TYPE AND (QUANTITY)		EXISTING EVERGREEN TREE
AC.01 (4)	EVERGREEN TREE GROUPING WITH PLANT TYPE AND (QUANTITY)		TOE OF SLOPE
	WILDFLOWER MIX - PLANTED BY VAOT		LIMIT OF CUT
	NORTHEAST WETLAND GRASS SEED MIX / STREAMBANK RESTORATION AREA		TREELINE
			PROPERTY LINE
			R.O.W.
			R.O.W. FENCE

DATUM

VERTICAL	NAVD 88
HORIZONTAL	NAD 83 (1992)

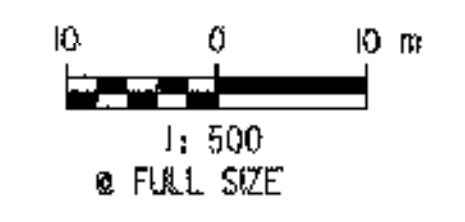

CONTRACT PLANS

JFW 2/4/06
*TREE'S WERE MOVED TO DR. WOLF'S PROPERTY ON SILK ROAD

LANDSCAPE PLAN

SURVEYED BY	C.H.A. & V.S.E.	DATE	12/93
DESIGNED BY	J.A.S./C.W.B.	DATE	01/04
DRAWN BY	K.R.K.	DATE	2/26/04
CHECKED BY	J.A.S.	DATE	2/26/04

DESIGN FILE NO.	R13464-PROJECT.dgn
PROJ. NAME	BENNINGTON - HOOSICK D.P.L 04601C/7
DWG. NO. L5	SHEET 6 OF 13