

NORTHEAST WETLAND GRASS SEED MIX

MATCH LINE STA. 16+960,000 DWG. L7

WALLOOMSAK RIVER

VT. ROUTE 279

VT. ROUTE 67A

130 VTC.01H MEDIAN RAMP AB STA ABIO+065 TO STA ABIO+196.5 SEE DETAIL SHEET L2

UNDISTURBED WOODED AREA

MATCH TO SHEET DWG. L9

LEGEND

- | | | | |
|------------|---|--|-------------------------------|
| AMC.01 (9) | DECIDUOUS SHRUB GROUPING WITH PLANT TYPE AND QUANTITY | | EXISTING DECIDUOUS TREE |
| AR.01 (3) | DECIDUOUS TREE GROUPING WITH PLANT TYPE AND QUANTITY | | EXISTING EVERGREEN TREE |
| AC.01 (4) | EVERGREEN TREE GROUPING WITH PLANT TYPE AND QUANTITY | | TOE OF SLOPE |
| | WILDFLOWER MIX PLANTING BY VAOT | | LIMIT OF CUT |
| | NORTHEAST WETLAND GRASS SEED MIX./ STREAMBANK RESTORATION AREA SEE NOTE 2, THIS SHEET | | TREELINE |
| | | | R.O.W. |
| | | | R.O.W. FENCE |
| | | | VAOT'S LOW GROWING FESCUE MIX |
| | | | MEDIAN PLANTING |


NOTES:

- PRECISE LOCATION OF WOODY PLANTINGS IN STREAMBANK RESTORATION AREA (STA 16+800 TO 17+000) TO BE DETERMINED IN THE FIELD AS DIRECTED BY THE RESIDENT ENGINEER IN CONSULTATION WITH VAOT'S FIELD NATURALIST AT THE TIME OF PLANTING, AND IN RESPONSE TO THE ACTUAL FIELD CONDITIONS AT THAT TIME.
- ENTIRE AREA WITHIN LIMITS OF CONSTRUCTION FOR THE STREAMBANK RESTORATION AREA (STA 16+800 TO 17+000) HAS BEEN SEEDED WITH NORTHEAST WETLAND GRASS SEED MIX AND MULCHED WITH STRAW (NOT HAY). NO FURTHER SEEDING REQUIRED UNLESS THE SEEDED AREA IS DISTURBED BY THE CONTRACTOR.

CONTRACT PLANS

DATUM

| | |
|------------|---------------|
| VERTICAL | NAVD 88 |
| HORIZONTAL | NAD 83 (1992) |

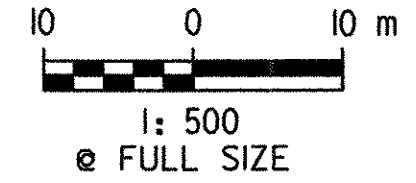

LANDSCAPE PLAN

| | | | |
|-----------------|---------------------------------------|------|---------|
| SURVEYED BY | C.H.A. & V.S.E. | DATE | 12/93 |
| DESIGNED BY | J.A.S./C.W.B. | DATE | 1/04 |
| DRAWN BY | J.S.L. | DATE | 2/26/04 |
| CHECKED BY | T.P.K. | DATE | 2/26/04 |
| DESIGN FILE NO. | R13464-PROJECT.dgn | | |
| PROJ. NAME | BENNINGTON - HOOSICK D.P.I. 0146(1C/7 | | |
| DWG. NO. L9 | SHEET 10 OF 13 | | |