


EMBANKMENT PLANTING (SEE LANDSCAPE DETAIL & TYPICAL SHEETS)  
 STA 113+50 TO 114+50 LT (4 BPO-TR, 4 FA-TR, 4 QR-TR, 8 PT-TR, 36 CS, 36 SP, & 44 CA)

DECIDUOUS TREES-MOD (SEE LANDSCAPE DETAIL & TYPICAL SHEETS)  
 STA 113+25 TO 114+25 RT (3FP)  
 STA 120+75 TO 121+25 LT (3FP)

SHRUB BED (SEE LANDSCAPE DETAIL & TYPICAL SHEETS)  
 STA 120+50 TO 122+00 LT (20 AI & 100 RT)

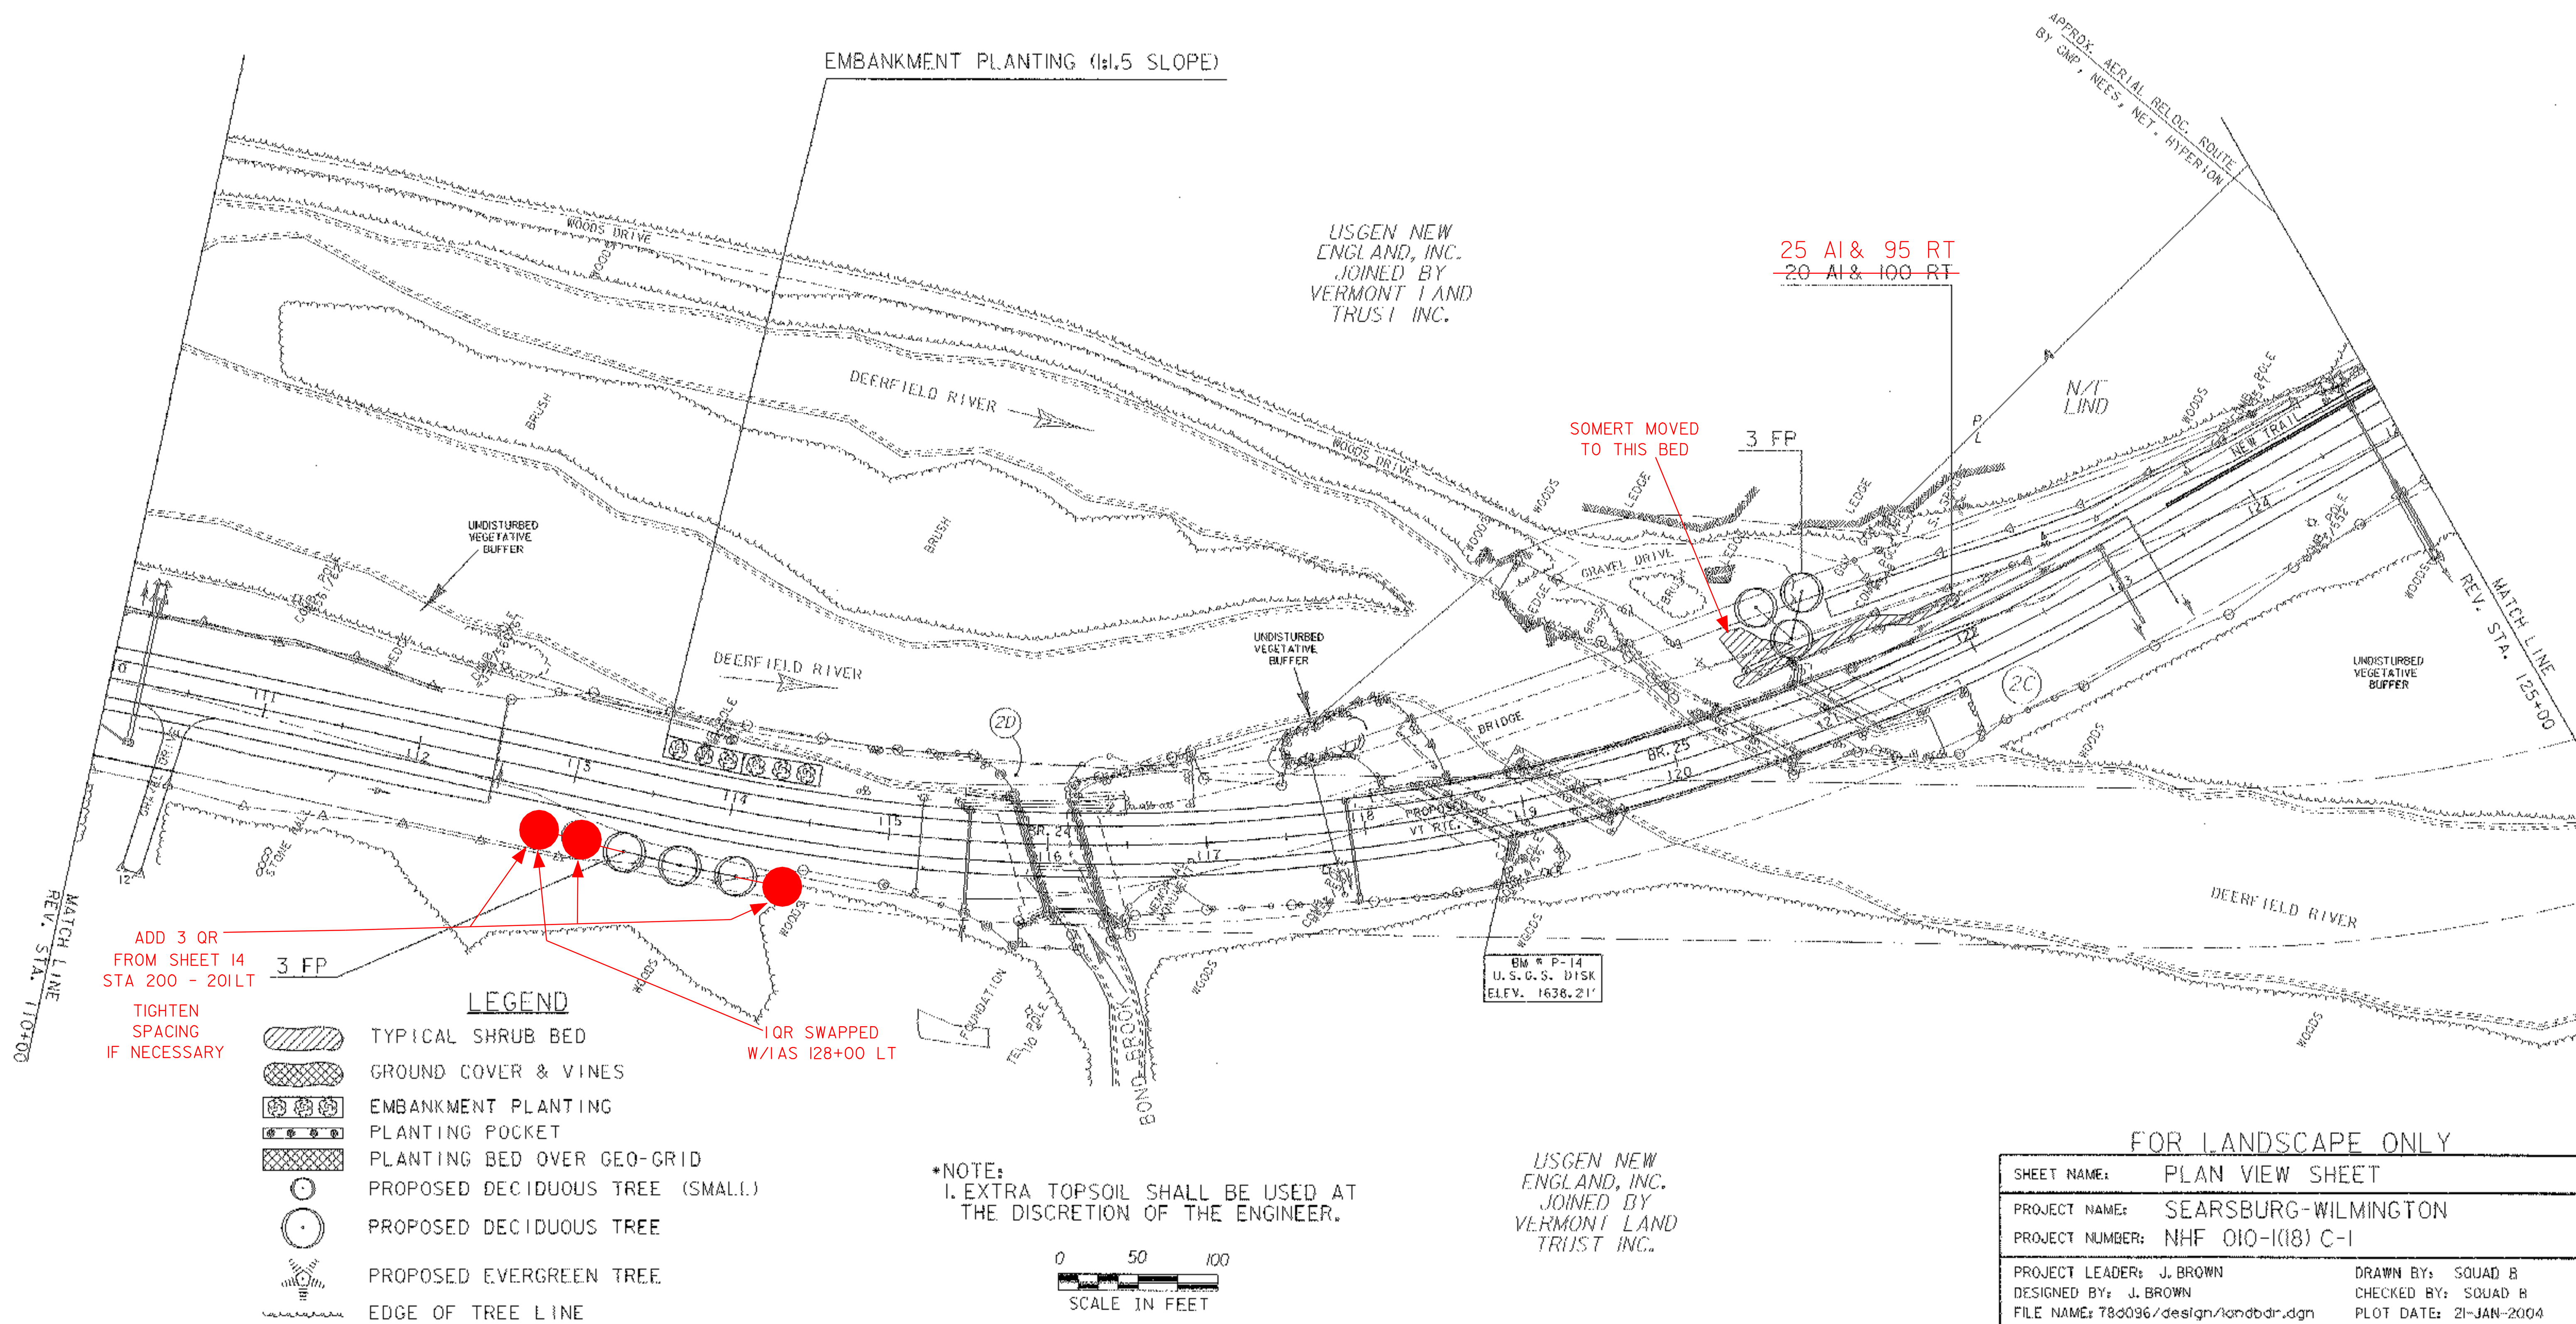

USGEN NEW ENGLAND, INC.  
 JOINED BY  
 VERMONT LAND TRUST INC.

25 AI & 95 RT  
~~20 AI & 100 RT~~

SOMERT MOVED TO THIS BED

3 FP


ADD 3 QR  
 FROM SHEET 14  
 STA 200 - 201LT

TIGHTEN  
 SPACING  
 IF NECESSARY

- LEGEND**
- TYPICAL SHRUB BED
  - GROUND COVER & VINES
  - EMBANKMENT PLANTING
  - PLANTING POCKET
  - PLANTING BED OVER GEO-GRID
  - PROPOSED DECIDUOUS TREE (SMALL)
  - PROPOSED DECIDUOUS TREE
  - PROPOSED EVERGREEN TREE
  - EDGE OF TREE LINE

1 QR SWAPPED  
 W/IAS 128+00 LT

\*NOTE:  
 1. EXTRA TOPSOIL SHALL BE USED AT  
 THE DISCRETION OF THE ENGINEER.

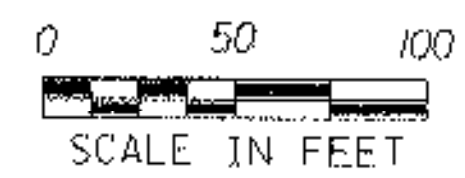

USGEN NEW ENGLAND, INC.  
 JOINED BY  
 VERMONT LAND TRUST INC.

FOR LANDSCAPE ONLY	
SHEET NAME:	PLAN VIEW SHEET
PROJECT NAME:	SEARSBURG-WILMINGTON
PROJECT NUMBER:	NHF 010-1(18) C-1
PROJECT LEADER:	J. BROWN
DESIGNED BY:	J. BROWN
FILE NAME:	78-0096/design/landbdr.dgn
IPARM FILE NAME:	land02J
DRAWN BY:	SQUAD B
CHECKED BY:	SQUAD B
PLOT DATE:	21-JAN-2004
SHEET	8 OF 30