

ADD 1QR FROM SHEET 15 STA 206 LT

1QR FROM 216+00 RT (SUB FP)

1QR FROM 216+00 RT (AA SUB)

20 BPO-TR

40 RT MOVED TO 140+00 LT

80 RT SHIFT GROUP TO TOP OF SLOPE AS STAKED

25 CS 10 CA

10 BPO-TR, 10 AI  
10 CS, & 10 CA

20 BPO-TR


**DECIDUOUS TREES-MOD (SEE LANDSCAPE DETAIL & TYPICAL SHEETS)**

- STA 127+50 TO 128+25 LT (3 FP)
- STA 128+25 TO 128+50 LT (2 AS)
- STA 128+75 TO 129+50 LT (7 OR)
- STA 133+50 TO 134+00 LT (20 BPO-TR)
- STA 133+50 TO 134+50 RT (20 BPO-TR)

**SHRUB BED (SEE LANDSCAPE DETAIL & TYPICAL SHEETS)**

- STA 128+25 TO 128+75 LT (80 RT)
- STA 135+00 TO 135+50 LT (40 RT)
- STA 130+25 TO 130+75 RT (40 CS)
- STA 131+00 TO 131+50 RT (10 BPO-TR, 10 AI, 10 CS, & 10 CA)

\*NOTE:  
1. EXTRA TOPSOIL SHALL BE USED AT THE DISCRETION OF THE ENGINEER.

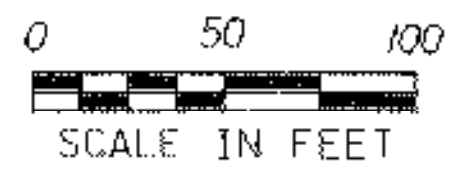

**LEGEND**

- TYPICAL SHRUB BED
- GROUND COVER & VINES
- EMBANKMENT PLANTING
- PLANTING POCKET
- PLANTING BED OVER GEO-GRID
- PROPOSED DECIDUOUS TREE (SMALL)
- PROPOSED DECIDUOUS TREE
- PROPOSED EVERGREEN TREE
- EDGE OF TREE LINE

USGEN NEW ENGLAND, INC. JOINED BY VERMONT LAND TRUST INC.

**FOR LANDSCAPE ONLY**

SHEET NAME:	PLAN VIEW SHEET
PROJECT NAME:	SEARSBURG-WILMINGTON
PROJECT NUMBER:	NHF 010-1(18) C-1
PROJECT LEADER:	J. BROWN
DESIGNED BY:	J. BROWN
FILE NAME:	78d096/design/landbdr.dgn
WARM FILE NAME:	land03.j
DRAWN BY:	SQUAD B
CHECKED BY:	SQUAD B
PLOT DATE:	21-JAN-2004
SHEET	9 OF 30