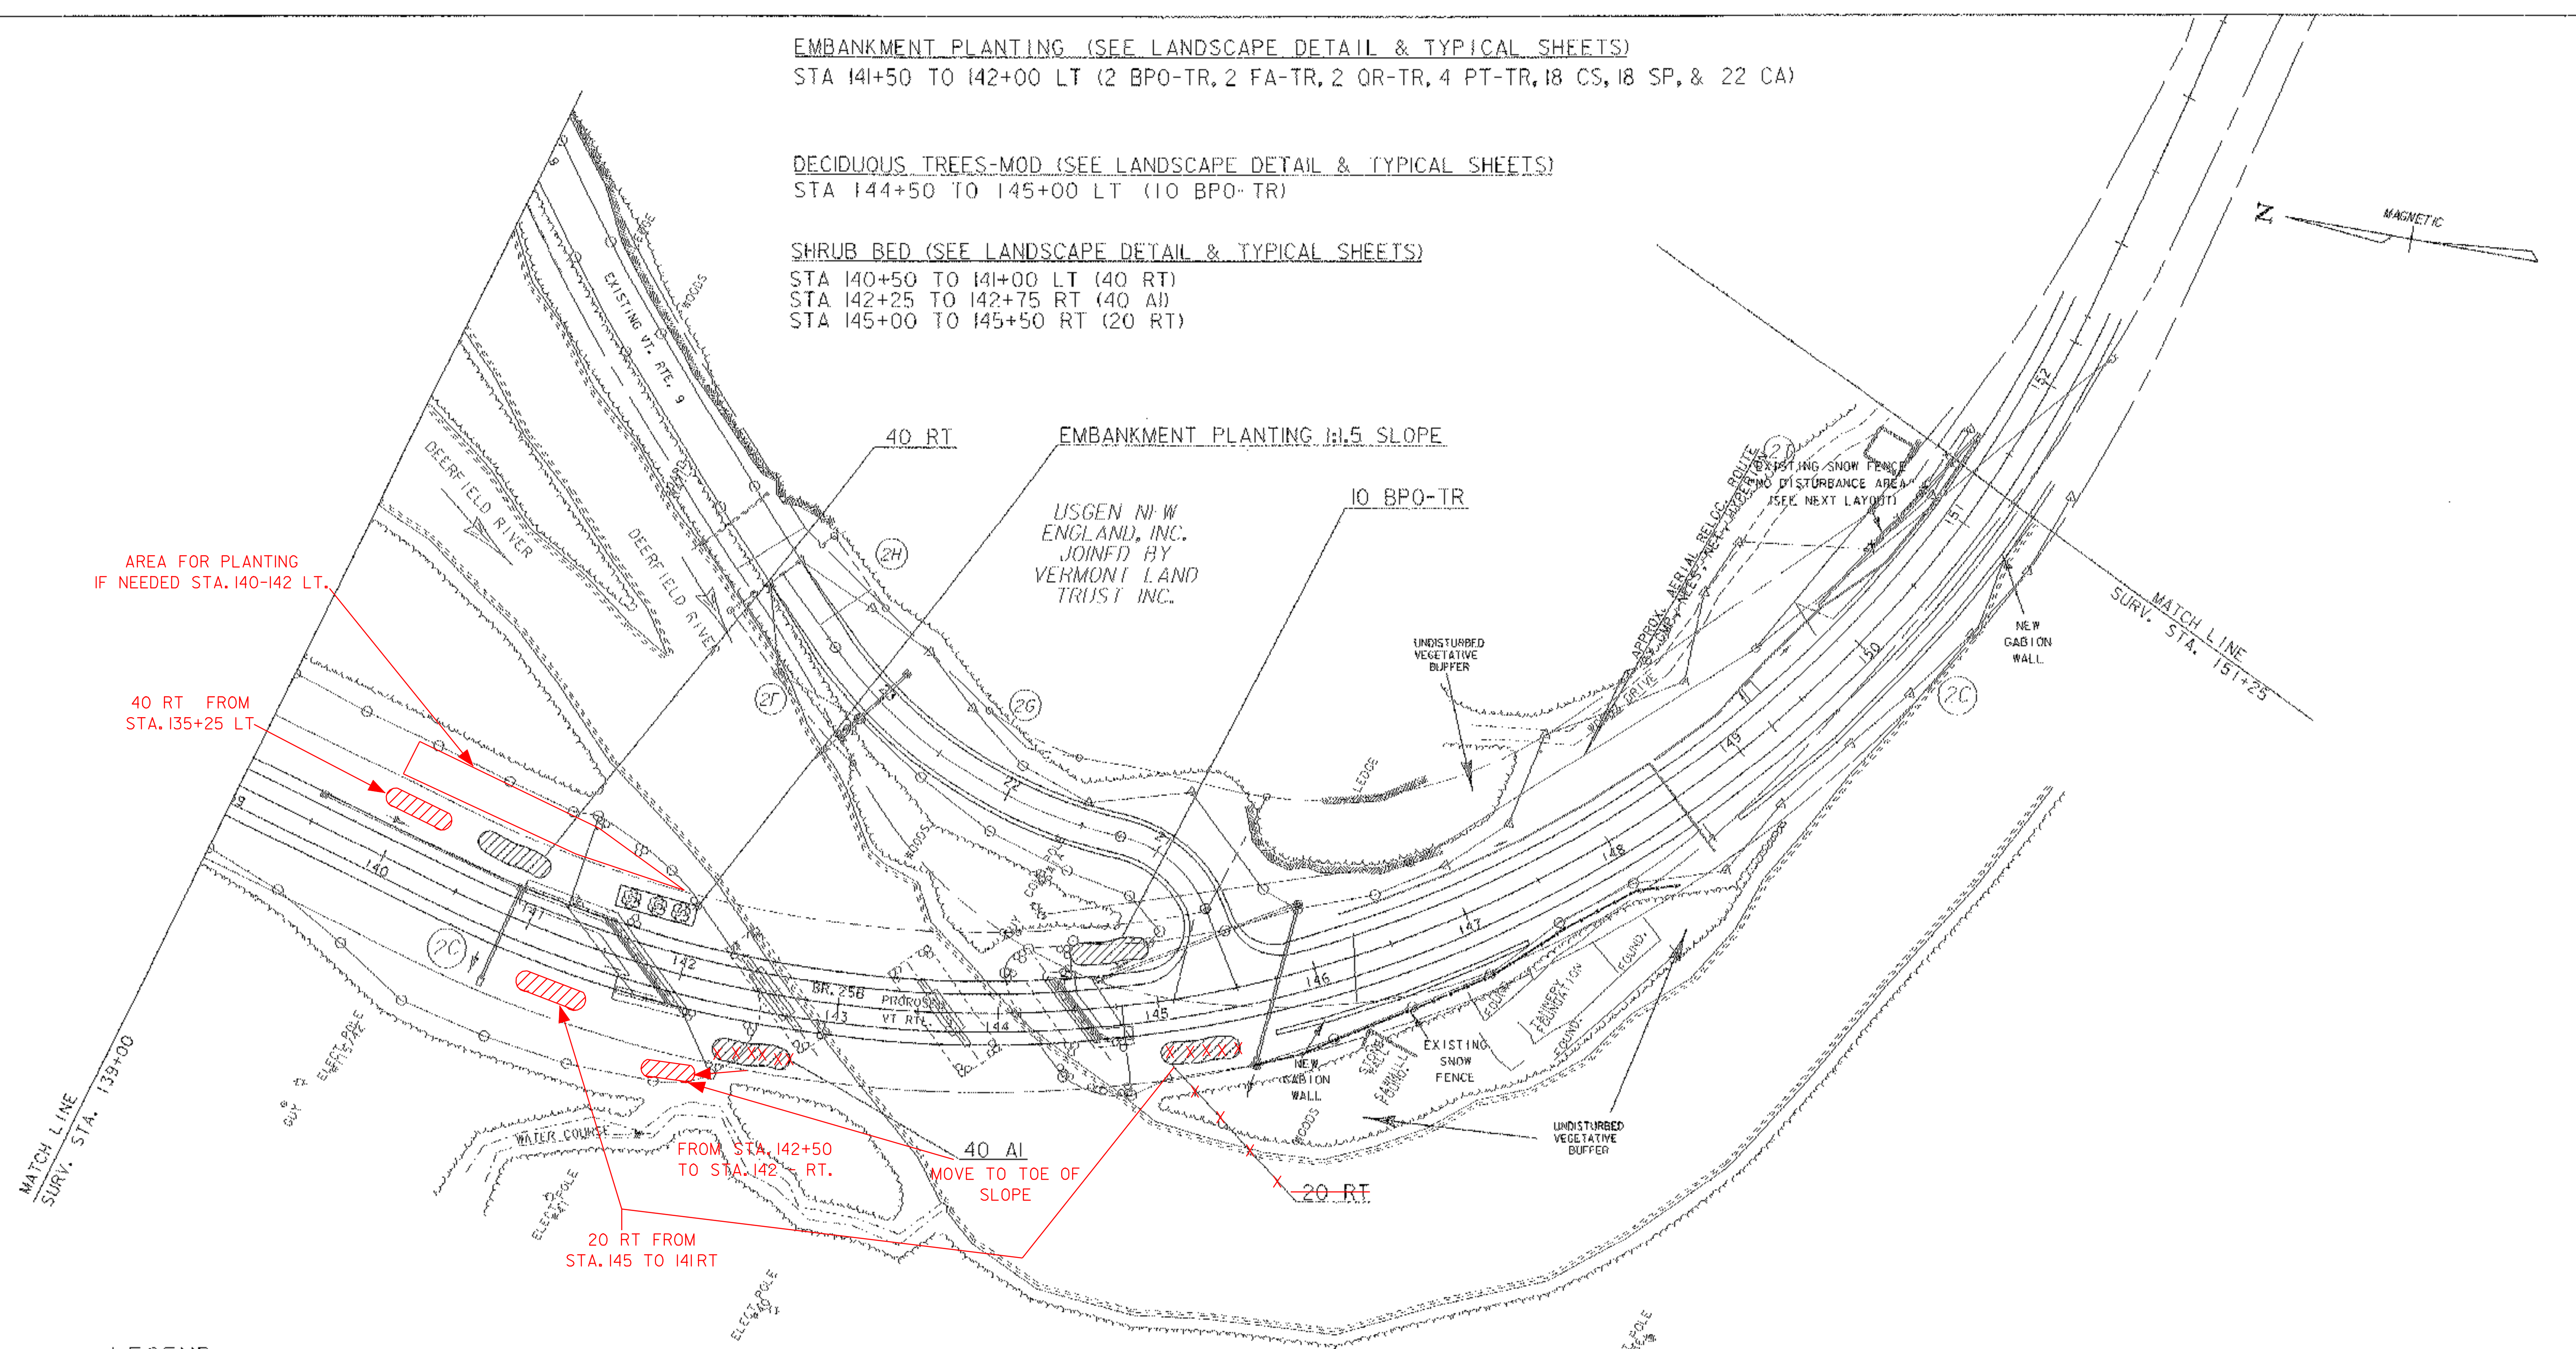


EMBANKMENT PLANTING (SEE LANDSCAPE DETAIL & TYPICAL SHEETS)
 STA 141+50 TO 142+00 LT (2 BPO-TR, 2 FA-TR, 2 QR-TR, 4 PT-TR, 18 CS, 18 SP, & 22 CA)

DECIDUOUS TREES-MOD (SEE LANDSCAPE DETAIL & TYPICAL SHEETS)
 STA 144+50 TO 145+00 LT (10 BPO-TR)

SHRUB BED (SEE LANDSCAPE DETAIL & TYPICAL SHEETS)
 STA 140+50 TO 141+00 LT (40 RT)
 STA 142+25 TO 142+75 RT (40 AI)
 STA 145+00 TO 145+50 RT (20 RT)



AREA FOR PLANTING
 IF NEEDED STA. 140-142 LT.

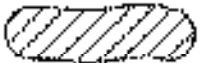


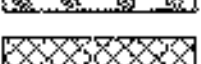





40 RT FROM
 STA. 135+25 LT

FROM STA. 142+50
 TO STA. 142+5 RT.

40 AI
 MOVE TO TOE OF
 SLOPE

20 RT FROM
 STA. 145 TO 141 RT

LEGEND

-  TYPICAL SHRUB BED
-  GROUND COVER & VINES
-  EMBANKMENT PLANTING
-  PLANTING POCKET
-  PLANTING BED OVER GEO-GRID
-  PROPOSED DECIDUOUS TREE (SMALL)
-  PROPOSED DECIDUOUS TREE
-  PROPOSED EVERGREEN TREE
-  EDGE OF TREE LINE

*NOTE:
 1. EXTRA TOPSOIL SHALL BE USED AT
 THE DISCRETION OF THE ENGINEER.



USGEN NEW
 ENGLAND, INC.
 JOINED BY
 VERMONT LAND
 TRUST INC.

FOR LANDSCAPE ONLY

SHEET NAME: PLAN VIEW SHEET	
PROJECT NAME: SEARSBURG-WILMINGTON	
PROJECT NUMBER: NHF 010-1(18) C-1	
PROJECT LEADER: J. BROWN	DRAWN BY: SQUAD B
DESIGNED BY: J. BROWN	CHECKED BY: SQUAD B
FILE NAME: 78d096/design/landbdr.dgn	PLOT DATE: 21-JAN-2004
IPARM FILE NAME: land014.r	SHEET 10 OF 30