

DECIDUOUS TREES-MOD (SEE LANDSCAPE DETAIL & TYPICAL SHEETS)

- STA 188+75 TO 189+75 LT (3 FA)
- STA 194+00 TO 194+75 LT (3 OR)
- STA 200+25 TO 200+75 LT (3 OR)
- STA 201+50 TO 202+00 LT (2 BP)
- STA 187+50 TO 188+00 RT (5 AA)
- STA 189+00 TO 189+25 RT (2 AA)
- STA 191+25 TO 192+00 RT (2 OR)
- STA 192+25 TO 193+00 RT (3 BP)
- STA 196+50 TO 197+25 RT (2 BP)
- STA 201+75 TO 202+25 RT (3 AA)

SHRUB BED (SEE LANDSCAPE DETAIL & TYPICAL SHEETS)

- STA 188+00 TO 189+00 RT (80 CS)

SUBBED 3 AA(LARGE)  
FOR 2 FP AND 1QR  
STA. 272+00 - STA. 273+00 LT


MOVE  
3 OR FROM STA. 194 LT  
TO STA. 232-234 RT  
SHEET 17

MOVED 3 OR TO  
STA. 112+50 - STA. 114+50  
SHEET 8

MOVED TO STA. 278+00 RT

ADD 8AA  
NOTE: 5 FROM SHEET 19 STA 260 RT  
3 FROM SHEET 19 STA 258 LT  
(GROUP OF 6)

ADD 3AA  
EXCHANGE FROM PST  
STA. 258 LT  
SHEET 19  
(GROUP OF 6)

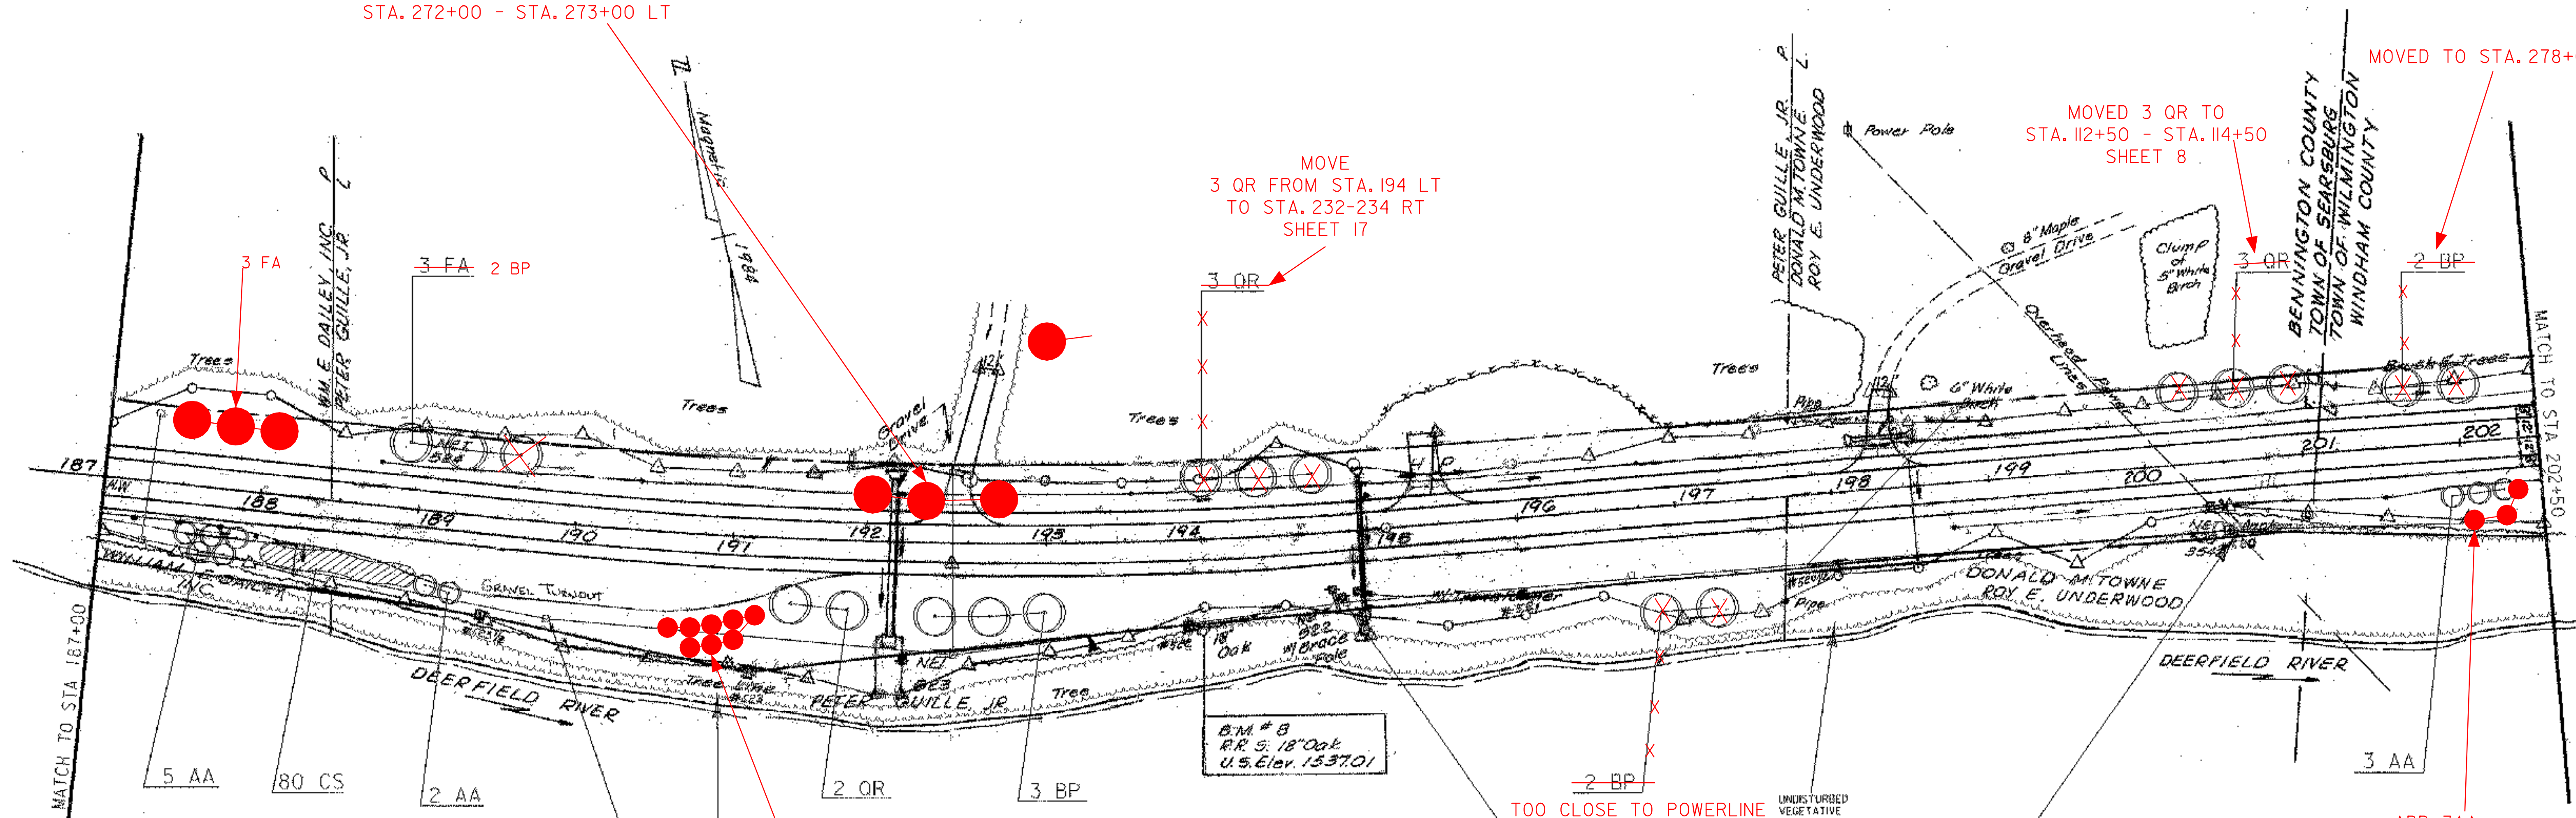

LEGEND

- TYPICAL SHRUB BED
- GROUND COVER & VINES
- EMBANKMENT PLANTING
- PLANTING POCKET
- PLANTING BED OVER GEO-GRID
- PROPOSED DECIDUOUS TREE (SMALL)
- PROPOSED DECIDUOUS TREE
- PROPOSED EVERGREEN TREE
- EDGE OF TREE LINE

APPROXIMATE LOCATION OF NEW UTILITY POLES AND LINES.

APPROXIMATE LOCATION OF NEW UTILITY POLES AND LINES.

\*NOTE:  
1. EXTRA TOPSOIL SHALL BE USED AT THE DISCRETION OF THE ENGINEER.



FOR LANDSCAPE ONLY

SHEET NAME:	PLAN VIEW SHEET
PROJECT NAME:	SEARSBURG-WILMINGTON
PROJECT NUMBER:	NHF 010-1(18) C-1
PROJECT LEADER:	J. BROWN
DESIGNED BY:	J. BROWN
FILE NAME:	78d096/des/ign/landnul.dgn
IPARM FILE NAME:	land08.j
DRAWN BY:	SQUAD B
CHECKED BY:	SQUAD B
PLOT DATE:	21-JAN-2004
	SHEET 14 OF 30