

EMBANKMENT PLANTING (SEE LANDSCAPE DETAIL & TYPICAL SHEETS)

STA 237+00 TO 238+00 RT (4 BPO-TR, 4 FA-TR, 4 QR-TR, 8 PT-TR, 36 CS, 36 SP, & 44 CA)  
 STA 240+25 TO 240+75 RT (2 BPO-TR, 2 FA-TR, 2 QR-TR, 4 PT-TR, 18 CS, 18 SP, & 22 CA)

DECIDUOUS TREES-MOD (SEE LANDSCAPE DETAIL & TYPICAL SHEETS)


STA 237+25 TO 238+00 LT (3 FP)  
 STA 240+25 TO 240+50 LT (2 QR)  
 STA 230+50 TO 231+25 RT (3 FP)  
 STA 232+00 TO 232+25 RT (2 AS)  
 STA 232+75 TO 233+00 RT (2 QR)  
 STA 234+00 RT (1BP)

PLANTING POCKET (SEE LANDSCAPE DETAIL & TYPICAL SHEETS)

STA 229+00 TO 229+50 RT (2 BPO-TR, 2 FA-TR, 2 QR-TR, 6 VL, 6 AM, & 6 CR)  
 STA 238+00 TO 240+00 RT (8 BPO-TR, 8 FA-TR, 8 QR-TR, 24 VL, 24 AM, & 24 CR)

CHANNEL STABILIZATION SHRUB PLANTING (SEE LANDSCAPE DETAIL & TYPICAL SHEETS)

\*\*STA 237+40 TO 239+70 RT  
 228' LENGTH AT TOE OF SLOPE  
 70 AI & 70 SD-ON FLAT AREA LEFT BANK OF CHANNEL (10' BY 228')  
 70 AI-ON SLOPED AREA LEFT OF CHANNEL (4' BY 228')  
 70 SP-ON SLOPED AREA RIGHT BANK OF CHANNEL (4' BY 228')  
 \*\*FINAL LOCATION TO BE DETERMINED IN THE FIELD BY THE ENGINEER.

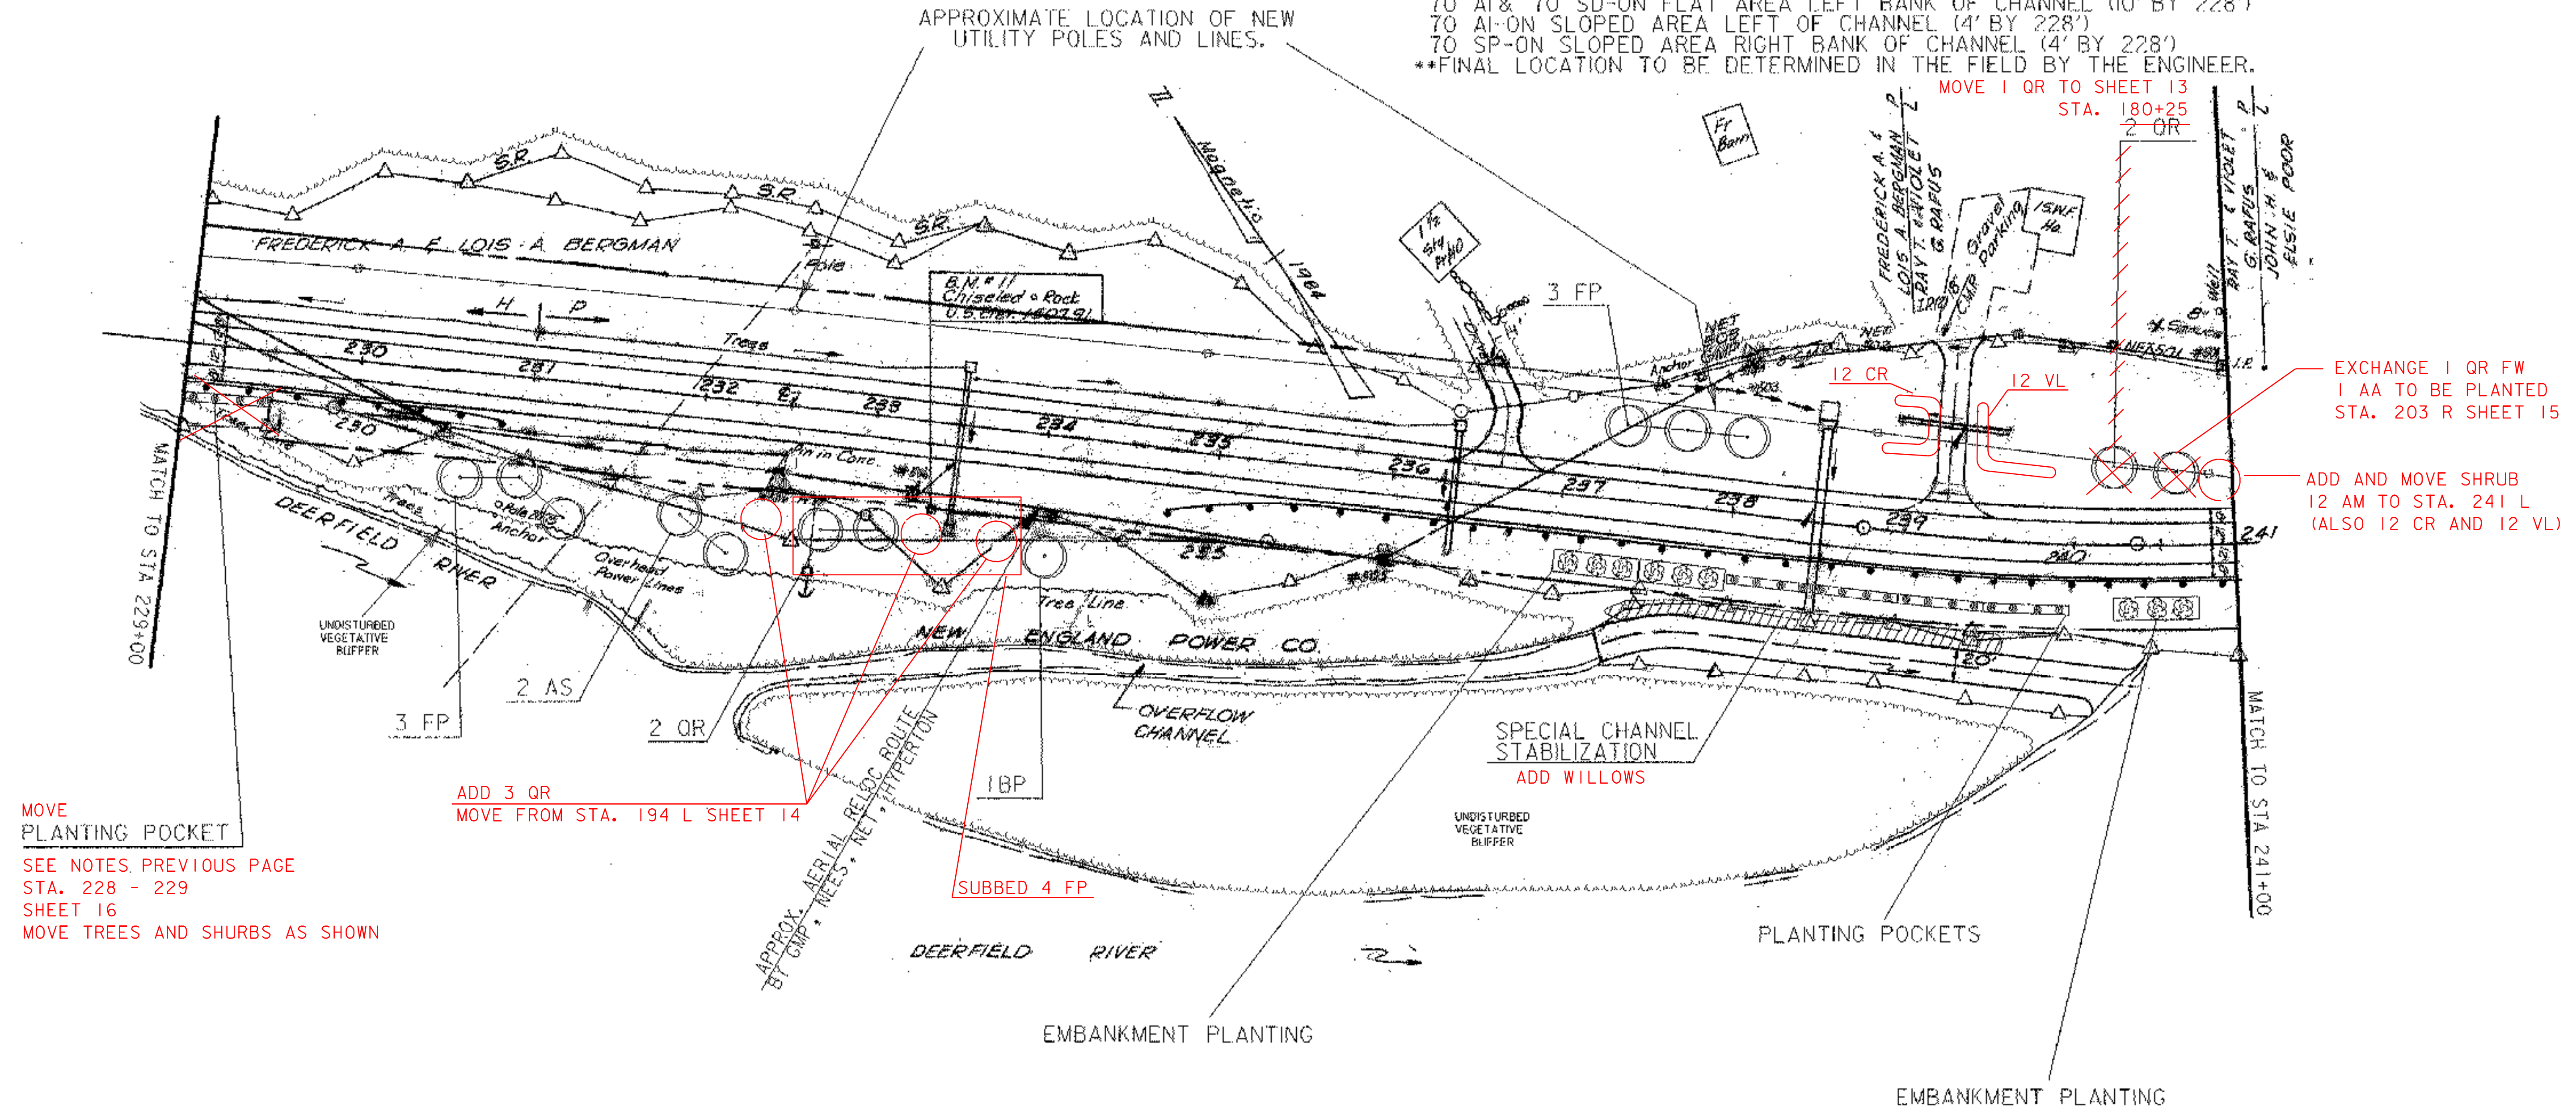

MOVE PLANTING POCKET  
 SEE NOTES, PREVIOUS PAGE  
 STA. 228 - 229  
 SHEET 16  
 MOVE TREES AND SHURBS AS SHOWN

ADD 3 QR  
 MOVE FROM STA. 194 L SHEET 14

SUBBED 4 FP

EXCHANGE 1 QR FW  
 1 AA TO BE PLANTED  
 STA. 203 R SHEET 15

ADD AND MOVE SHRUB  
 12 AM TO STA. 241 L  
 (ALSO 12 CR AND 12 VL)

- LEGEND**
- TYPICAL SHRUB BED
  - GROUND COVER & VINES
  - EMBANKMENT PLANTING
  - PLANTING POCKET
  - PLANTING BED OVER GEO-GRID
  - PROPOSED DECIDUOUS TREE (SMALL)
  - PROPOSED DECIDUOUS TREE
  - PROPOSED EVERGREEN TREE
  - EDGE OF TREE LINE

\*NOTE:  
 1. EXTRA TOPSOIL SHALL BE USED AT THE DISCRETION OF THE ENGINEER.



FOR LANDSCAPE ONLY

SHEET NAME:	PLAN VIEW SHEET
PROJECT NAME:	SEARSBURG-WILMINGTON
PROJECT NUMBER:	NHF 010-1(18) C-1
PROJECT LEADER:	J. BROWN
DESIGNED BY:	J. BROWN
FILE NAME:	78d096/desigr/landnul.dgn
IPARM FILE NAME:	landll1
DRAWN BY:	SQUAD B
CHECKED BY:	SQUAD B
PLOT DATE:	21-JAN-2004
SHEET	17 OF 30