

EMBANKMENT PLANTING (SEE LANDSCAPE DETAIL & TYPICAL SHEETS)
 STA 242+75 TO 243+75 RT (4 BPO-TR, 4 FA-TR, 4 QR-TR, 8 PT-TR, 36 CS, 36 SP, & 44 CA)

DECIDUOUS TREES-MOD (SEE LANDSCAPE DETAIL & TYPICAL SHEETS)

STA 241+75 TO 242+25 LT (2 QR)
 *STA 252+25 TO 253+50 RT (8 BPO-TR)
 STA 252+50 TO 253+00 RT (2 FA)
 STA 253+25 TO 253+50 RT (2 QR)
 *PLANT ON FLAT AREA MID-SLOPE, LOCATE 50' FROM CENTERLINE.

PLANT 10 VL SHRUBS AT STA. 242 L
 THESE WERE EXCHANGED FW 1 QR FROM
 SHEET 15, STA. 206 L

EXCHANGE 2 QR FOR 2 AA TO BE PLANTED
 STA. 203 SHEET 15

APPROXIMATE LOCATION OF NEW
 UTILITY POLES AND LINES.

SHRUB BED (SEE LANDSCAPE DETAIL & TYPICAL SHEETS)


STA 252+50 TO 253+50 RT (80 RT)

PLANTING POCKET (SEE LANDSCAPE DETAIL & TYPICAL SHEETS)

STA 241+00 TO 242+50 RT (6 BPO-TR, 6 FA-TR, 6 QR-TR, 18 VL, 18 AM, & 18 CR)
 STA 244+00 TO 246+50 RT (10 BPO-TR, 10 FA-TR, 10 QR-TR, 30 VL, 30 AM, & 30 CR)

GEOGRID (SEE LANDSCAPE DETAIL & TYPICAL SHEETS)

STA 248+00 TO 249+00 RT (52 CS, 48 RT, & 40 CA)

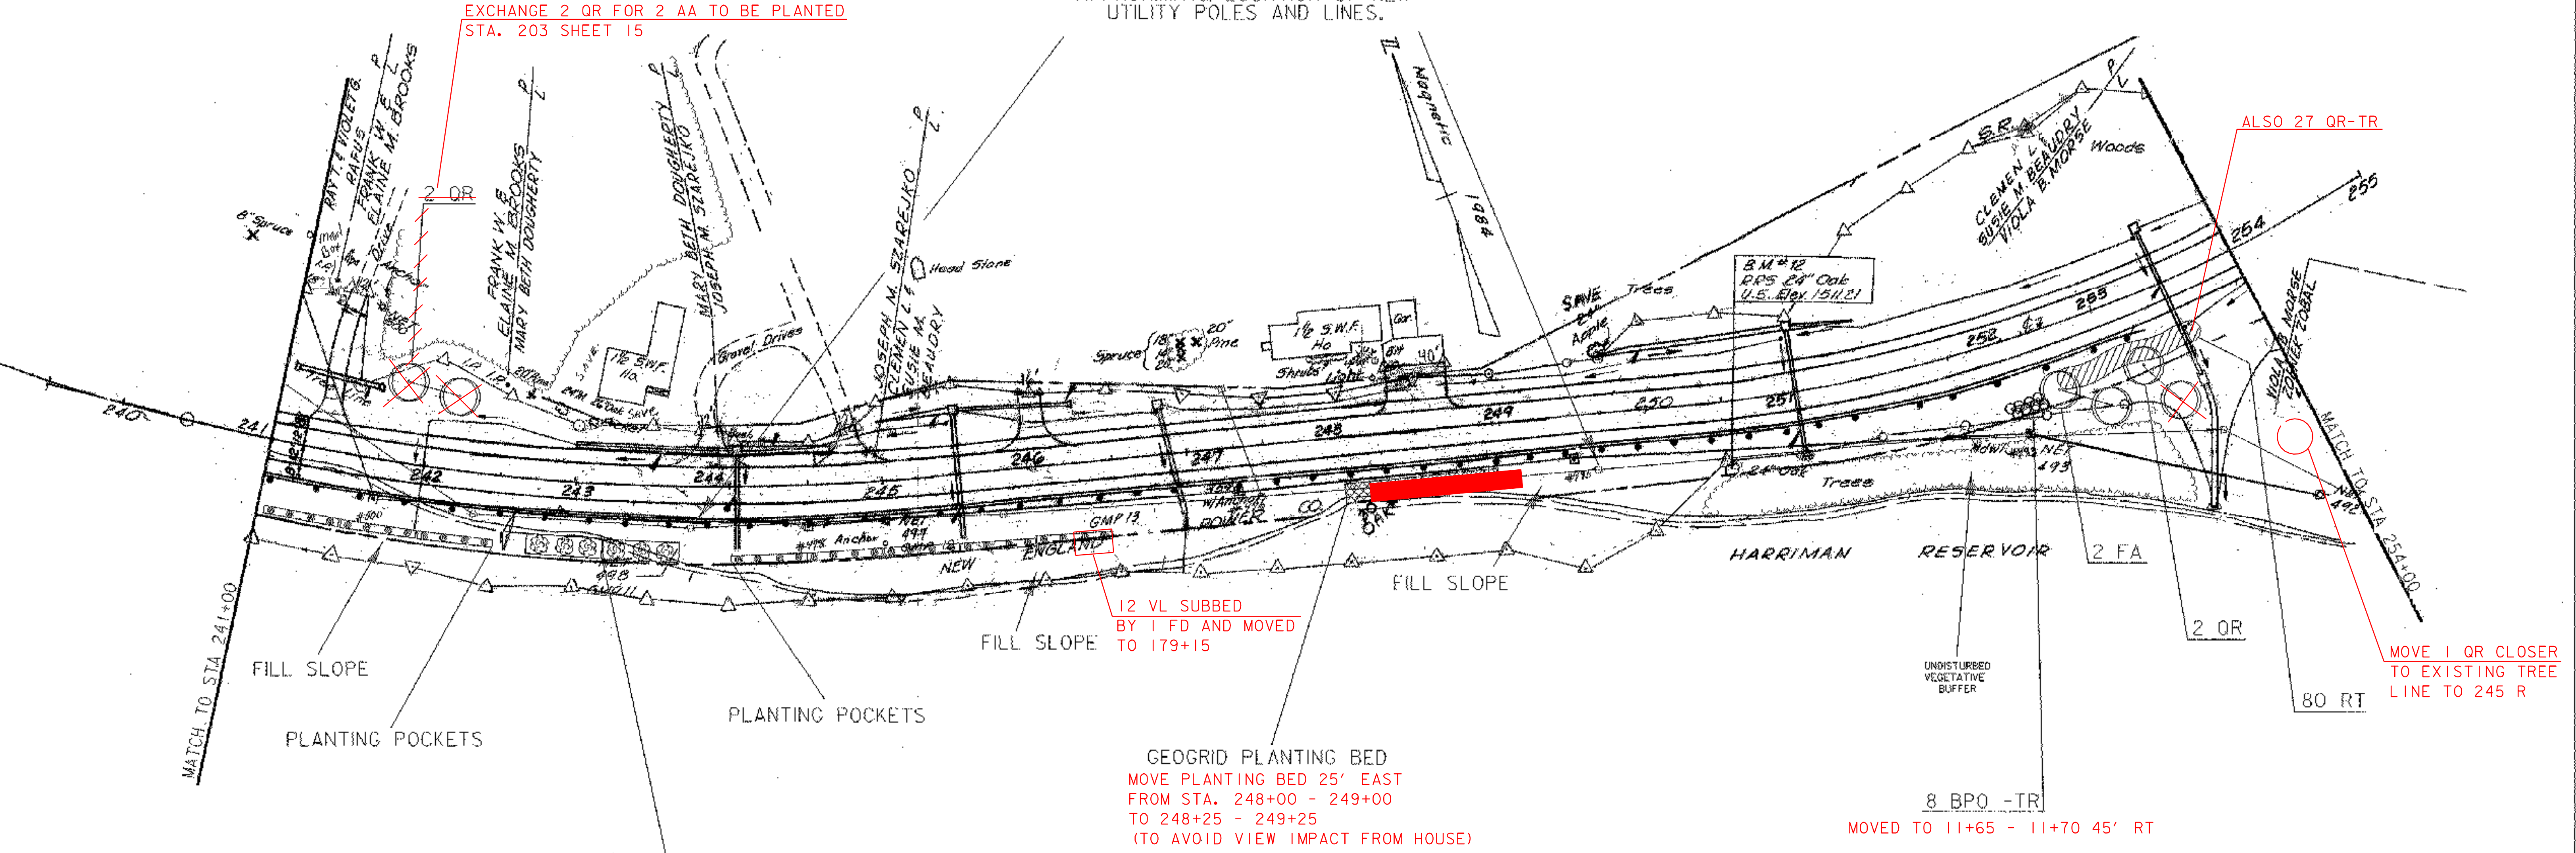

EMBANKMENT PLANTING
 VERY IRREGULAR SHAPE
 DUE TO INCONSISTENT SOIL
 CONDITIONS

- LEGEND**
- TYPICAL SHRUB BED
 - GROUND COVER & VINES
 - EMBANKMENT PLANTING
 - PLANTING POCKET
 - PLANTING BED OVER GEO-GRID
 - PROPOSED DECIDUOUS TREE (SMALL)
 - PROPOSED DECIDUOUS TREE
 - PROPOSED EVERGREEN TREE
 - EDGE OF TREE LINE

*NOTE:
 1. EXTRA TOPSOIL SHALL BE USED AT
 THE DISCRETION OF THE ENGINEER.



FOR LANDSCAPE ONLY

SHEET NAME: PLAN VIEW SHEET	
PROJECT NAME: SEARSBURG-WILMINGTON	
PROJECT NUMBER: NHF 010-(K18) C-1	
PROJECT LEADER: J. BROWN	DRAWN BY: SQUAD B
DESIGNED BY: J. BROWN	CHECKED BY: SQUAD B
FILE NAME: 78d096/design/landnu1.dgn	PLOT DATE: 21-JAN-2004
IPARM FILE NAME: land12.1	SHEET 18 OF 30