


EXCHANGE 6 PST FOR 3 AA - STA. 191 RT, SHEET 14
 3 AA - STA. 202 RT, SHEET 14
 6 PST

NOTE:
 CUT LINE MEETS
 EXISTING GRADE
 AT STA 267+00

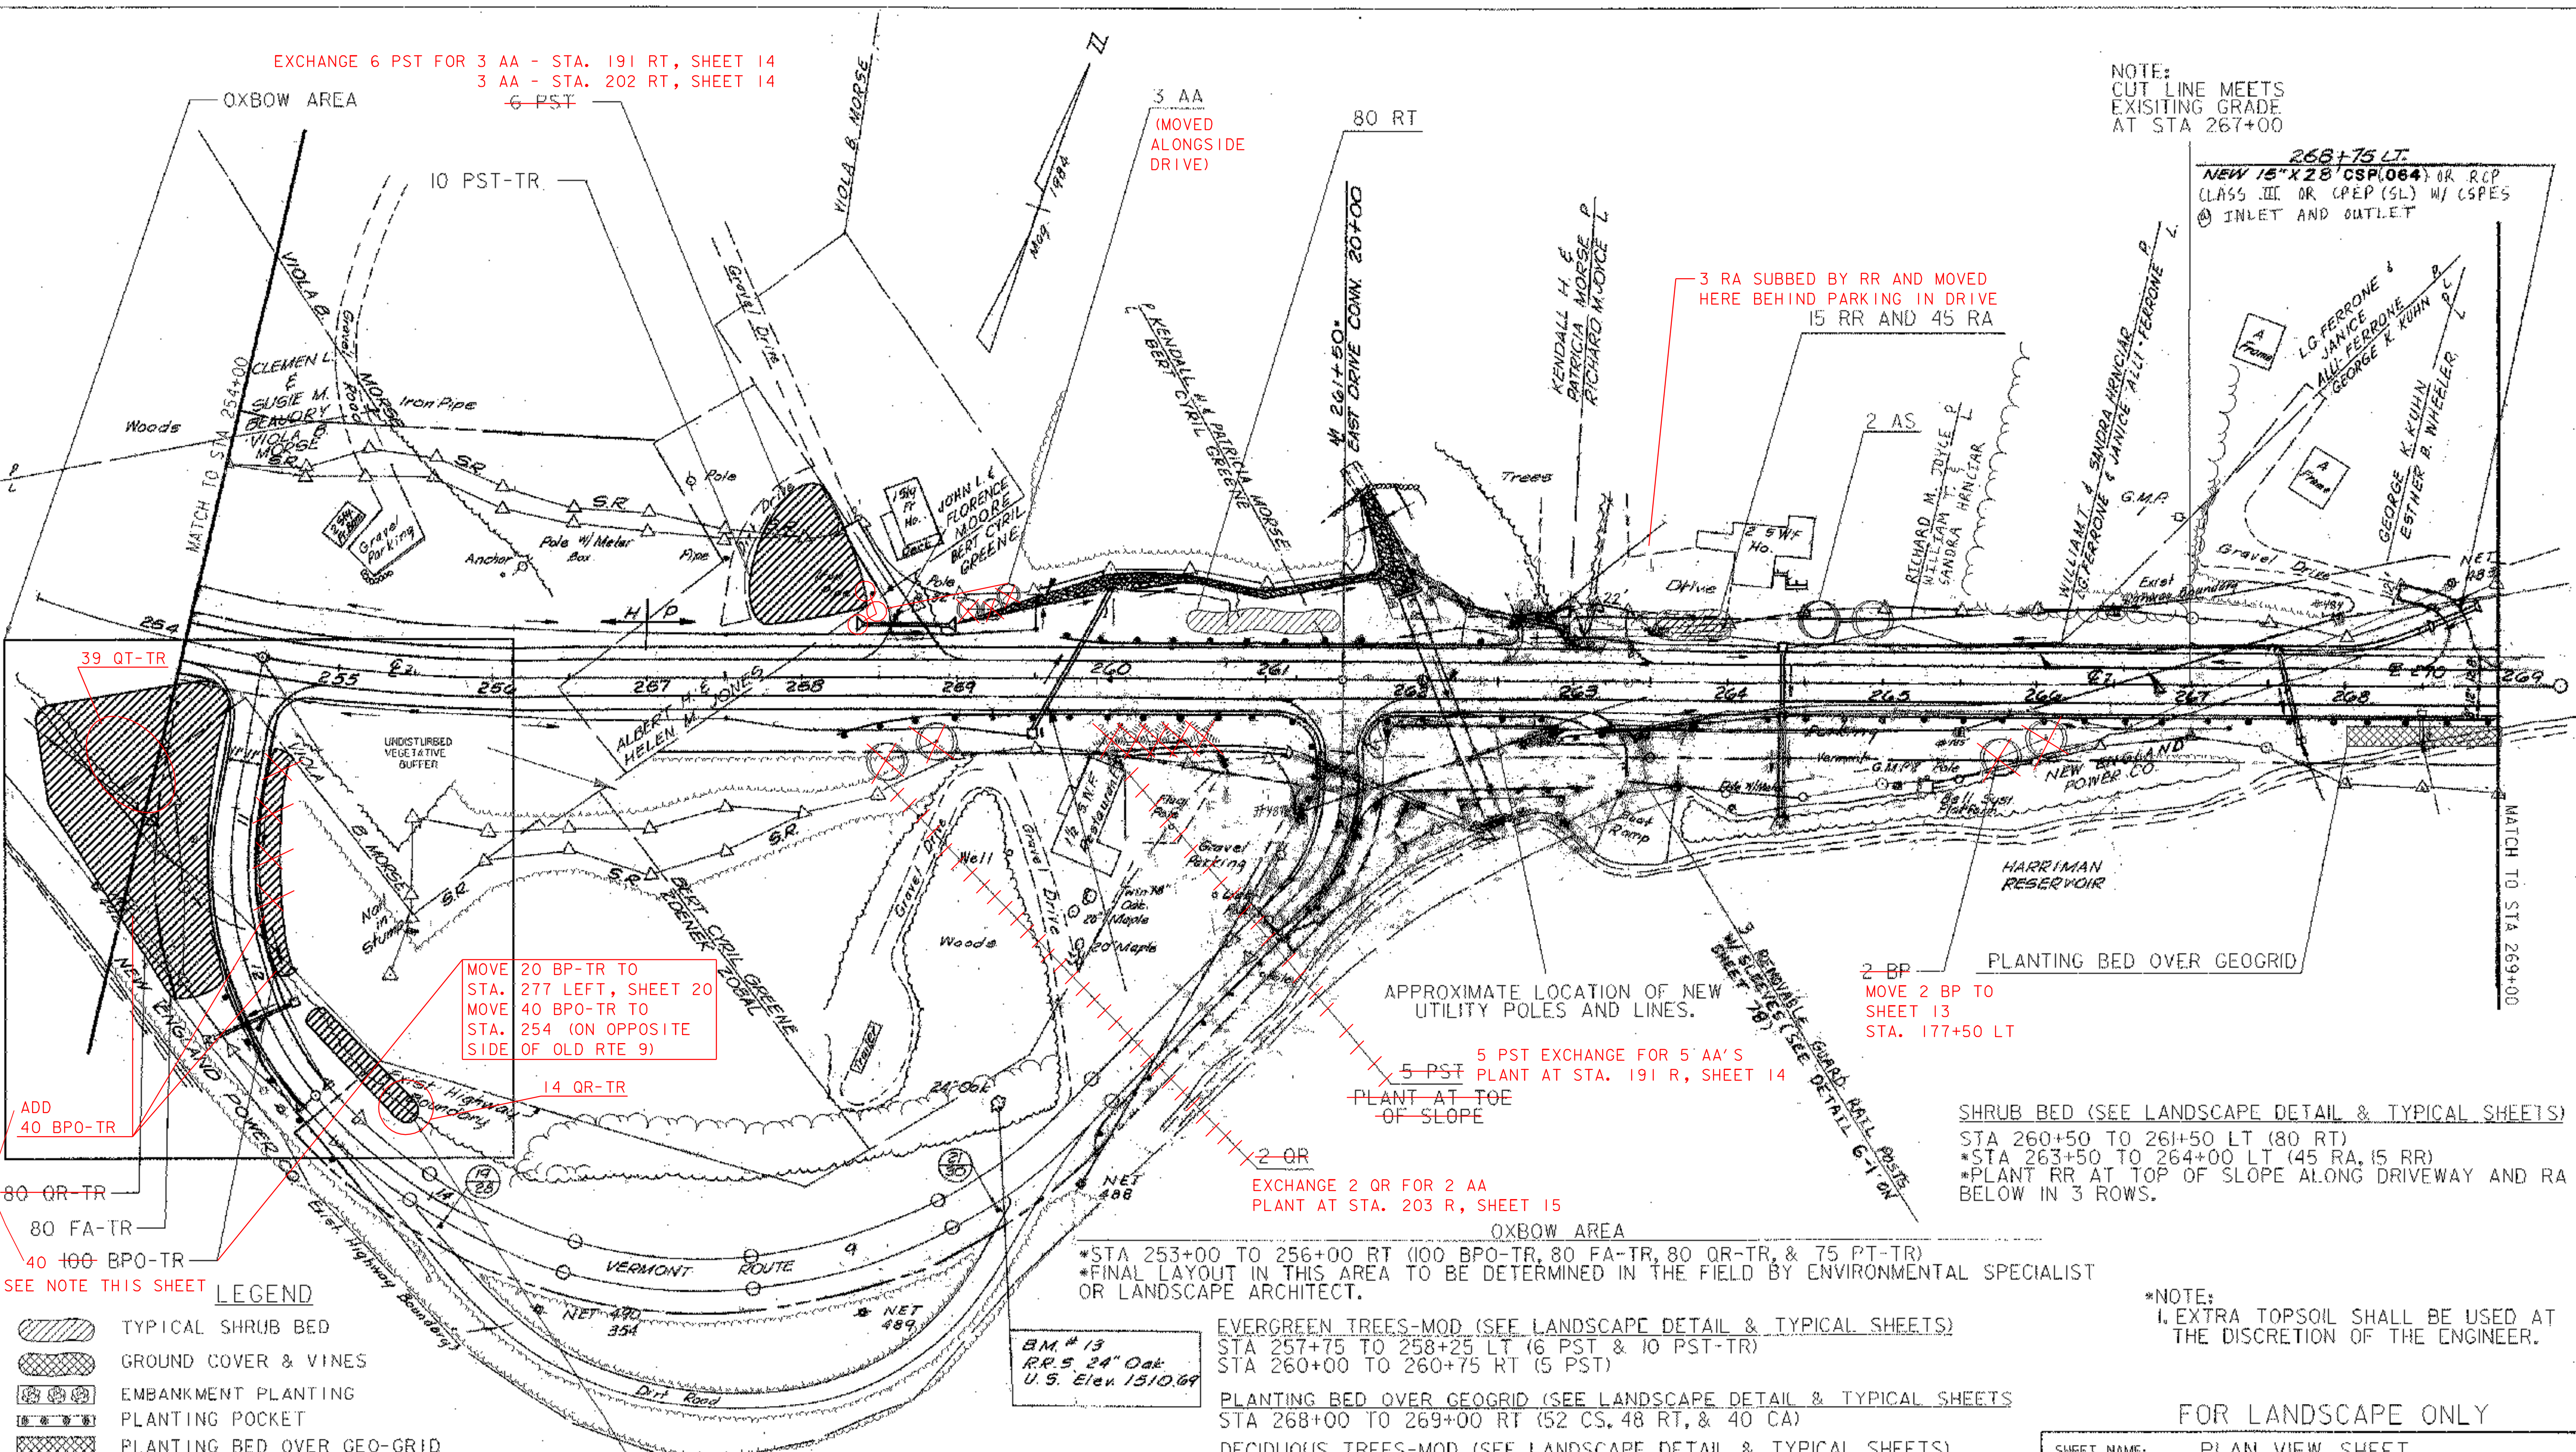

268+75 LT.
 NEW 15" X 28" CSP(064) OR RCP
 (CLASS III OR GPEP (SL) W/ CSPES
 @ INLET AND OUTLET

3 RA SUBBED BY RR AND MOVED
 HERE BEHIND PARKING IN DRIVE
 15 RR AND 45 RA

MOVE 20 BP-TR TO
 STA. 277 LEFT, SHEET 20
 MOVE 40 BPO-TR TO
 STA. 254 (ON OPPOSITE
 SIDE OF OLD RTE 9)

APPROXIMATE LOCATION OF NEW
 UTILITY POLES AND LINES.

5 PST EXCHANGE FOR 5' AA'S
 5 PST PLANT AT STA. 191 R, SHEET 14
 PLANT AT TOE
 OF SLOPE

2 BP
 MOVE 2 BP TO
 SHEET 13
 STA. 177+50 LT

SHRUB BED (SEE LANDSCAPE DETAIL & TYPICAL SHEETS)
 STA 260+50 TO 261+50 LT (80 RT)
 *STA 263+50 TO 264+00 LT (45 RA, 15 RR)
 *PLANT RR AT TOP OF SLOPE ALONG DRIVEWAY AND RA
 BELOW IN 3 ROWS.

EXCHANGE 2 QR FOR 2 AA
 PLANT AT STA. 203 R, SHEET 15

OXBOW AREA
 *STA 253+00 TO 256+00 RT (100 BPO-TR, 80 FA-TR, 80 QR-TR, & 75 PT-TR)
 *FINAL LAYOUT IN THIS AREA TO BE DETERMINED IN THE FIELD BY ENVIRONMENTAL SPECIALIST
 OR LANDSCAPE ARCHITECT.

BM # 13
 RR. 5 24" Oak
 U.S. Elev. 1310.69

EVERGREEN TREES-MOD (SEE LANDSCAPE DETAIL & TYPICAL SHEETS)
 STA 257+75 TO 258+25 LT (6 PST & 10 PST-TR)
 STA 260+00 TO 260+75 RT (5 PST)

PLANTING BED OVER GEOGRID (SEE LANDSCAPE DETAIL & TYPICAL SHEETS)
 STA 268+00 TO 269+00 RT (52 CS, 48 RT, & 40 CA)

DECIDUOUS TREES-MOD (SEE LANDSCAPE DETAIL & TYPICAL SHEETS)
 STA 259+00 TO 259+25 LT (3 AA)
 STA 264+50 TO 265+00 LT (2 AS)
 STA 258+50 TO 259+00 RT (2 QR)
 STA 265+75 TO 266+00 RT (2 BP)

PLANTING BED OVER GEOGRID (SEE LANDSCAPE DETAIL & TYPICAL SHEETS)
 STA 268+00 TO 269+00 RT (52 CS, 48 RT, & 40 CA)

*NOTE:
 1. EXTRA TOPSOIL SHALL BE USED AT
 THE DISCRETION OF THE ENGINEER.

FOR LANDSCAPE ONLY

SHEET NAME:	PLAN VIEW SHEET
PROJECT NAME:	SEARSBURG-WILMINGTON
PROJECT NUMBER:	NHF 010-1(18) C-1
PROJECT LEADER:	J. BROWN
DESIGNED BY:	J. BROWN
FILE NAME:	78d096/design/landnul.dgn
IPARM FILE NAME:	landl3.1
DRAWN BY:	SQUAD B
CHECKED BY:	SQUAD B
PLOT DATE:	21-JAN-2004
SHEET	19 OF 30

LEGEND

- TYPICAL SHRUB BED
- GROUND COVER & VINES
- EMBANKMENT PLANTING
- PLANTING POCKET
- PLANTING BED OVER GEO-GRID
- PROPOSED DECIDUOUS TREE (SMALL)
- PROPOSED DECIDUOUS TREE
- PROPOSED EVERGREEN TREE
- EDGE OF TREE LINE

45
 75 PT-TR
 MOVE 30 PT-TR TO
 SHEET 20 STA. 278

