

**604.412 REHABING DI, CB OR MH CLASS I**  
 STA. 5+66.76 RT EXIT 7 RAMP A  
 STA. 6+01.06 RT EXIT 7 RAMP A  
 STA. 6+34.47 RT EXIT 7 RAMP A  
 STA. 6+95.14 RT EXIT 7 RAMP A  
 STA. 7+47.09 RT EXIT 7 RAMP A  
 STA. 8+44.73 RT EXIT 7 RAMP A  
 STA. 14+22.59 LT EXIT 7 RAMP D  
 STA. 16+63.75 LT EXIT 7 RAMP D

**621.505 MANUFACTURED TERMINAL SECTIONS (FLARED)**  
 STA. 3+76.95 RT - STA. 4+14.45 RT EXIT 7 RAMP A  
 STA. 4+02.85 LT - STA. 4+40.35 LT EXIT 7 RAMP A  
 STA. 9+12.08 LT - STA. 9+49.58 LT EXIT 7 RAMP A  
 STA. 9+20.22 RT - STA. 9+57.72 RT EXIT 7 RAMP A  
 STA. 12+41.57 LT - STA. 12+79.07 LT EXIT 7 RAMP D  
 STA. 12+55.27 RT - STA. 12+92.77 RT EXIT 7 RAMP D  
 STA. 17+15.47 RT - STA. 17+52.97 RT EXIT 7 RAMP D  
 STA. 17+17.27 LT - STA. 17+54.77 LT EXIT 7 RAMP D

**616.35 TREATED TIMBER CURB**  
 STA. 4+05.00 LT - STA. 5+50.00 LT EXIT 7 RAMP A  
 STA. 5+00.00 RT - STA. 5+21.00 RT EXIT 7 RAMP A  
 STA. 8+88.00 RT - STA. 9+14.00 RT EXIT 7 RAMP A

**616.47 BITUMINOUS CONCRETE GUTTERS AND TRAFFIC ISLAND**  
 EXIT 7 RAMP A STA. 5+33.75 RT - STA. 5+45.75 RT  
 EXIT 7 RAMP A STA. 5+53.30 LT - STA. 5+66.80 LT  
 EXIT 7 RAMP A STA. 8+81.25 LT - STA. 9+07.25 LT

**646.414 DURABLE 6" WHITE LINE (MOD. - RETROREFLECTIVITY / INLAID)**  
 STA. 1+00.00 RT - STA. 19+09.00 RT EXIT 7 RAMP A (SOLID)  
 STA. 414+68.00 RT - STA. 415+00.00 RT (SOLID)  
 STA. 15+81.00 CL - STA. 19+09.00 CL EXIT 7 RAMP A (DASHED)  
 STA. 414+68.00 RT - STA. 415+00.00 RT (DASHED)  
 STA. 2+99.00 RT - STA. 19+26.00 RT EXIT 7 RAMP D (SOLID)  
 STA. 17+97.00 CL - STA. 19+03.00 CL EXIT 7 RAMP D (SOLID)

**646.415 DURABLE 6" YELLOW LINE (MOD. - RETROREFLECTIVITY / INLAID)**  
 STA. 1+00.00 LT - STA. 17+41.00 LT EXIT 7 RAMP A (SOLID)  
 STA. 17+41.00 LT - STA. 19+09.00 LT EXIT 7 RAMP A (DOUBLE SOLID)  
 STA. 414+68.00 CL - STA. 415+00.00 CL (DOUBLE SOLID)  
 STA. 2+99.00 LT - STA. 5+00.00 LT EXIT 7 RAMP D (DOUBLE SOLID)  
 STA. 5+00.00 LT - STA. 19+26.00 LT EXIT 7 RAMP D (SOLID)

**646.45 DURABLE 12" YELLOW LINE (MOD. - RETROREFLECTIVITY / INLAID)**  
 STA. 413+00.00 CL - STA. 415+00.00 CL (HATCHED)

**646.46 DURABLE 24" STOP BAR (THERMOPLASTIC)**  
 STA. 19+03.64 EXIT 7 RAMP D

**646.50 DURABLE LETTER OR SYMBOL (THERMOPLASTIC)**  
 STA. 12+59.00 CL "ARROW" EXIT 7 RAMP A  
 STA. 11+19.00 CL "SIGNAL" EXIT 7 RAMP D  
 STA. 11+60.00 CL "AHEAD" EXIT 7 RAMP D  
 STA. 16+73.00 CL "ARROW" EXIT 7 RAMP D  
 STA. 18+14.00 RT "ARROW" EXIT 7 RAMP D  
 STA. 18+14.00 LT "ARROW" EXIT 7 RAMP D  
 STA. 18+55.00 RT "ONLY" EXIT 7 RAMP D  
 STA. 18+55.00 LT "ONLY" EXIT 7 RAMP D  
 STA. 18+94.00 RT "ARROW" EXIT 7 RAMP D  
 STA. 18+94.00 LT "ARROW" EXIT 7 RAMP D

**646.614 TEMPORARY 6" WHITE LINE (PAINT)**  
 STA. 1+00.00 RT - STA. 19+09.00 RT EXIT 7 RAMP A (SOLID)  
 STA. 414+68.00 RT - STA. 415+00.00 RT (SOLID)  
 STA. 15+81.00 CL - STA. 19+09.00 CL EXIT 7 RAMP A (DASHED)  
 STA. 414+68.00 RT - STA. 415+00.00 RT (DASHED)  
 STA. 2+99.00 RT - STA. 19+26.00 RT EXIT 7 RAMP D (SOLID)  
 STA. 17+97.00 CL - STA. 19+03.00 CL EXIT 7 RAMP D (SOLID)

**646.615 TEMPORARY 6" YELLOW LINE (PAINT)**  
 STA. 1+00.00 LT - STA. 17+41.00 LT EXIT 7 RAMP A (SOLID)  
 STA. 17+41.00 LT - STA. 19+09.00 LT EXIT 7 RAMP A (DOUBLE SOLID)  
 STA. 414+68.00 CL - STA. 415+00.00 CL (DOUBLE SOLID)  
 STA. 2+99.00 LT - STA. 5+00.00 LT EXIT 7 RAMP D (DOUBLE SOLID)  
 STA. 5+00.00 LT - STA. 19+26.00 LT EXIT 7 RAMP D (SOLID)

**646.65 TEMPORARY 12" YELLOW LINE (PAINT)**  
 STA. 413+00.00 CL - STA. 415+00.00 CL (HATCHED)

**646.66 TEMPORARY 24" STOP BAR (PAINT)**  
 STA. 19+03.64 EXIT 7 RAMP D


**646.70 TEMPORARY LETTER OR SYMBOL (PAINT)**  
 STA. 12+59.00 CL "ARROWS" EXIT 7 RAMP A  
 STA. 11+19.00 CL "SIGNAL" EXIT 7 RAMP D  
 STA. 11+60.00 CL "AHEAD" EXIT 7 RAMP D  
 STA. 16+73.00 CL "ARROW" EXIT 7 RAMP D  
 STA. 18+14.00 RT "ARROW" EXIT 7 RAMP D  
 STA. 18+14.00 LT "ARROW" EXIT 7 RAMP D  
 STA. 18+55.00 RT "ONLY" EXIT 7 RAMP D  
 STA. 18+55.00 LT "ONLY" EXIT 7 RAMP D  
 STA. 18+94.00 RT "ARROW" EXIT 7 RAMP D  
 STA. 18+94.00 LT "ARROW" EXIT 7 RAMP D

**675.50 REMOVING SIGN**  
 AS SHOWN - 51

**SIGN LEGEND**  
 R = REMOVE  
 S = SALVAGE  
 N = NEW  
 RET = RETAIN  
 B-B = BACK TO BACK

NOTE:  
 SEE LOOP LAYOUT SHEETS FOR  
 LOCATION OF LOOPS. LOOPS  
 NOT SHOWN ON THIS SHEET.

**PROJECT LAYOUT SHEET 1**

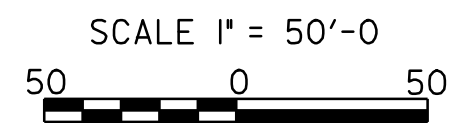

|                                    |                             |
|------------------------------------|-----------------------------|
| PROJECT NAME: ESSEX                | PLOT DATE: 23-APR-2009 15:4 |
| PROJECT NUMBER: NH 2403 (1S)       | DRAWN BY: SJB, RHB          |
| FILE NAME: pave/04b032/p04b032.dgn | CHECKED BY: EPD             |
| PROJECT LEADER: EPD                | SHEET 9 OF 48               |
| DESIGNED BY: JDA                   |                             |
| PLOT FILE: p04b032101              |                             |

|            |     |
|------------|-----|
| DATUM      |     |
| VERTICAL   | N/A |
| HORIZONTAL | N/A |