

618.10 PORTLAND CEMENT CONCRETE SIDEWALK, 5 INCH (MOD.)  
 STA. 1+53 LT RAMP B (5 FEET)  
 STA. 1+25 LT RAMP C (5 FEET)

618.30 DETECTABLE WARNING SURFACE  
 STA. 1+53 LT RAMP B  
 STA. 1+25 LT RAMP C

646.414 DURABLE 6" WHITE LINE (MOD. - RETROREFLECTIVITY / INLAID)  
 STA. 495+00 RT - STA. 506+94 RT (SOLID)  
 STA. 508+38 RT - STA. 511+00 RT (DASHED)  
 STA. 495+00 LT - STA. 509+37 LT (SOLID)  
 STA. 8+11 RT - STA. 14+38 RT EXIT 9 RAMP A (SOLID)  
 STA. 13+70 LT - STA. 13+91 LT EXIT 9 RAMP A (SOLID)  
 STA. 1+00 RT - STA. 9+92 RT EXIT 9 RAMP B (SOLID)  
 STA. 509+28 RT - STA. 511+00 RT (SOLID)  
 STA. 1+60 LT - STA. 1+83 LT EXIT 9 RAMP B (SOLID)  
 STA. 2+61 RT - STA. 11+61 RT EXIT 9 RAMP C (SOLID)  
 STA. 10+82 LT - STA. 11+12 LT EXIT 9 RAMP C (SOLID)  
 STA. 1+00 RT - STA. 8+00 RT EXIT 9 RAMP D (SOLID)  
 STA. 2+07 LT - STA. 2+61 LT EXIT 9 RAMP D (SOLID)

646.415 DURABLE 6" YELLOW LINE (MOD. - RETROREFLECTIVITY / INLAID)  
 STA. 495+00 - STA. 511+00 (DOUBLE SOLID CENTERLINE)  
 STA. 8+11 LT - STA. 13+84 LT EXIT 9 RAMP A (SOLID)  
 STA. 13+70 LT - STA. 14+13 LT EXIT 9 RAMP A (SOLID)  
 STA. 1+30 LT - STA. 1+83 LT EXIT 9 RAMP B (SOLID)  
 STA. 1+68 LT - STA. 7+56 LT EXIT 9 RAMP B (SOLID)  
 STA. 4+20 LT - STA. 11+06 LT EXIT 9 RAMP C (SOLID)  
 STA. 10+82 LT - STA. 11+45 LT EXIT 9 RAMP C (SOLID)  
 STA. 2+17 LT - STA. 8+00 LT EXIT 9 RAMP D (SOLID)  
 STA. 1+50 LT - STA. 2+61 LT EXIT 9 RAMP D (SOLID)

646.44 DURABLE 12" WHITE LINE (MOD. - RETROREFLECTIVITY / INLAID)  
 STA. 509+37 LT - STA. 511+00 LT (SOLID)  
 STA. 2+62 LT - STA. 4+20 LT EXIT 9 RAMP C (SOLID)  
 STA. 509+37 LT - STA. 511+00 LT (HATCHED)  
 STA. 506+94 RT - STA. 508+38 RT (SOLID)  
 STA. 7+56 LT - STA. 9+00 LT EXIT 9 RAMP B (SOLID)

646.46 DURABLE 24" STOP BAR (THERMOPLASTIC)  
 STA. 13+85.00 EXIT 9 RAMP A  
 STA. 14+9.00 EXIT 9 RAMP A  
 STA. 11+06.00 EXIT 9 RAMP C  
 STA. 11+33.00 EXIT 9 RAMP C


646.50 DURABLE LETTER OR SYMBOL (THERMOPLASTIC)  
 STA. 11+60.43 EXIT 9 RAMP A "ARROW"  
 STA. 13+91.00 EXIT 9 RAMP A "STOP"  
 STA. 1+71.36 EXIT 9 RAMP B "YIELD TRIANGLES" (5)  
 STA. 5+40.00 EXIT 9 RAMP C "SIGNAL"  
 STA. 5+81.00 EXIT 9 RAMP C "AHEAD"  
 STA. 8+83.11 EXIT 9 RAMP C "ARROW"  
 STA. 11+25.00 EXIT 9 RAMP C "STOP"  
 STA. 2+30.61 EXIT 9 RAMP D "YIELD TRIANGLES" (5)

646.614 TEMPORARY 6" WHITE LINE (PAINT)  
 STA. 495+00 RT - STA. 506+94 RT (SOLID)  
 STA. 508+38 RT - STA. 511+00 RT (DASHED)  
 STA. 495+00 LT - STA. 509+37 LT (SOLID)  
 STA. 8+11 RT - STA. 14+38 RT EXIT 9 RAMP A (SOLID)  
 STA. 13+70 LT - STA. 13+91 LT EXIT 9 RAMP A (SOLID)  
 STA. 1+00 RT - STA. 9+92 RT EXIT 9 RAMP B (SOLID)  
 STA. 509+28 RT - STA. 511+00 RT (SOLID)  
 STA. 1+60 LT - STA. 1+83 LT EXIT 9 RAMP B (SOLID)  
 STA. 2+61 RT - STA. 11+61 RT EXIT 9 RAMP C (SOLID)  
 STA. 10+82 LT - STA. 11+12 LT EXIT 9 RAMP C (SOLID)  
 STA. 1+00 RT - STA. 8+00 RT EXIT 9 RAMP D (SOLID)  
 STA. 2+07 LT - STA. 2+61 LT EXIT 9 RAMP D (SOLID)

646.615 TEMPORARY 6" YELLOW LINE (PAINT)  
 STA. 495+00 - STA. 511+00 (DOUBLE SOLID CENTERLINE)  
 STA. 8+11 LT - STA. 13+84 LT EXIT 9 RAMP A (SOLID)  
 STA. 13+70 LT - STA. 14+13 LT EXIT 9 RAMP A (SOLID)  
 STA. 1+30 LT - STA. 1+83 LT EXIT 9 RAMP B (SOLID)  
 STA. 1+68 LT - STA. 7+56 LT EXIT 9 RAMP B (SOLID)  
 STA. 4+20 LT - STA. 11+06 LT EXIT 9 RAMP C (SOLID)  
 STA. 10+82 LT - STA. 11+45 LT EXIT 9 RAMP C (SOLID)  
 STA. 2+17 LT - STA. 8+00 LT EXIT 9 RAMP D (SOLID)  
 STA. 1+50 LT - STA. 2+61 LT EXIT 9 RAMP D (SOLID)


646.64 TEMPORARY 12" WHITE LINE (PAINT)  
 STA. 509+37 LT - STA. 511+00 LT (SOLID)  
 STA. 2+62 LT - STA. 4+20 LT EXIT 9 RAMP C (SOLID)  
 STA. 509+37 LT - STA. 511+00 LT (HATCHED)  
 STA. 506+94 RT - STA. 508+38 RT (SOLID)  
 STA. 7+56 LT - STA. 9+00 LT EXIT 9 RAMP B (SOLID)

646.66 TEMPORARY 24" STOP BAR (PAINT)  
 STA. 13+85.00 EXIT 9 RAMP A  
 STA. 14+9.00 EXIT 9 RAMP A  
 STA. 11+06.00 EXIT 9 RAMP C  
 STA. 11+33.00 EXIT 9 RAMP C

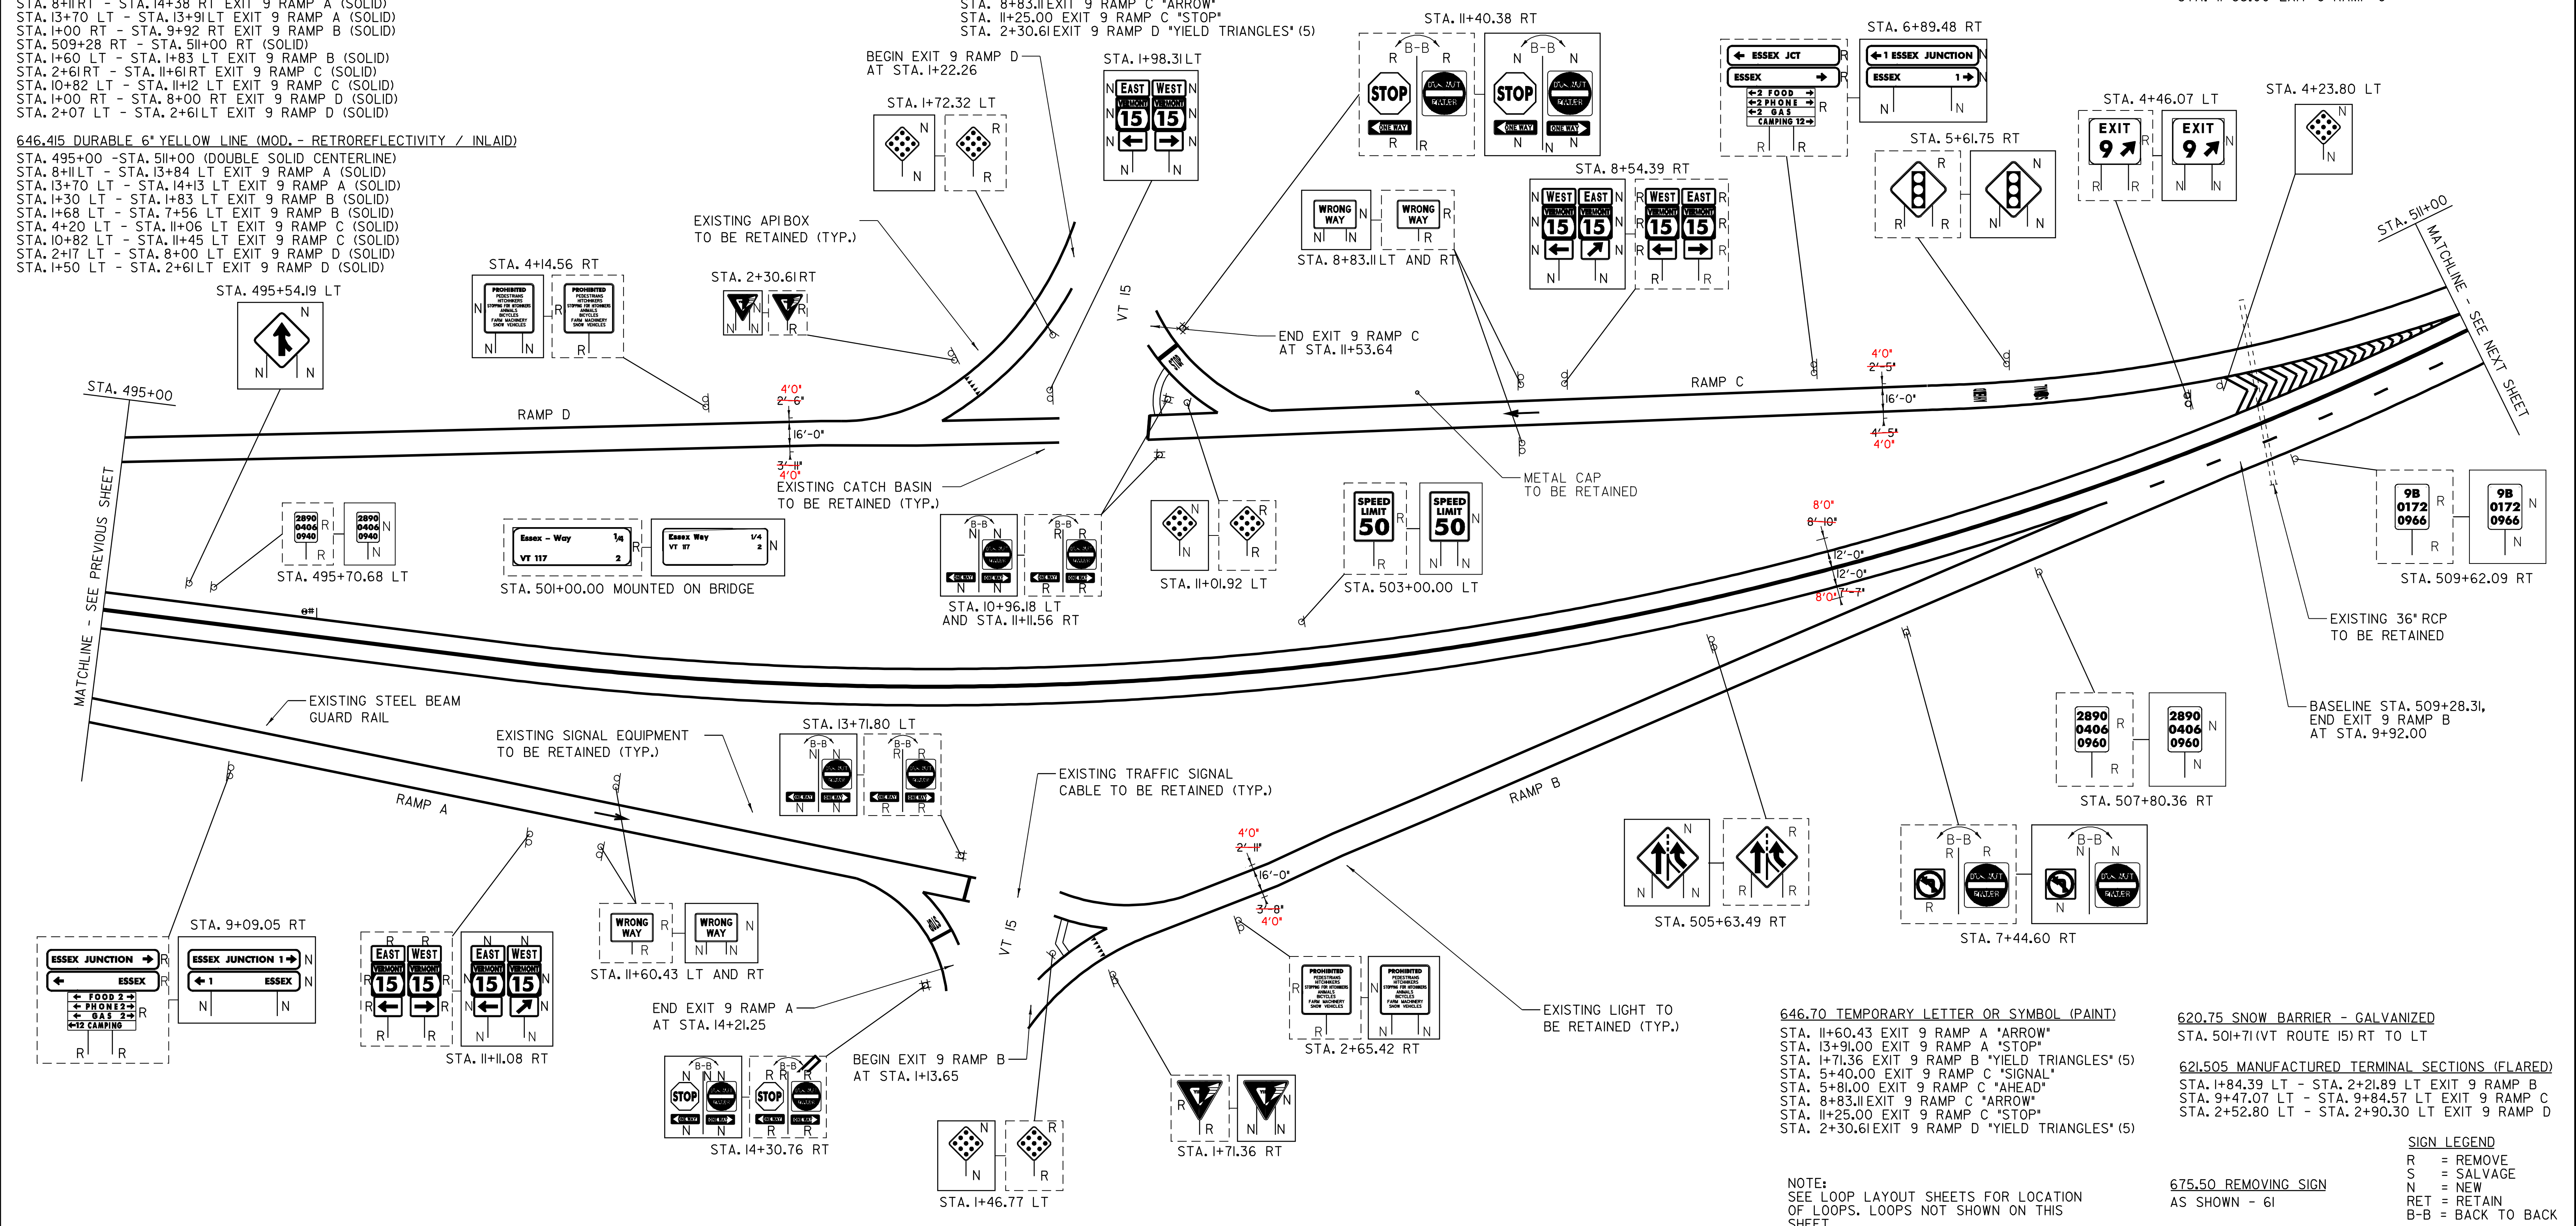

PAVEMENT CORES -		
TOTAL DEPTH		
NO.	(In.)	PCC
1	1.5	W
DATUM		
VERTICAL	N/A	
HORIZONTAL	N/A	

PAVEMENT CORES -		
TOTAL DEPTH		
NO.	(In.)	PCC
1	1.5	W

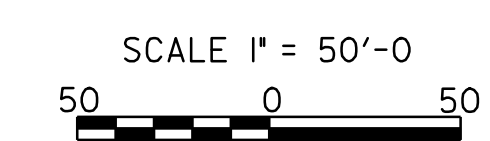

646.70 TEMPORARY LETTER OR SYMBOL (PAINT)  
 STA. 11+60.43 EXIT 9 RAMP A "ARROW"  
 STA. 13+91.00 EXIT 9 RAMP A "STOP"  
 STA. 1+71.36 EXIT 9 RAMP B "YIELD TRIANGLES" (5)  
 STA. 5+40.00 EXIT 9 RAMP C "SIGNAL"  
 STA. 5+81.00 EXIT 9 RAMP C "AHEAD"  
 STA. 8+83.11 EXIT 9 RAMP C "ARROW"  
 STA. 11+25.00 EXIT 9 RAMP C "STOP"  
 STA. 2+30.61 EXIT 9 RAMP D "YIELD TRIANGLES" (5)

620.75 SNOW BARRIER - GALVANIZED  
 STA. 501+71 (VT ROUTE 15) RT TO LT  
 621.505 MANUFACTURED TERMINAL SECTIONS (FLARED)  
 STA. 1+84.39 LT - STA. 2+21.89 LT EXIT 9 RAMP B  
 STA. 9+47.07 LT - STA. 9+84.57 LT EXIT 9 RAMP C  
 STA. 2+52.80 LT - STA. 2+90.30 LT EXIT 9 RAMP D

SIGN LEGEND  
 R = REMOVE  
 S = SALVAGE  
 N = NEW  
 RET = RETAIN  
 B-B = BACK TO BACK

NOTE:  
 SEE LOOP LAYOUT SHEETS FOR LOCATION OF LOOPS. LOOPS NOT SHOWN ON THIS SHEET.

675.50 REMOVING SIGN AS SHOWN - 61

**PROJECT LAYOUT SHEET 5**

PROJECT NAME: ESSEX	PLOT DATE: 23-APR-2009 15:4
PROJECT NUMBER: NH 2403 (1S)	DRAWN BY: SJB, RHB
FILE NAME: pave/04b032/p04b032.dgn	CHECKED BY: EPD
PROJECT LEADER: EPD	SHEET 13 OF 48
DESIGNED BY: JDA	
PLOT FILE: p04b032105.1	