

621.20 STEEL BEAM GUARD RAIL (GALVANIZED)

STA. 511+70.04 LT - STA. 511+82.54 LT
 STA. 518+61.04 LT - STA. 518+73.54 LT

621.505 MANUFACTURED TERMINAL SECTIONS (FLARED)

STA. 511+32.54 LT - STA. 511+70.04 LT
 STA. 511+82.54 LT - STA. 512+20.04 LT
 STA. 518+23.54 RT - STA. 518+61.04 RT
 STA. 518+73.54 RT - STA. 519+11.04 RT
 STA. 5+17.47 LT - STA. 5+54.97 LT EXIT IO RAMP A

646.414 DURABLE 6" WHITE LINE (MOD. - RETROREFLECTIVITY / INLAID)

STA. 511+00 RT - STA. 518+20 RT (SOLID)
 STA. 1+00 RT - STA. 9+00 RT EXIT IO RAMP A (SOLID)
 STA. 511+00 RT - STA. 518+62 RT (DASHED)
 STA. 518+62 RT - STA. 519+13 RT (SOLID)
 STA. 521+01 RT - STA. 526+00 RT (SOLID)
 STA. 511+00 LT - STA. 511+64 LT (SOLID)
 STA. 511+64 LT - STA. 518+25 LT (DASHED)
 STA. 518+25 LT - STA. 518+75 LT (SOLID)
 STA. 519+38 LT - STA. 526+00 LT (SOLID)
 STA. 1+00 RT - STA. 2+61 RT EXIT 9 RAMP C (SOLID)
 STA. 512+63 LT - STA. 517+61.34 LT (SOLID)
 STA. 2+75 RT - STA. 11+07 RT EXIT IO RAMP D (SOLID)
 STA. 3+09 LT - STA. 3+50 LT EXIT IO RAMP D (SOLID)

646.415 DURABLE 6" YELLOW LINE (MOD. - RETROREFLECTIVITY / INLAID)

STA. 511+00 - STA. 526+00 (DOUBLE SOLID CENTERLINE)
 STA. 3+80 LT - STA. 8+81 LT EXIT IO RAMP A (SOLID)
 STA. 3+18 LT - STA. 9+33 LT EXIT IO RAMP D (SOLID)
 STA. 2+90 LT - STA. 3+50 LT EXIT IO RAMP D (SOLID)

646.44 DURABLE 12" WHITE LINE (MOD. - RETROREFLECTIVITY / INLAID)

STA. 519+13 RT - STA. 521+01 RT (SOLID)
 STA. 1+92 LT - STA. 3+84 LT EXIT IO RAMP A (SOLID)
 STA. 519+13 RT - STA. 521+01 RT (HATCHED)
 STA. 518+75 LT - STA. 519+38 LT (SOLID)
 STA. 9+33 LT - STA. 9+95 LT EXIT IO RAMP D (SOLID)

646.50 DURABLE LETTER OR SYMBOL (THERMOPLASTIC)

STA. 3+94.00 EXIT IO RAMP A "SIGNAL"
 STA. 4+46.00 EXIT IO RAMP A "AHEAD"
 STA. 7+21.00 EXIT IO RAMP A "ARROW"
 STA. 3+48.24 EXIT IO RAMP D "YIELD TRIANGLES" (5)

646.614 TEMPORARY 6" WHITE LINE (PAINT)

STA. 511+00 RT - STA. 518+20 RT (SOLID)
 STA. 1+00 RT - STA. 9+00 RT EXIT IO RAMP A (SOLID)
 STA. 511+00 RT - STA. 518+62 RT (DASHED)
 STA. 518+62 RT - STA. 519+13 RT (SOLID)
 STA. 521+01 RT - STA. 526+00 RT (SOLID)
 STA. 511+00 LT - STA. 511+64 LT (SOLID)
 STA. 511+64 LT - STA. 518+25 LT (DASHED)
 STA. 518+25 LT - STA. 518+75 LT (SOLID)
 STA. 519+38 LT - STA. 526+00 LT (SOLID)
 STA. 1+00 RT - STA. 2+61 RT EXIT 9 RAMP C (SOLID)
 STA. 512+63 LT - STA. 517+61.34 LT (SOLID)
 STA. 2+75 RT - STA. 11+07 RT EXIT IO RAMP D (SOLID)
 STA. 3+09 LT - STA. 3+50 LT EXIT IO RAMP D (SOLID)

646.615 TEMPORARY 6" YELLOW LINE (PAINT)

STA. 511+00 - STA. 526+00 (DOUBLE SOLID CENTERLINE)
 STA. 3+80 LT - STA. 8+81 LT EXIT IO RAMP A (SOLID)
 STA. 3+18 LT - STA. 9+33 LT EXIT IO RAMP D (SOLID)
 STA. 2+90 LT - STA. 3+50 LT EXIT IO RAMP D (SOLID)

646.64 TEMPORARY 12" WHITE LINE (PAINT)


STA. 519+13 RT - STA. 521+01 RT (SOLID)
 STA. 1+92 LT - STA. 3+84 LT EXIT IO RAMP A (SOLID)
 STA. 519+13 RT - STA. 521+01 RT (HATCHED)
 STA. 518+75 LT - STA. 519+38 LT (SOLID)
 STA. 9+33 LT - STA. 9+95 LT EXIT IO RAMP D (SOLID)

646.70 TEMPORARY LETTER OR SYMBOL (PAINT)

STA. 3+94.00 EXIT IO RAMP A "SIGNAL"
 STA. 4+46.00 EXIT IO RAMP A "AHEAD"
 STA. 7+21.00 EXIT IO RAMP A "ARROW"
 STA. 3+48.24 EXIT IO RAMP D "YIELD TRIANGLES" (5)

675.50 REMOVING SIGN

AS SHOWN - 31

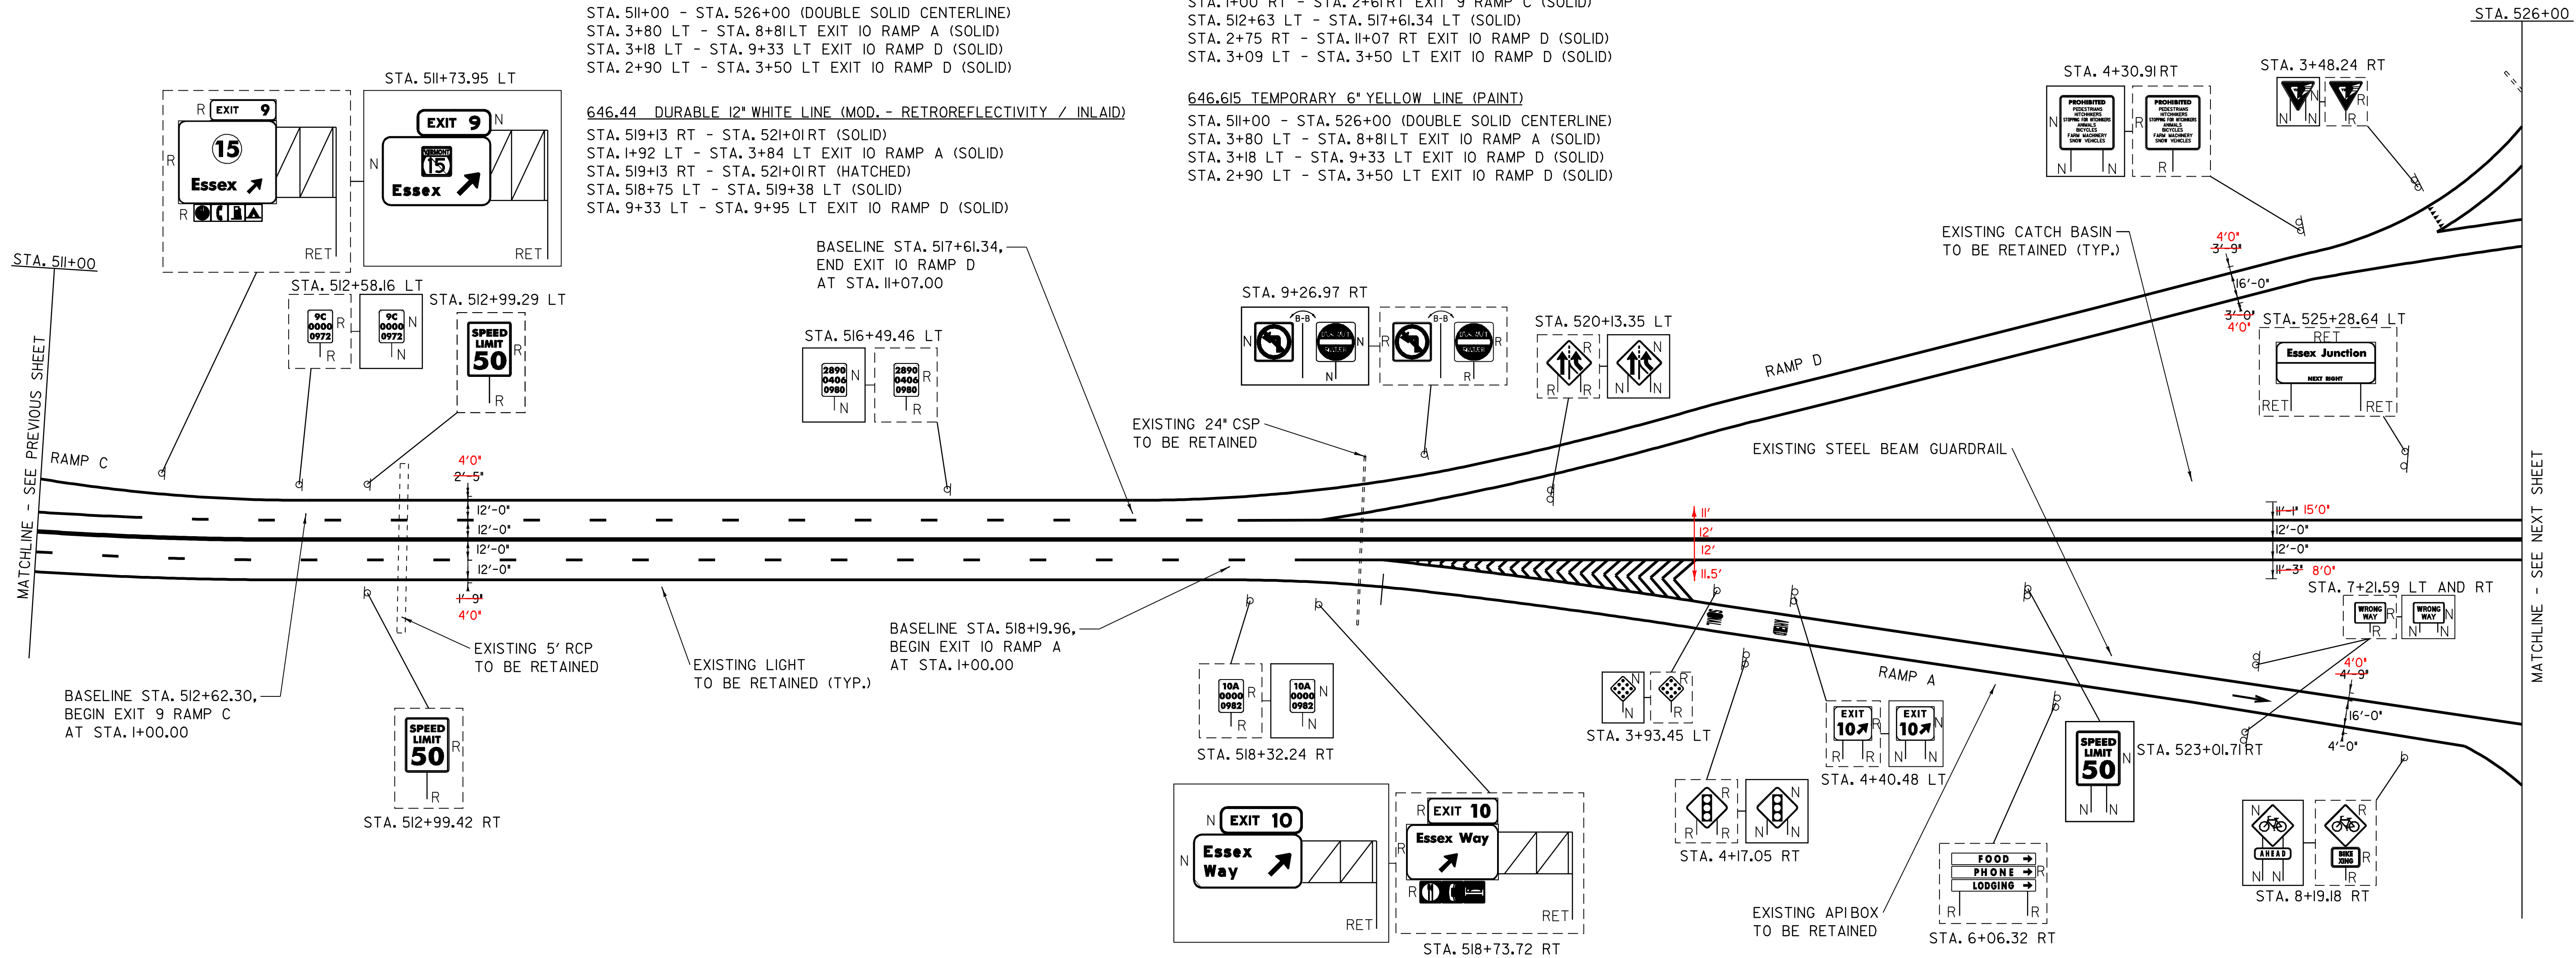

MATCHLINE - SEE NEXT SHEET


MATCHLINE - SEE PREVIOUS SHEET

SIGN LEGEND

- R = REMOVE
- S = SALVAGE
- N = NEW
- RET = RETAIN
- B-B = BACK TO BACK

DATUM

VERTICAL	N/A
HORIZONTAL	N/A

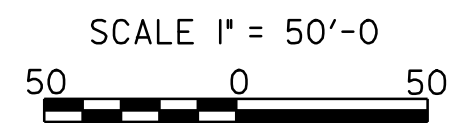

PROJECT LAYOUT SHEET 6	PROJECT NAME: ESSEX	PLOT DATE: 23-APR-2009 15:4
	PROJECT NUMBER: NH 2403 (1)S	DRAWN BY: SJB, RHB
	FILE NAME: pave/04b032/p04b032.dgn	CHECKED BY: EPD
	DESIGNED BY: JDA	SHEET 14 OF 48
	PLOT FILE: p04b032106.l	