

621.505 MANUFACTURED TERMINAL SECTIONS (FLARED)

STA. 549+77.75 RT - STA. 550+15.25 RT

646.414 DURABLE 6" WHITE LINE (MOD. - RETROREFLECTIVITY / INLAID)

STA. 541+00 RT - STA. 557+00 RT (SOLID)

STA. 541+00 RT - STA. 542+25 RT (DASHED)

STA. 541+00 LT - STA. 557+00 LT (SOLID)

STA. 541+00 LT - STA. 542+00 LT (DOTTED)

646.415 DURABLE 6" YELLOW LINE (MOD. - RETROREFLECTIVITY / INLAID)

STA. 541+00 - STA. 556+05 (DOUBLE SOLID CENTERLINE)

STA. 556+05 - STA. 557+00 (SOLID LT, DASHED RT)

604.412 REHABING DI, CB OR MH CLASS. I

STA. 552+92.60 RT

STA. 556+44.52 RT

646.614 TEMPORARY 6" WHITE LINE (PAINT)

STA. 541+00 RT - STA. 557+00 RT (SOLID)

STA. 541+00 RT - STA. 542+25 RT (DASHED)

STA. 541+00 LT - STA. 557+00 LT (SOLID)

STA. 541+00 LT - STA. 542+00 LT (DOTTED)


646.615 TEMPORARY 6" YELLOW LINE (PAINT)

STA. 541+00 - STA. 556+05 (DOUBLE SOLID CENTERLINE)

STA. 556+05 - STA. 557+00 (SOLID LT, DASHED RT)

675.50 REMOVING SIGN

AS SHOWN - 10

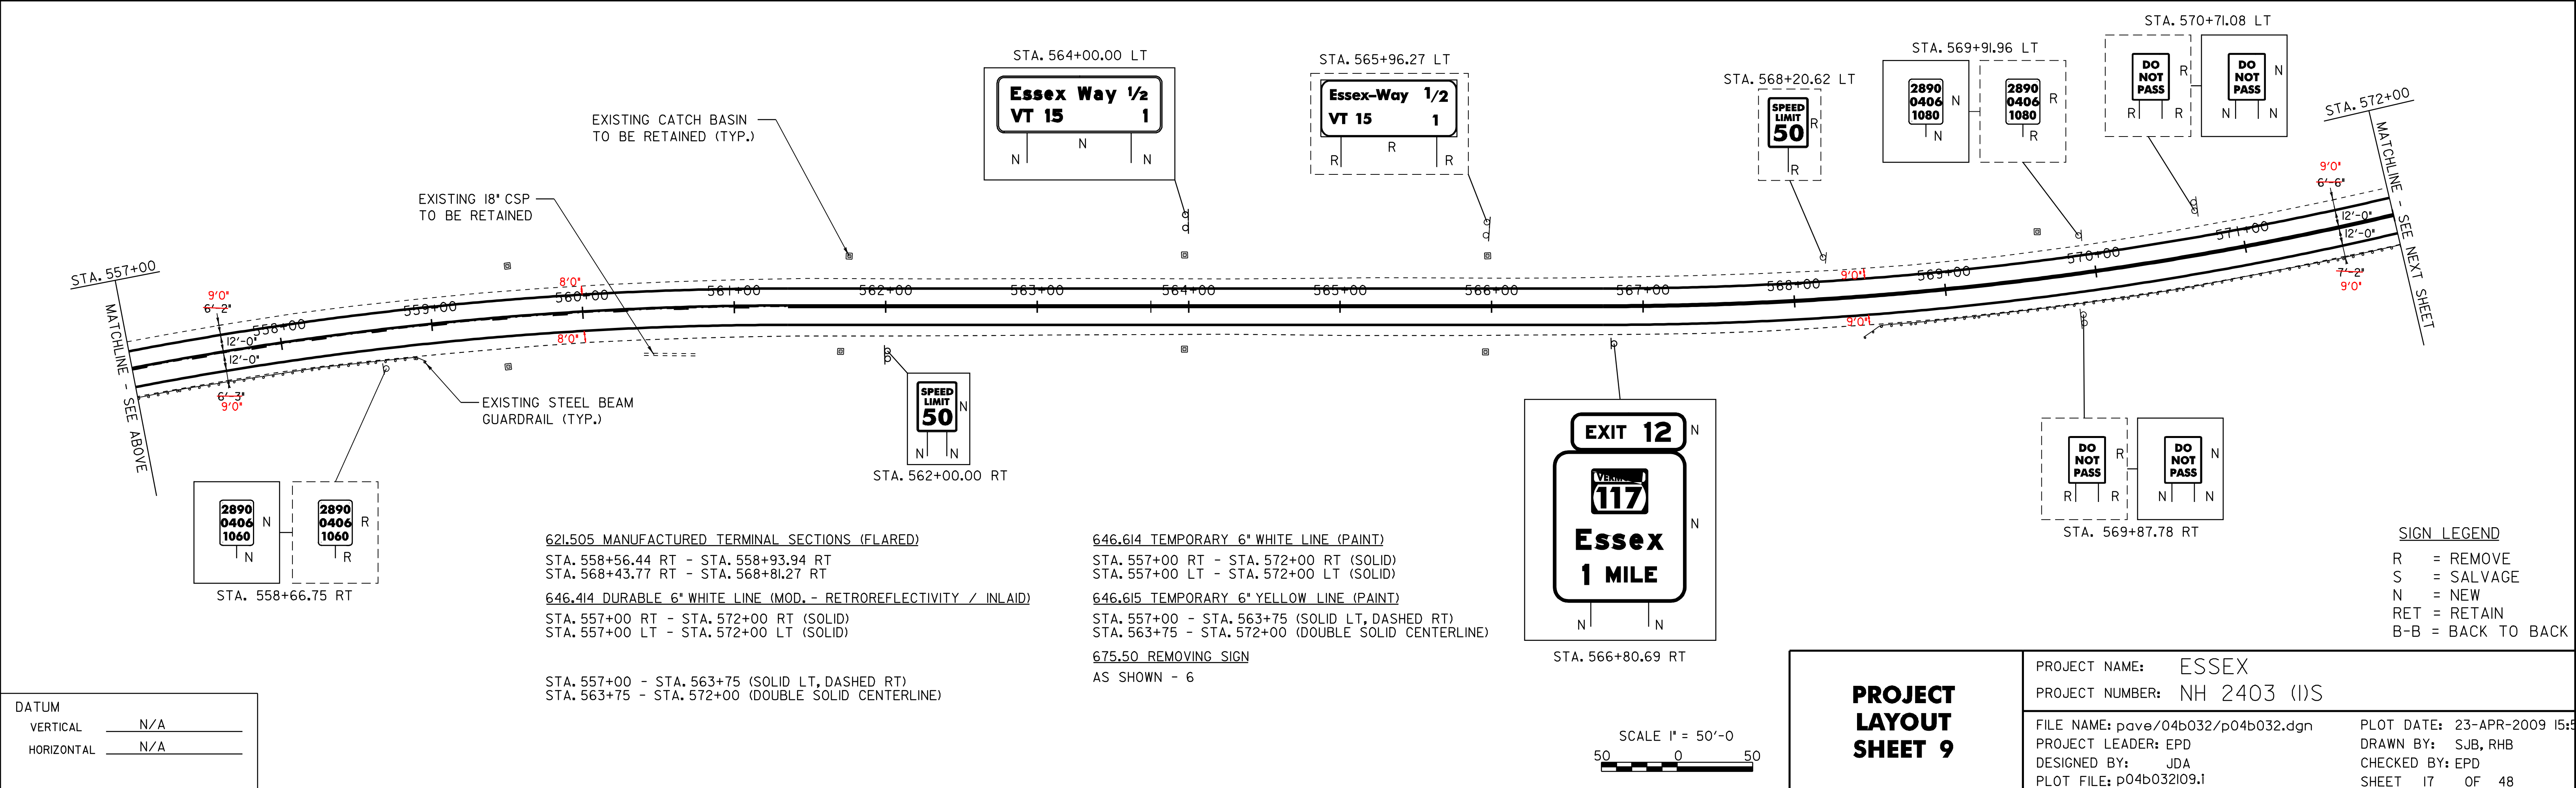

621.505 MANUFACTURED TERMINAL SECTIONS (FLARED)

STA. 558+56.44 RT - STA. 558+93.94 RT

STA. 568+43.77 RT - STA. 568+81.27 RT

646.414 DURABLE 6" WHITE LINE (MOD. - RETROREFLECTIVITY / INLAID)

STA. 557+00 RT - STA. 572+00 RT (SOLID)

STA. 557+00 LT - STA. 572+00 LT (SOLID)

STA. 557+00 - STA. 563+75 (SOLID LT, DASHED RT)

STA. 563+75 - STA. 572+00 (DOUBLE SOLID CENTERLINE)

646.614 TEMPORARY 6" WHITE LINE (PAINT)

STA. 557+00 RT - STA. 572+00 RT (SOLID)

STA. 557+00 LT - STA. 572+00 LT (SOLID)

646.615 TEMPORARY 6" YELLOW LINE (PAINT)

STA. 557+00 - STA. 563+75 (SOLID LT, DASHED RT)

STA. 563+75 - STA. 572+00 (DOUBLE SOLID CENTERLINE)

675.50 REMOVING SIGN

AS SHOWN - 6

SIGN LEGEND

R = REMOVE

S = SALVAGE

N = NEW

RET = RETAIN

B-B = BACK TO BACK

DATUM

VERTICAL N/A

HORIZONTAL N/A

PROJECT LAYOUT SHEET 9

PROJECT NAME: ESSEX

PROJECT NUMBER: NH 2403 (IS)

FILE NAME: pave/04b032/p04b032.dgn

PROJECT LEADER: EPD

DESIGNED BY: JDA

PLOT FILE: p04b032109.i

PLOT DATE: 23-APR-2009 15:5

DRAWN BY: SJB, RHB

CHECKED BY: EPD

SHEET 17 OF 48

