

EXISTING PAVED AREA FOR FUTURE EXIT RAMP. THESE AREAS WILL NOT BE PAVED AS PART OF THIS PROJECT. CONTRACTOR WILL USE A BUTT JOINT WHERE THE SHOULDER MEETS THESE TWO AREAS. SEE THE BUTT JOINT, DETAIL ON TYPICAL SECTIONS SHEET FOR DETAILS.

EXISTING STEEL BEAM GUARDRAIL (TYP.)

EXISTING CATCH BASIN TO BE RETAINED (TYP.)

- 646.414 DURABLE 6" WHITE LINE (MOD. - RETROREFLECTIVITY / INLAID)
 - STA. 572+00 RT - STA. 577+60 RT (SOLID)
 - STA. 577+60 RT - STA. 579+80 RT (DOTTED)
 - STA. 579+80 RT - STA. 580+92 RT (DASHED)
 - STA. 581+92 RT - STA. 584+80 RT (SOLID)
 - STA. 585+35 RT - STA. 604+00 RT (SOLID)
 - STA. 572+00 LT - STA. 604+00 LT (SOLID)
- 646.415 DURABLE 6" YELLOW LINE (MOD. - RETROREFLECTIVITY / INLAID)
 - STA. 572+00 - STA. 604+00 (DOUBLE SOLID CENTERLINE)
 - STA. 581+92 RT - STA. 584+80 RT (PULL OFF)
- 646.44 DURABLE 12" WHITE LINE (MOD. - RETROREFLECTIVITY / INLAID)
 - STA. 580+92 RT - STA. 581+92 RT (SOLID)
 - STA. 581+00 RT - STA. 581+92 RT PULL OFF (SOLID)
 - STA. 581+00 RT - STA. 581+92 RT (HATCHED)
- 646.46 DURABLE 24" STOP BAR (THERMOPLASTIC)
 - STA. 584+80 RT - STA. 585+20 RT
- 646.50 DURABLE LETTER OR SYMBOL (THERMOPLASTIC)
 - STA. 582+24 RT PULL OFF "STOP"
 - STA. 582+56 RT PULL OFF "AHEAD"
 - STA. 584+00 RT PULL OFF "ARROW"
 - STA. 585+00 RT PULL OFF "STOP"

- 646.614 TEMPORARY 6" WHITE LINE (PAINT)
 - STA. 572+00 RT - STA. 577+60 RT (SOLID)
 - STA. 577+60 RT - STA. 579+80 RT (DOTTED)
 - STA. 579+80 RT - STA. 580+92 RT (DASHED)
 - STA. 581+92 RT - STA. 584+80 RT (SOLID)
 - STA. 585+35 RT - STA. 604+00 RT (SOLID)
 - STA. 572+00 LT - STA. 604+00 LT (SOLID)
- 646.615 TEMPORARY 6" YELLOW LINE (PAINT)
 - STA. 572+00 - STA. 604+00 (DOUBLE SOLID CENTERLINE)
 - STA. 581+92 RT - STA. 584+80 RT (PULL OFF)
- 646.64 TEMPORARY 12" WHITE LINE (PAINT)
 - STA. 580+92 RT - STA. 581+92 RT (SOLID)
 - STA. 581+00 RT - STA. 581+92 RT PULL OFF (SOLID)
 - STA. 581+00 RT - STA. 581+92 RT (HATCHED)
- 646.66 TEMPORARY 24" STOP BAR (PAINT)
 - STA. 584+80 RT - STA. 585+20 RT
- 646.70 TEMPORARY LETTER OR SYMBOL (PAINT)
 - STA. 582+24 RT PULL OFF "STOP"
 - STA. 582+56 RT PULL OFF "AHEAD"
 - STA. 584+00 RT PULL OFF "ARROW"
 - STA. 585+00 RT PULL OFF "STOP"


675.50 REMOVING SIGN AS SHOWN - II

621.505 MANUFACTURED TERMINAL SECTIONS (FLARED)

- STA. 578+12.89 RT - STA. 578+50.39 RT
- STA. 583+43.15 RT - STA. 583+80.65 RT
- STA. 587+67.94 RT - STA. 588+05.44 RT

SIGN LEGEND
 R = REMOVE
 S = SALVAGE
 N = NEW
 RET = RETAIN
 B-B = BACK TO BACK

DATUM	
VERTICAL	N/A
HORIZONTAL	N/A

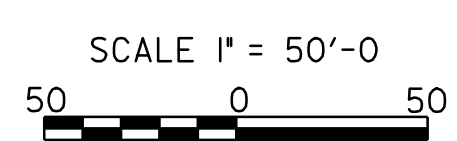

PROJECT LAYOUT SHEET 10	PROJECT NAME: ESSEX	PLOT DATE: 23-APR-2009 15:59
	PROJECT NUMBER: NH 2403 (1)S	DRAWN BY: SJB, RHB
	FILE NAME: pave/04b032/p04b032.dgn	CHECKED BY: EPD
	DESIGNED BY: JDA	SHEET 18 OF 48