

646.414 DURABLE 6" WHITE LINE (MOD. - RETROREFLECTIVITY / INLAID)

STA. 604+00 RT - STA. 620+00 RT (SOLID)
 STA. 604+00 LT - STA. 620+00 LT (SOLID)

646.415 DURABLE 6" YELLOW LINE (MOD. - RETROREFLECTIVITY / INLAID)

STA. 604+00 - STA. 615+00 (DOUBLE SOLID CENTERLINE)
 STA. 615+00 RT - STA. 620+00 RT (DOUBLE SOLID CENTERLINE)
 STA. 615+00 LT - STA. 620+00 LT (DOUBLE SOLID CENTERLINE)

646.45 DURABLE 12" YELLOW LINE (MOD. - RETROREFLECTIVITY / INLAID)

STA. 615+00 CL - STA. 620+00 CL (HATCHED)

646.614 TEMPORARY 6" WHITE LINE (PAINT)

STA. 604+00 RT - STA. 620+00 RT (SOLID)
 STA. 604+00 LT - STA. 620+00 LT (SOLID)

646.615 TEMPORARY 6" YELLOW LINE (PAINT)

STA. 604+00 - STA. 615+00 (DOUBLE SOLID CENTERLINE)
 STA. 615+00 RT - STA. 620+00 RT (DOUBLE SOLID CENTERLINE)
 STA. 615+00 LT - STA. 620+00 LT (DOUBLE SOLID CENTERLINE)

646.65 TEMPORARY 12" YELLOW LINE (PAINT)

STA. 615+00 CL - STA. 620+00 CL (HATCHED)

675.50 REMOVING SIGN

AS SHOWN - 6


678.16 FLASHING BEACON - GROUND MOUNTED (MOD.)

STA. 606+17.78 RT (2)

SIGN LEGEND

- R = REMOVE
- S = SALVAGE
- N = NEW
- RET = RETAIN
- B-B = BACK TO BACK

DATUM	
VERTICAL	N/A
HORIZONTAL	N/A

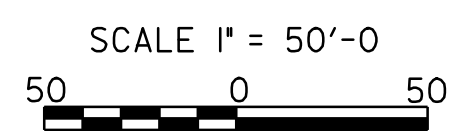

PROJECT LAYOUT SHEET 11

PROJECT NAME: ESSEX
 PROJECT NUMBER: NH 2403 (1)S

FILE NAME: pave/04b032/p04b032.dgn
 PROJECT LEADER: EPD
 DESIGNED BY: JDA
 PLOT FILE: p04b032III.I

PLOT DATE: 23-APR-2009 15:5
 DRAWN BY: SJB, RHB
 CHECKED BY: EPD
 SHEET 19 OF 48