

VT ROUTE 289
 STA. 624+54.50 = M.M. 11.829
 END PROJECT NH 2403 (I)S

STA. 14+47.07 LT
 STA. 15+02.67 LT

STA. 14+91.32 RT
 (B-B) (B-B)

STA. 621+95.75 LT
 12B 0273 1178

BASELINE STA. 621+93.71,
 END EXIT I2 RAMP B
 AT STA. 16+14.00

STA. 621+40.60 CENTER
 621+40
 57' PAVED
 (4' LT - 14' -
 23' ISLAND -
 12' - 4' RT)

623+00
 77' PAVED
 (4' LT - 17' -
 35' ISLAND -
 17' - 4' RT)

BASELINE STA. 623+03.83,
 BEGIN EXIT I2 RAMP D
 AT STA. 1+00.00

STA. 622+84.84 RT
 12D 0000 1180
 2890 0406 1180

STA. 621+35.87 CENTER
 STA. 622+16.52 CENTER
 STA. 622+91.00 CENTER

NOTE:

- SEE LOOP LAYOUT SHEETS FOR LOCATIONS OF LOOPS. LOOPS NOT SHOWN ON THIS SHEET.
- THE CONTRACTOR SHALL COLD PLANE AND PAVE THE RAMPS SO AS TO PREVENT THE PONDING OF WATER AT THE END OF RAMP AGAINST THE VT. 117 SHOULDER.

621.505 MANUFACTURED TERMINAL SECTIONS (FLARED)
 STA. 1+55.19 RT - STA. 1+92.69 RT EXIT I2 RAMP B
 STA. 7+35.04 RT - STA. 7+72.54 RT EXIT I2 RAMP B
 STA. 9+84.92 RT - STA. 10+22.42 RT EXIT I2 RAMP B

604.412 REHABING DICB OR MH CLASS I
 STA. 13+33.89 RT EXIT I2 RAMP D
 STA. 1+85.45 RT EXIT I2 RAMP B

646.414 DURABLE 6" WHITE LINE (MOD. - RETROREFLECTIVITY / INLAID)
 STA. 620+00 RT - STA. 623+03.05 RT (SOLID)
 STA. 620+00 LT - STA. 621+93.71 LT (SOLID)
 STA. 1+14 RT - STA. 16+14 RT EXIT I2 RAMP B (SOLID)
 STA. 2+40 LT - STA. 3+15 LT EXIT I2 RAMP B (SOLID)
 STA. 1+00 RT - STA. 13+42 RT EXIT I2 RAMP D (SOLID)
 STA. 12+93 RT - STA. 13+42 RT EXIT I2 RAMP D (SOLID)

646.415 DURABLE 6" YELLOW LINE (MOD. - RETROREFLECTIVITY / INLAID)
 STA. 620+00 RT - STA. 623+03.05 RT (DOUBLE SOLID)
 STA. 620+00 LT - STA. 621+93.71 LT (DOUBLE SOLID)
 STA. 1+00 LT - STA. 2+55 LT EXIT I2 RAMP D (DOUBLE SOLID)
 STA. 2+55 LT - STA. 13+42 LT EXIT I2 RAMP D (SOLID)
 STA. 12+93 RT - STA. 13+46 RT EXIT I2 RAMP D (SOLID)
 STA. 1+58 LT - STA. 3+15 LT EXIT I2 RAMP B (SOLID)
 STA. 2+48 LT - STA. 14+95 LT EXIT I2 RAMP B (SOLID)
 STA. 14+95 LT - STA. 16+14 LT EXIT I2 RAMP B (DOUBLE SOLID)

646.45 DURABLE 12" YELLOW LINE (MOD. - RETROREFLECTIVITY / INLAID)
 STA. 620+00 CL - STA. 624+54.5 CL (HATCHED)

646.614 TEMPORARY 6" WHITE LINE (PAINT)
 STA. 620+00 RT - STA. 623+03.05 RT (SOLID)
 STA. 620+00 LT - STA. 621+93.71 LT (SOLID)
 STA. 1+14 RT - STA. 16+14 RT EXIT I2 RAMP B (SOLID)
 STA. 2+40 LT - STA. 3+15 LT EXIT I2 RAMP B (SOLID)
 STA. 1+00 RT - STA. 13+42 RT EXIT I2 RAMP D (SOLID)
 STA. 12+93 RT - STA. 13+42 RT EXIT I2 RAMP D (SOLID)

646.615 TEMPORARY 6" YELLOW LINE (PAINT)
 STA. 620+00 RT - STA. 623+03.05 RT (DOUBLE SOLID)
 STA. 620+00 LT - STA. 621+93.71 LT (DOUBLE SOLID)
 STA. 1+00 LT - STA. 2+55 LT EXIT I2 RAMP D (DOUBLE SOLID)
 STA. 2+55 LT - STA. 13+42 LT EXIT I2 RAMP D (SOLID)
 STA. 12+93 RT - STA. 13+46 RT EXIT I2 RAMP D (SOLID)
 STA. 1+58 LT - STA. 3+15 LT EXIT I2 RAMP B (SOLID)
 STA. 2+48 LT - STA. 14+95 LT EXIT I2 RAMP B (SOLID)
 STA. 14+95 LT - STA. 16+14 LT EXIT I2 RAMP B (DOUBLE SOLID)

646.65 TEMPORARY 12" YELLOW LINE (PAINT)
 STA. 620+00 CL - STA. 624+55 CL (HATCHED)

646.46 DURABLE 24" STOP BAR (THERMOPLASTIC)
 STA. 13+46.00 EXIT I2 RAMP D

646.66 TEMPORARY 24" STOP BAR (PAINT)
 STA. 13+46.00 EXIT I2 RAMP D

646.50 DURABLE LETTER OR SYMBOL (THERMOPLASTIC)
 STA. 5+72.00 EXIT I2 RAMP D "SIGNAL"
 STA. 6+12.00 EXIT I2 RAMP D "AHEAD"
 STA. 9+91.89 EXIT I2 RAMP D "ARROW"
 STA. 13+10.00 EXIT I2 RAMP D "ONLY"
 STA. 13+30.00 EXIT I2 RAMP D "LEFT ARROW"
 STA. 13+37.00 EXIT I2 RAMP D "YIELD TRIANGLES" (5)
 STA. 3+11.26 EXIT I2 RAMP B "YIELD TRIANGLES" (5)

646.70 TEMPORARY LETTER OR SYMBOL (PAINT)
 STA. 5+72.00 EXIT I2 RAMP D "SIGNAL"
 STA. 6+12.00 EXIT I2 RAMP D "AHEAD"
 STA. 9+91.98 EXIT I2 RAMP D "ARROW"
 STA. 13+10.00 EXIT I2 RAMP D "ONLY"
 STA. 13+30.00 EXIT I2 RAMP D "LEFT ARROW"
 STA. 13+37.00 EXIT I2 RAMP D "YIELD TRIANGLES" (5)
 STA. 3+11.26 EXIT I2 RAMP B "YIELD TRIANGLES" (5)


675.50 REMOVING SIGN
 AS SHOWN - 43

SIGN LEGEND

R	= REMOVE
S	= SALVAGE
N	= NEW
RET	= RETAIN
B-B	= BACK TO BACK

DATUM

VERTICAL	N/A
HORIZONTAL	N/A

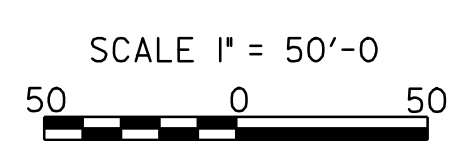

PROJECT LAYOUT SHEET 12

PROJECT NAME: ESSEX
 PROJECT NUMBER: NH 2403 (I)S

FILE NAME: pave/04b032/p04b032.dgn
 PROJECT LEADER: EPD
 DESIGNED BY: JDA
 PLOT FILE: p04b032i12.i

PLOT DATE: 23-APR-2009 15:59
 DRAWN BY: SJB, RHB
 CHECKED BY: EPD
 SHEET 20 OF 48