



**STA. 436+03.84**  
LT POST LENGTH 19'-6"  
RT POST LENGTH 17'-6"

EDGE LINE

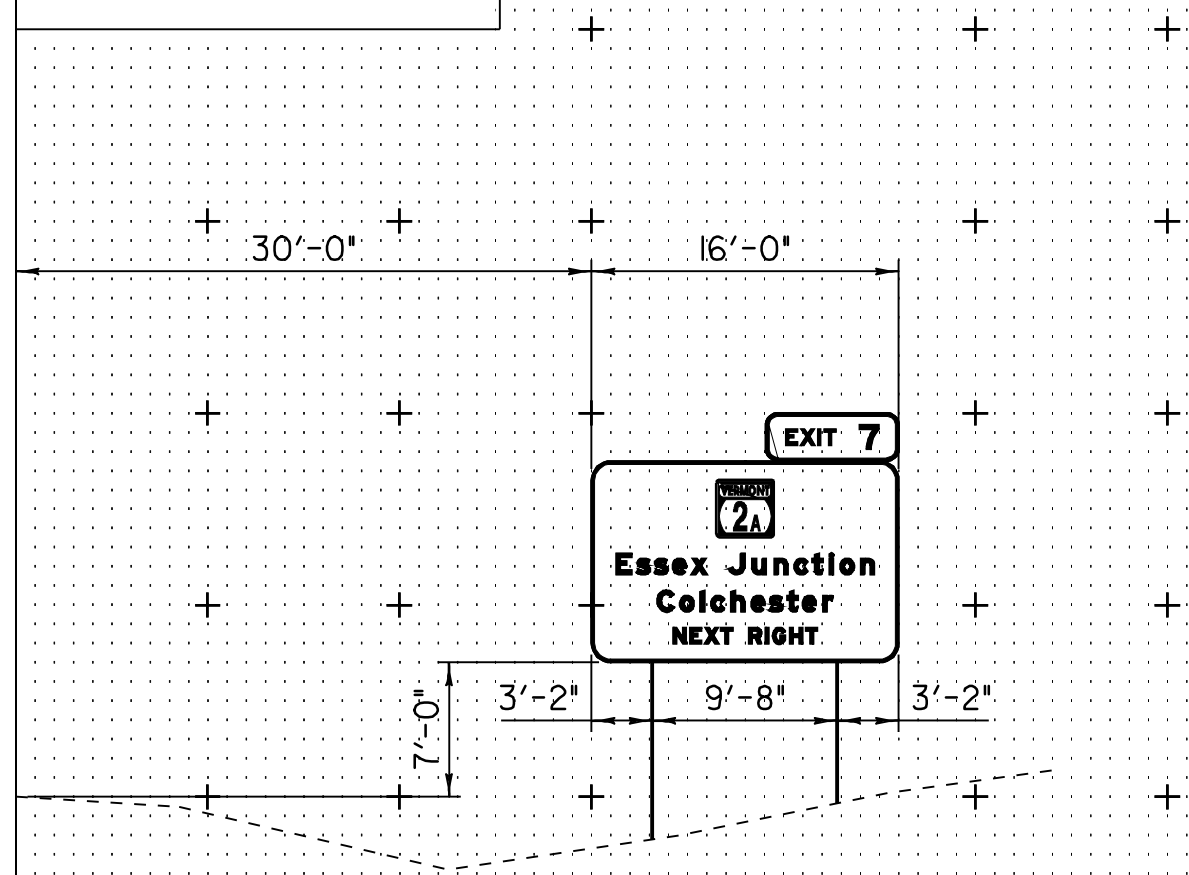


**STA. 481+93.67**  
LT POST LENGTH 20'-6"  
RT POST LENGTH 20'-6"

EDGE LINE

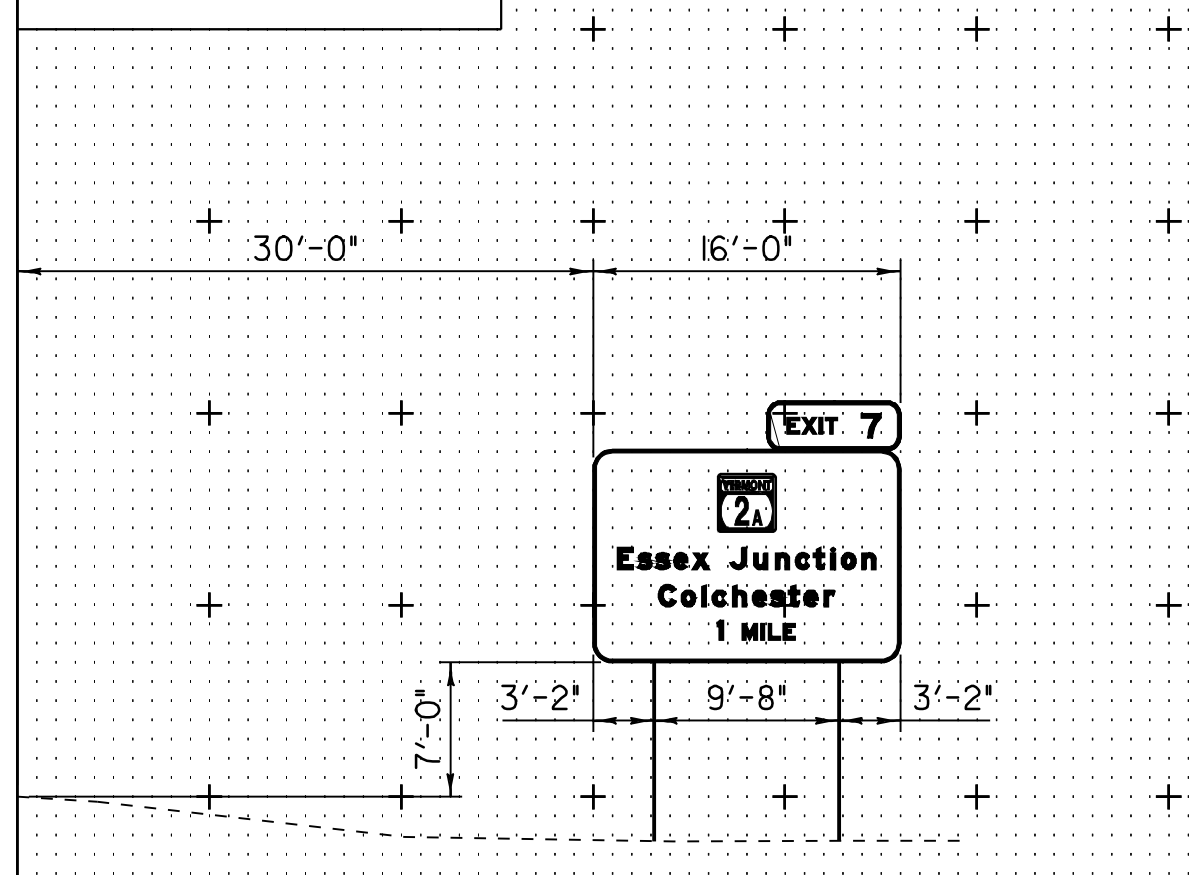


**STA. 566+80.69**  
LT POST LENGTH 18'-0"  
RT POST LENGTH 16'-6"

EDGE LINE

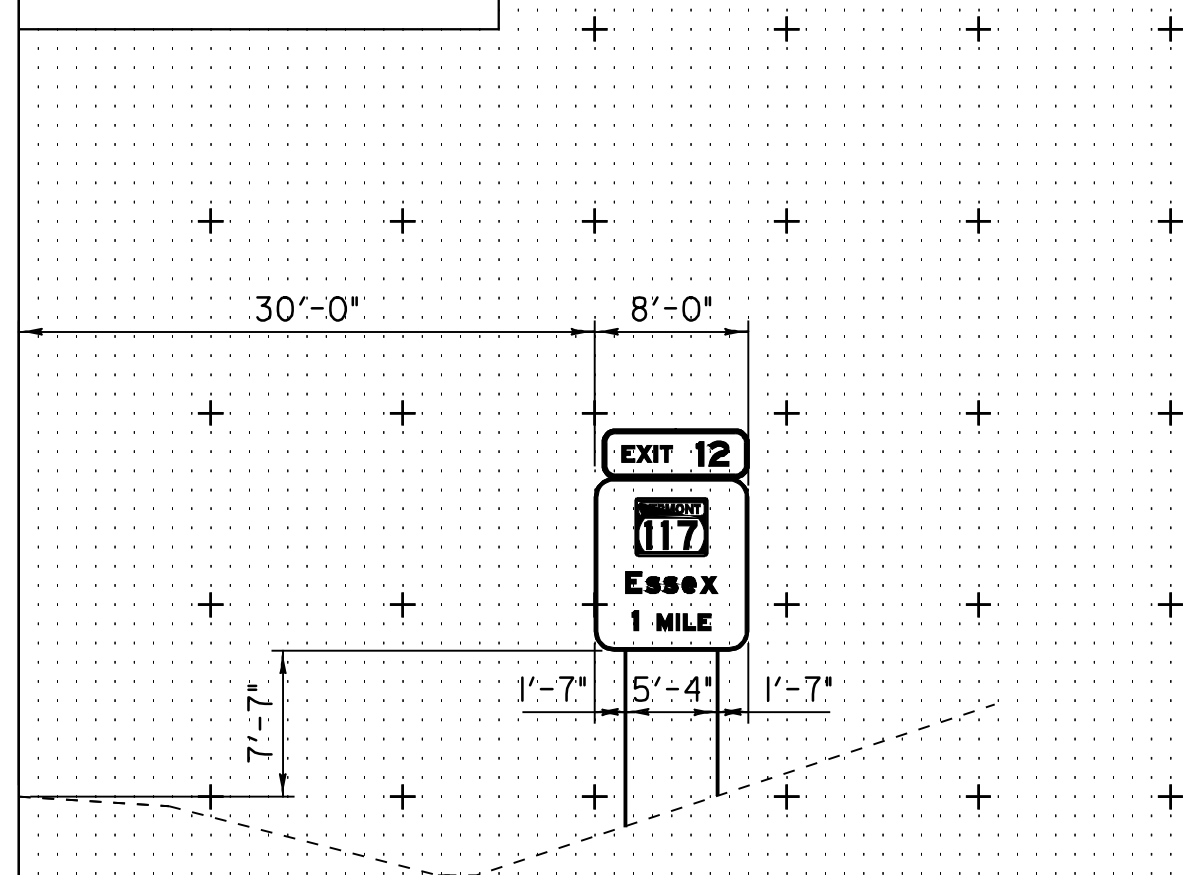


**STA. 618+02.23**  
LT POST LENGTH 15'-6"  
RT POST LENGTH 12'-6"

EDGE LINE

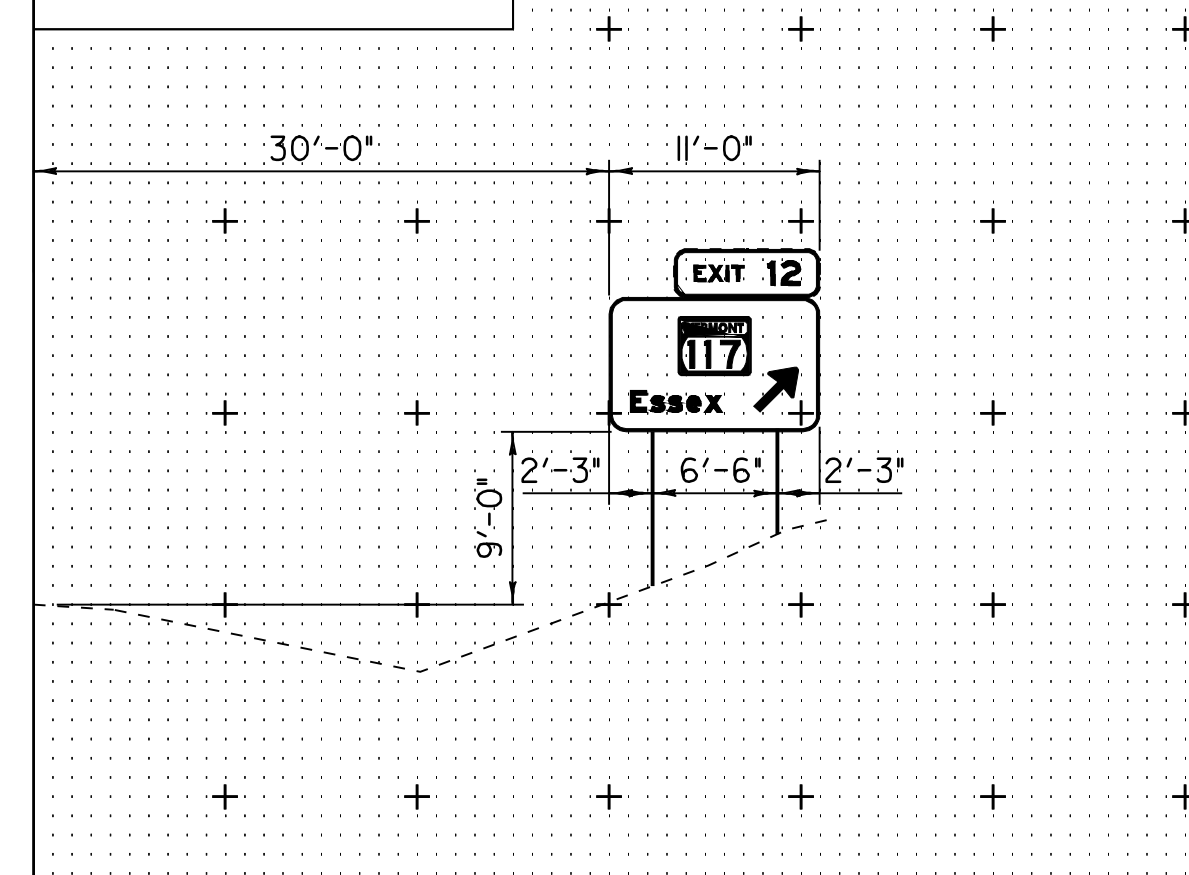


**STA. 437+07.43**  
LT POST LENGTH 11'-6"  
RT POST LENGTH 11'-0"

EDGE LINE

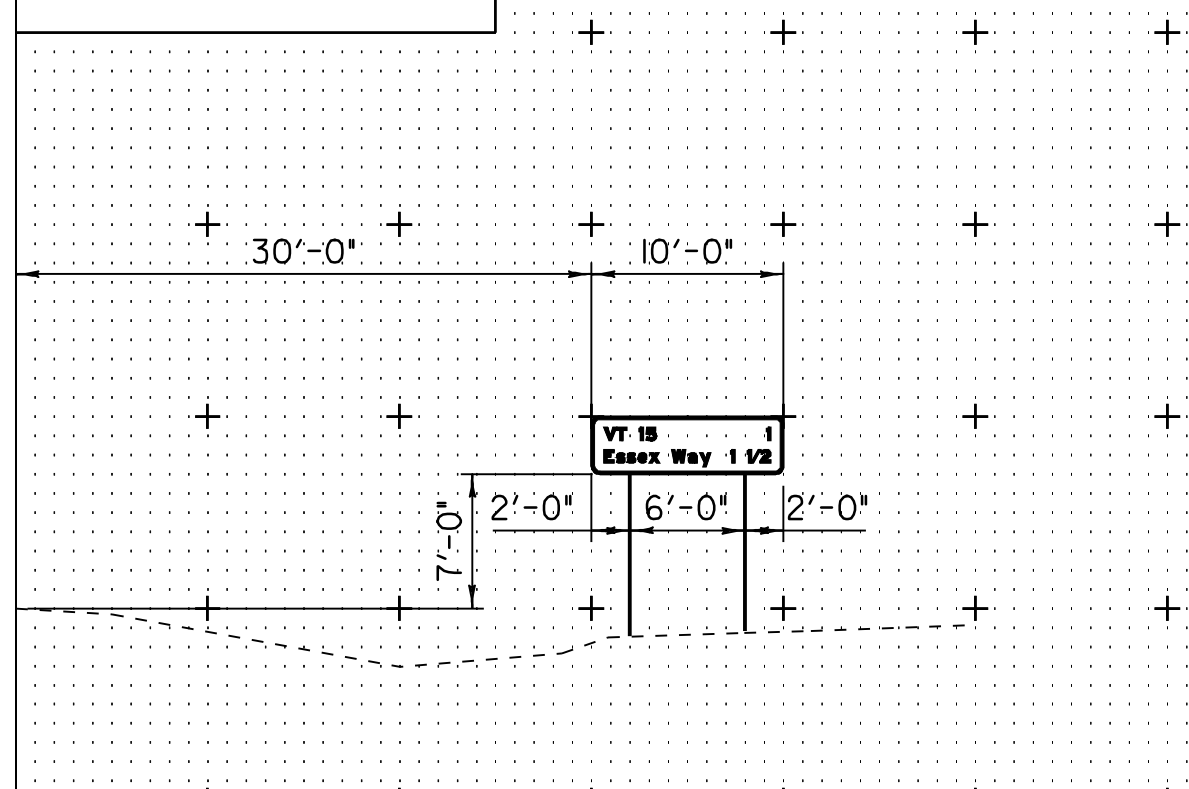


**STA. 485+81.39**  
LT POST LENGTH 16'-6"  
RT POST LENGTH 14'-6"

EDGE LINE

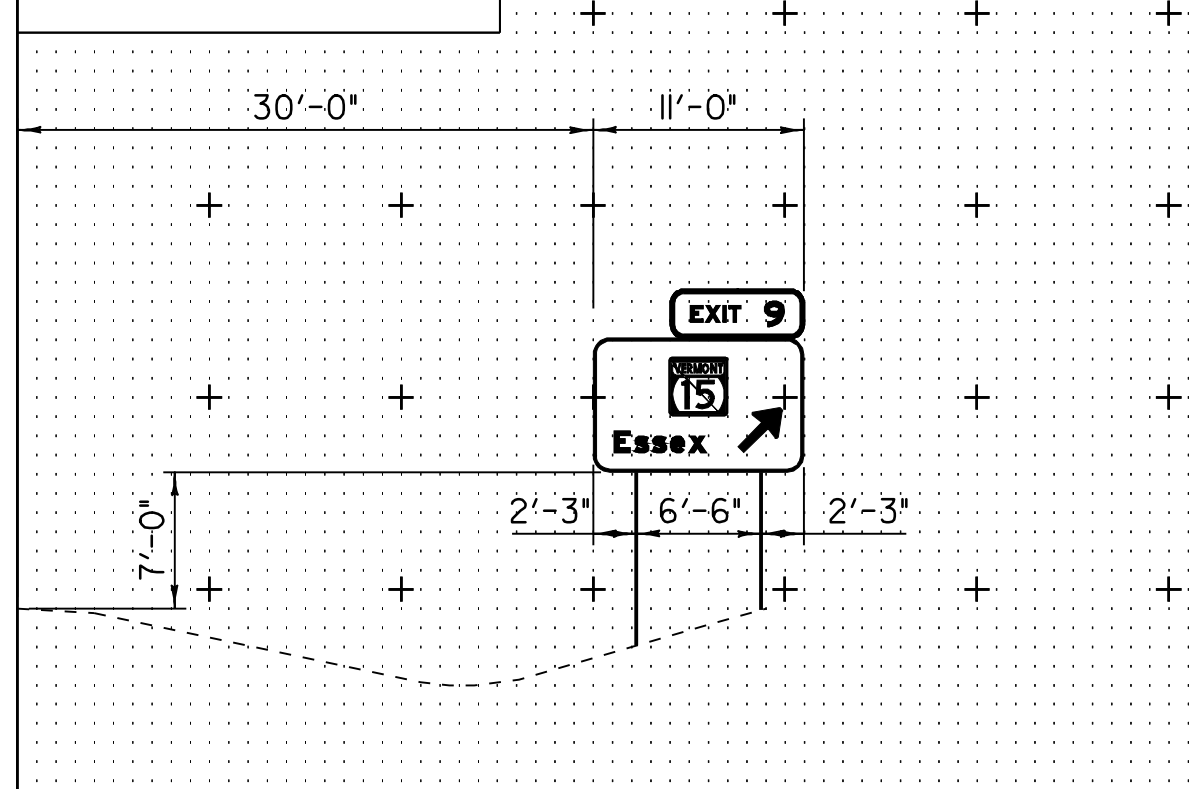


**STA. 589+01.53**  
LT POST LENGTH 14'-0"  
RT POST LENGTH 14'-0"

EDGE LINE

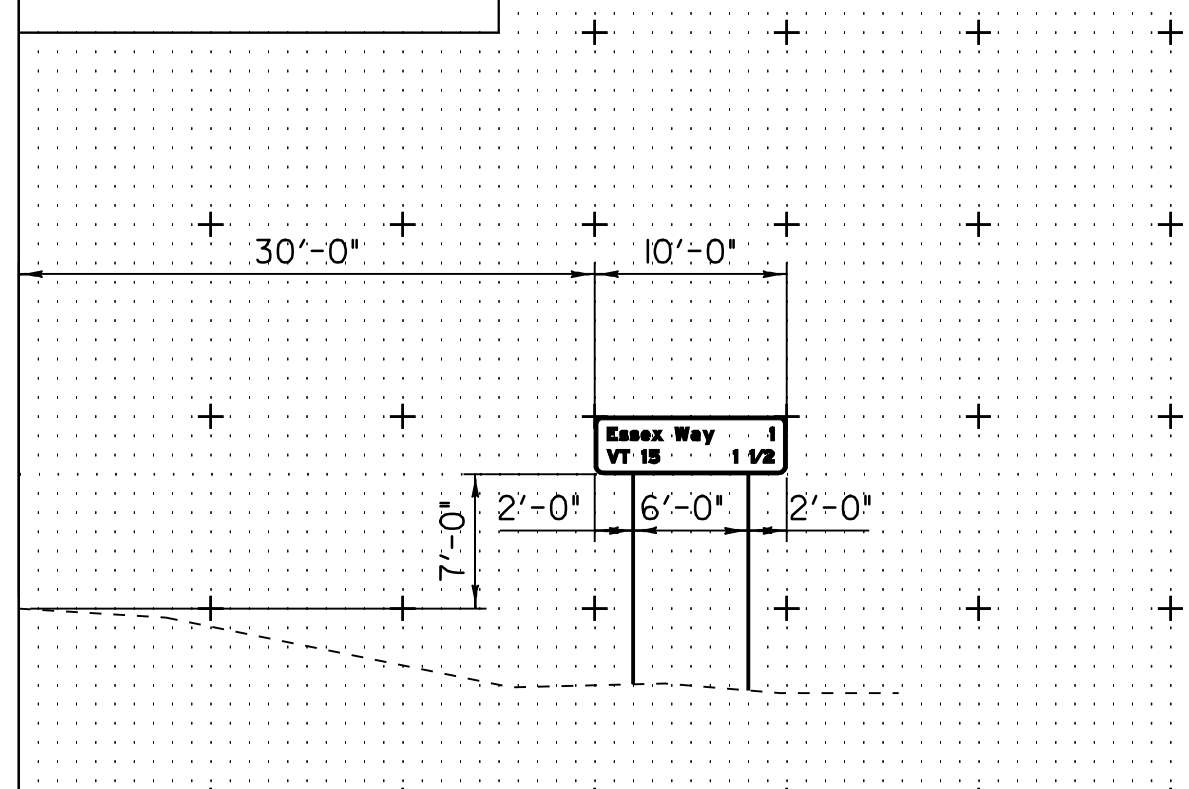


EDGE LINE

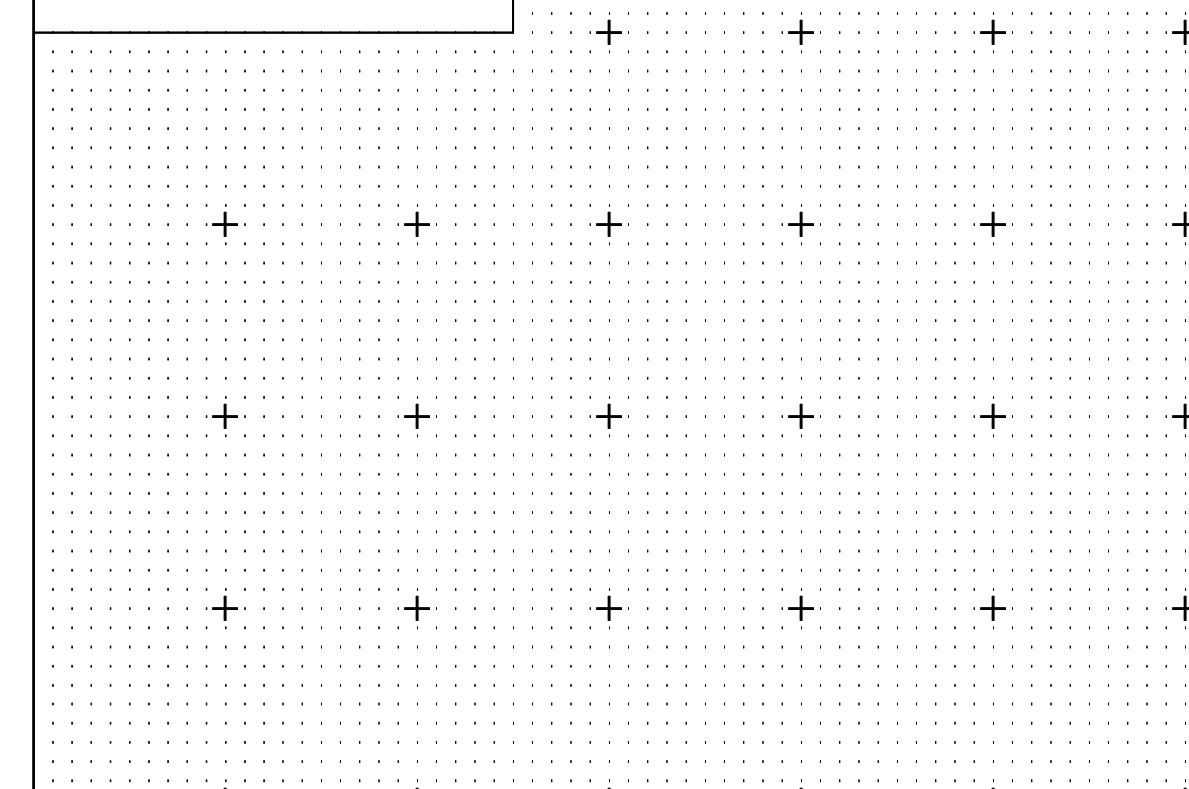


**STA. 462+00.00**  
LT POST LENGTH 12'-0"  
RT POST LENGTH 12'-0"

EDGE LINE

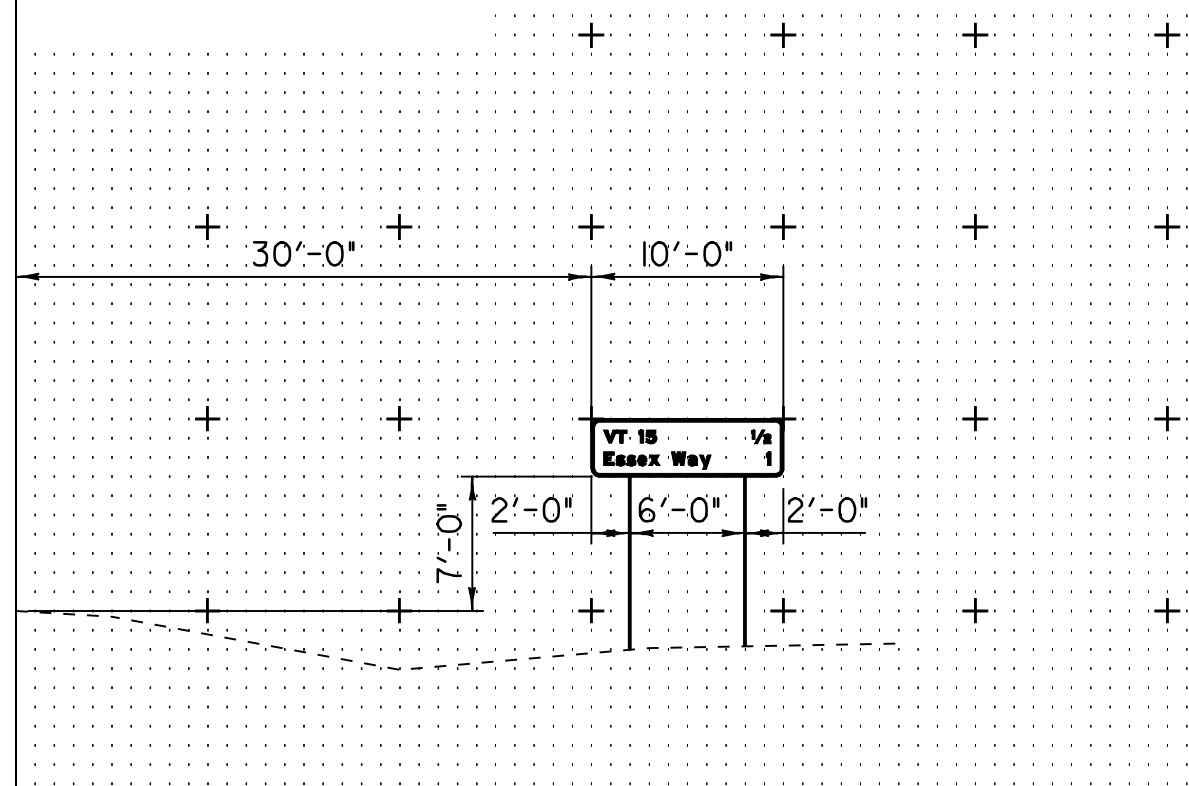


**STA. 547+00.00**  
LT POST LENGTH 15'-6"  
RT POST LENGTH 15'-6"

EDGE LINE

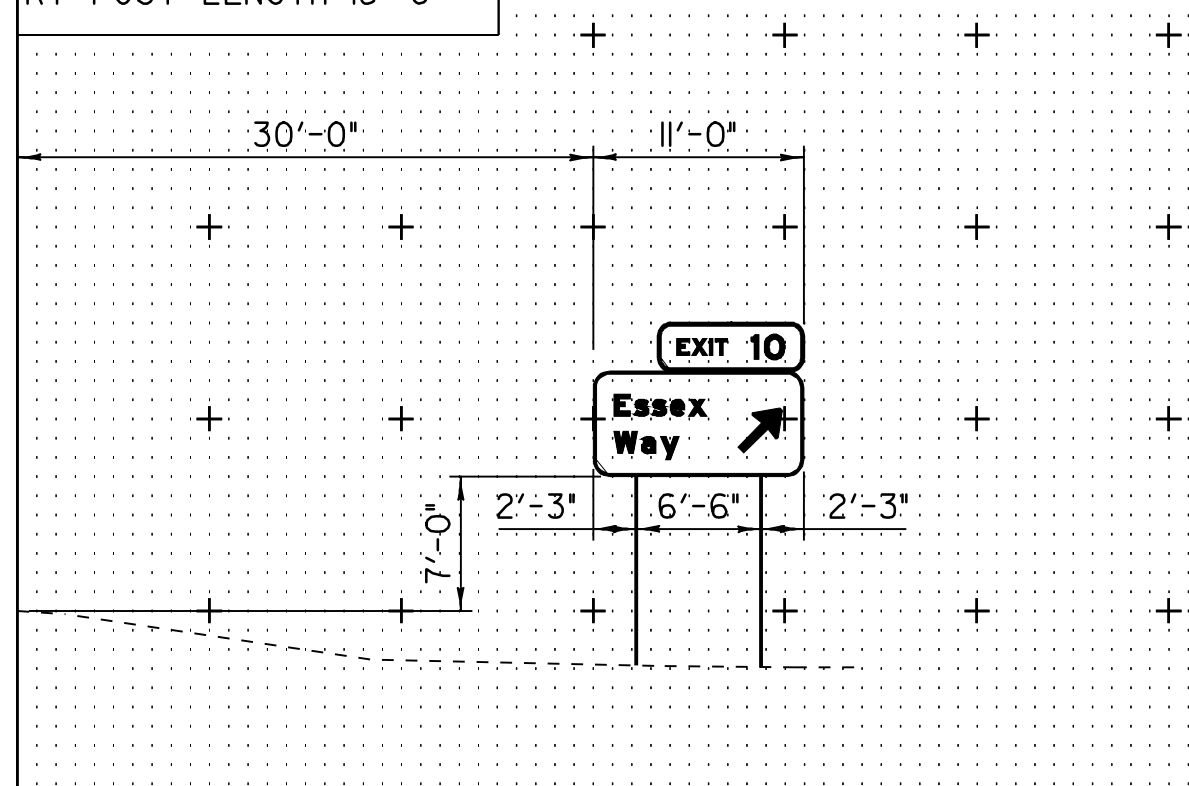


**STA. 595+50.00**  
LT POST LENGTH 18'-0"  
RT POST LENGTH 16'-5"

EDGE LINE

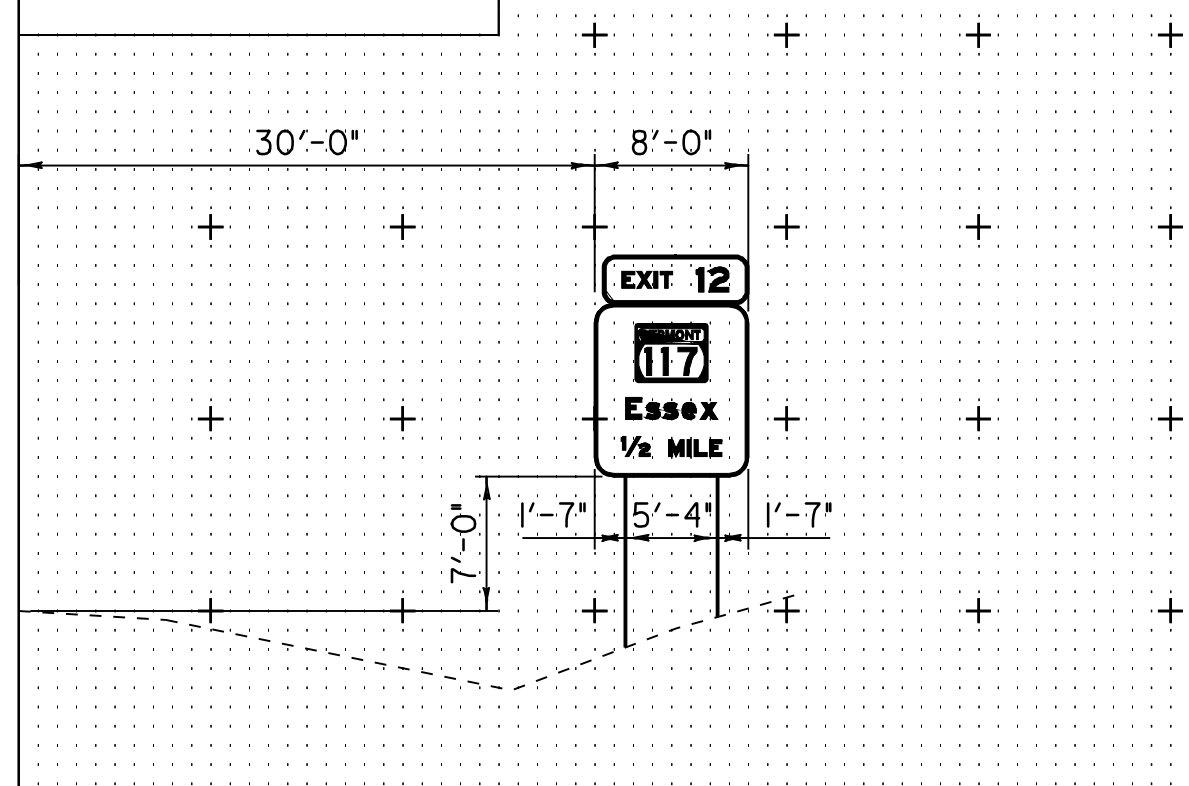


EDGE LINE

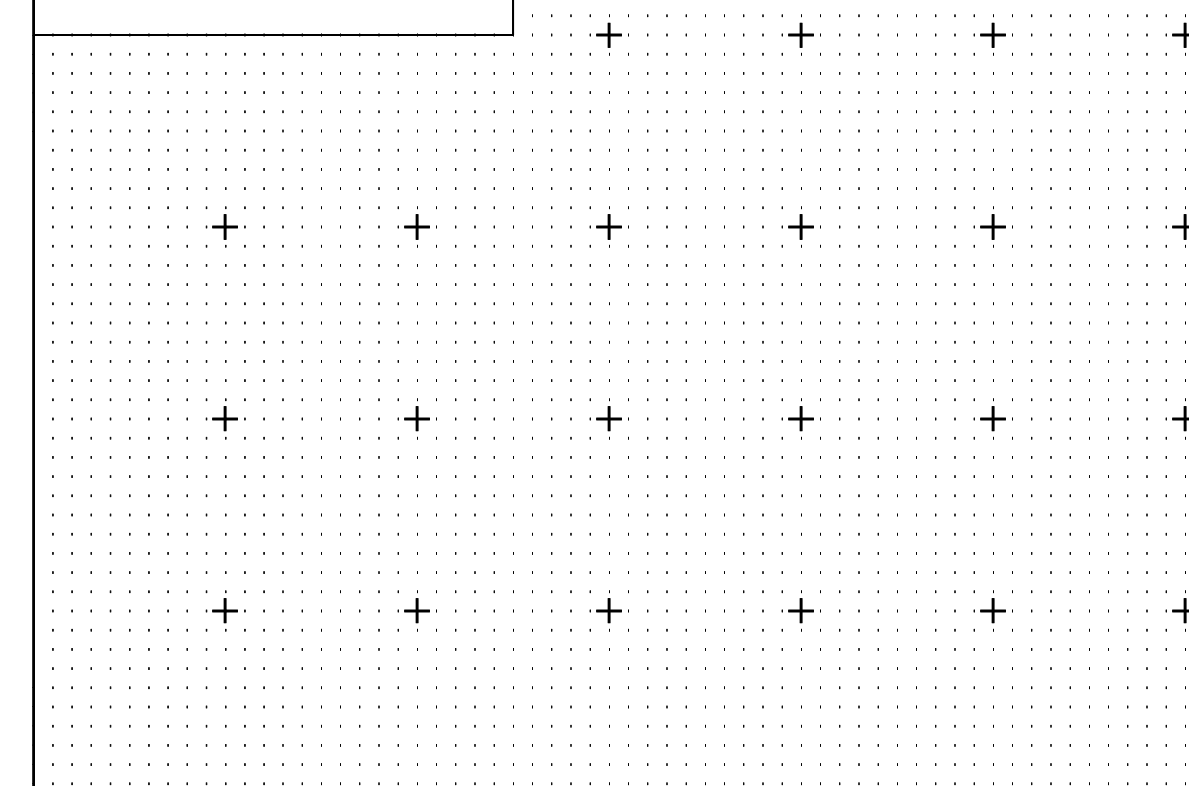


**STA. 564+00.00**  
LT POST LENGTH 12'-0"  
RT POST LENGTH 10'-0"

EDGE LINE

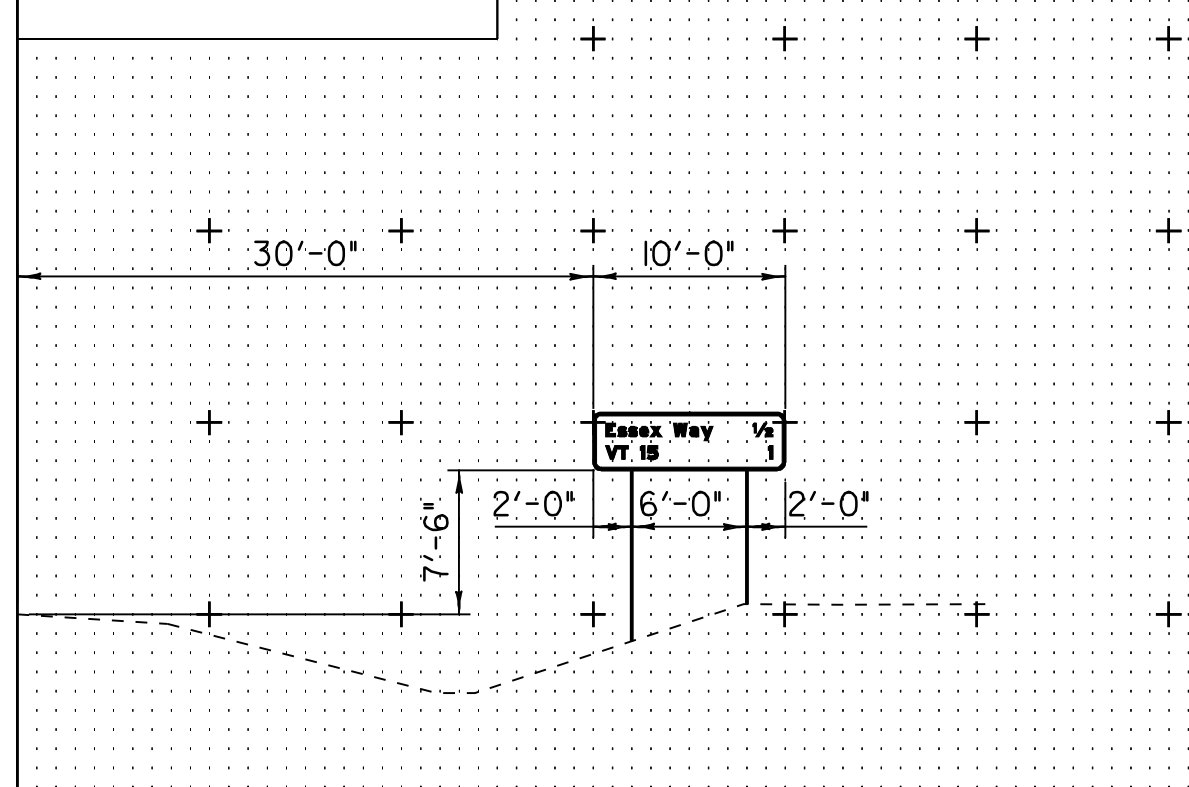

NOTE:  
SIGNS MOUNTED ON BRIDGES AND  
CANTILEVER FRAMES NOT SHOWN.

SCALE 1" = 20'

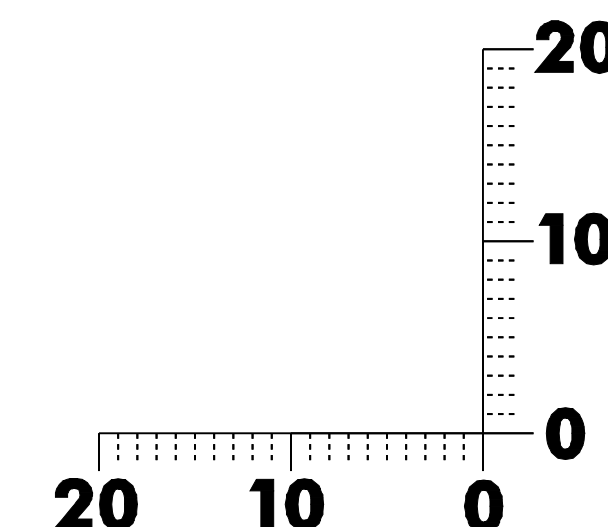

**SIGN  
CROSS SECTIONS**

PROJECT NAME: ESSEX  
PROJECT NUMBER: NH 2403 (I)S  
FILE NAME: pave/04b032/p04b032.dgn  
PROJECT LEADER: EPD  
DESIGNED BY: JDA  
PLOT FILE: p04b032sxs.l  
PLOT DATE: 23-APR-2009 15:5  
DRAWN BY: SJB  
CHECKED BY: EPD  
SHEET 39 OF 48