



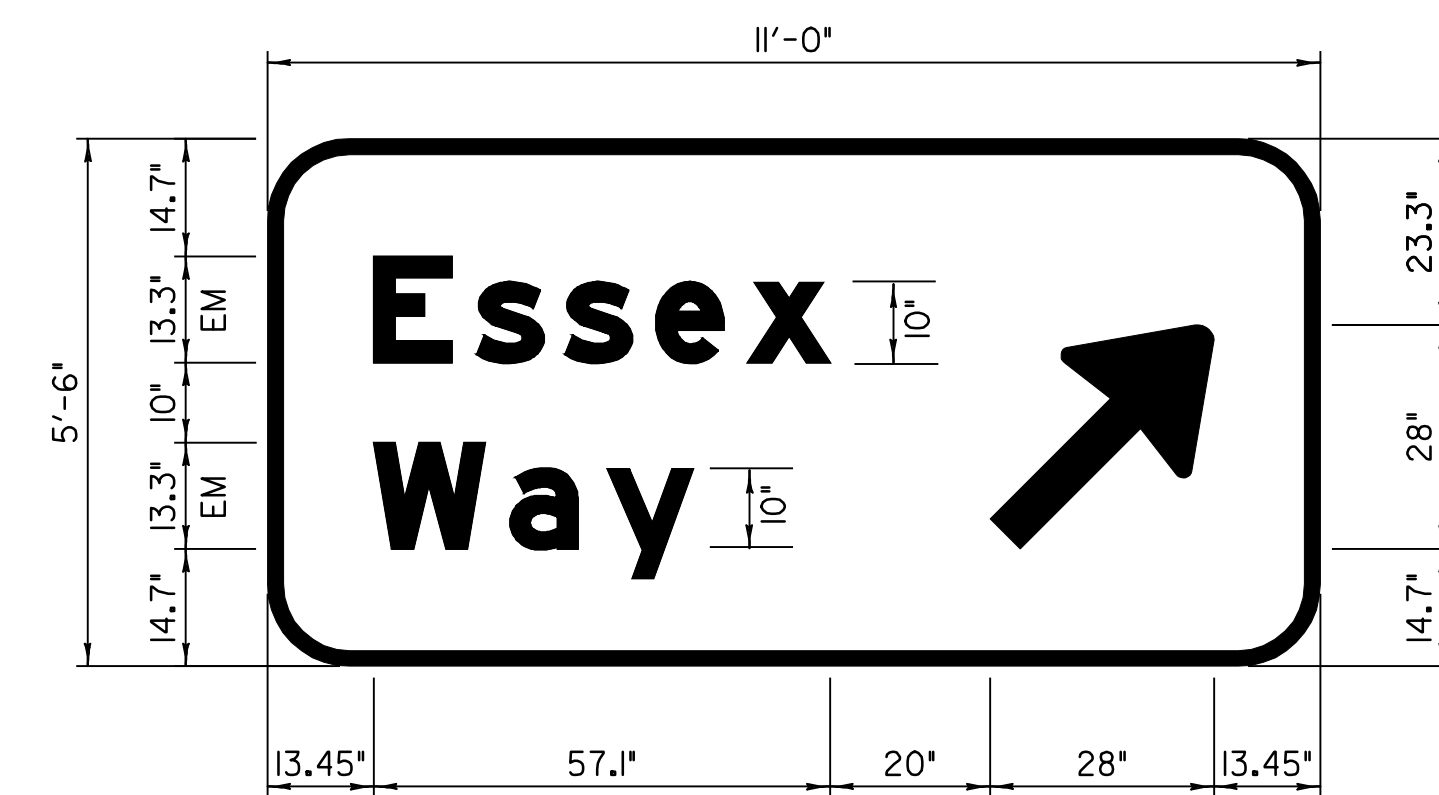


BORDER  
 R=12"  
 W=2"  
 COLORS: THE SIGN SHALL HAVE A REFLECTORIZED WHITE TEXT  
 AND BORDER ON A REFLECTORIZED GREEN BACKGROUND.

STA. 481+93.67 LT

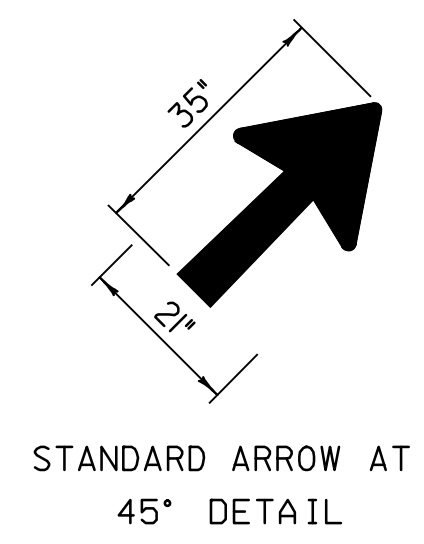


BORDER  
 R=8.25"  
 W=2"  
 COLORS: THE SIGN SHALL HAVE A REFLECTORIZED WHITE TEXT  
 AND BORDER ON A REFLECTORIZED GREEN BACKGROUND.

STA. 518+73.72 RT  
 STA. 547+00.00 LT

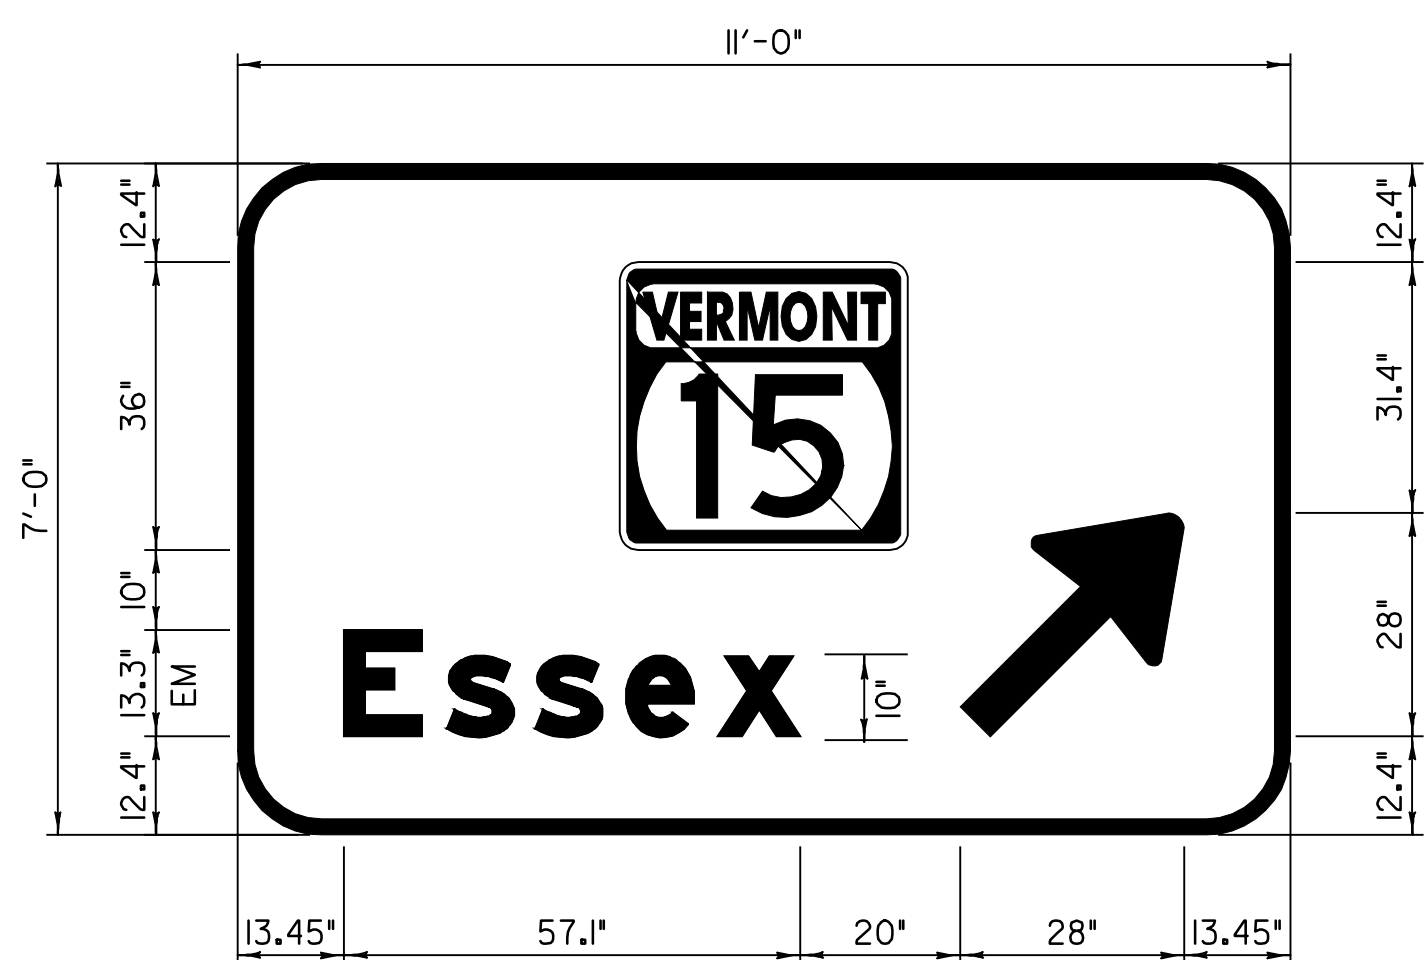

BORDER  
 R=10.5"  
 W=2"  
 COLORS: THE SIGN SHALL HAVE A REFLECTORIZED WHITE TEXT  
 AND BORDER ON A REFLECTORIZED GREEN BACKGROUND.

STA. 485+81.39 RT  
 STA. 511+73.95 LT

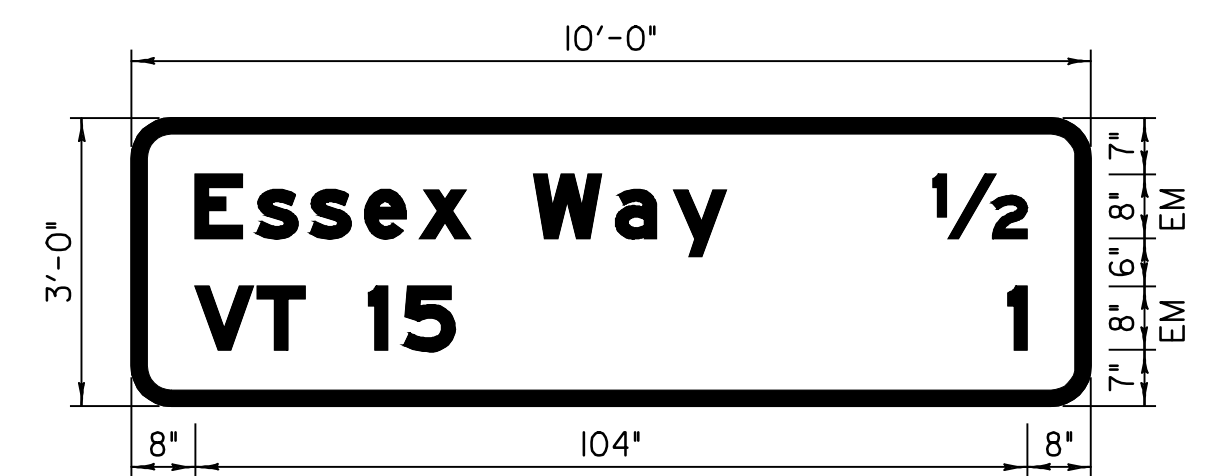

BORDER  
 R=8"  
 W=1.75"  
 COLORS: THE SIGN SHALL HAVE A REFLECTORIZED WHITE TEXT  
 AND BORDER ON A REFLECTORIZED GREEN BACKGROUND.

STA. 564+00.00 LT

TEXT LAYOUT DIMENSIONS ARE BASED ON THE "LETTER & NUMERAL WIDTHS AND SPACE" TABLES FOUND IN THE "STANDARD HIGHWAY SIGNS" BOOKLET. MINOR VARIATIONS IN THE TEXT DIMENSIONS ARE ACCEPTABLE BASED ON INDIVIDUAL MANUFACTURER'S LETTER FABRICATION. SIGNIFICANT CHANGES WHICH AFFECT SIGN APPEARANCE SHALL BE BROUGHT TO THE ATTENTION OF VTRANS PRIOR TO FABRICATION.

<b>TYPE B SIGN</b> <b>DETAIL SHEET 2</b>	PROJECT NAME: ESSEX	PLOT DATE: 23-APR-2009 15:5
	PROJECT NUMBER: NH 2403 (1)S	DRAWN BY: SJB, RHB
	FILE NAME: pave/04b032/p04b032.dgn	CHECKED BY: EPD
	PROJECT LEADER: EPD	SHEET 41 OF 48
	DESIGNED BY: JDA	
	PLOT FILE: p04b032sd2.1	