



INTERCHANGE 9 EXIT RAMPS A AND C
INTERCHANGE 10 EXIT RAMPS A AND C



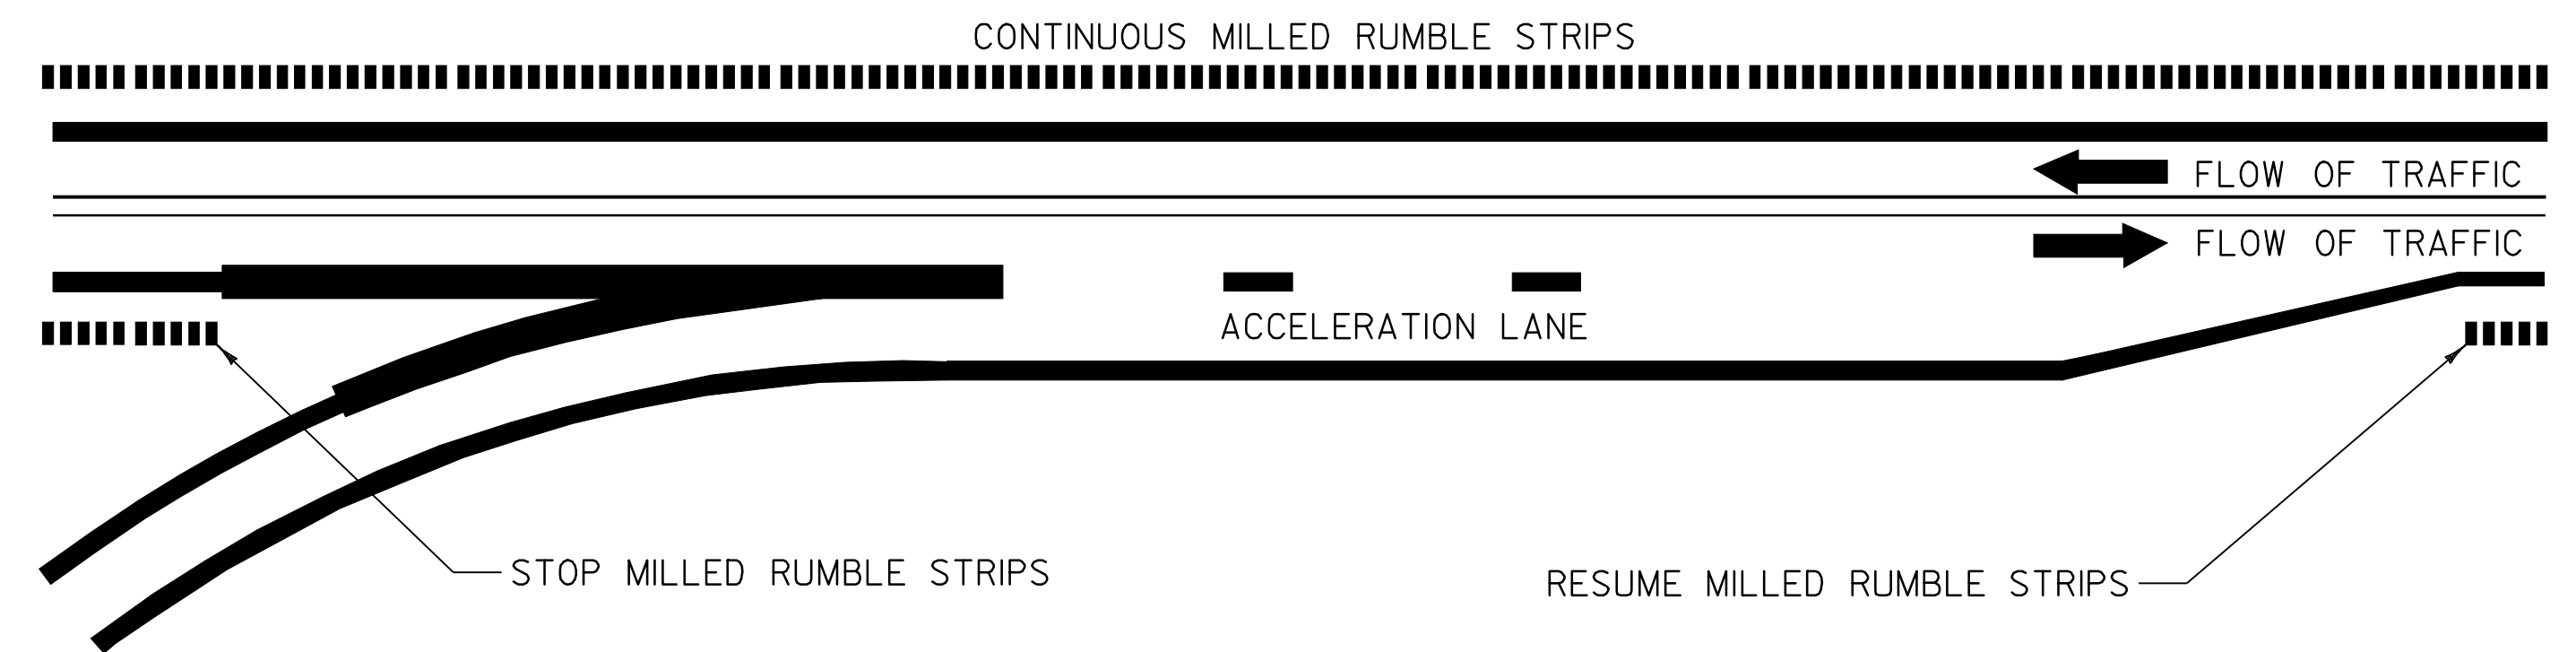

INTERCHANGE 9 RAMPS B AND D
INTERCHANGE 10 RAMPS B AND D
INTERCHANGE 12 RAMP B

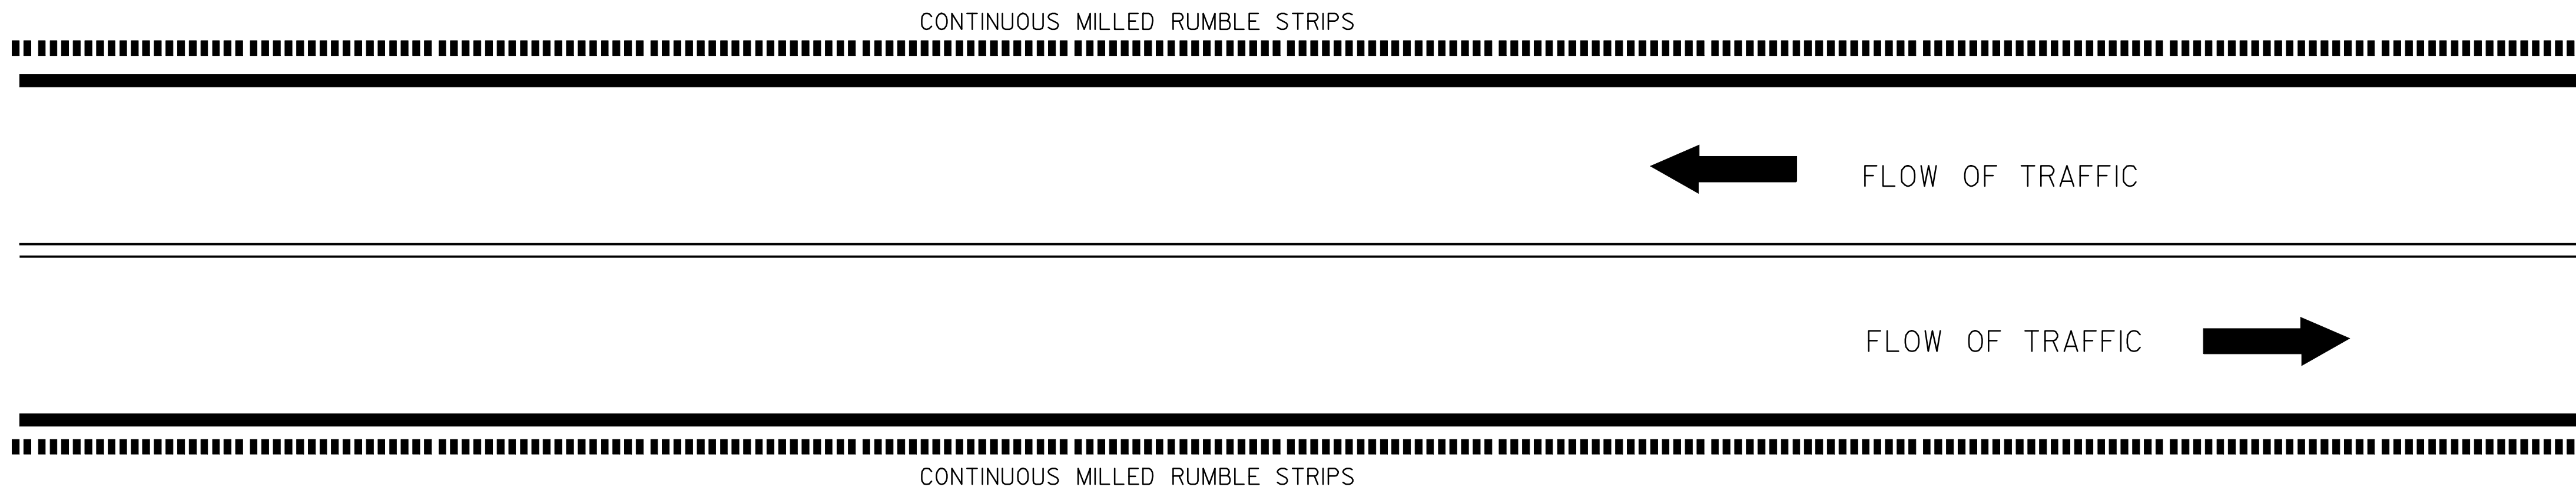

VT 289

DETAILS NOT TO SCALE

LEGEND

	DIRECTION OF TRAFFIC FLOW
	MILLED RUMBLE STRIPS

MILLED RUMBLE STRIPS DETAIL 2	PROJECT NAME: ESSEX	PLOT DATE: 23-APR-2009 15:5
	PROJECT NUMBER: NH 2403 (I)S	DRAWN BY: SJB, RHB
	FILE NAME: pave/04b032/p04b032.dgn	CHECKED BY: EPD
	DESIGNED BY: JDA	SHEET 47 OF 48
	PLOT FILE: p04b032rs2.1	