


LOCATION				FEET OF DITCHING			MISC. ITEMS			REMARKS	LOCATION				FEET OF DITCHING			MISC. ITEMS			REMARKS	LOCATION				FEET OF DITCHING			MISC. ITEMS			REMARKS
SITE	STATION	STATION	POS.	PERCENT GRADE			EROS. MATT.	STONE FILL TYP. I	GEOT. UNDER STONE FILL		SITE	STATION	STATION	POS.	PERCENT GRADE			EROS. MATT.	STONE FILL TYP. I	GEOT. UNDER STONE FILL		SITE	STATION	STATION	POS.	PERCENT GRADE			EROS. MATT.	STONE FILL TYP. I	GEOT. UNDER STONE FILL	
				0-1	1-2.5	2.5-10									0-1	1-2.5	2.5-10									0-1	1-2.5	2.5-10				
VT ROUTE 106, SPRINGFIELD				ft	ft	ft	sy	cy	sy						ft	ft	ft	sy	cy	sy						ft	ft	ft	sy	cy	sy	
1	6+15	22+25	RT		1610		536.7																									
2	24+90	25+10	RT		20		6.7																									
3	26+35	27+25	RT		90		30.0																									
4	34+90	45+00	RT		1010		336.7																									
5	45+42	47+00	RT		158		52.7																									
6	48+30	49+55	RT		125		41.7																									
7	50+05	51+50	RT		145		48.3																									
8	53+40	55+98	RT		258		86.0																									
9	63+75	65+00	RT		125		41.7																									
10	66+30	69+70	RT		340		113.3																									
11	93+35	95+40	RT		205		68.3																									
12	131+60	134+11	RT		251		83.7																									
13	134+60	137+47	RT		287		95.7																									
14	142+00	148+25	RT		625		208.3																									
15	162+00	165+00	LT		300		100.0																									
SUBTOTALS				0	5549	0	1849.8	0	0																							
ROUNDINGS				0	56	0	20.2	0	0																							
SHEET TOTALS				0	5605	0	1870	0	0																							

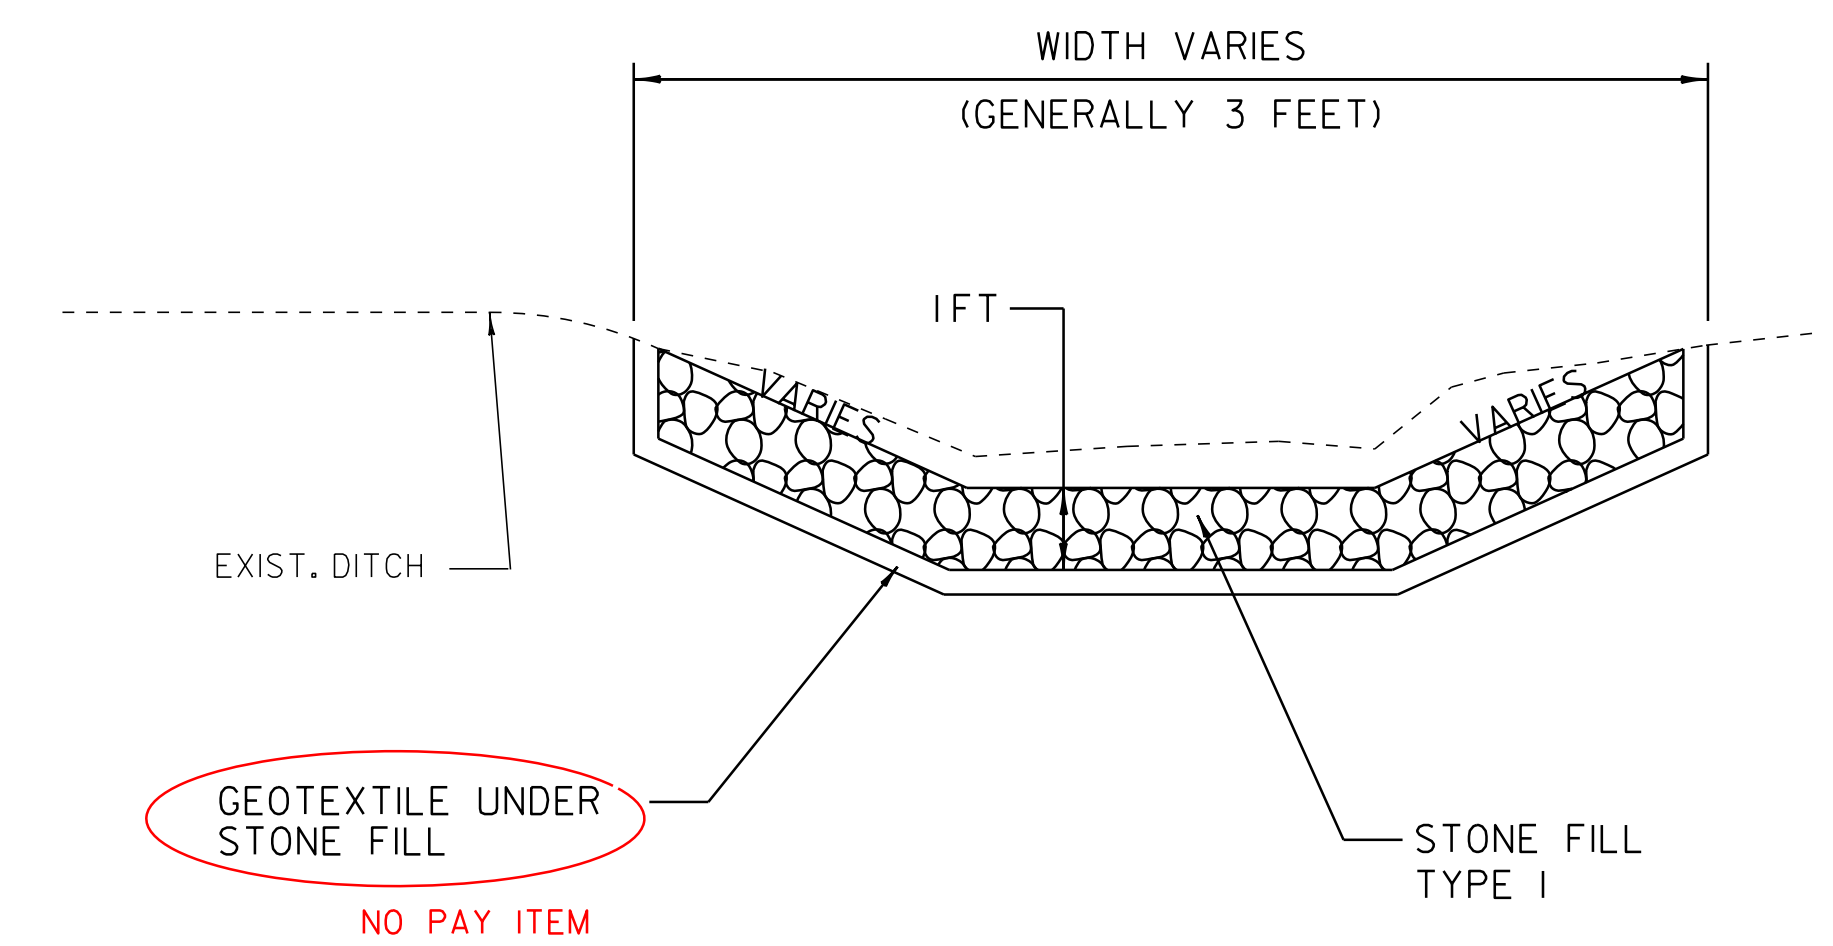

**DITCH DETAIL**

NOT TO SCALE

NOTES:

PIPE INLET AND OUTLET AREAS, AND DITCH CLEANING THROUGH PROJECT, SHALL BE PERFORMED AT LOCATIONS AND AS DIRECTED BY THE RESIDENT ENGINEER. PAYMENT WILL BE UNDER THE APPLICABLE EQUIPMENT RENTAL ITEM(S).

AN ESTIMATED QUANTITY OF EROSION MATTING AND STONE FILL TYPE I HAS BEEN INCLUDED. EROSION MATTING SHALL BE USED IN ALL DITCHES WITH A GRADE BETWEEN 1 AND 2.5 PERCENT AND STONE FILL TYPE I SHALL BE USED IN ALL DITCHES WITH A GRADE GREATER THAN 2.5 PERCENT OR AS DIRECTED BY THE RESIDENT ENGINEER.

DATUM  
VERTICAL N/A  
HORIZONTAL N/A

**DITCH CLEANING  
DETAIL SHEET**

SURVEYED BY CLD DATE 12/05  
DRAWN BY SRB DATE 5/05  
SQUAD LEADER CRB  
DESIGN FILE NO. /pave/04b038/pb038.dgn  
IPARM pb038dc.i DATE PLOTTED JUN-2012 08  
PROJ. NAME SPRINGFIELD  
PROJ. NO. STP 2405(1)S  
SHEET 11 OF 42 SHEETS