


TEMPORARY AND DURABLE 4" WHITE LINE
 STA 3+06 TO 10+00 SOLID LT
 STA 3+06 TO 10+00 SOLID RT
 STA 3+06 TO 4+50 DOTTED LT

REHABILITATION OF DI, CB, OR MH, CLASS J
 STA 3+26 DI RT
 STA 5+68 DI RT
 STA 7+73 DI RT
 STA 9+29 DI RT


TEMPORARY AND DURABLE 4" YELLOW LINE
 STA 3+06 TO 10+00 SOLID LT & RT

VT ROUTE 106
STA 3+06.24
(MM 0.058)
BEGIN PROJECT
STP 2405(1)S

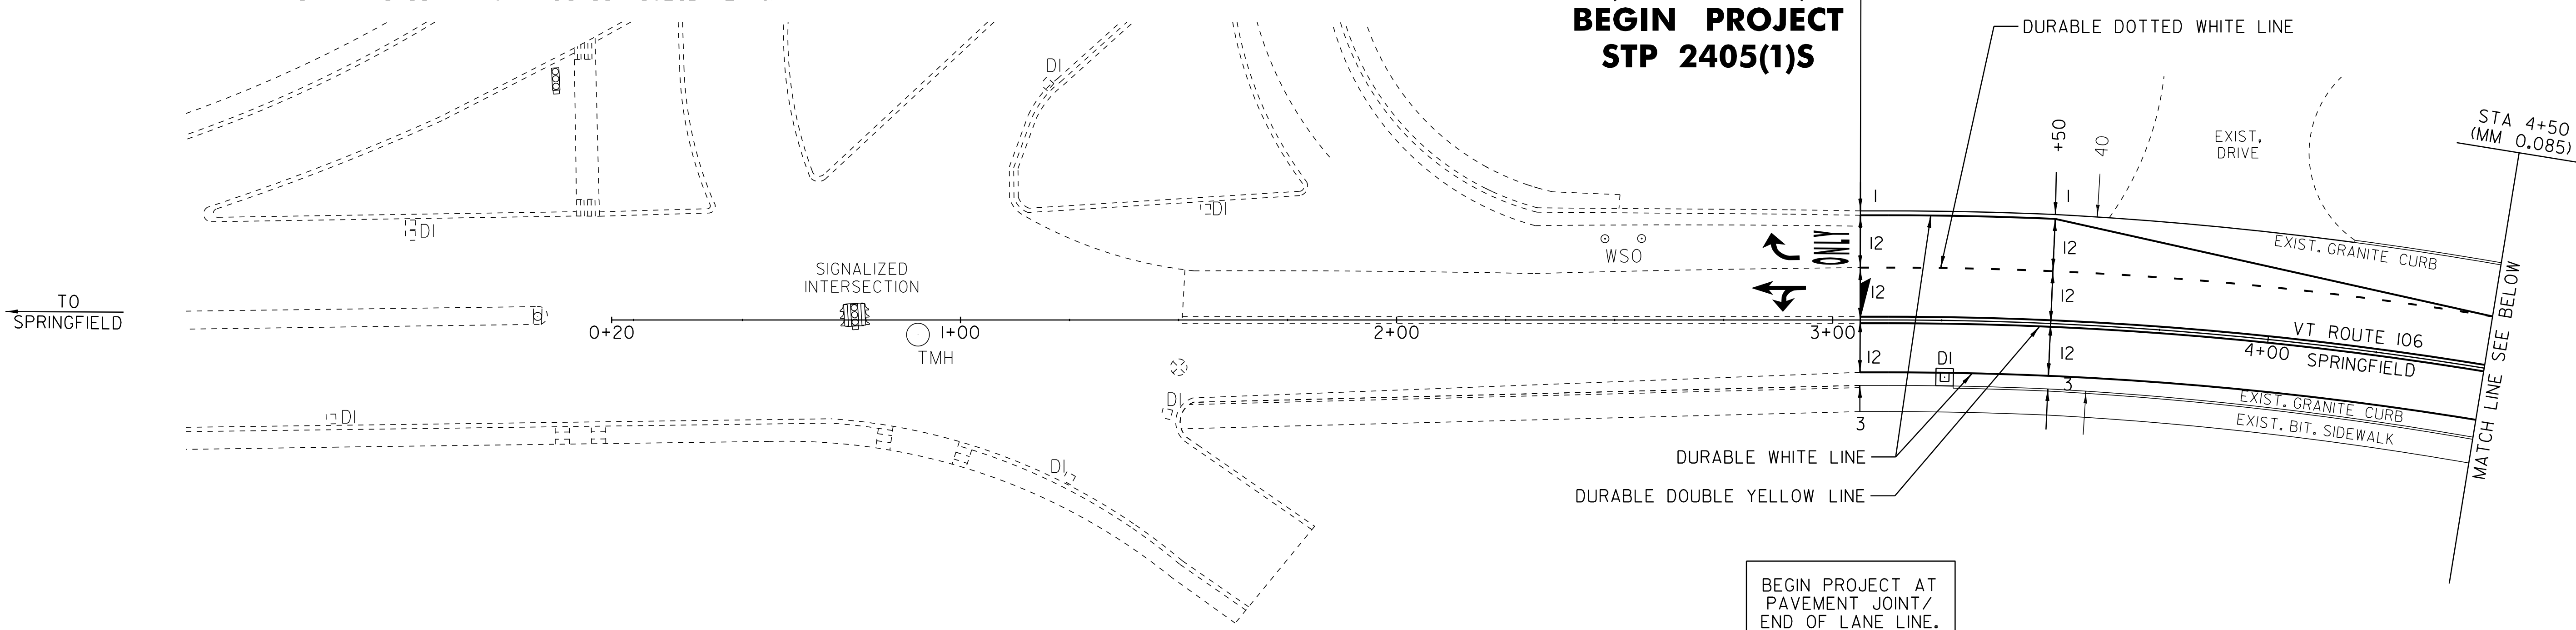

BEGIN PROJECT AT PAVEMENT JOINT/ END OF LANE LINE. DO NOT OBLITERATE "ONLY" TEXT

CONCRETE SIDEWALK, 5"
 STA. 3+17 - STA. 3+34 RT
 STA. 5+53 - STA. 5+83 RT
 STA. 7+61 - STA. 7+86 RT
 STA. 9+16 - STA. 9+44 RT

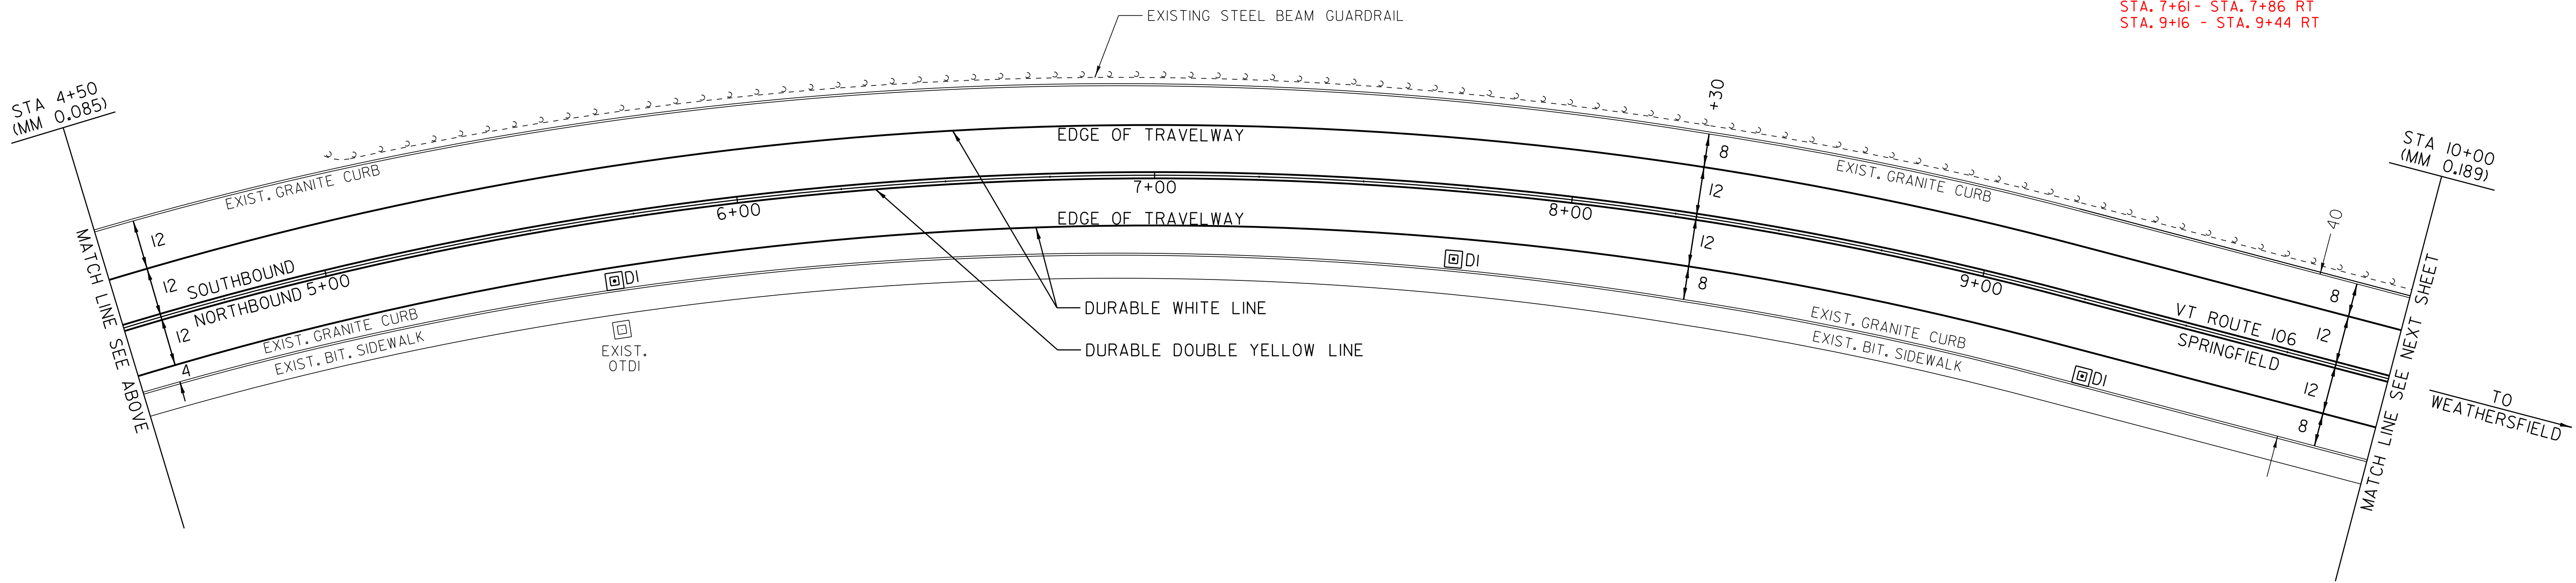

DATUM
 VERTICAL _____
 HORIZONTAL _____

NOT TO SCALE

LEGEND

R	=	REMOVE EXISTING
S	=	SALVAGE
R & S	=	REMOVE AND SALVAGE
N	=	NEW
RET	=	RETAIN
B-B	=	BACK TO BACK
—	=	NEW RAIL
- - -	=	EXISTING RAIL

NOTE: ALL DIMENSIONS ARE FEET EXCEPT AS INDICATED

PAVING PROJECT LAYOUT #1	PROJECT: SPRINGFIELD	PROJECT NO.: STP 2405(1)S
	DESIGN FILE NAME: /pave/04b038/pb038.dgn	PLOT DATE: 19-JUN-2012 08:11
	IPARM FILE NAME: pb038ia01.i	SURVEY DATE: 12/04
	SURVEYED BY: CLD SQUAD LEADER: CRB CLD 04-0397	DRAWN BY: SRB SHEET: 12 OF 42