

TEMPORARY AND DURABLE 4" WHITE LINE
 STA 10+00 TO 21+00 SOLID LT
 STA 10+00 TO 21+00 SOLID RT


REHABILITATION OF DI, CB, OR MH, CLASS I
 STA 15+67 DI LT

TEMPORARY AND DURABLE 4" YELLOW LINE
 STA 10+00 TO 21+00 SOLID LT & RT

CHANGING ELEVATION OF SMH
 STA 10+95 LT

TEMPORARY AND DURABLE LETTER OR SYMBOL
 STA 17+87 LT - "AHEAD"
 STA 18+27 LT - "SIGNAL"

REMOVING SIGNS
 AS SHOWN - 2

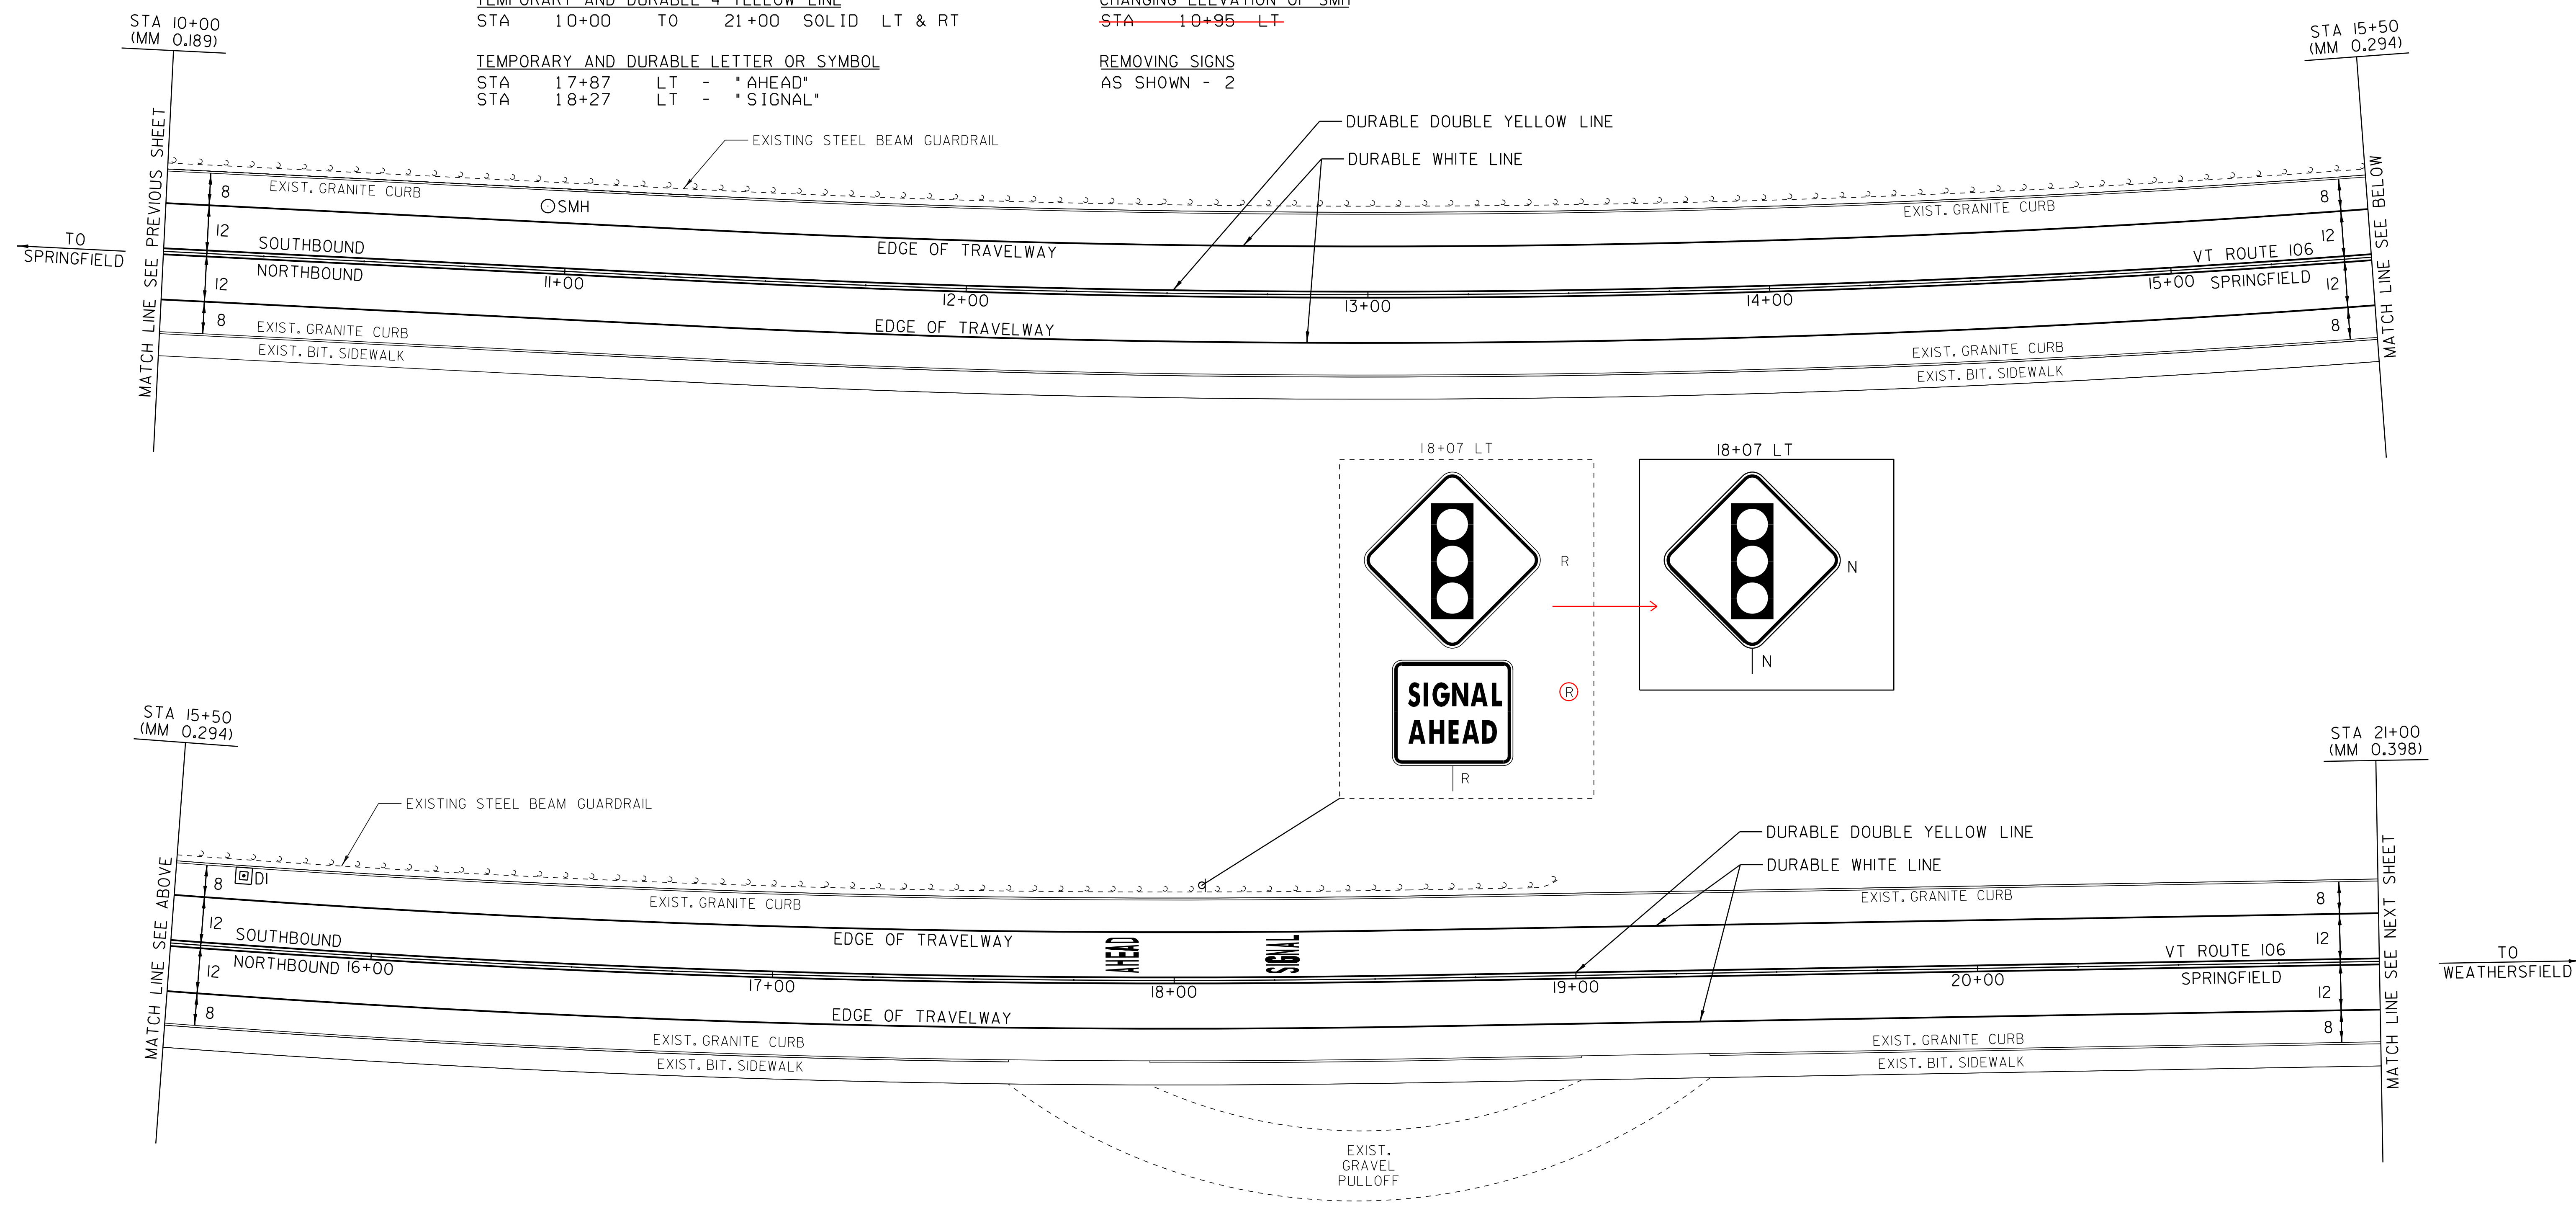

MATCH LINE SEE PREVIOUS SHEET

MATCH LINE SEE BELOW

MATCH LINE SEE ABOVE

MATCH LINE SEE NEXT SHEET

TO
SPRINGFIELD

TO
WEATHERSFIELD

DATUM
 VERTICAL _____
 HORIZONTAL _____

NOT TO SCALE

- LEGEND**
- R = REMOVE EXISTING
 - S = SALVAGE
 - R & S = REMOVE AND SALVAGE
 - N = NEW
 - RET = RETAIN
 - B-B = BACK TO BACK
 - = NEW RAIL
 - - - = EXISTING RAIL

NOTE: ALL DIMENSIONS ARE FEET EXCEPT AS INDICATED

PAVING PROJECT LAYOUT #2	PROJECT: SPRINGFIELD	PROJECT NO.: STP 2405(I)S
	DESIGN FILE NAME: /pave/04b038/pb038.dgn	PLOT DATE: 19-JUN-2012 08:11
	IPARM FILE NAME: pb038ia02.i	SURVEY DATE: 12/04
	SURVEYED BY: CLD	DRAWN BY: SRB
	SQUAD LEADER: CRB	SHEET: 13 OF 42
	CLD 04-0397	