

TEMPORARY AND DURABLE 4" WHITE LINE
 STA 42+00 TO 49+61 SOLID RT
 STA 42+00 TO 53+00 SOLID LT
 STA 49+86 TO 53+00 SOLID RT



TEMPORARY AND DURABLE 4" YELLOW LINE
 STA 42+00 TO 49+51 SOLID LT & RT
 STA 49+71 DOUBLE SOLID RT (TH 774)
 STA 49+91 TO 53+00 SOLID LT & RT

TEMPORARY AND DURABLE 24" STOP BAR
 STA 49+71 RT (TH 774)
 TEMPORARY AND DURABLE LETTER OR SYMBOL
 STA 49+80 RT - "STOP" (TH 774)


CHANGING ELEVATION OF SMH
~~STA 45+50 LT~~
~~STA 49+50 LT~~
~~STA 52+61 LT~~
 ADJUST ELEVATION OF VALVE BOX
 STA 49+73 RT
 SHOULDER BERM REMOVAL
 STA 42+00 TO 52+31 LT

STEEL BEAM GUARDRAIL
 STA 49+97 TO 50+05 RT
 ANCHOR FOR STEEL BEAM RAIL
 STA 49+97 RT
 STA 50+05 RT
 REMOVAL AND DISP. GUARDRAIL
 STA 49+97 TO 50+05 RT
 STA 47+50 (MM 0.900)

REMOVING SIGNS
 AS SHOWN - 1

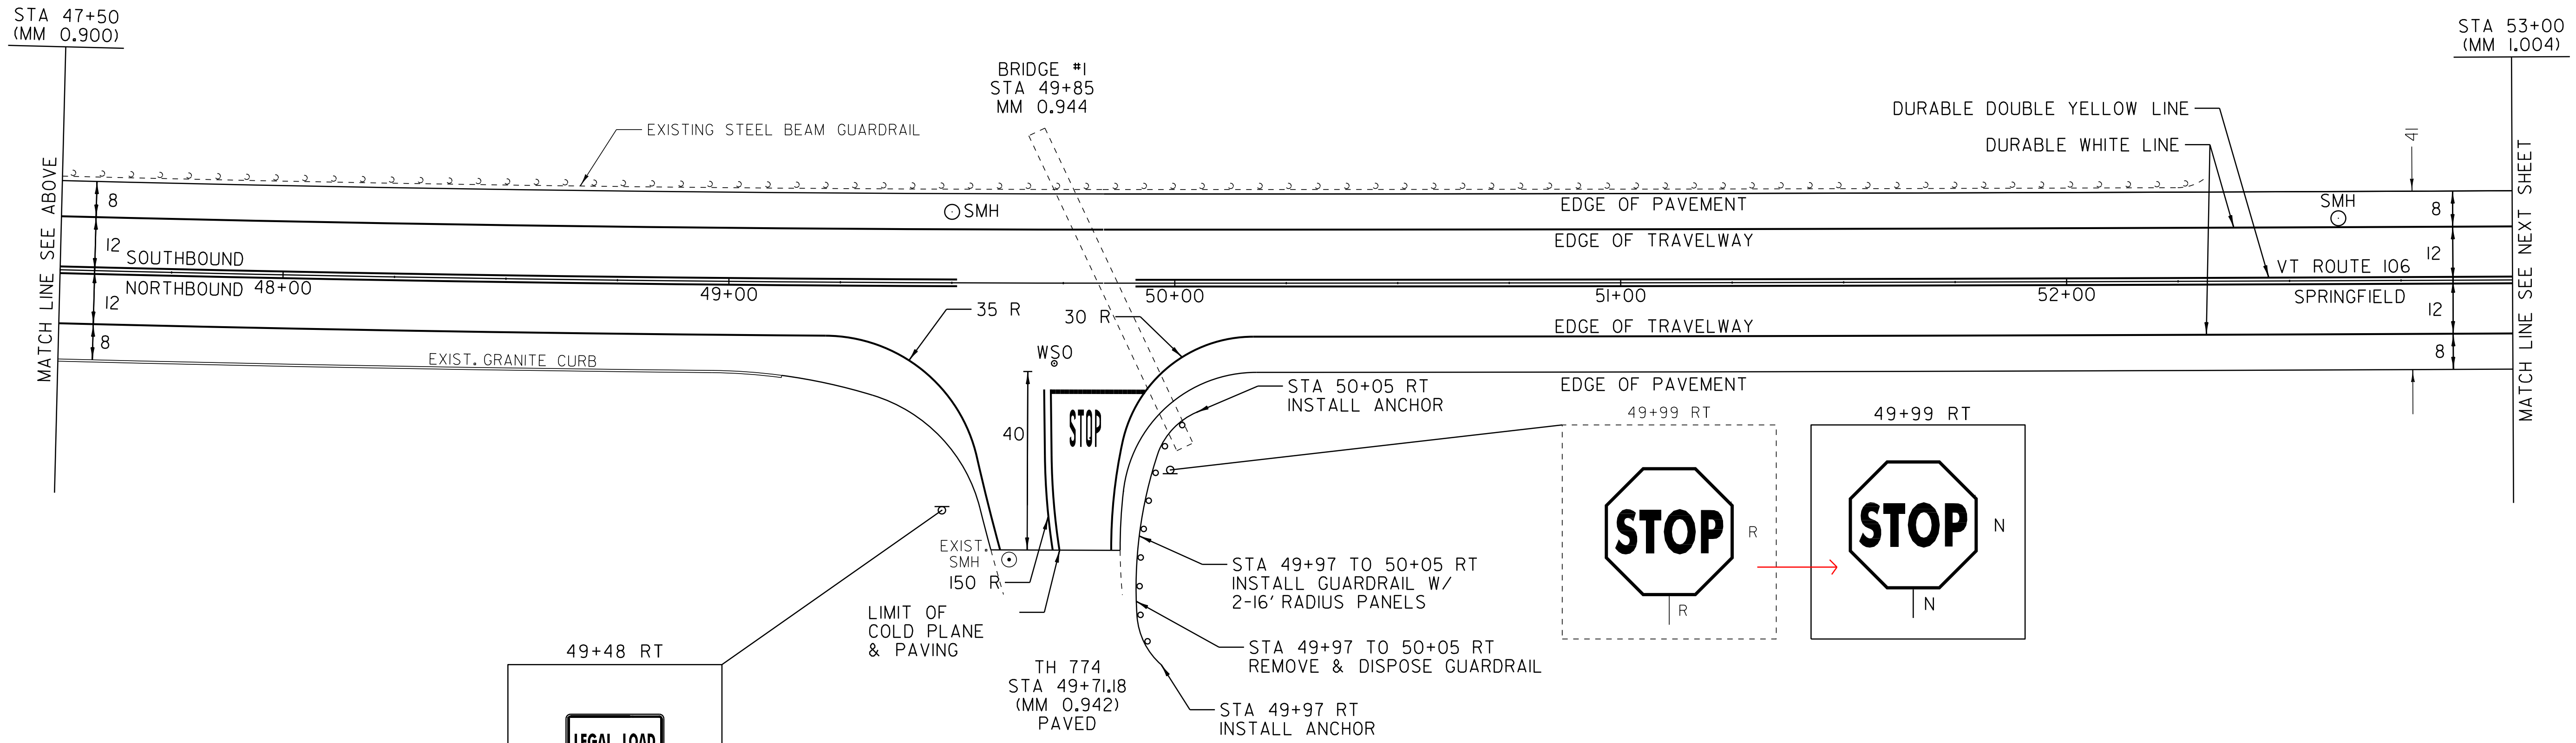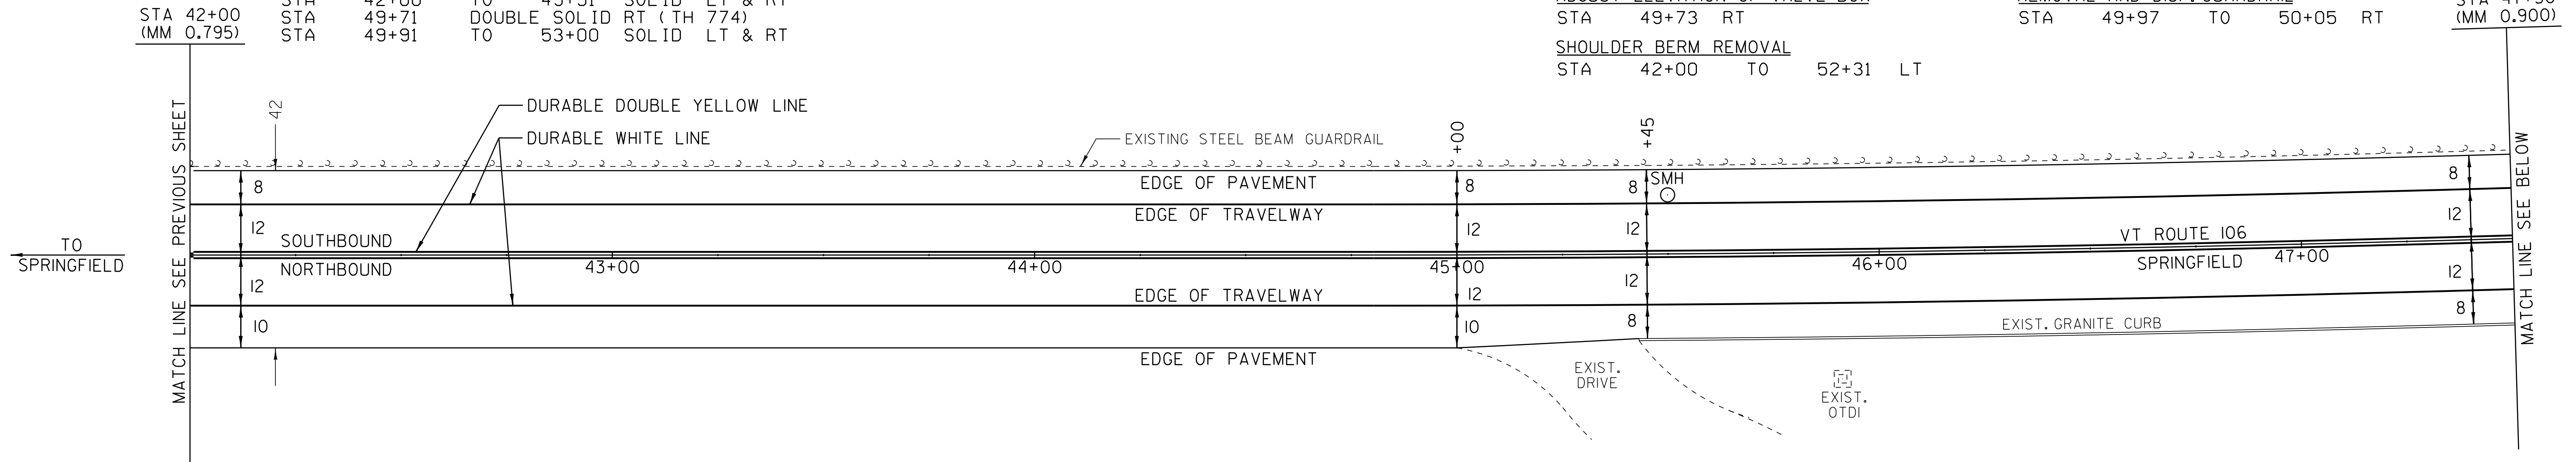

49+48 RT
 LEGAL LOAD LIMIT
 24,000
 POUNDS
 N

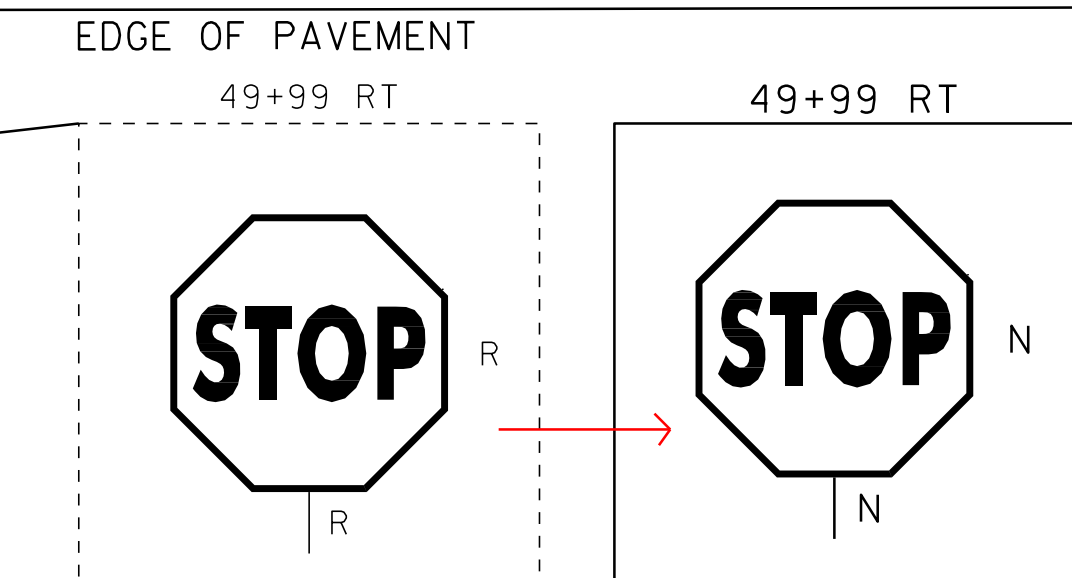

- LEGEND
- R = REMOVE EXISTING
 - S = SALVAGE
 - R & S = REMOVE AND SALVAGE
 - N = NEW
 - RET = RETAIN
 - B-B = BACK TO BACK
 - = NEW RAIL
 - - - = EXISTING RAIL

NOTE: ALL DIMENSIONS ARE FEET EXCEPT AS INDICATED

PAVING PROJECT LAYOUT #5	PROJECT: SPRINGFIELD	PROJECT NO.: STP 2405(I)S
	DESIGN FILE NAME: /pave/04b038/pb038.dgn	PLOT DATE: 19-JUN-2012 08:11
	IPARM FILE NAME: pb038ia05.i	SURVEY DATE: 12/04
	SURVEYED BY: CLD SQUAD LEADER: CRB CLD 04-0397	DRAWN BY: SRB SHEET: 16 OF 42

DATUM
 VERTICAL _____
 HORIZONTAL _____

NOT TO SCALE