
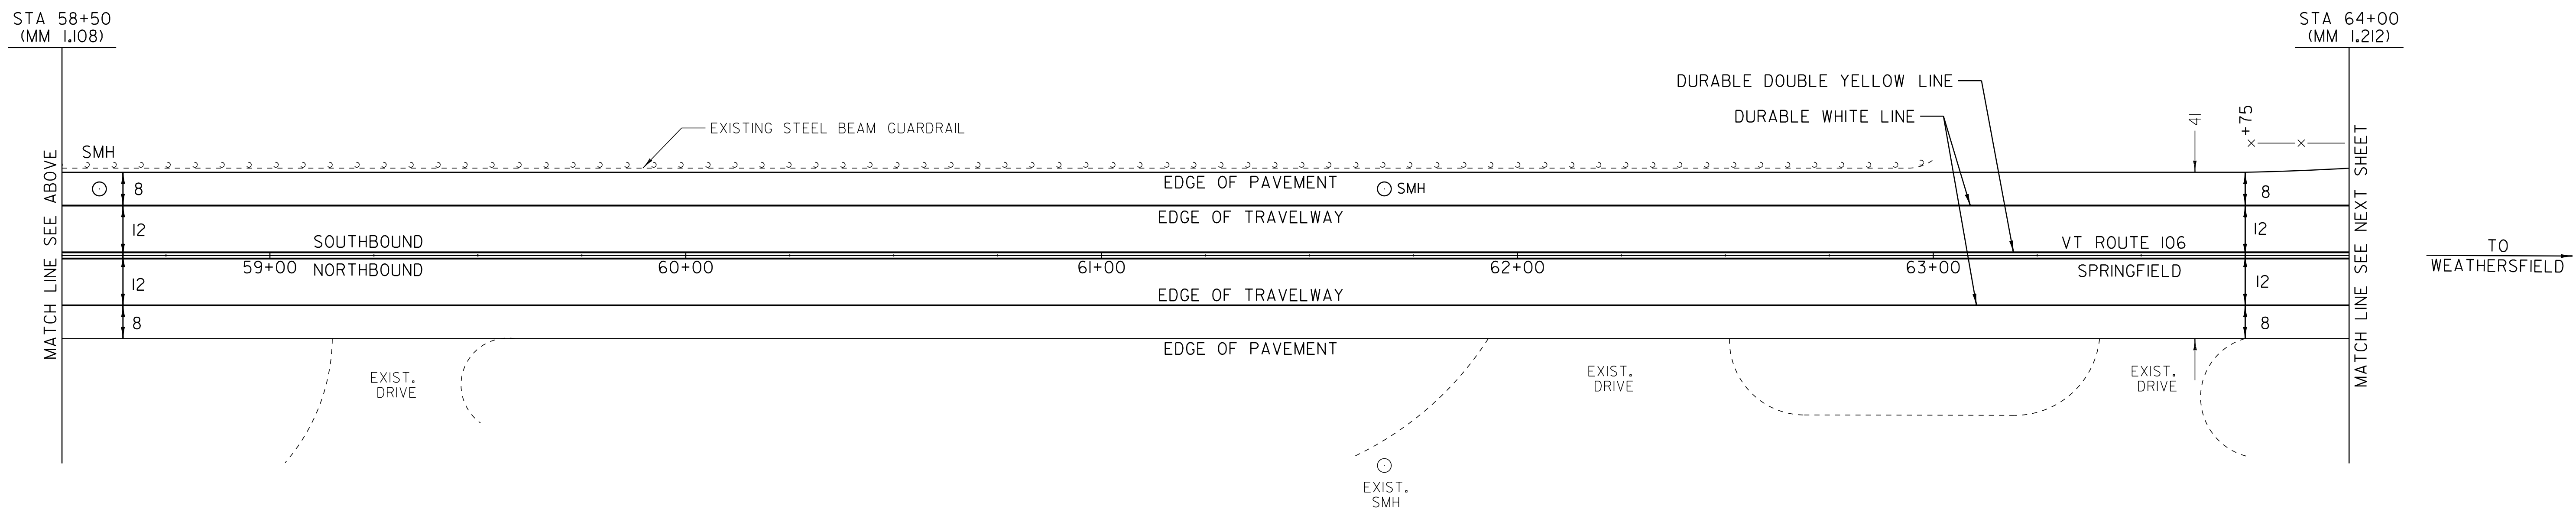


TEMPORARY AND DURABLE 4" WHITE LINE  
 STA 53+00 TO 64+00 SOLID LT  
 STA 53+00 TO 64+00 SOLID RT

CHANGING ELEVATION OF SMH  
~~STA 55+62 LT~~  
~~STA 58+59 LT~~  
~~STA 61+68 LT~~

TEMPORARY AND DURABLE 4" YELLOW LINE  
 STA 53+00 TO 64+00 SOLID LT & RT

SHOULDER BERM REMOVAL  
 STA 57+98 TO 63+00 LT

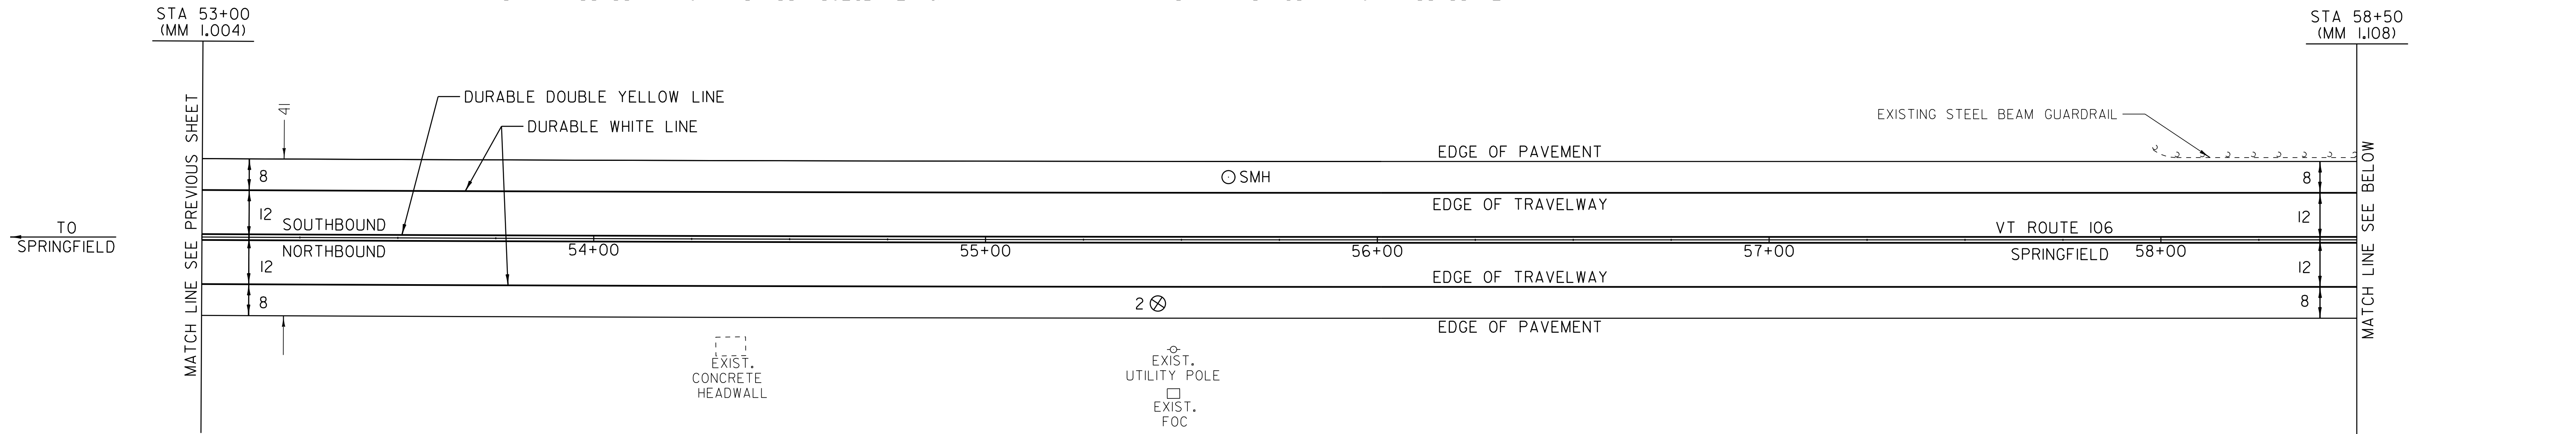

PRECISION VALLEY COMMUNICATIONS

VERMONT LIQUOR OUTLET

NOTE: ALL DIMENSIONS ARE FEET EXCEPT AS INDICATED

DATUM  
 VERTICAL \_\_\_\_\_  
 HORIZONTAL \_\_\_\_\_

PAVEMENT CORES - ⊗			
STA	TOTAL DEPTH (IN)	PCC	
2 STA 55+44 RT	2 1/2	N	

NOT TO SCALE

**PAVING PROJECT LAYOUT #6**

PROJECT: SPRINGFIELD	PROJECT NO. : STP 2405(I)S
DESIGN FILE NAME: /pave/04b038/pb038.dgn	PLOT DATE: 19-JUN-2012 08:11
IPARM FILE NAME: pb038ia06.i	SURVEY DATE: 12/04
SURVEYED BY: CLD	DRAWN BY: SRB
SQUAD LEADER: CRB	SHEET: 17 OF 42
CLD 04-0397	