
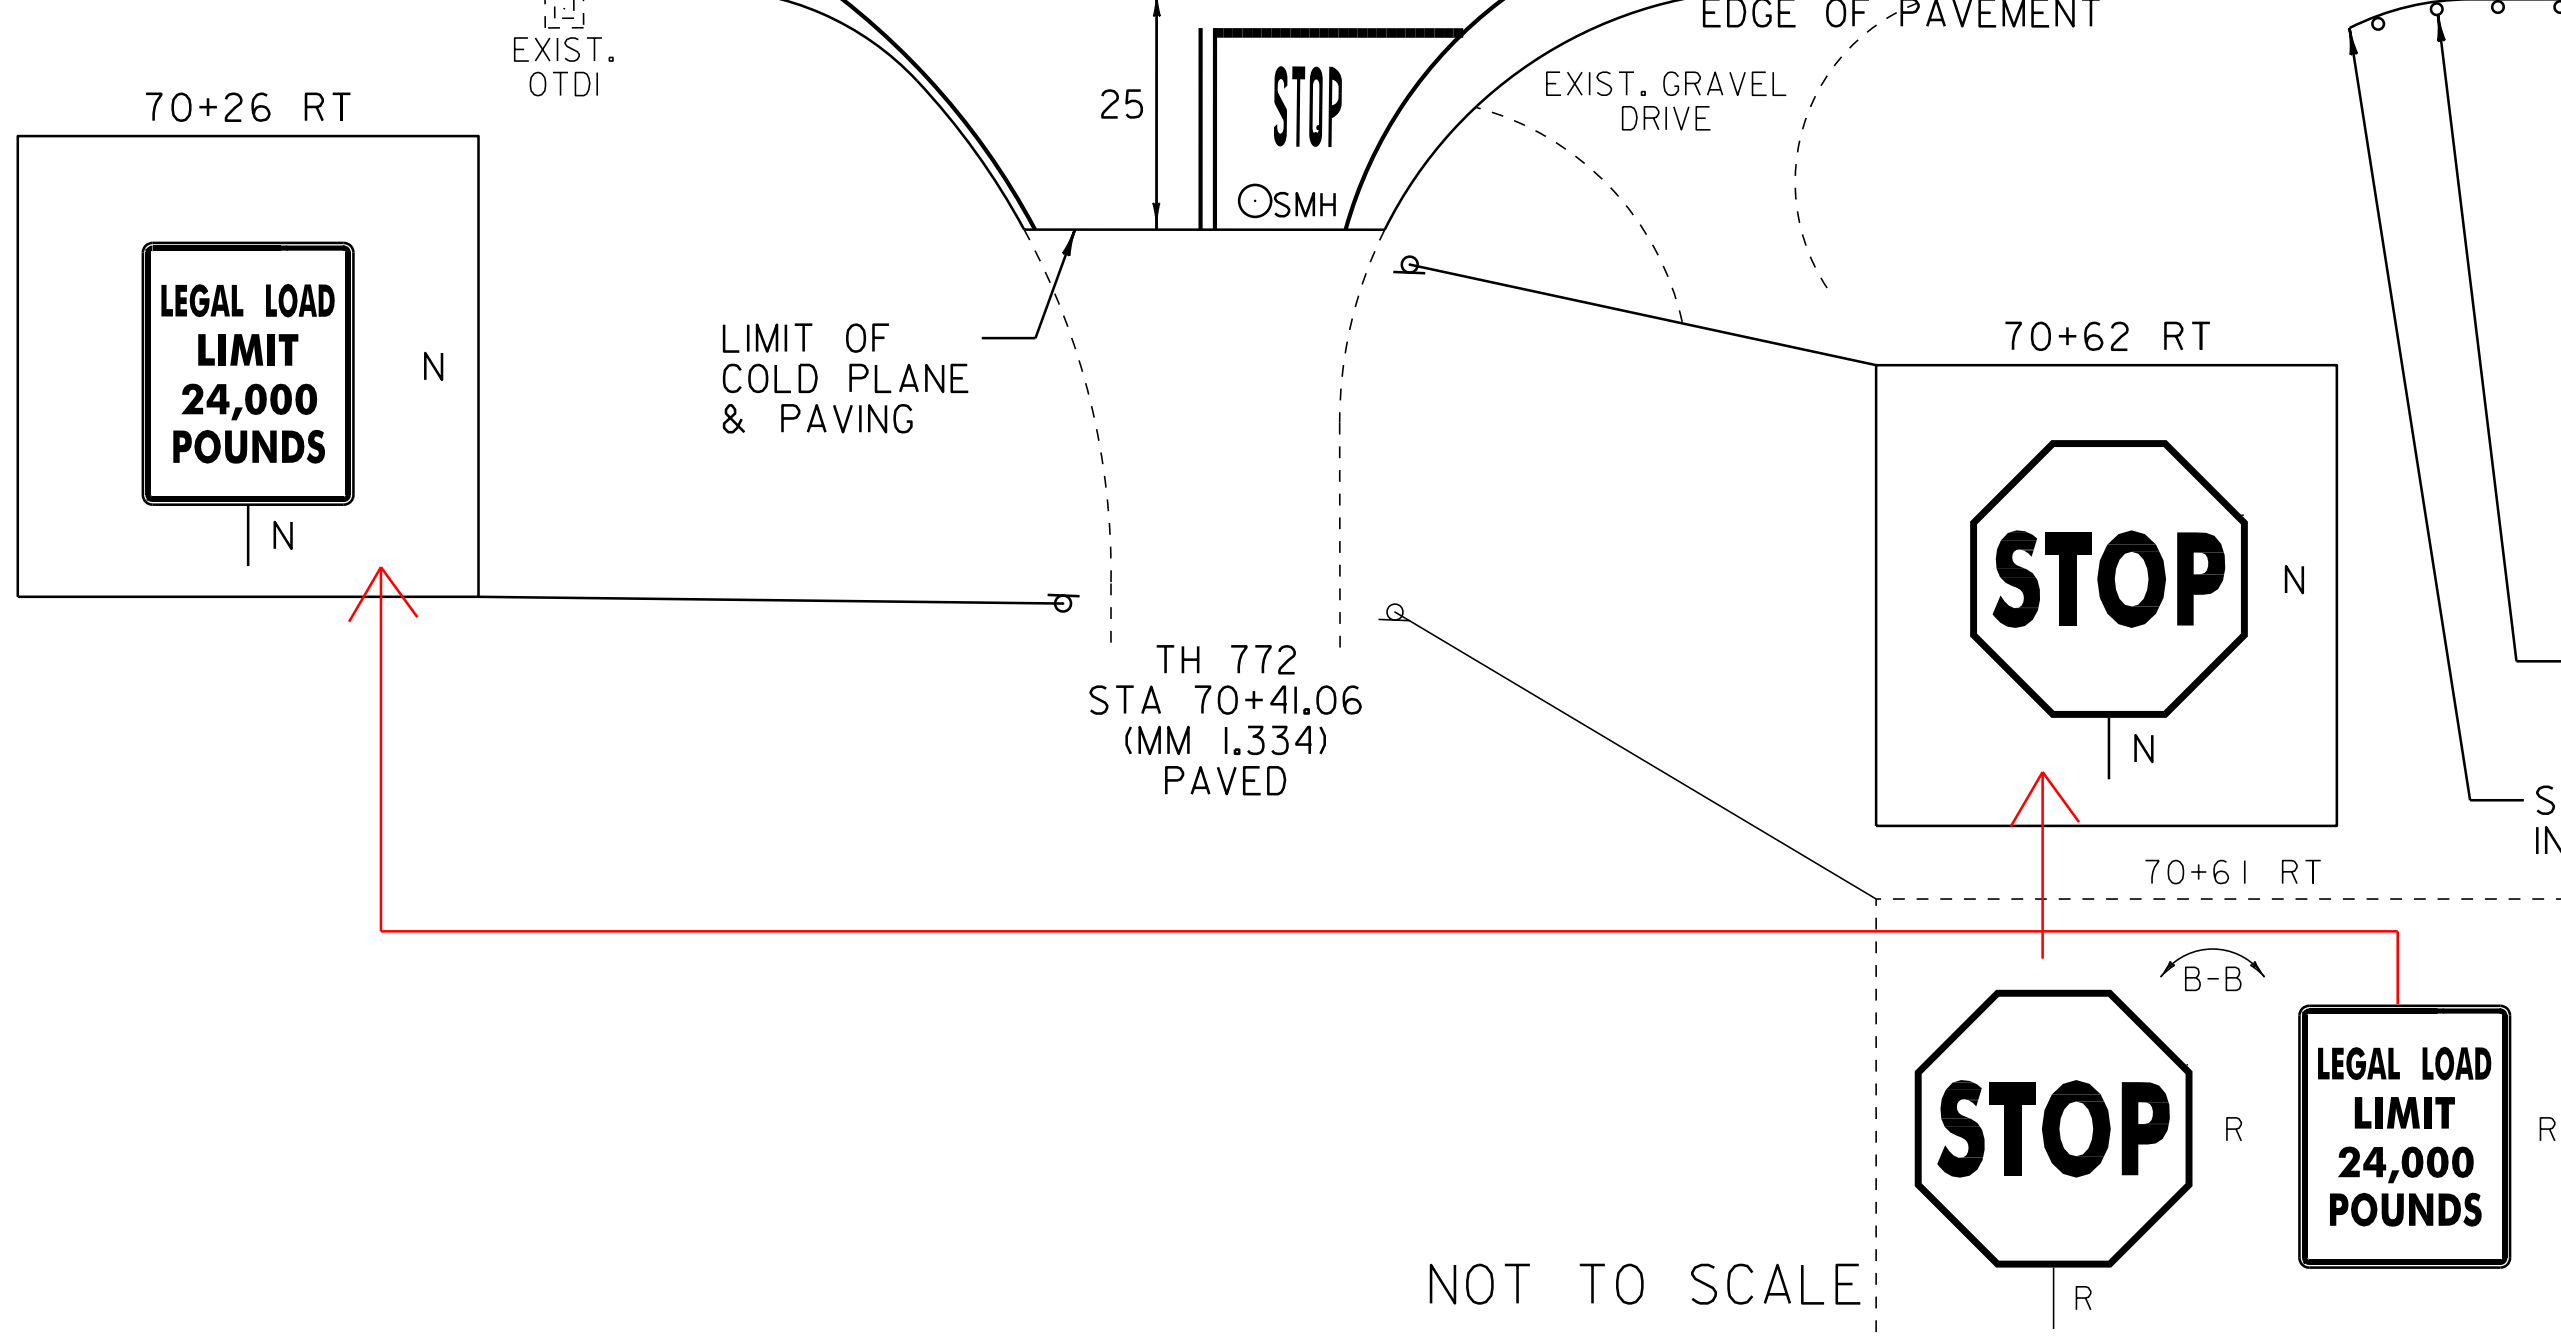


TEMPORARY AND DURABLE 4" WHITE LINE STA 64+00 TO 74+00 SOL ID LT STA 64+00 TO 70+23 SOL ID RT STA 70+55 TO 74+00 SOL ID RT	TEMPORARY AND DURABLE 24" STOP BAR STA 70+41 RT (TH 772)	CHANGING ELEVATION OF SMH STA 70+46 RT ADJUST ELEVATION OF VALVE BOX STA 70+50 RT STEEL BEAM GUARDRAIL STA 71+60 TO 71+73 RT STA 72+42 TO 72+54 LT	ANCHOR FOR STEEL BEAM RAIL STA 71+60 RT STA 71+73 67 LT STA 72+41 35 RT STA 72+54 LT REMOVAL AND DISP. GUARDRAIL STA 71+79 TO 72+04 RT STA 72+11 TO 72+36 LT	H.D. STEEL BEAM GUARDRAIL STA 71+73 67 TO 71+98 92 LT STA 71+73 TO 71+98 72+04 RT STA 72+11 16 TO 72+42 LT STA 72+16 23 TO 72+41 35 RT VERTICAL GRANITE CURB <del>STA 65+32 TO 65+86 LT</del> <del>STA 66+16 TO 66+70 LT</del> STA. 65+80 - STA. 65+22 LT	REMOVING SIGNS AS SHOWN - 2 REHAB DI STA. 69+80 RT
TEMPORARY AND DURABLE 4" YELLOW LINE STA 64+00 TO 70+21 SOL ID LT & RT STA 70+41 DOUBLE SOL ID RT (TH 772) STA 70+61 TO 74+00 SOL ID LT & RT	TEMPORARY AND DURABLE LETTER OR SYMBOL STA 70+50 RT - "STOP" (TH 772)				

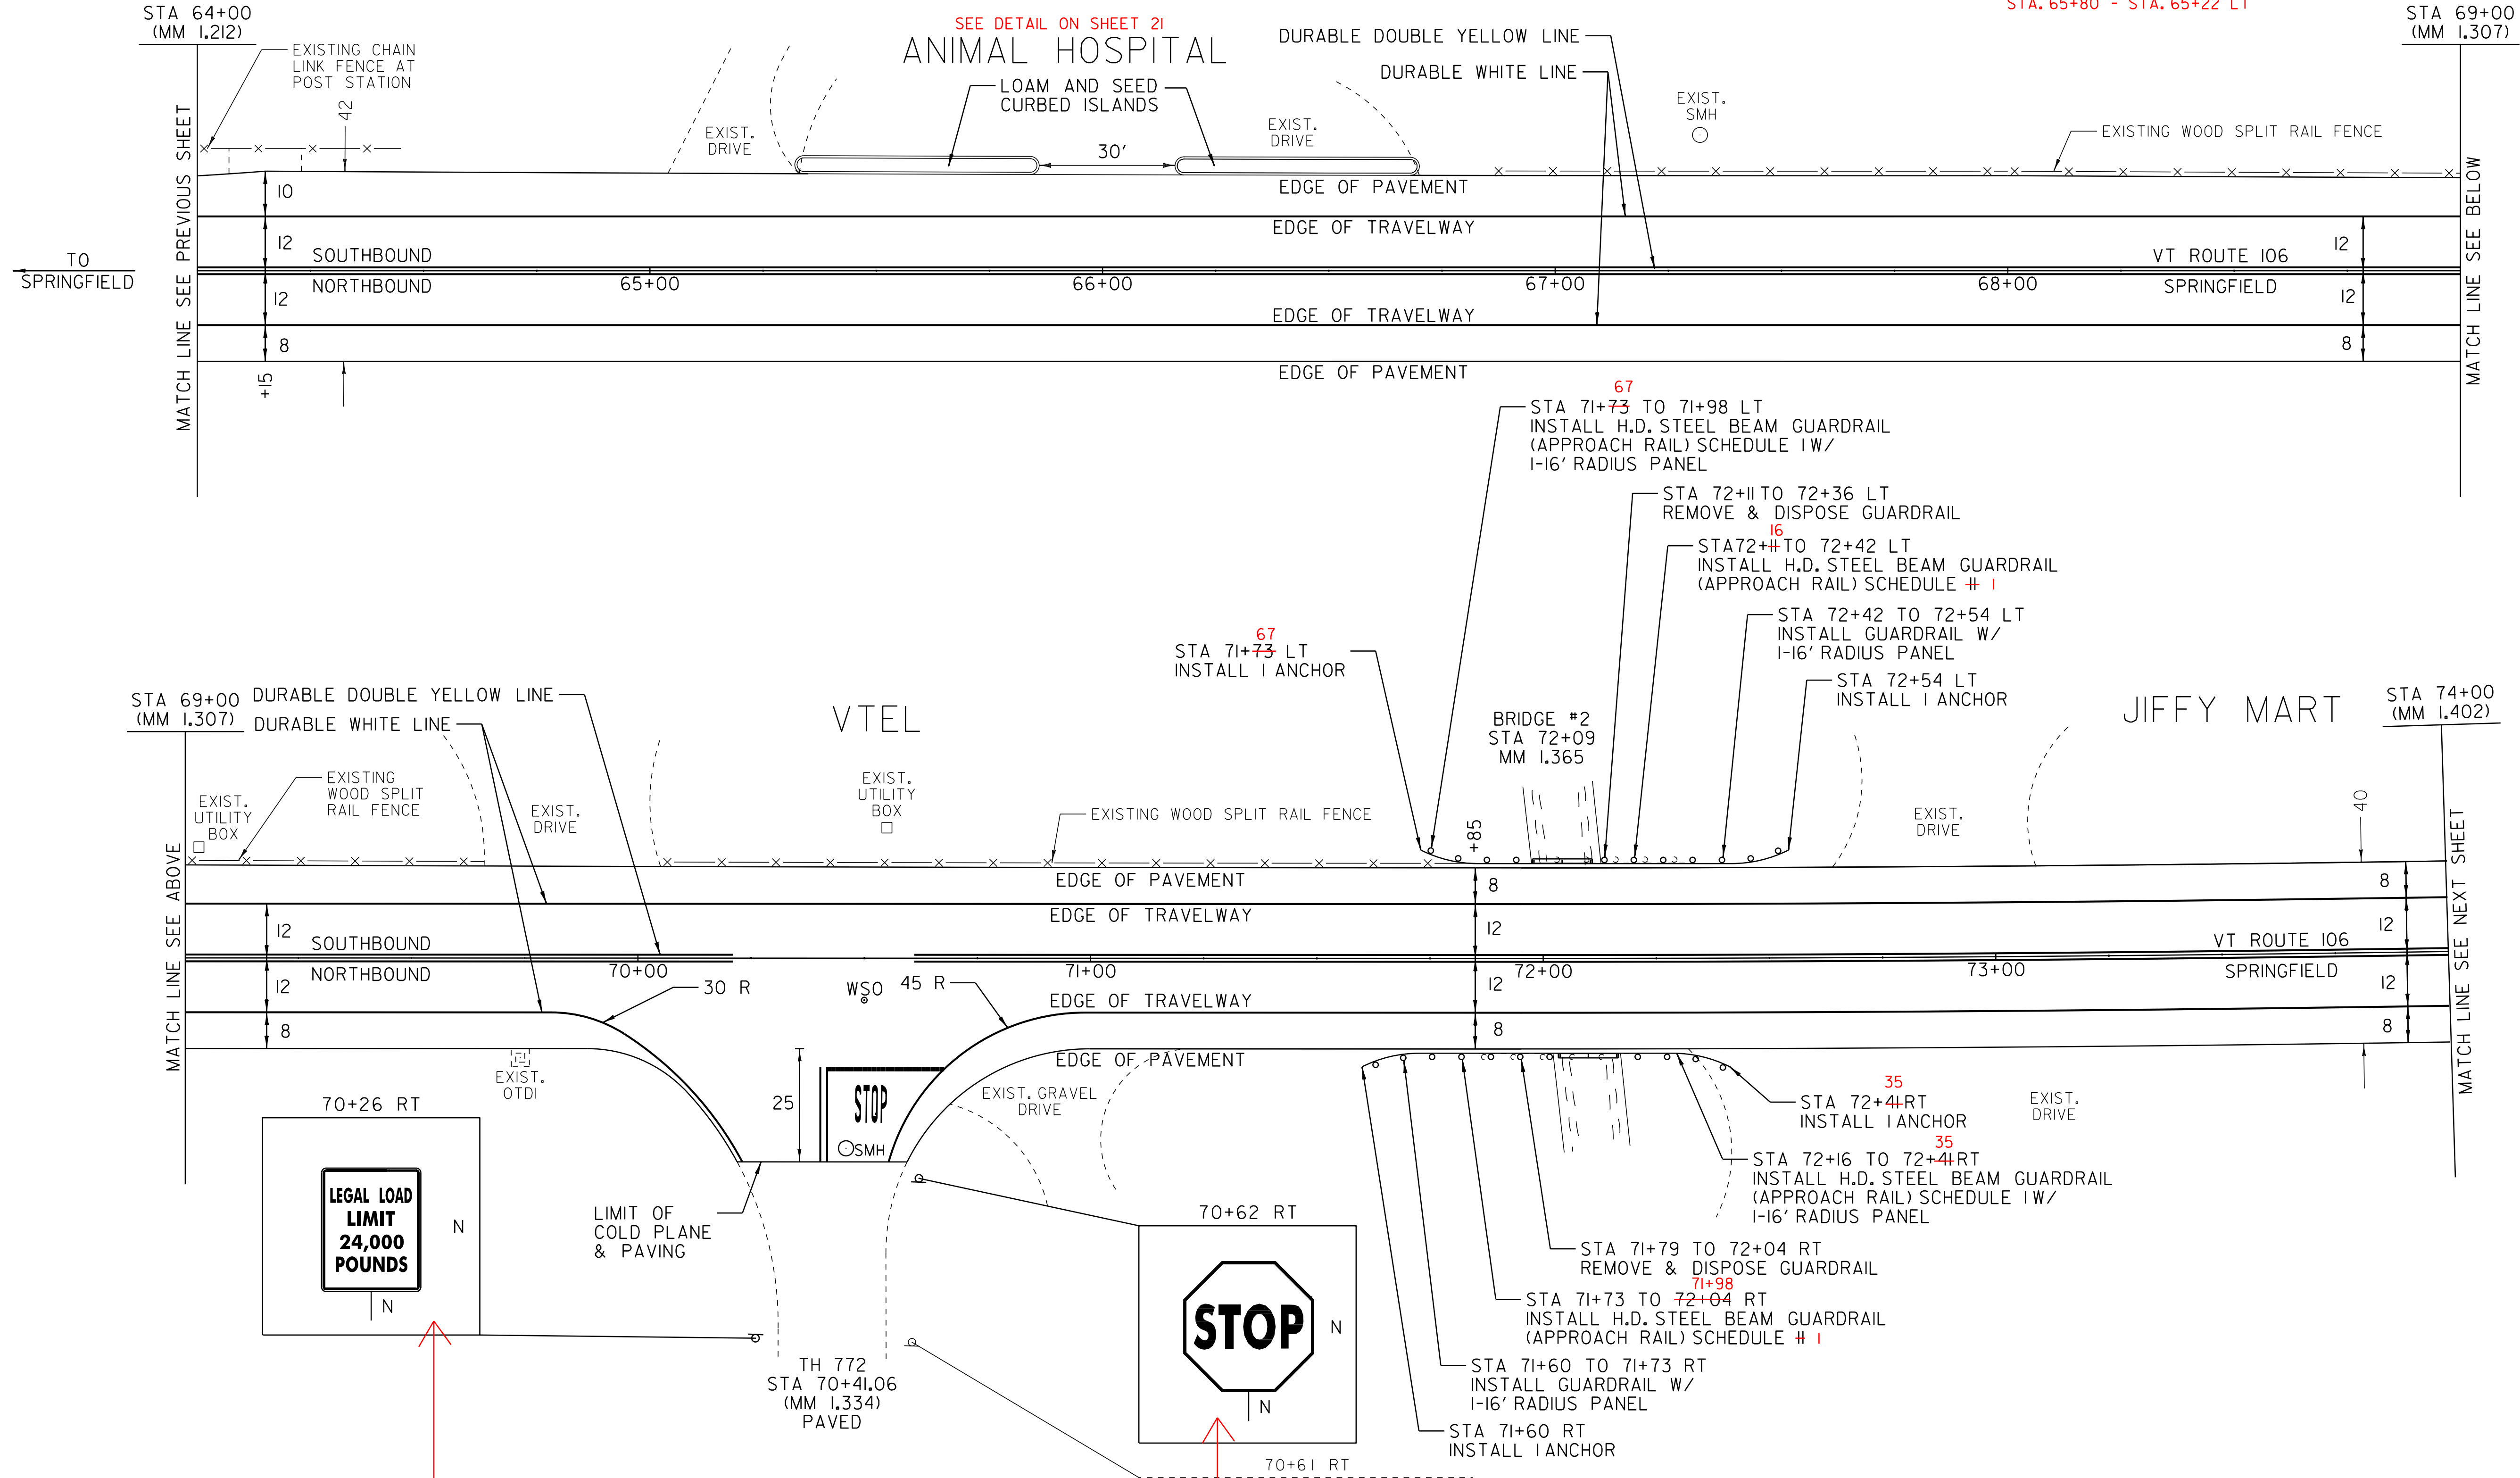

LEGEND

R	=	REMOVE EXISTING
S	=	SALVAGE
R & S	=	REMOVE AND SALVAGE
N	=	NEW
RET	=	RETAIN
B-B	=	BACK TO BACK
—	=	NEW RAIL
—	=	EXISTING RAIL

NOTE: ALL DIMENSIONS ARE FEET EXCEPT AS INDICATED

**PAVING PROJECT LAYOUT #7**

PROJECT: **SPRINGFIELD**

DESIGN FILE NAME: /pave/04b038/pb038.dgn

IPARM FILE NAME: pb038ia07.i

SURVEYED BY: CLD

SQUAD LEADER: CRB

CLD 04-0397

PROJECT NO.: **STP 2405(I)S**

PLOT DATE: 19-JUN-2012 08:11

SURVEY DATE: 12/04

DRAWN BY: SRB

SHEET: 18 OF 42

DATUM

VERTICAL \_\_\_\_\_

HORIZONTAL \_\_\_\_\_

NOT TO SCALE