


TEMPORARY AND DURABLE 4" WHITE LINE
 STA 85+00 TO 87+75 SOLID RT
 STA 85+00 TO 87+75 SOLID LT

TEMPORARY AND DURABLE 4" YELLOW LINE
 STA 85+00 TO 87+75 SOLID LT & RT

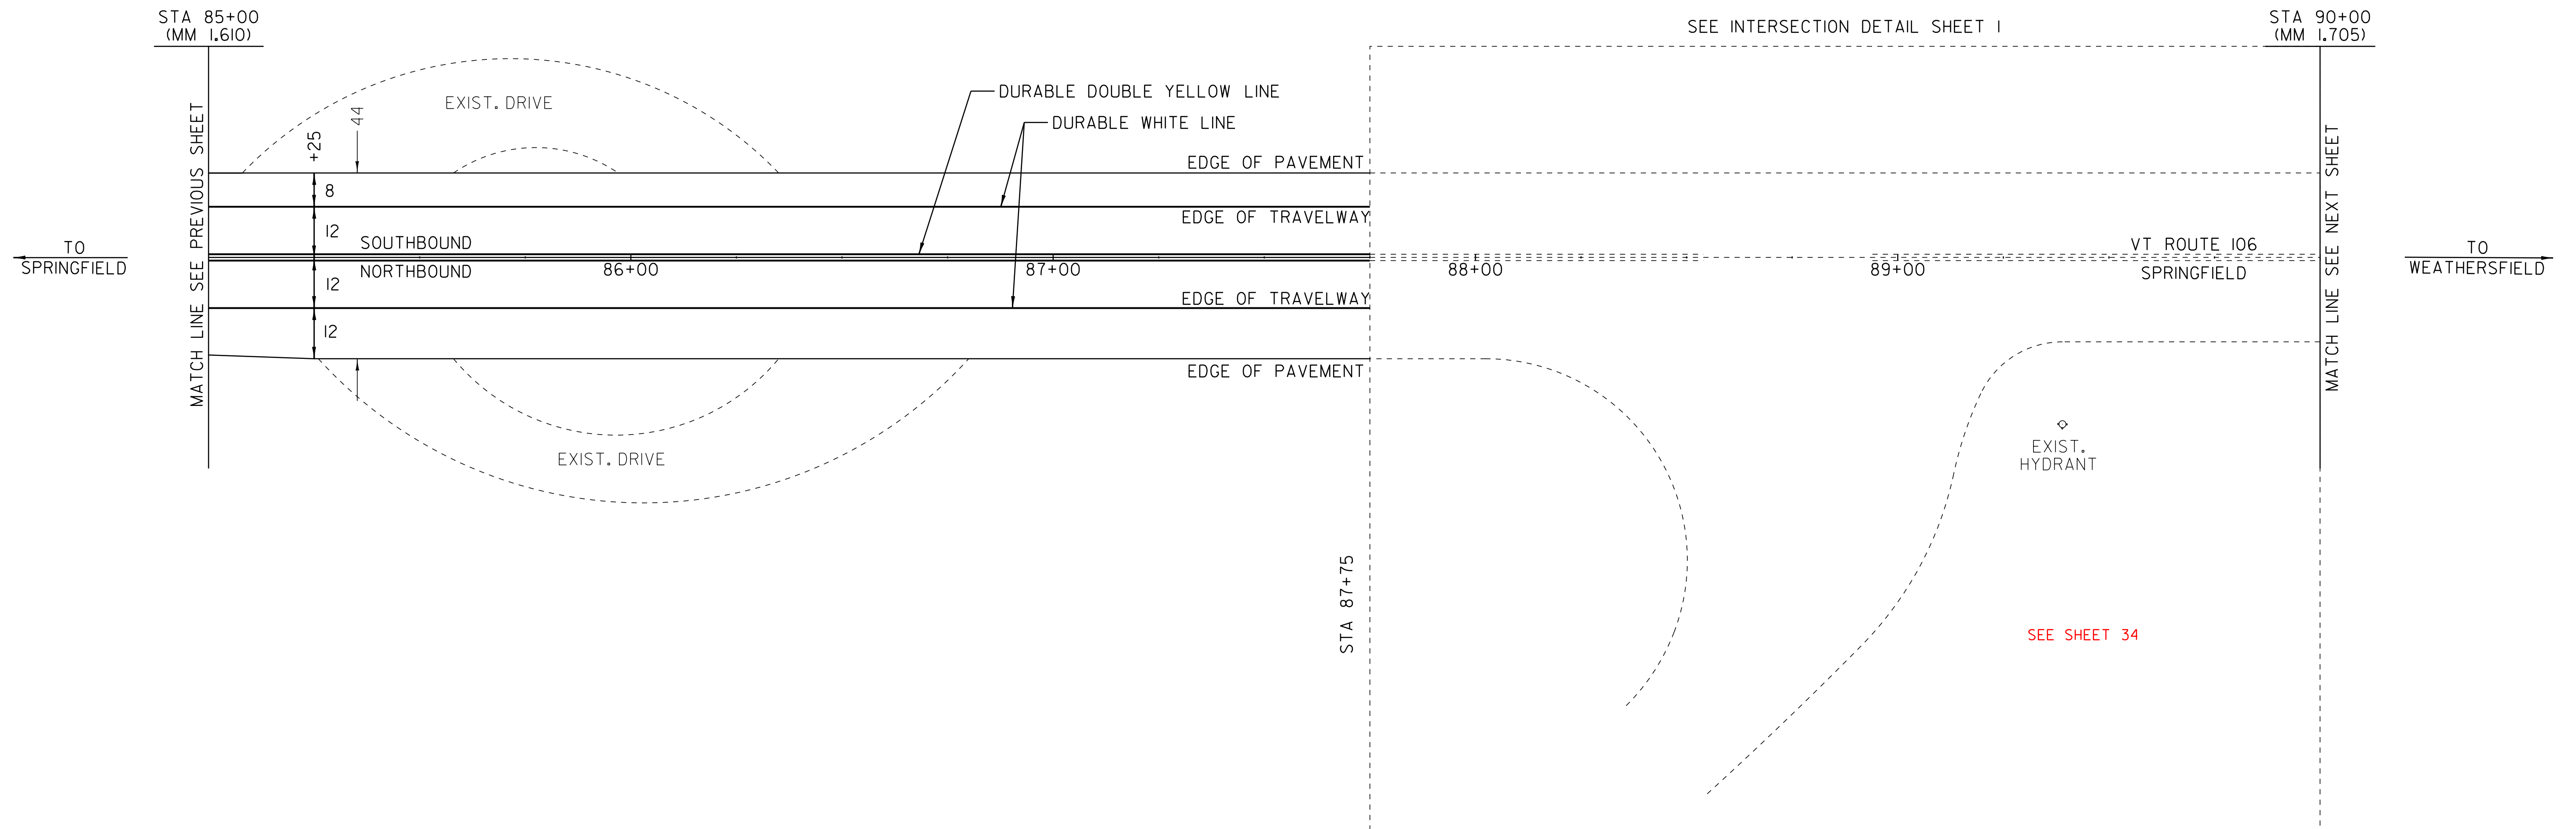

- LEGEND**
- R = REMOVE EXISTING
 - S = SALVAGE
 - R & S = REMOVE AND SALVAGE
 - N = NEW
 - RET = RETAIN
 - B-B = BACK TO BACK
 - = NEW RAIL
 - = EXISTING RAIL

NOTE: ALL DIMENSIONS ARE FEET EXCEPT AS INDICATED

**PAVING
PROJECT
LAYOUT #9**

PROJECT: SPRINGFIELD	PROJECT NO. : STP 2405(I)S
DESIGN FILE NAME: /pave/04b038/pb038.dgn	PLOT DATE: 19-JUN-2012 08:11
IPARM FILE NAME: pb038la09.i	SURVEY DATE: 12/04
SURVEYED BY: CLD	DRAWN BY: SRB
SQUAD LEADER: CRB	SHEET: 20 OF 42
CLD 04-0397	

DATUM

VERTICAL	_____
HORIZONTAL	_____

NOT TO SCALE