
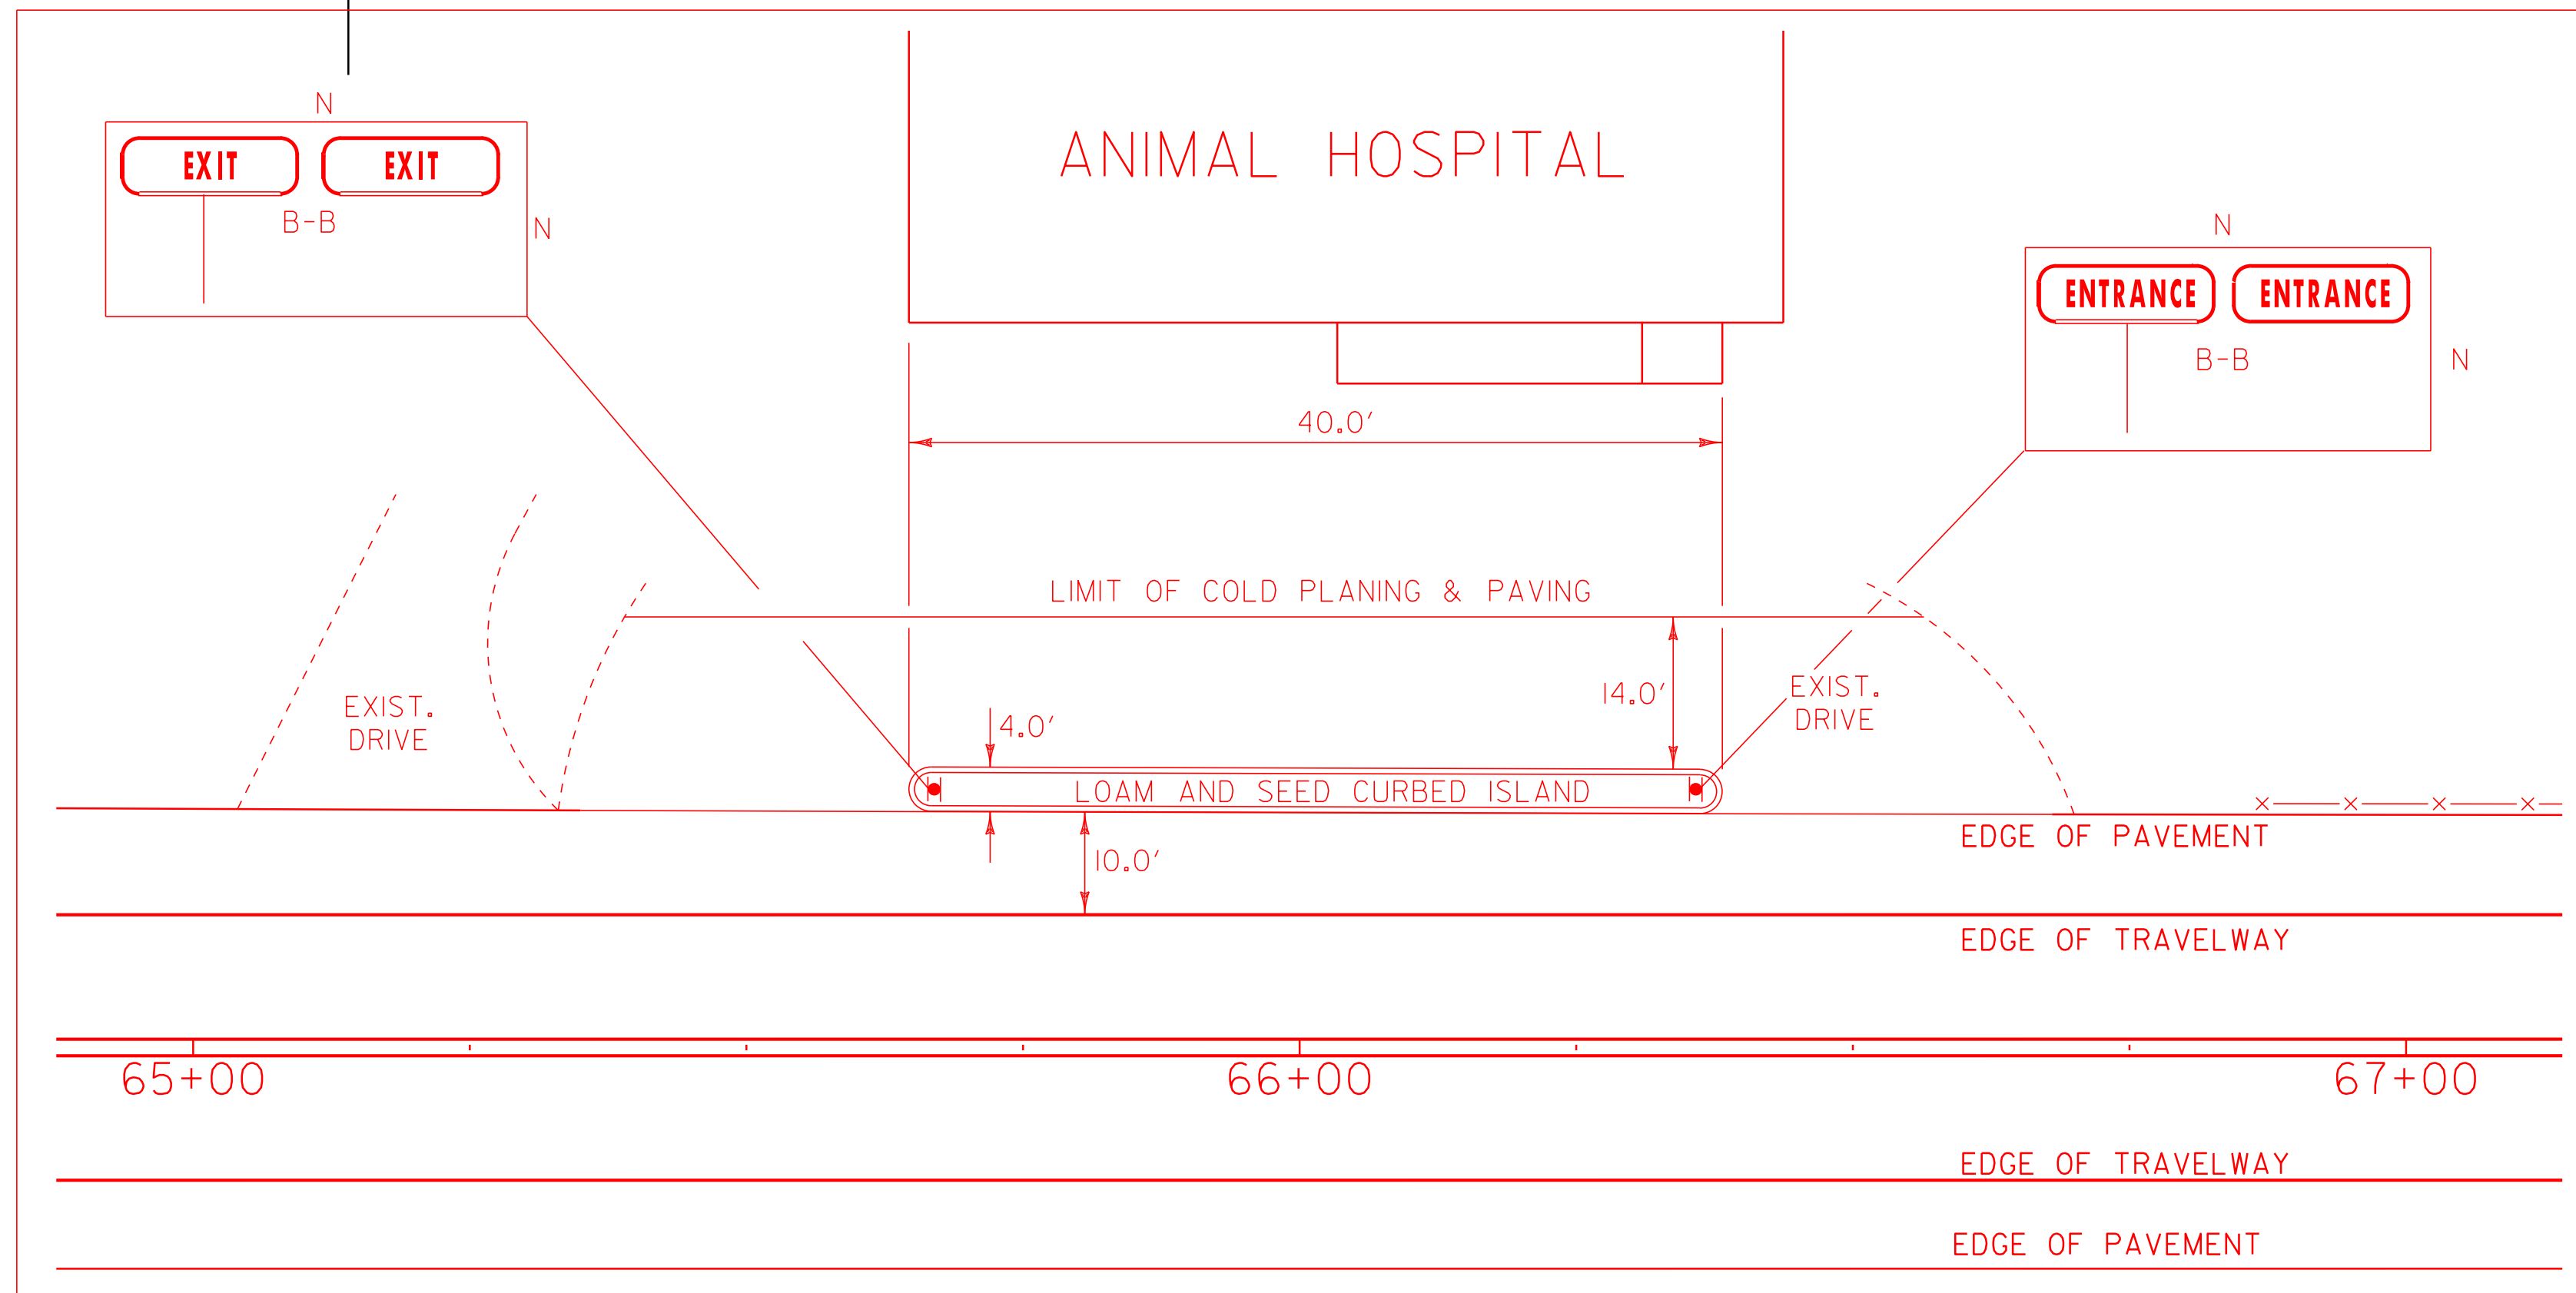


TEMPORARY AND DURABLE 4" WHITE LINE
 STA 90+00 TO 95+50 SOLID LT
 STA 90+00 TO 95+50 SOLID RT

TEMPORARY AND DURABLE 4" YELLOW LINE
 STA 90+00 TO 95+50 SOLID LT & RT

WOODBURY FLORIST

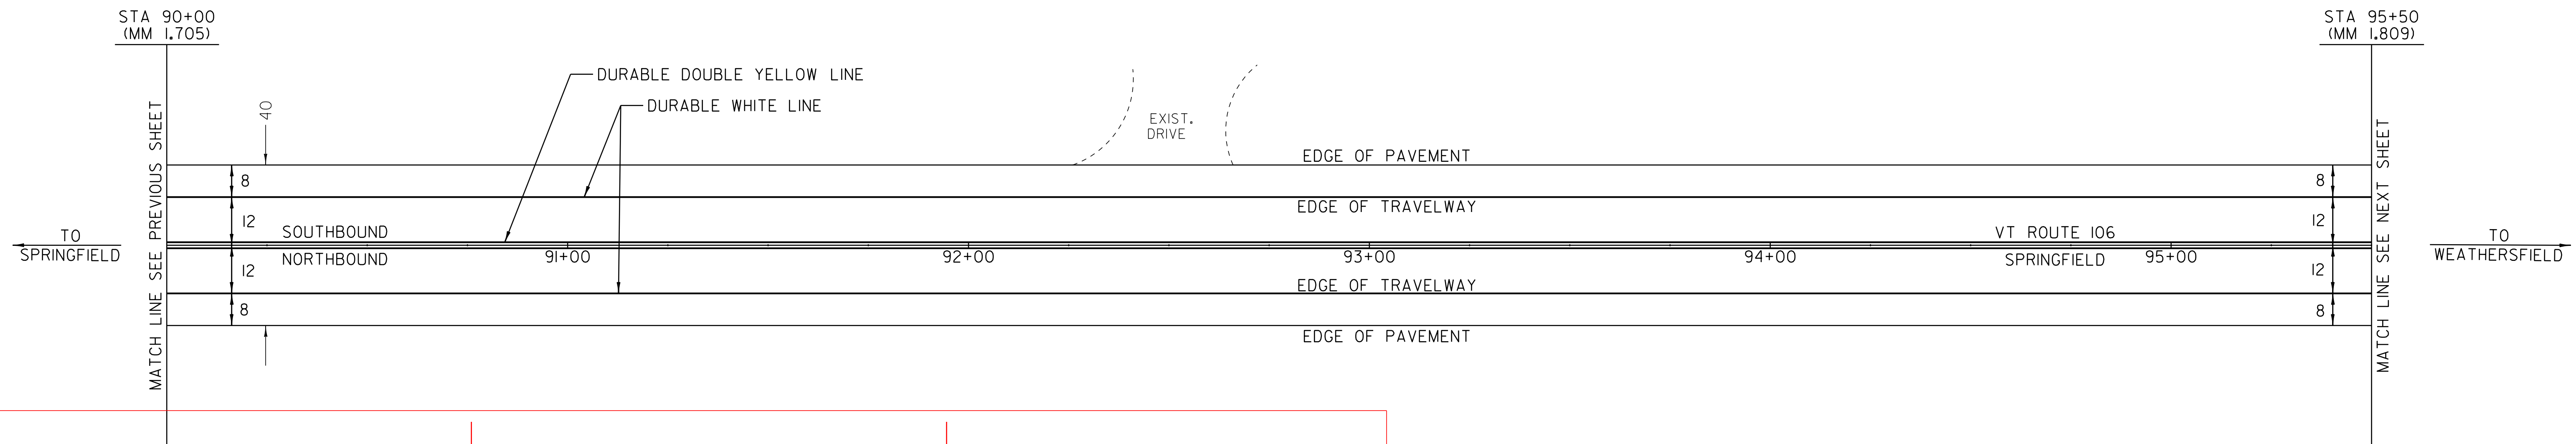

DETAIL REFERENCED ON SHEET 18

NOT TO SCALE

DATUM
 VERTICAL _____
 HORIZONTAL _____

- LEGEND
- R = REMOVE EXISTING
 - S = SALVAGE
 - R & S = REMOVE AND SALVAGE
 - N = NEW
 - RET = RETAIN
 - B-B = BACK TO BACK
 - = NEW RAIL
 - = EXISTING RAIL

NOTE: ALL DIMENSIONS ARE FEET EXCEPT AS INDICATED

**PAVING
 PROJECT
 LAYOUT #10**

PROJECT:	SPRINGFIELD	PROJECT NO.:	STP 2405(I)S
DESIGN FILE NAME:	/pave/04b038/pb038.dgn	PLOT DATE:	19-JUN-2012 08:11
IPARM FILE NAME:	pb038la10.i	SURVEY DATE:	12/04
SURVEYED BY:	CLD	DRAWN BY:	SRB
SQUAD LEADER:	CRB	SHEET:	21 OF 42
CLD 04-0397			