

TEMPORARY AND DURABLE 4" WHITE LINE
 STA 112+00 TO 117+50 SOLID LT
 STA 112+00 TO 117+50 SOLID RT

REHABILITATION OF DI, CB, OR MH, CLASS I
 STA 114+20 DI RT
 STA 116+29 DI RT


SHOULDER BERM REMOVAL
 STA 112+00 TO 117+50 LT

CONSTRUCT SIDEWALK RAMP
 STA 112+83 RT (TYPE 1)
 STA 113+10 RT (TYPE 1)
 STA 113+39 RT (TYPE 1)
 STA 116+70 RT (TYPE 1)
 STA 117+18 RT (TYPE 1)
 STA 117+49 RT (TYPE 1)

BITUMINOUS
 SIDEWALK
 RAMPS

TEMPORARY AND DURABLE 4" YELLOW LINE
 STA 112+00 TO 117+50 SOLID LT & RT

CHANGING ELEVATION OF SMH
 STA ~~116+41~~ RT

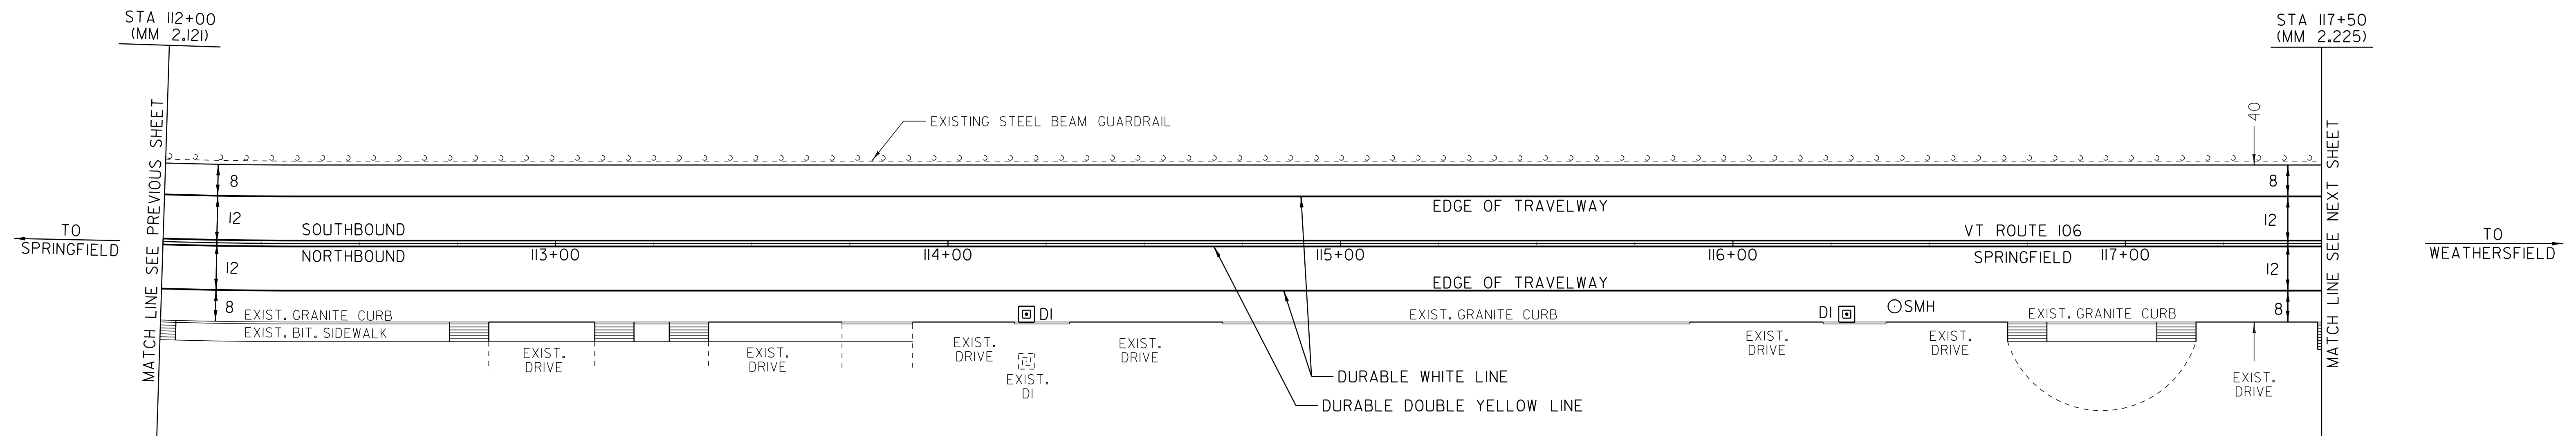

DATUM
 VERTICAL _____
 HORIZONTAL _____

NOT TO SCALE

- LEGEND**
- R = REMOVE EXISTING
 - S = SALVAGE
 - R & S = REMOVE AND SALVAGE
 - N = NEW
 - RET = RETAIN
 - B-B = BACK TO BACK
 - = NEW RAIL
 - - - = EXISTING RAIL

NOTE: ALL DIMENSIONS ARE FEET EXCEPT AS INDICATED

**PAVING
 PROJECT
 LAYOUT #13**

PROJECT: SPRINGFIELD	PROJECT NO. : STP 2405(I)S
DESIGN FILE NAME: /pave/04b038/pb038.dgn	PLOT DATE: 19-JUN-2012 08:11
IPARM FILE NAME: pb038la13.i	SURVEY DATE: 12/04
SURVEYED BY: CLD	DRAWN BY: SRB
SQUAD LEADER: CRB	SHEET: 24 OF 42
CLD 04-0397	