

TEMPORARY AND DURABLE 4" WHITE LINE
 STA 123+00 TO 127+55 SOLID RT
 STA 123+00 TO 127+59 SOLID LT
 STA 127+82 TO 128+50 SOLID RT
 STA 127+84 TO 128+50 SOLID LT

TEMPORARY AND DURABLE 4" YELLOW LINE
 STA 123+00 TO 127+49 SOLID LT & RT
 STA 127+69 DOUBLE SOLID RT (TH 740)
 STA 127+75 DOUBLE SOLID LT (TH 740)
 STA 127+95 TO 128+50 SOLID LT & RT

TEMPORARY AND DURABLE 24" STOP BAR
 STA 127+69 RT (TH 740)
 STA 127+75 LT (TH 740)

TEMPORARY AND DURABLE LETTER OR SYMBOL
 STA 127+67 LT - "STOP" (TH 740)
 STA 127+77 RT - "STOP" (TH 740)

TEMPORARY AND DURABLE CROSSWALK MARKING W/ DIAGONAL LINES (MOD.)
 STA 127+58 TO 127+89 LT

REHABILITATION OF DI, CB, OR MH, CLASS I
 STA 124+85 DI LT

STEEL BEAM GUARDRAIL
 STA 127+33 TO 127+44 RT
~~STA 127+33 TO 127+46 LT~~
 STA 127+83 TO 128+07 RT

ANCHOR FOR STEEL BEAM GUARD RAIL
 STA 127+44 RT
~~STA 127+46 LT~~
 STA 127+83 RT





REMOVAL AND DISP. GUARDRAIL
 STA 127+33 TO 127+44 RT
~~STA 127+33 TO 127+46 LT~~
 STA 127+83 TO 128+07 RT

TERMINAL CONNECTOR FOR STEEL BEAM GUARD RAIL (MOD.)
~~STA 127+33 RT~~
~~STA 127+33 LT~~

SHOULDER BERM REMOVAL
 STA 128+07 TO 128+50 RT
 STA 128+15 TO 128+50 LT

REMOVING SIGNS
 AS SHOWN - 3

CONSTRUCT SIDEWALK RAMP W/ DETECTABLE WARNING SURFACE (YELLOW)
 STA 127+45 RT (TYPE 6)
 STA 127+55 LT (TYPE 6)
 STA 127+94 LT (TYPE 6)

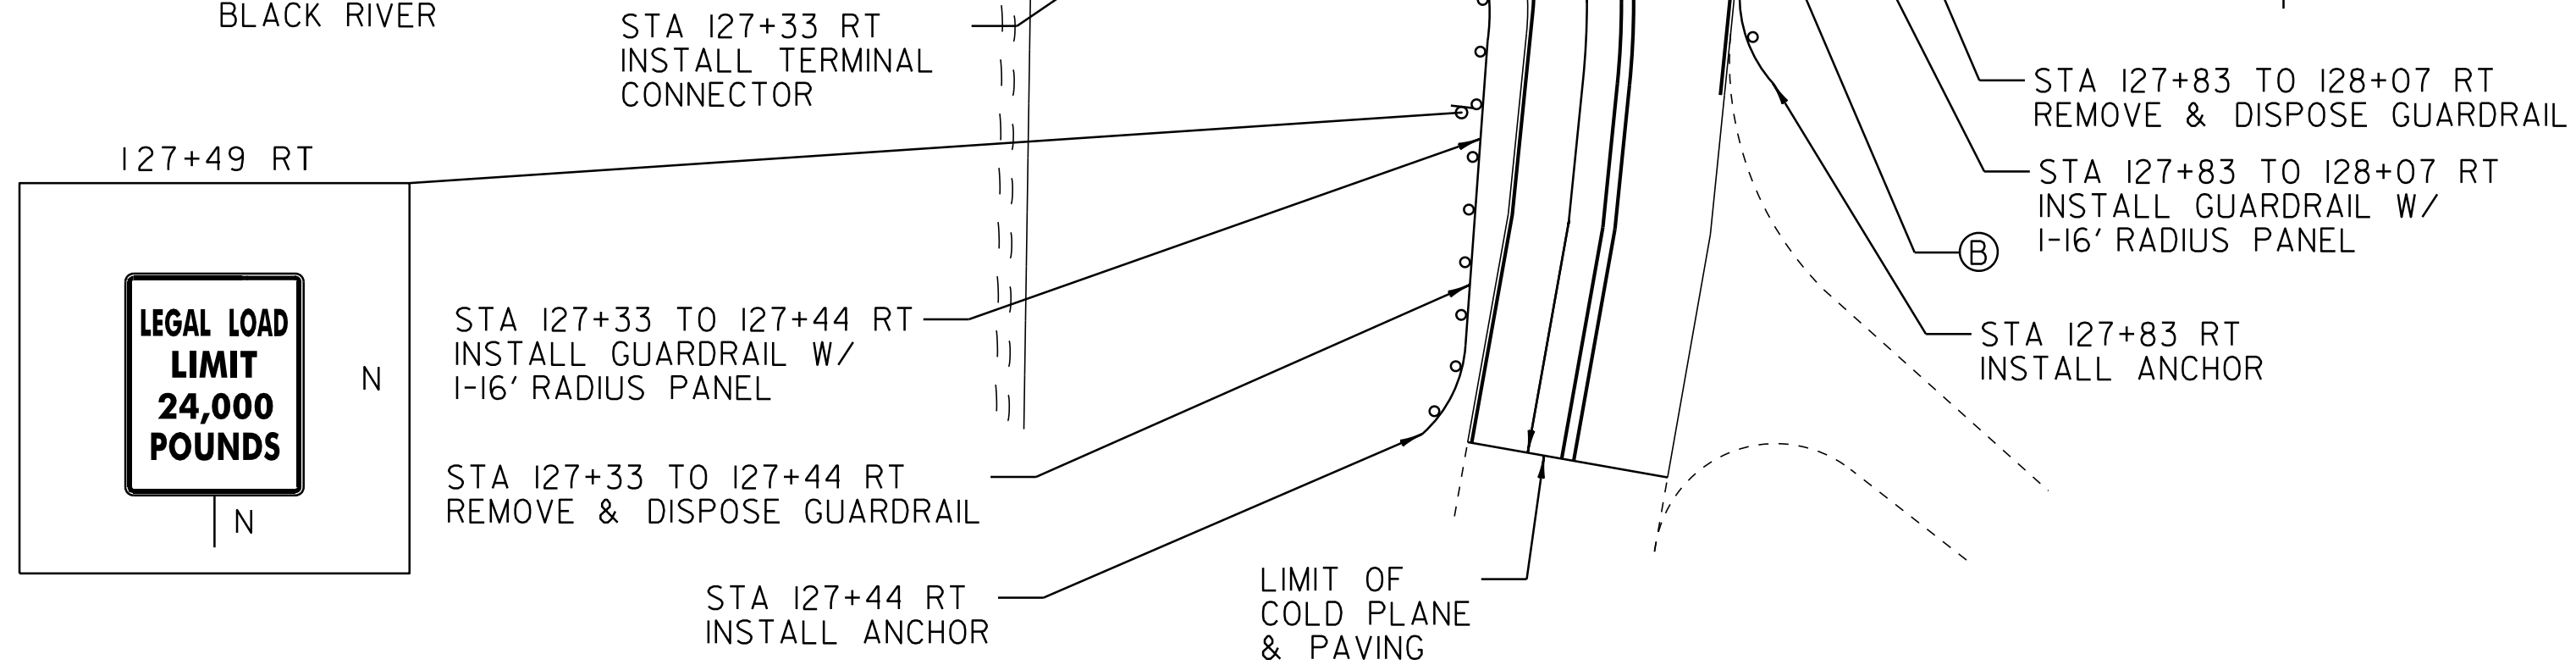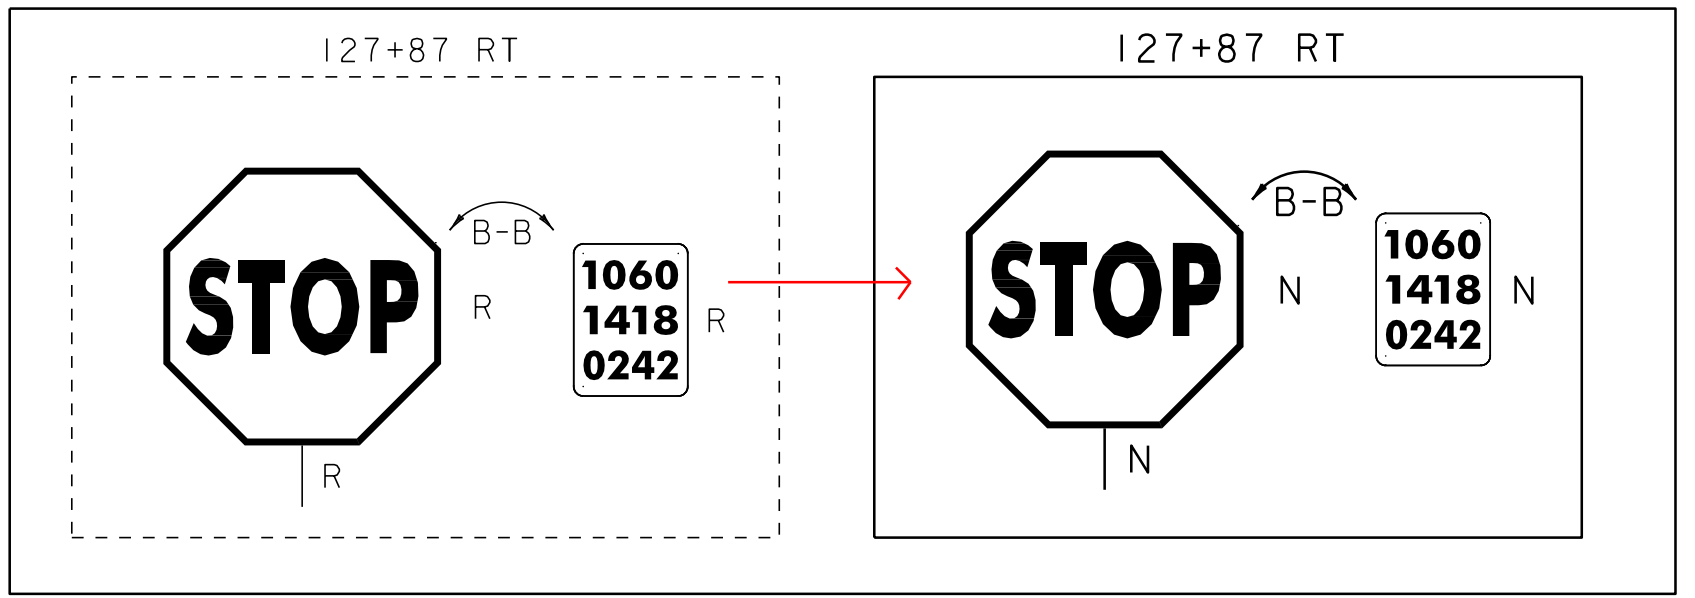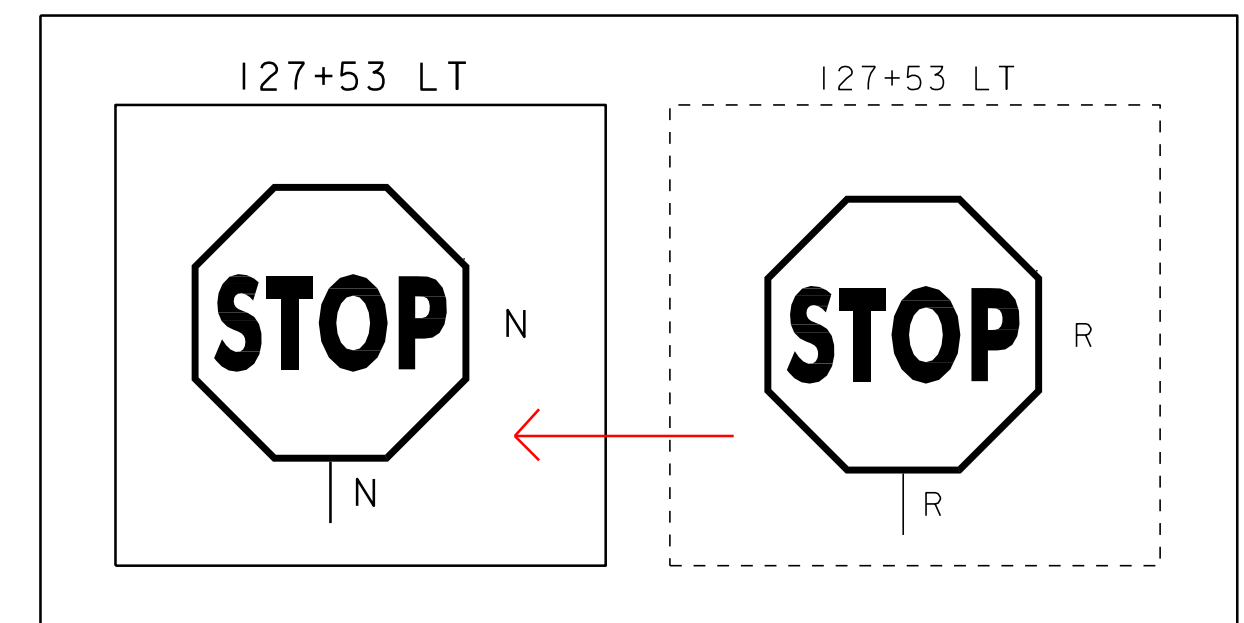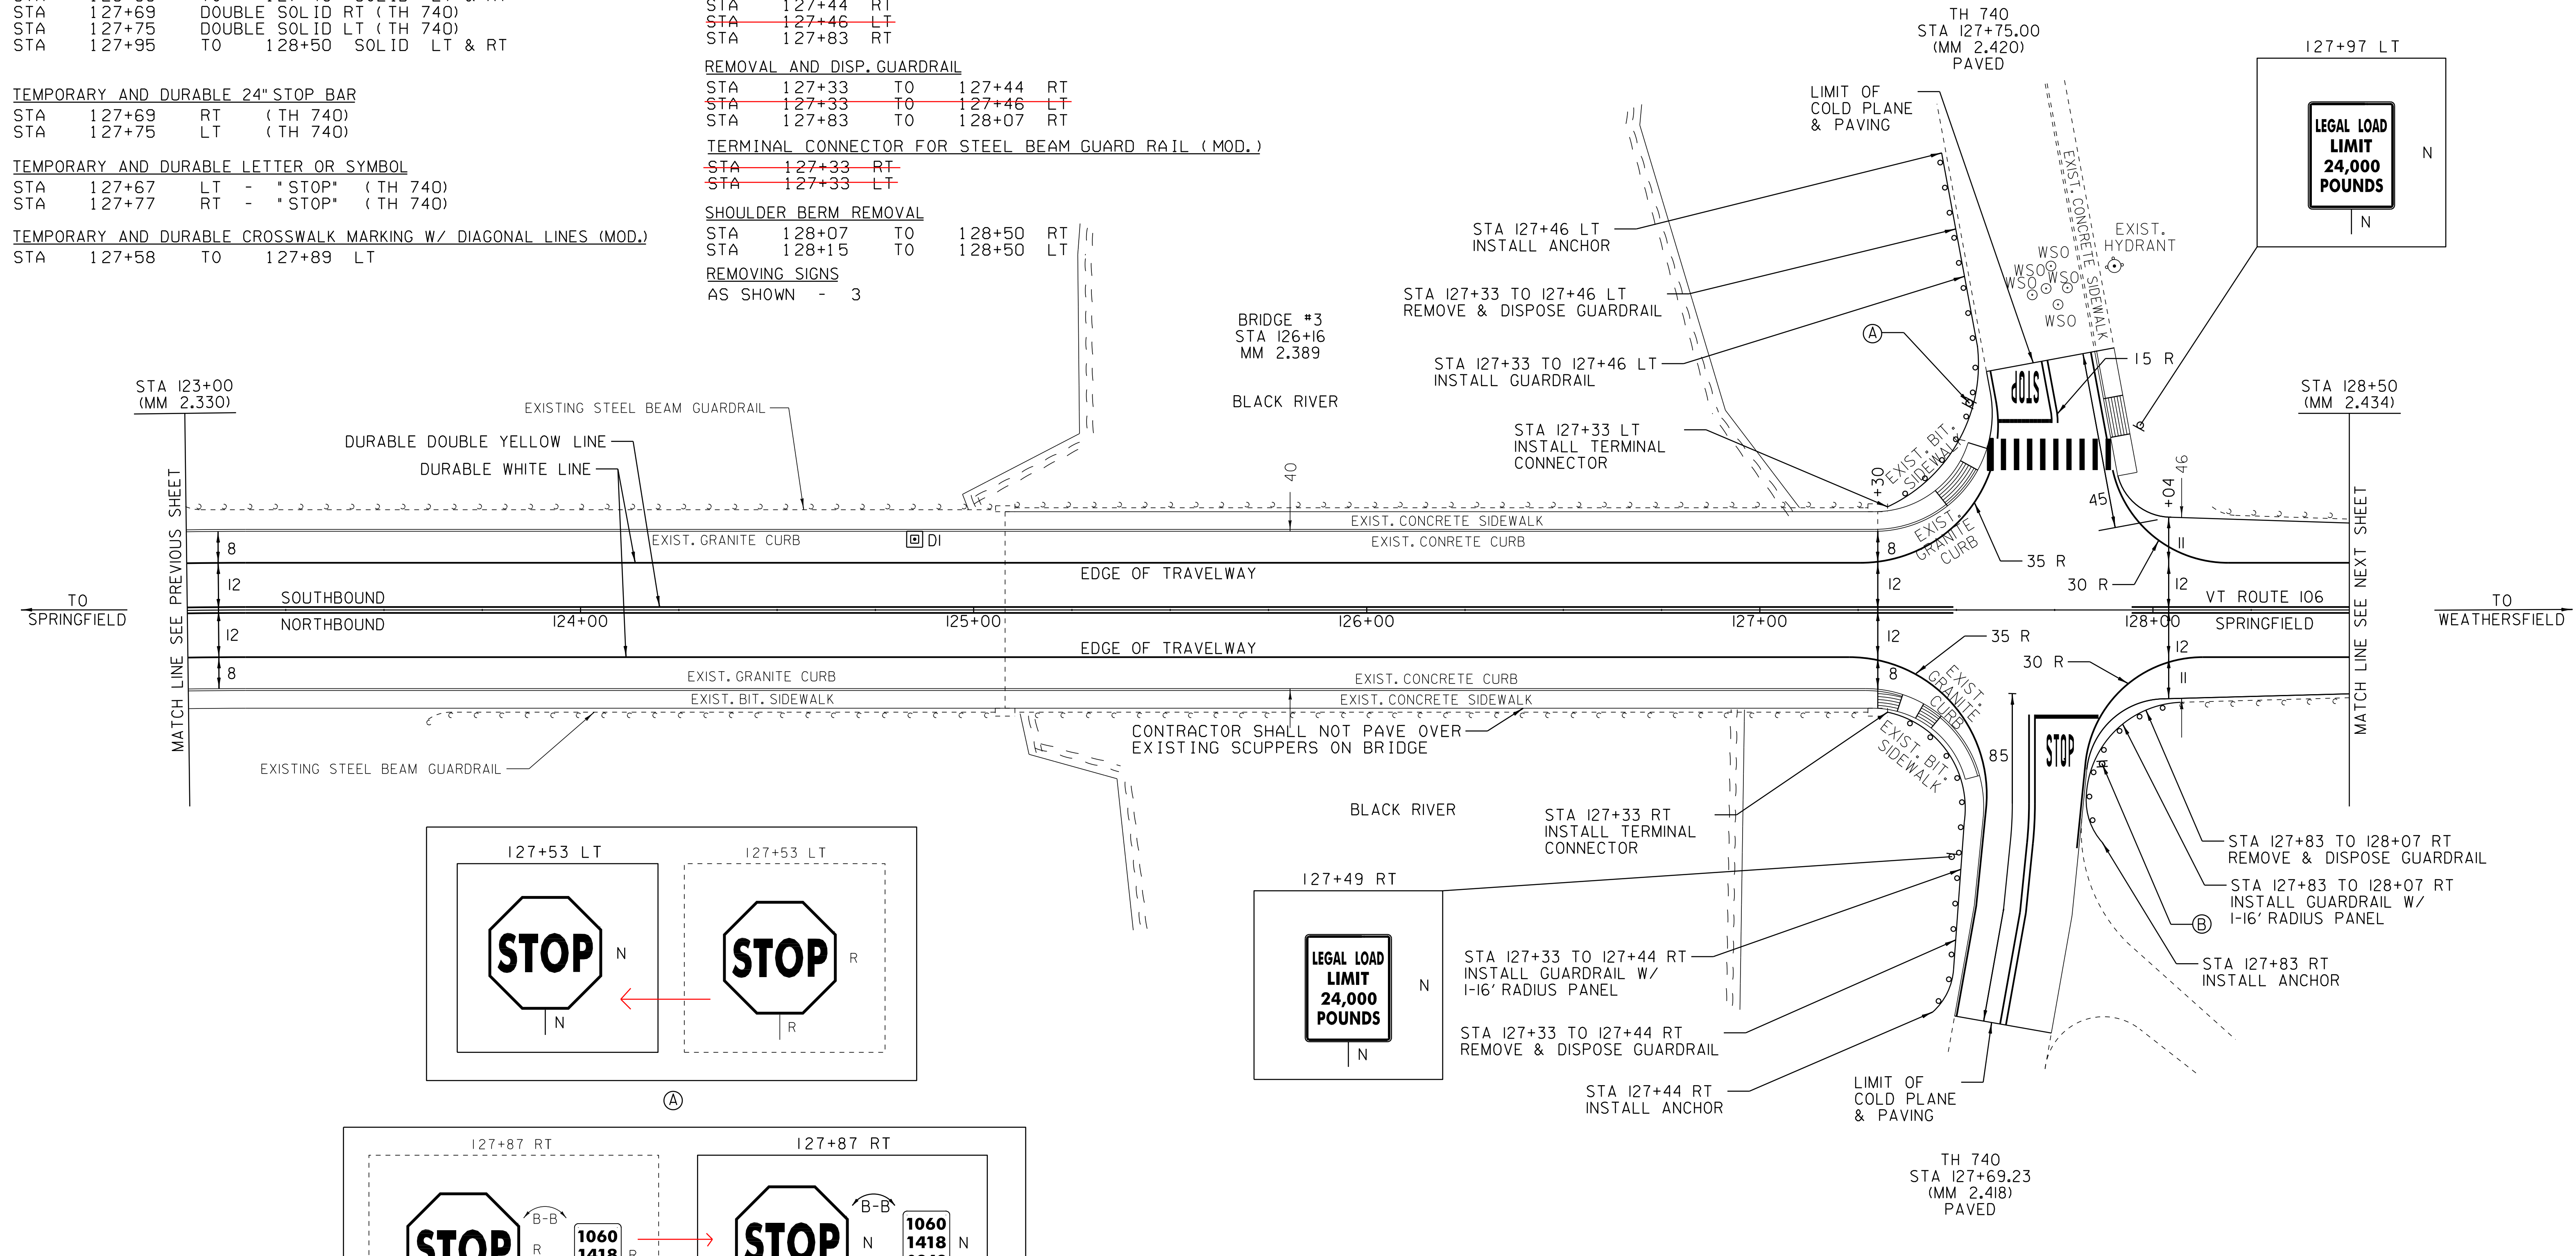

DATUM
 VERTICAL _____
 HORIZONTAL _____

NOT TO SCALE

- LEGEND**
- R = REMOVE EXISTING
 - S = SALVAGE
 - R & S = REMOVE AND SALVAGE
 - N = NEW
 - RET = RETAIN
 - B-B = BACK TO BACK
 - = NEW RAIL
 - - - = EXISTING RAIL

PAVING PROJECT LAYOUT #15

NOTE: ALL DIMENSIONS ARE FEET EXCEPT AS INDICATED

PROJECT: SPRINGFIELD	PROJECT NO.: STP 2405(I)S
DESIGN FILE NAME: /pave/04b038/pb038.dgn	PLOT DATE: 19-JUN-2012 08:11
IPARM FILE NAME: pb038la15.l	SURVEY DATE: 12/04
SURVEYED BY: CLD	DRAWN BY: SRB
SQUAD LEADER: CRB	SHEET: 26 OF 42
CLD 04-0397	