
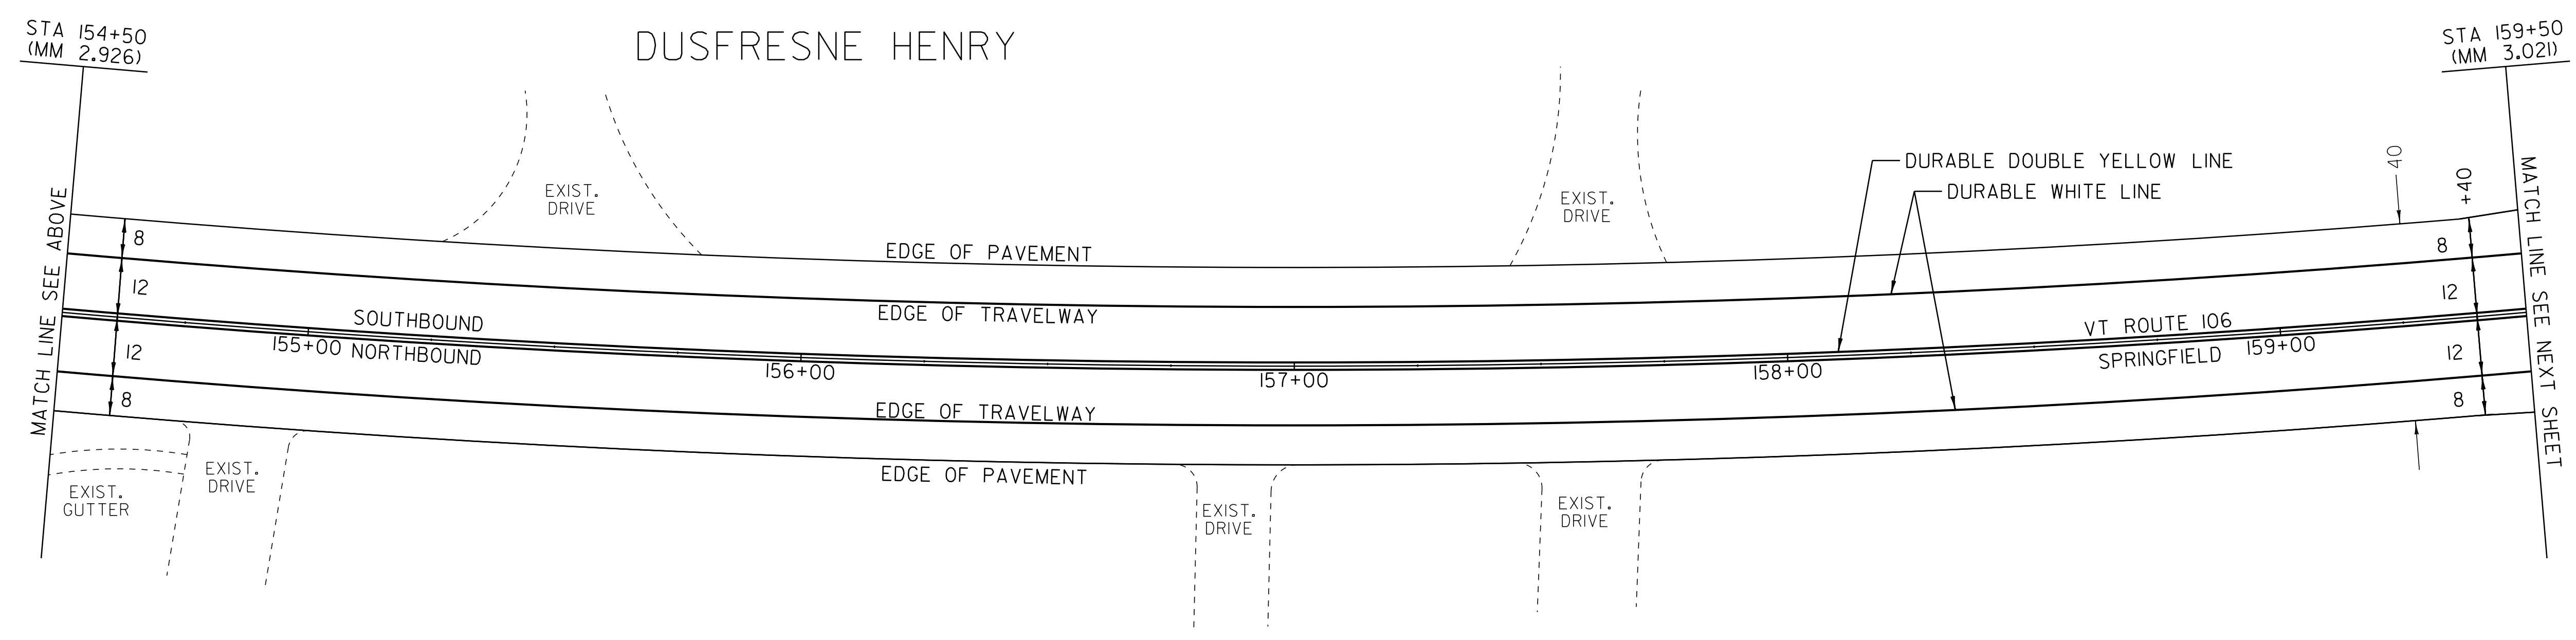


TEMPORARY AND DURABLE 4" WHITE LINE
 STA 149+50 TO 159+50 SOLID LT
 STA 149+50 TO 159+50 SOLID RT
 TEMPORARY AND DURABLE 4" YELLOW LINE
 STA 149+50 TO 159+50 SOLID LT & RT

SHOULDER BERM REMOVAL
 STA 149+50 TO 151+78 LT
 STA 149+50 TO 152+57 RT

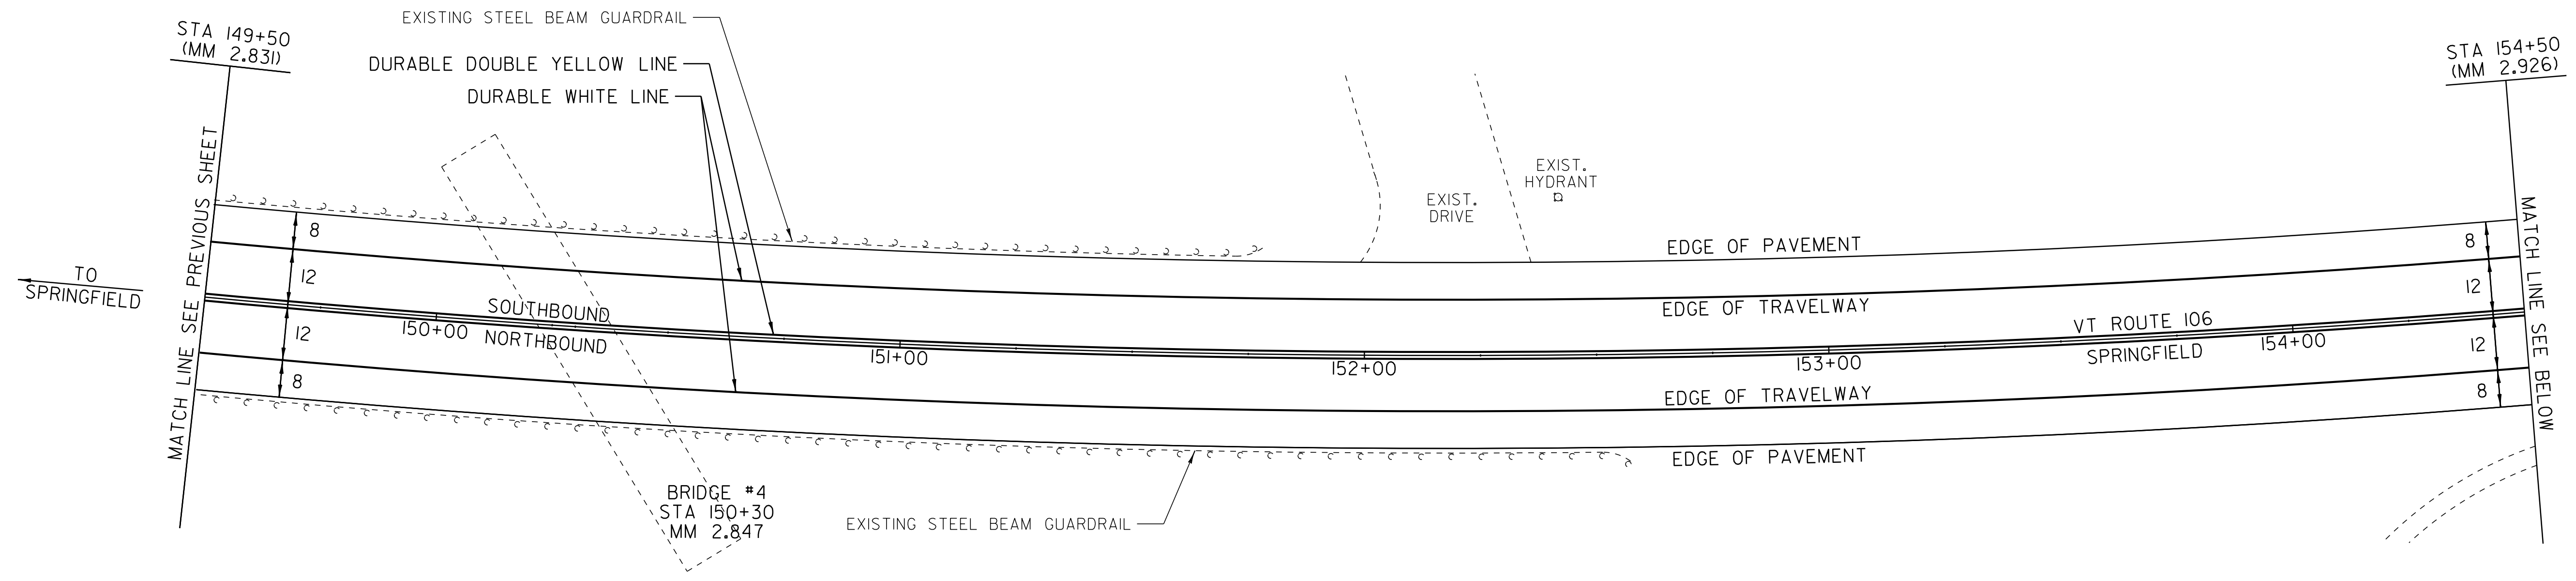

DUSFRESNE HENRY

DATUM
 VERTICAL _____
 HORIZONTAL _____

NOT TO SCALE

- LEGEND
- R = REMOVE EXISTING
 - S = SALVAGE
 - R & S = REMOVE AND SALVAGE
 - N = NEW
 - RET = RETAIN
 - B-B = BACK TO BACK
 - = NEW RAIL
 - - - = EXISTING RAIL

**PAVING
 PROJECT
 LAYOUT #19**

NOTE: ALL DIMENSIONS ARE FEET EXCEPT AS INDICATED

PROJECT: SPRINGFIELD	PROJECT NO. : STP 2405(I)S
DESIGN FILE NAME: /pave/04b038/pb038.dgn	PLOT DATE: 19-JUN-2012 08:11
IPARM FILE NAME: pb038la19.i	SURVEY DATE: 12/04
SURVEYED BY: CLD	DRAWN BY: SRB
SQUAD LEADER: CRB	SHEET: 30 OF 42
CLD 04-0397	