


TEMPORARY AND DURABLE 4" WHITE LINE
 STA 164+50 TO 170+00 SOLID LT
 STA 164+50 TO 170+00 SOLID RT

TEMPORARY AND DURABLE 4" YELLOW LINE
 STA 164+50 TO 170+00 SOLID LT & RT

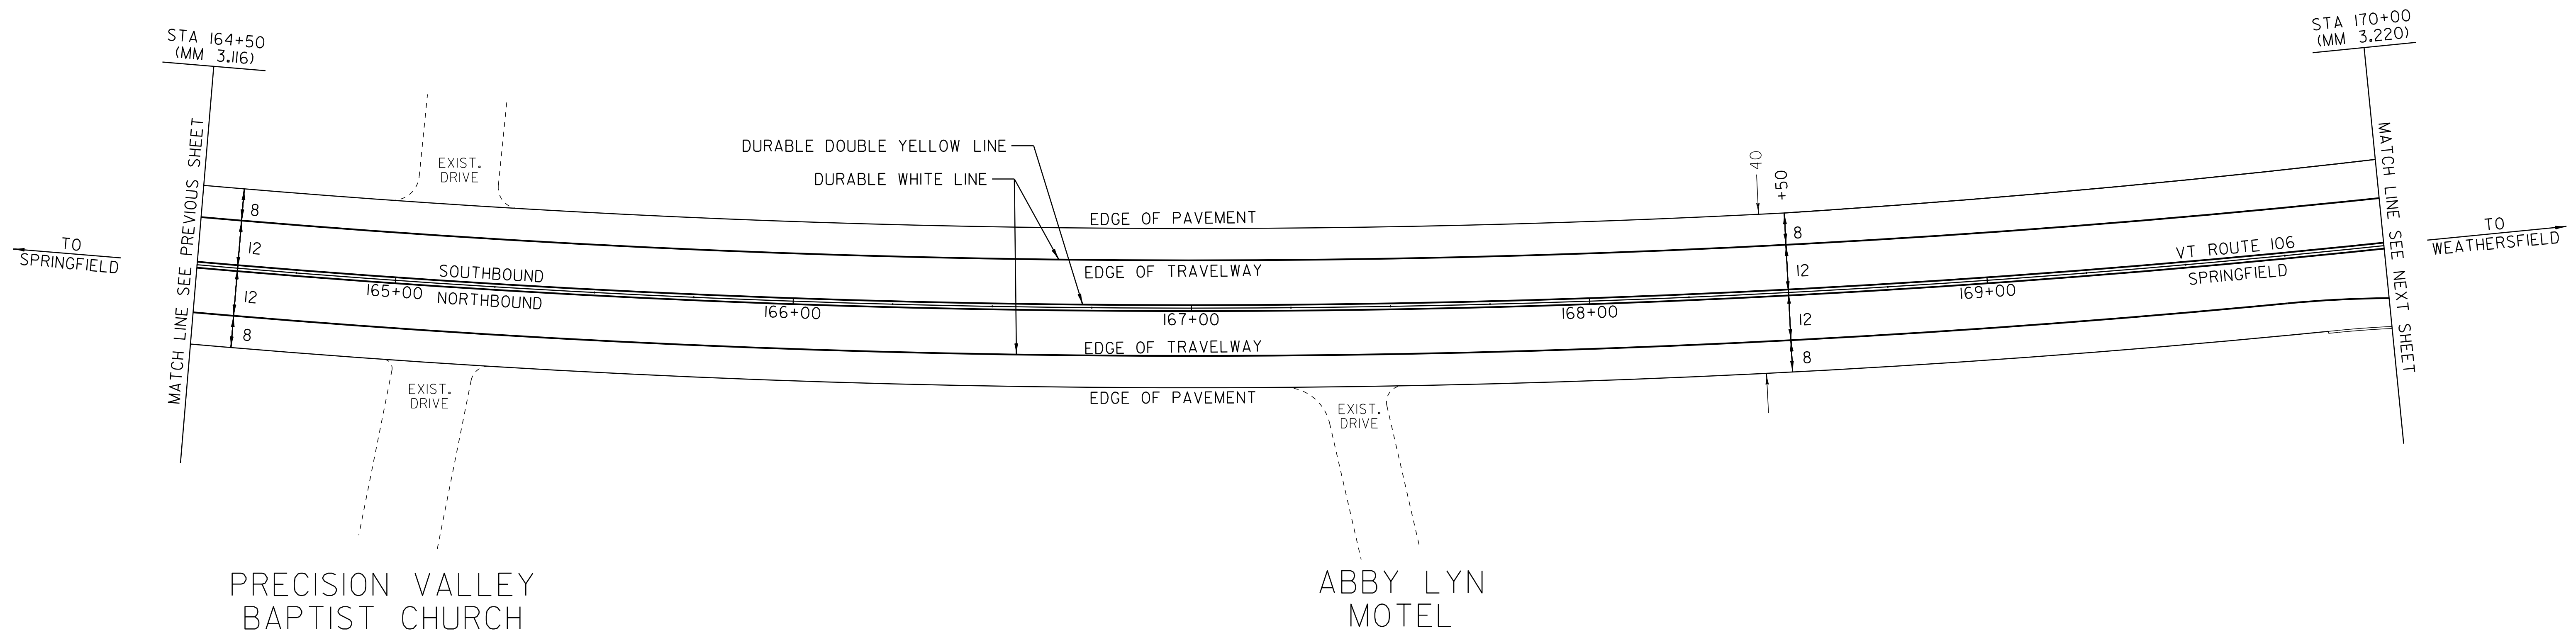

NOT TO SCALE

LEGEND

- R = REMOVE EXISTING
- S = SALVAGE
- R & S = REMOVE AND SALVAGE
- N = NEW
- RET = RETAIN
- B-B = BACK TO BACK
- = NEW RAIL
- = EXISTING RAIL

NOTE: ALL DIMENSIONS ARE FEET EXCEPT AS INDICATED

DATUM	
VERTICAL	_____
HORIZONTAL	_____

**PAVING
PROJECT
LAYOUT #21**

PROJECT:	SPRINGFIELD	PROJECT NO.:	STP 2405(I)S
DESIGN FILE NAME:	/pave/04b038/pb038.dgn	PLOT DATE:	19-JUN-2012 08:11
IPARM FILE NAME:	pb038la21.i	SURVEY DATE:	12/04
SURVEYED BY:	CLD	DRAWN BY:	SRB
SQUAD LEADER:	CRB	SHEET:	32 OF 40
CLD 04-0397			