

646.414 DURABLE 6" WHITE LINE (MOD.) (RETROREFLECTIVITY/INLAID)
 (ALL LINES WILL INCLUDE EDGE LINE BREAKS AND RADIUS FOR TOWN HIGHWAYS)

CLARENDON:
 STA. 1+00.00 - STA. 16+00.00 DASHED LINE C/L
 STA. 1+00.00 - STA. 16+00.00 EDGE LINE LT

646.415 DURABLE 6" YELLOW LINE (MOD.) (RETROREFLECTIVITY/INLAID)
 (ALL LINES WILL INCLUDE EDGE LINE BREAKS AND RADIUS FOR TOWN HIGHWAYS)

CLARENDON:
 STA. 1+00.00 - STA. 16+00.00 EDGE LINE RT


646.614 TEMPORARY 6" WHITE LINE (PAINT)
 (ALL LINES WILL INCLUDE EDGE LINE BREAKS AND RADIUS FOR TOWN HIGHWAYS)

CLARENDON:
 STA. 1+00.00 - STA. 16+00.00 DASHED LINE C/L
 STA. 1+00.00 - STA. 16+00.00 EDGE LINE LT

646.615 TEMPORARY 6" YELLOW LINE (PAINT)
 (ALL LINES WILL INCLUDE EDGE LINE BREAKS AND RADIUS FOR TOWN HIGHWAYS)

CLARENDON:
 STA. 1+00.00 - STA. 16+00.00 EDGE LINE RT

675.50 REMOVING SIGNS
 AS SHOWN - 1

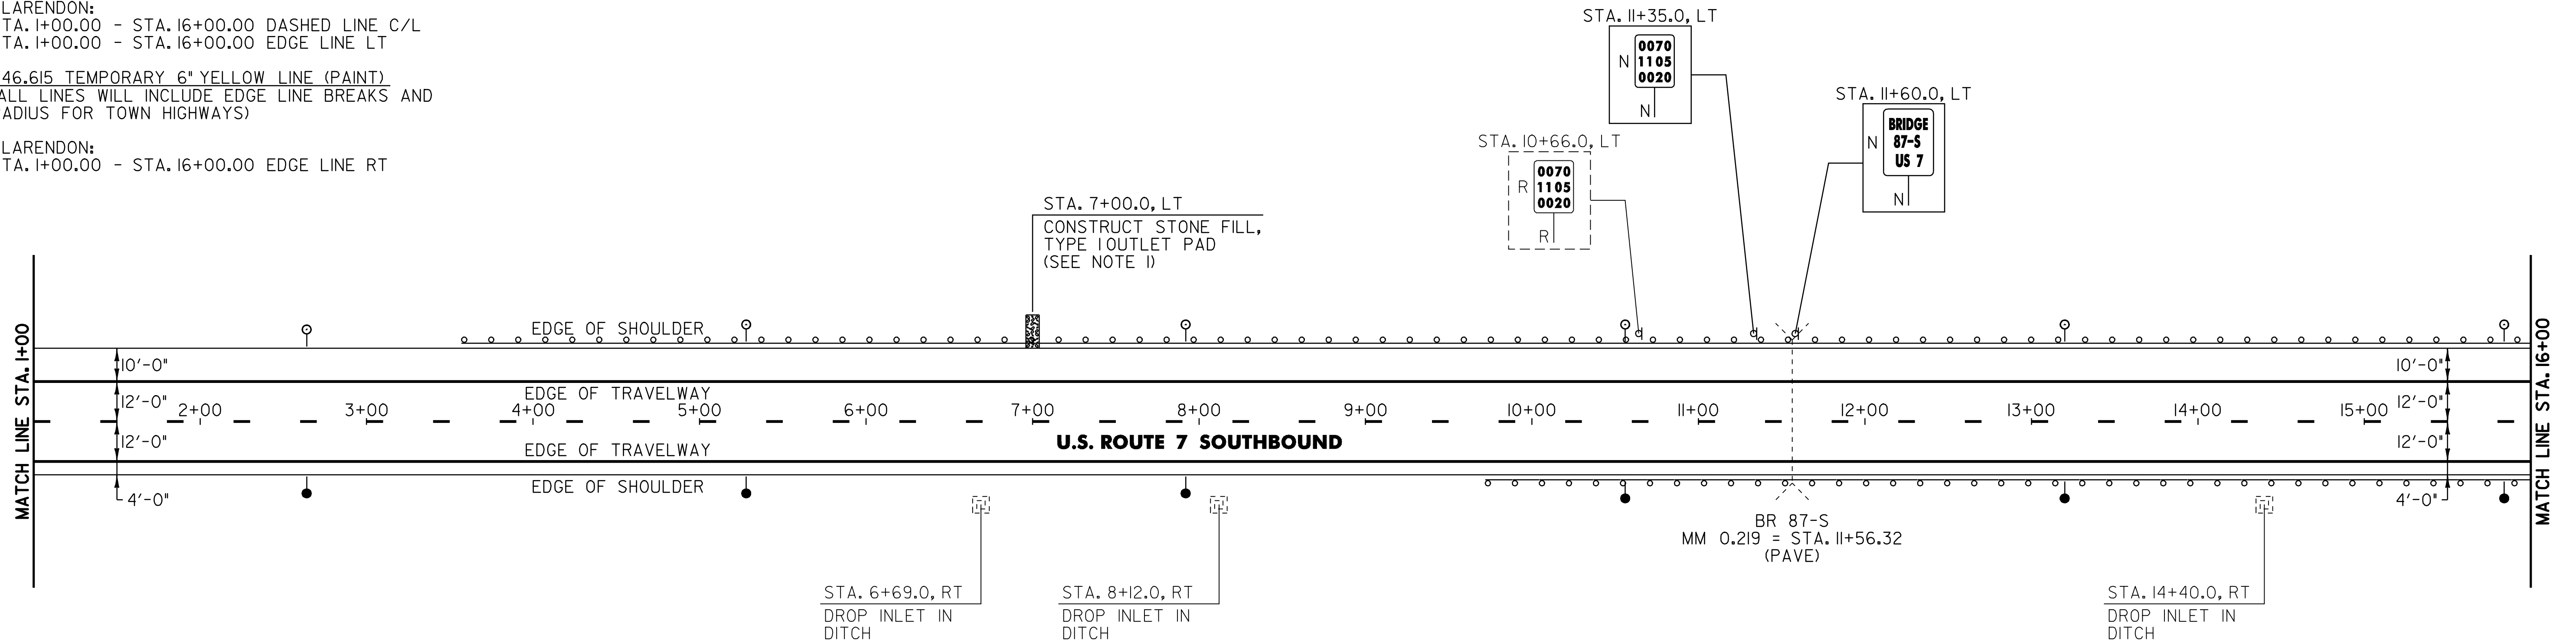

213.10 MILLED RUMBLE STRIPS

CLARENDON:
 STA. 1+00.0 - STA. 16+00.0 LT (1500 LF)
 STA. 1+00.0 - STA. 9+72.0 RT (872 LF)

604.412 REHABING DI, CB OR MH, CLASS 1

CLARENDON:
 STA. 6+69.0 RT
 STA. 8+12.0 RT
 STA. 14+40.0 RT

621.20 STEEL BEAM GUARDRAIL (GALVANIZED)

CLARENDON: 3+58.5 1216.5
 STA. 3+71.0 - STA. 16+00.0 LT (1229 LF)
 STA. 9+86.0 - STA. 16+00.0 RT (614 LF)

621.52 TRAILING END TERMINAL

CLARENDON:
 STA. 3+57.0 - STA. 3+71.0 LT
 STA. 9+72.0 - STA. 9+86.0 RT

621.80 REMOVAL AND DISPOSAL OF GUARDRAIL

CLARENDON:
 STA. 3+59.0 - STA. 16+00.0 LT (1241 LF)
 STA. 9+74.0 - STA. 16+00.0 RT (626 LF)

676.10 DELINEATORS WITH STEEL POSTS

☉ TYPE 1 WHITE ● TYPE 1 AMBER

CLARENDON:
 STA. 2+64.0 LT STA. 2+64.0 RT
 STA. 5+28.0 LT STA. 5+28.0 RT
 STA. 7+92.0 LT STA. 7+92.0 RT
 STA. 10+56.0 LT STA. 10+56.0 RT
 STA. 13+20.0 LT STA. 13+20.0 RT
 STA. 15+84.0 LT STA. 15+84.0 RT

NOTE:

1. CONSTRUCT A 10' x 4' x 1' (L x W x D) STONE FILL, TYPE 1 OUTLET PAD ADJACENT TO THE SHOULDER AT STA. 7+00, OR AS DIRECTED BY THE RESIDENT ENGINEER. ALL REQUIRED EXCAVATION SHALL BE PAID FOR UNDER ITEM 608.25 ALL PURPOSE EXCAVATOR RENTAL, TYPE 1.

SIGN LEGEND
 R = REMOVE
 S = SALVAGE
 N = NEW
 RET = RETAIN
 B-B = BACK TO BACK
 EXISTING = -----
 NEW = -----

PROJECT LAYOUT SHEET #3

PROJECT NAME: WALLINGFORD - RUTLAND TOWN
 PROJECT NUMBER: NH 2408(1)S
 FILE NAME: p04b050.dgn PLOT DATE: \$DATE\$
 PROJECT LEADER: D.E.G. DRAWN BY: C.A.K.
 DESIGNED BY: J.S.P. CHECKED BY: D.E.G.
 IPARM FILE: p04b050L03.1 SHEET 15 OF 80