

646.414 DURABLE 6" WHITE LINE (MOD.) (RETROREFLECTIVITY/INLAID)
 (ALL LINES WILL INCLUDE EDGE LINE BREAKS AND RADIUS FOR TOWN HIGHWAYS)

CLARENDON:
 STA. 48+00.00 - STA. 64+00.00 DASHED LINE C/L
 STA. 48+00.00 - STA. 64+00.00 EDGE LINE LT
 STA. 60+85.00 - STA. 63+40.00 SOLID LANE LINE RT
 STA. 63+40.00 - STA. 64+00.00 DOTTED LANE LINE RT

646.415 DURABLE 6" YELLOW LINE (MOD.) (RETROREFLECTIVITY/INLAID)
 (ALL LINES WILL INCLUDE EDGE LINE BREAKS AND RADIUS FOR TOWN HIGHWAYS)

CLARENDON:
 STA. 48+00.00 - STA. 64+00.00 EDGE LINE RT

646.614 TEMPORARY 6" WHITE LINE (PAINT)
 (ALL LINES WILL INCLUDE EDGE LINE BREAKS AND RADIUS FOR TOWN HIGHWAYS)

CLARENDON:
 STA. 48+00.00 - STA. 64+00.00 DASHED LINE C/L
 STA. 48+00.00 - STA. 64+00.00 EDGE LINE LT
 STA. 60+85.00 - STA. 63+40.00 SOLID LANE LINE RT
 STA. 63+40.00 - STA. 64+00.00 DOTTED LANE LINE RT

646.615 TEMPORARY 6" YELLOW LINE (PAINT)
 (ALL LINES WILL INCLUDE EDGE LINE BREAKS AND RADIUS FOR TOWN HIGHWAYS)

CLARENDON:
 STA. 48+00.00 - STA. 64+00.00 EDGE LINE RT

646.50 DURABLE LETTER OR SYMBOL (THERMOPLASTIC)


CLARENDON:
 STA. ~~61+04.3~~ RT, ARROW (1 EA) **61+17 RT**
 STA. 61+50.6 RT, "O,N,L,Y" (4 EA)
 STA. 61+96.9 RT, ARROW (1 EA)
 STA. 62+43.2 RT, "O,N,L,Y" (4 EA)
 STA. ~~62+89.5~~ RT, ARROW (1 EA) **62+53 RT**
 STA. 63+35.8 RT, "O,N,L,Y" (4 EA)

646.70 TEMPORARY LETTER OR SYMBOL (PAINT)

CLARENDON:
 STA. 61+04.3 RT, ARROW (2 EA)
 STA. 62+89.5 RT, ARROW (2 EA)

675.50 REMOVING SIGNS

AS SHOWN - 8

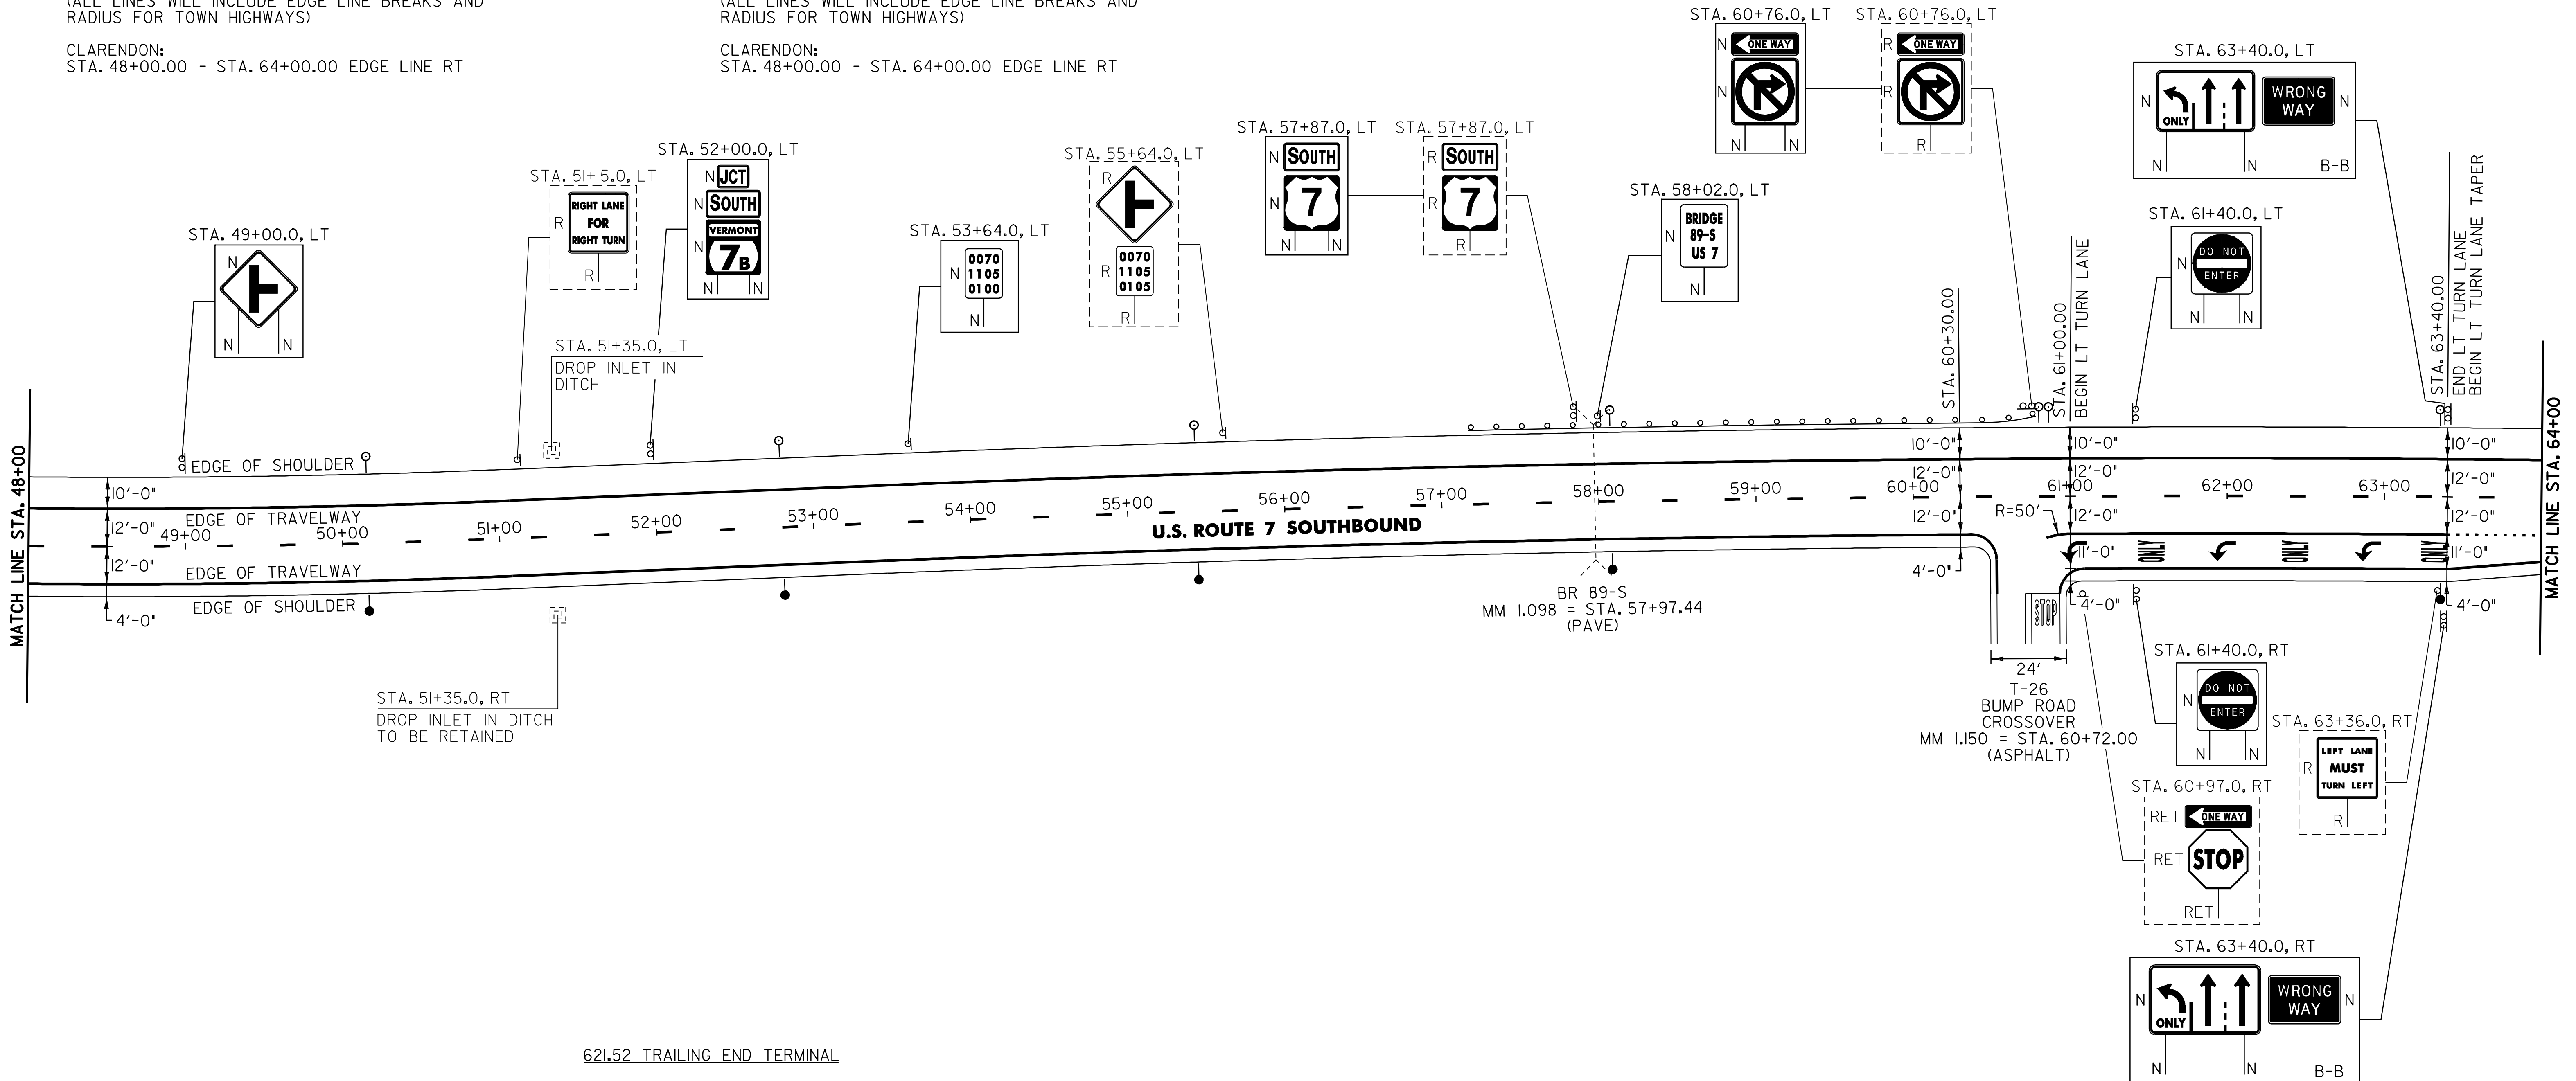

213.10 MILLED RUMBLE STRIPS

CLARENDON:
 STA. 48+00.0 - STA. 64+00.0 LT (1600 LF)
 STA. 48+00.0 - STA. 60+00.0 RT (1200 LF)

604.412 REHABING DI, CB OR MH, CLASS I

CLARENDON:
 STA. 51+35.0 LT

621.20 STEEL BEAM GUARDRAIL (GALVANIZED)

CLARENDON: ~~57+42 - STA. 60+55 LT~~
~~STA. 57+32.0 - STA. 60+44.5 LT~~ (312.5 LF)

621.505 MANUFACTURED TERMINAL SECTION (FLARED)

CLARENDON: ~~60+55 - STA. 60+92 LT~~
~~STA. 60+44.5 - STA. 60+82.0 LT~~

621.52 TRAILING END TERMINAL

CLARENDON:
 STA. ~~57+18.0 - STA. 57+32.0 LT~~
~~57+30 - STA. 57+42 LT~~

621.80 REMOVAL AND DISPOSAL OF GUARDRAIL

CLARENDON:
 STA. 57+20.0 - STA. 60+74.0 LT (354 LF)

676.10 DELINEATORS WITH STEEL POSTS

⚪ TYPE I WHITE ⚫ TYPE I AMBER

CLARENDON:
 STA. 50+16.0 LT STA. 50+16.0 RT
 STA. 52+80.0 LT STA. 52+80.0 RT
 STA. 55+44.0 LT STA. 55+44.0 RT
 STA. 58+08.0 LT STA. 58+08.0 RT
 STA. 60+72.0 LT STA. 63+36.0 RT
 STA. 60+82.0 LT
 STA. 63+36.0 LT

SIGN LEGEND
 R = REMOVE
 S = SALVAGE
 N = NEW
 RET = RETAIN
 B-B = BACK TO BACK
 EXISTING = -----
 NEW = _____

PROJECT LAYOUT SHEET #6

PROJECT NAME: WALLINGFORD - RUTLAND TOWN
 PROJECT NUMBER: NH 2408(1)S
 FILE NAME: p04b050.dgn
 PROJECT LEADER: D.E.G.
 DESIGNED BY: J.S.P.
 IPARM FILE: p04b050L06.1
 PLOT DATE: \$DATE\$
 DRAWN BY: C.A.K.
 CHECKED BY: D.E.G.
 SHEET 18 OF 80