

646.414 DURABLE 6" WHITE LINE (MOD.) (RETROREFLECTIVITY/INLAID)
 (ALL LINES WILL INCLUDE EDGE LINE BREAKS AND RADIUS FOR TOWN HIGHWAYS)

CLARENDON:
 STA. 160+25.00 - STA. 175+00.00 DASHED LINE C/L
 STA. 160+25.00 - STA. 175+00.00 EDGE LINE LT

646.415 DURABLE 6" YELLOW LINE (MOD.) (RETROREFLECTIVITY/INLAID)
 (ALL LINES WILL INCLUDE EDGE LINE BREAKS AND RADIUS FOR TOWN HIGHWAYS)

CLARENDON:
 STA. 160+25.00 - STA. 175+00.00 EDGE LINE RT


646.614 TEMPORARY 6" WHITE LINE (PAINT)
 (ALL LINES WILL INCLUDE EDGE LINE BREAKS AND RADIUS FOR TOWN HIGHWAYS)

CLARENDON:
 STA. 160+25.00 - STA. 175+00.00 DASHED LINE C/L
 STA. 160+25.00 - STA. 175+00.00 EDGE LINE LT

646.615 TEMPORARY 6" YELLOW LINE (PAINT)
 (ALL LINES WILL INCLUDE EDGE LINE BREAKS AND RADIUS FOR TOWN HIGHWAYS)

CLARENDON:
 STA. 160+25.00 - STA. 175+00.00 EDGE LINE RT

675.50 REMOVING SIGNS
 AS SHOWN - II

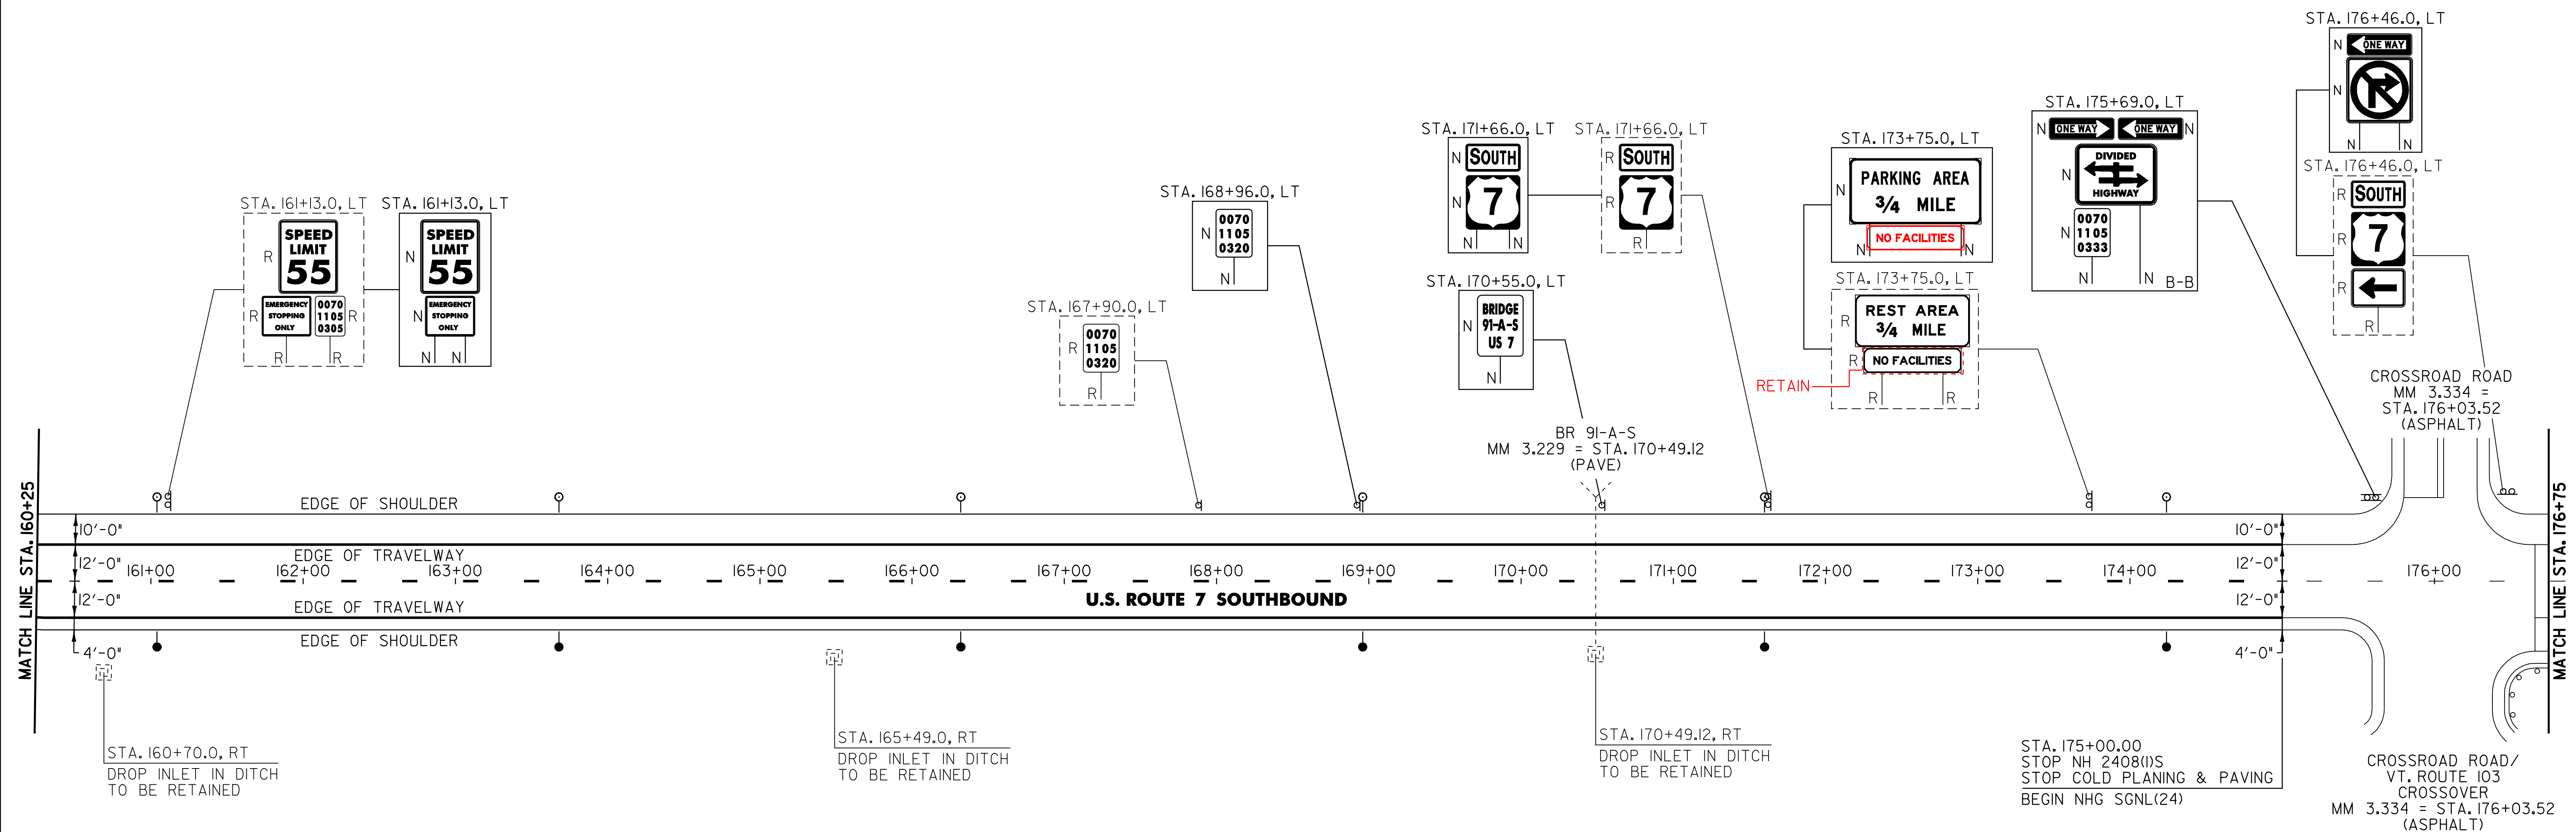

213.10 MILLED RUMBLE STRIPS

CLARENDON:
 STA. 160+25.0 - STA. 175+10.0 LT (1485 LF)
 STA. 160+25.0 - STA. 175+00.0 RT (1475 LF)

676.10 DELINEATORS WITH STEEL POSTS

☉ TYPE I WHITE ● TYPE I AMBER

CLARENDON:
 STA. 161+04.0 LT STA. 161+04.0 RT
 STA. 163+68.0 LT STA. 163+68.0 RT
 STA. 166+32.0 LT STA. 166+32.0 RT
 STA. 168+96.0 LT STA. 168+96.0 RT
 STA. 171+60.0 LT STA. 171+60.0 RT
 STA. 174+24.0 LT STA. 174+24.0 RT

SIGN LEGEND
 R = REMOVE
 S = SALVAGE
 N = NEW
 RET = RETAIN
 B-B = BACK TO BACK
 EXISTING = - - - - -
 NEW = _____

PROJECT LAYOUT SHEET #13	PROJECT NAME: WALLINGFORD - RUTLAND TOWN	PROJECT NUMBER: NH 2408(1)S
	FILE NAME: p04b050.dgn	PLOT DATE: \$DATE\$
	PROJECT LEADER: D.E.G.	DRAWN BY: C.A.K.
	DESIGNED BY: J.S.P.	CHECKED BY: D.E.G.
	IPARM FILE: p04b050L13.1	SHEET 25 OF 80