

646.414 DURABLE 6" WHITE LINE (MOD.) (RETROREFLECTIVITY/INLAID)
 (ALL LINES WILL INCLUDE EDGE LINE BREAKS AND RADIUS FOR TOWN HIGHWAYS)

CLARENDON:
 STA. 256+00.00 - STA. 272+00.00 DASHED LINE C/L
 STA. 256+00.00 - STA. 272+00.00 EDGE LINE LT
 STA. 256+00.00 - STA. 256+60.00 DOTTED LANE LINE RT

646.415 DURABLE 6" YELLOW LINE (MOD.) (RETROREFLECTIVITY/INLAID)
 (ALL LINES WILL INCLUDE EDGE LINE BREAKS AND RADIUS FOR TOWN HIGHWAYS)

CLARENDON:
 STA. 256+00.00 - STA. 272+00.00 EDGE LINE RT

646.614 TEMPORARY 6" WHITE LINE (PAINT)
 (ALL LINES WILL INCLUDE EDGE LINE BREAKS AND RADIUS FOR TOWN HIGHWAYS)

CLARENDON:
 STA. 256+00.00 - STA. 272+00.00 DASHED LINE C/L
 STA. 256+00.00 - STA. 272+00.00 EDGE LINE LT
 STA. 256+00.00 - STA. 256+60.00 DOTTED LANE LINE RT


646.615 TEMPORARY 6" YELLOW LINE (PAINT)
 (ALL LINES WILL INCLUDE EDGE LINE BREAKS AND RADIUS FOR TOWN HIGHWAYS)

CLARENDON:
 STA. 256+00.00 - STA. 272+00.00 EDGE LINE RT

646.81 PAINTED CURB

CLARENDON:
 STA. 256+00.0 - STA. 272+00.0 RT (1600 LF)

675.50 REMOVING SIGNS
 AS SHOWN - 4

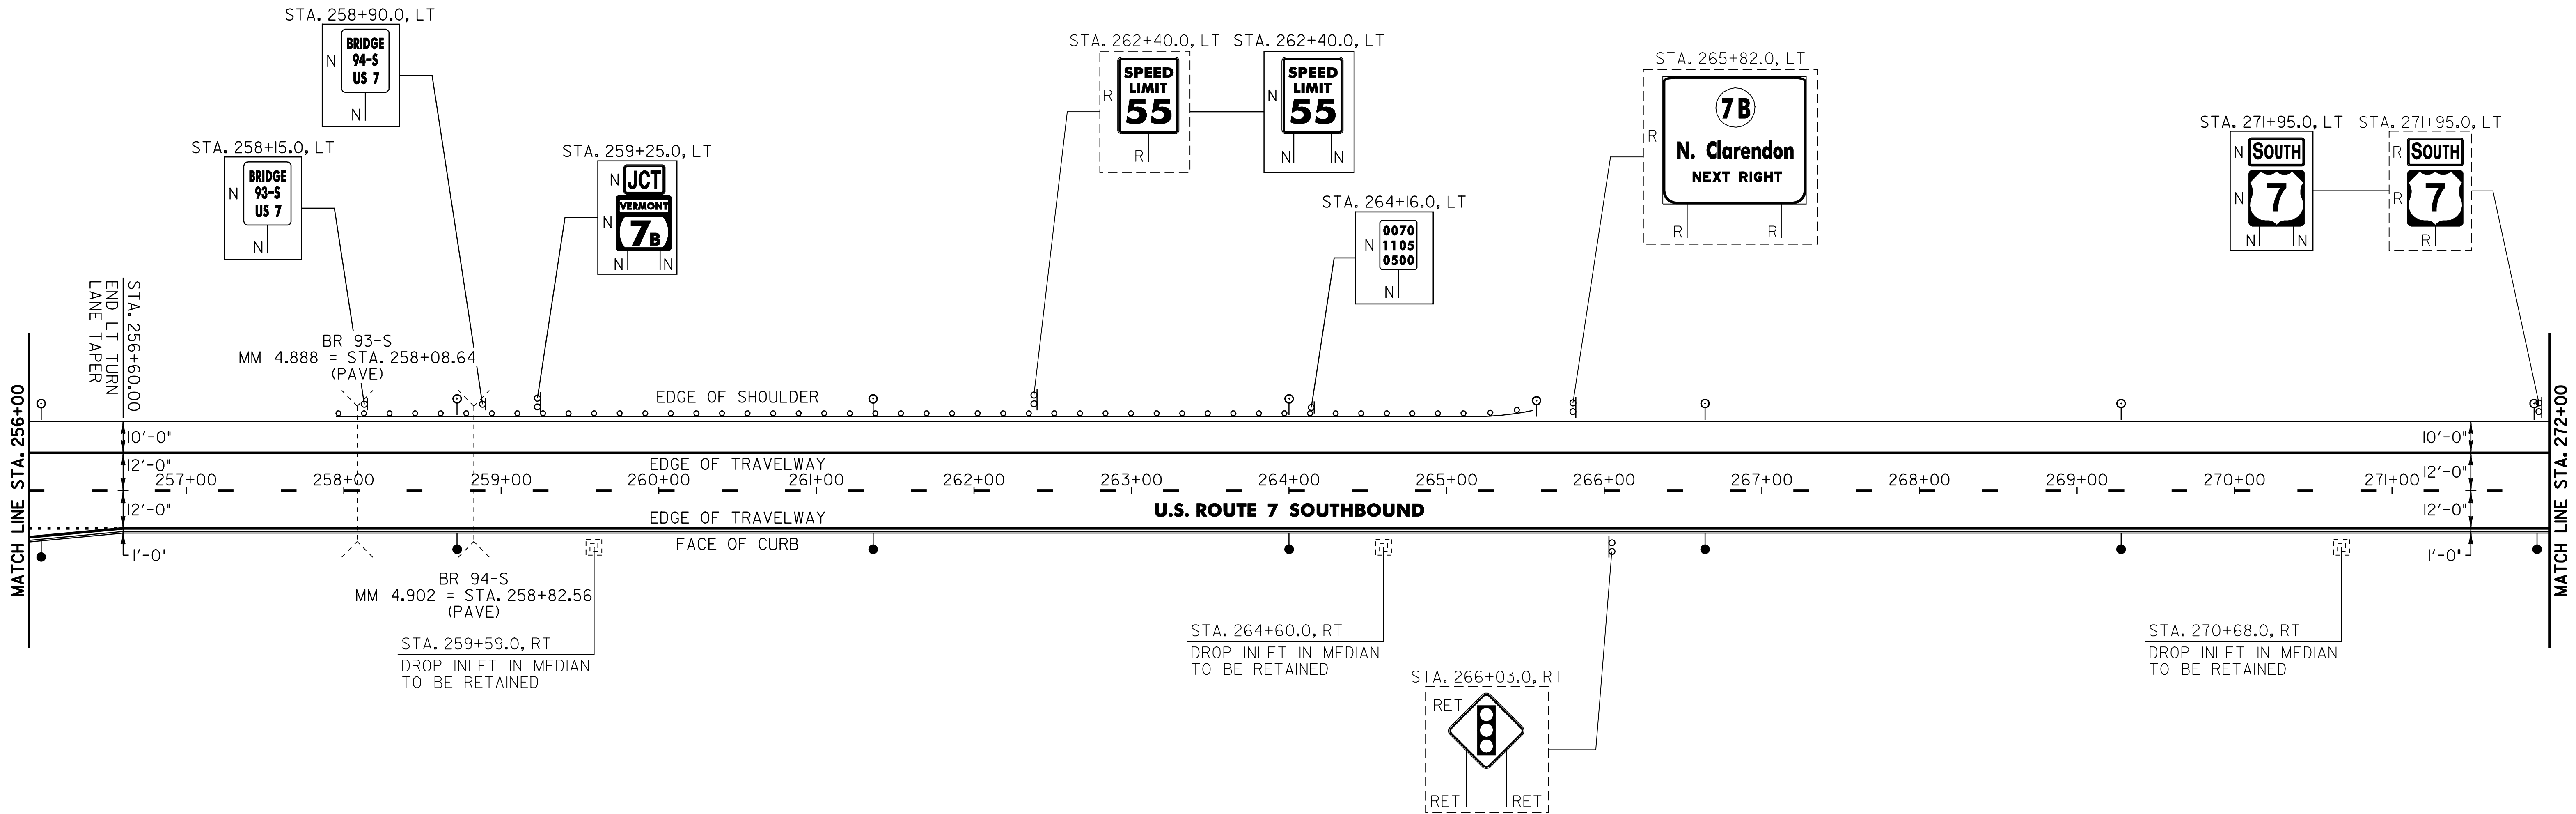

213.10 MILLED RUMBLE STRIPS

CLARENDON:
 STA. 256+00.0 - STA. 272+00.0 LT (1600 LF)

621.20 STEEL BEAM GUARDRAIL WITH 8' POSTS (MOD.) (GALVANIZED)

CLARENDON: 257+96
 STA. ~~258+09.0~~ - STA. 265+21.5 LT (712.5 LF) 725 LF

621.505 MANUFACTURED TERMINAL SECTION (FLARED)

CLARENDON:
 STA. 265+21.5 - STA. 265+59.0 LT

621.52 TRAILING END TERMINAL

CLARENDON:
 STA. ~~257+95.0~~ - STA. ~~258+09.0~~ LT 257+82 - STA. 257+96 LT

621.80 REMOVAL AND DISPOSAL OF GUARDRAIL

CLARENDON:
 STA. 257+97.0 - STA. 265+51.0 LT (754 LF)

676.10 DELINEATORS WITH STEEL POSTS

♀ TYPE I WHITE ♂ TYPE I AMBER

CLARENDON:
 STA. 256+08.0 LT STA. 256+08.0 RT
 STA. 258+72.0 LT STA. 258+72.0 RT
 STA. 261+36.0 LT STA. 261+36.0 RT
 STA. 264+00.0 LT STA. 264+00.0 RT
 STA. 265+59.0 LT STA. 266+64.0 RT
 STA. 266+64.0 LT STA. 269+28.0 RT
 STA. 269+28.0 LT STA. 271+92.0 RT
 STA. 271+92.0 LT

SIGN LEGEND
 R = REMOVE
 S = SALVAGE
 N = NEW
 RET = RETAIN
 B-B = BACK TO BACK
 EXISTING = -----
 NEW = _____

PROJECT LAYOUT SHEET #19	PROJECT NAME: WALLINGFORD - RUTLAND TOWN	FILE NAME: p04b050.dgn	PLOT DATE: \$DATE\$
	PROJECT NUMBER: NH 2408(1)S	DESIGNED BY: J.S.P.	CHECKED BY: D.E.G.
		IPARM FILE: p04b050L19.1	SHEET 31 OF 80