

646.414 DURABLE 6" WHITE LINE (MOD.) (RETROREFLECTIVITY/INLAID)
 (ALL LINES WILL INCLUDE EDGE LINE BREAKS AND RADIUS FOR TOWN HIGHWAYS)

646.415 DURABLE 6" YELLOW LINE (MOD.) (RETROREFLECTIVITY/INLAID)
 (ALL LINES WILL INCLUDE EDGE LINE BREAKS AND RADIUS FOR TOWN HIGHWAYS)

646.44 DURABLE 12" WHITE LINE (MOD.) (RETROREFLECTIVITY/INLAID)
 CLARENDON:
 STA. 296+15.00 - STA. 297+40.00 GORE AREA LT

646.615 TEMPORARY 6" YELLOW LINE (PAINT)
 (ALL LINES WILL INCLUDE EDGE LINE BREAKS AND RADIUS FOR TOWN HIGHWAYS)

646.46 DURABLE 24" STOP BAR (THERMOPLASTIC)
 CLARENDON:
 STA. 293+46.24 LT, VT. ROUTE 7B

CLARENDON:
 STA. 288+25.00 - STA. 298+47.84 DASHED LINE C/L
 STA. 288+25.00 - STA. 296+15.00 EDGE LINE LT
 STA. 296+15.00 - STA. 298+47.84 EDGE LINE LT
 STA. 297+40.00 - STA. 298+47.84 DOTTED LANE LINE LT

CLARENDON:
 STA. 288+25.00 - STA. 298+47.84 EDGE LINE RT
 RUTLAND TOWN:
 STA. 0+00.00 - STA. 5+00.00 EDGE LINE RT

646.614 TEMPORARY 6" WHITE LINE (PAINT)
 (ALL LINES WILL INCLUDE EDGE LINE BREAKS AND RADIUS FOR TOWN HIGHWAYS)
 CLARENDON:
 STA. 288+25.00 - STA. 298+47.84 DASHED LINE C/L
 STA. 288+25.00 - STA. 296+15.00 EDGE LINE LT
 STA. 296+15.00 - STA. 298+47.84 EDGE LINE LT
 STA. 297+40.00 - STA. 298+47.84 DOTTED LANE LINE LT

CLARENDON:
 STA. 288+25.00 - STA. 298+47.84 EDGE LINE RT
 RUTLAND TOWN:
 STA. 0+00.00 - STA. 5+00.00 EDGE LINE RT

646.66 TEMPORARY 24" STOP BAR (PAINT)
 CLARENDON:
 STA. 293+46.24 LT, VT. ROUTE 7B
 646.50 DURABLE LETTER OR SYMBOL (THERMOPLASTIC)
 CLARENDON: 293+35 LT
 STA. 293+46.24 LT, VT. ROUTE 7B, "S,T,O,P" (4 EA)

RUTLAND TOWN:
 STA. 0+00.00 - STA. 5+00.00 DASHED LINE C/L
 STA. 0+00.00 - STA. 5+00.00 EDGE LINE LT
 STA. 0+00.00 - STA. 1+00.00 DOTTED LANE LINE LT

646.40 DURABLE 4" WHITE LINE (MOD.) (RETROREFLECTIVITY/INLAID)

CLARENDON:
 STA. 293+46.24 EDGE LINE LT, VT. ROUTE 7B

RUTLAND TOWN:
 STA. 0+00.00 - STA. 5+00.00 DASHED LINE C/L
 STA. 0+00.00 - STA. 5+00.00 EDGE LINE LT
 STA. 0+00.00 - STA. 1+00.00 DOTTED LANE LINE LT

646.60 TEMPORARY 4" WHITE LINE (PAINT)

CLARENDON:
 STA. 293+46.24 EDGE LINE LT, VT. ROUTE 7B

646.70 TEMPORARY LETTER OR SYMBOL (PAINT)

CLARENDON:
 STA. 293+46.24 LT, VT. ROUTE 7B, "S,T,O,P" (8 EA)

646.41 DURABLE 4" YELLOW LINE (MOD.) (RETROREFLECTIVITY/INLAID)

CLARENDON:
 STA. 293+46.24 DOUBLE SOLID LT, VT. ROUTE 7B

646.61 TEMPORARY 4" YELLOW LINE (PAINT)

CLARENDON:
 STA. 293+46.24 DOUBLE SOLID LT, VT. ROUTE 7B


646.81 PAINTED CURB

CLARENDON:
 STA. 288+25.00 - STA. 293+00.00 RT (475 LF)
 STA. 293+65.00 - STA. 298+47.84 RT (483 LF)
 STA. 295+55.00 - STA. 296+15.00 LT (120 LF)

RUTLAND TOWN:
 STA. 0+00.00 - STA. 5+00.00 RT (500 LF)

675.50 REMOVING SIGNS

AS SHOWN - 13

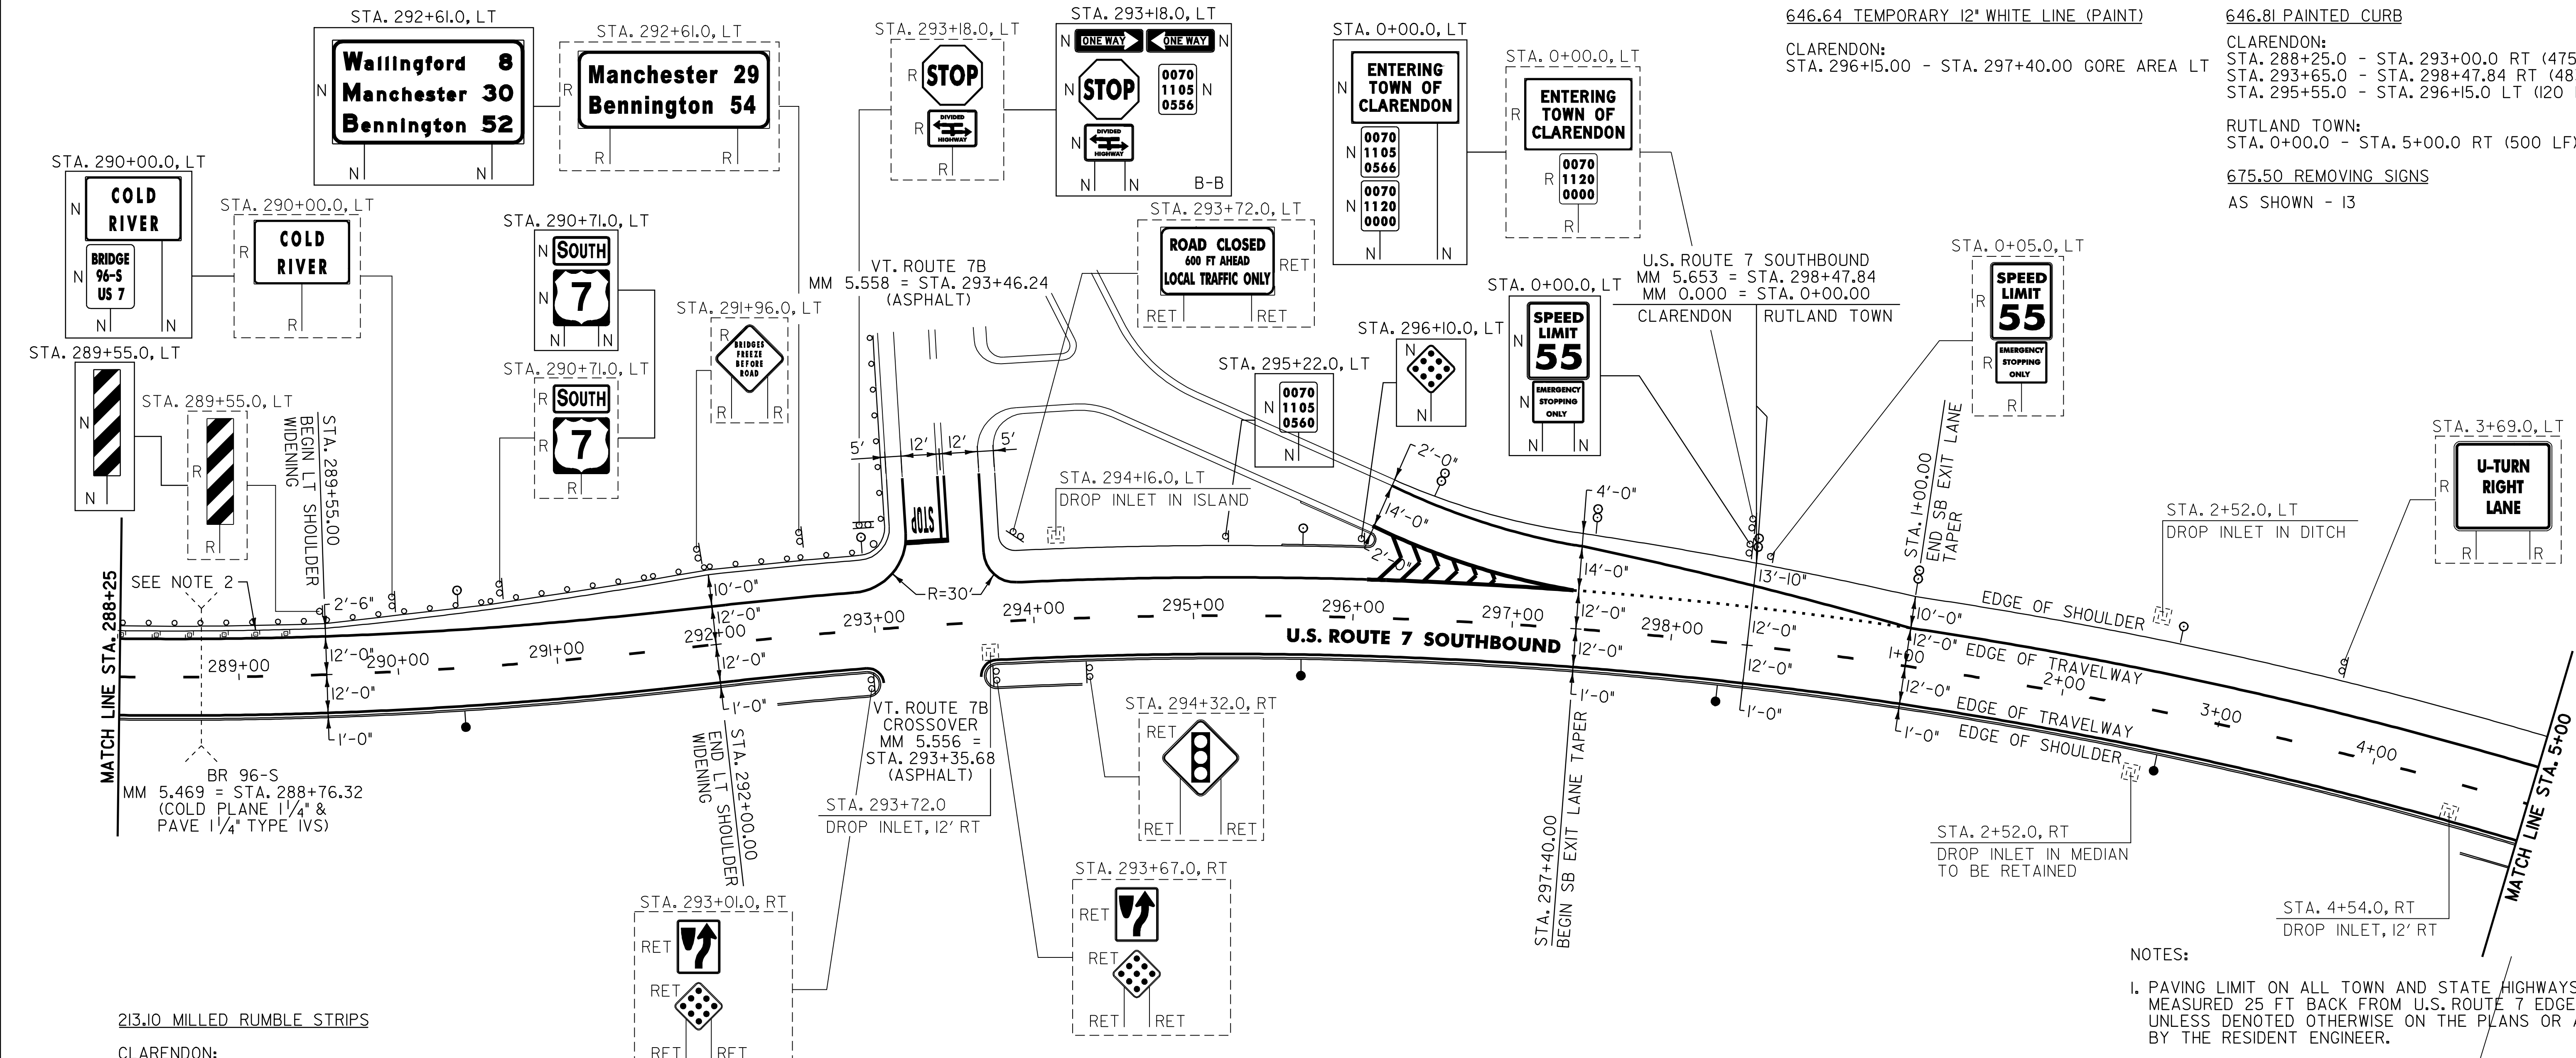

- NOTES:
- PAVING LIMIT ON ALL TOWN AND STATE HIGHWAYS SHALL BE MEASURED 25 FT BACK FROM U.S. ROUTE 7 EDGE OF SHOULDER UNLESS DENOTED OTHERWISE ON THE PLANS OR AS DIRECTED BY THE RESIDENT ENGINEER.
 - THERE ARE SIX EXISTING DRAINAGE STRUCTURES LOCATED IN THE LEFT SHOULDER OF BR 96-S. HEIGHT ADJUSTMENTS OR REHABILITATIONS WILL NOT BE REQUIRED.
 - SEE SHEETS 72 TO 74 FOR ALUMINUM APPROACH RAILING DETAILS. SEE SHEET 76 FOR BR 96-S DETAILS.

213.10 MILLED RUMBLE STRIPS
 CLARENDON:
 STA. 290+05.0 - STA. 292+70.0 LT (265 LF)
 STA. 294+25.0 - STA. 296+15.0 LT (190 LF)
 RUTLAND TOWN:
 STA. 1+00.0 - STA. 4+95.0 LT (395 LF)
 604.412 REHABING DI, CB OR MH, CLASS I
 CLARENDON:
 STA. 293+72.0 RT
 STA. 294+16.0 LT
 RUTLAND TOWN:
 STA. 2+52.0 LT
 STA. 4+54.0 RT

621.20 STEEL BEAM GUARDRAIL (GALVANIZED)
 CLARENDON: 293+40 LT 360.75 LF
 STA. 289+80.3 - STA. 293+30.0 LT (350 LF)
 621.72 ALUMINUM APPROACH RAIL
 CLARENDON:
 STA. 289+53.0 - STA. 289+80.3 LT (27.3 LF)
 621.80 REMOVAL AND DISPOSAL OF GUARDRAIL
 CLARENDON:
 STA. 289+53.0 - STA. 293+40.0 LT (387 LF)

676.10 DELINEATORS WITH STEEL POSTS
 ♀ TYPE I WHITE ♂ TYPE I AMBER ♂ TYPE II WHITE
 CLARENDON:
 STA. 290+40.0 LT STA. 290+40.0 RT STA. 296+48.0 LT
 STA. 293+04.0 LT STA. 295+68.0 RT STA. 297+48.0 LT
 STA. 295+68.0 LT STA. 298+52.0 RT
 RUTLAND TOWN:
 STA. 2+64.0 LT RUTLAND TOWN:
 STA. 2+64.0 RT RUTLAND TOWN:
 STA. 0+00.0 LT
 STA. 1+00.0 LT

SIGN LEGEND
 R = REMOVE
 S = SALVAGE
 N = NEW
 RET = RETAIN
 B-B = BACK TO BACK
 EXISTING = - - - - -
 NEW = _____

PROJECT LAYOUT SHEET #21

PROJECT NAME: WALLINGFORD - RUTLAND TOWN
 PROJECT NUMBER: NH 2408(1)S
 FILE NAME: p04b050.dgn PLOT DATE: \$DATE\$
 PROJECT LEADER: D.E.G. DRAWN BY: C.A.K.
 DESIGNED BY: J.S.P. CHECKED BY: D.E.G.
 IPARM FILE: p04b050L21.I SHEET 33 OF 80