

646.414 DURABLE 6" WHITE LINE (MOD.) (RETROREFLECTIVITY/INLAID)  
 (ALL LINES WILL INCLUDE EDGE LINE BREAKS AND RADIUS FOR TOWN HIGHWAYS)

RUTLAND TOWN:  
 STA. 5+00.00 - STA. 21+00.00 DASHED LINE C/L  
 STA. 5+00.00 - STA. 7+60.00 EDGE LINE LT  
 STA. 6+30.00 - STA. 9+25.00 SOLID LANE LINE RT  
 STA. 7+60.00 - STA. 16+90.00 EDGE LINE LT  
 STA. 8+85.00 - STA. 10+00.00 SOLID LANE LINE LT  
 STA. 9+25.00 - STA. 11+30.00 DOTTED LANE LINE RT  
 STA. 10+00.00 - STA. 15+30.00 DASHED LANE LINE LT  
 STA. 16+90.00 - STA. 21+00.00 EDGE LINE LT  
 STA. 19+75.00 - STA. 21+00.00 SOLID LANE LINE RT

646.415 DURABLE 6" YELLOW LINE (MOD.) (RETROREFLECTIVITY/INLAID)  
 (ALL LINES WILL INCLUDE EDGE LINE BREAKS AND RADIUS FOR TOWN HIGHWAYS)

RUTLAND TOWN:  
 STA. 5+00.00 - STA. 21+00.00 EDGE LINE RT

646.40 DURABLE 4" WHITE LINE (MOD.) (RETROREFLECTIVITY/INLAID)

RUTLAND TOWN:  
 STA. 5+70.24 EDGE LINE LT, T-3

646.41 DURABLE 4" YELLOW LINE (MOD.) (RETROREFLECTIVITY/INLAID)  
 (ALL LINES WILL INCLUDE C/L BREAKS FOR TOWN HIGHWAYS) S=SOLID, D=DASHED

RUTLAND TOWN:  
 STA. 5+70.24 DOUBLE SOLID LT, T-3

646.44 DURABLE 12" WHITE LINE (MOD.) (RETROREFLECTIVITY/INLAID)

RUTLAND TOWN:  
 STA. 7+60.00 - STA. 8+85.00 GORE AREA LT  
 STA. 15+30.00 - STA. 16+90.00 GORE AREA LT

646.614 TEMPORARY 6" WHITE LINE (PAINT)  
 (ALL LINES WILL INCLUDE EDGE LINE BREAKS AND RADIUS FOR TOWN HIGHWAYS)

RUTLAND TOWN:  
 STA. 5+00.00 - STA. 21+00.00 DASHED LINE C/L  
 STA. 5+00.00 - STA. 7+60.00 EDGE LINE LT  
 STA. 6+30.00 - STA. 9+25.00 SOLID LANE LINE RT  
 STA. 7+60.00 - STA. 16+90.00 EDGE LINE LT  
 STA. 8+85.00 - STA. 10+00.00 SOLID LANE LINE LT  
 STA. 9+25.00 - STA. 11+30.00 DOTTED LANE LINE RT  
 STA. 10+00.00 - STA. 15+30.00 DASHED LANE LINE LT  
 STA. 16+90.00 - STA. 21+00.00 EDGE LINE LT  
 STA. 19+75.00 - STA. 21+00.00 SOLID LANE LINE RT

646.615 TEMPORARY 6" YELLOW LINE (PAINT)  
 (ALL LINES WILL INCLUDE EDGE LINE BREAKS AND RADIUS FOR TOWN HIGHWAYS)

RUTLAND TOWN:  
 STA. 5+00.00 - STA. 21+00.00 EDGE LINE RT

646.60 TEMPORARY 4" WHITE LINE (PAINT)

RUTLAND TOWN:  
 STA. 5+70.24 EDGE LINE LT, T-3

646.61 TEMPORARY 4" YELLOW LINE (PAINT)

RUTLAND TOWN:  
 STA. 5+70.24 DOUBLE SOLID LT, T-3

646.64 TEMPORARY 12" WHITE LINE (PAINT)

RUTLAND TOWN:  
 STA. 7+60.00 - STA. 8+85.00 GORE AREA LT  
 STA. 15+30.00 - STA. 16+90.00 GORE AREA LT

675.50 REMOVING SIGNS

AS SHOWN - II

646.46 DURABLE 24" STOP BAR (THERMOPLASTIC)

RUTLAND TOWN:  
 STA. 5+70.24 LT, T-3  
 STA. 6+30.00 LT/RT  
 STA. 19+75.00 LT/RT  
 STA. 20+00.00 RT

646.66 TEMPORARY 24" STOP BAR (PAINT)

RUTLAND TOWN:  
 STA. 5+70.24 LT, T-3  
 STA. 6+30.00 LT/RT  
 STA. 19+75.00 LT/RT  
 STA. 20+00.00 RT

646.50 DURABLE LETTER OR SYMBOL (THERMOPLASTIC)


RUTLAND TOWN:  
 STA. 6+39.3 RT, ARROW (IEA)  
 STA. 6+95.6 RT, "O,N,L,Y" (4 EA) 7+08 RT  
 STA. 7+51.9 RT, ARROW (IEA) 7+67 RT  
 STA. 8+08.2 RT, "O,N,L,Y" (4 EA) 8+25 RT  
 STA. 8+64.5 RT, ARROW (IEA)  
 STA. 8+89.3 LT, ARROW (IEA)  
 STA. 9+20.8 RT, "O,N,L,Y" (4 EA)  
 STA. 9+42.5 LT, "O,N,L,Y" (4 EA)  
 STA. 9+95.7 LT, ARROW (IEA)  
 STA. 20+09.3 RT, ARROW (IEA)  
 STA. 20+63.1 RT, "O,N,L,Y" (4 EA)

646.70 TEMPORARY LETTER OR SYMBOL (PAINT)

RUTLAND TOWN:  
 STA. 6+39.3 RT, ARROW (2 EA)  
 STA. 8+64.5 RT, ARROW (2 EA)  
 STA. 8+89.3 LT, ARROW (2 EA)  
 STA. 9+95.7 LT, ARROW (2 EA)  
 STA. 20+09.3 RT, ARROW (2 EA)

646.81 PAINTED CURB

RUTLAND TOWN:  
 STA. 5+00.0 - STA. 5+25.0 RT (25 LF)  
 STA. 6+28.0 - STA. 18+60.0 RT (1232 LF)  
 STA. 7+05.0 - STA. 7+60.0 LT (110 LF)  
 STA. 19+95.0 - STA. 21+00.0 RT (105 LF)

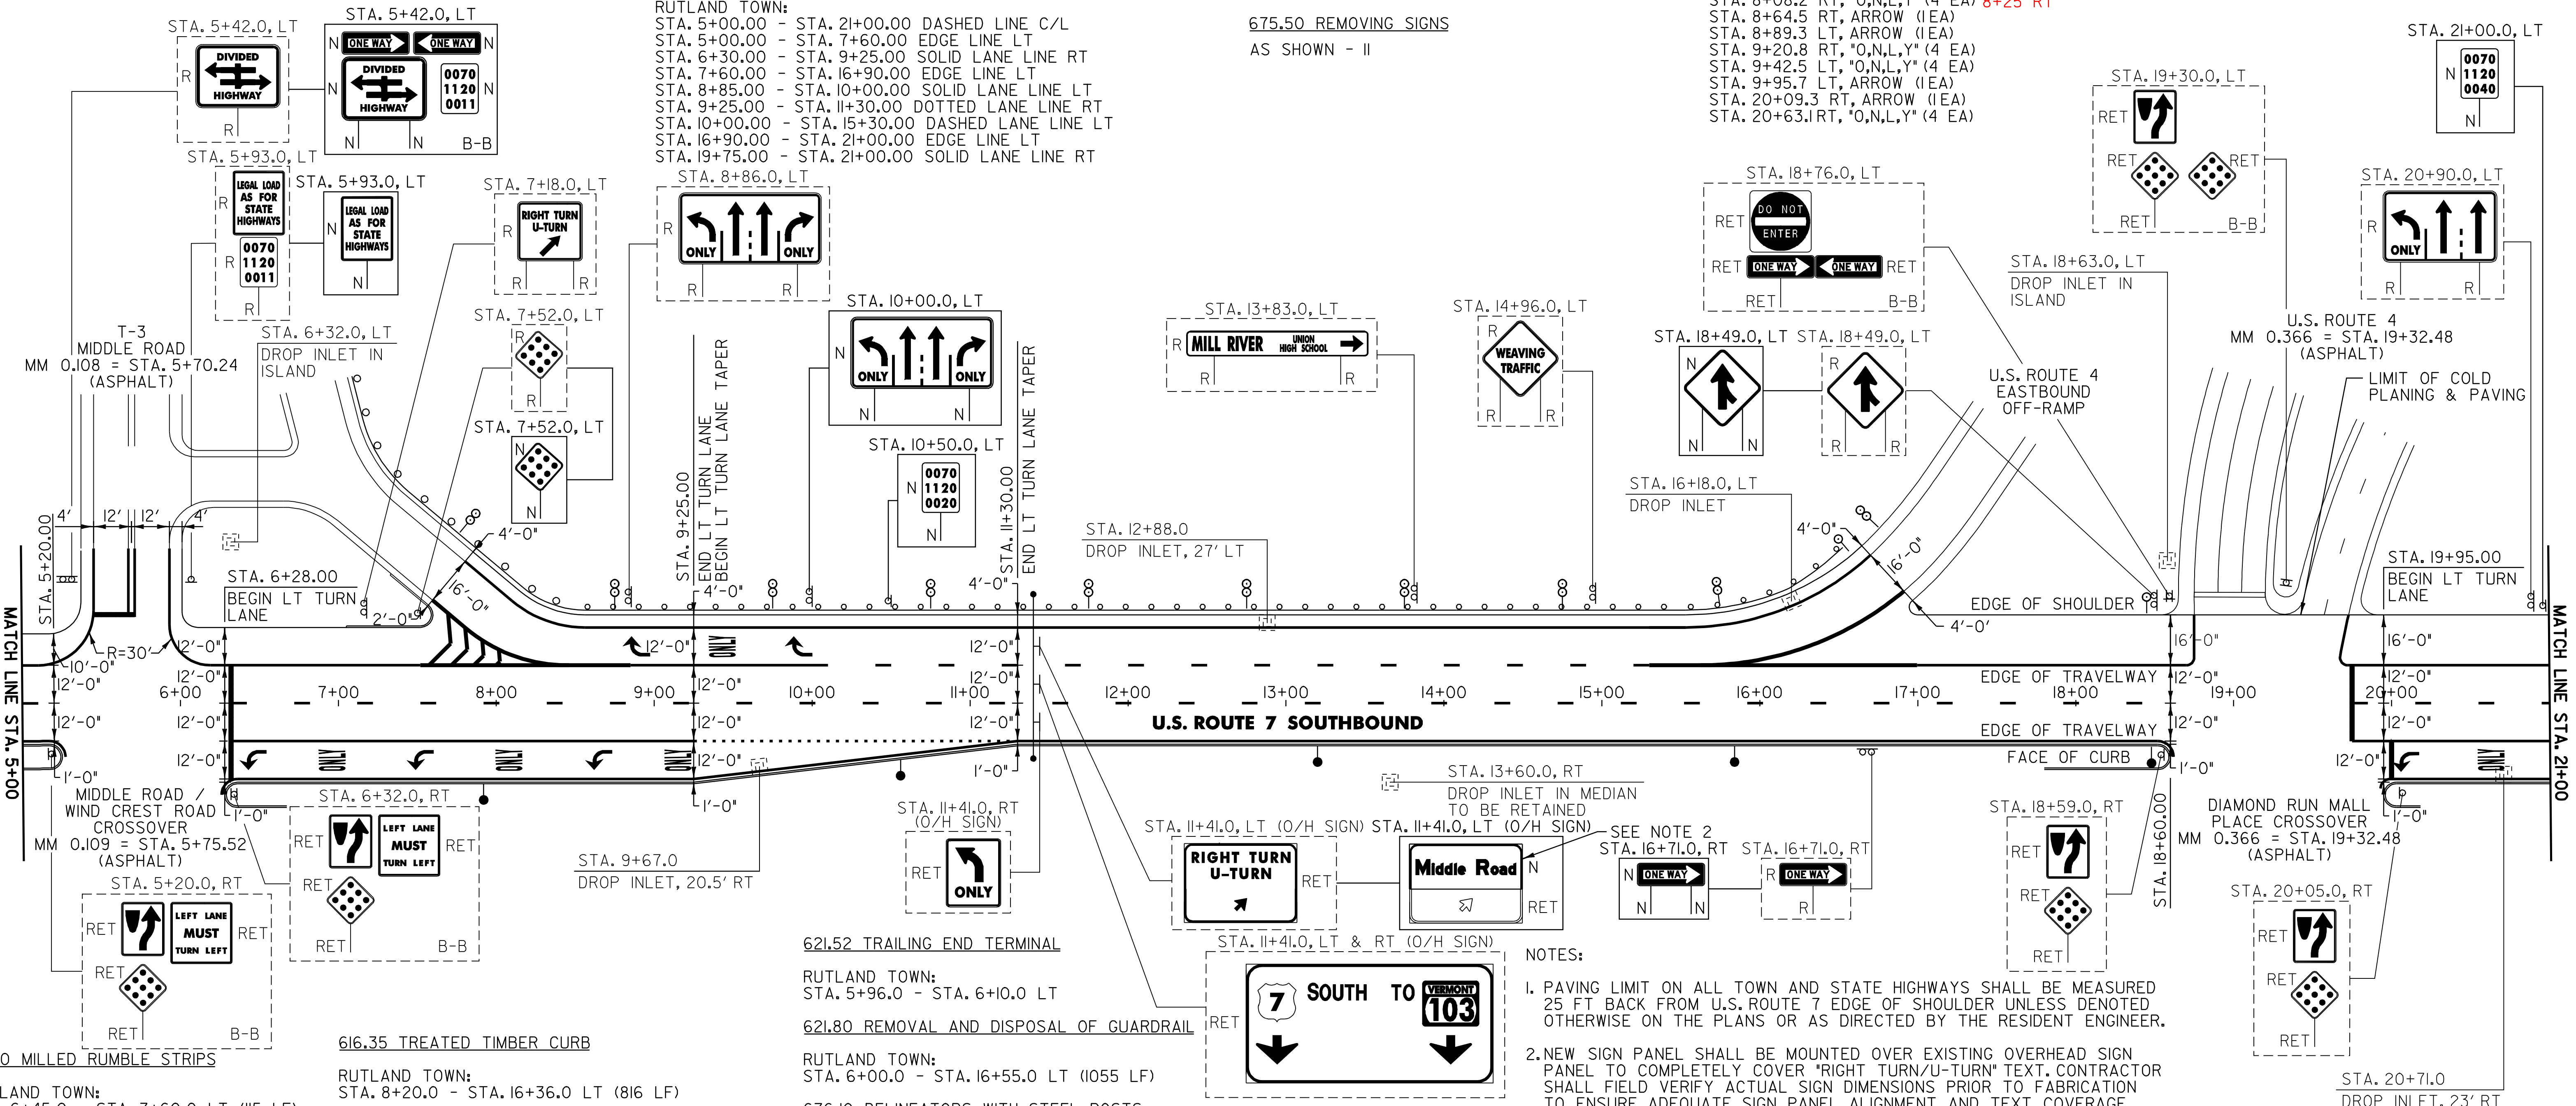

213.10 MILLED RUMBLE STRIPS

RUTLAND TOWN:  
 STA. 6+45.0 - STA. 7+60.0 LT (115 LF)  
 STA. 16+90.0 - STA. 18+20.0 LT (130 LF)  
 STA. 20+25.0 - STA. 21+00.0 LT (75 LF)

604.412 REHABING DI, CB OR MH, CLASS I

RUTLAND TOWN:  
 STA. 6+32.0 LT STA. 16+18.0 LT  
 STA. 9+67.0 RT STA. 18+63.0 LT  
 STA. 12+88.0 LT STA. 20+71.0 RT

616.35 TREATED TIMBER CURB

RUTLAND TOWN:  
 STA. 8+20.0 - STA. 16+36.0 LT (816 LF)

621.20 STEEL BEAM GUARDRAIL (GALVANIZED)

RUTLAND TOWN:  
 STA. 6+10.0 - STA. 16+22.5 LT (1012.5 LF)

621.505 MANUFACTURED TERMINAL SECTION (FLARED)

RUTLAND TOWN:  
 STA. 16+22.5 - STA. 16+60.0 LT

621.52 TRAILING END TERMINAL

RUTLAND TOWN:  
 STA. 5+96.0 - STA. 6+10.0 LT

621.80 REMOVAL AND DISPOSAL OF GUARDRAIL

RUTLAND TOWN:  
 STA. 6+00.0 - STA. 16+55.0 LT (1055 LF)

676.10 DELINEATORS WITH STEEL POSTS

♀ TYPE I WHITE    ♂ TYPE I AMBER    ♂ TYPE II WHITE

RUTLAND TOWN:  
 STA. 7+92.0 RT    STA. 7+75.0 LT    STA. 12+75.0 LT  
 STA. 10+56.0 RT    STA. 8+75.0 LT    STA. 13+75.0 LT  
 STA. 13+20.0 RT    STA. 9+75.0 LT    STA. 14+75.0 LT  
 STA. 15+84.0 RT    STA. 10+75.0 LT    STA. 15+75.0 LT  
 STA. 18+48.0 RT    STA. 11+75.0 LT    STA. 16+75.0 LT

NOTES:

- PAVING LIMIT ON ALL TOWN AND STATE HIGHWAYS SHALL BE MEASURED 25 FT BACK FROM U.S. ROUTE 7 EDGE OF SHOULDER UNLESS DENOTED OTHERWISE ON THE PLANS OR AS DIRECTED BY THE RESIDENT ENGINEER.
- NEW SIGN PANEL SHALL BE MOUNTED OVER EXISTING OVERHEAD SIGN PANEL TO COMPLETELY COVER "RIGHT TURN/U-TURN" TEXT. CONTRACTOR SHALL FIELD VERIFY ACTUAL SIGN DIMENSIONS PRIOR TO FABRICATION TO ENSURE ADEQUATE SIGN PANEL ALIGNMENT AND TEXT COVERAGE.

SIGN LEGEND

R = REMOVE  
 S = SALVAGE  
 N = NEW  
 RET = RETAIN  
 B-B = BACK TO BACK  
 EXISTING = -----  
 NEW = \_\_\_\_\_

**PROJECT LAYOUT SHEET #22**

PROJECT NAME: WALLINGFORD - RUTLAND TOWN  
 PROJECT NUMBER: NH 2408(1)S

FILE NAME: p04b050.dgn    PLOT DATE: \$DATE\$  
 PROJECT LEADER: D.E.G.    DRAWN BY: C.A.K.  
 DESIGNED BY: J.S.P.    CHECKED BY: D.E.G.  
 IPARM FILE: p04b050L22.i    SHEET 34 OF 80