

646.414 DURABLE 6" WHITE LINE (MOD.) (RETROREFLECTIVITY/INLAID)
 (ALL LINES WILL INCLUDE EDGE LINE BREAKS AND RADIUS FOR TOWN HIGHWAYS)

RUTLAND TOWN:
 STA. 21+00.00 - STA. 35+58.72 DASHED LINE C/L
 STA. 21+00.00 - STA. 22+10.00 EDGE LINE LT
 STA. 21+00.00 - STA. 21+75.00 SOLID LANE LINE RT
 STA. 21+75.00 - STA. 23+80.00 DOTTED LANE LINE RT
 STA. 22+10.00 - STA. 35+58.72 EDGE LINE LT
 STA. 23+00.00 - STA. 23+60.00 DASHED LANE LINE LT
 STA. 23+60.00 - STA. 26+75.00 DOTTED LANE LINE LT

646.415 DURABLE 6" YELLOW LINE (MOD.) (RETROREFLECTIVITY/INLAID)
 (ALL LINES WILL INCLUDE EDGE LINE BREAKS AND RADIUS FOR TOWN HIGHWAYS)

RUTLAND TOWN:
 STA. 21+00.00 - STA. 35+58.72 EDGE LINE RT

646.44 DURABLE 12" WHITE LINE (MOD.) (RETROREFLECTIVITY/INLAID)

RUTLAND TOWN:
 STA. 22+10.00 - STA. 23+00.00 GORE AREA LT

646.614 TEMPORARY 6" WHITE LINE (PAINT)
 (ALL LINES WILL INCLUDE EDGE LINE BREAKS AND RADIUS FOR TOWN HIGHWAYS)

RUTLAND TOWN:
 STA. 21+00.00 - STA. 35+58.72 DASHED LINE C/L
 STA. 21+00.00 - STA. 22+10.00 EDGE LINE LT
 STA. 21+00.00 - STA. 21+75.00 SOLID LANE LINE RT
 STA. 21+75.00 - STA. 23+80.00 DOTTED LANE LINE RT
 STA. 22+10.00 - STA. 35+58.72 EDGE LINE LT
 STA. 23+00.00 - STA. 23+60.00 DASHED LANE LINE LT
 STA. 23+60.00 - STA. 26+75.00 DOTTED LANE LINE LT

646.615 TEMPORARY 6" YELLOW LINE (PAINT)
 (ALL LINES WILL INCLUDE EDGE LINE BREAKS AND RADIUS FOR TOWN HIGHWAYS)

RUTLAND TOWN:
 STA. 21+00.00 - STA. 35+58.72 EDGE LINE RT

646.64 TEMPORARY 12" WHITE LINE (PAINT)

RUTLAND TOWN:
 STA. 22+10.00 - STA. 23+00.00 GORE AREA LT

646.50 DURABLE LETTER OR SYMBOL (THERMOPLASTIC)

RUTLAND TOWN:
 STA. 21+6.9 RT, ARROW (1EA)
 STA. 21+70.7 RT, "O,N,L,Y" (4 EA)

646.70 TEMPORARY LETTER OR SYMBOL (PAINT)



RUTLAND TOWN:
 STA. 21+6.9 RT, ARROW (2 EA)

646.81 PAINTED CURB

RUTLAND TOWN:
 STA. 21+00.0 - STA. 35+58.72 RT (1459 LF)

675.50 REMOVING SIGNS

AS SHOWN - 9

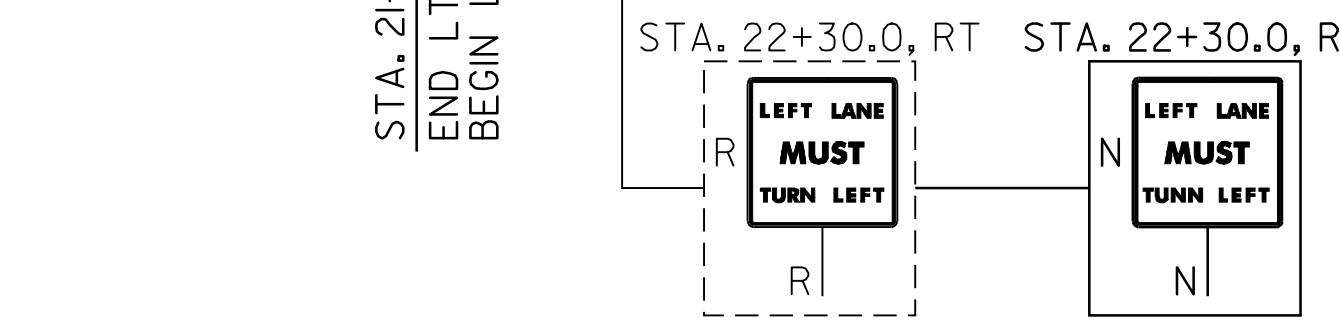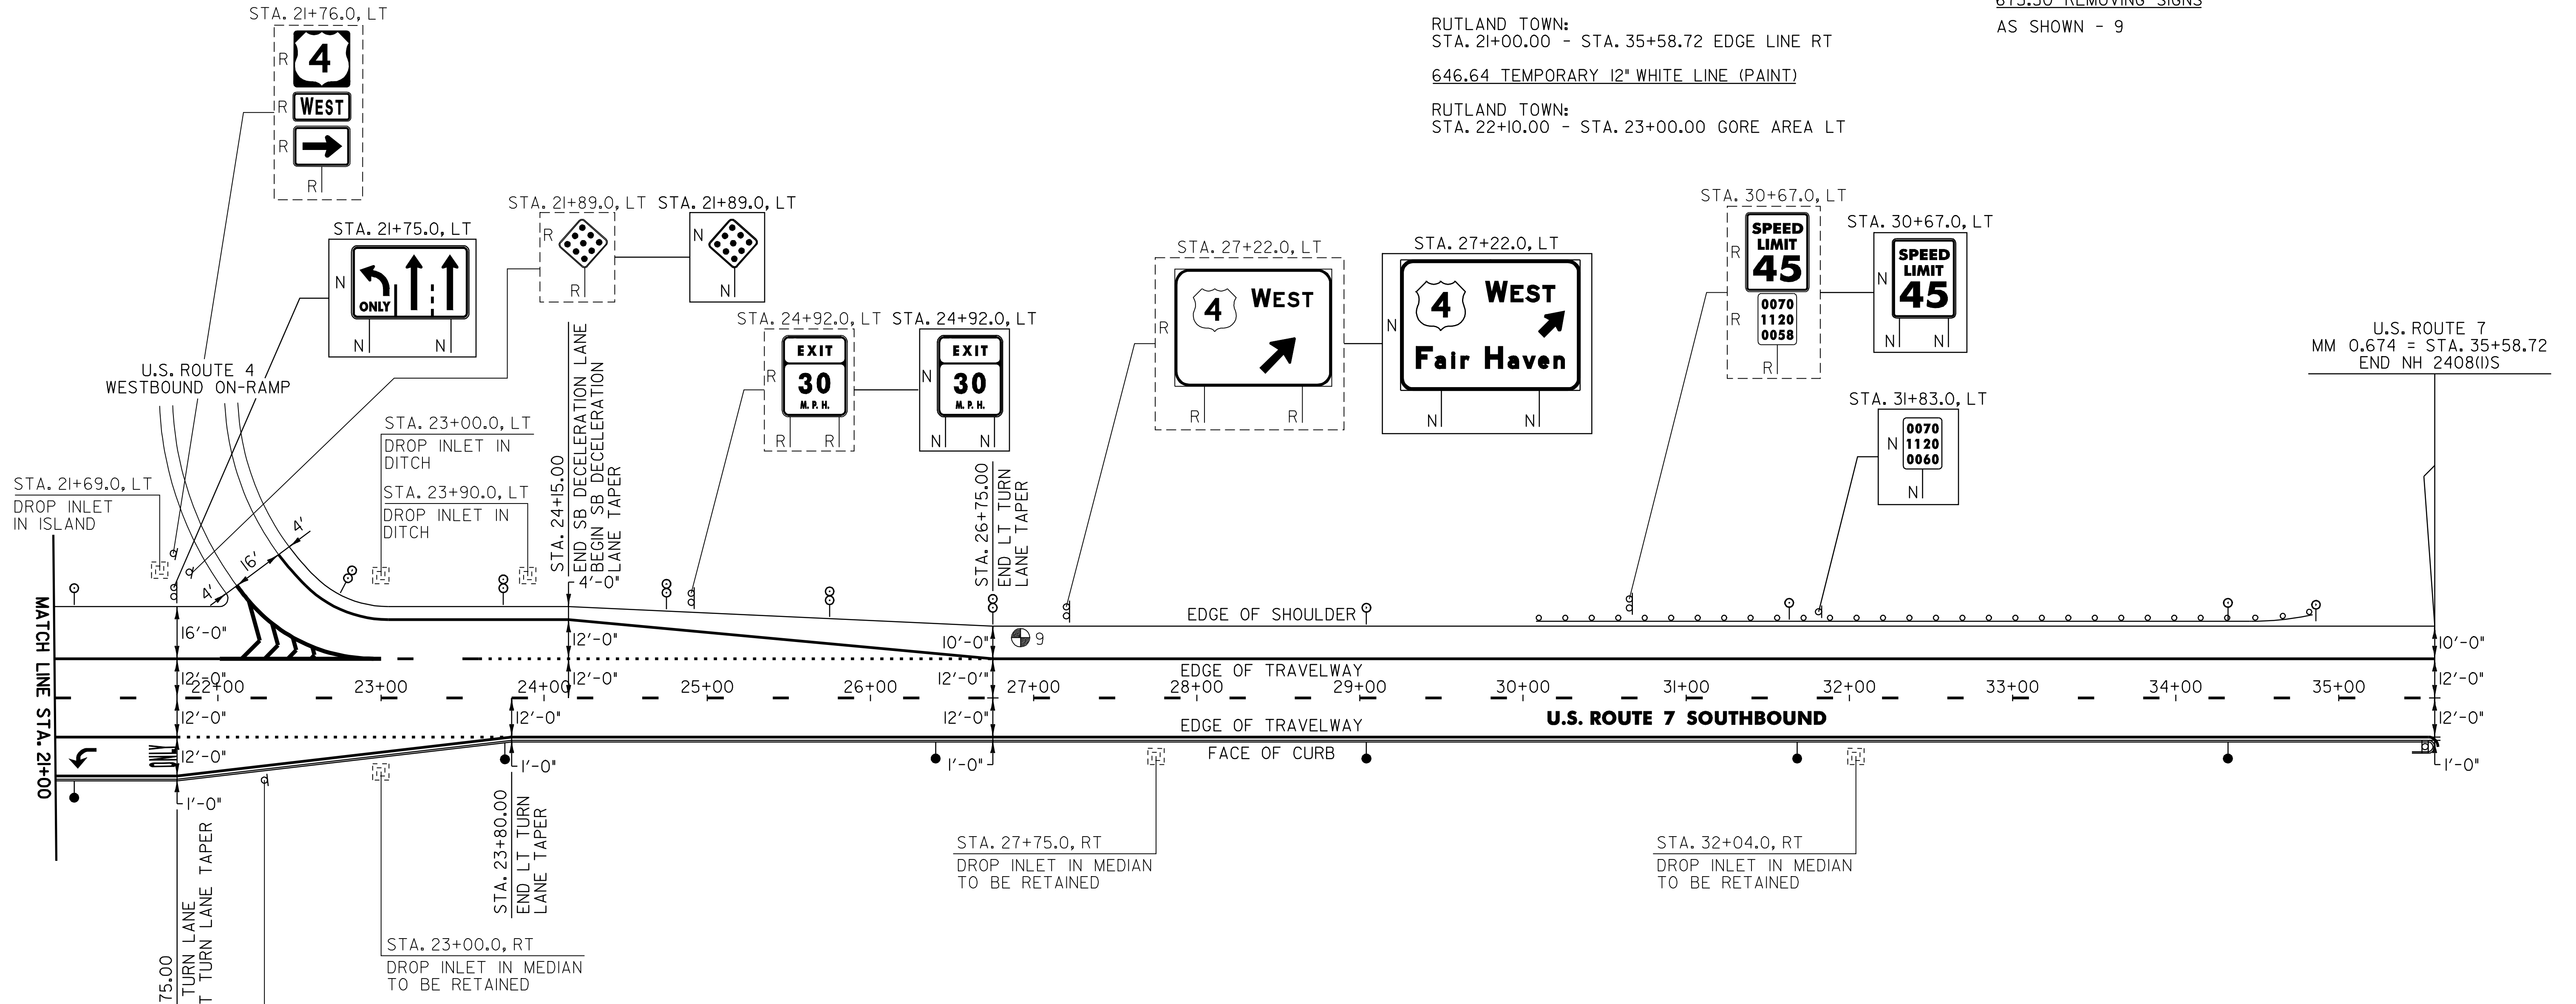

213.10 MILLED RUMBLE STRIPS
 RUTLAND TOWN:
 STA. 21+00.0 - STA. 22+10.0 LT (110 LF)
 STA. 26+75.0 - STA. 35+58.72 LT (884 LF)

604.412 REHABING DI, CB OR MH, CLASS I
 RUTLAND TOWN:
 STA. 21+69.0 LT
 STA. 23+00.0 LT
 STA. 23+90.0 LT

621.20 STEEL BEAM GUARDRAIL (GALVANIZED)

RUTLAND TOWN: 30+02 - STA. 34+52 LT
 STA. 30+20.0 - STA. 34+57.5 LT (437.5 LF) 450 LF

621.505 MANUFACTURED TERMINAL SECTION (FLARED)

RUTLAND TOWN:
 STA. 34+57.5 - STA. 34+95.0 LT

621.52 TRAILING END TERMINAL
 RUTLAND TOWN: 29+88 - STA. 30+02 LT
 STA. 30+06.0 - STA. 30+20.0 LT

621.80 REMOVAL AND DISPOSAL OF GUARDRAIL
 RUTLAND TOWN:
 STA. 30+08.0 - STA. 34+86.0 LT (478 LF)

676.10 DELINEATORS WITH STEEL POSTS

⊙ TYPE I WHITE ⊙ TYPE I AMBER ⊙ TYPE II WHITE

RUTLAND TOWN:
 STA. 21+12.0 LT STA. 21+12.0 RT STA. 22+75.0 LT
 STA. 29+04.0 LT STA. 21+76.0 RT STA. 23+75.0 LT
 STA. 31+68.0 LT STA. 26+40.0 RT STA. 24+75.0 LT
 STA. 34+32.0 LT STA. 28+04.0 RT STA. 25+75.0 LT
 STA. 34+95.0 LT STA. 31+68.0 RT STA. 26+75.0 LT
 STA. 34+32.0 RT

SIGN LEGEND
 R = REMOVE
 S = SALVAGE
 N = NEW
 RET = RETAIN
 B-B = BACK TO BACK
 EXISTING = -----
 NEW = _____

PAVEMENT CORES = ⊕

No.	TOTAL DEPTH (Inches)	PCC	COMMENTS
9	1,625	NO	-

PROJECT LAYOUT SHEET #23

PROJECT NAME: WALLINGFORD - RUTLAND TOWN
 PROJECT NUMBER: NH 2408(I)S

FILE NAME: p04b050.dgn PLOT DATE: \$DATE\$
 PROJECT LEADER: D.E.G. DRAWN BY: C.A.K.
 DESIGNED BY: J.S.P. CHECKED BY: D.E.G.
 IPARM FILE: p04b050L23.I SHEET 35 OF 80