




CLARENDON  
 STA. 88+00.0 LT  
 LEFT POST = 21.1'  
 RIGHT POST = 24.5'  
 W8 x 18

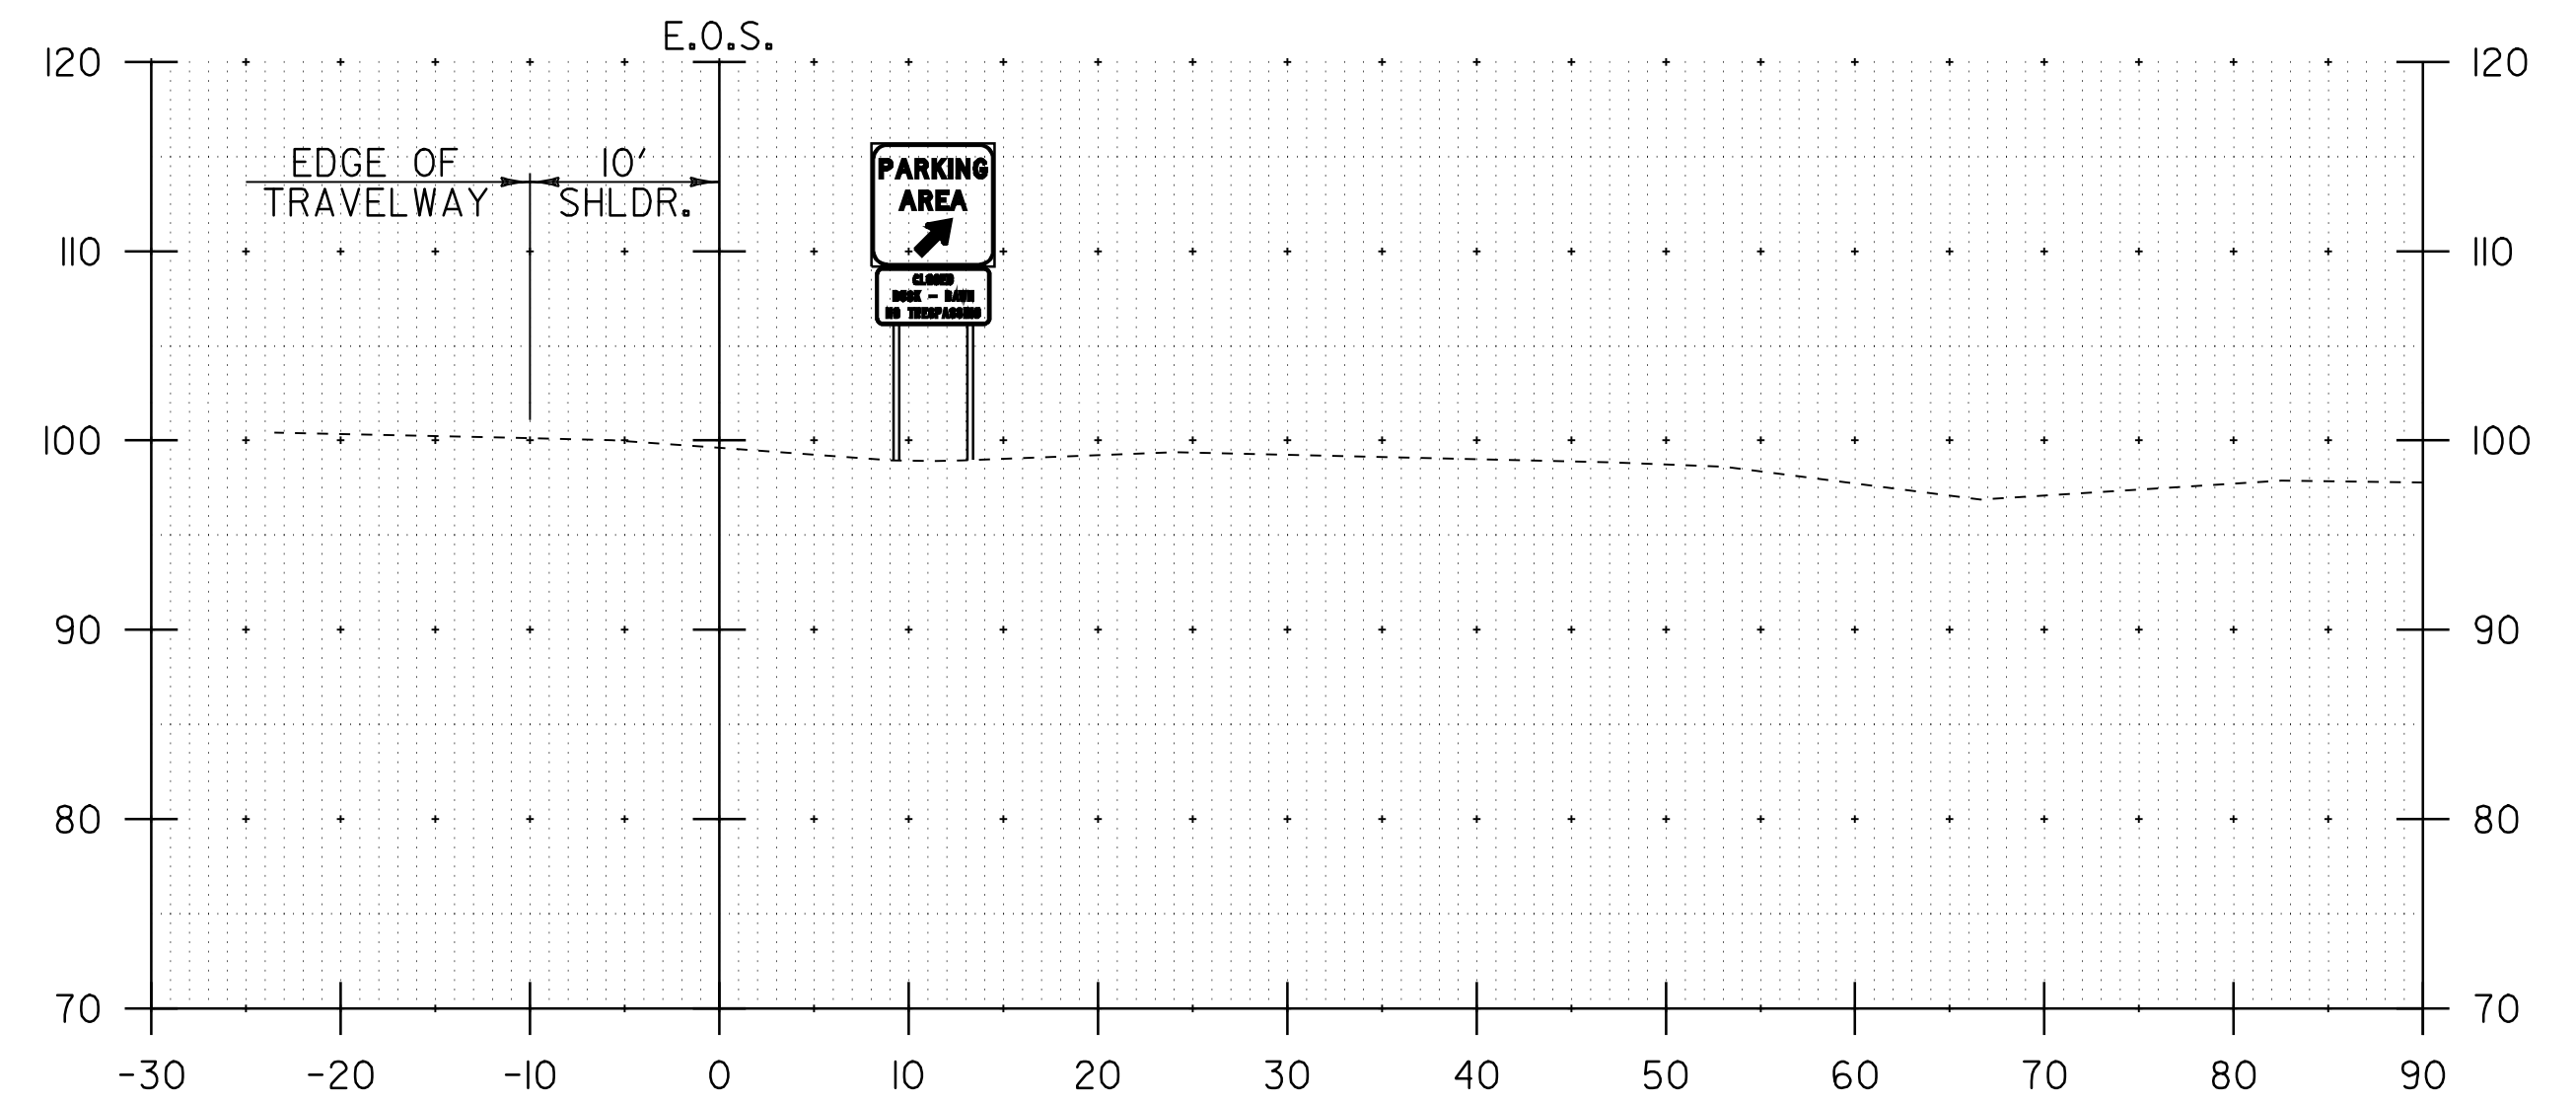


CLARENDON  
 STA. 134+03.0 LT  
 LEFT POST = 16.7'  
 RIGHT POST = 16.7'  
 3/2" DIAMETER TUBULAR STEEL

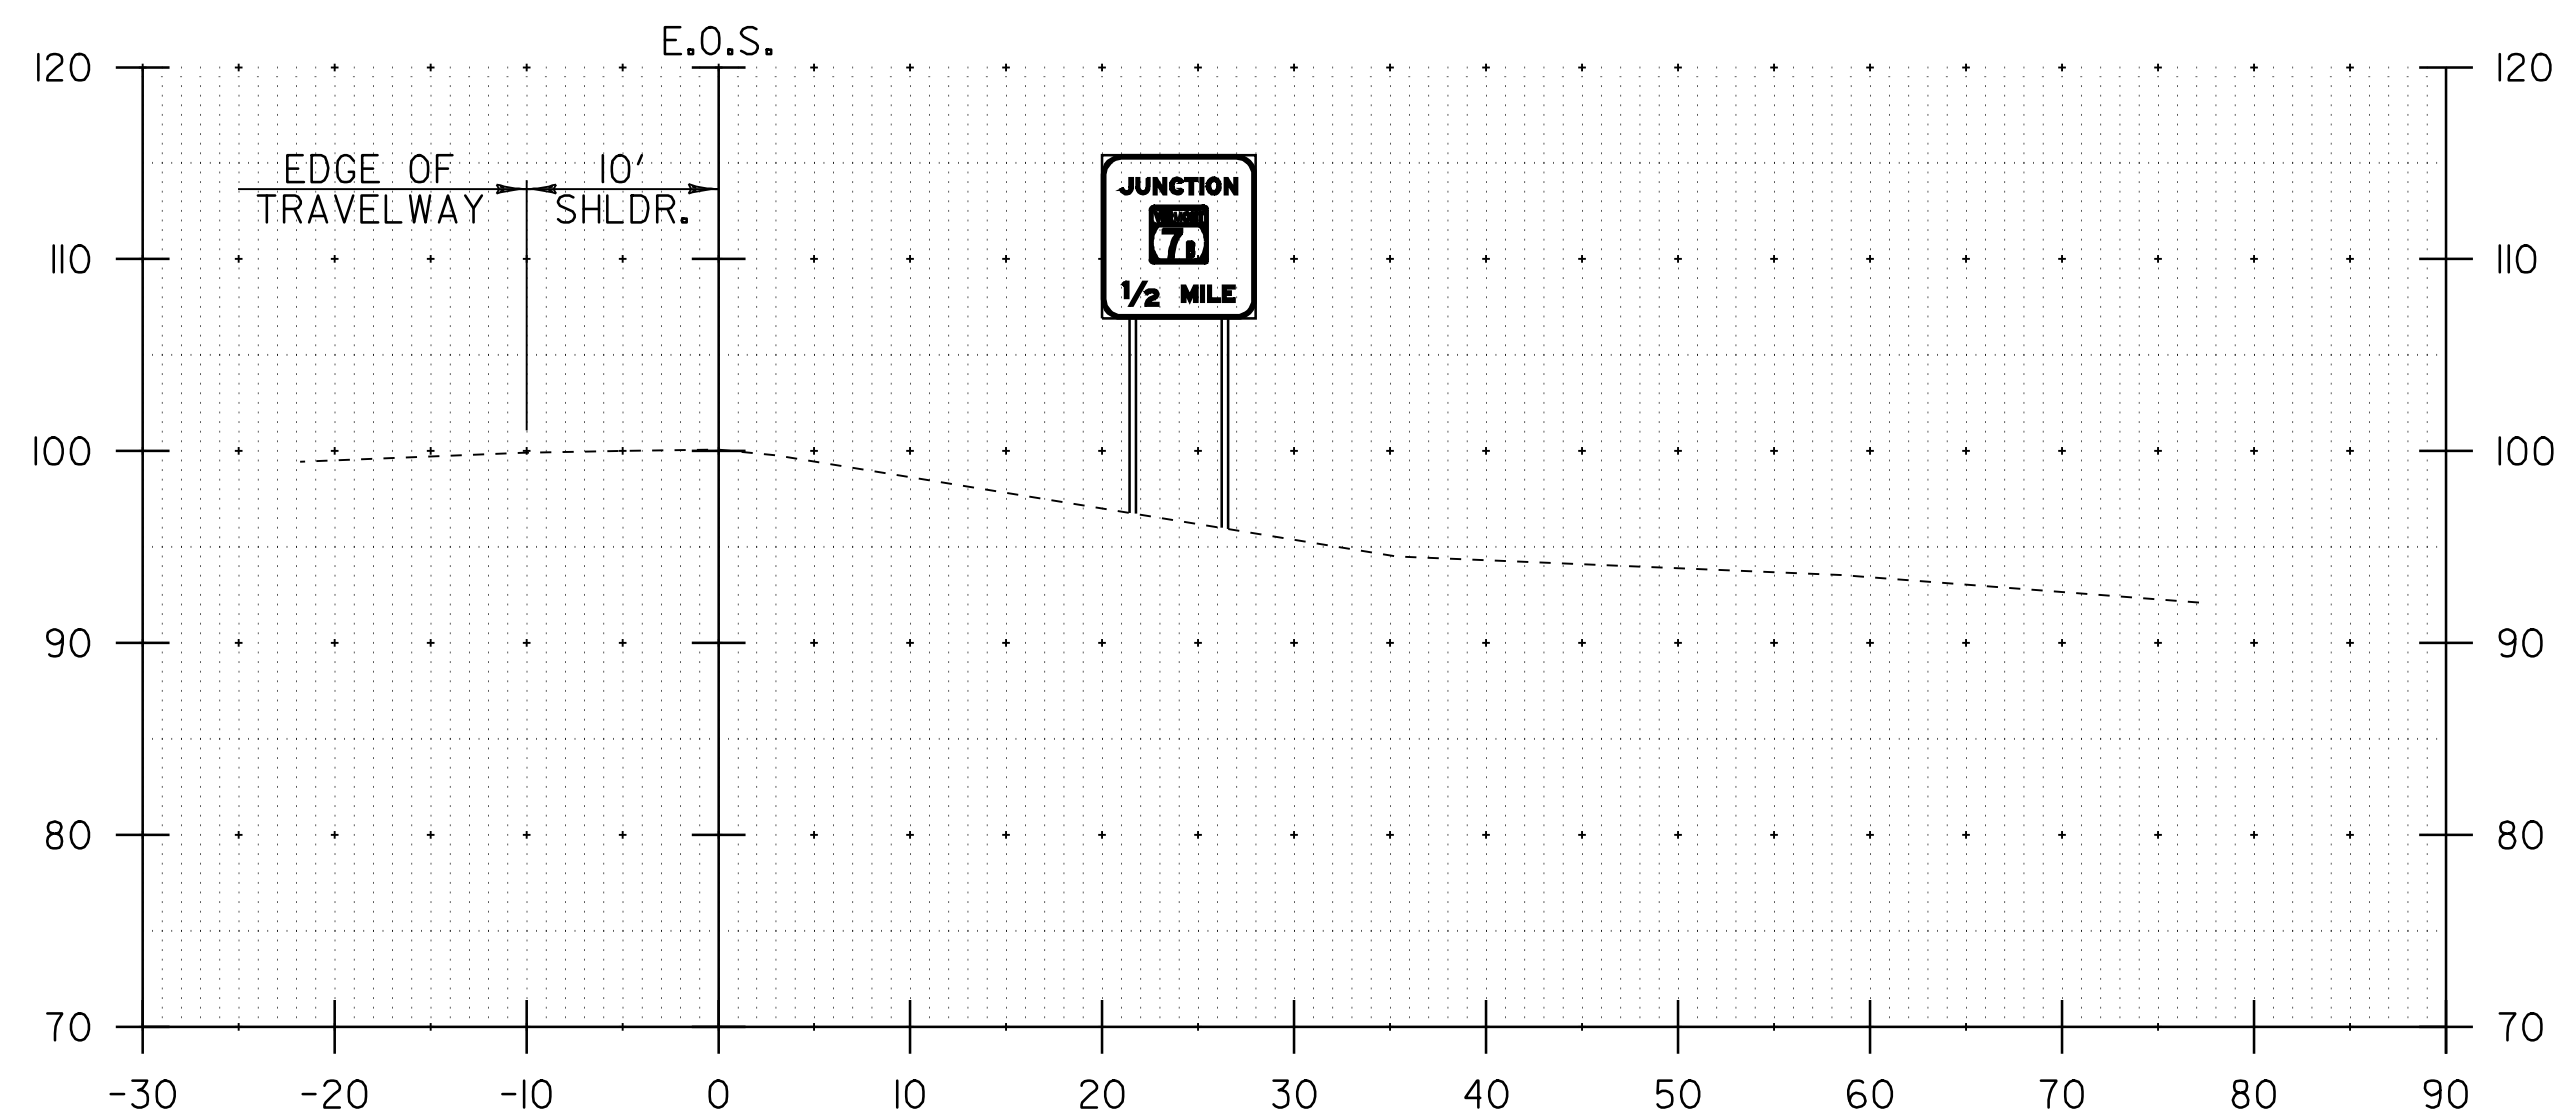

CLARENDON  
 STA. 104+00.0 LT  
 LEFT POST = 18.2'  
 RIGHT POST = 19.0'  
 4" DIAMETER TUBULAR STEEL

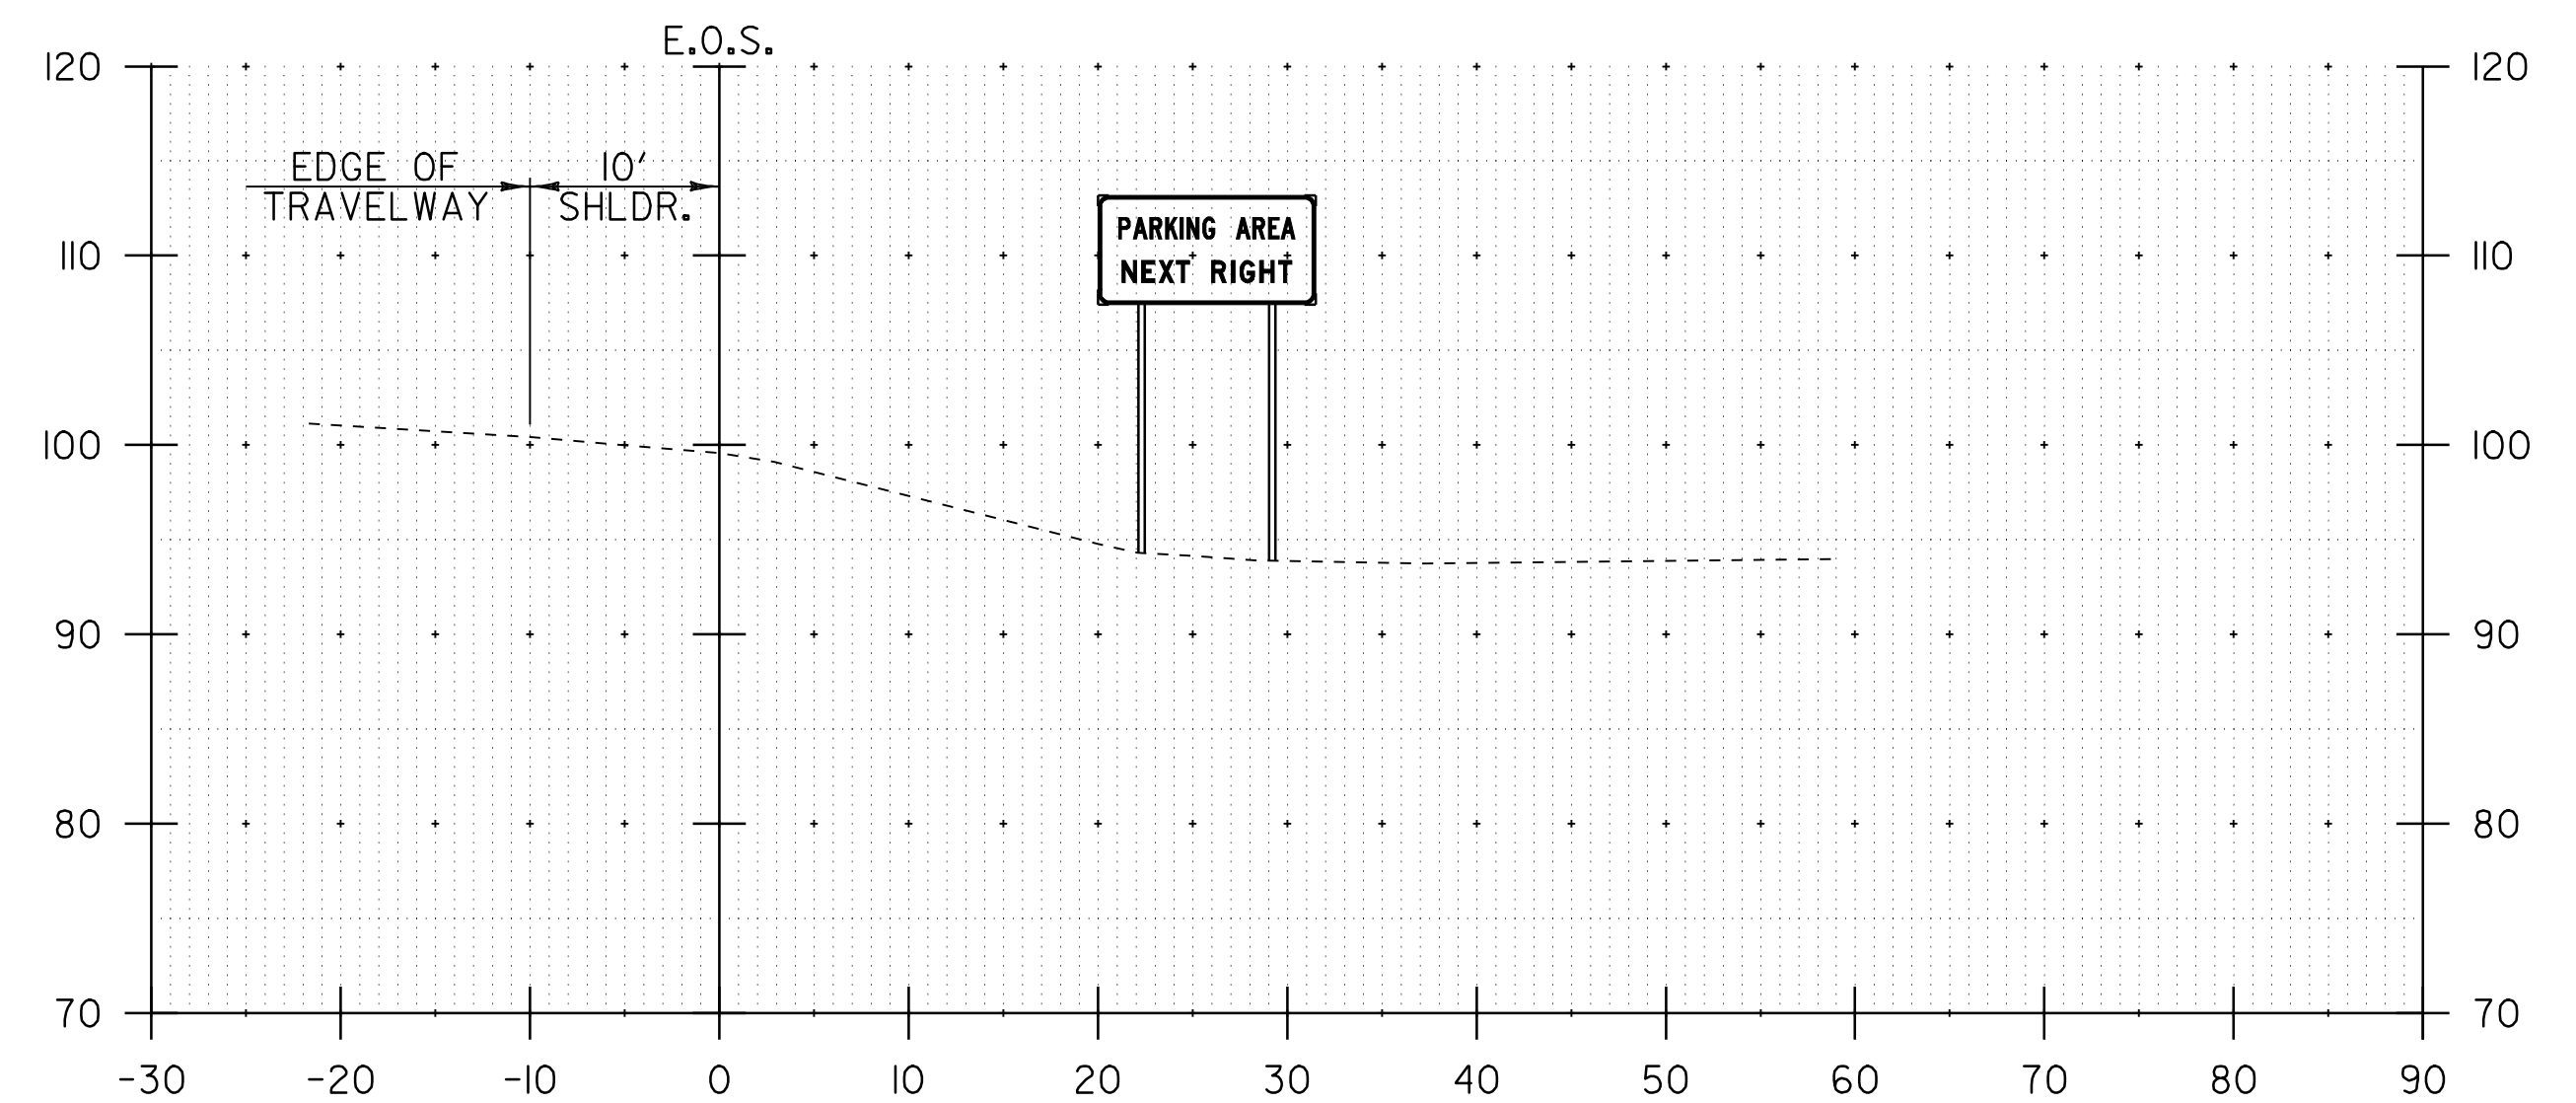

CLARENDON  
 STA. 148+32.0 LT  
 LEFT POST = 18.2'  
 RIGHT POST = 18.5'  
 4" DIAMETER TUBULAR STEEL

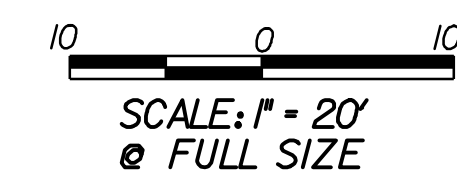

**TRAFFIC SIGN  
 CROSS SECTION  
 SHEET #1**

PROJECT NAME: WALLINGFORD - RUTLAND TOWN  
 PROJECT NUMBER: NH 2408(I)S

FILE NAME: p04b050.dgn  
 PROJECT LEADER: D.E.G.  
 DESIGNED BY: J.S.P.  
 FILE NAME: p04b050xsc01.dgn

PLOT DATE: \$DATE\$  
 DRAWN BY: C.A.K.  
 CHECKED BY: D.E.G.  
 SHEET 68 OF 80