




CLARENDON
 STA. 201+75.0 LT
 LEFT POST = 19.5'
 RIGHT POST = 18.6'
 4" DIAMETER TUBULAR STEEL

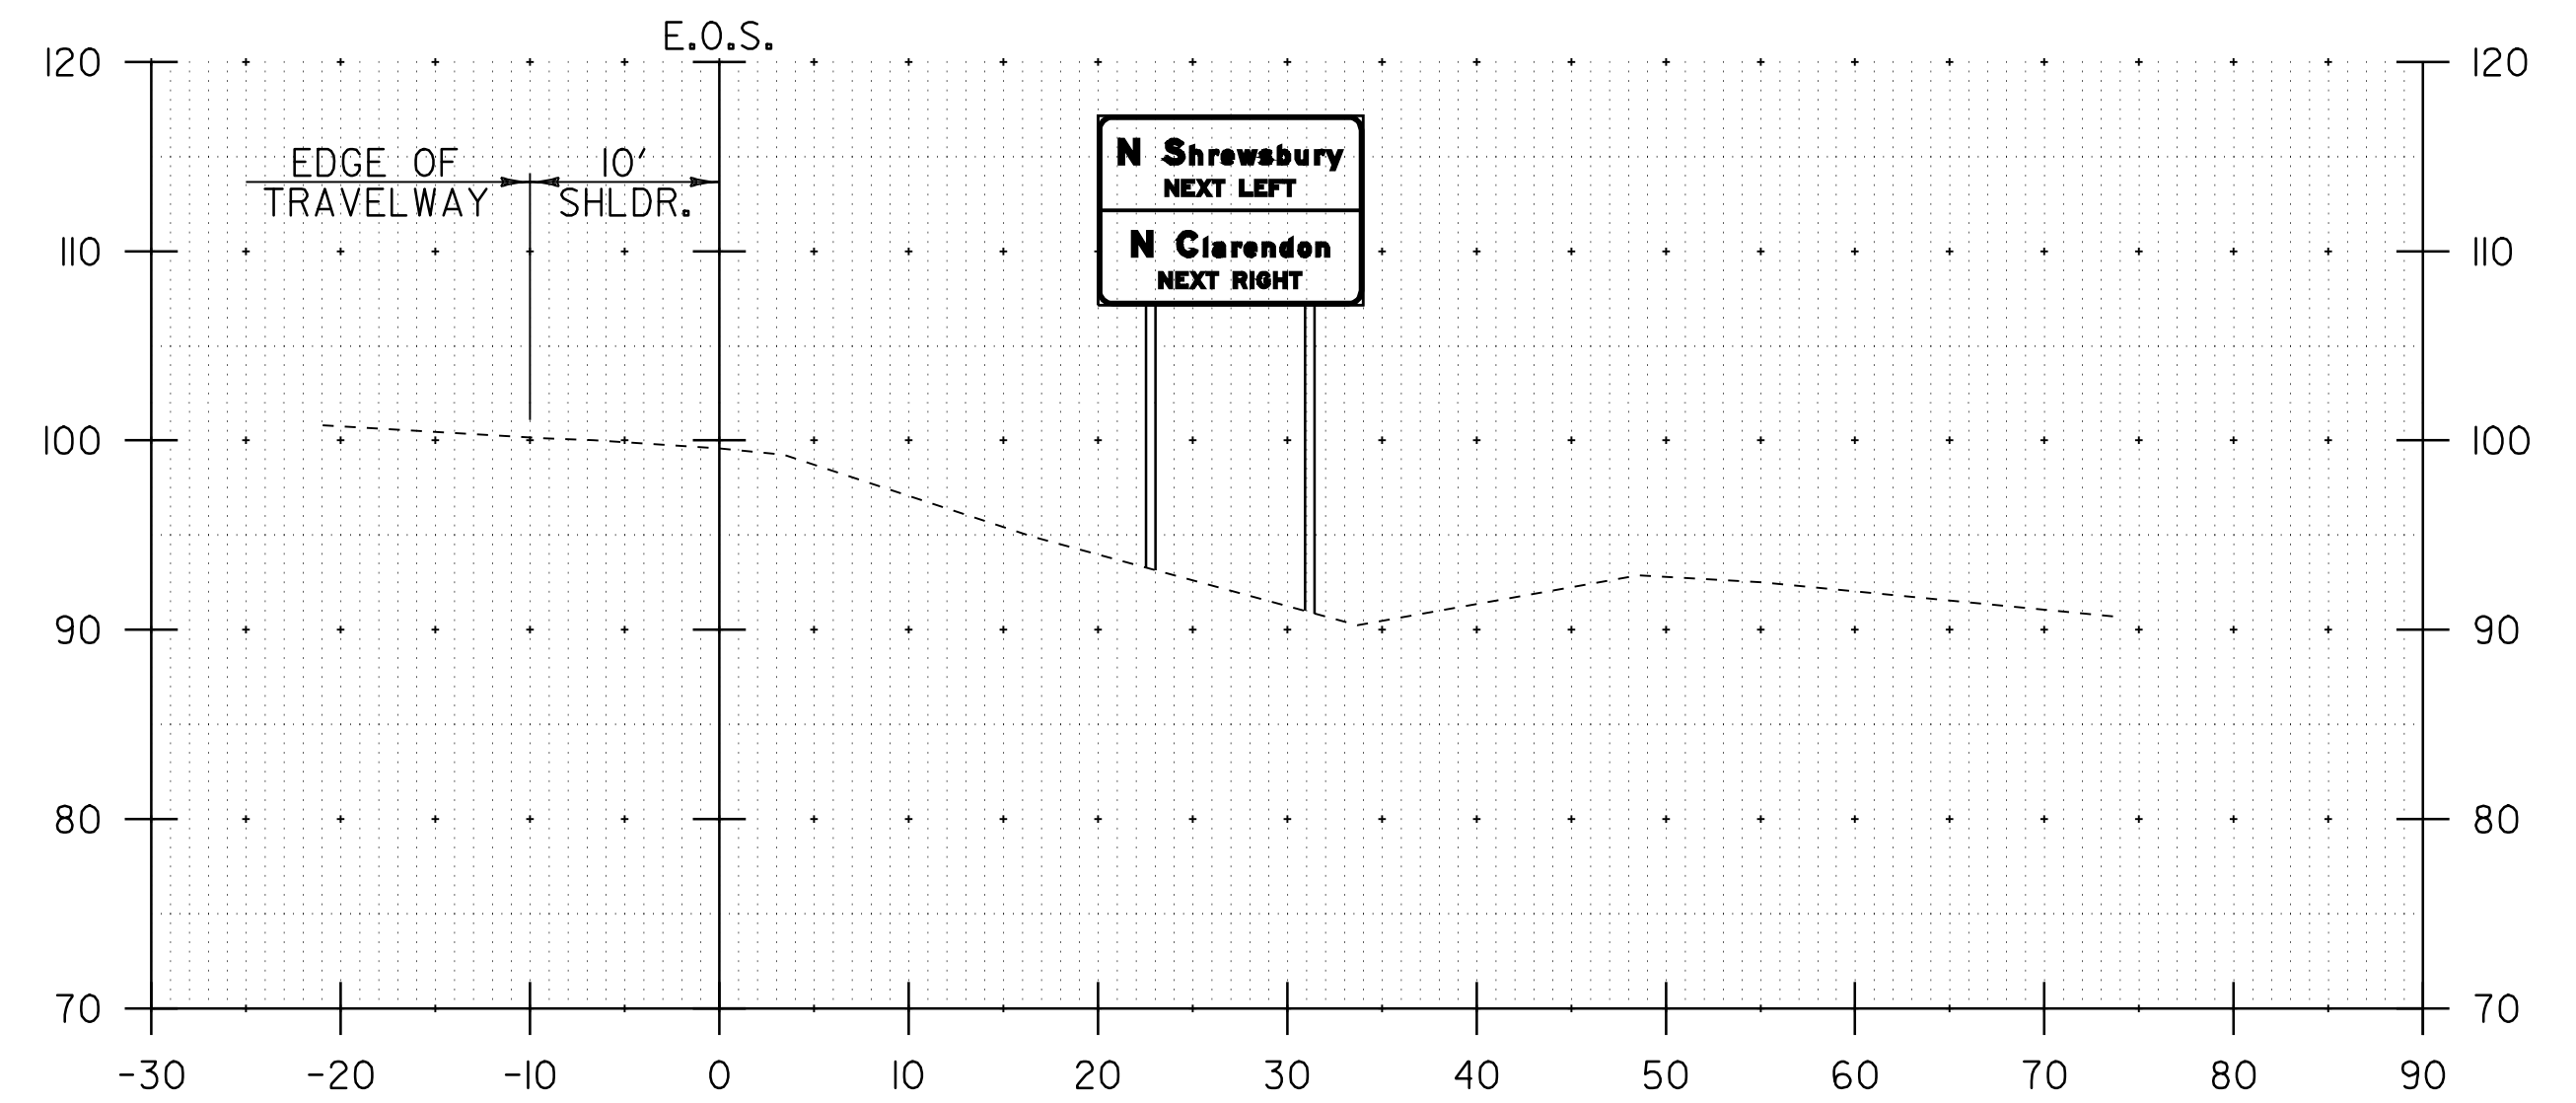

CLARENDON
 STA. 286+88.0 LT
 LEFT POST = 24.0'
 RIGHT POST = 26.3'
 W8 x 21

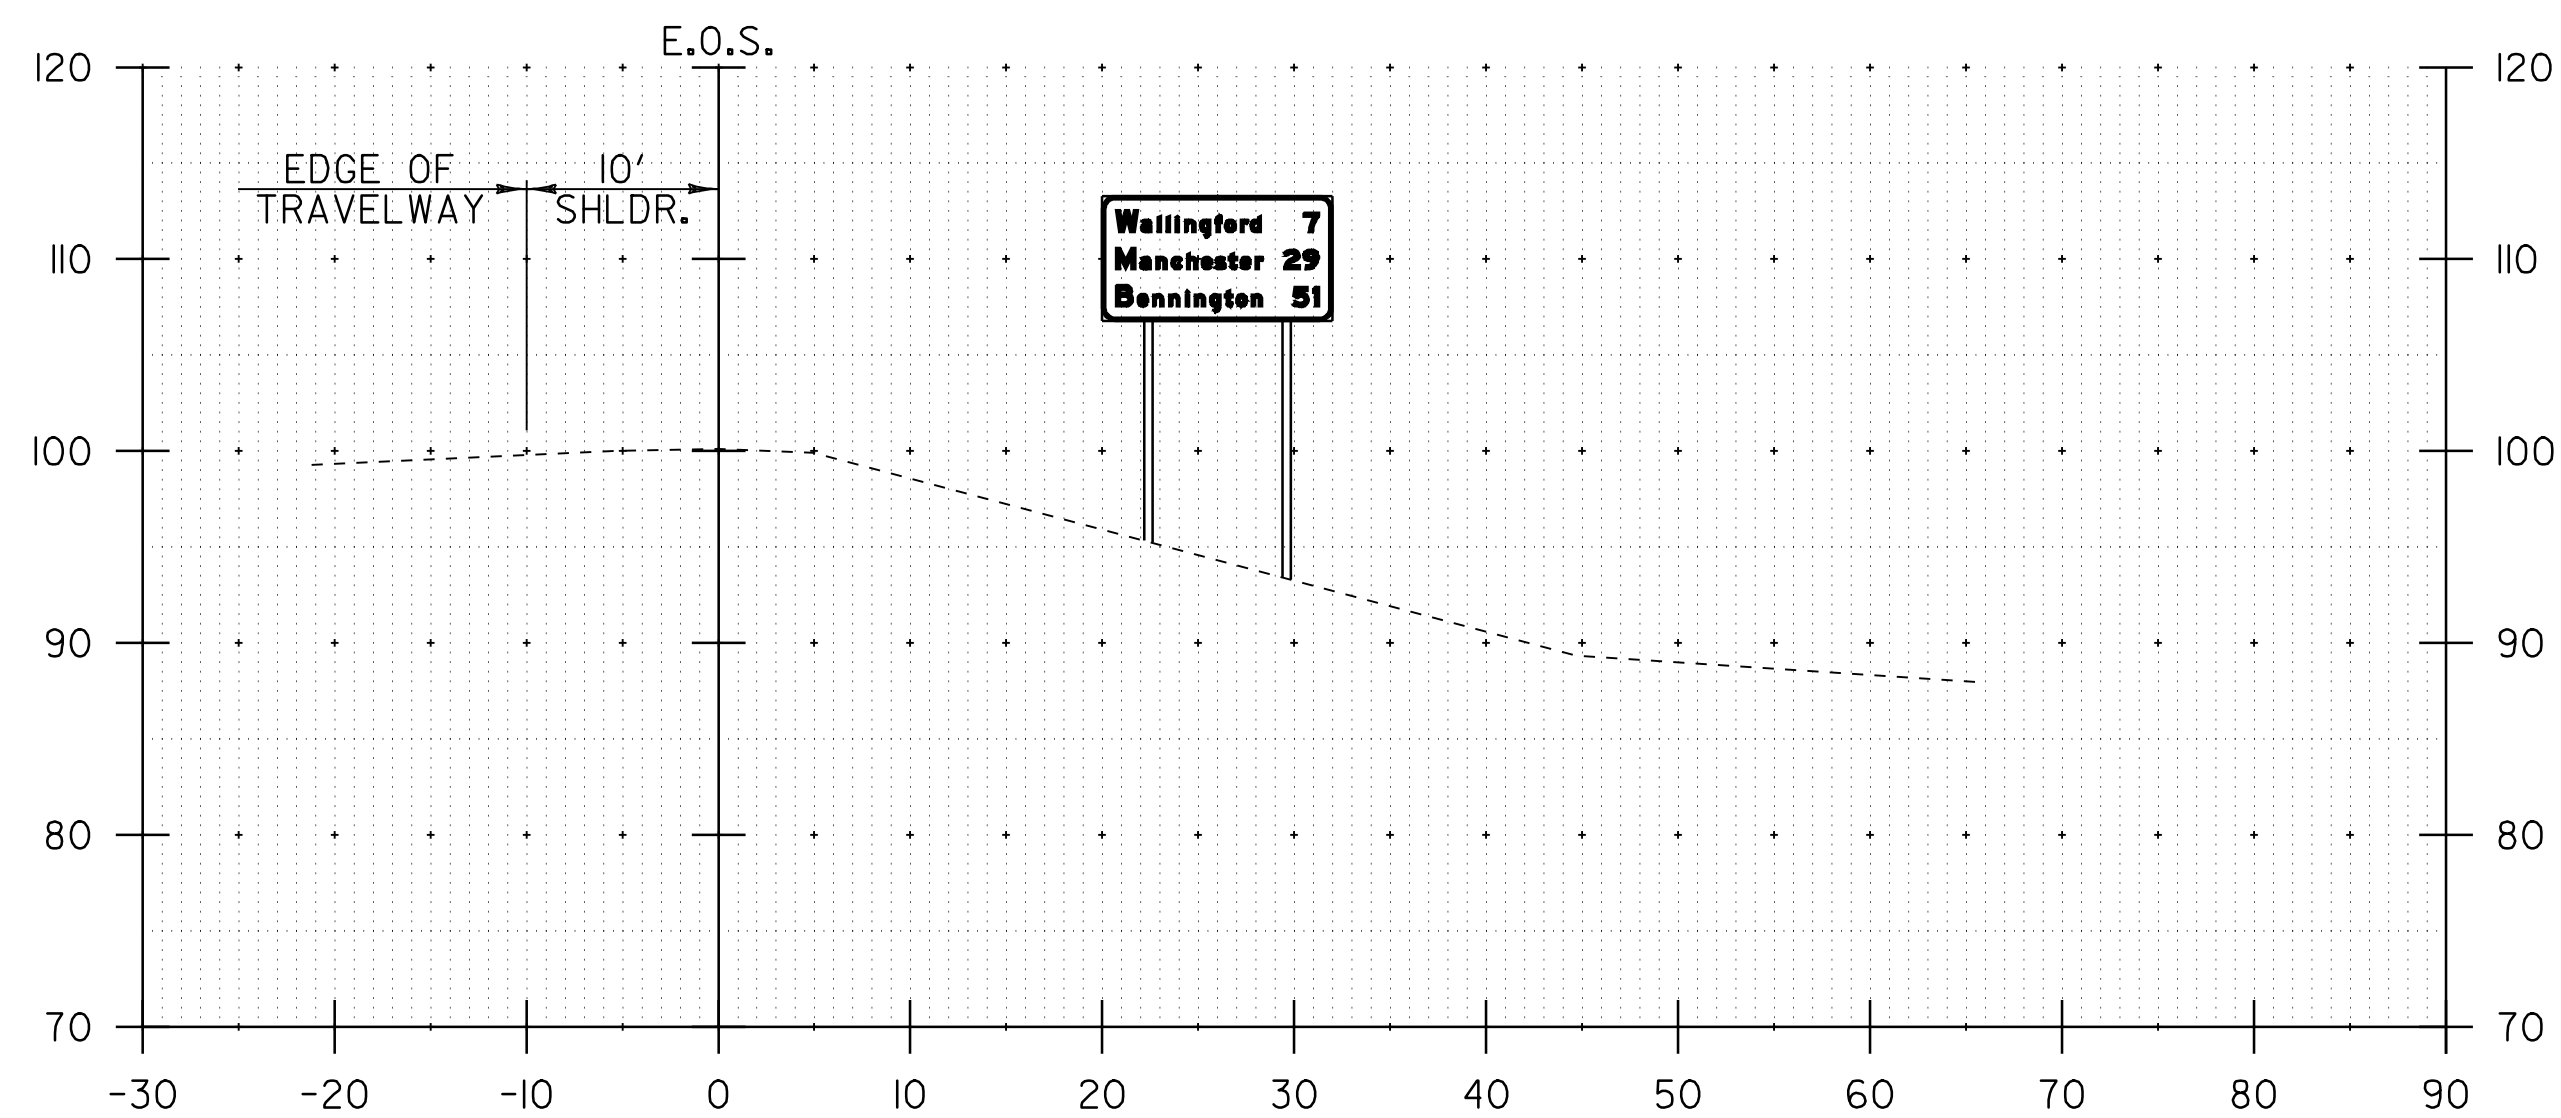

CLARENDON
 STA. 229+50.0 LT
 LEFT POST = 18.0'
 RIGHT POST = 20.0'
 5" DIAMETER TUBULAR STEEL

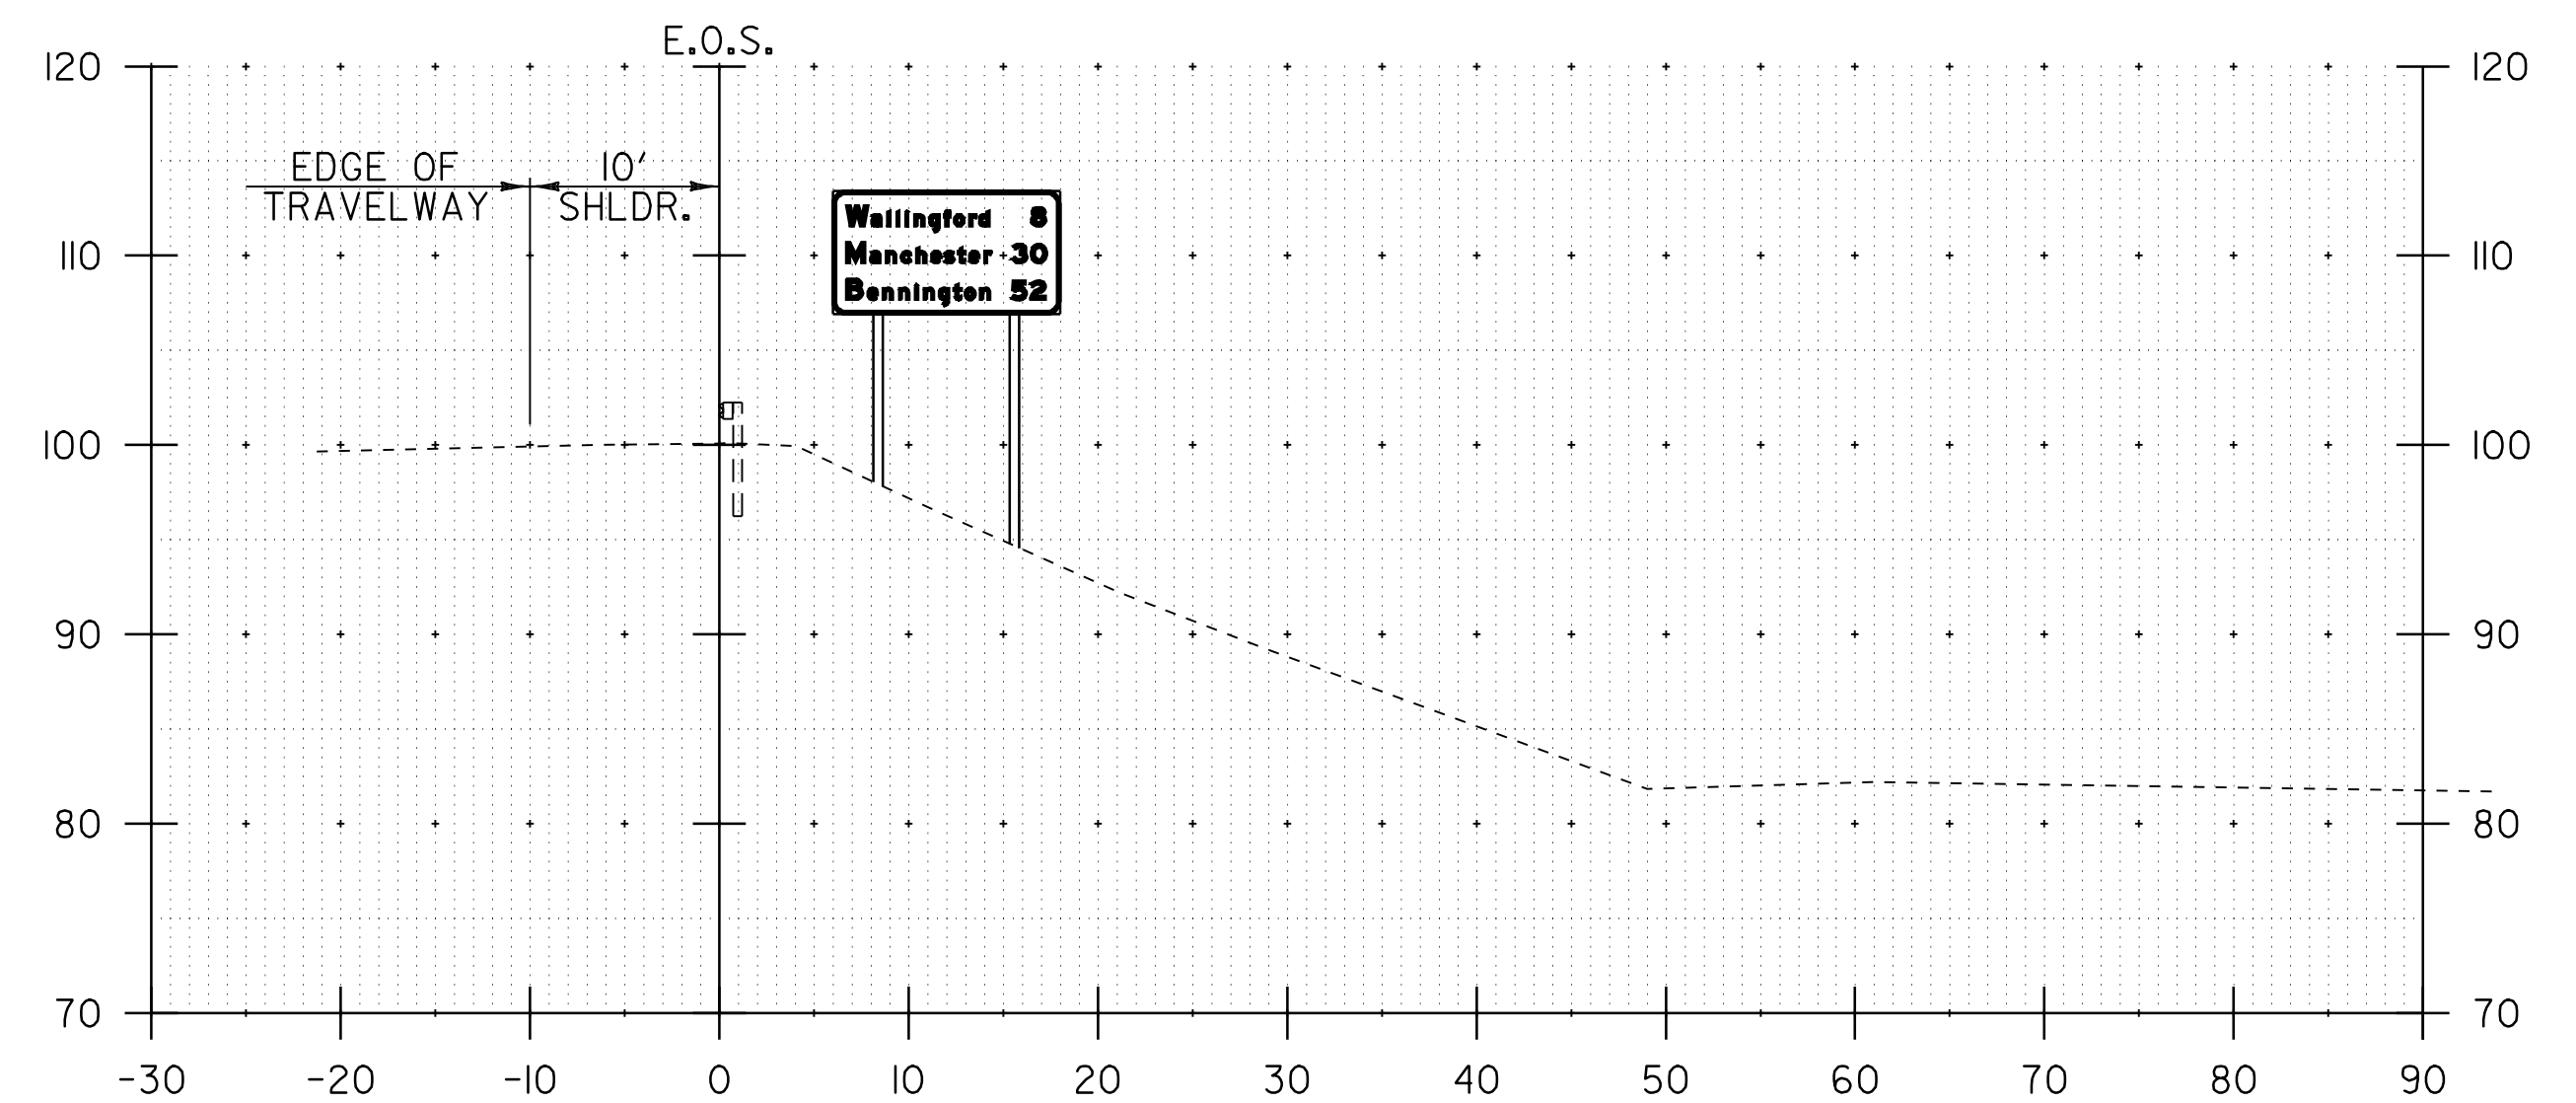

CLARENDON
 STA. 292+61.0 LT
 LEFT POST = 15.5'
 RIGHT POST = 18.8'
 5" DIAMETER TUBULAR STEEL

10 0 10
 SCALE: 1" = 20'
 @ FULL SIZE

**TRAFFIC SIGN
 CROSS SECTION
 SHEET #3**

PROJECT NAME: WALLINGFORD - RUTLAND TOWN
 PROJECT NUMBER: NH 2408(I)S

FILE NAME: p04b050.dgn
 PROJECT LEADER: D.E.G.
 DESIGNED BY: J.S.P.
 FILE NAME: p04b050xsc03.dgn

PLOT DATE: \$DATE\$
 DRAWN BY: C.A.K.
 CHECKED BY: D.E.G.
 SHEET 70 OF 80