


## DETOUR SHEET 5 VT 105 & VT 139

PROJECT NAME: JAY	
PROJECT NUMBER: ST STP CULV (2)	
FILE NAME: 04b140\s04b140detour\signs.dgn	PLOT DATE: 23-OCT-2006
PROJECT LEADER: W. SYMONDS	DRAWN BY: G. SHANGRAW
DESIGNED BY: T. FILLBACH	CHECKED BY: T. SUMNER
s04b140dsigns5.i	SHEET 25 OF 39

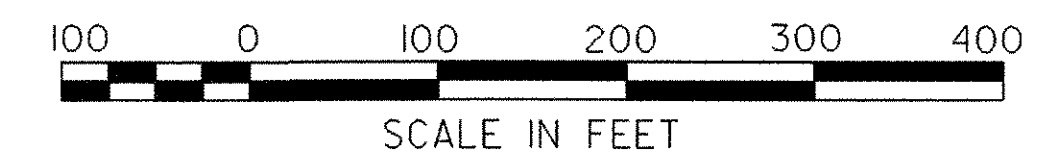

**VT 105 TO  
ENOSBURG FALLS**

**VT 105 TO  
STEVENS MILLS**

**VT 139  
TO CANADA**